
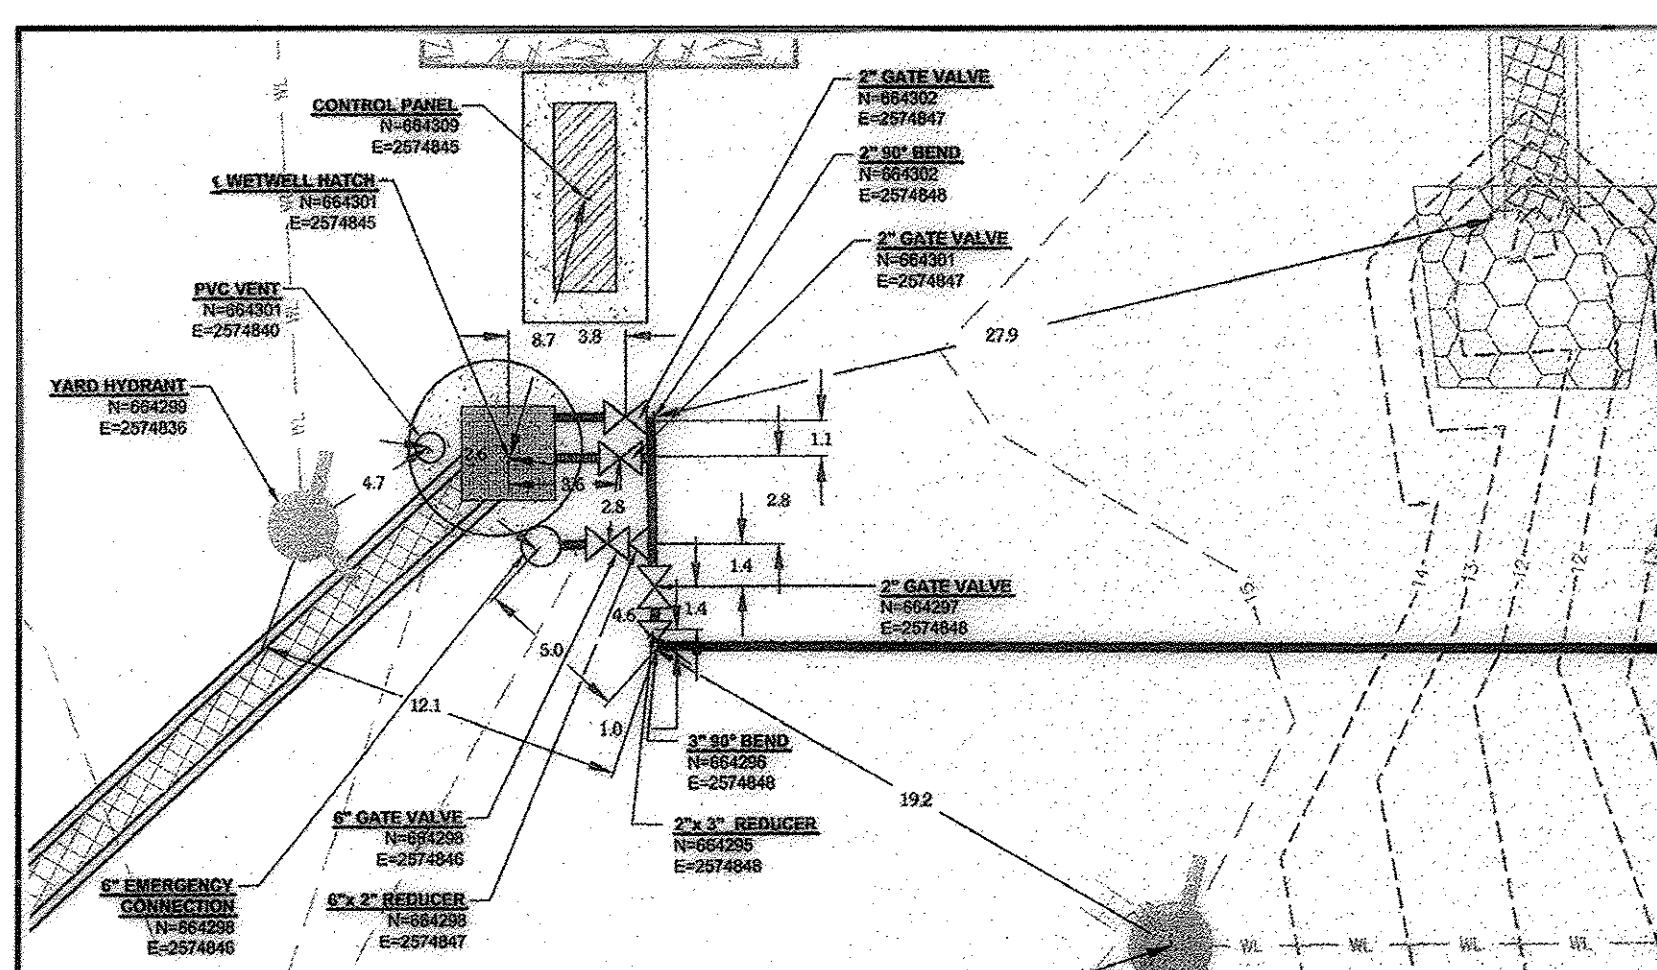
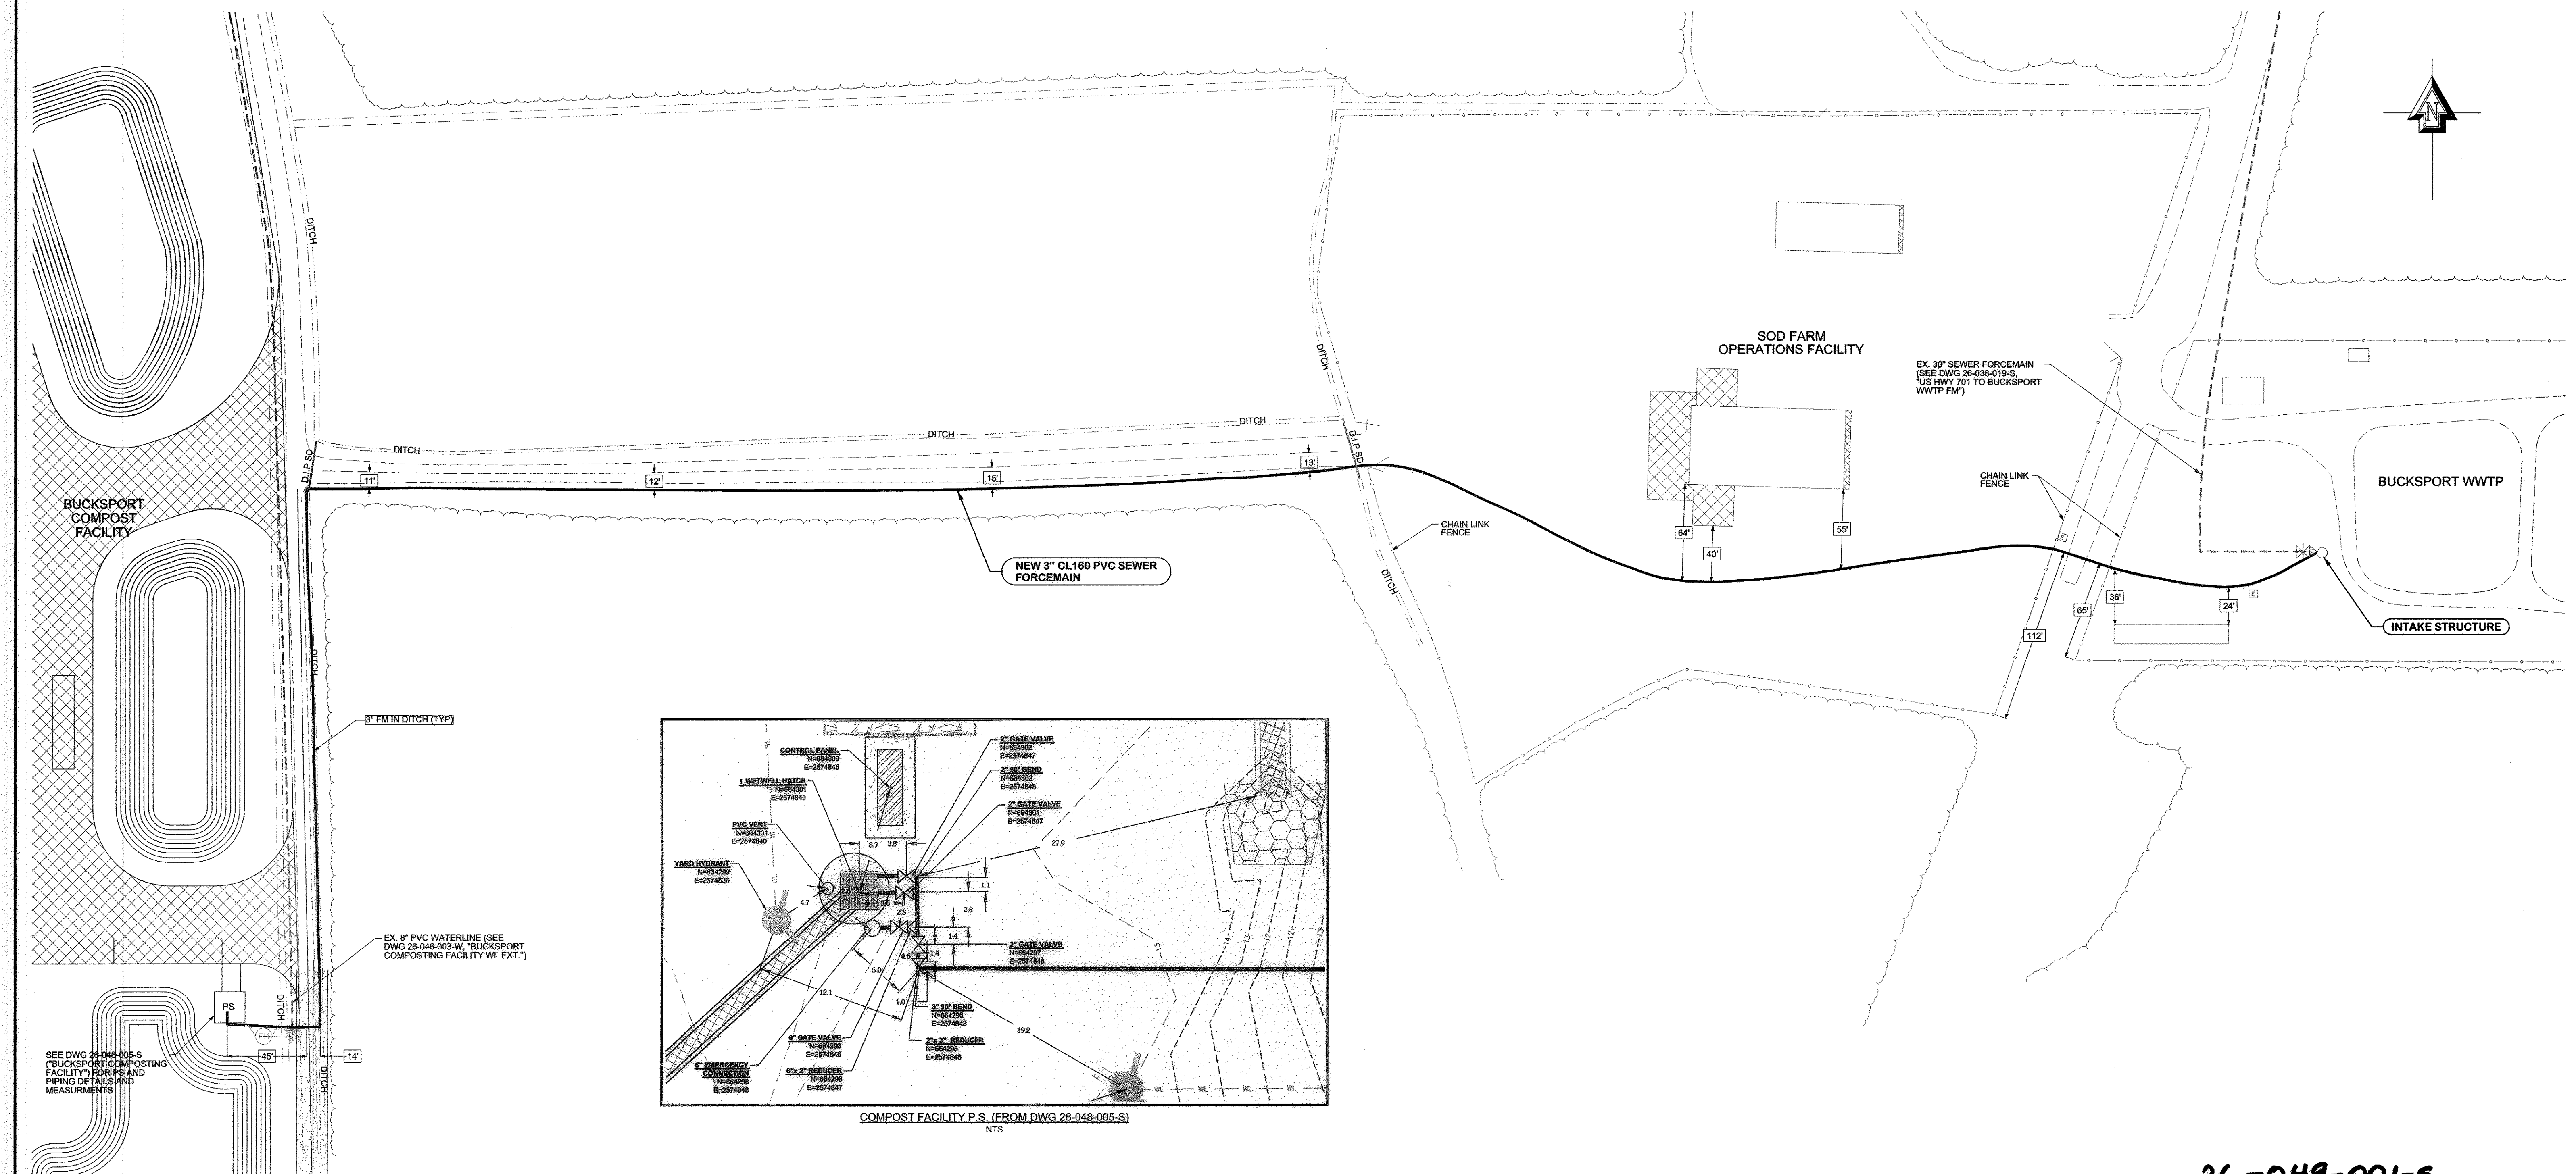


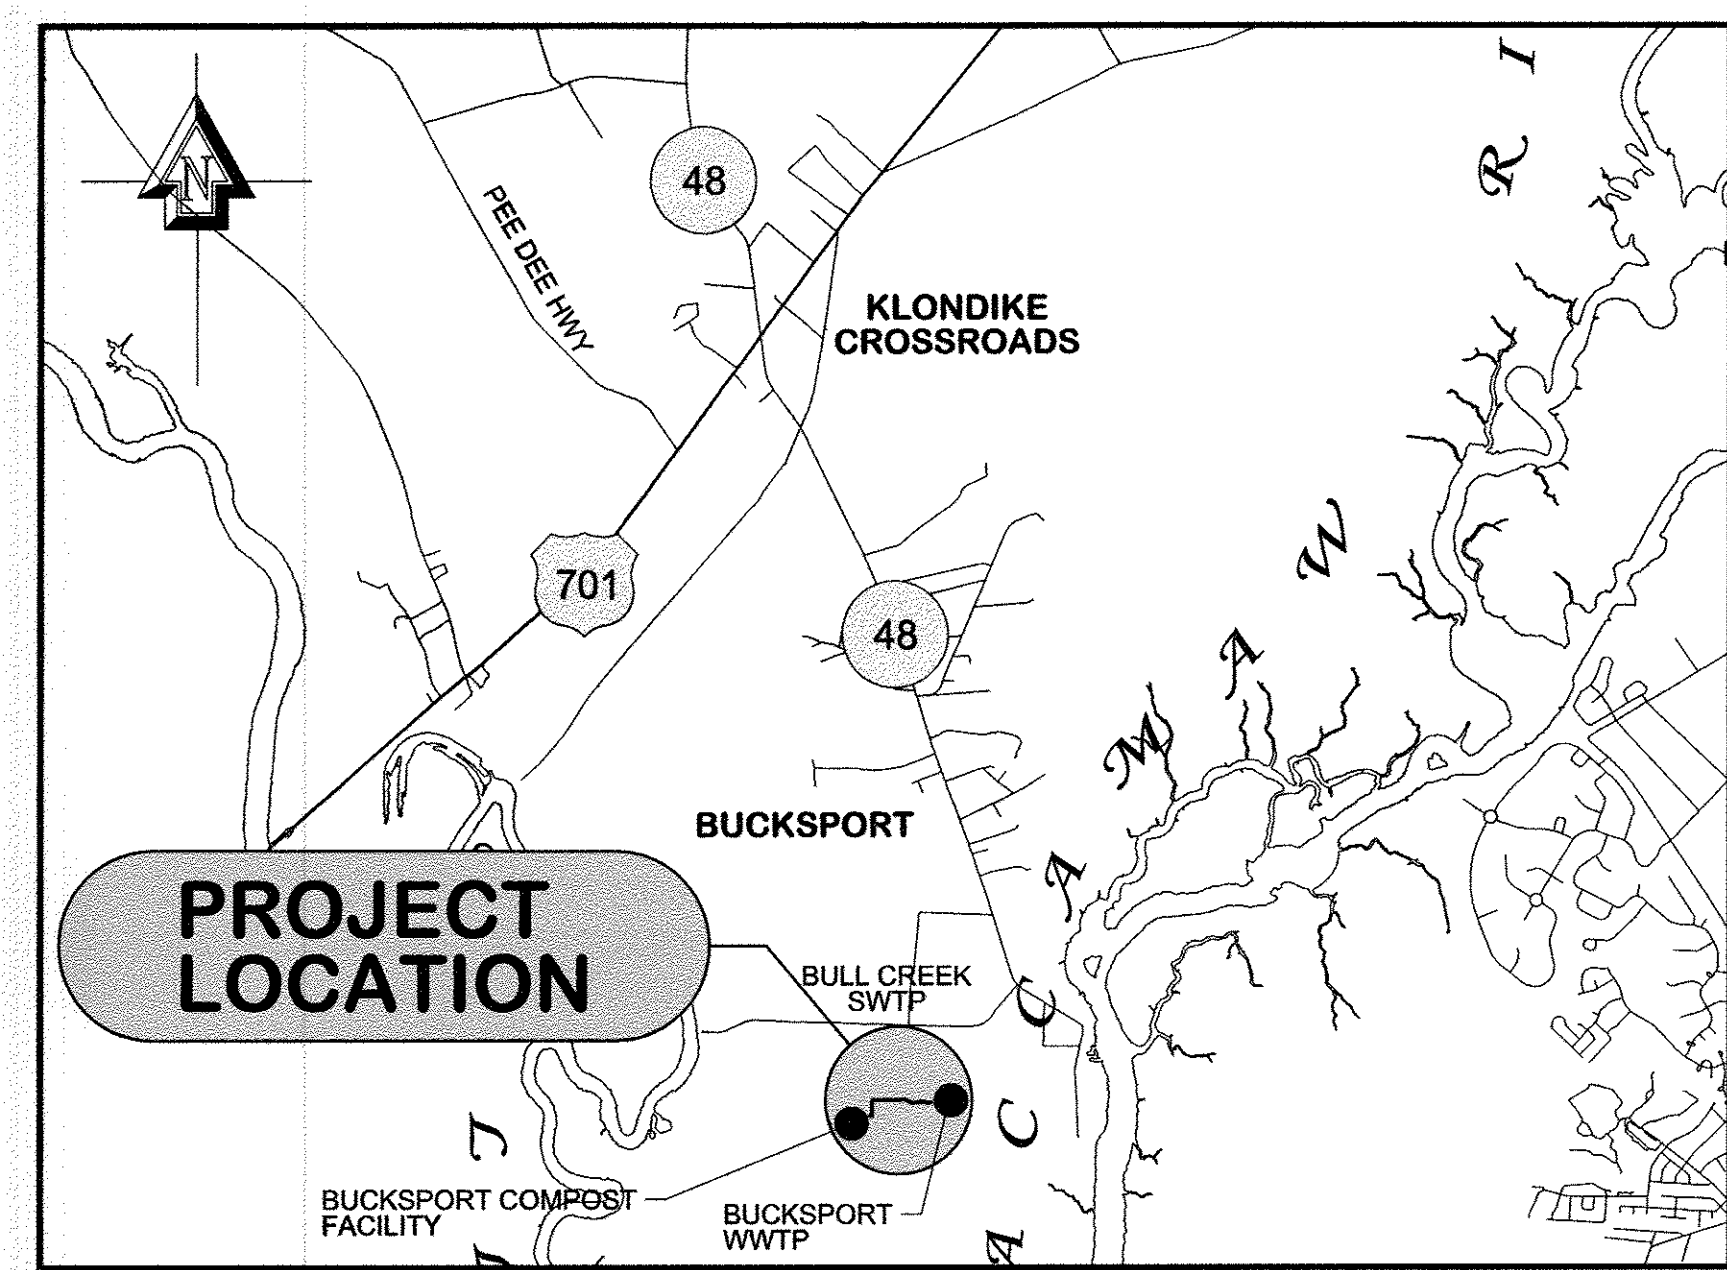

REVISION	BY	DATE
AS-BUILT	DRT	8-8-2011

GRAND STRAND WATER & SEWER AUTHORITY
188 JACKSON BLUFF RD.
P.O. BOX 2385
CONWAY, SC 29525-2385
(843) 343-3433 FAX 1986
E-MAIL: GSWSA.COM

**BUCKSPORT COMPOSTING FACILITY
FORCEMAIN TO WWTP**
(BUCKSPORT COMPOSTING FACILITY & WWTP)
PROJ. #

SC DHEC GENERAL CONSTRUCTION PERMIT
DATE:
SCALE:
FILENAME: Compost facility FM.dgn
DESIGNED BY:
CHECKED BY:
APPROVED BY:
CHRISTINA S. EVERETT PE #21255
SHEET
1
OF 1