



american blueprint of columbia

CHECKED

DRAINAGE STANDBY LAGOON TOP OF DIKE ELEV = 8.8' BOTTOM ELEV.=1.5' 31 SLOP SLOPE Construction and a second s PROPOSED CURTAIN WALL 3-25 Hp AERATORS محسني \bigcirc CELL #1 CELL #2 - IO WIDE DIKE C TOP INFLUENT WITH TOP EL BAR SCREEN EPA FLUME PRVALL EL. 16,25 GEORGETOWN OLD HWY: Agreed and Approved As Correct THE CATTY OF CONWAY BY: May Manta Martin EXIST. AERATORS PROPOSED AERATORS GSW 64 APPROVALS SEAL B. P. BARBER & ASSOCIATES, INC GKM, JY. ENGINEERS • SURVEYORS • PLANNERS GKM, JC BY 2611 FOREST DRIVE GKM, JC P.O. BOX 1116 RTH BY COLUMBIA, S. C. 29202 JML APPROVED BY 803 - 254-4400

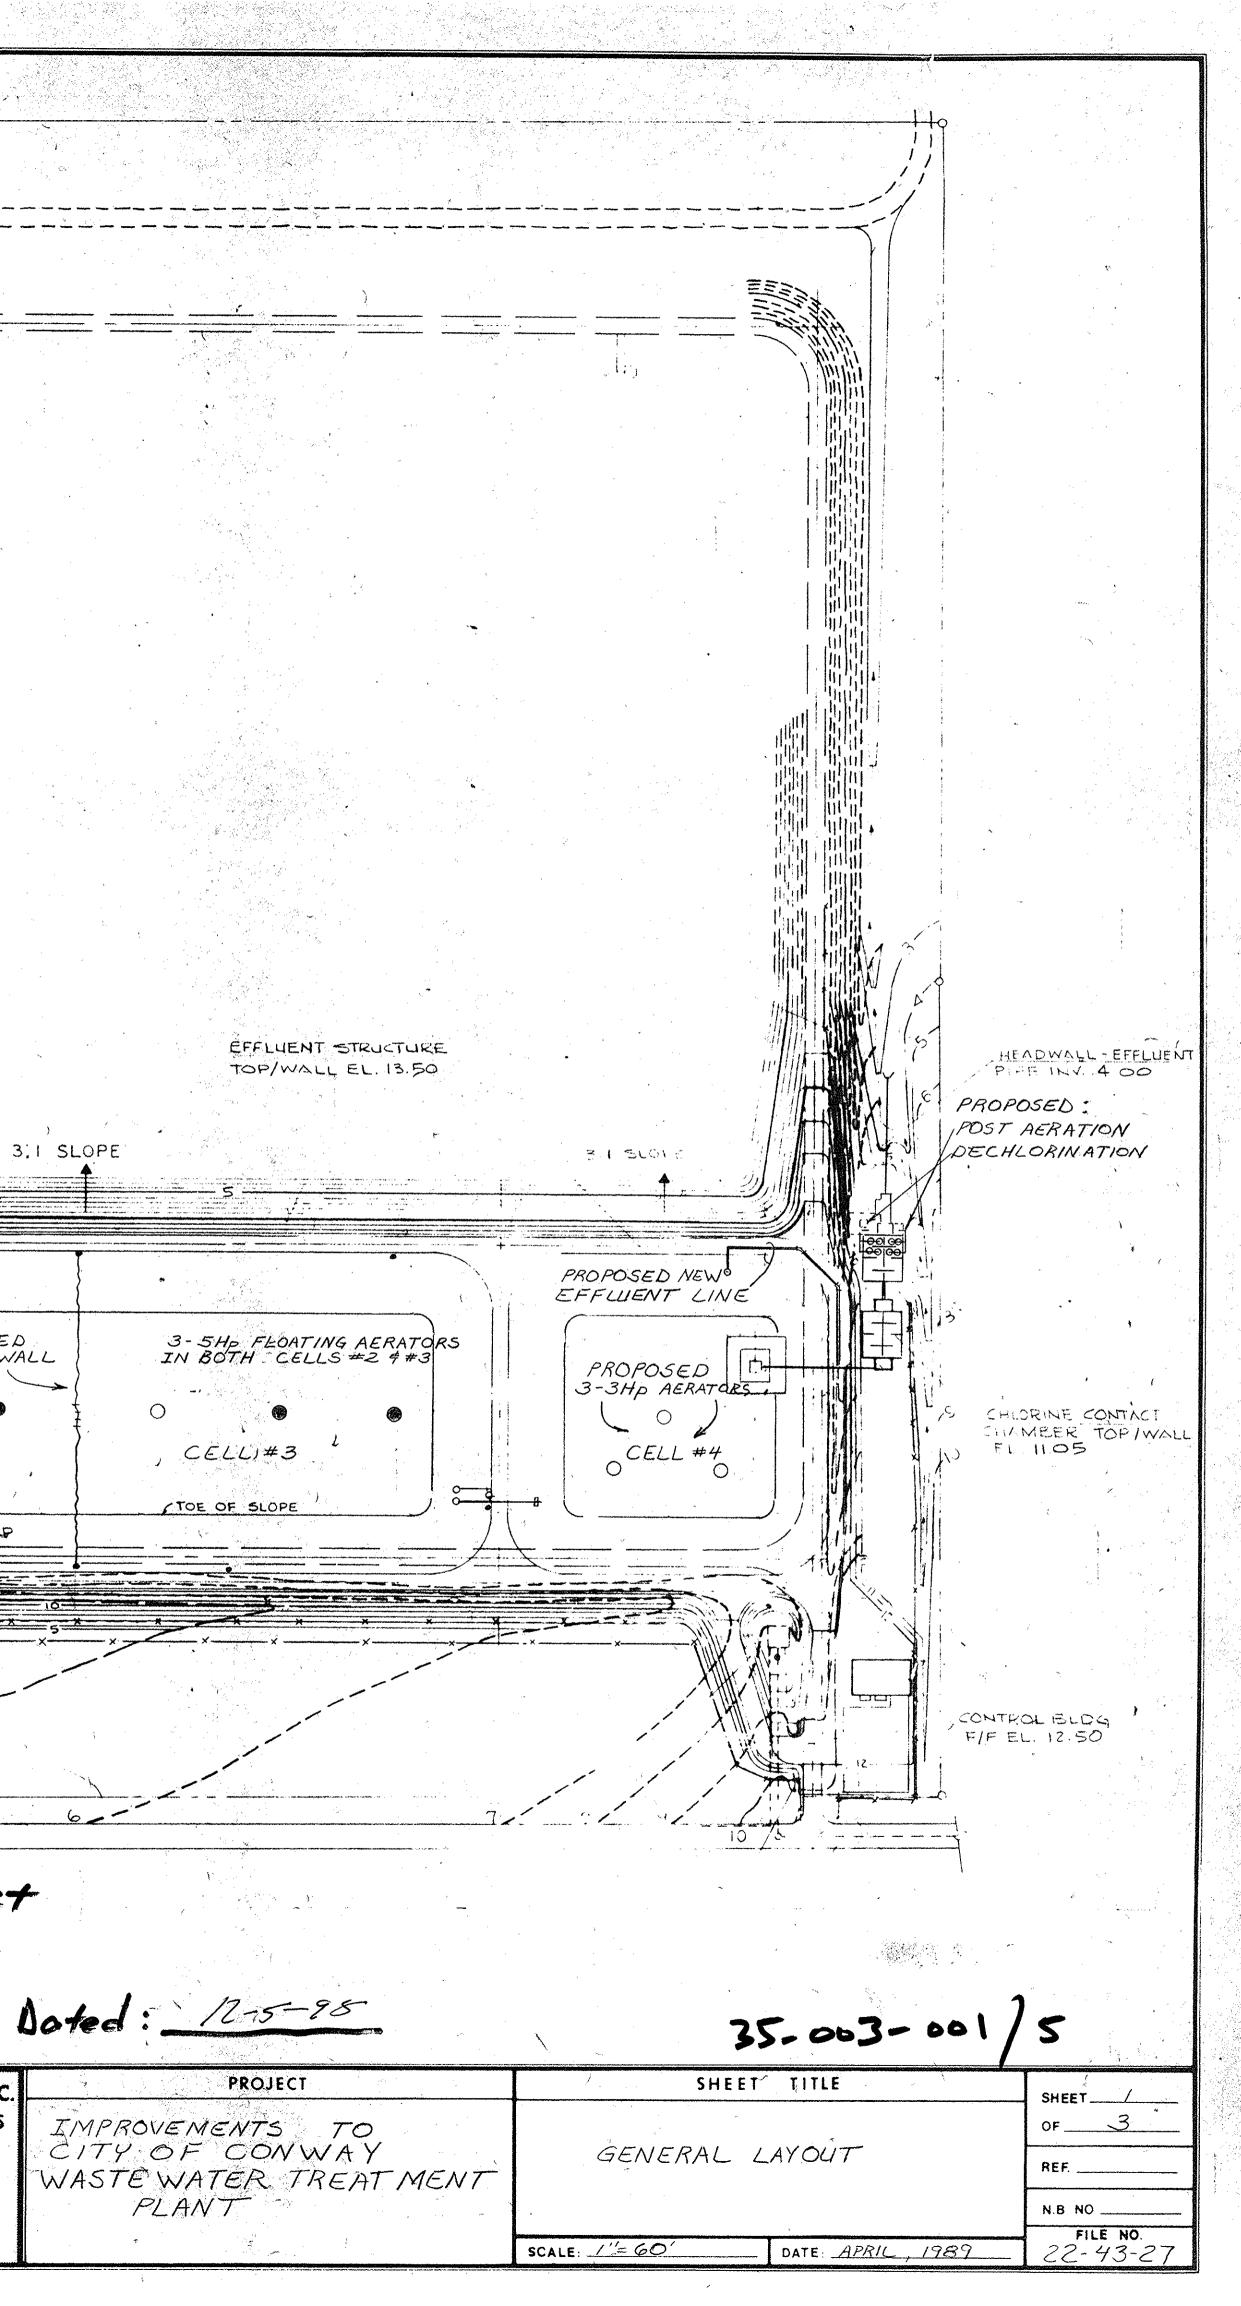

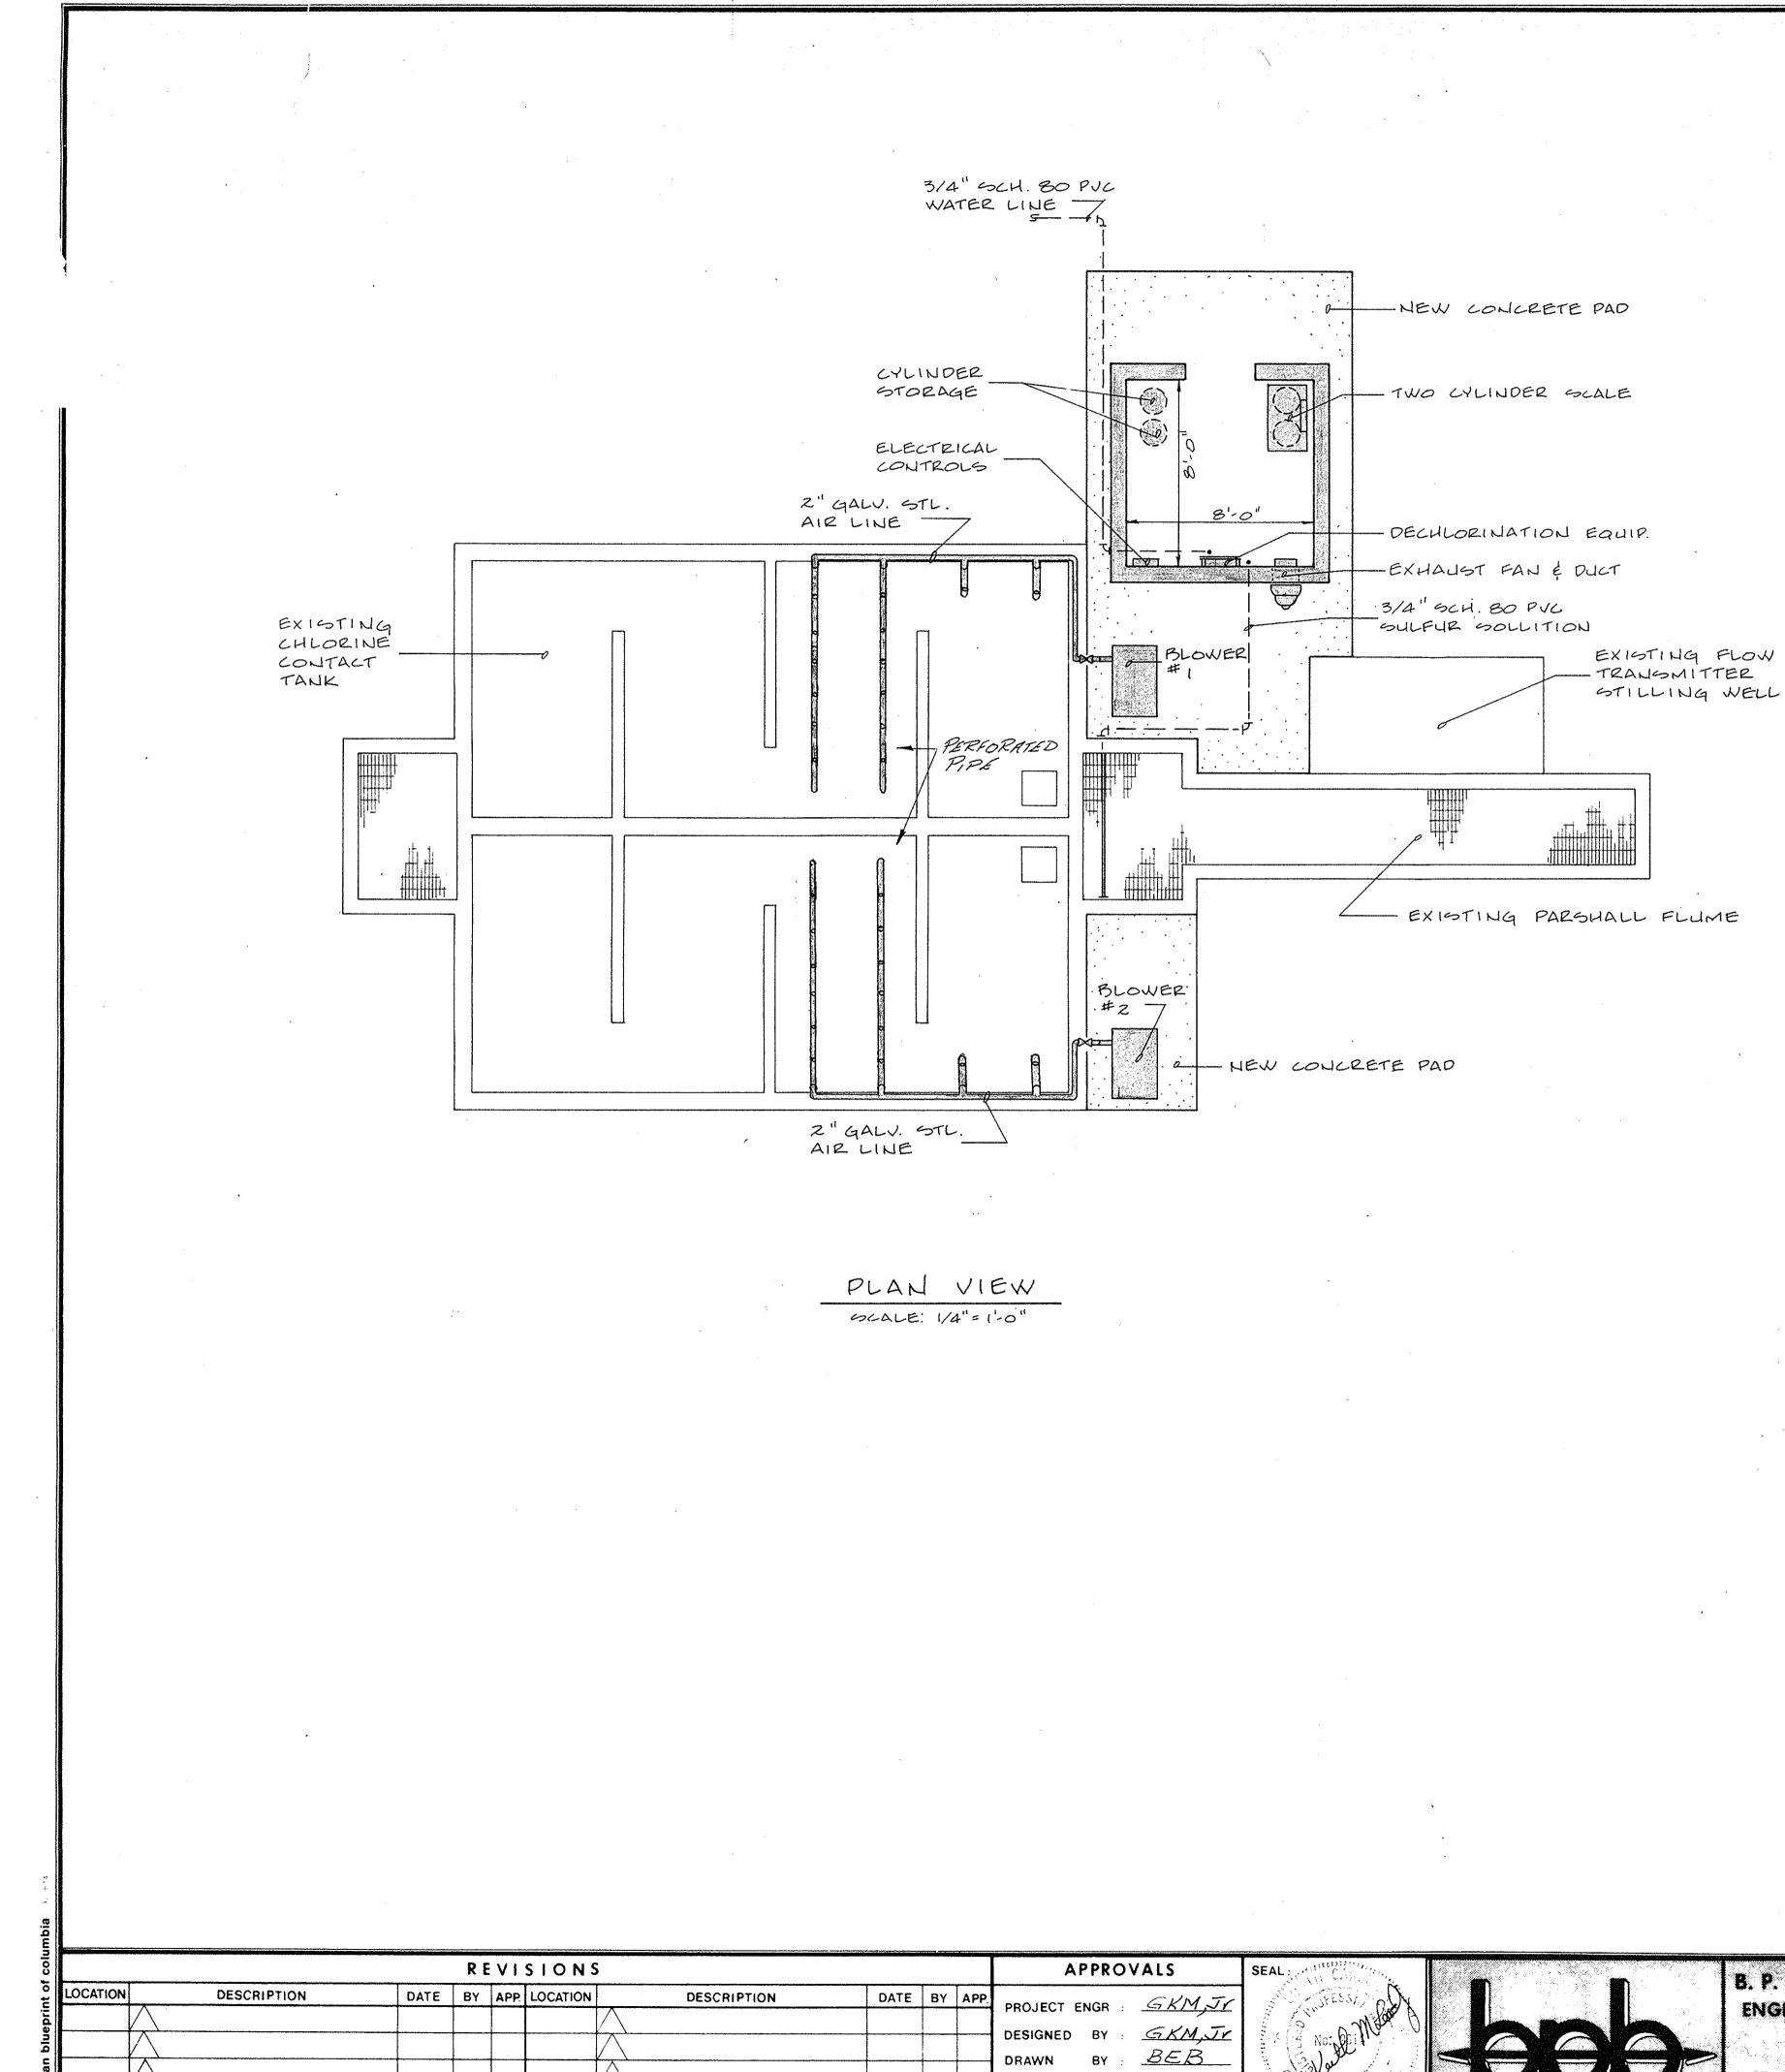

RTH


CHECKED


BY

APPROVED BY : JMC


B. P. BARBER & ASSOCIATES, INC. ENGINEERS + SURVEYORS + PLANNERS 2611 FOREST DRIVE


P.O. BOX 1116 COLUMBIA, S. C. 29202 803 --- 254-4400

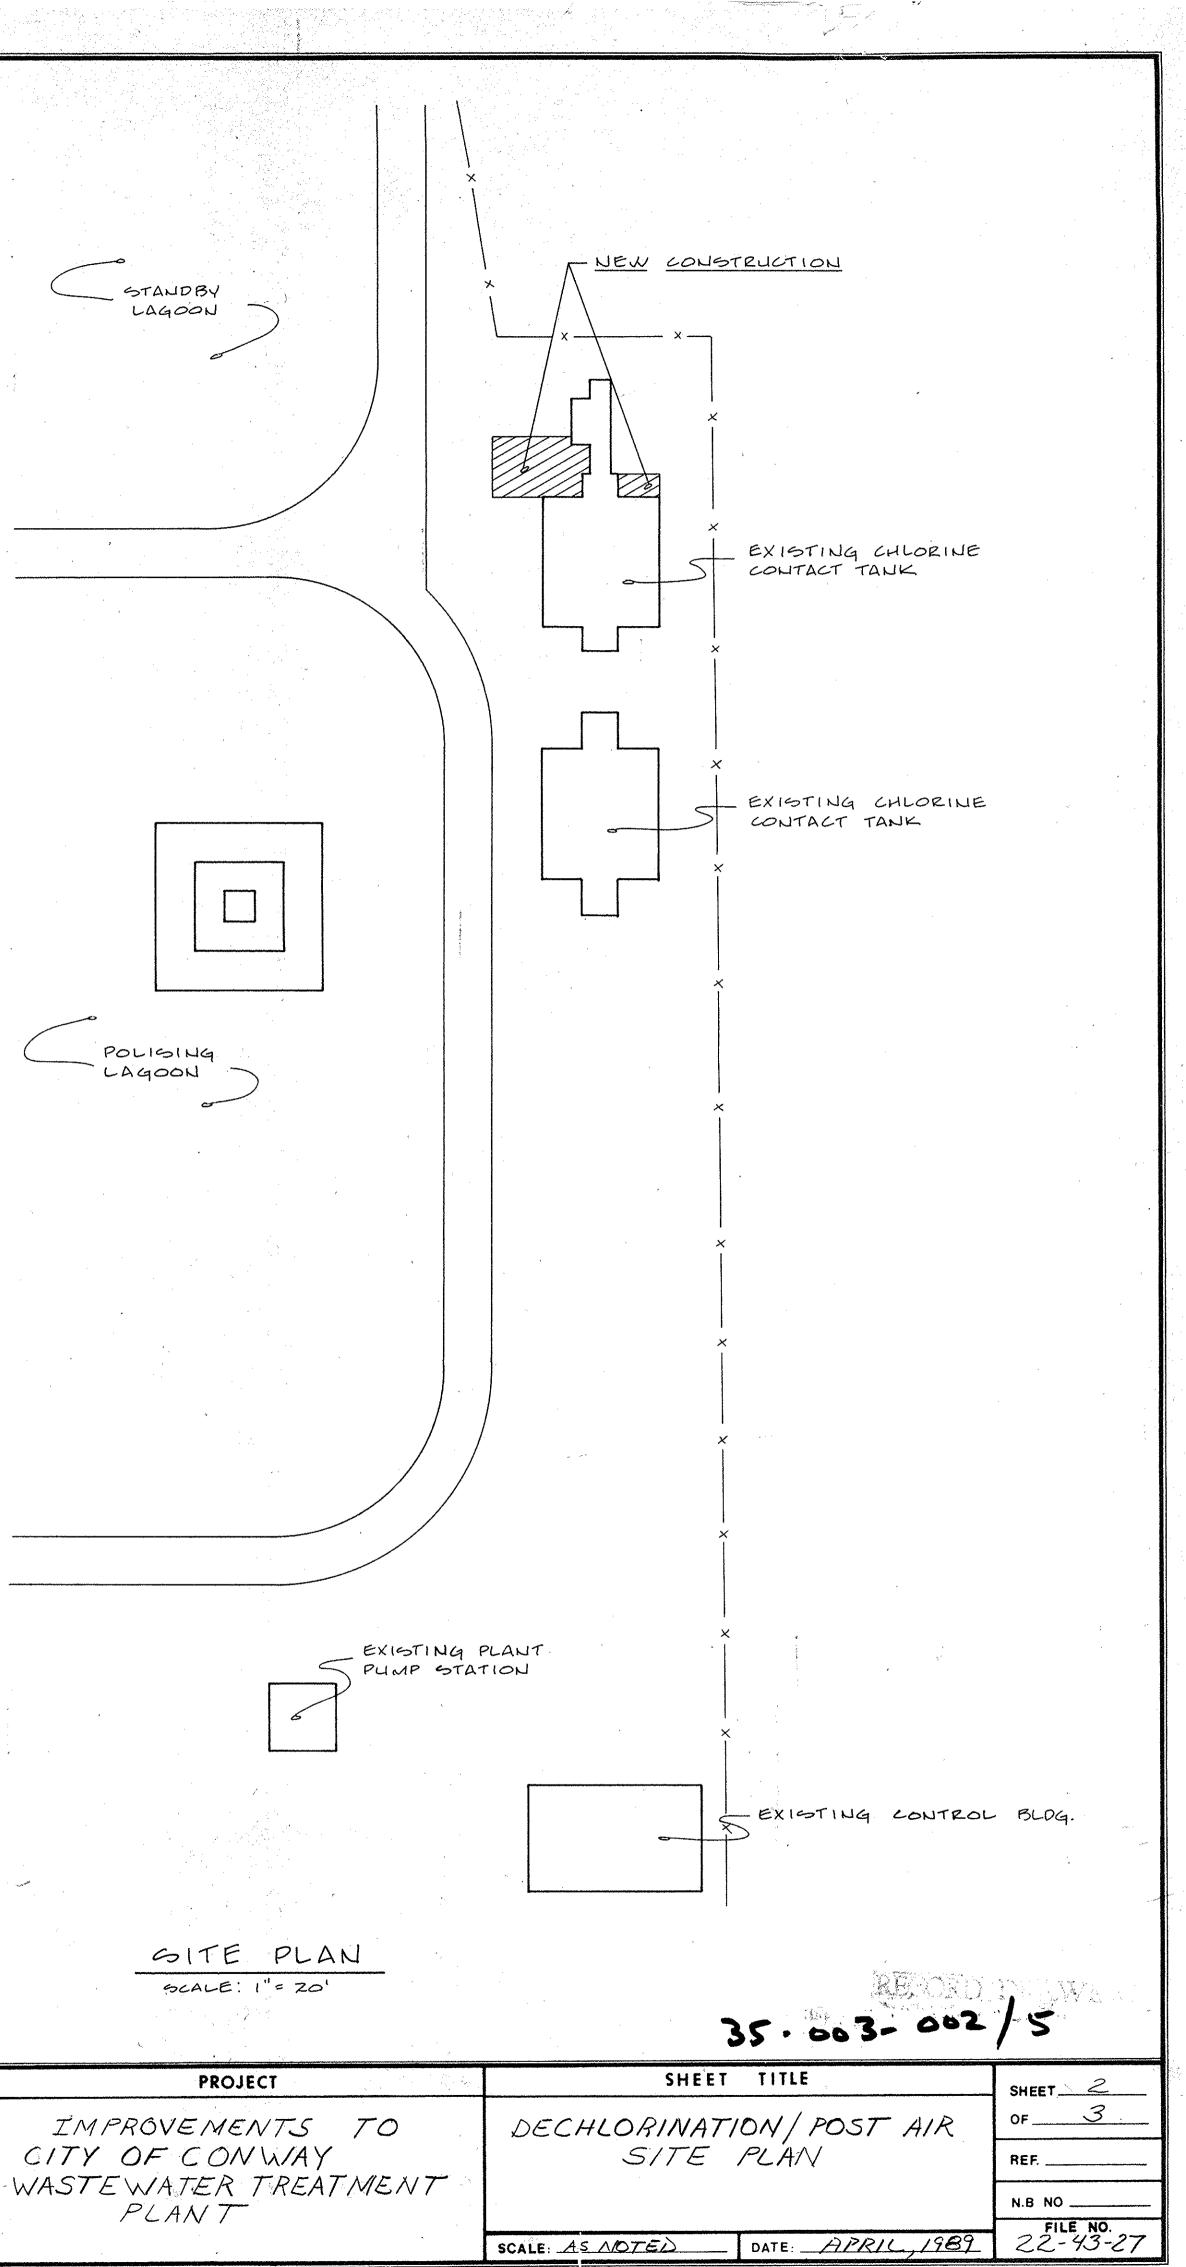

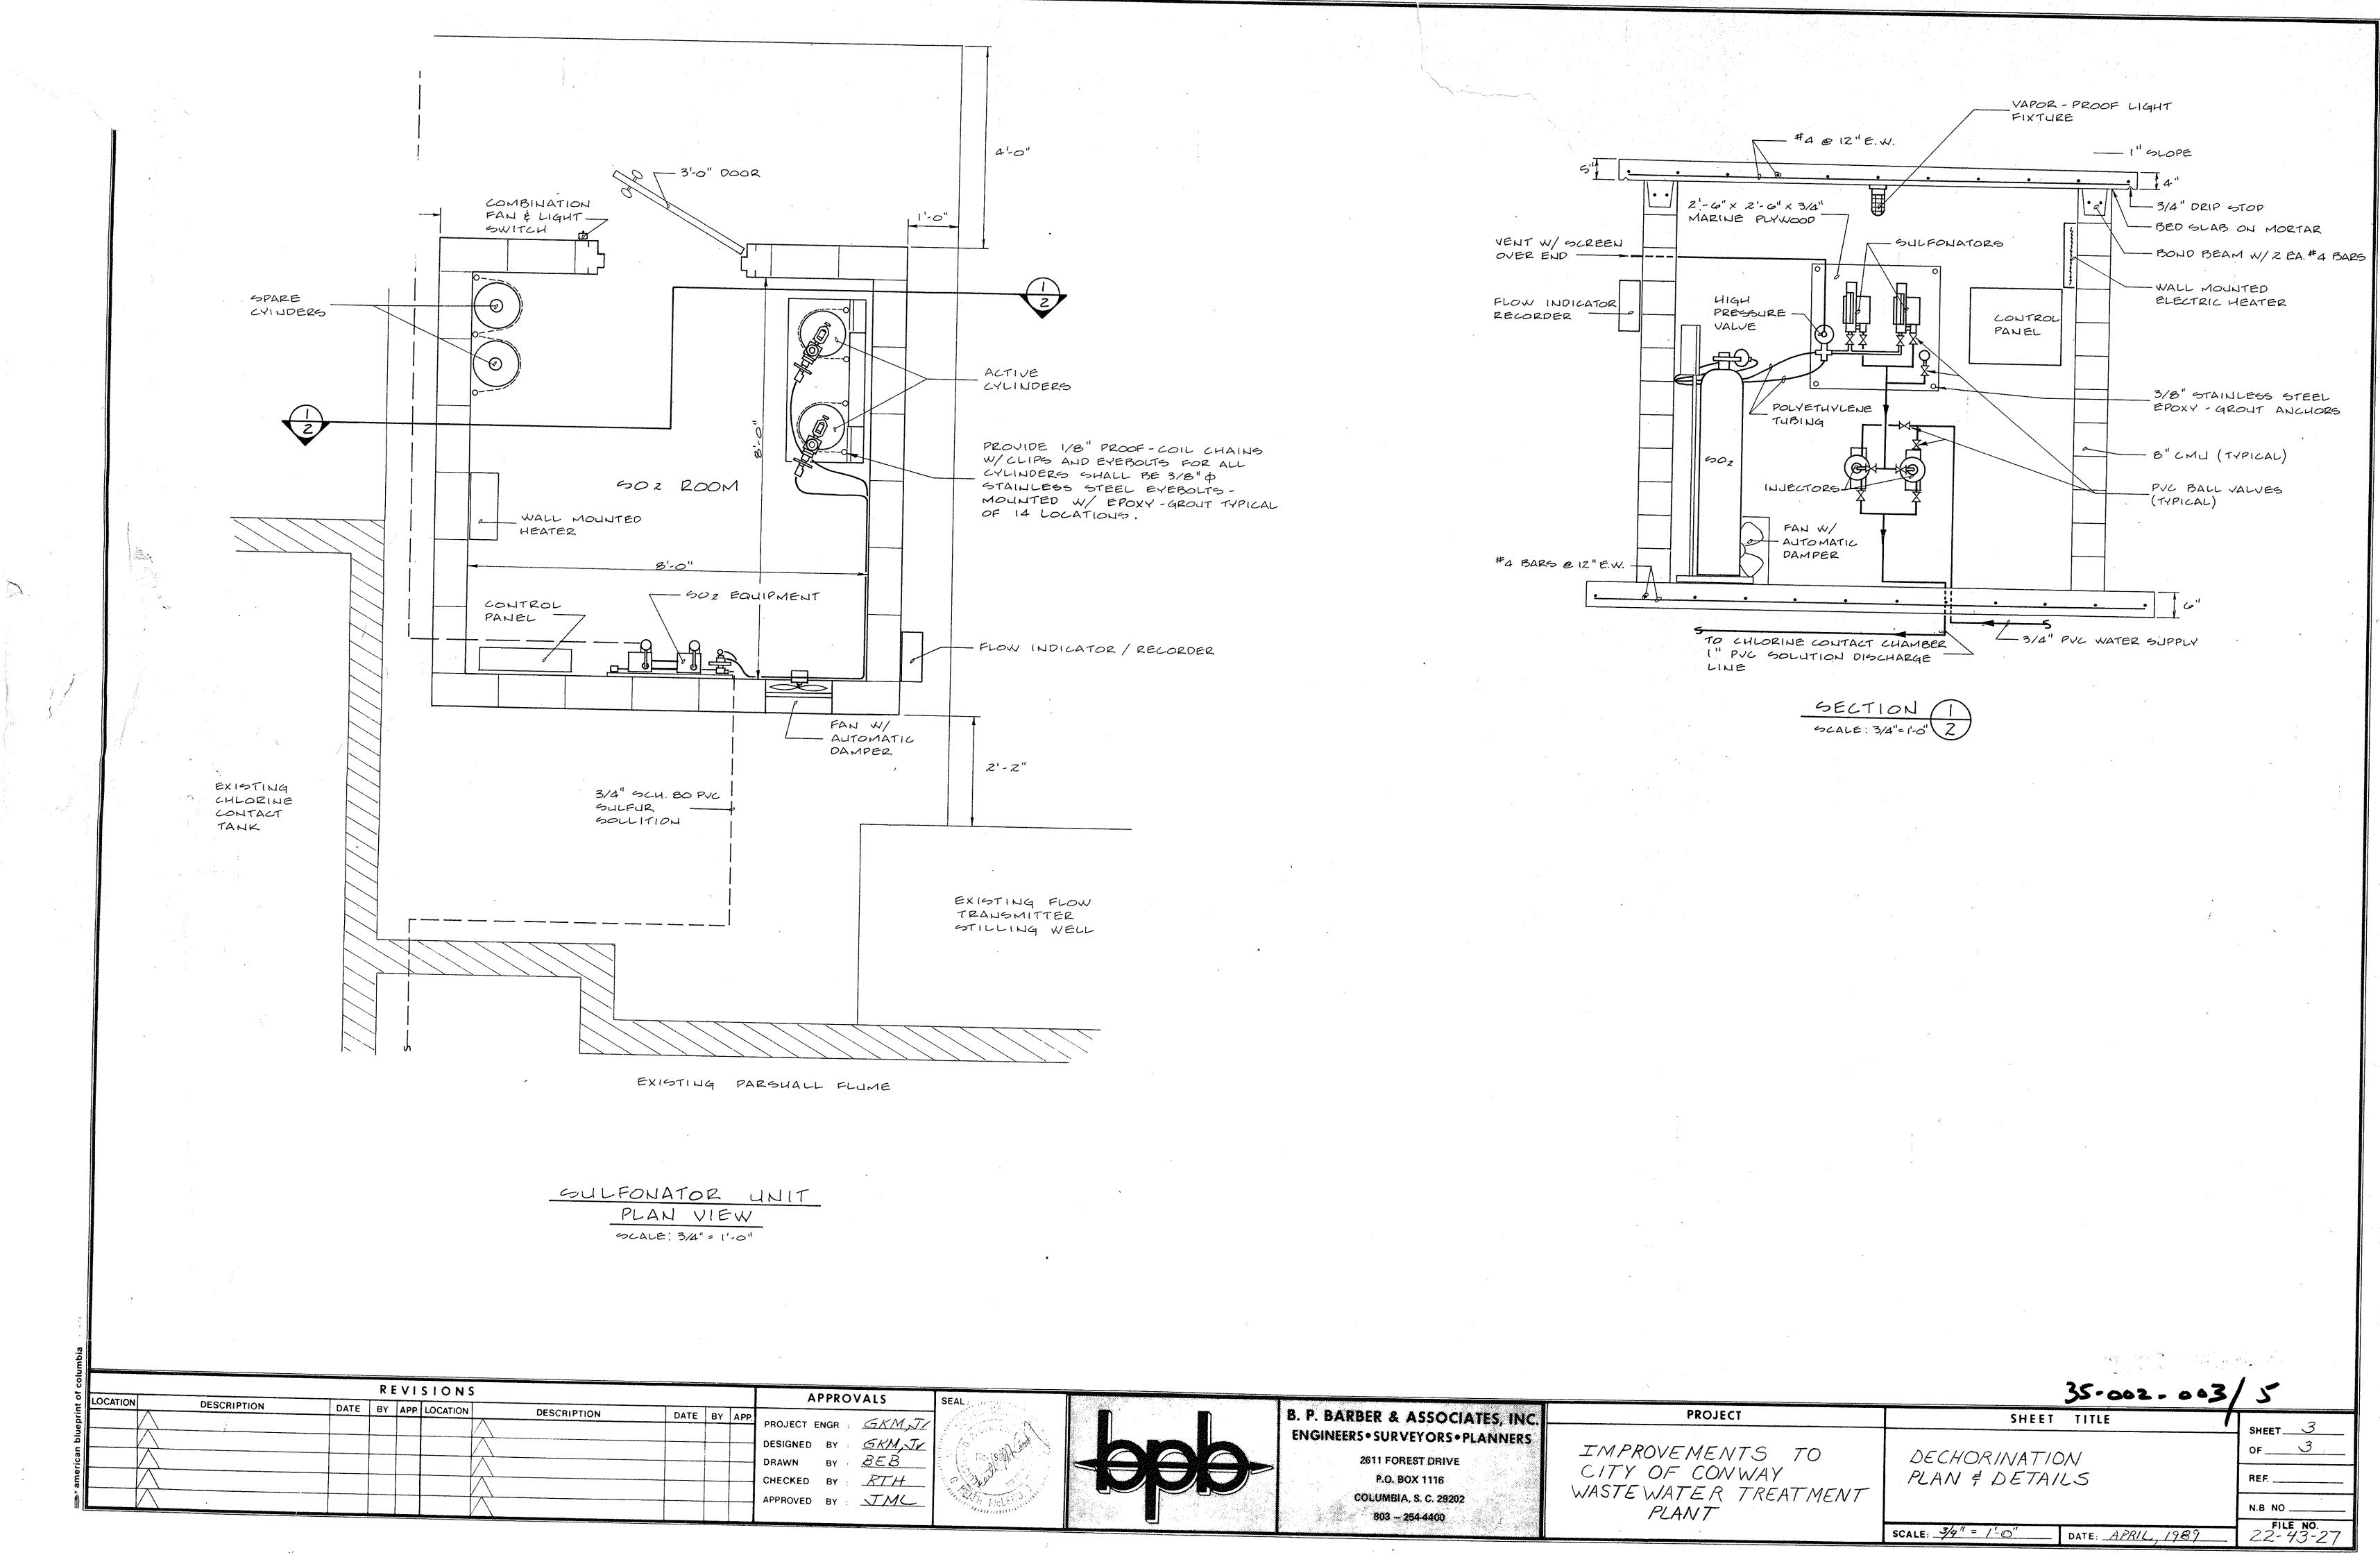

AHCHOR BOLTS 4- 76" × 91/2" LOHG HOOK BOLT, PROJ. 21/2" NUTE HASHER & MANHOLE 10:0' A. BOE. TS C PRAIH FOR OPEHING FOR MECH. BAR SCREEN BAR SCREEN 4' NAHHOLE A BOLTS & ----- SI L BOLTS IHV. 12.78' EDGE OF IZ" HALL 18"D. T. P. IHFLUEHT 6'-114" INV. EL. 12.75' A.BOLT FOR MECH. BAR SCREEN 12211 12211 12211 NOT TO BCALE 18" WALL SLEEVE 18" WALL SLEEVE أتنكب بتكين بتكين كبر بعصد بسيا تكيد شدائ RECESSED 7" #4 e 12"E, W TYP. ------THY. ELEV. 11.50' -#4012'E.W WATERSTOP TYP. 21-10 7-38" 10'-014 10" 2-9% 37-1" 31-836" 31-4" ~ 5"x 1/4" PLATE W/ANCHOR 6"O.C. a and in and the -MAHUAL BAR SCREEM 22"22"x"/4" W/AHCHOES 6"0.C. A Charles A city of a find a find SECTION - CENTER CUT MANUAL BAR SCREEN 1/= 1-0'

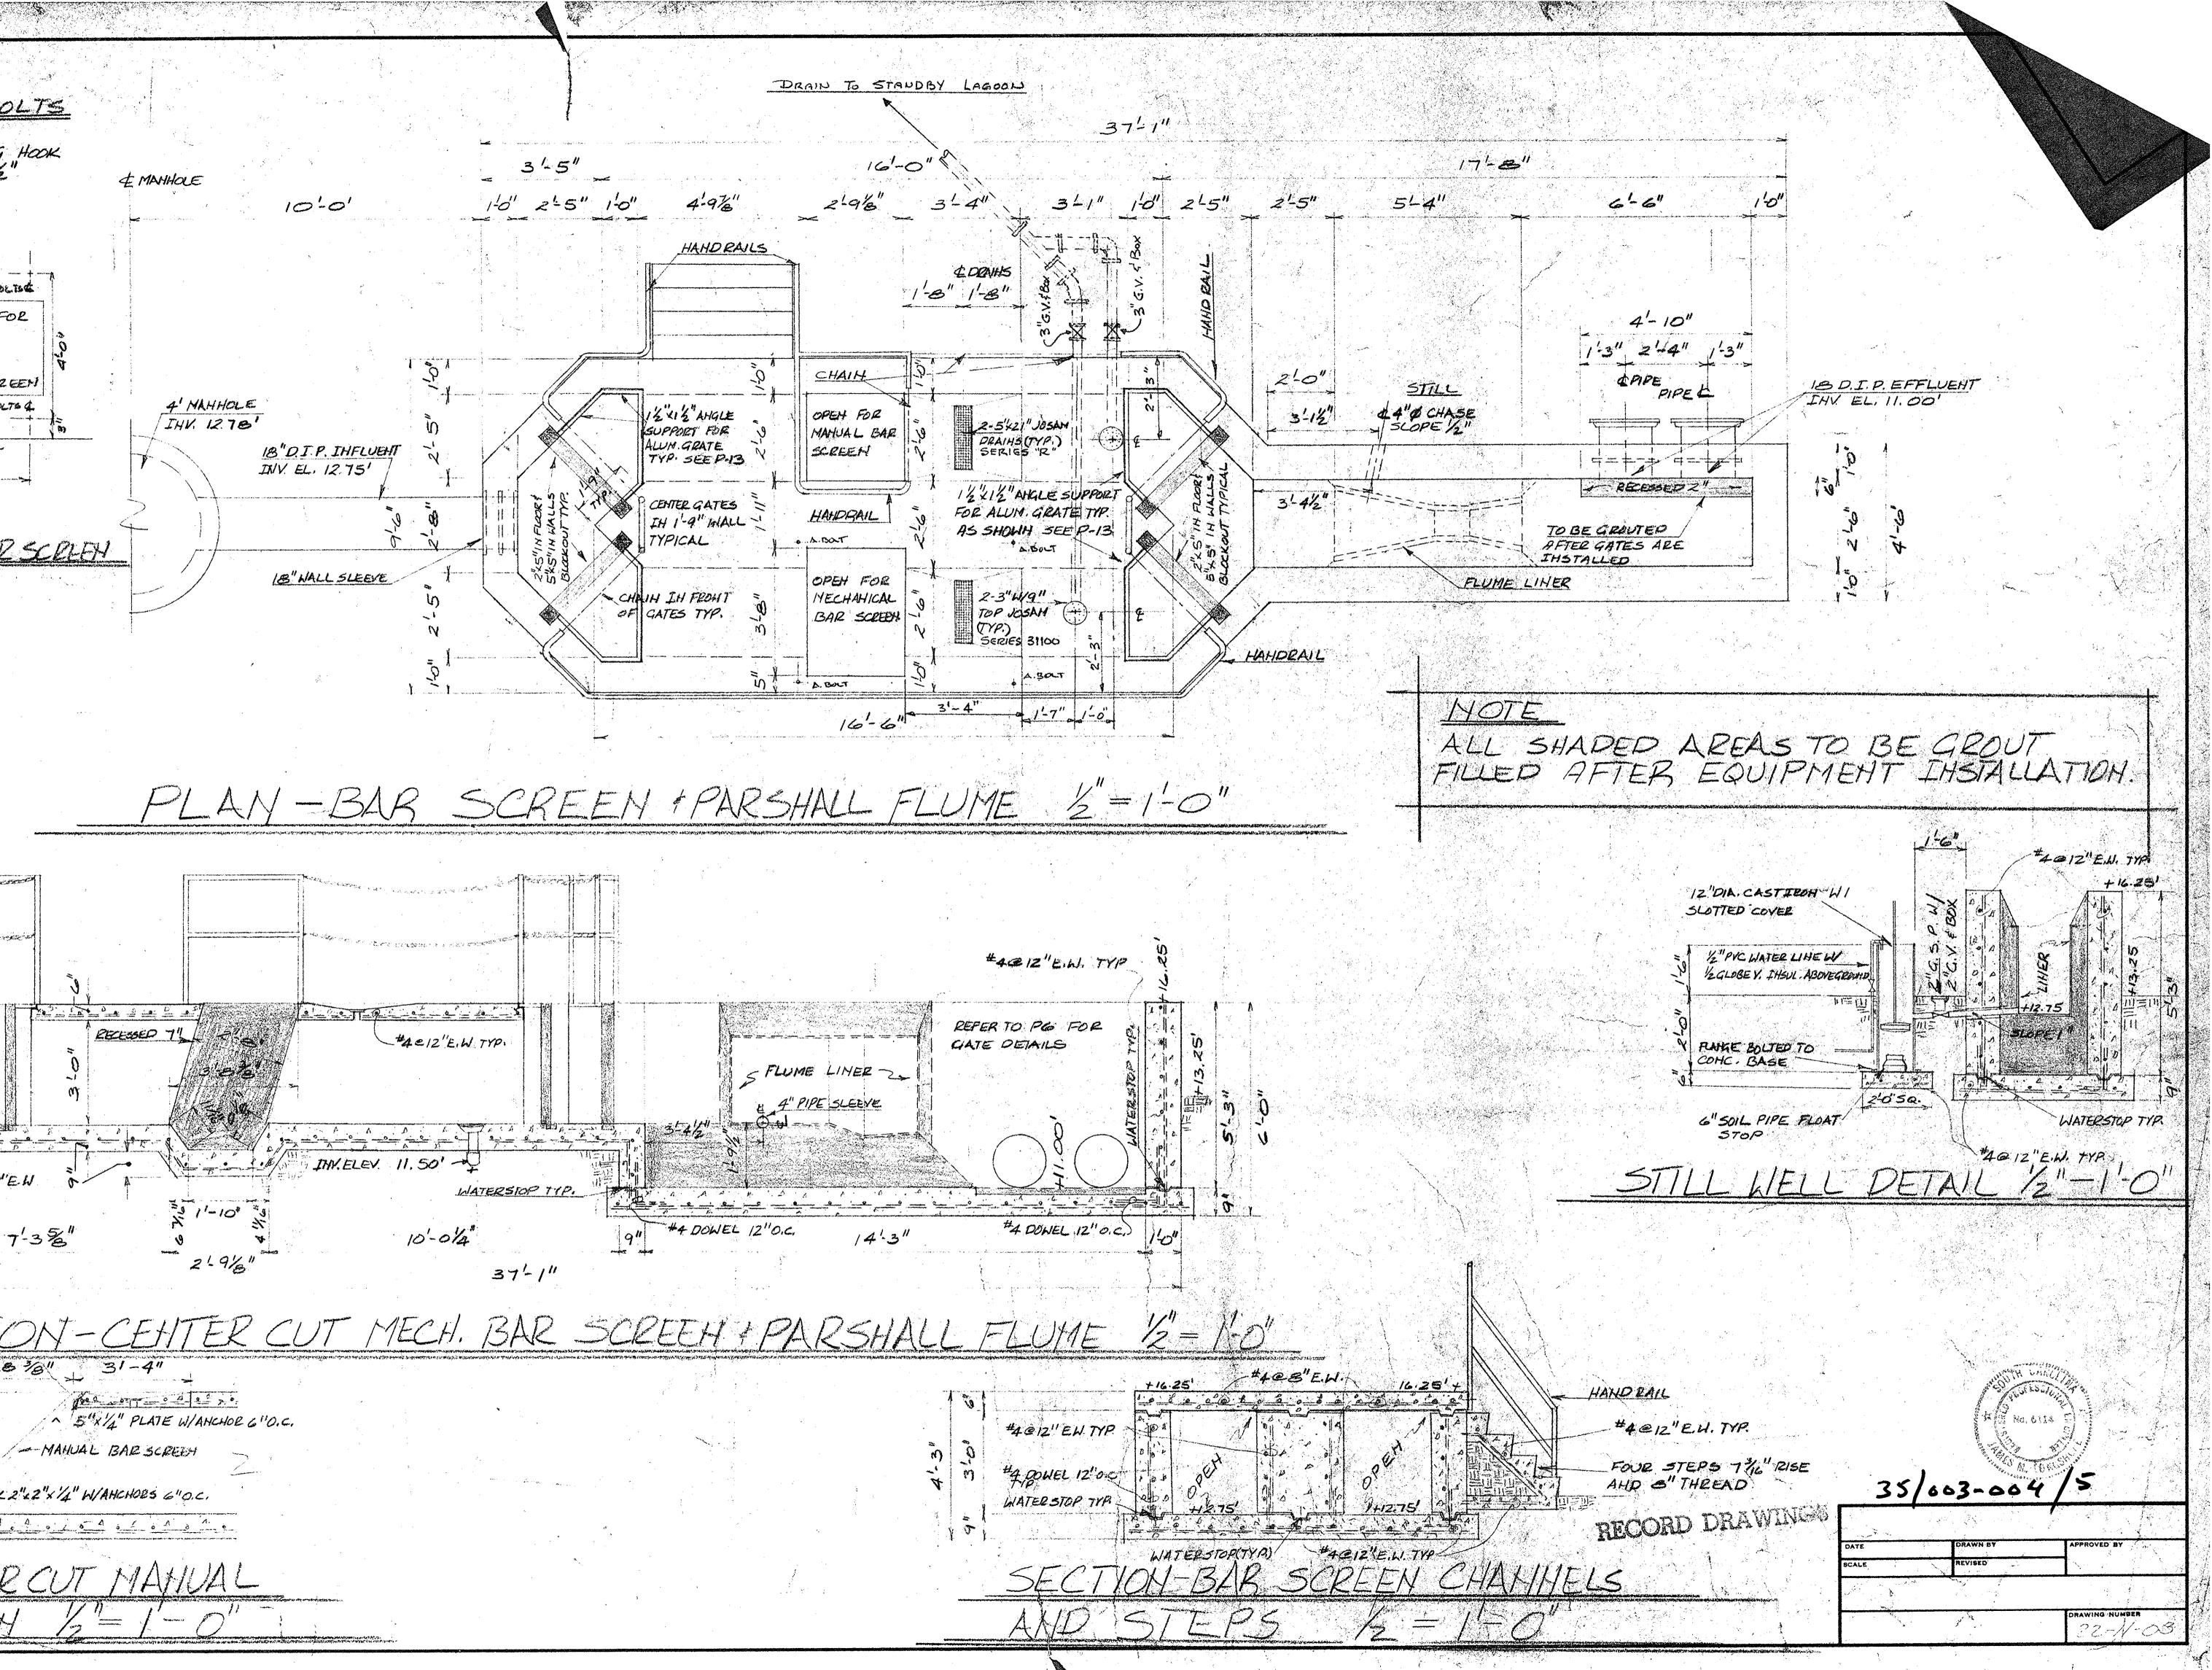

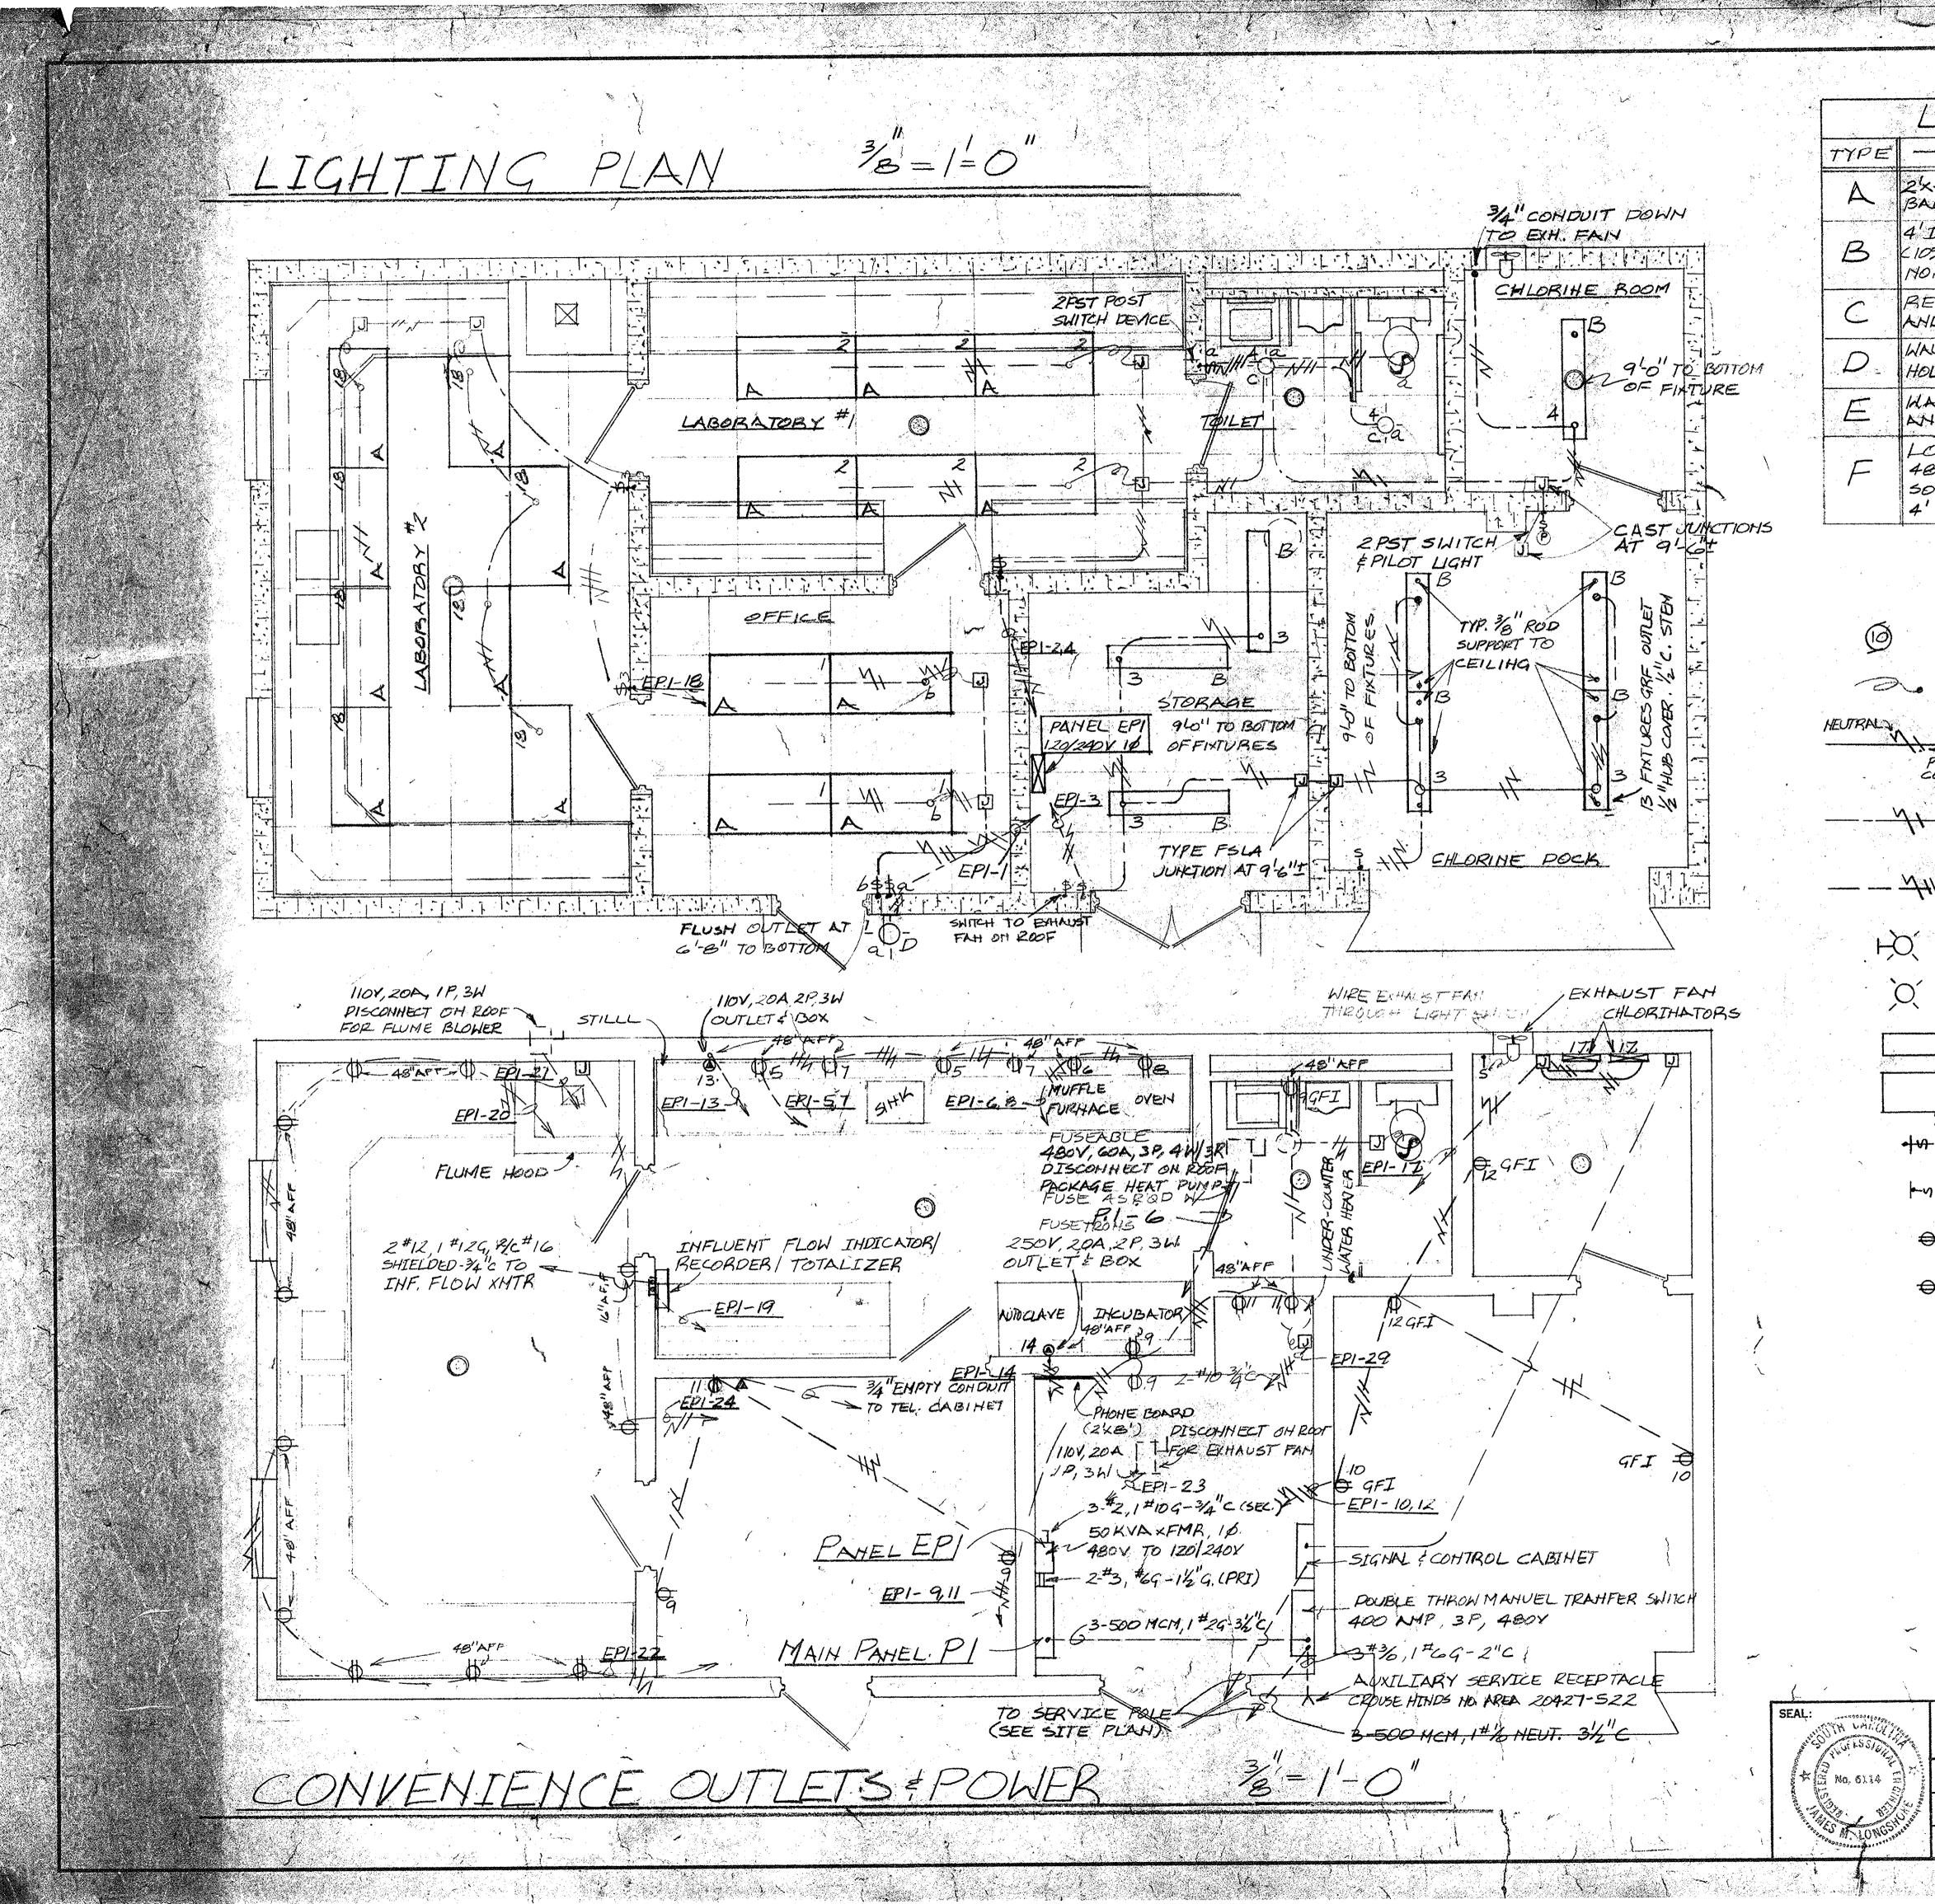

LIGHT FIXTURE SCHEDULE -DESCRIPTION. 2'x4' FLUORESCENT TROFFER WITH PRISMATIC ACRYLIC LEHS, 1202 BALLAST, 4-40 WATT FAOT 12/CW LAMPS, SYLVANIA NO, KFW-BD-4404 OR EQUAL 4'INDUSTRIAL TYPE FLUORESCENT FIXTURE WITH SLOTTED REFLECTORS (10% UPLIGHT) 120Y BALLAST, 2-40 WATT F40T12/CW LAMPS SYLYAHIA NO, PVID-2404 OR EQUAL RECESSED INCAMPESCENT FIXTURE WITH WHITE ALBALITE GLASS LENS AND 150 WATT N-21 LAMP LIGHTOLIER NO. 7303 OR EQUAL WALL NOUNTED OUTDOOR INCANDESCENT WITH 100 WATT A19 LAMP. HOLOPHANE HO. 400 OR EQUAL WALL MOUNTED VAPORTIGHT INCAMPESCENT FIXTURE WITH GLOBE AND '30" ANGLE REFLECTOR, 150 WATT A-21 LAMP CROUSE HINDS NO. YXHBF 25 CRA OR BO. LOW PRESSURE SODIUM AREA LUMINAIRE WITH 135 WATT LAMP. 4001, 10 BALLAST AND PHOTO-ELEC: CONTROL- MORELCO NO. 31665, WITH SOL 135 LAMP OR EQUAL, MOUNTED ON 30' TAPED ALUMINUM POLE WITH 4' MOUNTING MRM - HAPCO NO. 21-582 OR EQUAL DRAWING LEGEND & SYMBOLS HOTOR LOCATION HORSEPOWER INDICATED CIRCUIT TERMITHAL CONNECTION IN FLEXIBLE LIQUID-TIGHT METAL COHPUIT, MINIMUM 34" SIZE RACEWAY RUH EXPOSED AT CEILTHGE AND HALLS EXCEPT AS HOTED, RIGID STEEL CONDUIT, 34" UNLESS OTHERWISE HOTED NO. 12 CONDUCTORS OR AS INDICATED. CONDUCTOR RACEWAY RUN CONCEALED ABOVE CEILING CONSTRUCTIONS AND TURHED DOWN CONCEALED IN WALL OR PARTITIONS, RIGID STEEL CONDUIT 32" MIN. SIZE HO. 12 CONDUCTORS OR NO INDICATED. RACEWAY UNDERGROUND, OR UNDER FLOOR SLAB, CON-CEALED, MINIMUM SIZE 34" RIGID STEEL CONDUIT, HO. 12 CONDUCTORS EXCEPT AS HOTED. INCANDESCENT TYPE LIGHTING FIXTURE, WALL MOUNTED OVER FLUSH OUTLET; HEIGHT IHDICATED INCANDESCENT TYPE LIGHTING FIXTURE ON CEILING DUTLET FLUORESCENT TYPE LIGHTING FIXTURE, CEILING SURFACE LETC.) MOUNTED OR SUSPENED AS NOTED. FLUORESCENT TYPE LIGHTING FIXTURE CEILING RECESSED FLEXIBLE METAL CONDUIT 34"MIN. TO OUTLET ABOVE CEILING. FLUSH MOUNTED SWITCH WIRENG DEVICE 20A, 1P, 1204, MOUNTING HEIGHT 48" OR AS HOTED. WALL SURFACE MOUNTED SWITCH DEVICE, CAST SURFACE OUTLET, AT 48" OR AS HOTED. FLUSH WALL OUTLET AT 16" EXCEPT AS HOTED, DUPLEX 2-WIRE 3-WIRE GROUNDING RECEPTACLE DEVICE, 154 AT 1204. DUPLEX RECEPTACLE, GROUND FAULT INTERBUPTER TYPEN **€**GFI AS SPECIFIED. RECORD DRAWINGS 35-003-005/5 B. P. BARBER & ASSOCIATES, INC CITY, OF COHWAY, S.C. SHEET

ENGINEERS EILASTE FAGILITIES IMPROVEMENTS COLUMBIA, S. C. OF 4 SHEETS REVISIONS DÉSIGNED_ CONTROL BUILDING' PLANDSECTIONS NOTEBOOK NO. TRACED SCALE: NOTED DATE CHECKED_