
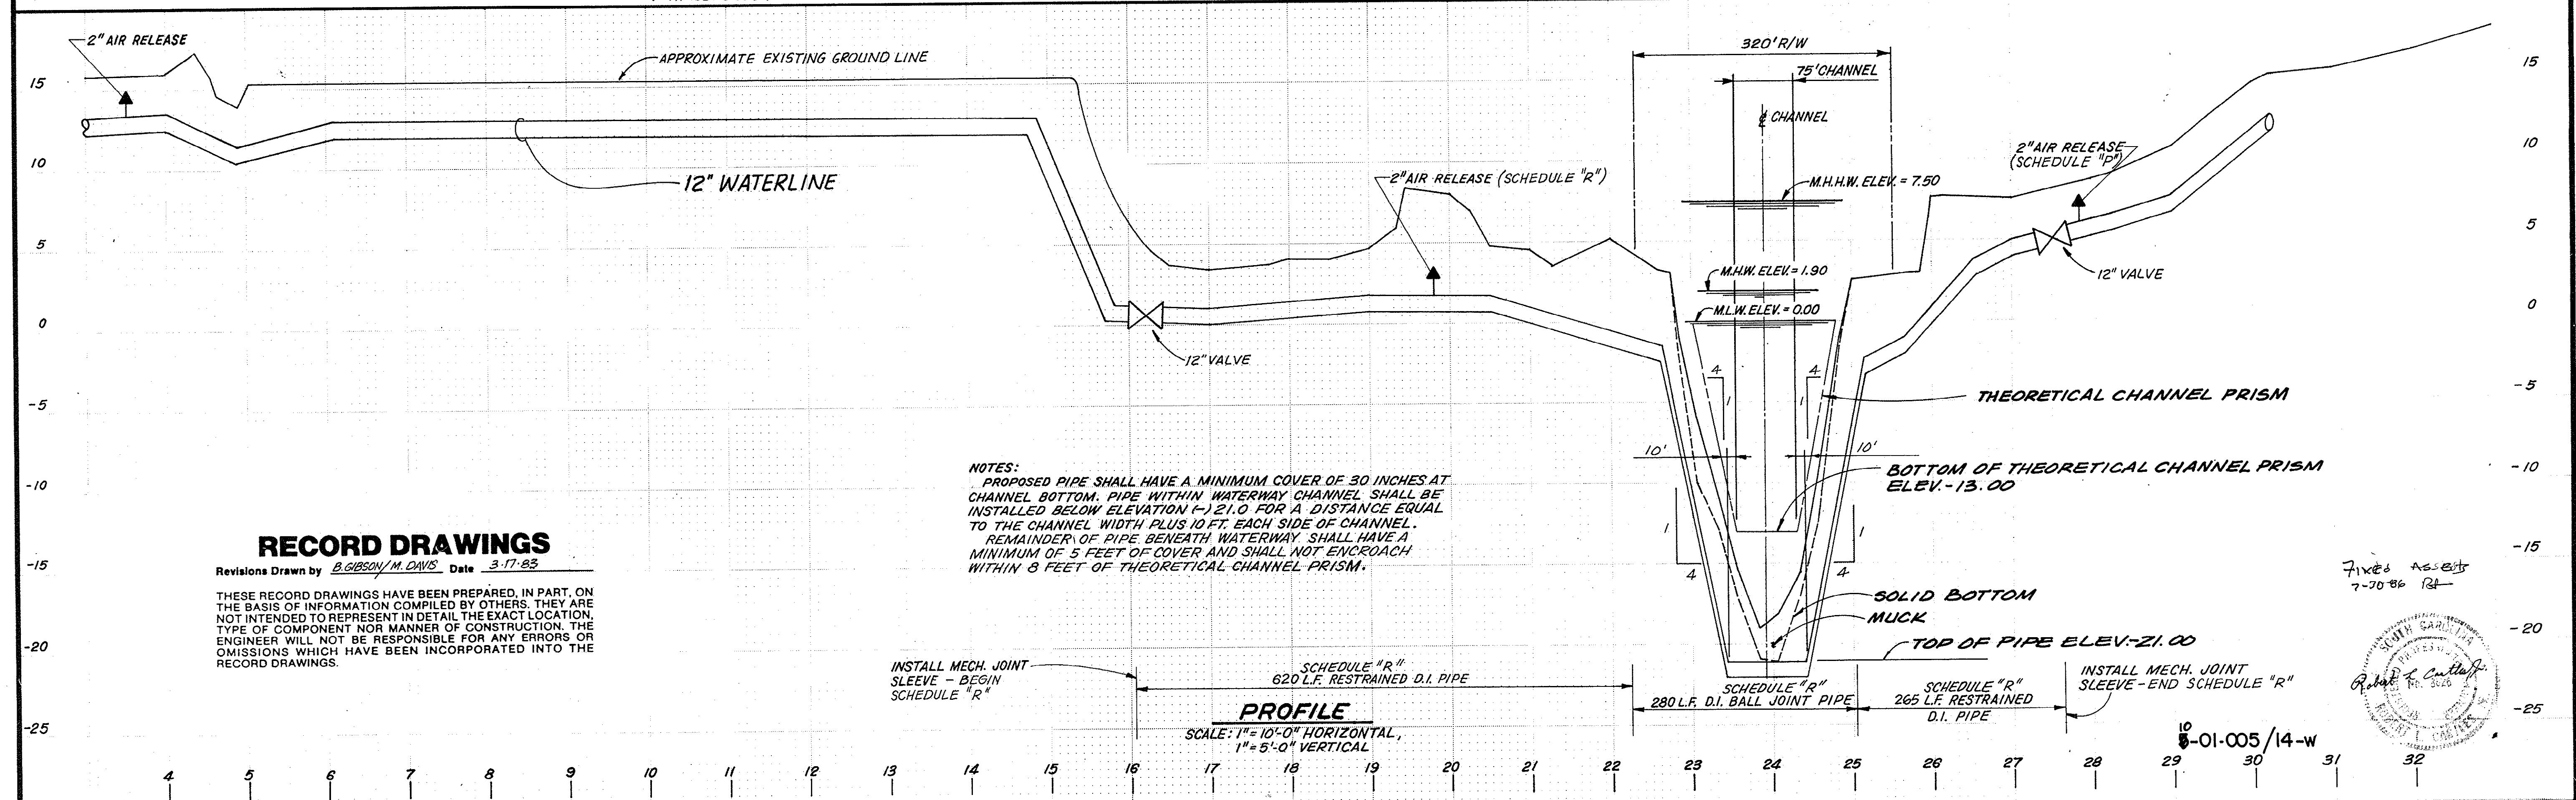


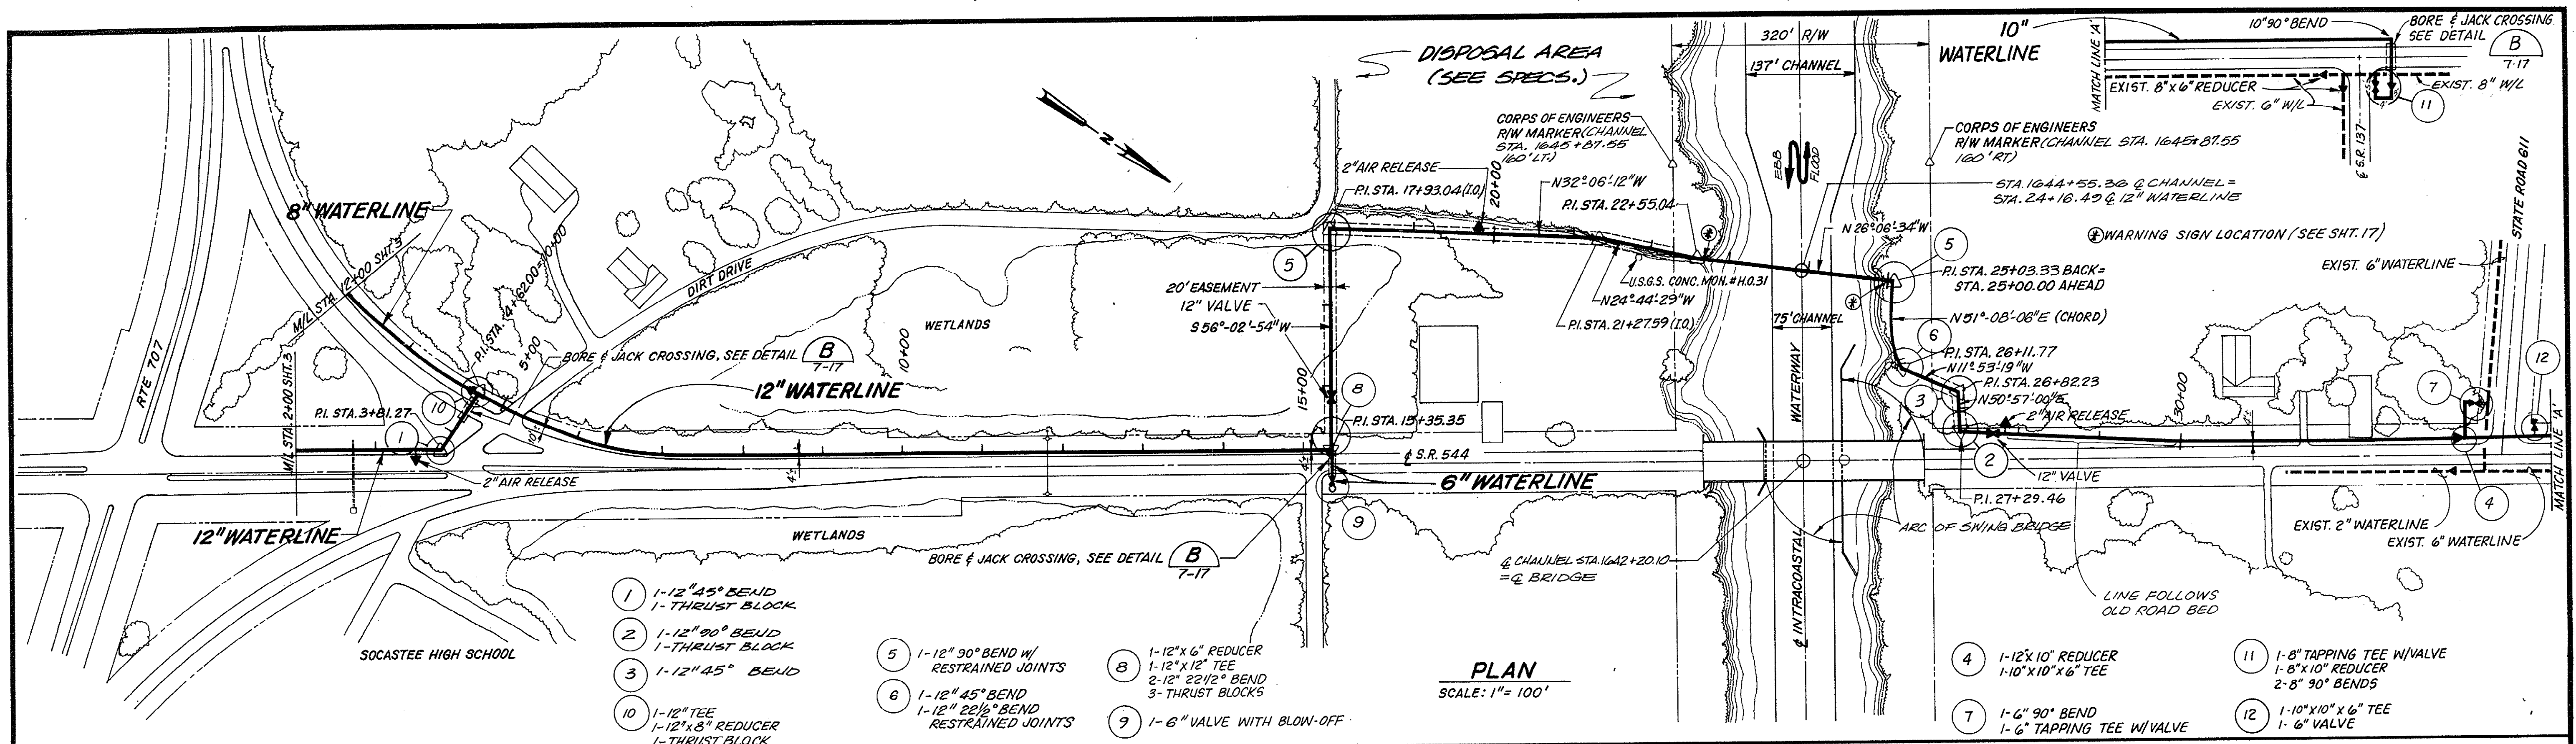

RECORD DRAWINGS

Revisions Drawn by B. GIBSON/M. DAVIS Date 3-17-83

THESE RECORD DRAWINGS HAVE BEEN PREPARED, IN PART, ON THE BASIS OF INFORMATION COMPILED BY OTHERS. THEY ARE NOT INTENDED TO REPRESENT IN DETAIL THE EXACT LOCATION, TYPE OF COMPONENT NOR MANNER OF CONSTRUCTION. THE ENGINEER WILL NOT BE RESPONSIBLE FOR ANY ERRORS OR OMISSIONS WHICH HAVE BEEN INCORPORATED INTO THE RECORD DRAWINGS.

INSTALL MECH. JOINT SLEEVE - BEGIN SCHEDULE "R"

PROFILE

SCALE: 1" = 10'-0" HORIZONTAL, 1" = 5'-0" VERTICAL

SOCASTEE WATER SYSTEM EXTENSION

GRAND STRAND
WATER & SEWER AUTHORITY
CONWAY, S.C.

**12" WATERLINE
ALONG STATE ROAD 544
& INTRACOASTAL WATERWAY CROSSING**

SHEET 7

OF 18

DATE 6-81

DWG. NO. CA68522.91