

THESE DOCUMENTS AND PLANS ARE AN INSTRUMENT OF SERVICE AND THE SOLE PROPERTY OF VENTURE ENGINEERING, INC. AND ARE SUBJECT TO COPYRIGHT LAW.

MICHELLE COX
D.B. 1838, PG. 335
P.B. 45, PG. 6

DANNY M. SMITH
D.B. 1866, PG. 335
P.B. 45, PG. 6

JOHN EDWARD
BATTEN III et al
D.B. 627, PG. 513
P.B. 57, PG. 2
P.B. 51, PG. 26A

OWNER:
SOCASTEE HARVEST II, L.L.C.
ENGINEER:
VENTURE ENGINEERING, INC.
742 HIGHWAY 501
CONWAY, SC
347-5851
SURVEYOR:
JONES GODFREY & ASSOCIATES
FLORENCE, SC
662-4442
CONTRACTOR:
W&S UNDERGROUND, INC.
FLORENCE, SC
395-0105


1455 L.F. - 8" WATER MAIN (C900, CL100)
845 L.F. - 6" WATER MAIN (C900, CL100)
410 L.F. - 4" WATER MAIN (C900, CL100)
19 DOUBLE WATER SERVICES
14 SINGLE WATER SERVICES

TOTAL WATER CONSTRUCTION COST:
\$50,957.50

I HEREBY CERTIFY THAT THE WATER AND/OR SEWER UTILITIES AS SHOWN
HAVE BEEN INSTALLED IN ACCORDANCE WITH THE APPROVED CONSTRUCTION
DRAWINGS AND SPECIFICATIONS AND ARE, TO THE BEST OF MY KNOWLEDGE
AS SHOWN ON THESE PLANS.

ENGINEER: SC 15,319 DATE: 1/5/99
REGISTRATION NUMBER

WATER RECORD DRAWINGS

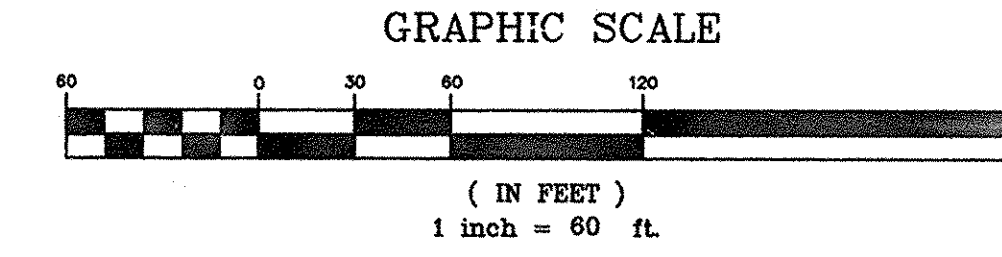


VICINITY MAP
SCALE 1" = 2 miles

VENTURE ENGINEERING, INC. / 742 HIGHWAY 501 E. / CONWAY, S.C. 29526 / (803) 347-5851 / CIVIL ENGINEERING / LAND PLANNING / LANDSCAPE ARCHITECTURE

AMBERFIELD SUBD. PHASE 1
HORRY COUNTY, SOUTH CAROLINA
PREPARED FOR
SOCASTEE HARVEST II, L.L.C.

NO.	DATE	DESCRIPTION	BY	CHECKED BY	DATE	JOB NO.
1						97025
2						
3						
DATE: NOVEMBER 2, 1998
DRAWN BY: JBG
CHECKED BY: WMJ
JOB NO.: 97025
SHEET OF

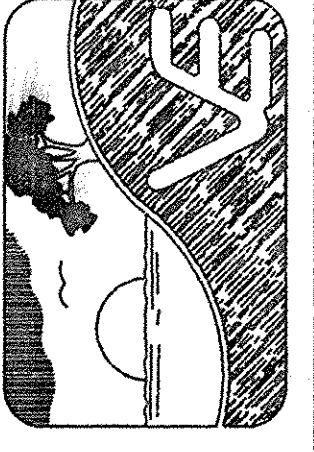

MAGNETIC



TOTAL SEWER CONSTRUCTION COST:
\$ 225,234.20

DANNY M. SMITH
D.B. 1268, PG. 303
P.B. 483, PG. 482
P.B. 62, PG. 42


VENTURE ENGINEERING, INC. / 742 HIGHWAY 501 E. / CONWAY, S.C. 29526 / (803) 347-5851 / CIVIL ENGINEERING / LAND PLANNING / LANDSCAPE ARCHITECTURE

16-068-00213 W/S

JOHN EDWARD
BATTEN III et al
D.B. 627, PG. 513
P.B. 57, PG. 2
P.B. 51, PG. 26A

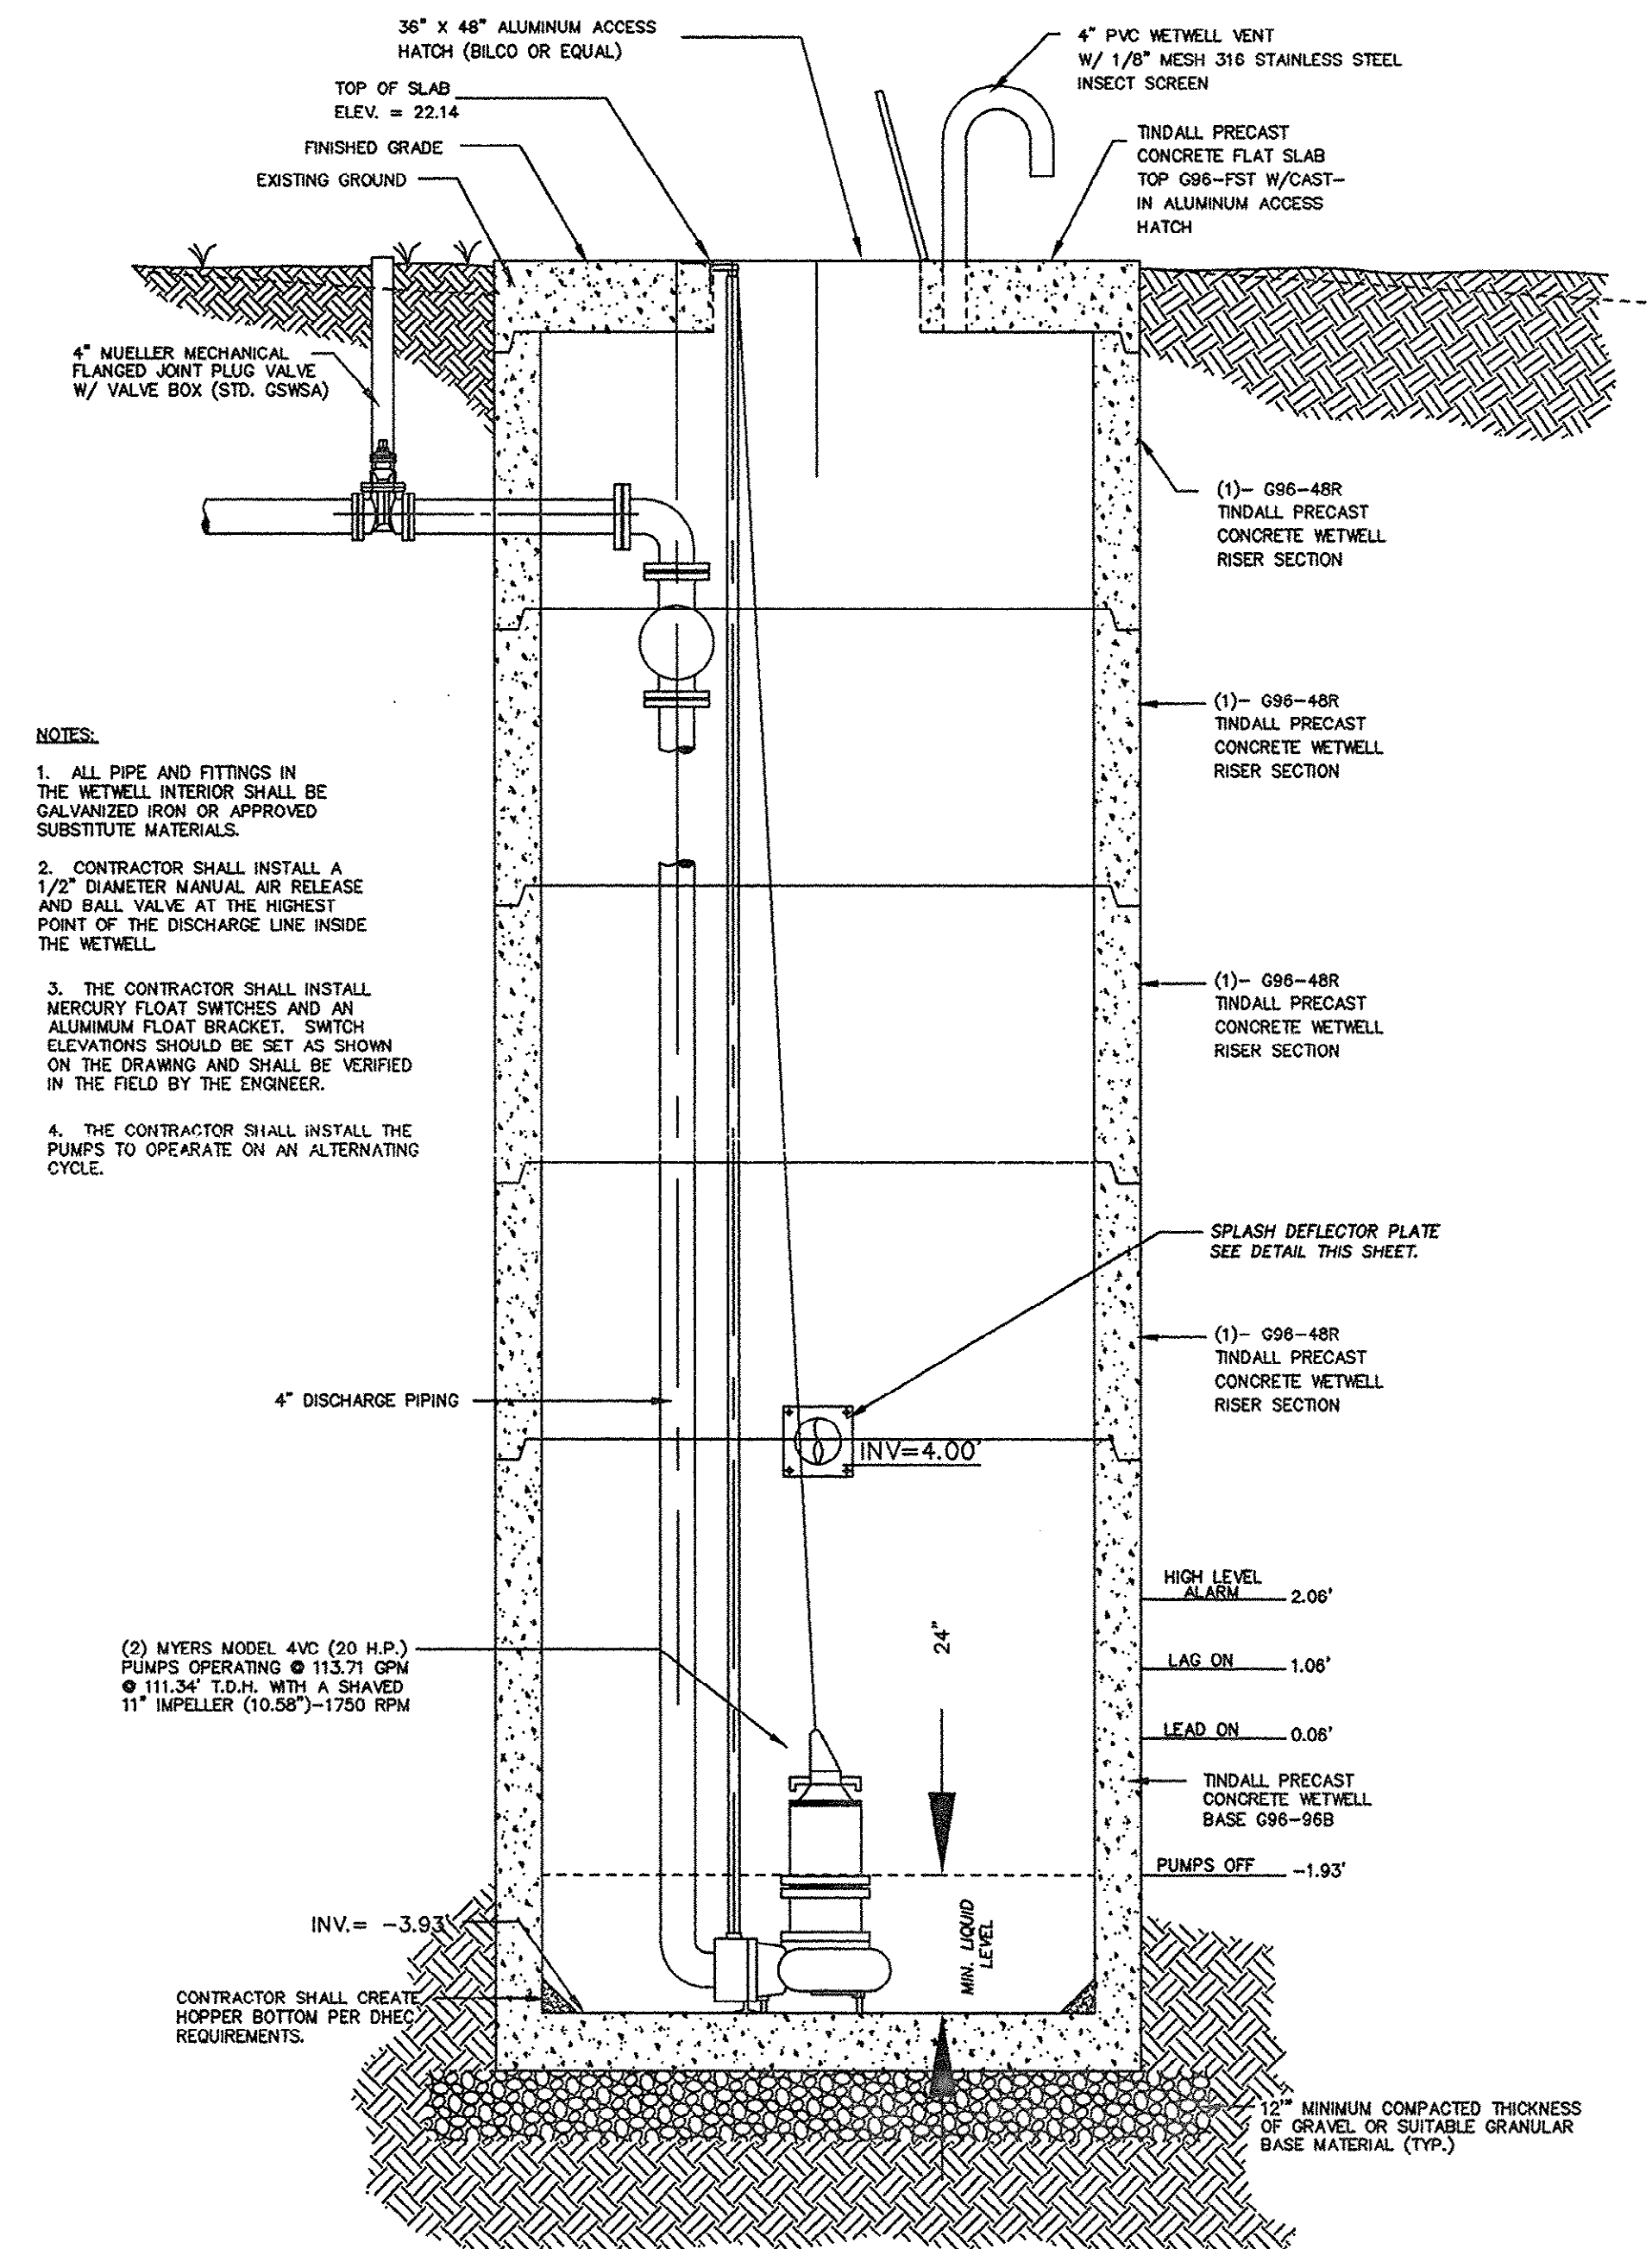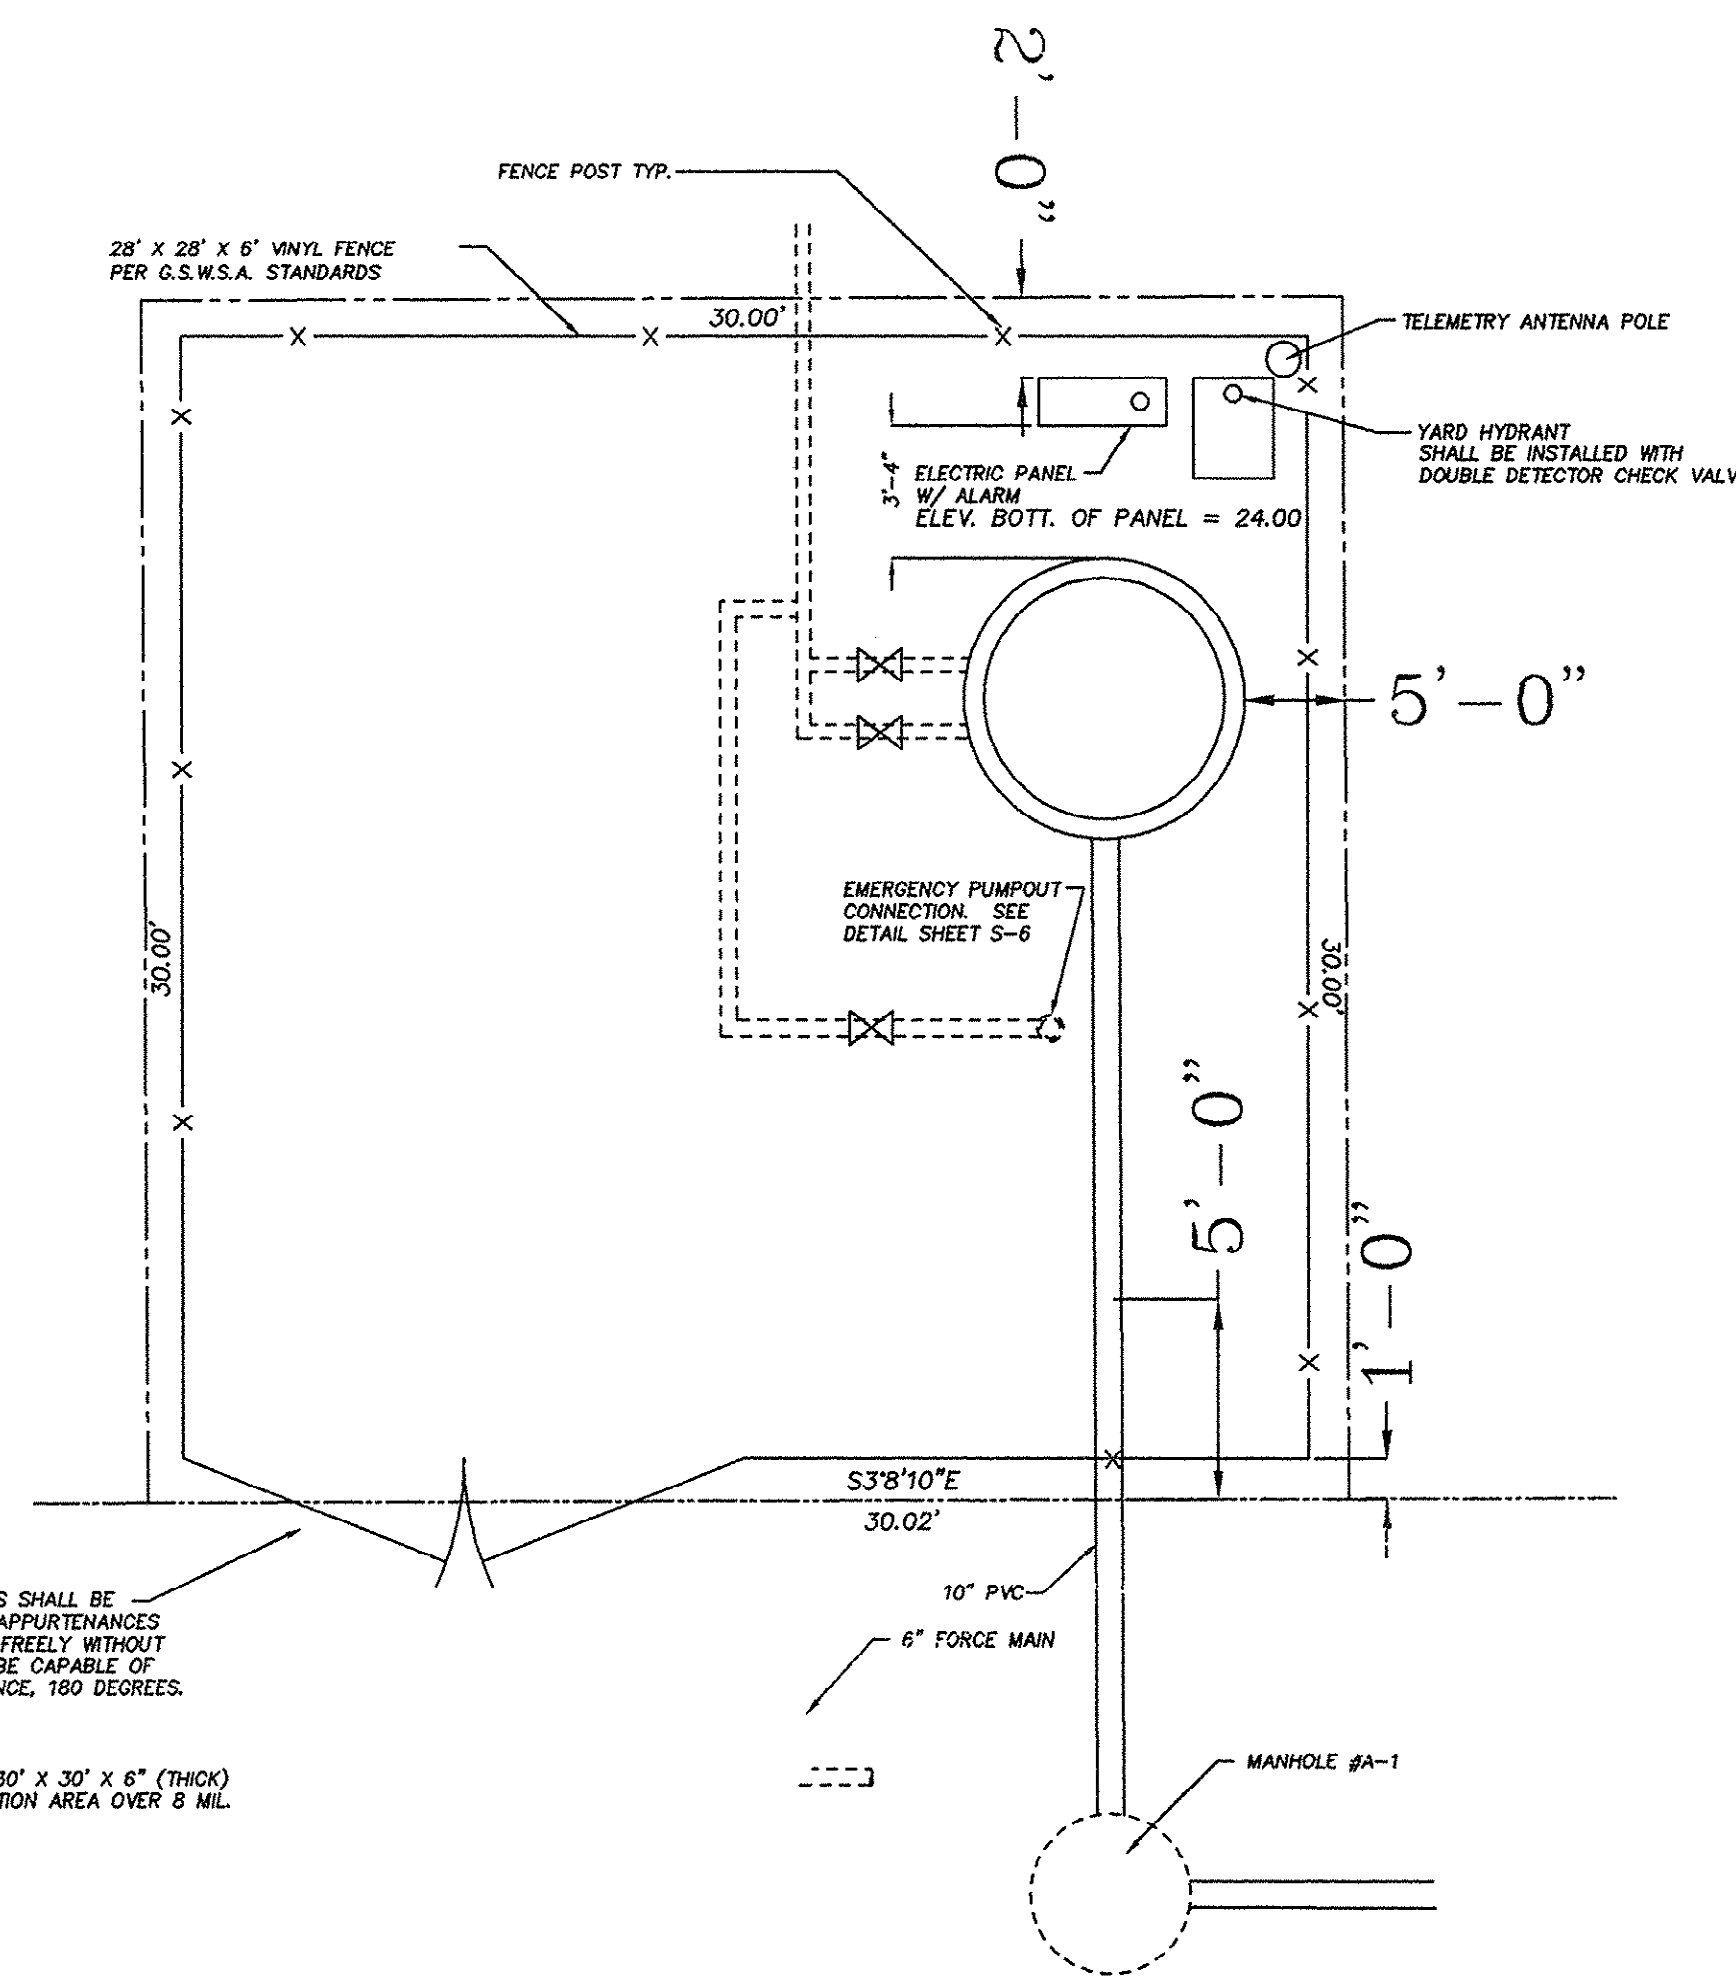

SECTION "A - A"
SCALE: 1/2" = 1'

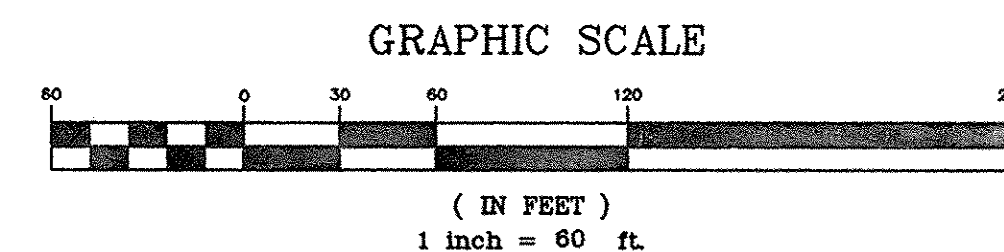

SEWER RECORD DRAWINGS

APPROVED DATE 1/4/99
GRAND STRAND WATER & SEWER AUTHORITY
BY: Ronald W. Lynn

VENTURE ENGINEERING, INC. / 742 HIGHWAY 501 E. / CONWAY, S.C. 29526 / (803) 347-5851 / CIVIL ENGINEERING / LAND PLANNING / LANDSCAPE ARCHITECTURE

AMBERFIELD SUBD.—PHASE I
HORRY COUNTY, SOUTH CAROLINA
PREPARED FOR
SOCASTEE HARVEST II, L. L. C.

[illegible]

16-068-008/3 W/S