



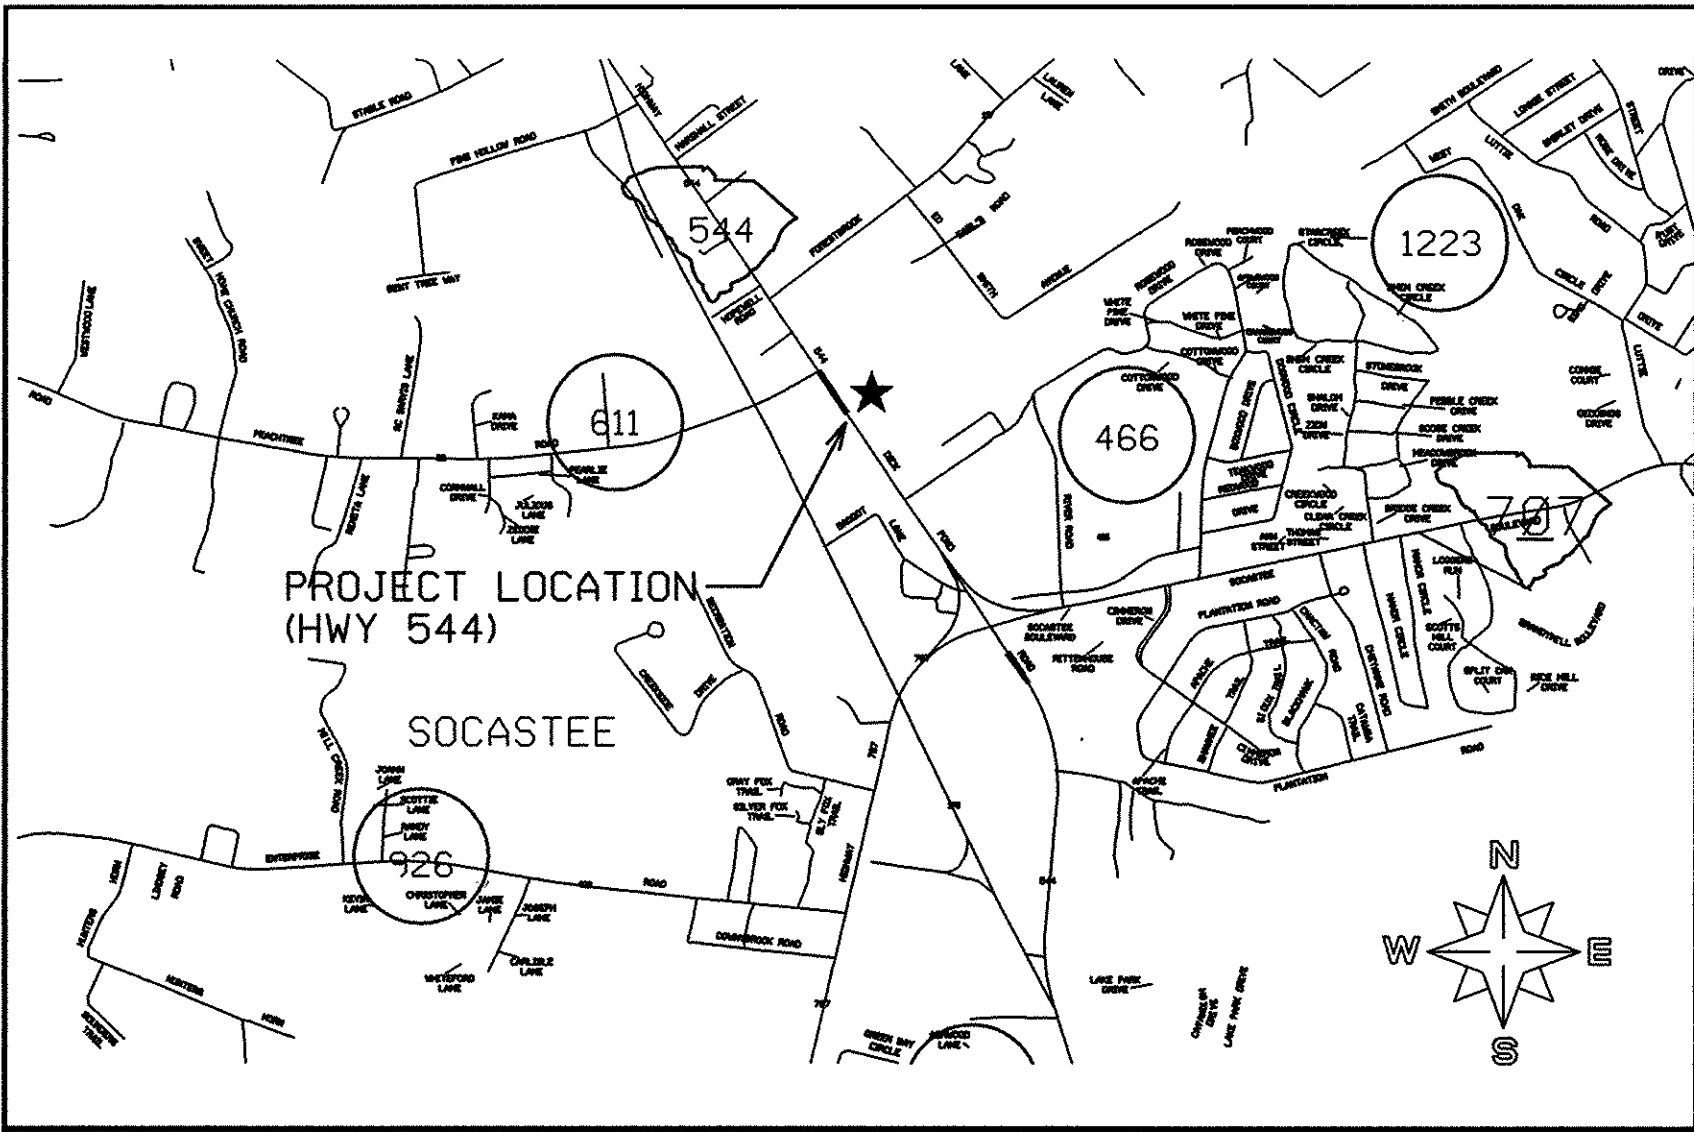

LOCATION MAP
SCALE: 1" = 50'


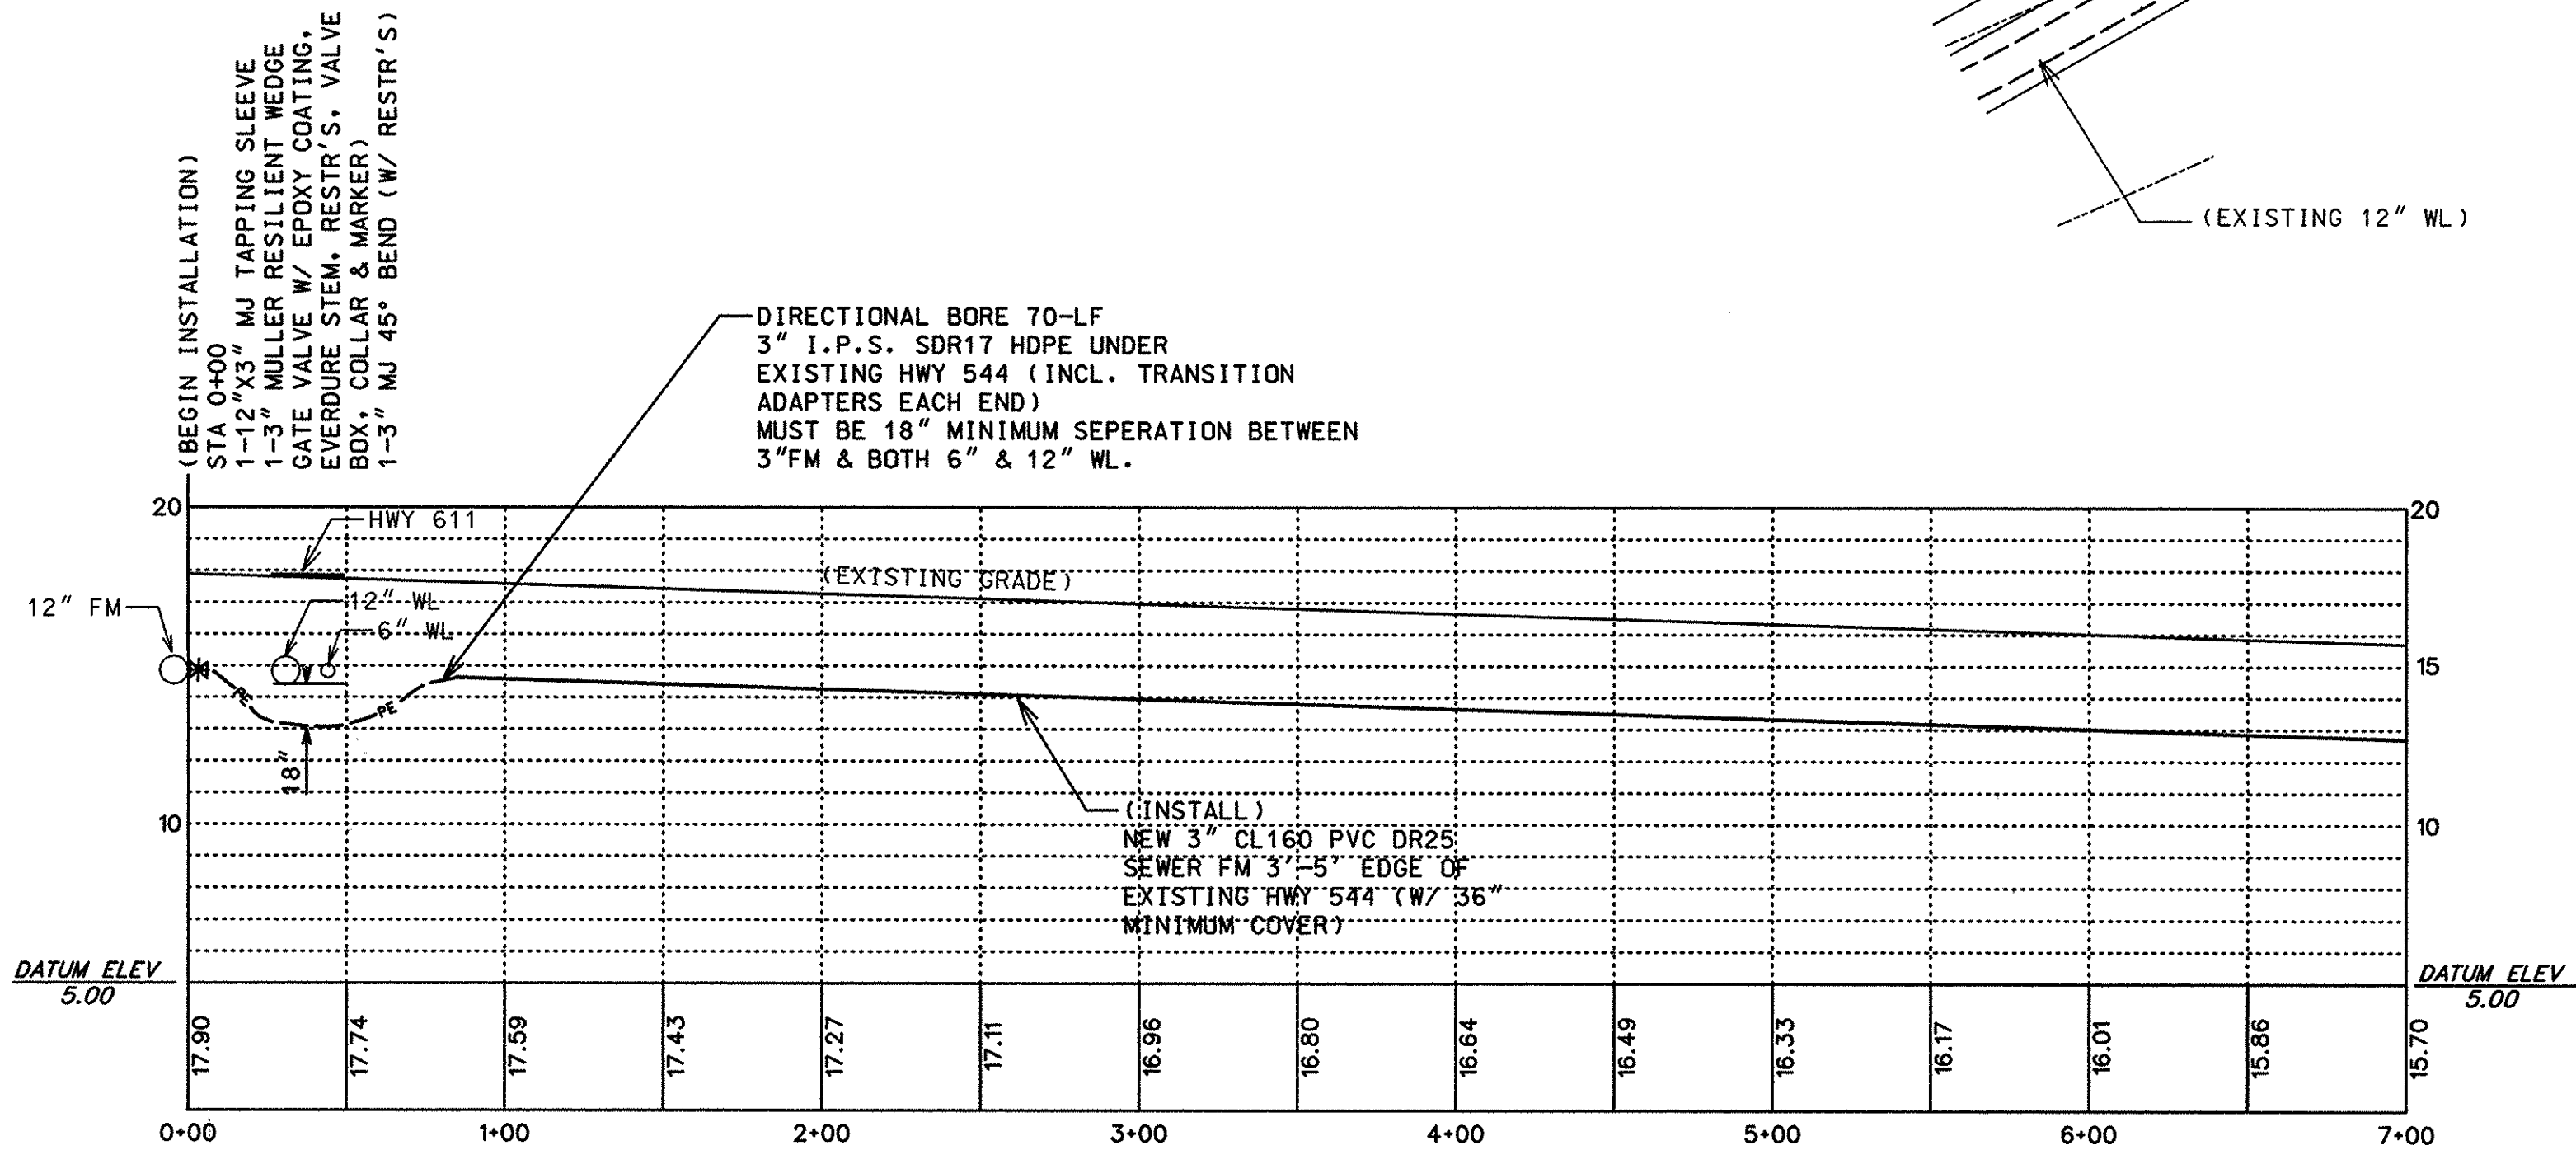


FORCE MAIN PROFILE INFORMATION IS SHOWN FOR INFORMATION PURPOSES ONLY. ELEVATION SHOWN ARE NOT BASED ON MEAN SEA LEVEL DATUM.

LEGEND (APPLIES TYPICALLY THROUGHOUT PLAN SHEETS)	
DIRT/GRASS DRIVEWAY	FIRE HYDRANT & G.V.
COULINA/GRAVEL DRIVEWAY	POST HYDRANT & G.V.
CONCRETE DRIVEWAY	GATE VALVE
ASPHALT DRIVEWAY	WATER SERVICE
REINFORCED CONCRETE PIPE (RCP)	REDUCER
TELEPHONE PEDESTAL	RESIDENCE TO RECEIVE WATER SERVICE
	ELECTRIC POWER POLE

ASBUILT NOTE:

WORK WAS INSTALLED BY WORK ORDDER BY TAPS AND REPAIRS. NO MARK UPS WERE TURNED IN. LOCATION OF UTILITIES MAY NOT BE EXACTLY WHERE SHOWN.

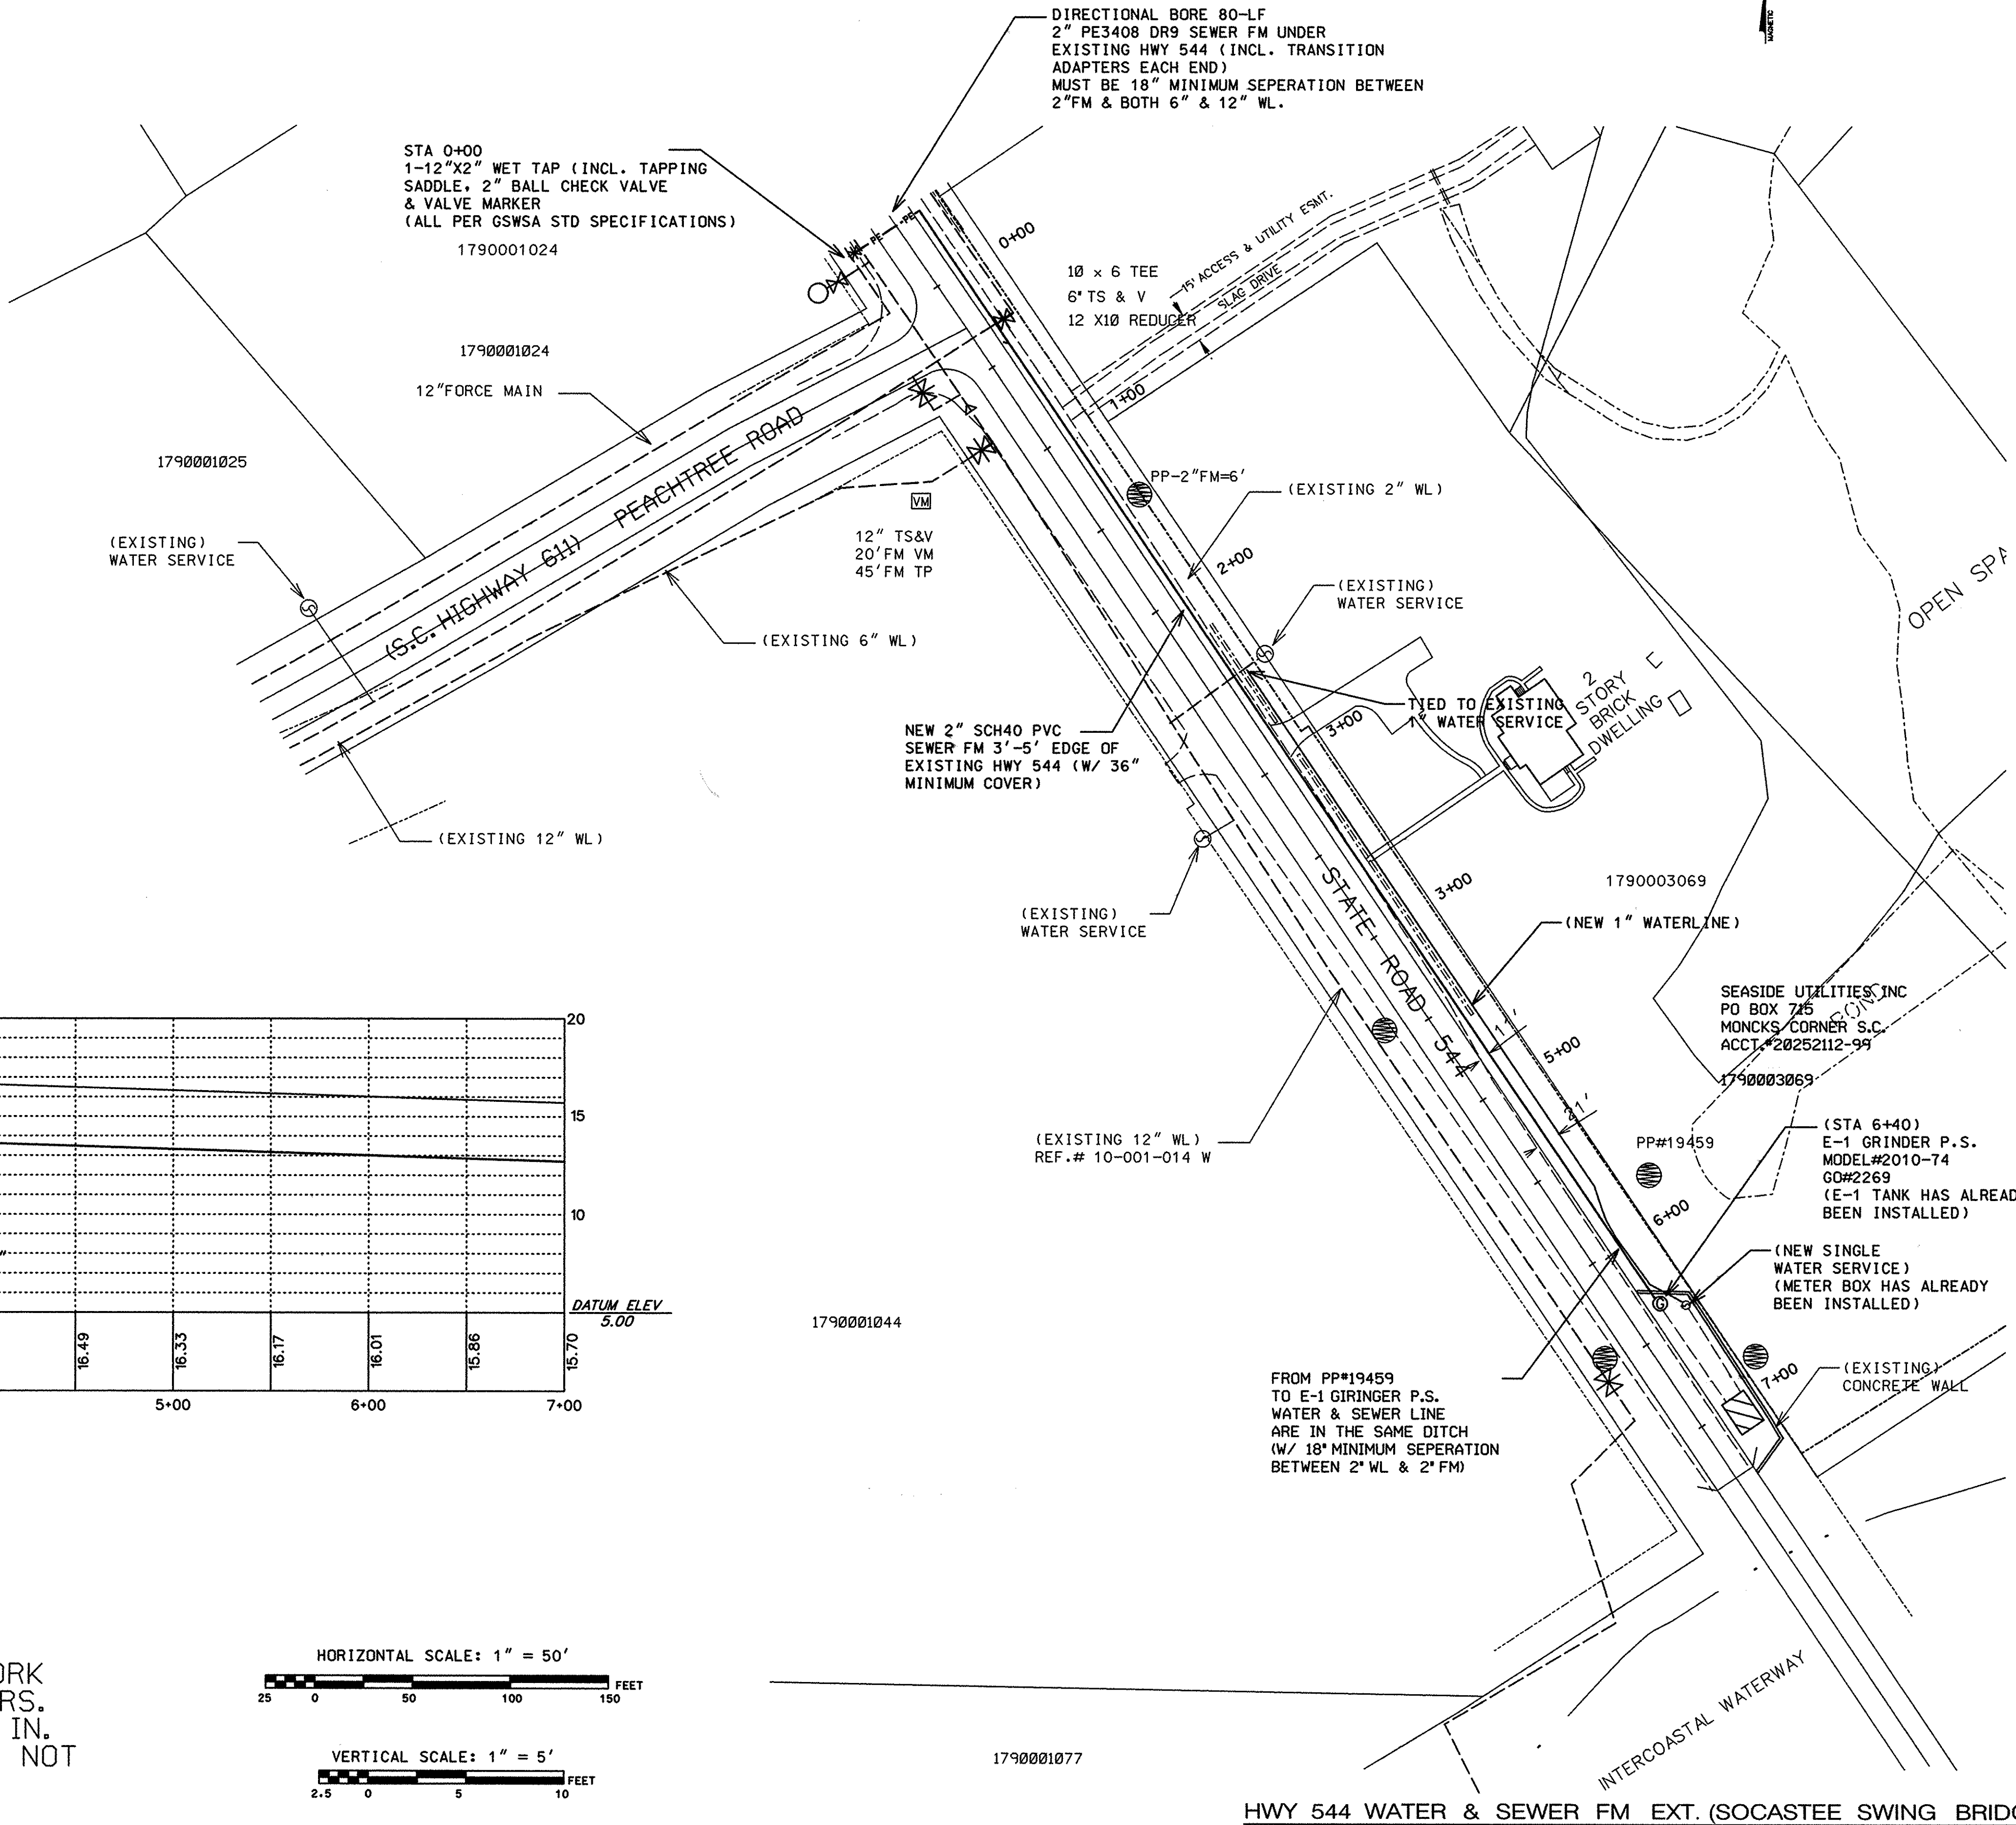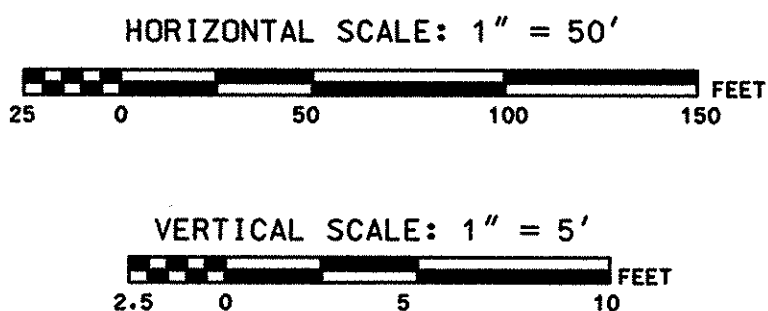

HWY 544 WATER & SEWER FM EXT. (SOCASTEE SWING BRIDGE)

DATE: FEBRUARY 2008
SCALE: 1"=50'
FILENAME: hwy544ab.dgn

DRAWN BY: CHANDUS PORTER
CHECKED BY: ROBERT PERKINS
APPROVED BY: CHRISTINA S. EVERETT, PE #21255

SHEET OF
DWG #

REVISION

BY

DATE

GRAND STRAND WATER & SEWER AUTHORITY

170 JACKSON BLUFF RD.
CONWAY, SC 29528-2388
(843) 347-4641 OR 445-1086
E-MAIL: GSWA@GMAIL.COM

HWY 544 WATER & SEWER FM EXT. (SOCASTEE SWING BRIDGE)

(LOCATED ALONG HWY 544 NORTHWEST THE INTERCOASTAL WATERWAY)

PROJ. #W483-06.#8858-92 /CONT. #W109-03.#s105-03

REGISTERED PROFESSIONAL ENGINEER

No. 21255

CHRISTINA S. EVERETT

16-096-001-w/5