
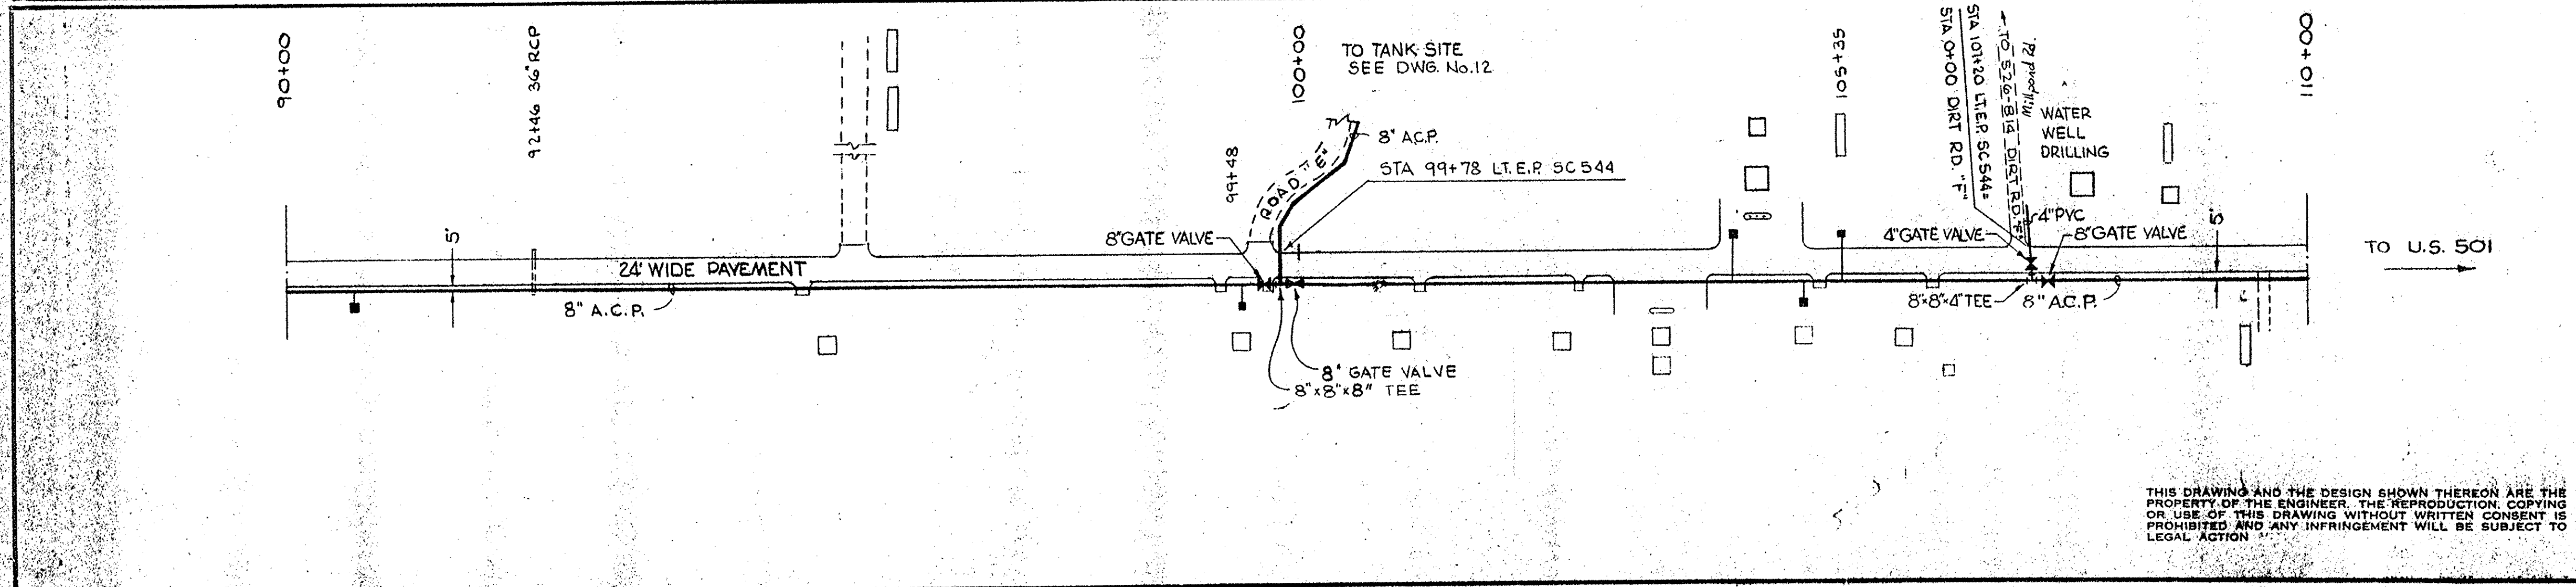
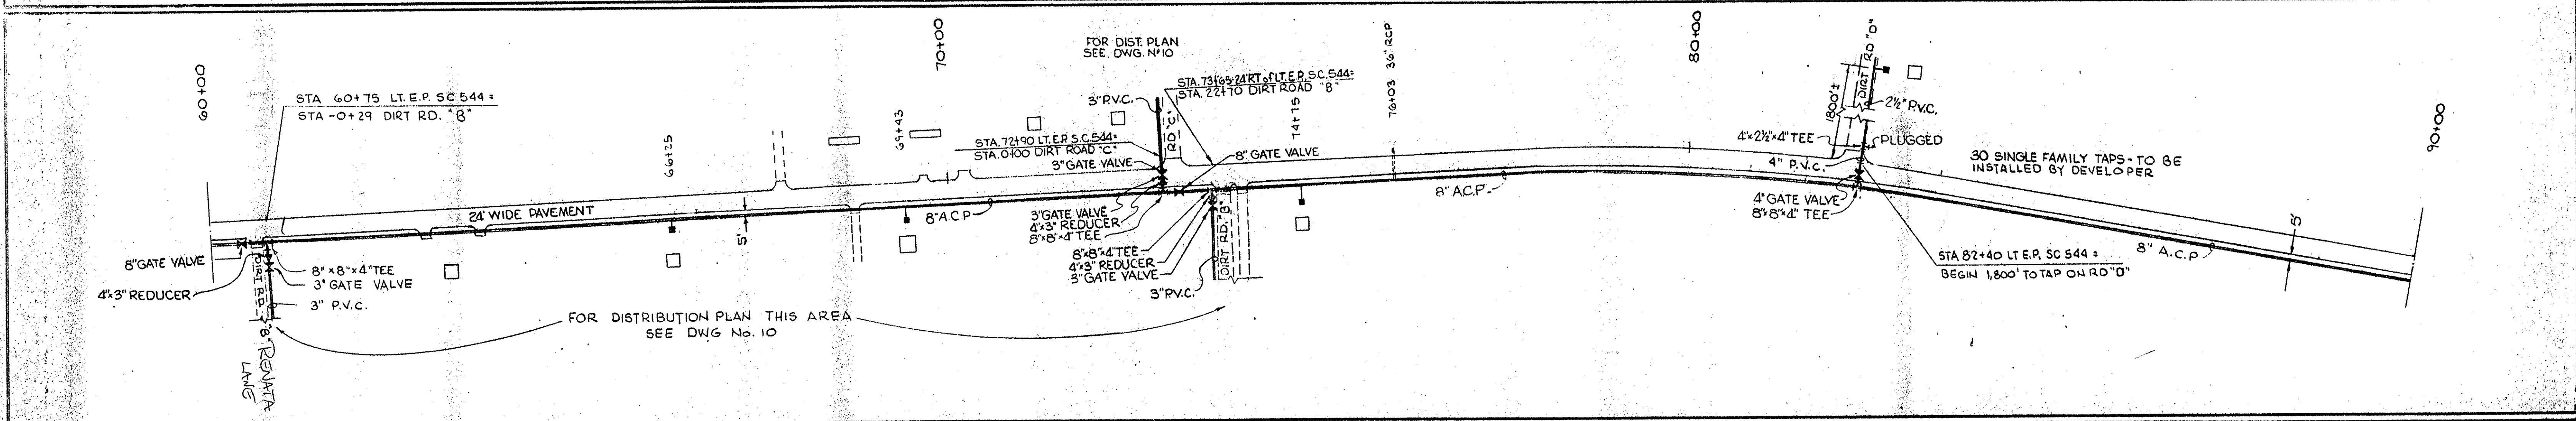
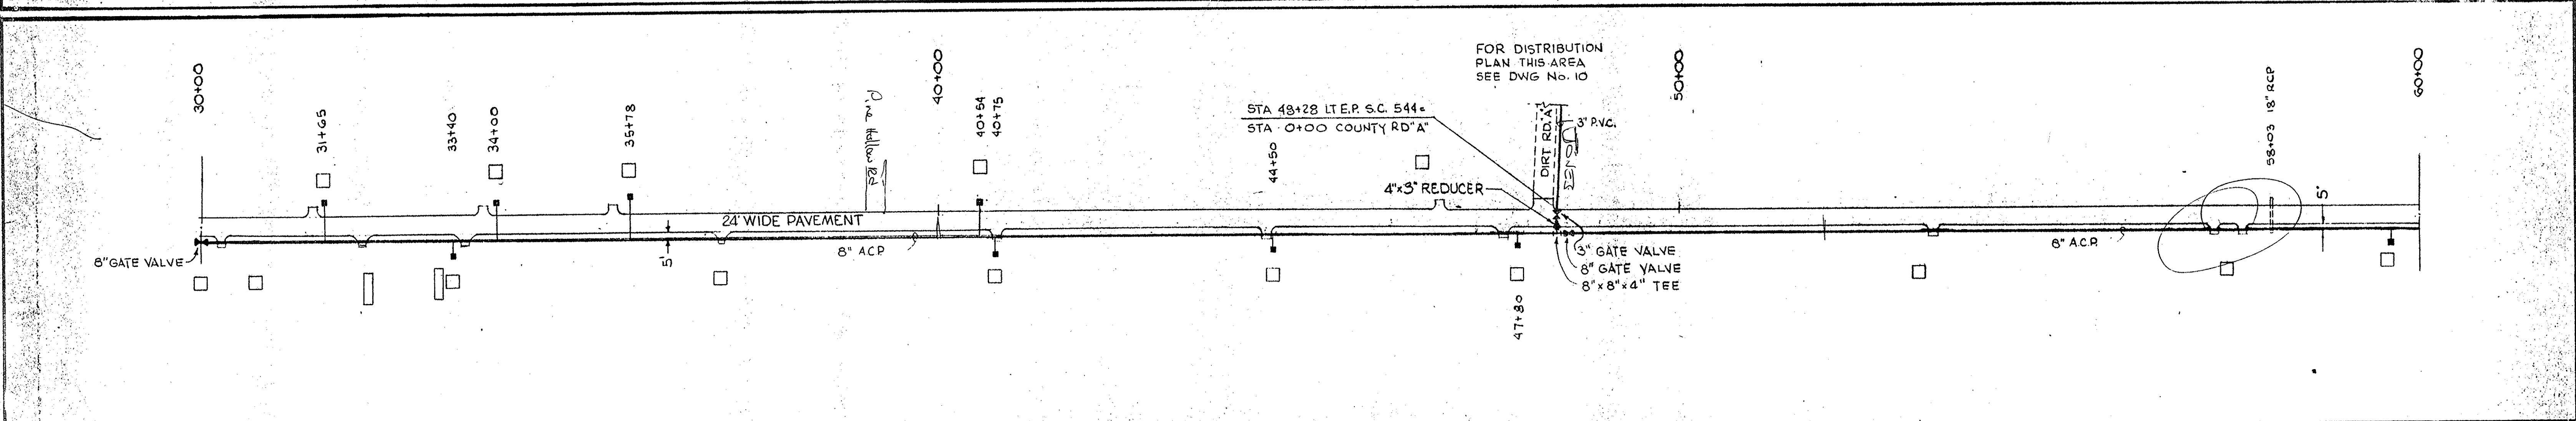


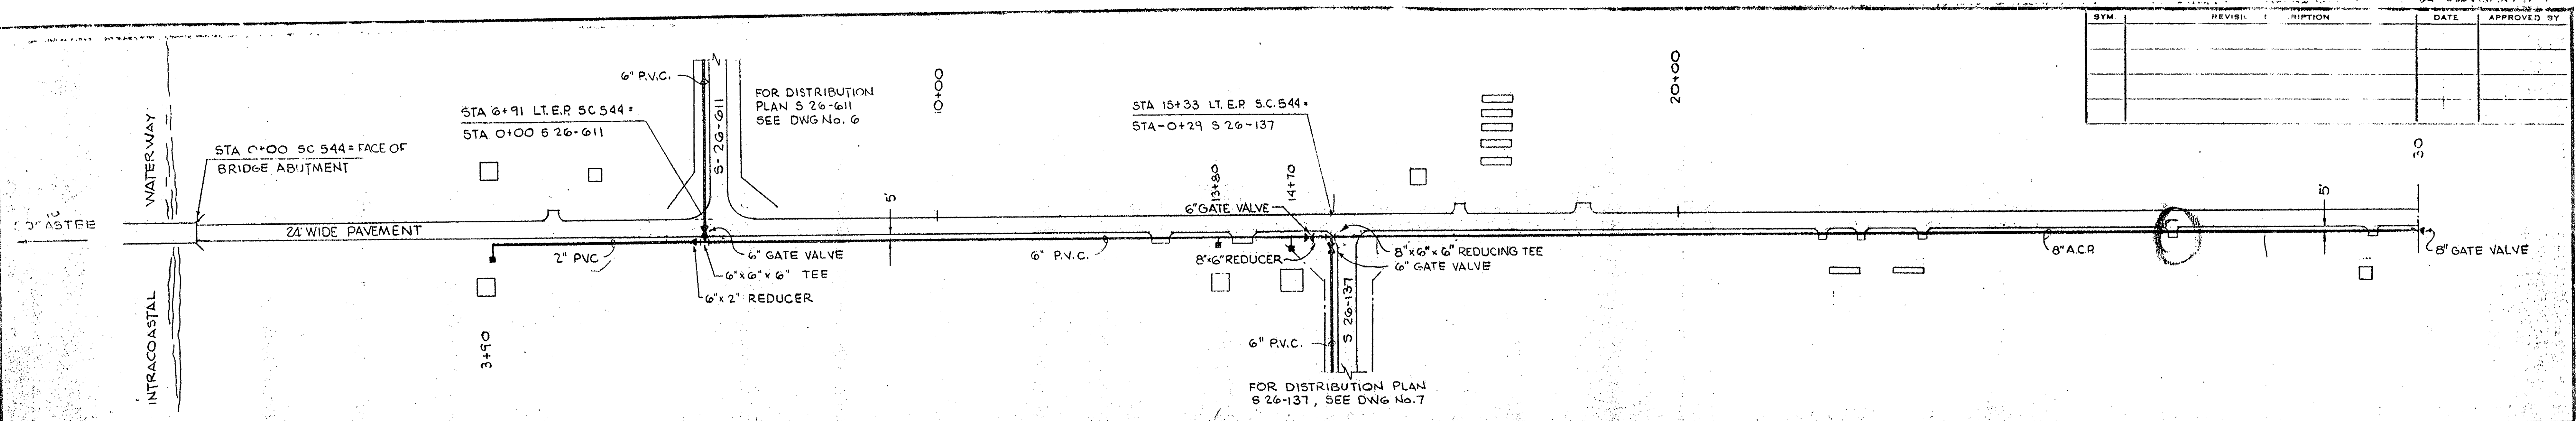

LEGEND

- EXIST. BUILDING
- EXIST. MOBILE HOME
- EXIST. PAVEMENT
- PROPOSED WATER MAIN
- PROPOSED VALVE
- PROPOSED WATER METER
- E.P. EDGE OF PAVEMENT

NOTE:
FRONT OF METER BOXES
TO BE SET 37.5' FROM
CENTERLINE OF ROADWAY.

17-01-001/13-W

LEON CAMPBELL & ASSOCIATES
CONSULTING ENGINEERS & PLANNERS
COLUMBIA, S.C.

SCALE: 1"=100'
DATE: JAN 24, 1975
APPROVED BY: [Signature]
DRAWN RDM
No. 2590
DGN:LSU
CRD:AW






WATER DISTRIBUTION PLAN
S.C. HIGHWAY 544

GRAND STRAND WATER AND SEWER AUTHORITY
HIGHWAY 544 WATER SYSTEM

DRAWING NUMBER
2 OF 14

J/C No. 74028

SYM.	REVISION DESCRIPTION	DATE	APPROVED BY

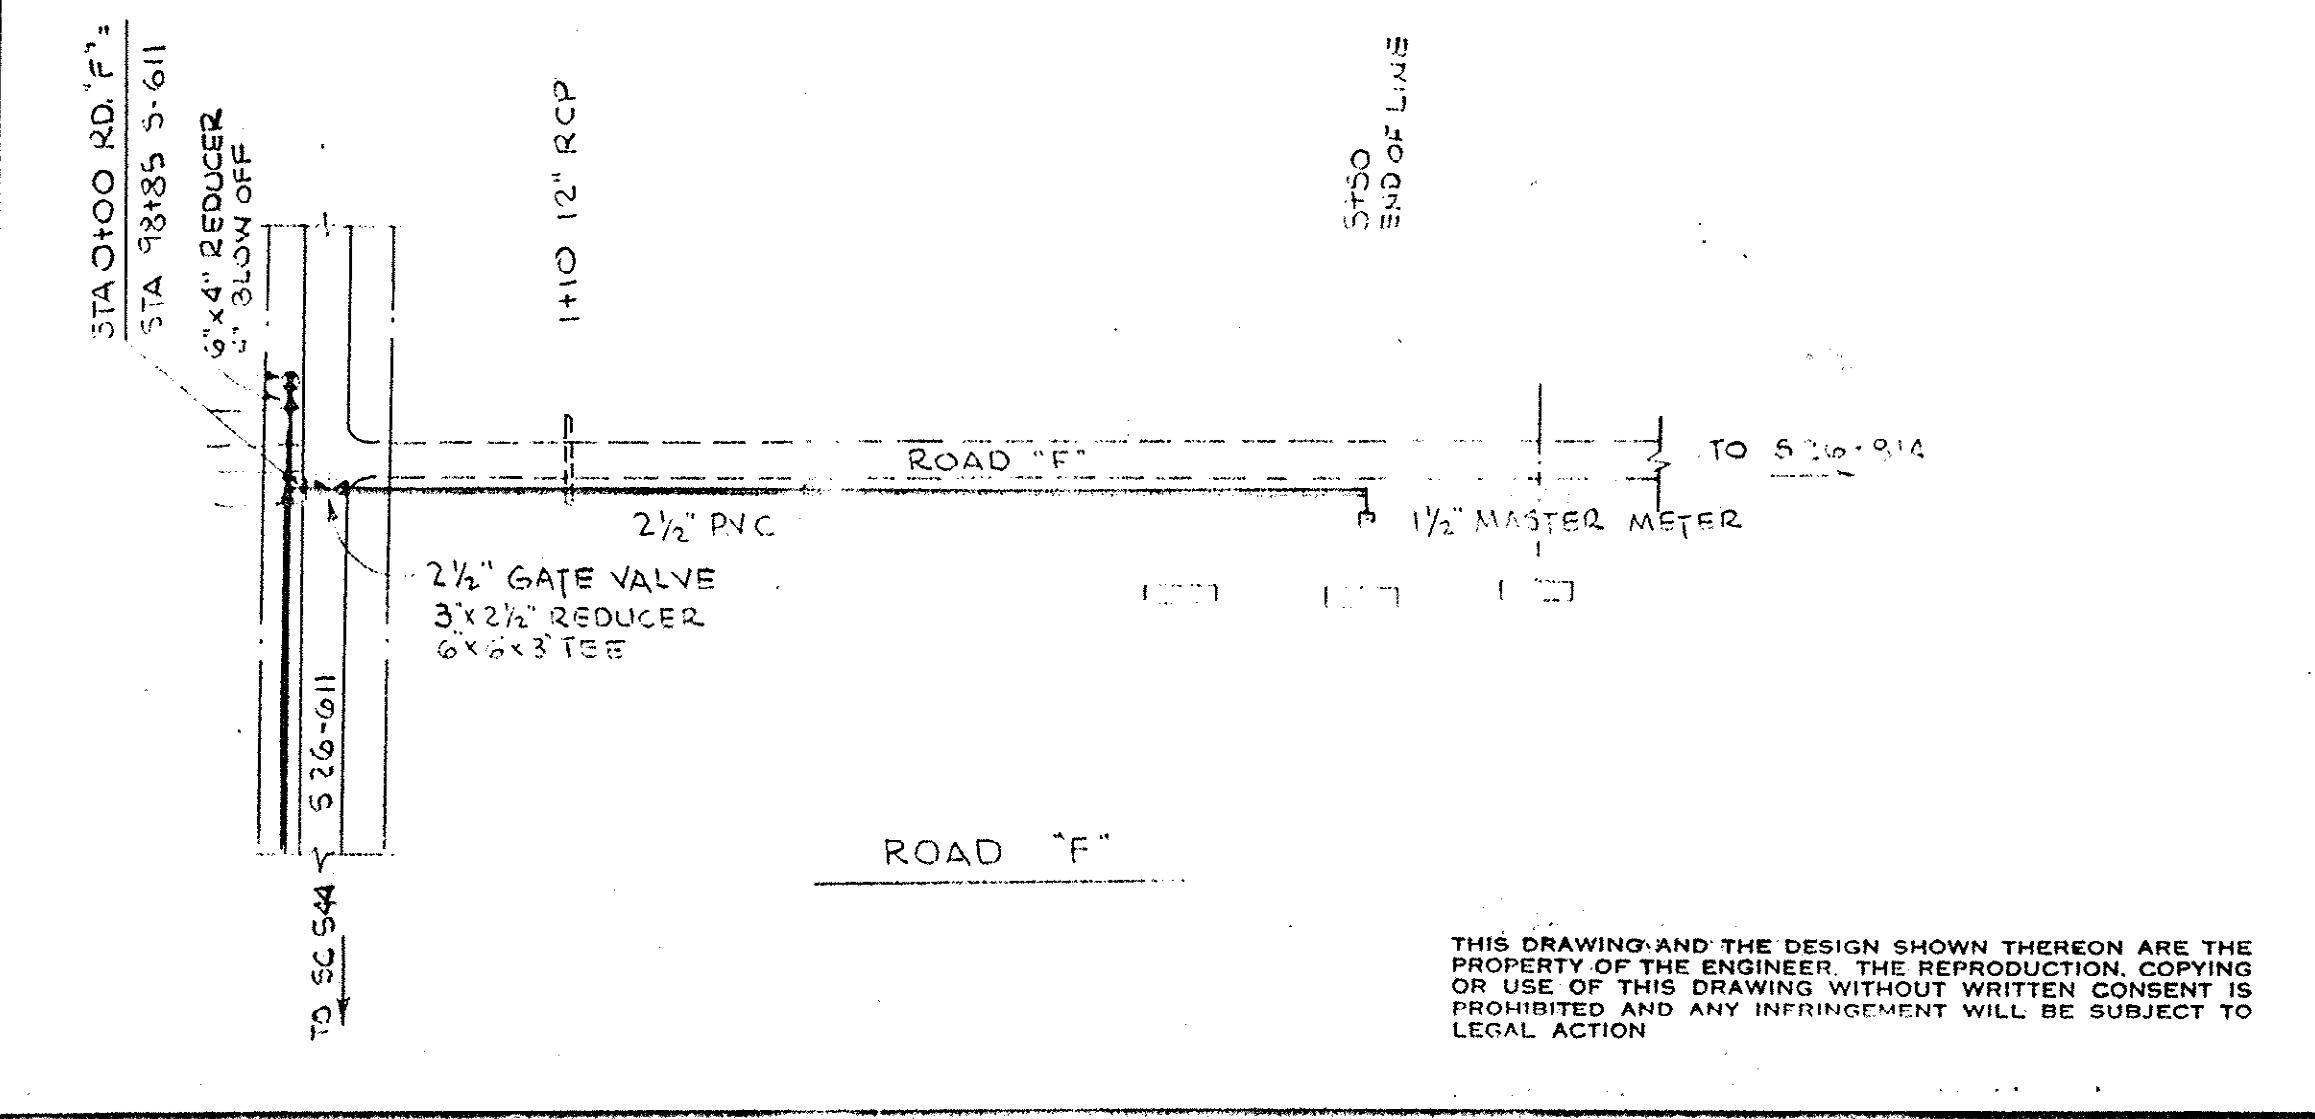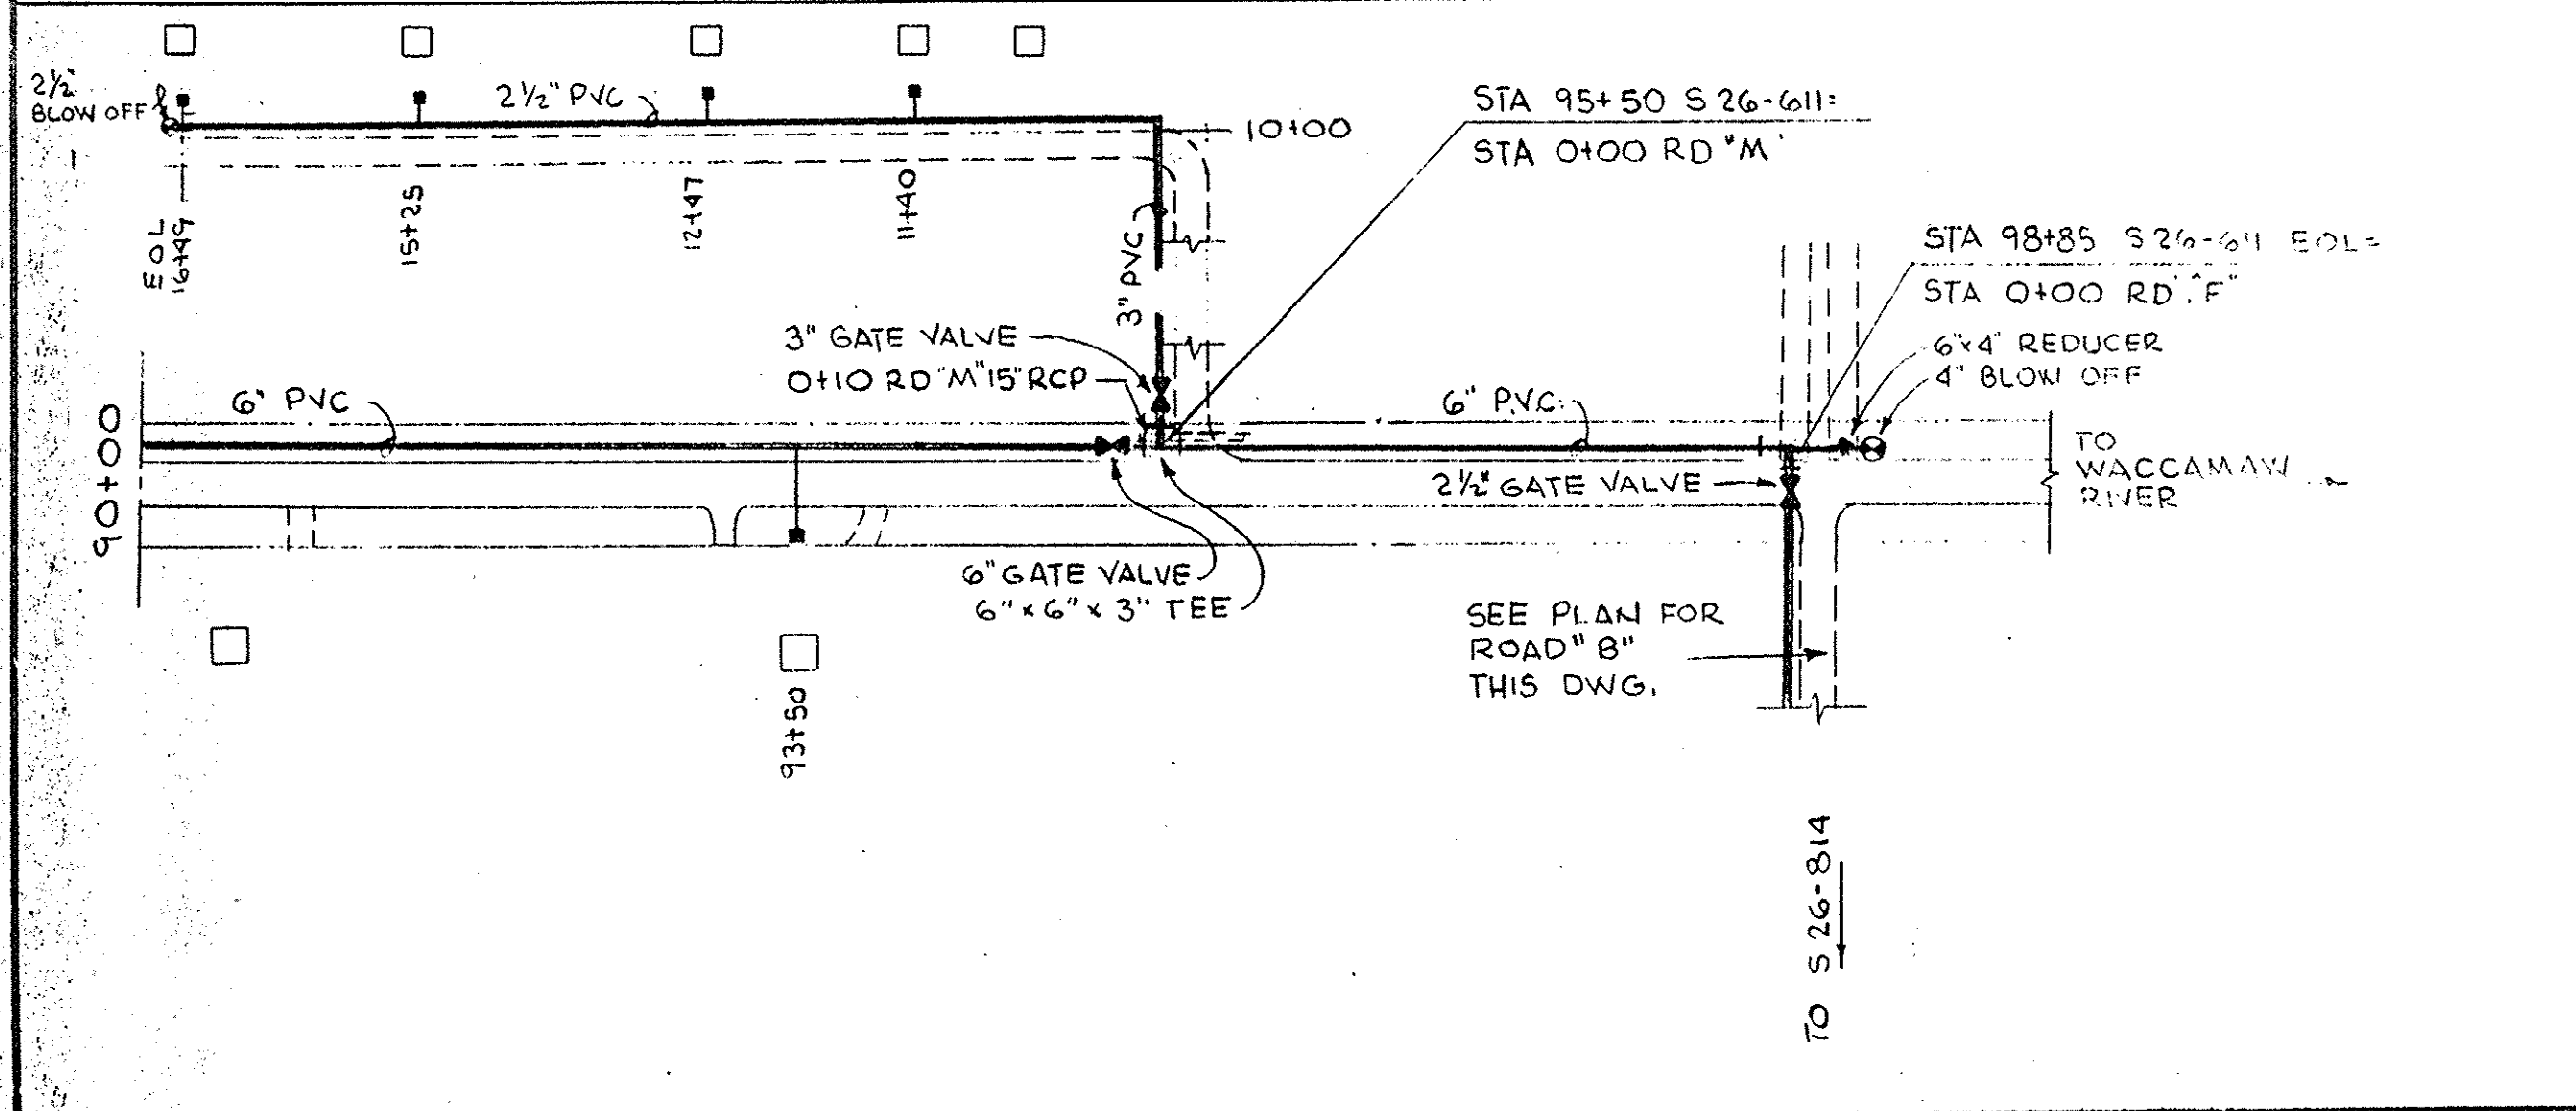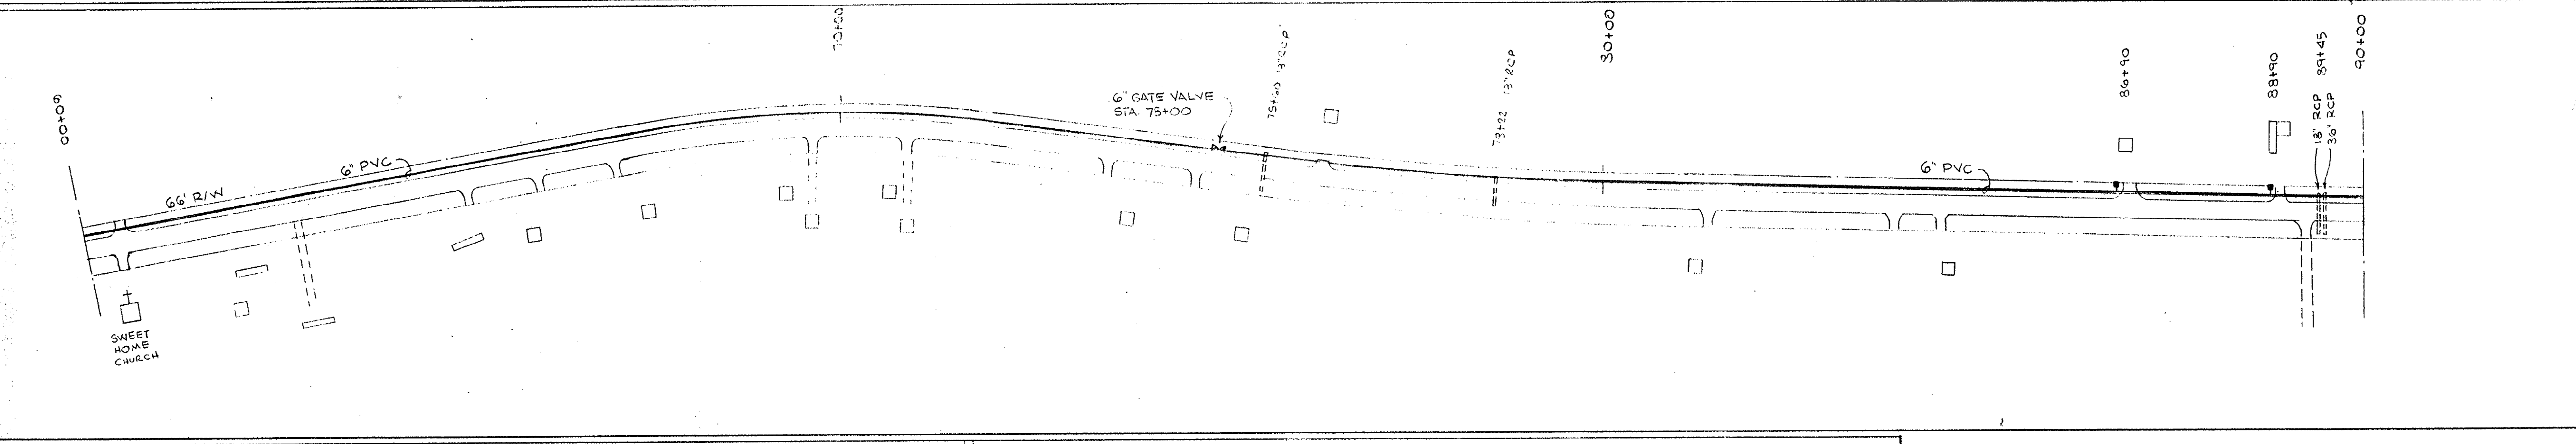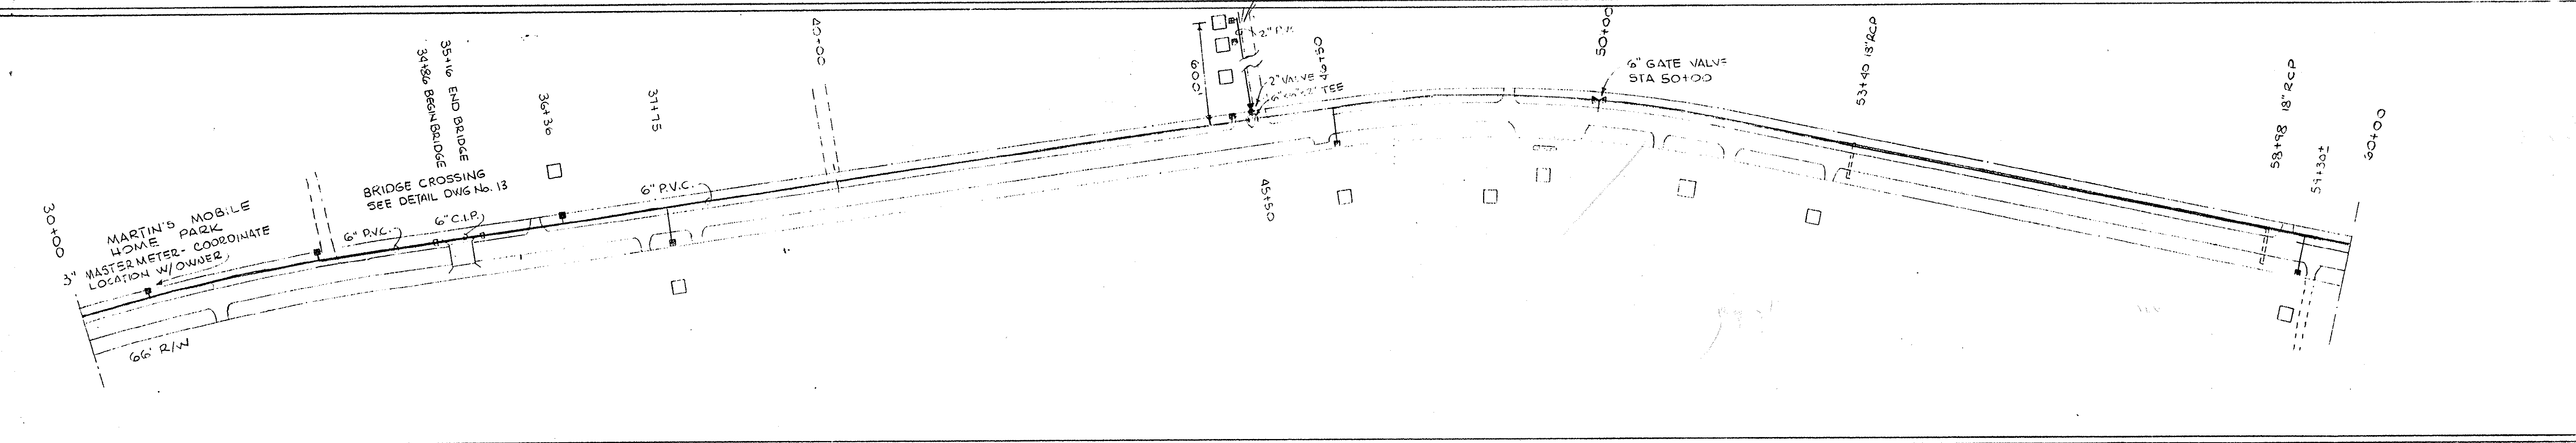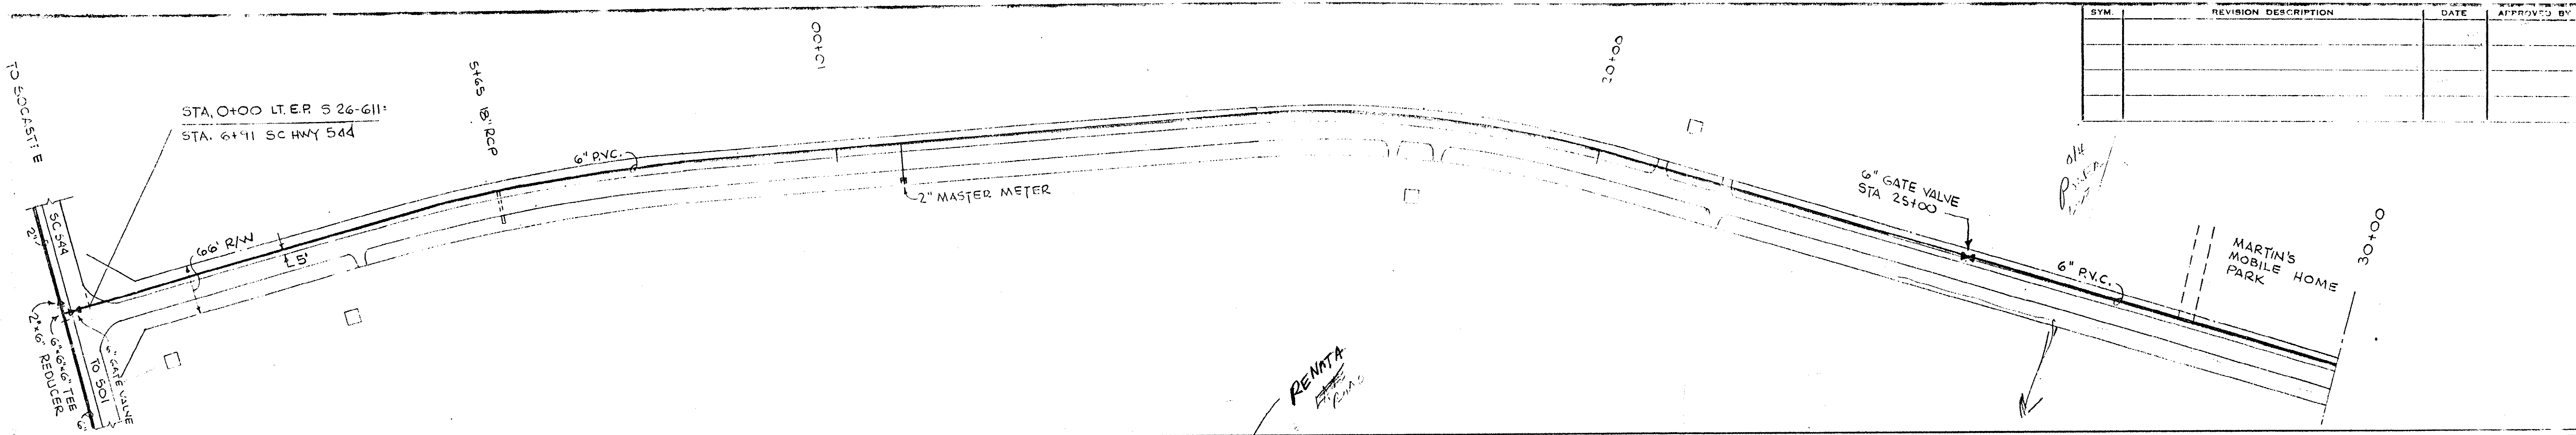


LEGEND

- EXIST. BUILDING
- EXIST. MOBILE HOME
- EXIST. PAVEMENT
- PROPOSED WATER MAIN
- PROPOSED VALVE
- PROPOSED WATER METER

NOTE

FRONT OF METER BOX TO BE SET 33' FROM CENTER PAVEMENT S26-611

17-01-005/13-W

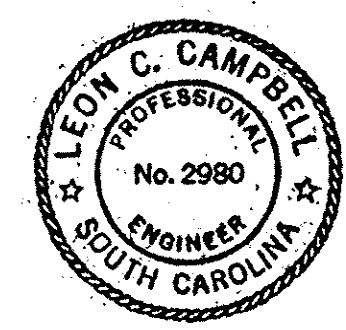

LEON CAMPBELL & ASSOCIATES
CONSULTING ENGINEERS & PLANNERS
COLUMBIA, S. C.

SCALE 1"=100'

DATE JAN 24, 1975

APPROVED BY [Signature]

DRAWN RDM


OGN LSU CKD RTM

WATER DISTRIBUTION PLAN
ROAD S26-611

GRAND STRAND WATER AND SEWER AUTHORITY
HIGHWAY 544 WATER SYSTEM

DRAWING NUMBER
6 OF 14

THIS DRAWING AND THE DESIGN SHOWN THEREON ARE THE PROPERTY OF THE ENGINEER. THE REPRODUCTION, COPYING OR USE OF THIS DRAWING WITHOUT WRITTEN CONSENT IS PROHIBITED AND ANY INFRINGEMENT WILL BE SUBJECT TO LEGAL ACTION

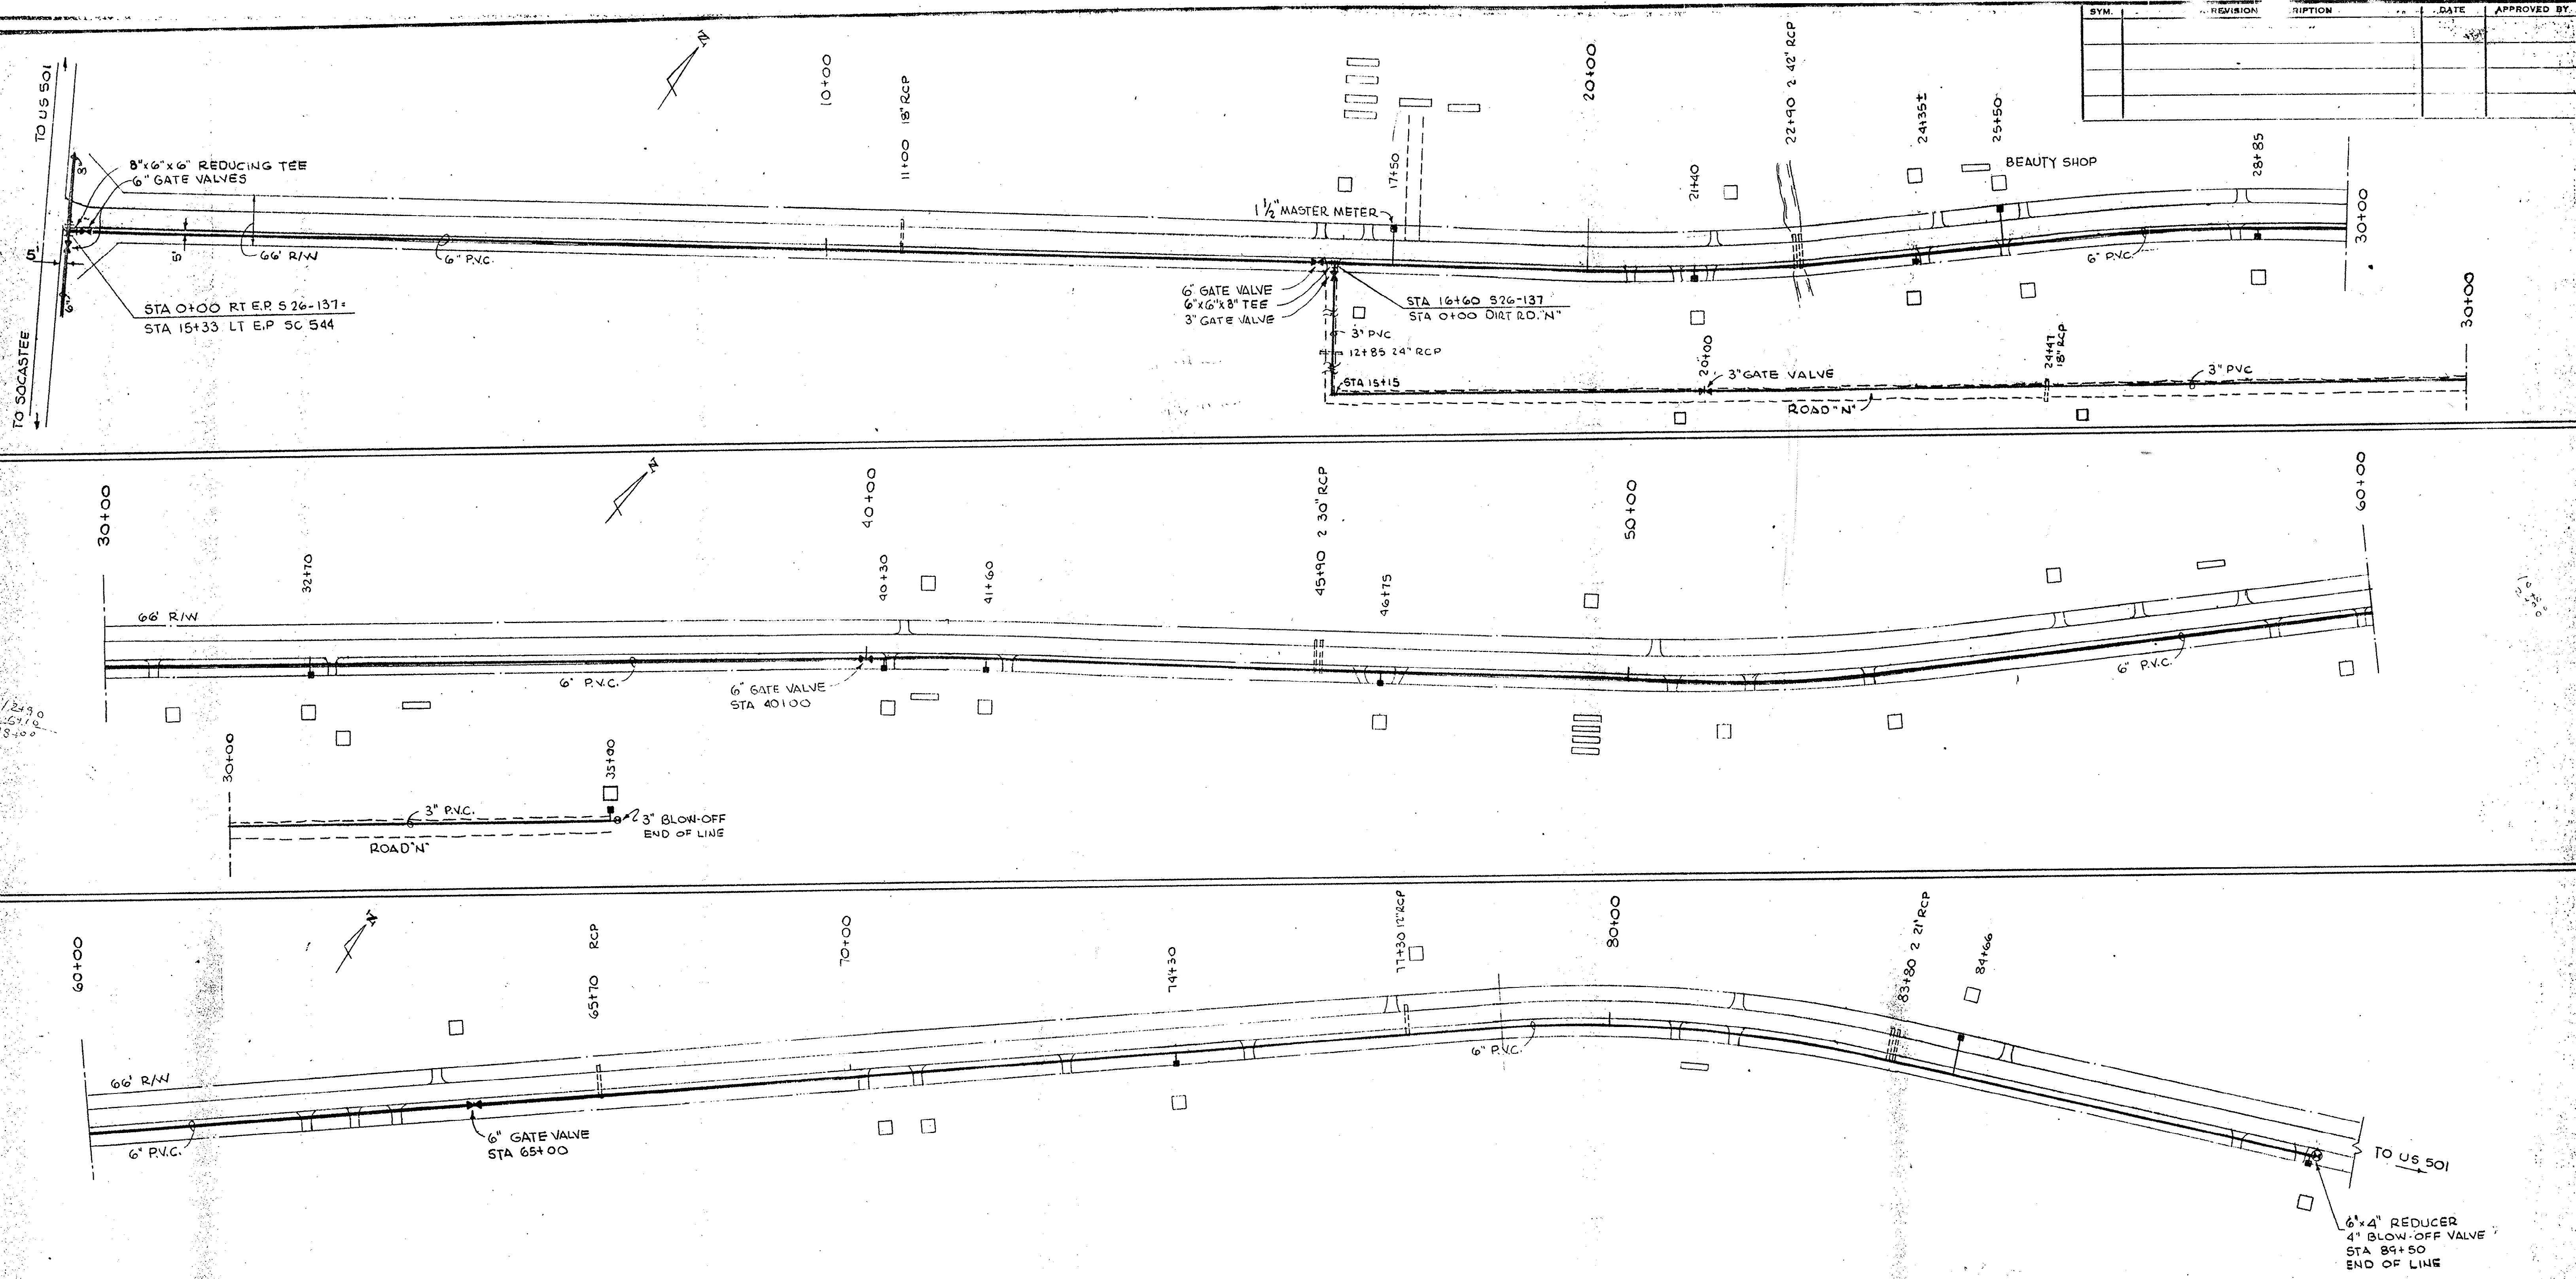


NOTE:
FRONT OF METER BOX TO BE 33' FROM
CENTER OF PAVEMENT S 26-137

- LEGEND**
- EXIST. BUILDING
 - ▭ EXIST. MOBILE HOME
 - EXIST. PAVEMENT
 - PROPOSED WATER MAIN
 - PROPOSED VALVE
 - PROPOSED WATER METER

Final As-Built
7-23-84 RL

17-01-006/13-W

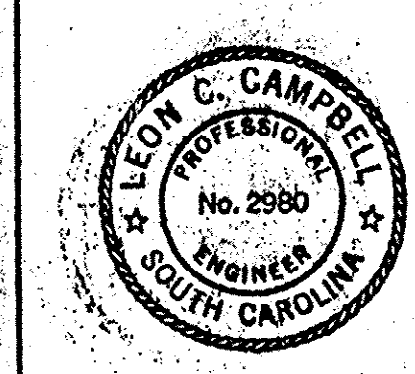

LEON CAMPBELL & ASSOCIATES CONSULTING ENGINEERS & PLANNERS COLUMBIA, S. C.	
SCALE: 1"=100' DATE: JAN 24, 1975	APPROVED BY: <i>[Signature]</i> DRAWN RDM DGN: LBU SKD: RDM
WATER DISTRIBUTION PLAN ROAD S 26-137	
GRAND STRAND WATER AND SEWER AUTHORITY HIGHWAY 544 WATER SYSTEM	
DRAWING NUMBER: 7 OF 14	

THIS DRAWING AND THE DESIGN SHOWN THEREON ARE THE
PROPERTY OF THE ENGINEER. THE REPRODUCTION, COPYING
OR USE OF THIS DRAWING WITHOUT WRITTEN CONSENT IS
PROHIBITED AND ANY INFRINGEMENT WILL BE SUBJECT TO
LEGAL ACTION