


GRAND STRAND WATER AND SEWER AUTHORITY

HWY 616 SEWER EXTENSION

(FORESTBROOK RD. TO PINE HOLLOW RD.)

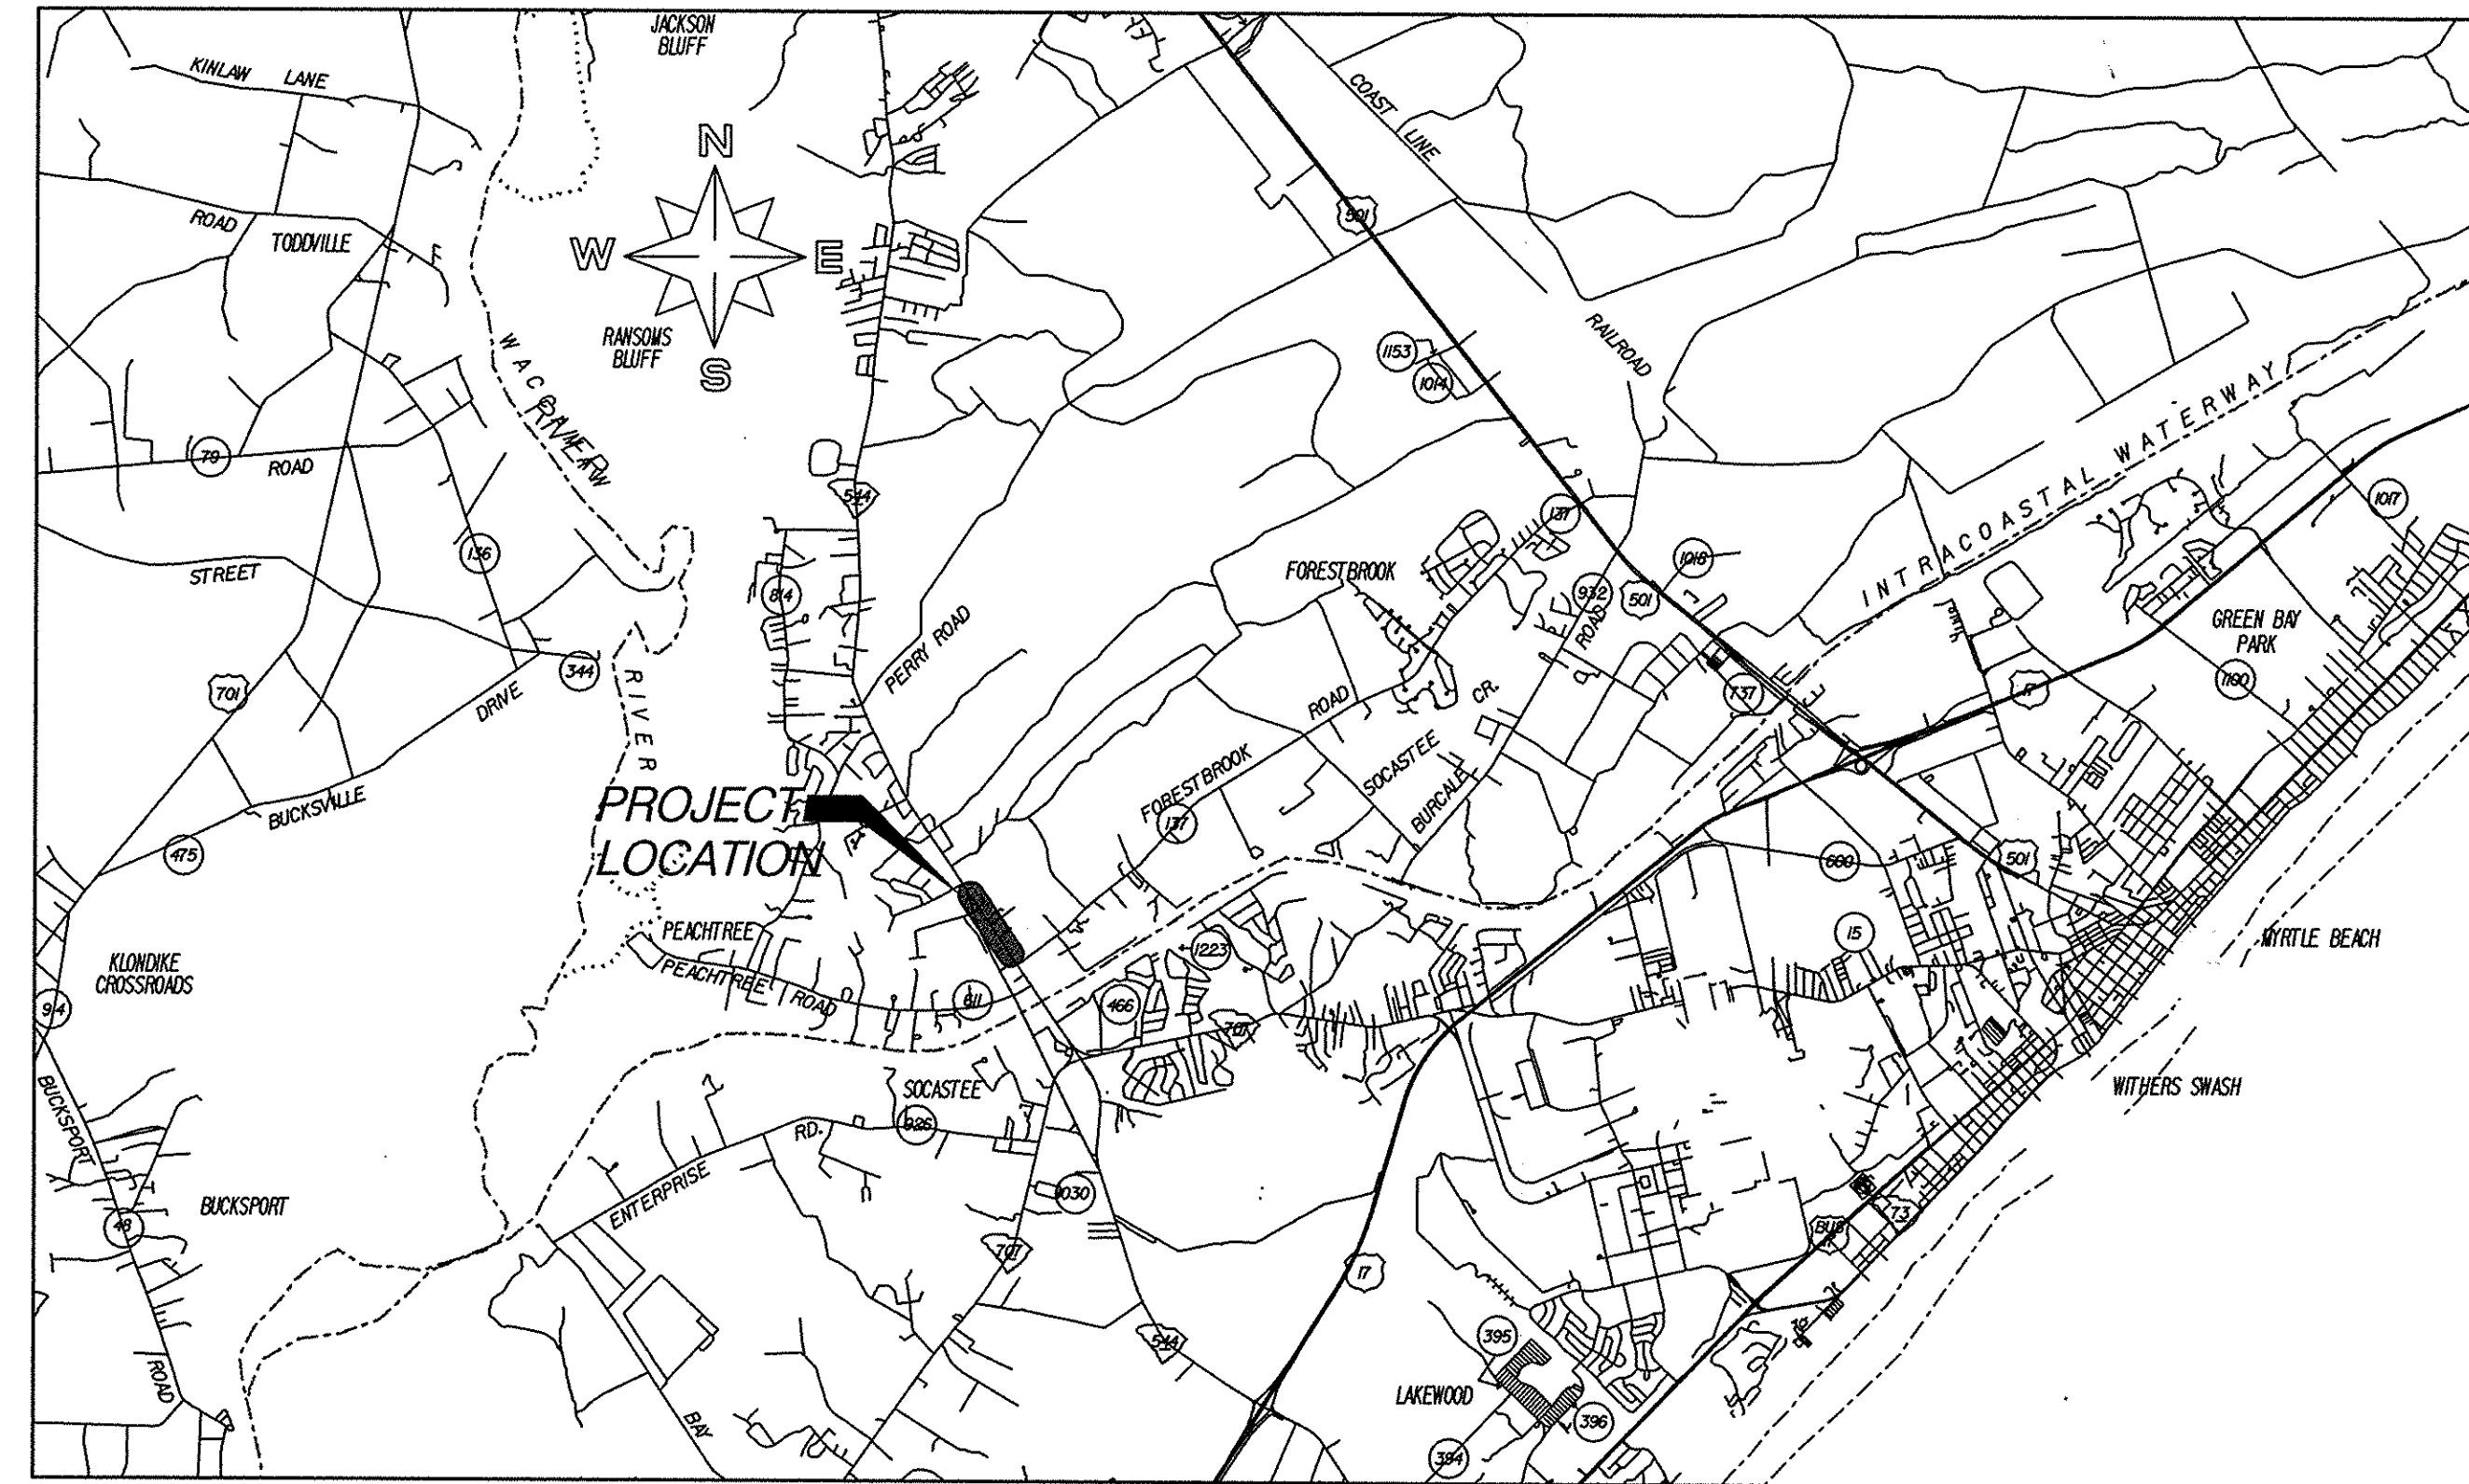


LOCATION MAP
NOT TO SCALE

1. WORK WITHIN PUBLIC RIGHT-OF-WAYS OR PRIVATE EASEMENTS SHALL BE ACCOMPLISHED BY THE CONTRACTOR ACCORDING TO THE REQUIREMENTS OR CONDITIONS OF THE ENCROACHMENT PERMIT OR OTHER LEGAL DOCUMENTS AS THOUGH DOCUMENTS WERE ISSUED IN THE CONTRACTORS NAME. THE CONTRACTOR SHALL MAINTAIN COPIES OF THESE DOCUMENTS ON THE SITE AT ALL TIMES. THE CONTRACTOR SHALL BE RESPONSIBLE FOR THE MAINTENANCE OF PUBLIC RIGHT-OF-WAYS DURING CONSTRUCTION OF THE PROJECT AND UNTIL THE CONTRACTOR OBTAINS AND DELIVERS TO THE OWNER A WRITTEN SIGN-OFF FROM HORRY COUNTY AND/OR THE S.C.D.O.T. THAT THE PUBLIC AGENCY HAS ACCEPTED THE RIGHT-OF-WAY BACK FOR MAINTENANCE. FINAL PAYMENT AND RELEASE OF RETAINAGE WILL NOT BE MADE TO THE CONTRACTOR UNTIL WRITTEN SIGN-OFF HAS BEEN OBTAINED FROM THE APPROPRIATE PUBLIC AGENCY AND PROVIDED TO THE OWNER.
2. PROVISIONS SHALL BE MADE TO PREVENT EROSION AND SILTRATION CAUSED BY CONSTRUCTION. TEMPORARY GRASSING, HAY BALES, SILT FENCES OR OTHER METHODS, AS CALLED FOR ON THE PLAN OR THAT MAY BE REQUIRED, SHALL BE USED.
3. DISTANCES SHOWN ON THE PLAN FOR THE DESIGNATED LOCATION OF THE PROPOSED LINE WHICH MAY BE FROM THE EDGE OF PAVEMENT OR OTHERWISE SHOWN IS INTENDED ONLY AS A DESIRED LOCATION FOR THIS INSTALLATION. HOWEVER, SHOULD A CONFLICT OCCUR AND/OR DUE TO UNFORESEEN OR OTHER UTILITIES DISCOVERED THAT ARE IN CONFLICT, IT IS THE CONTRACTOR'S RESPONSIBILITY TO PROVIDE FOR ANY AND ALL INSTALLATIONS AND DEVIATIONS OF ALIGNMENT NECESSARY TO ACHIEVE A CHANGED AND SATISFACTORY LOCATION FOR THIS INSTALLATION. THE INSTALLATION COSTS THAT MAY OCCUR DUE TO ALIGNMENT CHANGES ARE CONSIDERED TO BE A PART OF THE PRICE SUBMITTED FOR PIPE INSTALLATION AND NO ADDITIONAL COMPENSATION IS ALLOWED. THE FINAL LOCATION SELECTED FOR INSTALLATION BY THE CONTRACTOR OTHER THAN WHAT IS SHOWN ON THE PLANS SHALL BE FIRST APPROVED BY THE AUTHORITY PRIOR TO PROCEEDING WITH THE WORK AND ACTUAL INSTALLATION. THE CONTRACTOR WILL BE RESPONSIBLE FOR VERIFYING THE LOCATION AND EXISTENCE OF ALL UNDERGROUND UTILITIES BOTH PRIOR


TO THE BID SUBMITTAL AND DURING CONSTRUCTION. LOCATION OF UTILITIES AS TENTATIVELY SHOWN ON THE PLANS, WHETHER FULLY AND CORRECTLY LOCATED OR PARTIALLY AND/OR INCORRECTLY LOCATED OR OMITTED WILL NOT RELIEVE THE CONTRACTOR OF THE RESPONSIBILITY OR LIABILITY FOR PROVIDING FOR ANY DEVIATION FROM THE PLANNED LOCATION AND FOR THE COMPLETE INSTALLATION AND/OR DAMAGE TO OTHER UTILITIES. THE CONTRACTOR WILL BE RESPONSIBLE FOR CONTACTING LOCAL UTILITIES FOR ASSISTANCE IN LOCATING UTILITIES BOTH PRIOR TO BID PROPOSALS AND DURING INSTALLATIONS. THE CONTRACTOR MUST FULLY COMPLY WITH THE SOUTH CAROLINA UNDERGROUND UTILITIES DAMAGE PREVENTION ACT, GENERAL STATUTES 58-35, SECTIONS 20 THROUGH 120 AND ALL APPLICABLE STATUTES AND STATE APPROVED REQUIREMENTS.


4. WHEN THE CONTRACTOR IS UNABLE TO COMPLETE HIS WORK AS SHOWN ON THE PLANS BECAUSE OF AN EXISTING UTILITY, CONTRACTOR SHALL STAKE THE LOCATION OF THE UTILITY PRIOR TO PROCEEDING AND CONTACT THE ENGINEER.
5. THE CONTRACTOR SHALL NOTIFY ALL PUBLIC AGENCIES, THE OWNER, THE ENGINEER AND ALL OTHER CONCERNED PARTIES WHEN CONSTRUCTION IS TO COMMENCE SO THAT INSPECTIONS AND OTHER SITE VISITS MAY BE SCHEDULED.
6. DATA REQUIRED FOR PREPARATION OF AS-BUILT DRAWINGS SHALL BE OBTAINED BY THE CONTRACTOR AT THE TIME OF INSTALLATION. THIS DATA SHALL BE ACCUMULATED BY THE CONTRACTOR AND COORDINATED WITH THE PROJECT INSPECTOR ON A DAILY BASIS DURING THE CONSTRUCTION PERIOD AND BE SUBMITTED TO THE PROJECT INSPECTOR IN A NEAT AND LEGIBLE MANNER AFTER COMPLETION OF THE PROJECT.
7. ALL MATERIALS AND/OR INSTALLATION, UNLESS OTHERWISE NOTED, SHALL BE IN ACCORDANCE WITH THE LATEST EDITION OF THE AUTHORITY'S WATER AND SEWER STANDARDS AND SPECIFICATIONS, AND WHERE APPLICABLE, ALL FEDERAL, SOUTH CAROLINA AND LOCAL ORDINANCES, REGULATIONS, SPECIFICATIONS AND PERMITS.

8. SPECIAL NOTE: PRIOR TO ANY EXCAVATION THE CONTRACTOR IS REQUIRED TO CONTACT HORRY TELEPHONE COOPERATIVE FOR CABLE LOCATIONS AT 365-2151. THIS PROJECT HAS SEVERAL CABLES OFF EDGE OF PAVEMENT THAT THE CONTRACTOR WILL BE REQUIRED TO LOCATE AND EXPOSE PRIOR TO THE INSTALLATION OF ANY MATERIALS.
9. REPLACE IN KIND ALL AREAS PROPERTY OWNER HAS DEVELOPED SPECIAL GRASS, TURF, OR LANDSCAPING. ALL DISTURBED AREAS ARE TO BE RAKED AND SEEDDED.

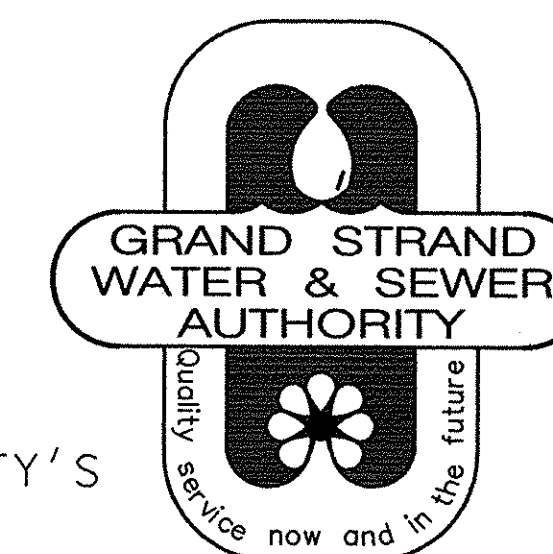

PREPARED BY:
GRAND STRAND WATER & SEWER AUTHORITY
PO BOX 1537 CONWAY, SC 29526

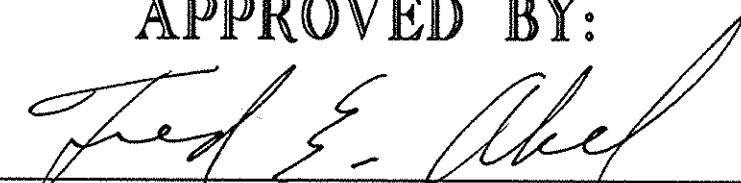APPROVED BY:

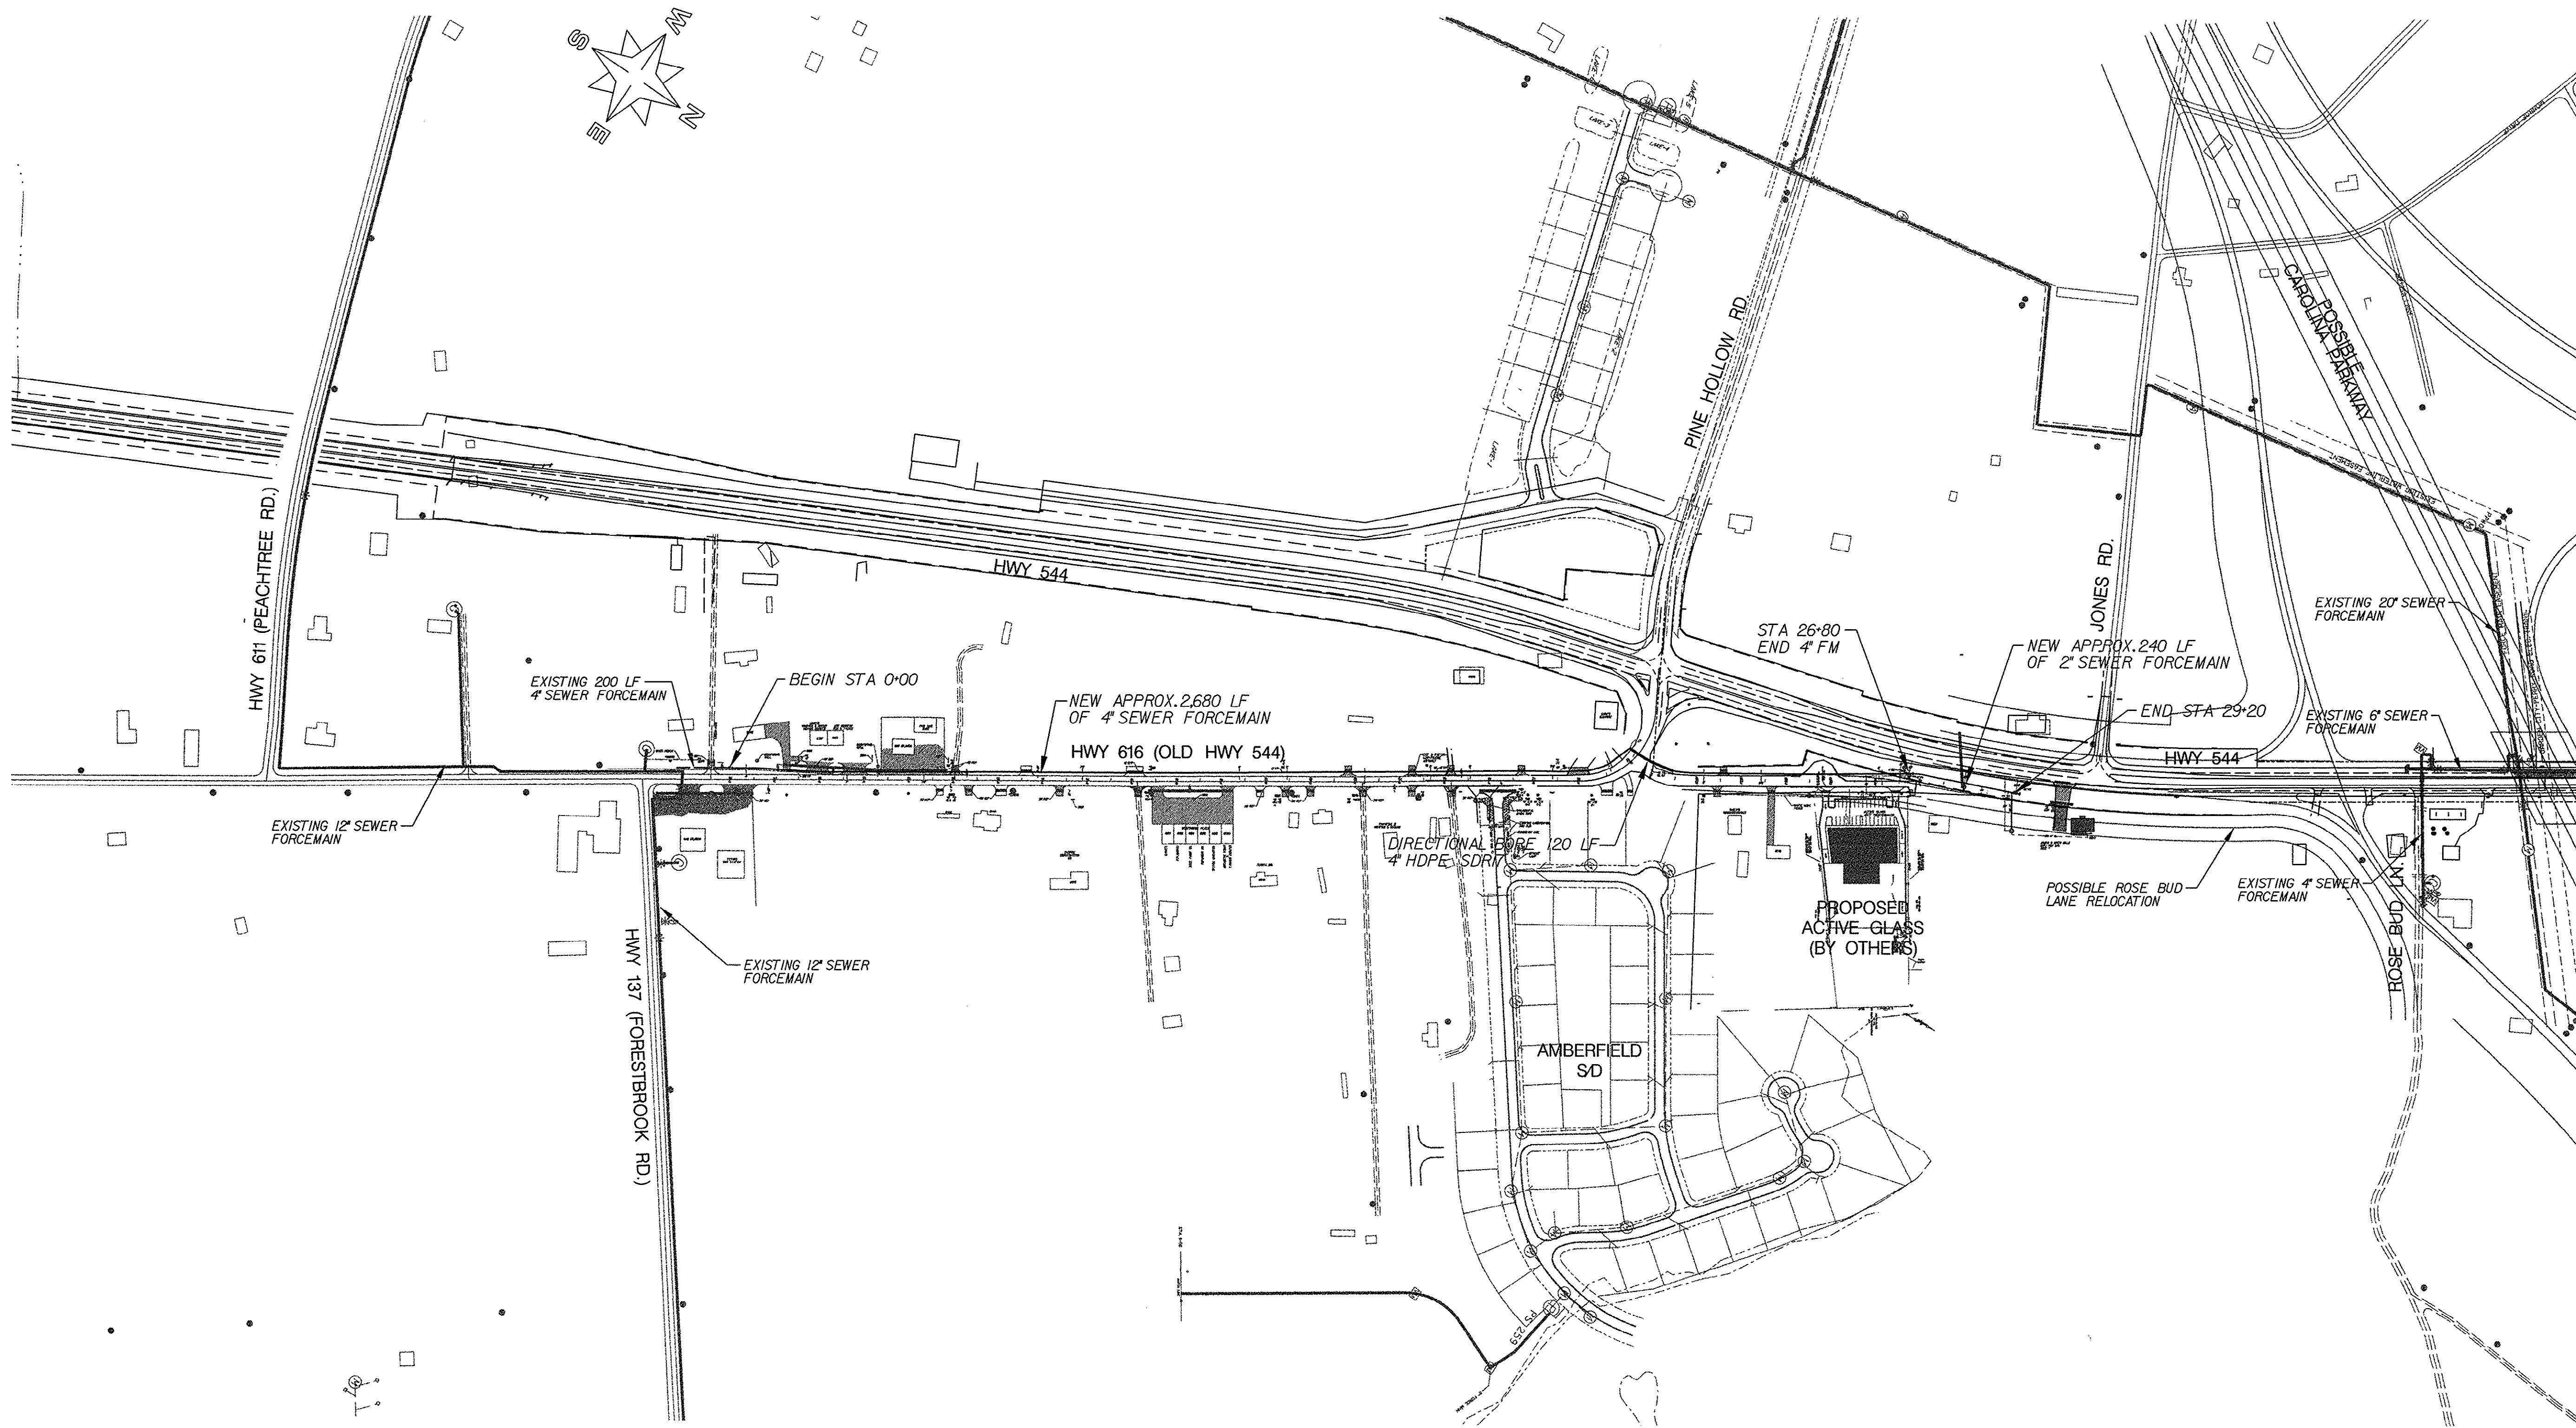FRED E. AKEL P.E. #12859
HWY 616 SEWER EXTENSION
(FORESTBROOK RD. TO PINE HOLLOW RD.)
PROJECT #831-25
CONTACT #8108-00
JUNE 2000 A.D.



OVERALL LAYOUT

SCALE: 1" = 200'

100 0 200 400 600 FEET



HWY 616 SEWER EXTENSION (FORESTBROOK RD. TO PINE HOLLOW RD.) OVERALL LAYOUT

GRAND STRAND WATER & SEWER AUTHORITY
P.O. BOX 1537, CONWAY, SC 29526
TELEPHONE 803 347-4641 OR 448-1686

SC DHEC CONSTRUCTION
PERMIT #25,813 (8/25/00)
PROJECT #831-25
CONTACT #S108-00

DATE: JUNE 2000 A.D.

SCALE: HOR. 1" = 200'

FILENAME:

DRAWN BY
RAY THOMPKINS




CHECKED BY
JIM HEMBREE

APPROVED BY

FRED E. AKEL P.E. #12859

SHEET 2 OF 4

DWG # 17-108-002/4-S

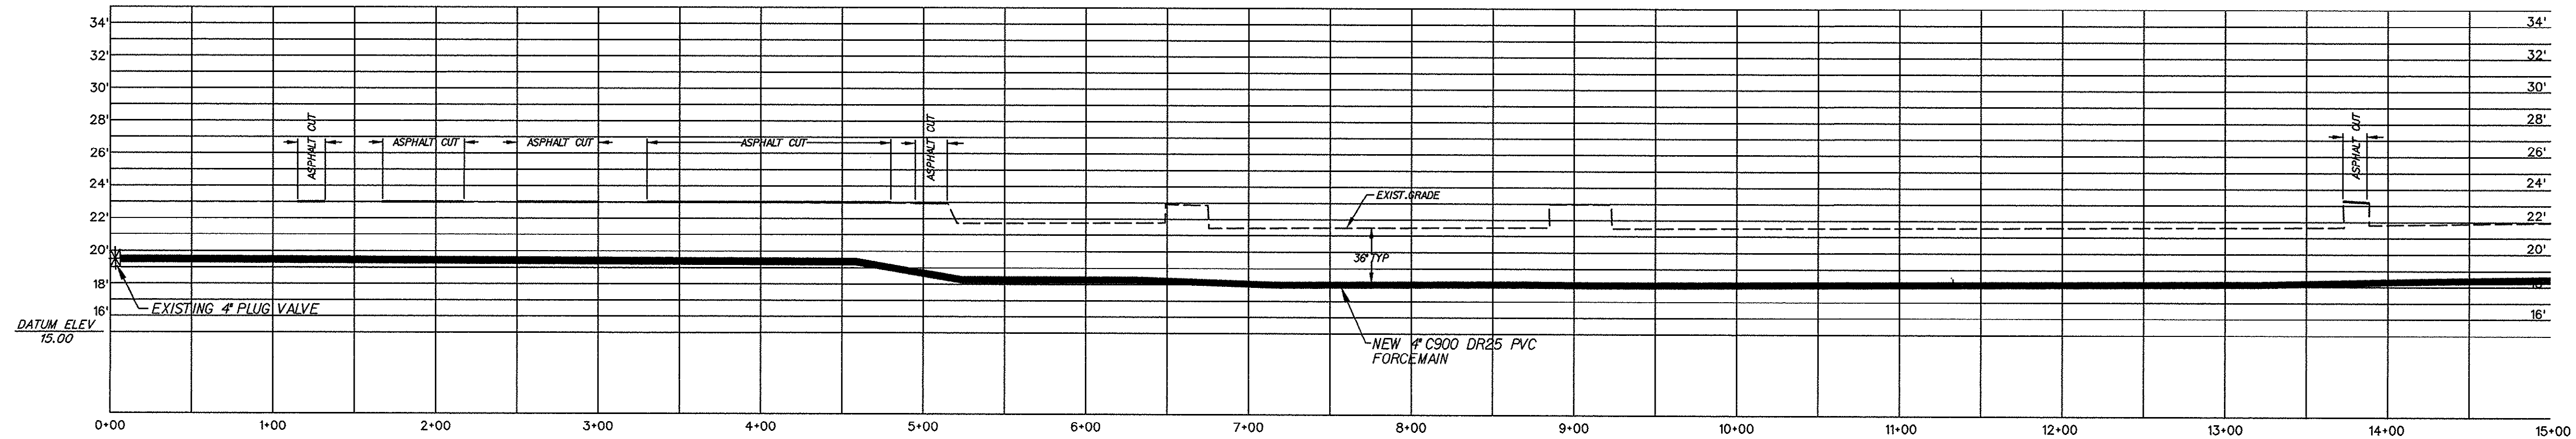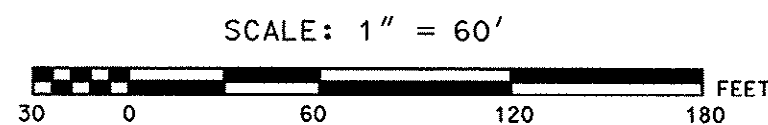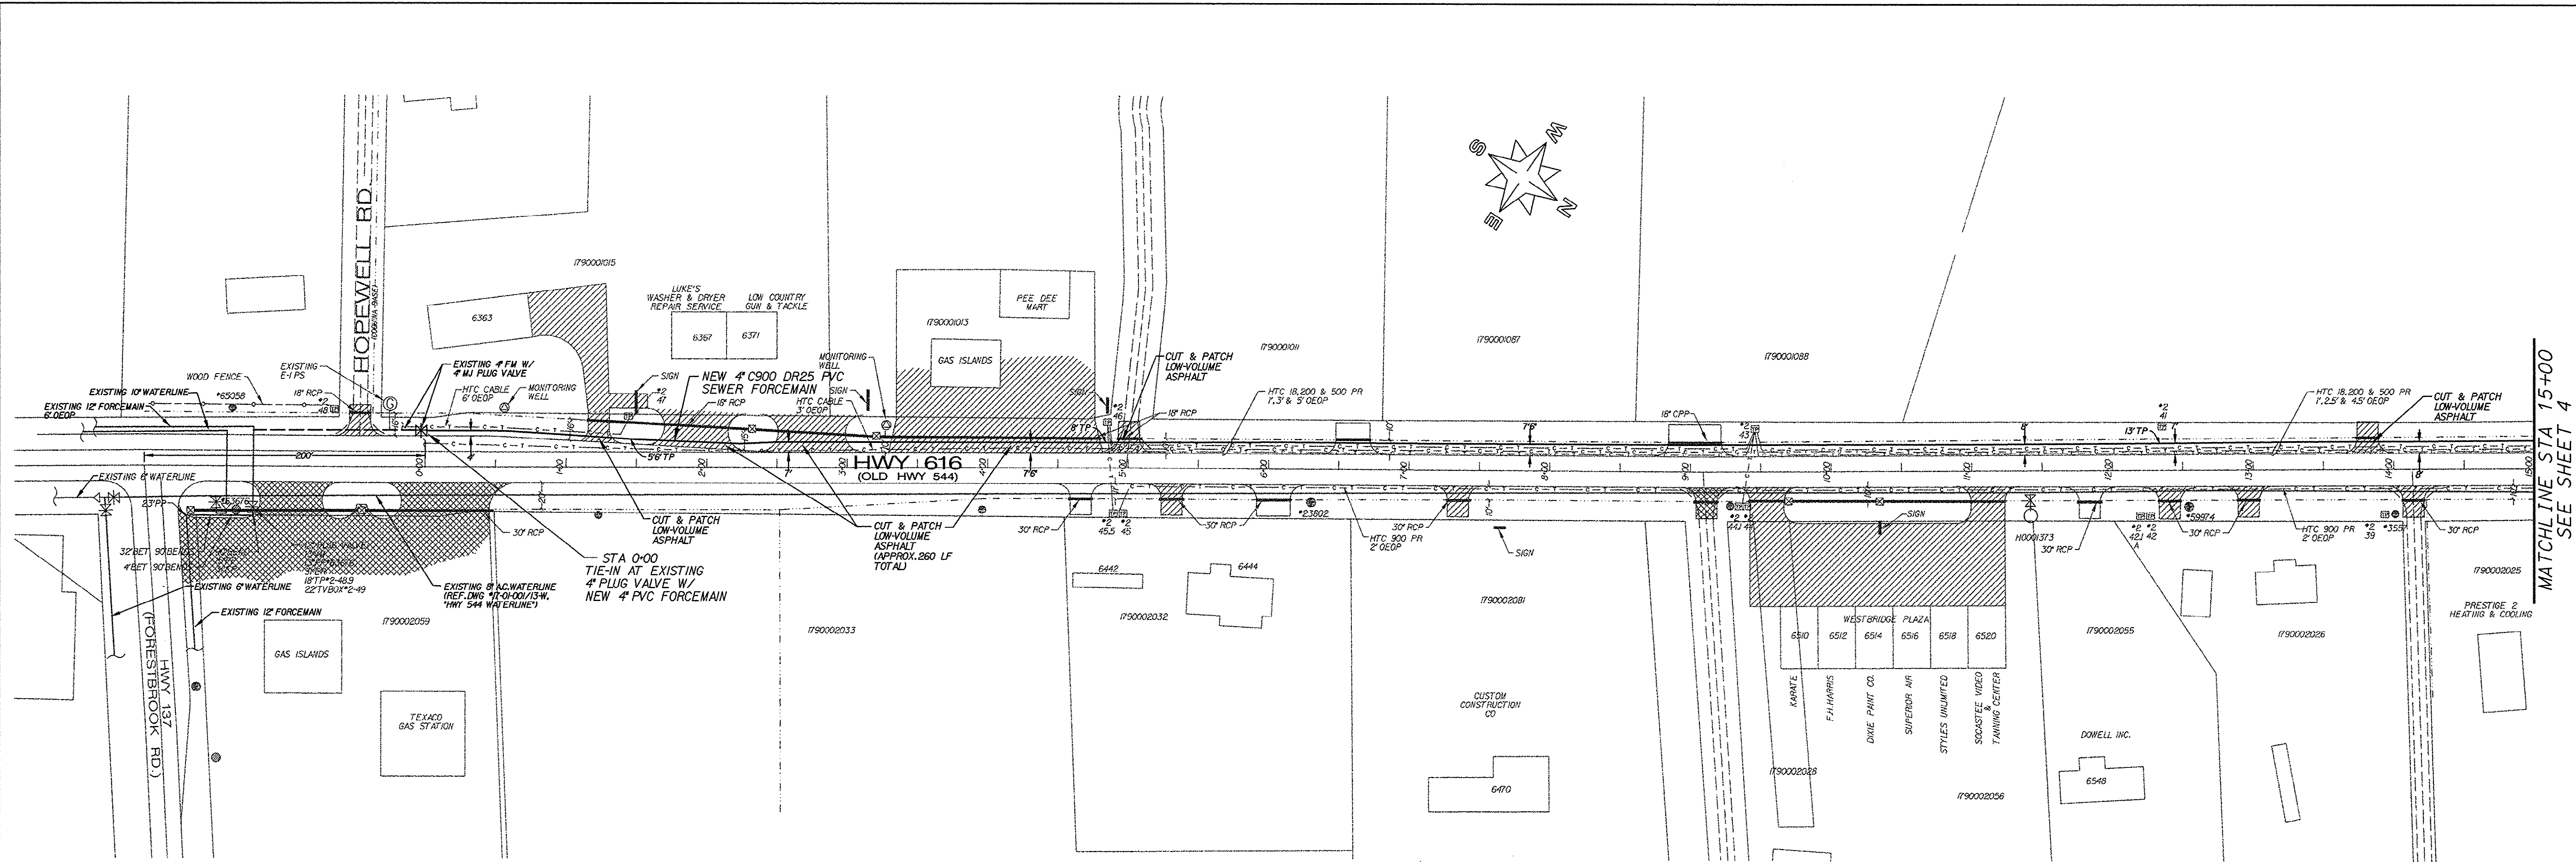


THESE DRAWINGS REFLECT
AS-BUILT
CONDITIONS

REVIEWED BY: *[Signature]* DATE: 11-28-00
INSPECTIONS

REVIEWED BY: *[Signature]* DATE: _____
ENGINEERING

GRAND STRAND WATER AND SEWER AUTHORITY

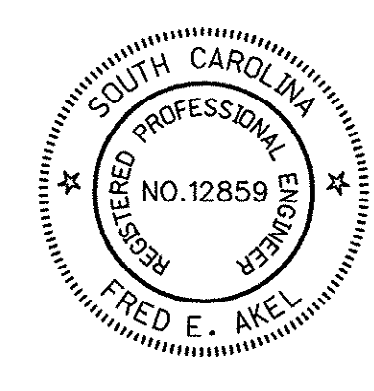

REVISION		DATE
BY	DATE	
DRT	11/8/00	
1/ AS-BUILT		

HWY 616 SEWER EXTENSION

(FORESTBROOK RD. TO PINE HOLLOW RD.)

GRAND STRAND WATER & SEWER AUTHORITY

P.O. BOX 1157, CONWAY, SC 29526
TELEPHONE 803 347-4641 OR 48-1686

SC DHEC CONSTRUCTION PERMIT #25,813 (8/25/00)
PROJECT #831-25
CONTACT #S108-00

DATE: JUNE 2000 A.D.

SCALE: HOR. 1" = 60'
VER. 1" = 6'

FILENAME:





DRAWN BY	RAY THOMPkins
CHECKED BY	JIM HEMBREE
APPROVED BY	

FRED E. AKEL P.E. #12859


SHEET 3 OF 4

DWG # 17-108-0034-S

MATCHLINE STA 15+00
SEE SHEET 3

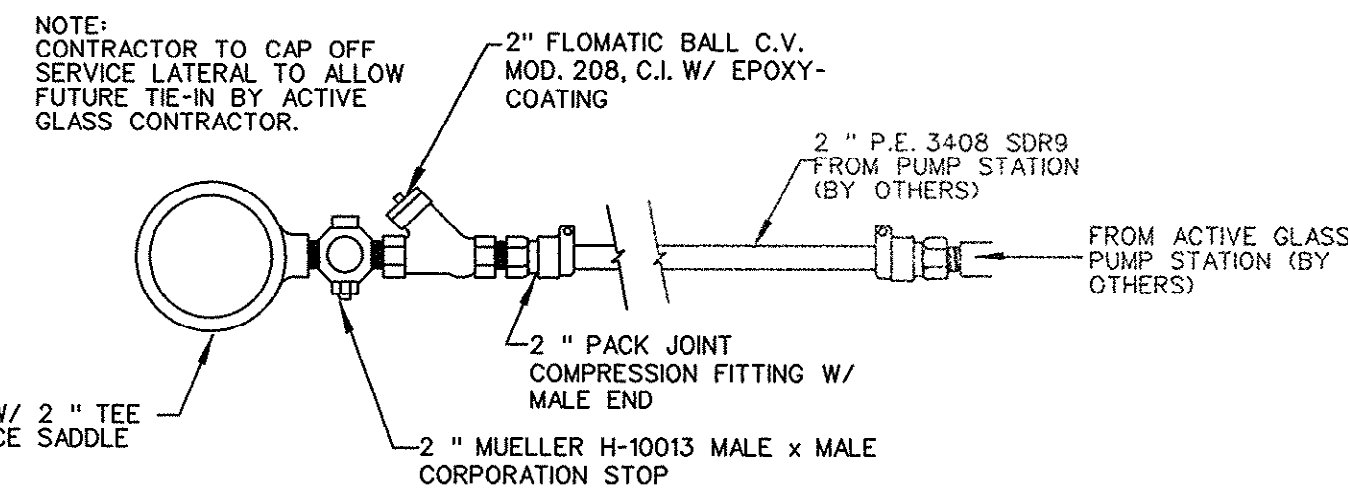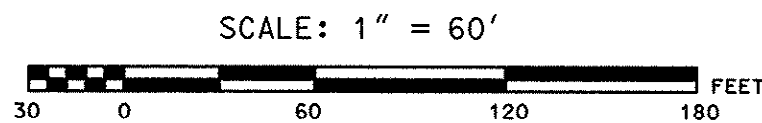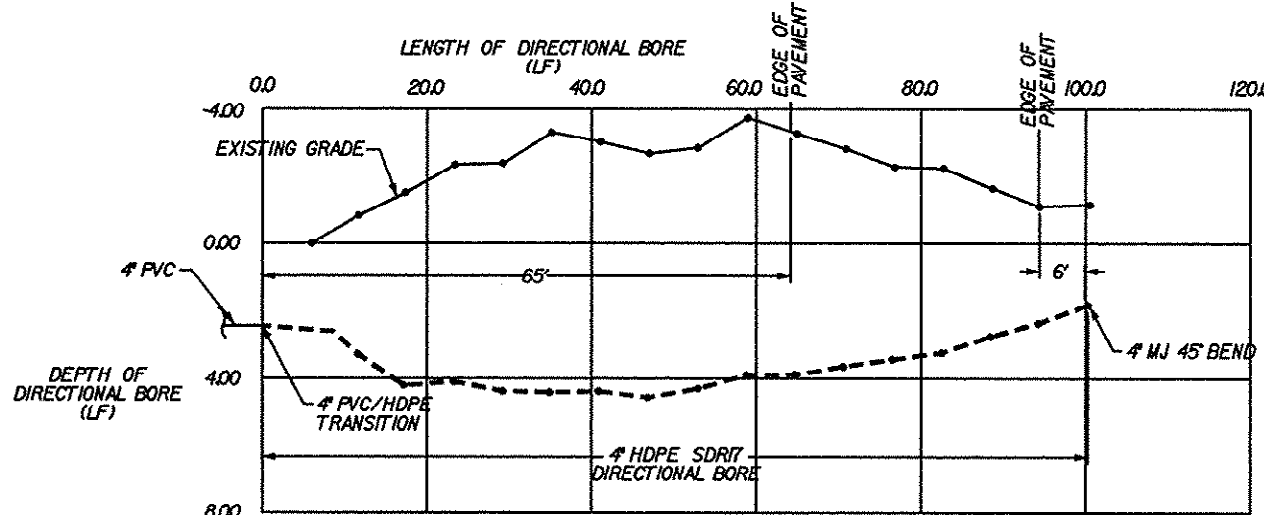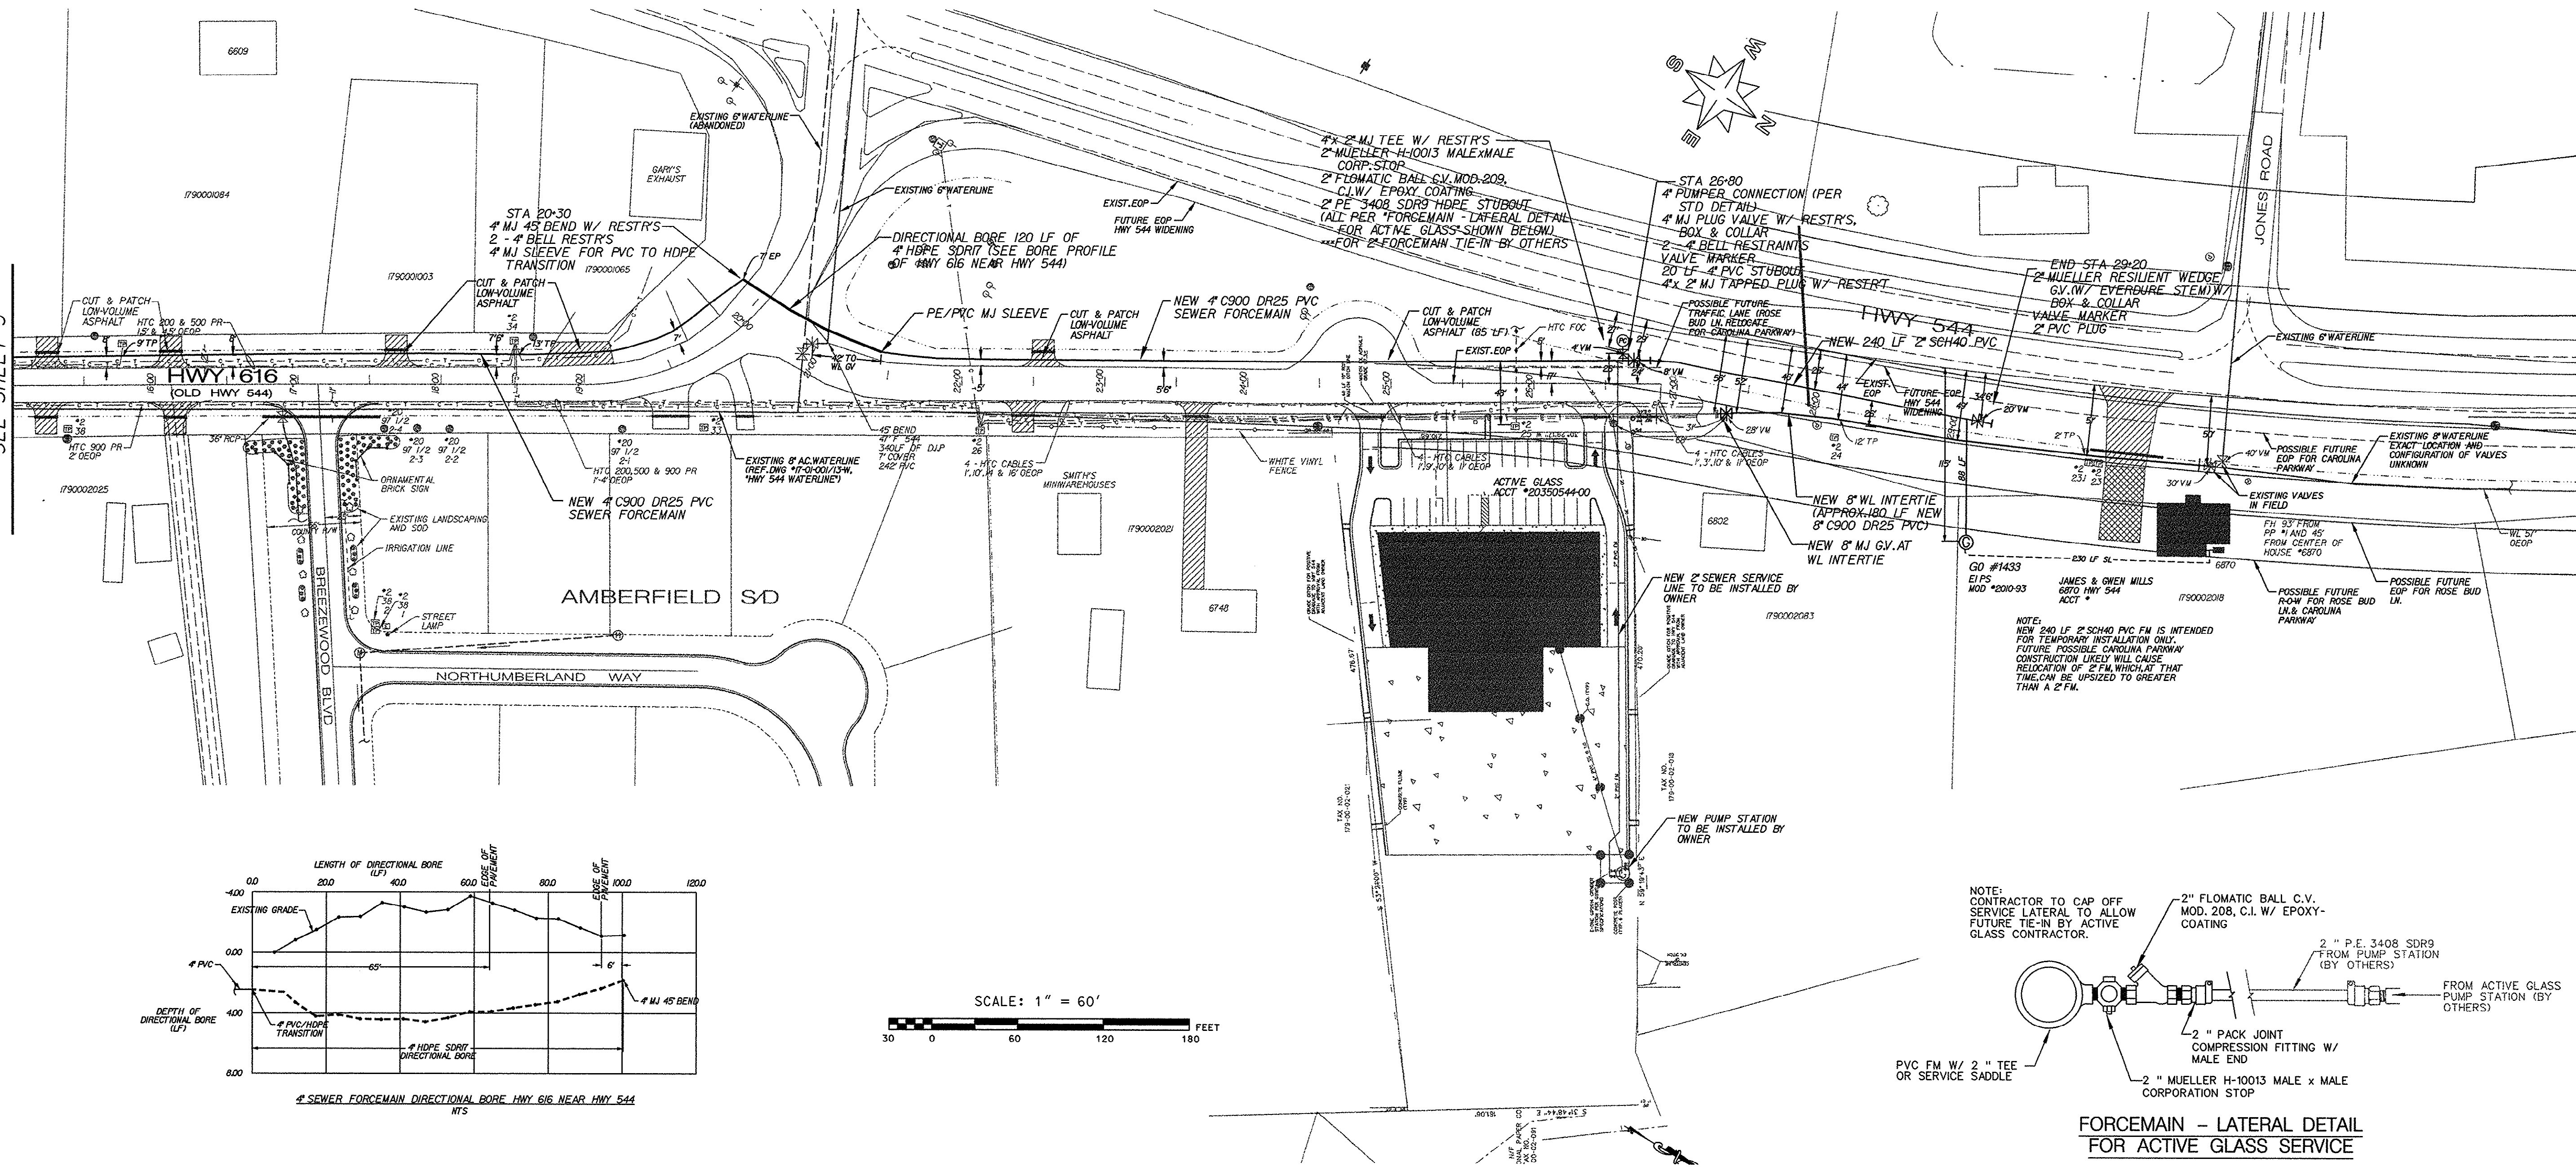

FORCEMAIN - LATERAL DETAIL
FOR ACTIVE GLASS SERVICE

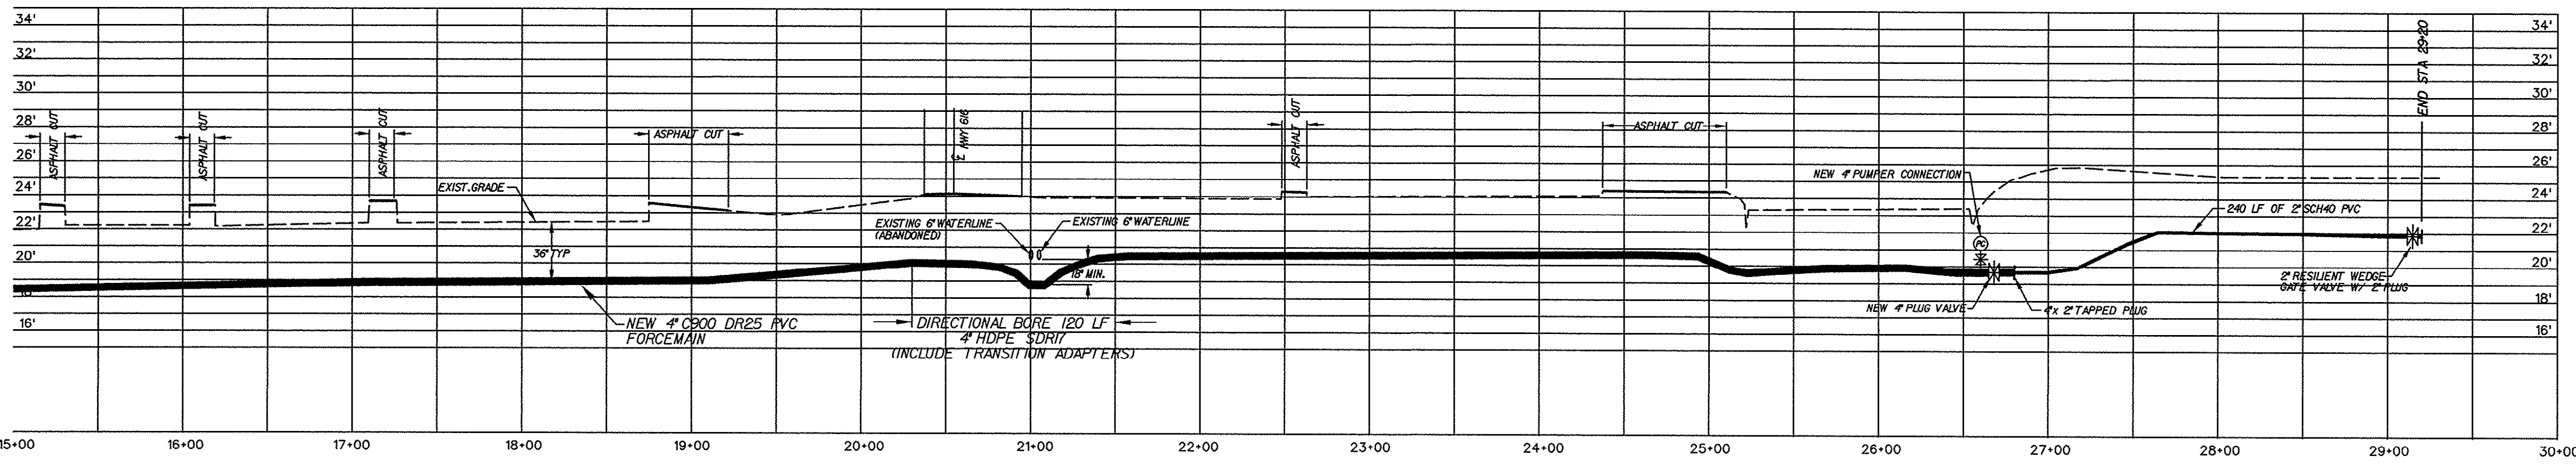

THESE DRAWINGS REFLECT
AS-BUILT
CONDITIONS

REVIEWED BY: *[Signature]* 11-28-00 DATE
INSPECTIONS

REVIEWED BY: *[Signature]* DATE
ENGINEERING

GRAND STRAND WATER AND SEWER AUTHORITY



DATE	11/28/00
BY	DWT
REVISION	
17/AS-BUILT	

HWY 616 SEWER EXTENSION (FORESTBROOK RD. TO PINE HOLLOW RD.)

GRAND STRAND WATER & SEWER AUTHORITY

P.O. BOX 1437, CONWAY, SC 29526
TELEPHONE 803 347-4641 OR 448-1686

SC DHEC CONSTRUCTION PERMIT #25-813 (8/25/00)	
PROJECT #831-25 CONTACT #S108-00	
DATE: JUNE 2000 A.D.	
SCALE:	HOR. 1" = 60' VER. 1" = 6'
FILENAME:	
DRAWN BY	RAY THOMPKINS
CHECKED BY	JIM HEMBREE
APPROVED BY	
FRED E. AKEL P.E. #12859	
SHEET 4 OF 4	
DWG #	17-108-0044-S