



INTERSECTION OF STATE ROADS 707 AND 544

- 1 TIE TO EXIST. 8" WATERLINE
1-8" TAPPING TEE VALVE
1-8" 90° BEND
2-THRUST BLOCKS
- 2 1-8" TEE
2-8" VALVES
1-8" PLUG
1-FIRE HYDRANT
- 3 1-8" 90° BEND
1-THRUST BLOCK
- 4 2-8" 45° BENDS
2-THRUST BLOCKS
- 5 1-8" 12" CROSS
2-8" VALVES
1-12" VALVE
1-8" PLUG
1-12" 22 1/2° BEND
- 6 1-12" 22° BEND
1-12" 45° BEND
- 7 1-12" TEE
2-12" VALVES
2-12" PLUGS
2-THRUST BLOCKS
- 8 1-8" TEE
2-8" VALVES
1-THRUST BLOCK
- 9 1-8" 90° BEND
1-THRUST BLOCK
- 10 1-8" TEE
3-8" VALVES
1-THRUST BLOCK
- 11 1-8" TEE
2-8" VALVES
1-THRUST BLOCK
- 12 1-8" TEE
1-8" VALVE
1-THRUST BLOCK
(FUTURE FIRE HYD.)
- 13 1-8" 90° BEND
1-THRUST BLOCK
- 14 1-8" 90° BEND
2-8" VALVES, 1-8" PLUG
1-8" TEE
1-4" 8" REDUCER
1-4" TEE
2-THRUST BLOCKS
- 15 1-8" TEE
1-8" VALVE & PLUG

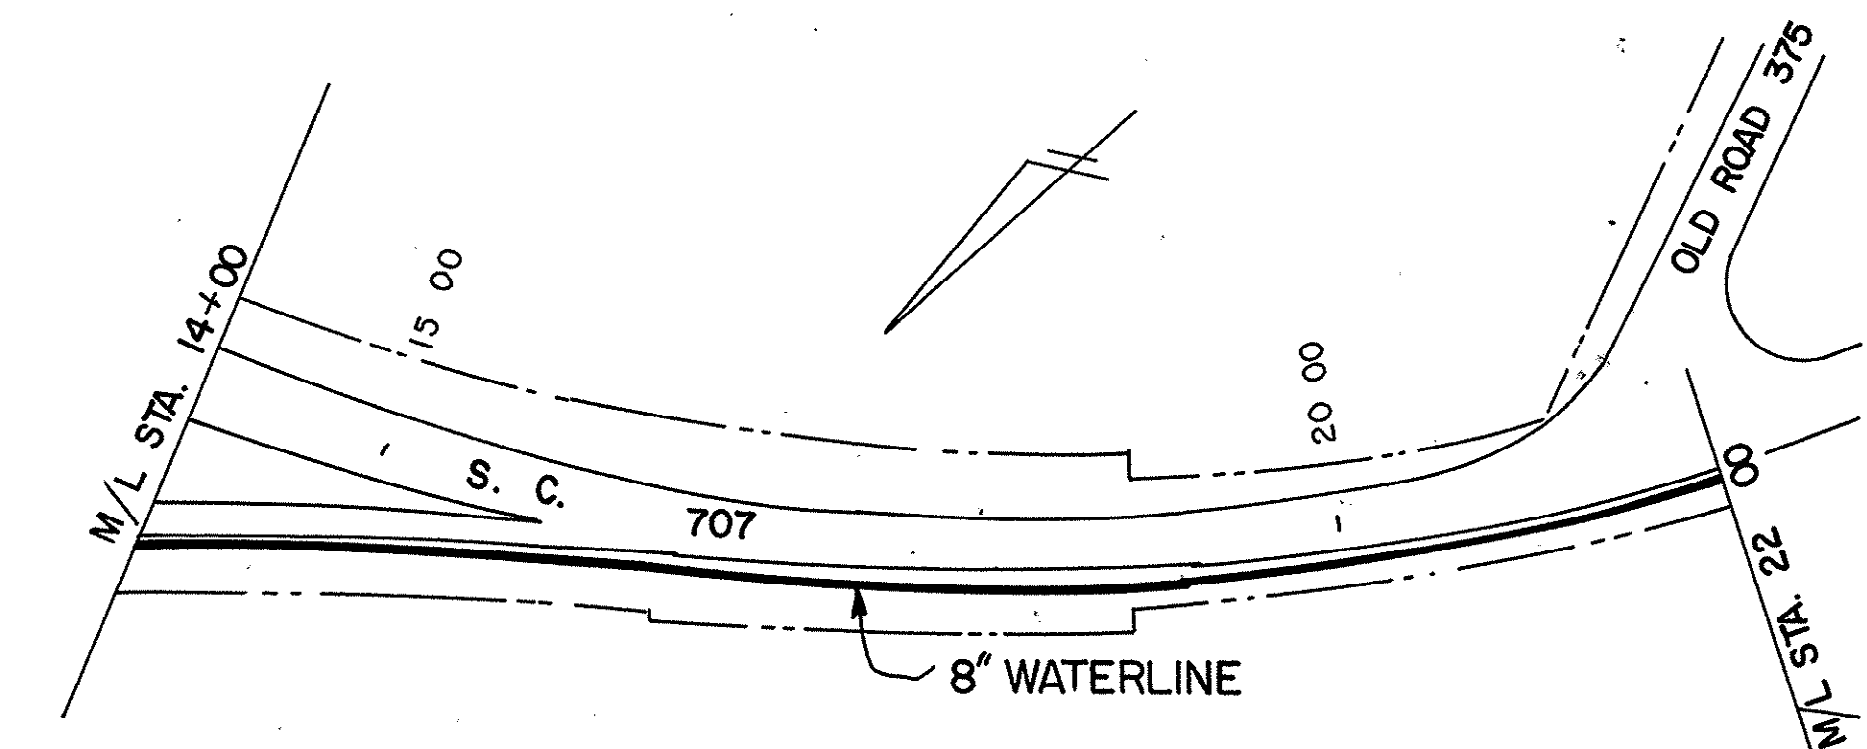


STATE ROAD 707

NOTE: WATERLINE IS LOCATED 4' FROM EDGE OF PAVEMENT
UNLESS OTHERWISE NOTED ON PLANS.

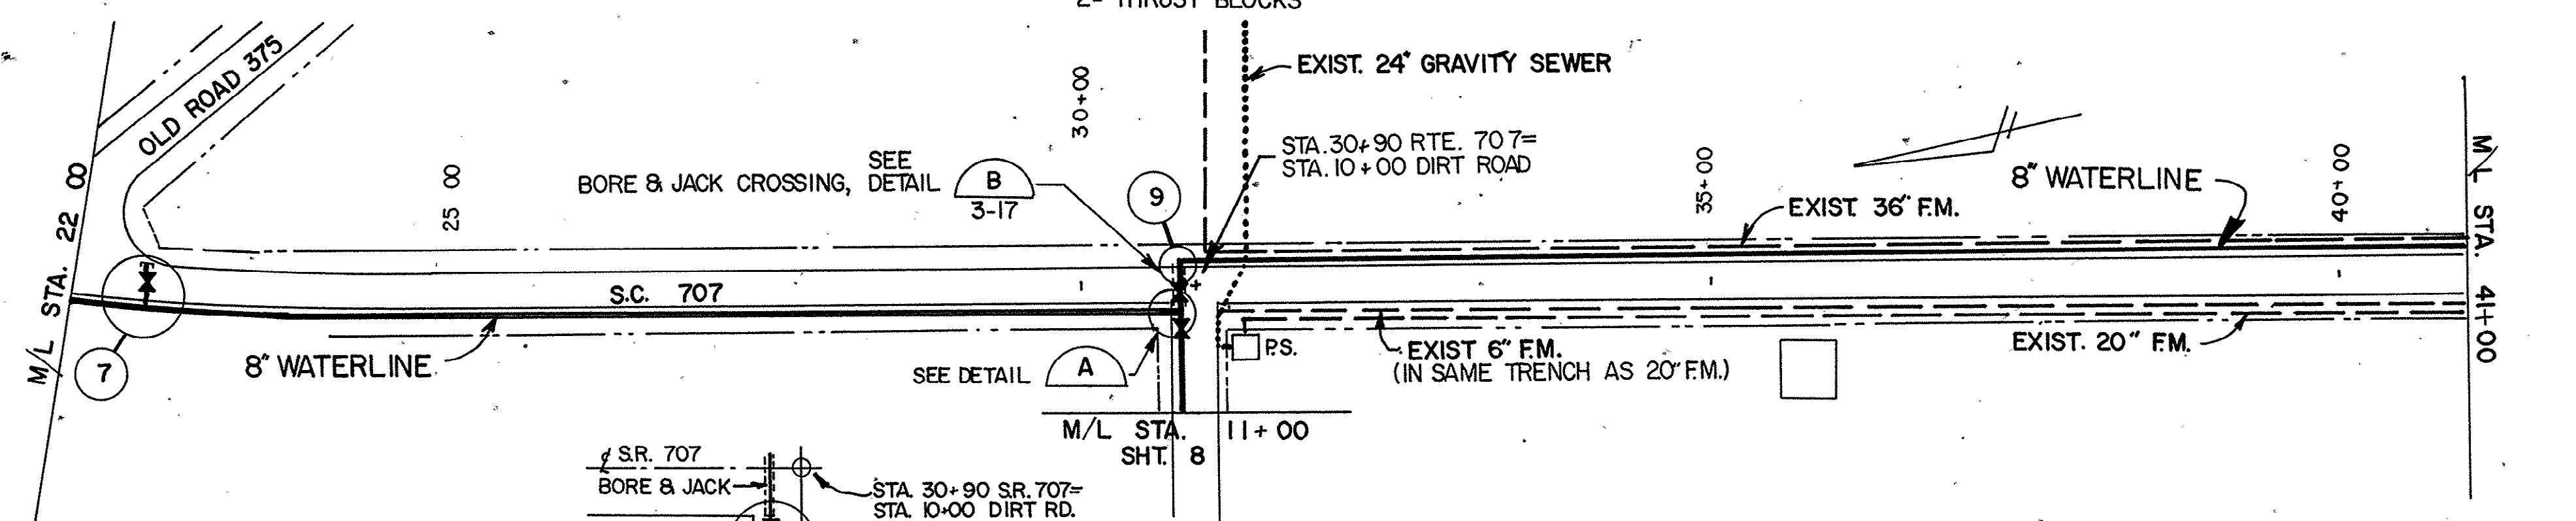


STATE ROAD 707

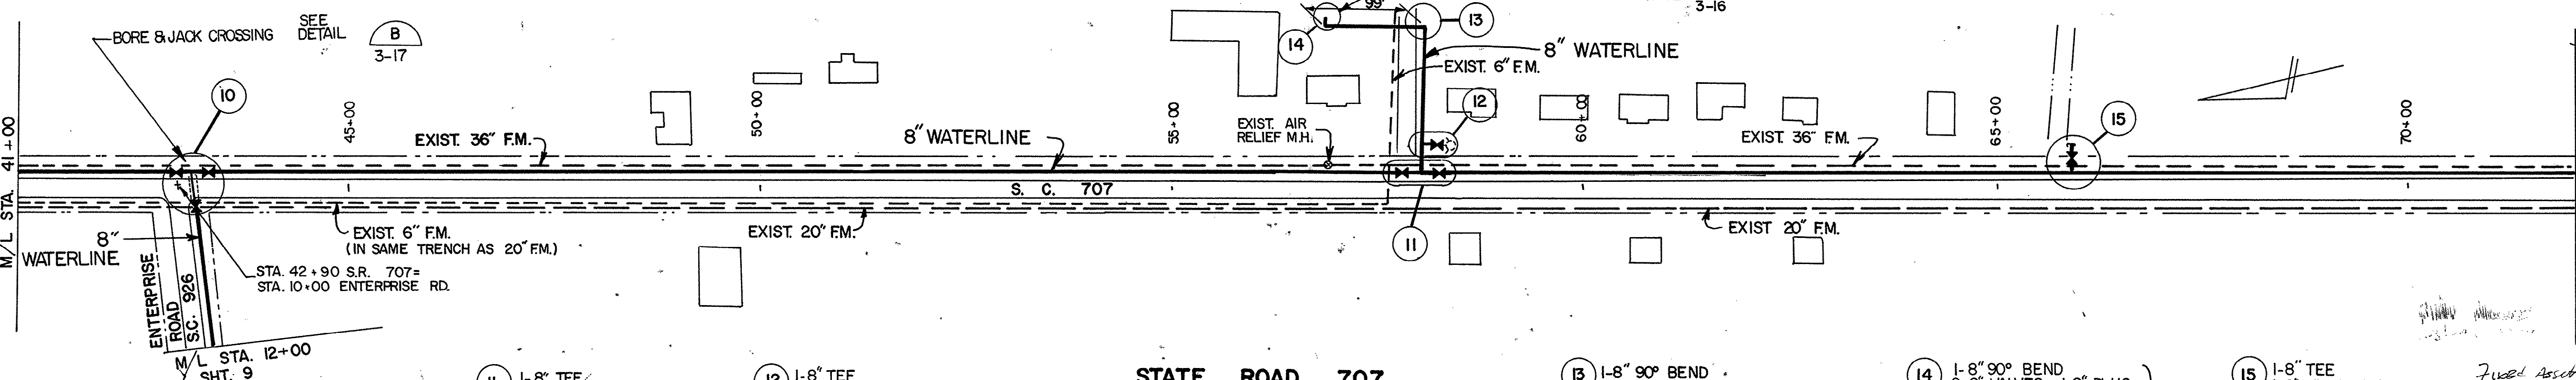

STATE ROAD 707

RECORD DRAWING

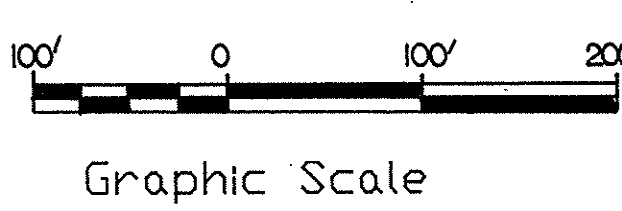

CH2M
HILL

This Drawing is a copy
of an original Design
by CH2M Hill. It has
been Traced By GSWSA
For Microfilming


No.	Date	REVISION	By	Appd.

**SOCASTEE WATER
SYSTEM EXTENSION**

**GRAND STRAND
WATER & SEWER AUTHORITY
CONWAY, S. C.**


**8" WATERLINE
ALONG STATE ROAD 707**

SHEET 3
OF 18
Date 6-81
Traced 12-85
No. CA68522.91

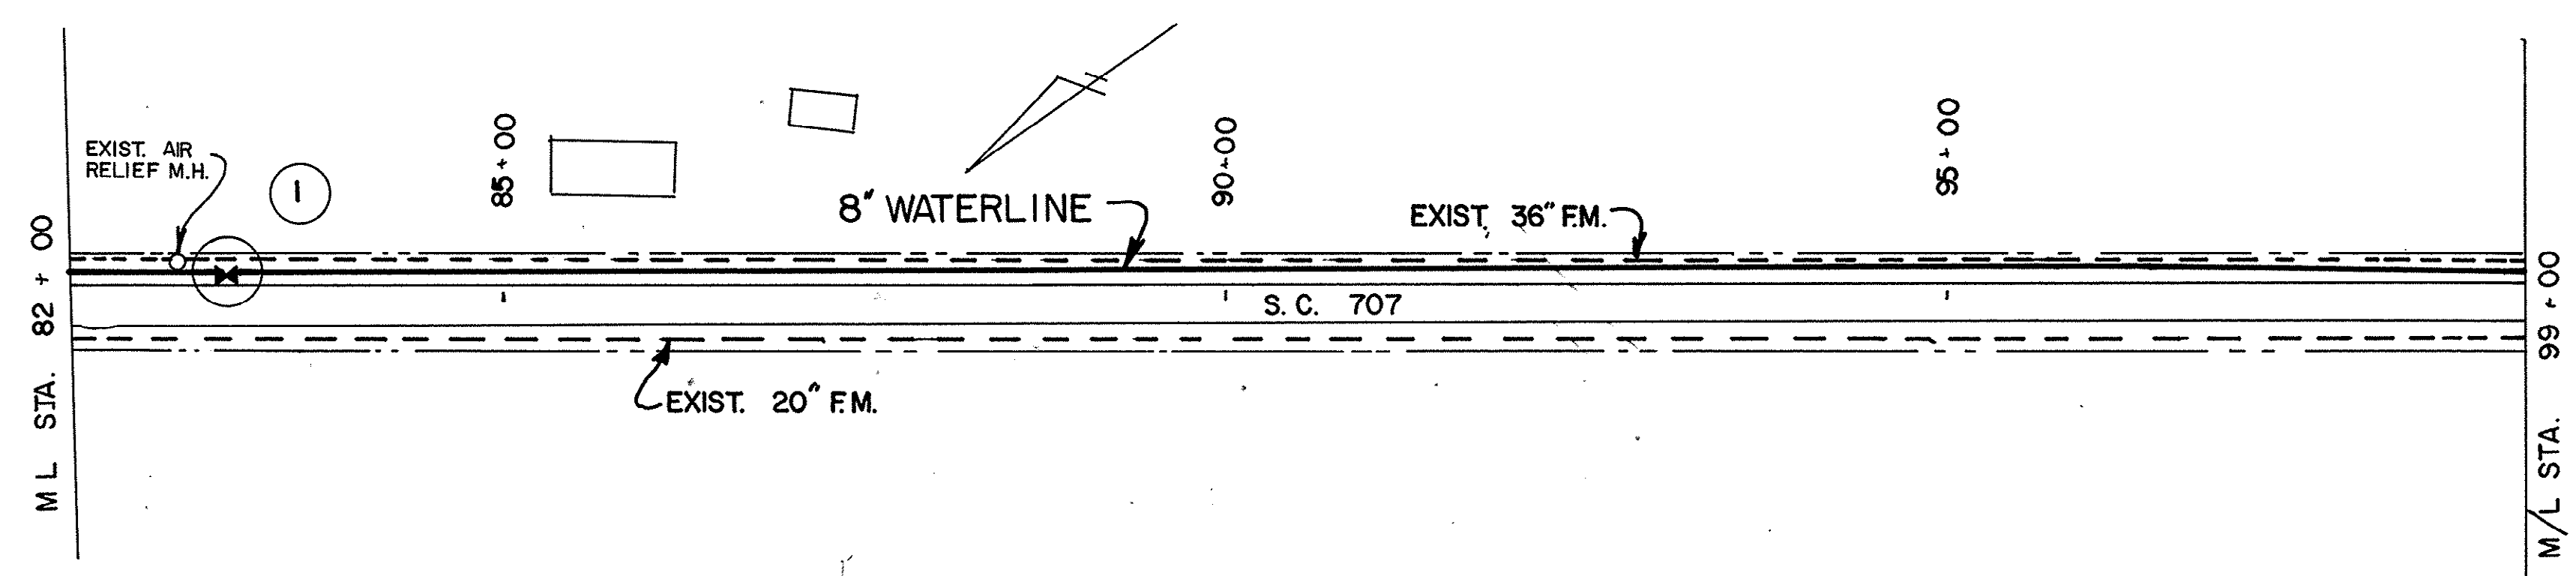

STATE ROAD 707

STATE ROAD 707

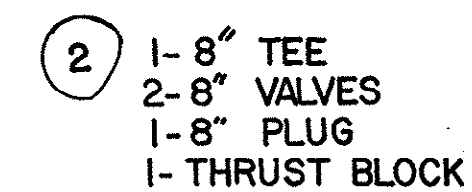


3 1-8" TEE
1-8" VALVE & PLUG
1-THRUST BLOCK

4 1-8" TEE
2-8" VALVES
1-8" PLUG
1-THRUST BLOCK



6 1-8" TEE
2-8" VALVES
1-8" PLUG
1-THRUST BLOCK


10-01-002/14-w

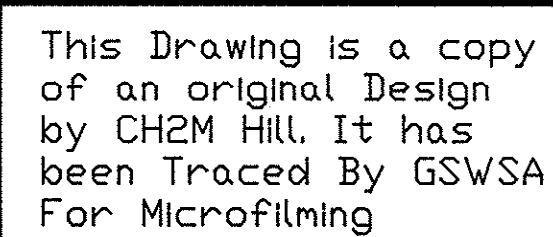

Bv	Annd
----	------

GRAND STRAND
WATER & SEWER AUTHORITY
CONWAY, S. C.

SHEET 4 OF 18
Date 6-81 Traced 12-85
Dwg. NO. CA68522.91

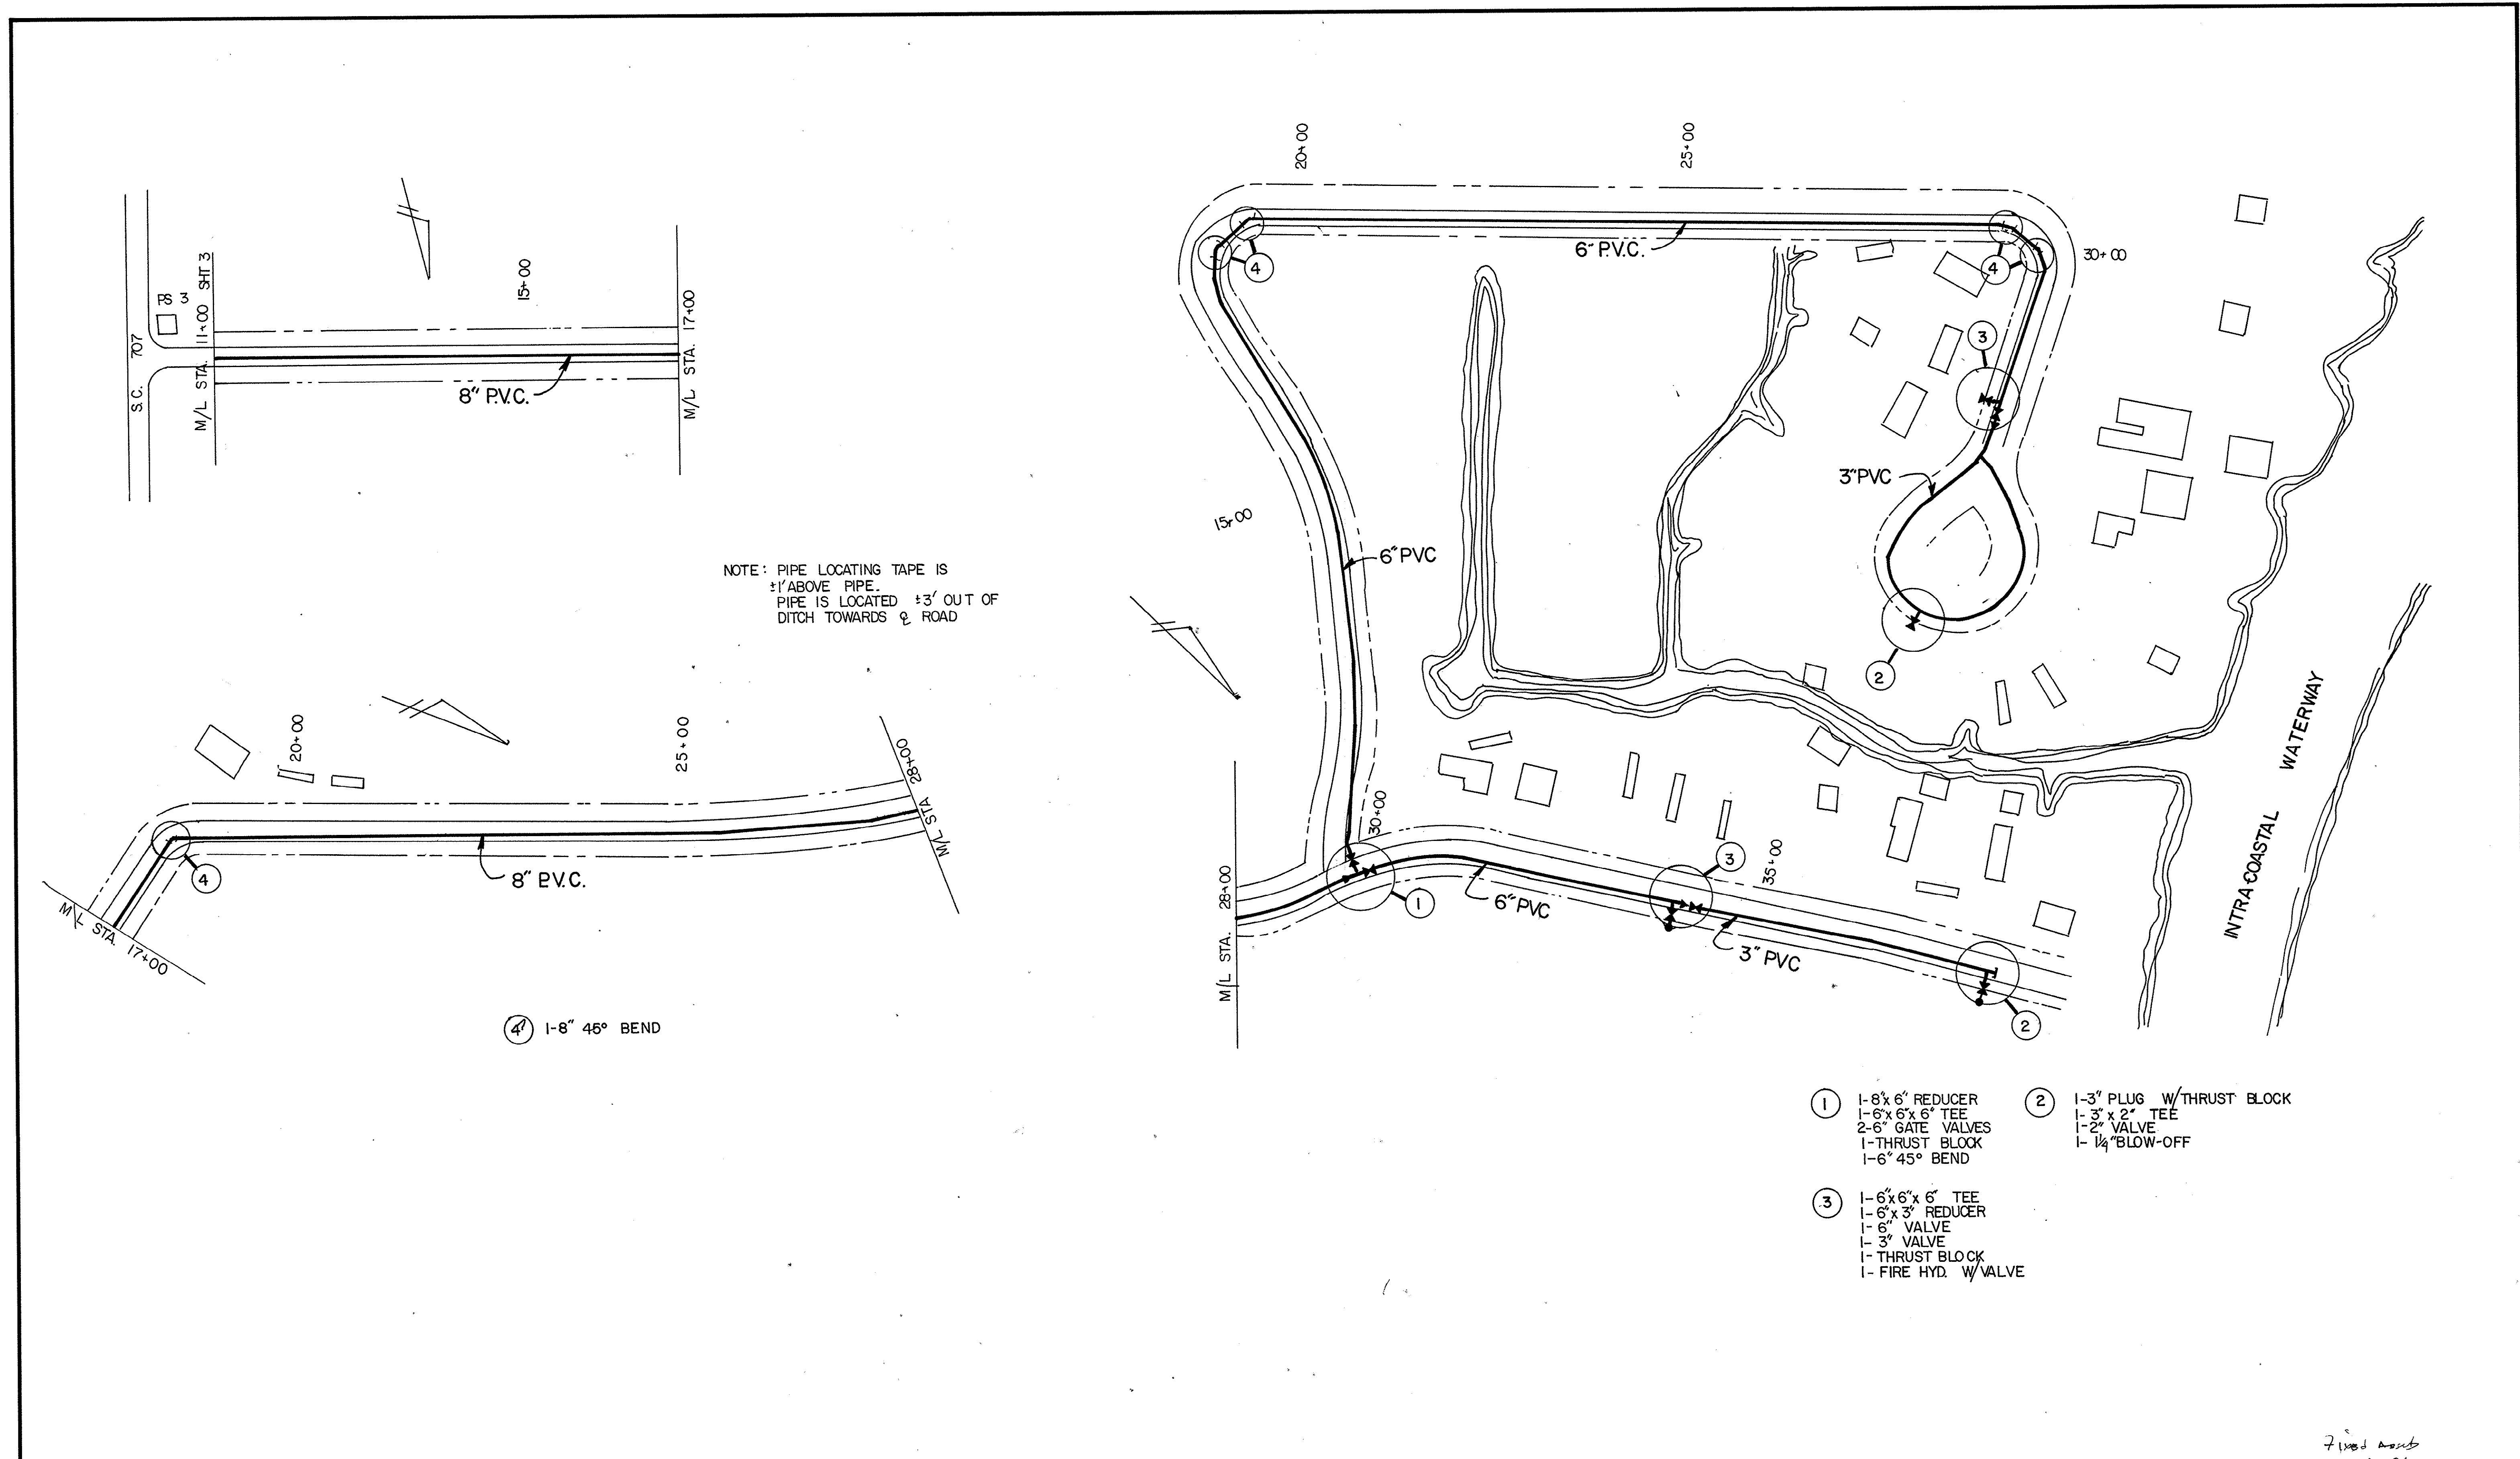


RECORD DRAWING

10-01-006/14-w

100 0 100 200 Graphic Scale	CH2M HILL	This Drawing is a copy of an original Design by CH2M HILL. It has been Traced By GSWSA For Microfilming	No. Date	REVISION	By Appd.	SOCASTEE WATER SYSTEM EXTENSION	GRAND STRAND WATER & SEWER AUTHORITY CONWAY, S. C.	8" & 6" WATERLINE ALONG DIRT ROAD OFF 707	SHEET 8 OF 18 Date 6-81 Traced 12-85 Dwg. No. CA68522.91
---	----------------------	--	-----------------	-----------------	-----------------	--	---	--	---

S. C. 707

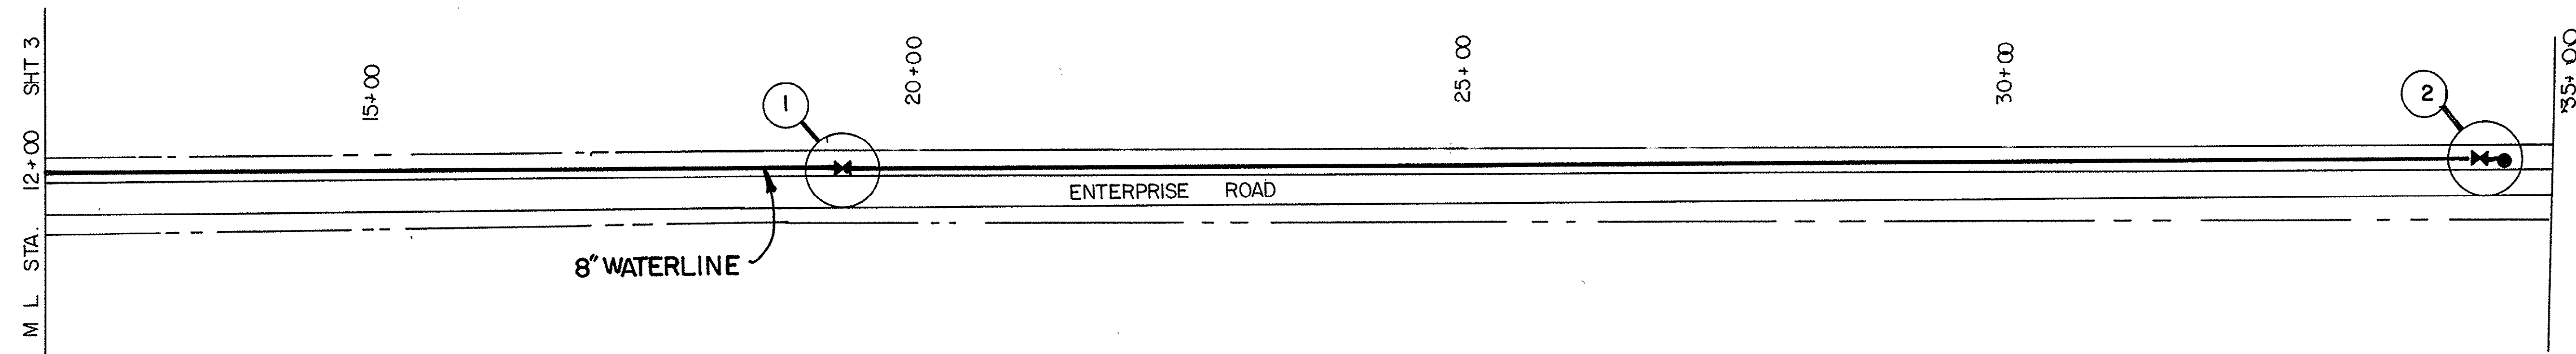

NOTE: WATERLINE IS LOCATED 4' FROM THE EDGE OF PAVEMENT UNLESS OTHERWISE SHOWN

ENTERPRISE ROAD (S-926)

① 1-8" VALVE

2 1-8" VALVE
1-BLOW OFF

RECORD DRAWING

10-01-007/14-w

 Graphic Scale	CH2M HILL	This Drawing is a copy of an original Design by CH2M HILL. It has been Traced By GSWSA For Microfilming	No.	Date	REVISION	By	Appd.	SOCASTEE WATER SYSTEM EXTENSION	GRAND STRAND WATER & SEWER AUTHORITY CONWAY, S. C.	8" WATERLINE ALONG ENTERPRISE RD.	SHEET 9 OF 18
											Date 6-81 Traced 12-85 Dwg. No. CA68522.91