




SCALE 1"=100

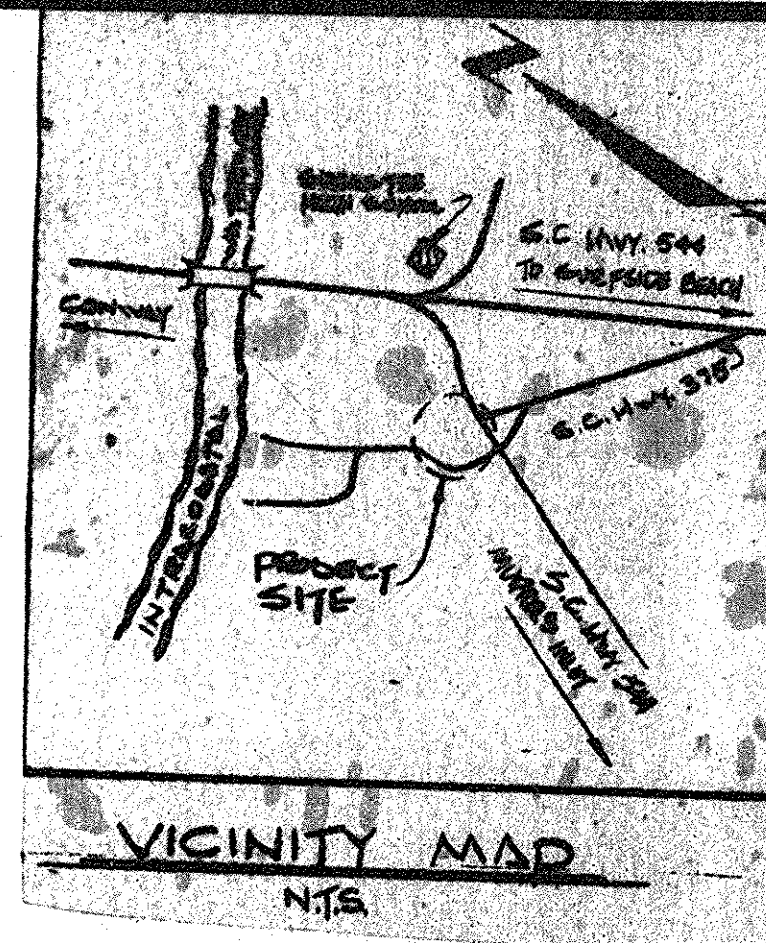

14-07-001/2-WS

MCDOWELL ENGINEERING
P. O. BOX 276
MURRELLS INLET, SOUTH CAROLINA



KENNETH MCDOWELL, P.E., R.L.S.

RIVERBANK PARK
SOCASSEE COMMUNITY

HUCKS, BELLAMY,
& HINSON

AS BUILT WATER PLAN

DRAWN J. HINSON
CHECKED
DATE 5/11/83
SCALE 1"=100'
JOB NO.
SHEET
OF SHEETS

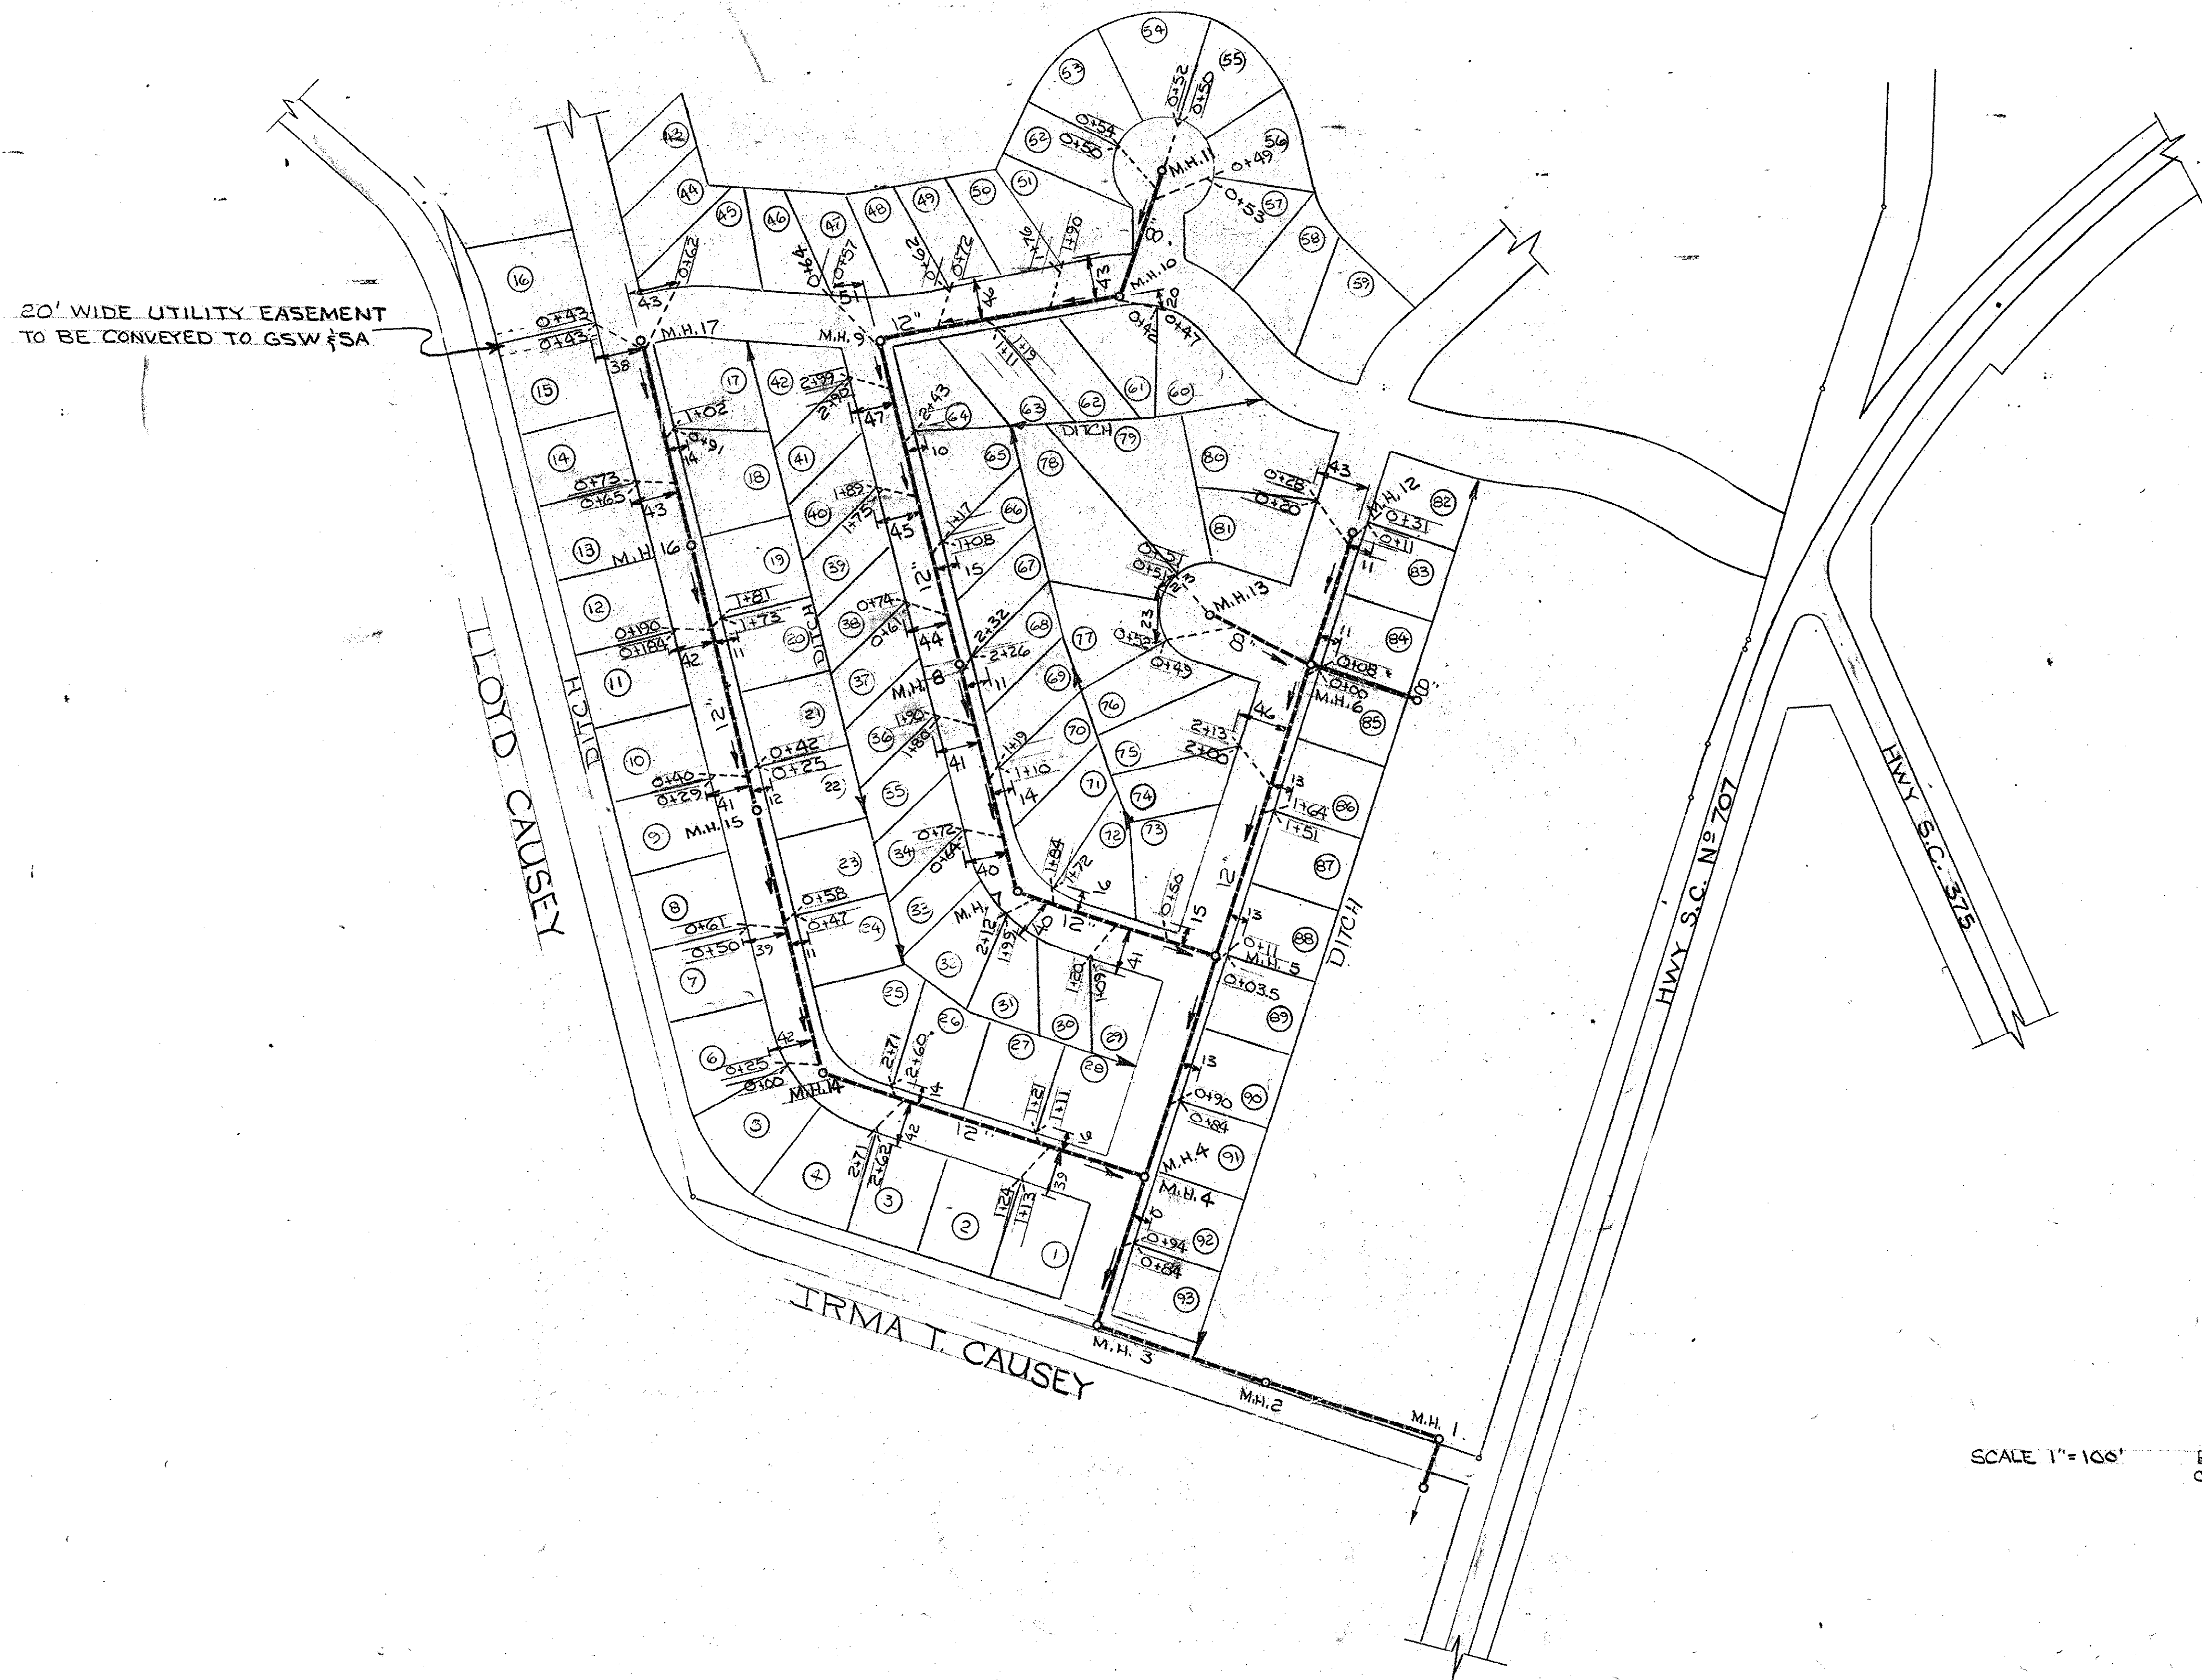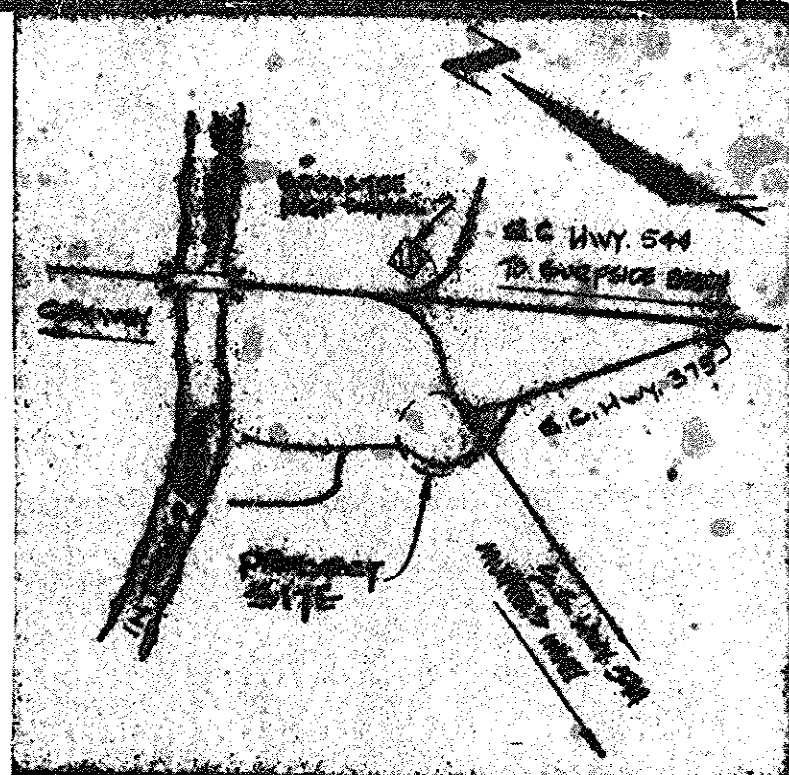

SCALE 1"=100'

Fixed Ascs
8-26-86
14-07-002/2-WS

MCDOWELL ENGINEERING
P. O. BOX 276
MURRELLS INLET, SOUTH CAROLINA

KENNETH MCDOWELL, P.E., R.L.S.

RIVERBANK PARK
SOCASTEE COMMUNITY

HUCKS, BELLAMY,
& HINSON
AS-BUILT GRAVITY SEWER PLAN

DRAWN J. HINSON
CHECKED
DATE 5/9/83
SCALE 1"=100'
JOB NO.
SHEET