


DWG NAME: P:\18005 CMC SOCASSTEE MOB AND RETAIL CONSTRUCTION\RECORD DRAWINGS\18005_2019-03-14-RECORD_DRAWING_RECOVER.DWG

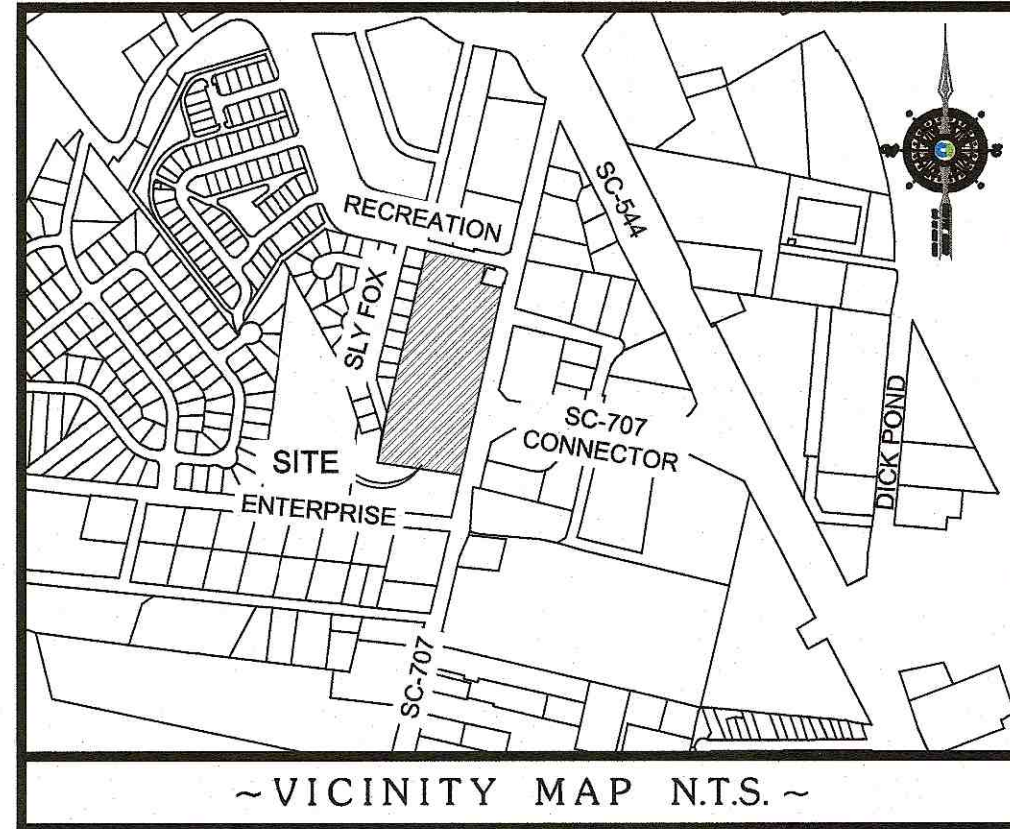

~VICINITY MAP N.T.S.~



WATER DISTRIBUTION & SANITARY SEWER SYSTEM RECORD DRAWING FOR: CONWAY MEDICAL CENTER SOCASSTEE CAMPUS BUILDING

PROJECT SUMMARY:	
LOCATION ON THE CORNER OF SC-707 AND 707 CONNECTOR	
HORRY COUNTY, SOUTH CAROLINA	
TAX PARCEL: 179-00-05-020	PIN: 44015010054
CURRENT ZONING: RE3	
TOTAL PROJECT AREA = 8.1 ACRES	
LAND DISTURBANCE AREA = 8.1	
ROADS AND DRAINAGE: PRIVATE	
WATER AND SEWER: GSWSA	
OWNER:	
CONWAY HOSPITAL INC.	
300 SINGLETON RIDGE ROAD	
CONWAY, SC 29526	
PHONE: 843-347-7111	
CONTRACTOR:	
MONTEITH CONSTRUCTION CORP.	
1200 48TH AVENUE	
MYRTLE BEACH, SC 29577	
PHONE: 843-740-7270	
ENGINEER / LAND SURVEYOR:	
CASTLES ENGINEERING	
2024 CORPORATE CENTRE DR, SUITE 102	
MYRTLE BEACH, SC 29577	
PHONE: 843-448-0910	
CONTRACTOR:	
KING CONSTRUCTION SERVICES, INC.	
111 WHITE OAK FOREST PLACE	
CONWAY, SC 29527	
PHONE: 843-397-8000	
UTILITY CONTRACTOR:	
EXPRESS CONSTRUCTION, LLC	
635 HORRY ROAD	
CONWAY, SC 29526	
PHONE: 843-458-3834	



ENGINEERING / PLANNING
LAND SURVEYING
2024 Corporate Centre Drive
Suite 102
Myrtle Beach, SC 29577
Telephone: 843-448-0910
Fax: 843-448-0969
www.castlesengineering.com


WATER DISTRIBUTION AND SANITARY SEWER SYSTEM
RECORD DRAWING COVER SHEET

CONWAY MEDICAL CENTER
SOCASSTEE CAMPUS BUILDING

GRAND STRAND WATER AND SEWER AUTHORITY
MYRTLE BEACH, HORRY COUNTY, SOUTH CAROLINA

SCALE: N.T.S.
DESIGNED BY: WAG
DRAWN BY: TCM
CHECKED BY: ERB
DATE ISSUED: 01/06/19

Number	Date	Revisions
1		
2		
3		
4		
5		
6		
7		
8		
9		
10		

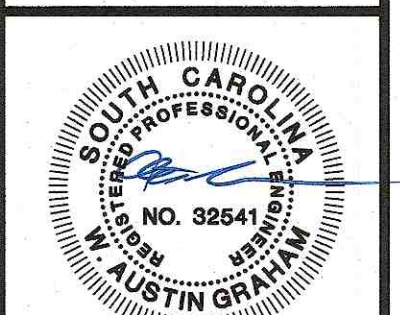

SHEET NUMBER:

1 OF 7

PROJECT#: 18.005

SHEET INDEX

DESCRIPTION

WATER DISTRIBUTION AND SANITARY SEWER SYSTEM
RECORD DRAWING COVER SHEET

SHEET

1 OF 7

WATER DISTRIBUTION AND SANITARY SEWER SYSTEM
RECORD DRAWING KEY PLAN

2 OF 7

WATER DISTRIBUTION SYSTEM
RECORD DRAWING

3 OF 7 & 4 OF 7

SANITARY SEWER SYSTEM
RECORD DRAWING

5 OF 7 & 6 OF 7

APPROVED DATE: 4-30-19
BY: W. Austin Graham
GRAND STRAND WATER & SEWER AUTHORITY

FLOOD ZONE INFORMATION

THIS PROPERTY IS LOCATED IN FLOOD ZONE "X" AS SCALED FROM F.I.R.M. 45061C 0670 H DATED AUG. 23, 1999. THIS PLAT IS NOT THE BASIS FOR FLOOD ZONE DETERMINATION OR FLOOD ZONE RELATED ISSUES.


HORIZONTAL DATUM: NAD 83(11)
VERTICAL DATUM: NAVD 88

LEGEND


SEWER MANHOLE	TREE
SEWER CLEANOUT	WATER LINE
WATER SERVICE	SEWER LINE
FIRE HYDRANT	DRAINAGE PIPE
VALVE	CATCH BASIN
POST INDICATOR VALVE	JUNCTION BOX
FDC	POWER POLE
GAS VALVE MARKER	OVERHEAD POWER
TELEPHONE PEDESTAL	UNDERGROUND POWER
CABLE PEDESTAL	CONCRETE
LIGHT POLE	TRANSFORMER
POWER BOX	SIGN

MANHOLE SCHEDULE			
MH #	RIM	INV. IN	INV. OUT
MH# B5	19.85	-----	13.59
MH# B4	20.28	13.32	13.26
MH# B3	20.50	12.05	11.90
MH# B2	20.50	11.14	10.94
MH# B1	18.88	9.44	9.37
EX. MH# D9	17.93	8.72	

PIPE SCHEDULE				
FROM MH #	TO MH #	DISTANCE	SLOPE	MATERIAL
MH# B5	MH# B4	78 LF	0.35%	8" SDR-35
MH# B4	MH# B3	303 LF	0.40%	8" SDR-35
MH# B3	MH# B2	193 LF	0.39%	8" SDR-35
MH# B2	MH# B1	365 LF	0.41%	8" DR-18
MH# B1	EX. MH# B	79 LF	0.82%	8" DR-18

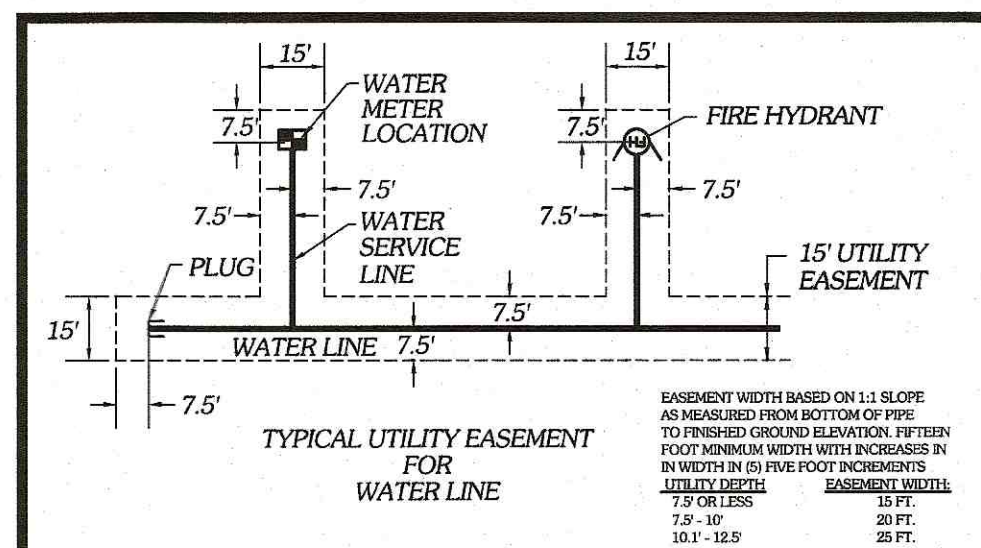

DWG NAME: P:\18005 CMC SCASTEEL MOB AND RETAIL CONSTRUCTION\RECORD DRAWINGS\RECORD CAD DRAWINGS\18005_2019-03-14\RECORD_DRAWING_RECOVER.DWG

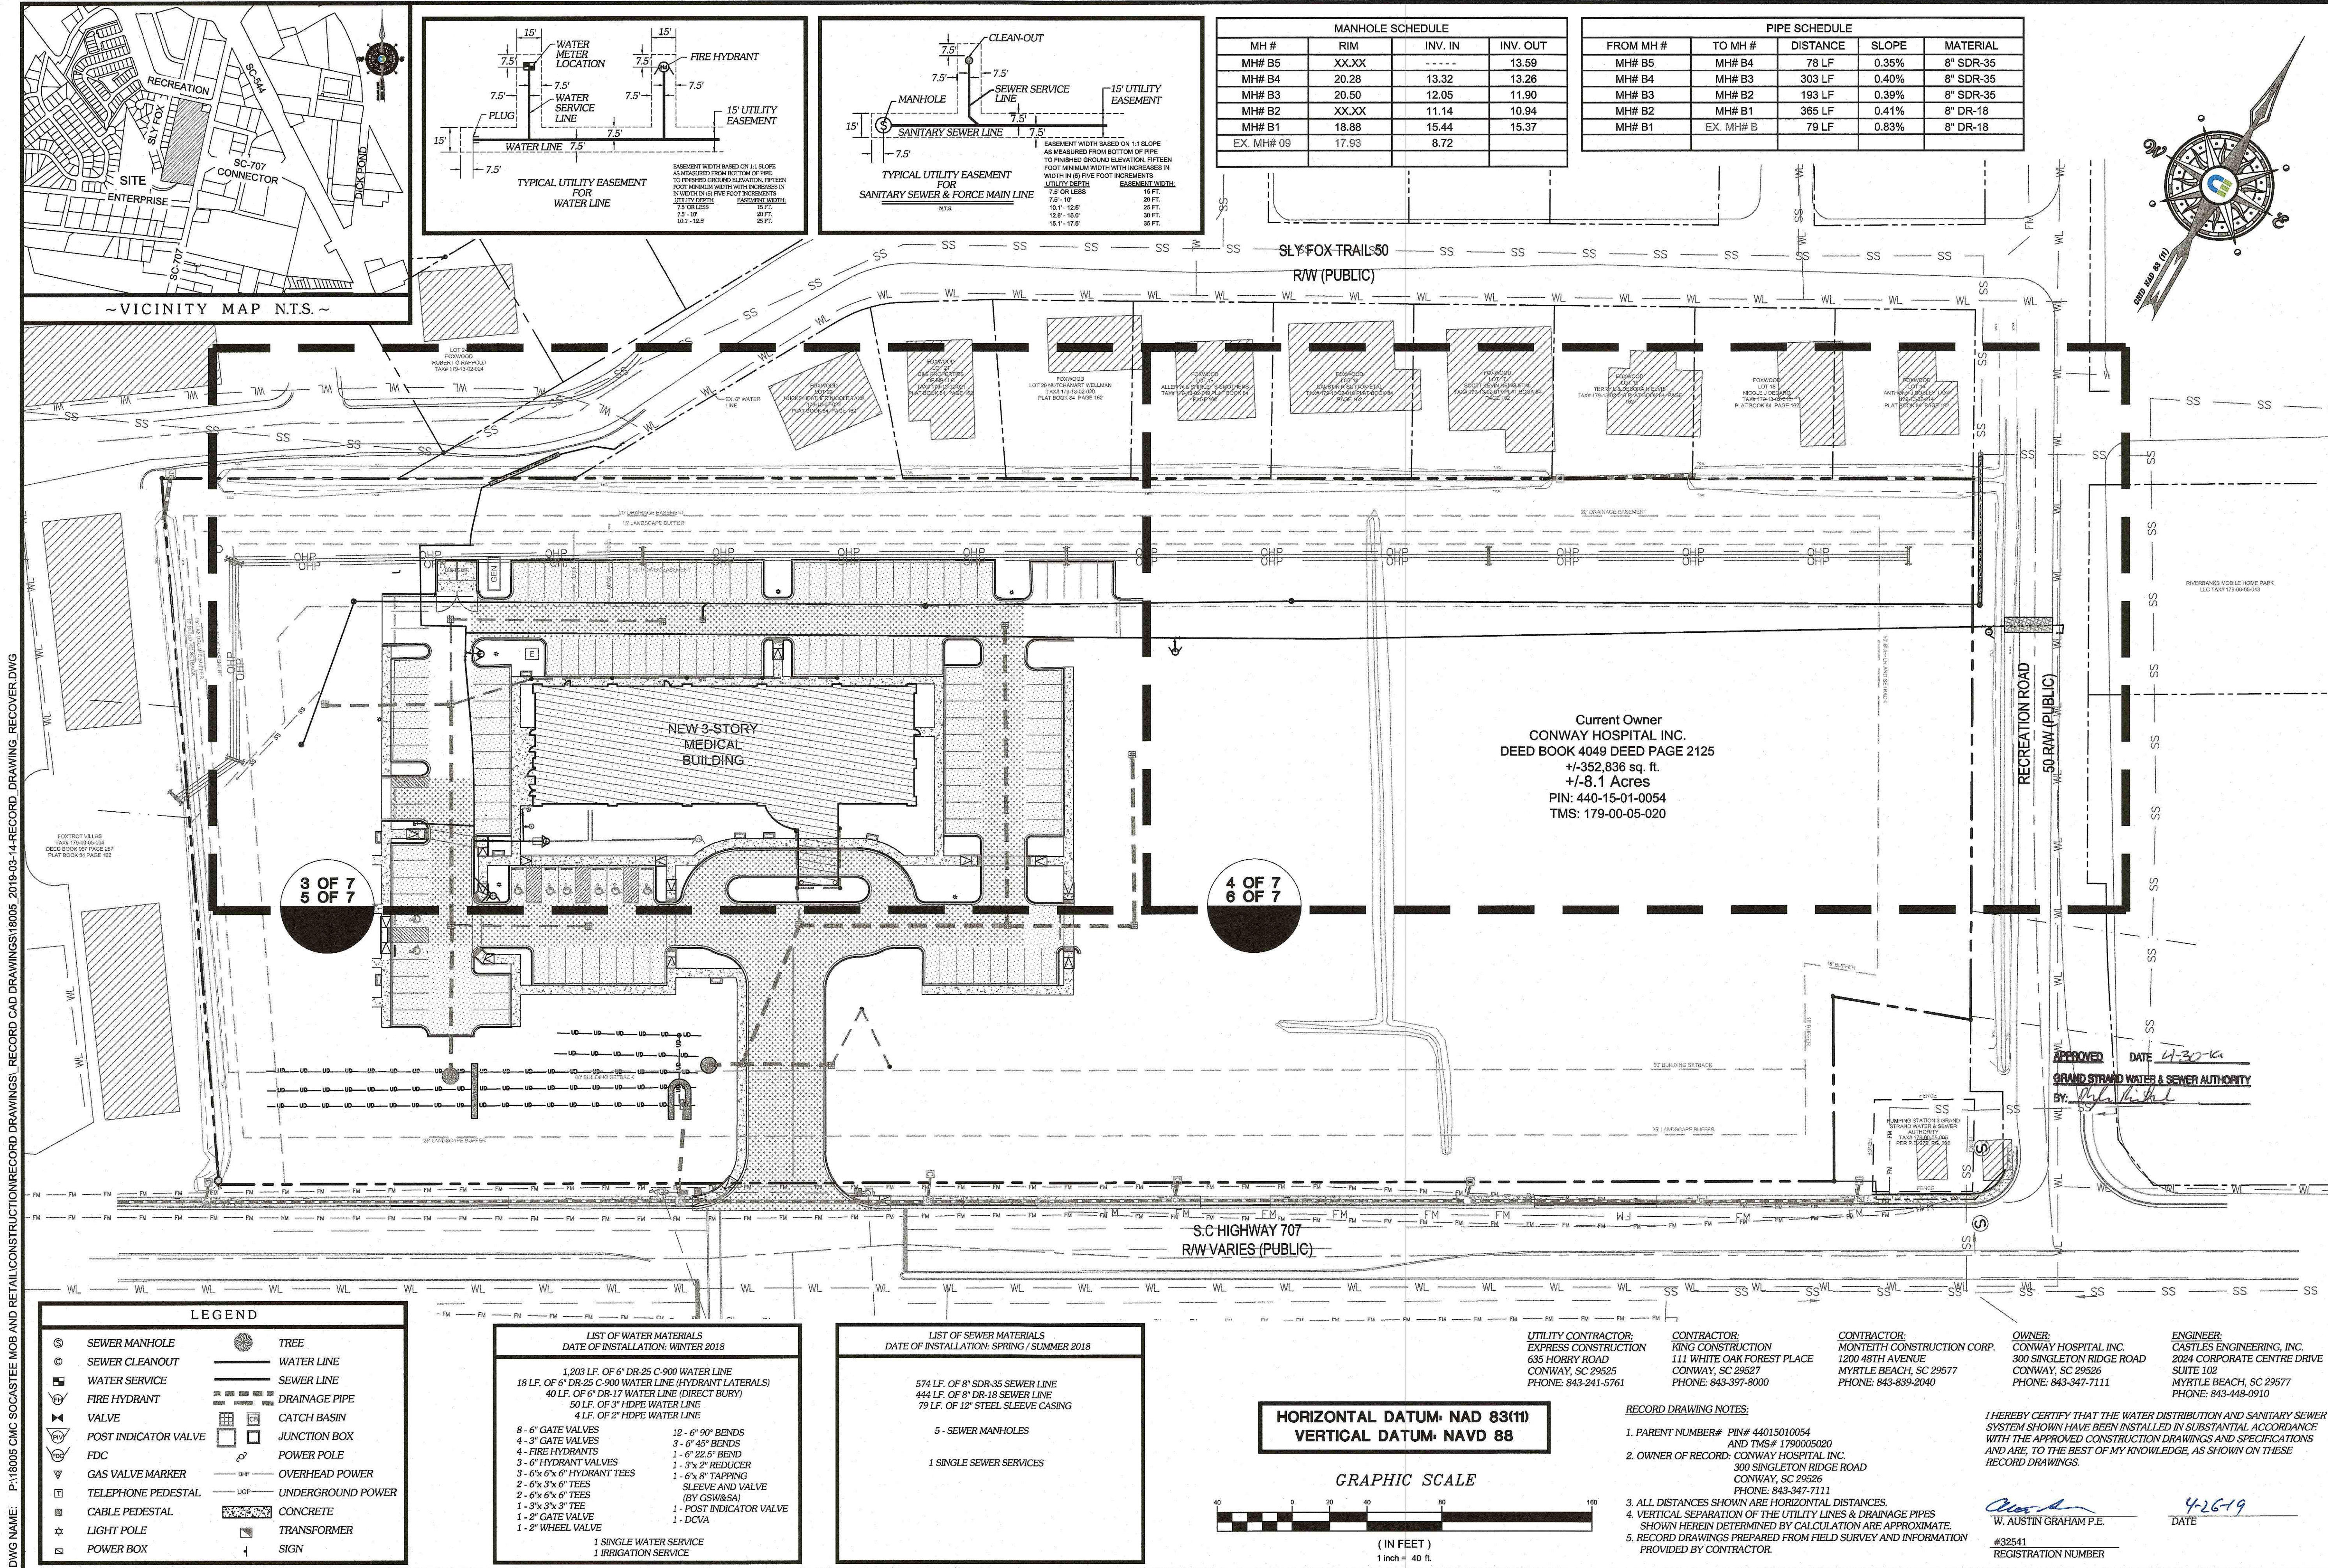

ENGINEERING / PLANNING
LAND SURVEYING
2024 Corporate Centre Drive
Suite 102
Myrtle Beach, SC 29577
Telephone: 843-448-0910
Fax: 843-448-0969
www.castlesengineering.com

Castles Engineering

WATER DISTRIBUTION AND SANITARY SEWER SYSTEM
RECORD DRAWING KEY PLAN

**CONWAY MEDICAL CENTER
SOCASTEE CAMPUS BUILDING**

GRAND STRAND WATER AND SEWER AUTHORITY
MYRTLE BEACH, Horry County, SOUTH CAROLINA

SCALE: 1" = 40'

DESIGNED BY: WAG

DRAWN BY: TCM

CHECKED BY: ERB

DATE ISSUED: 01/06/19

APPROVED DATE 4-30-19
BY: [Signature]
GRAND STRAND WATER & SEWER AUTHORITY

CASTLES ENGINEERING, INC.
No. 000380
STATE OF SOUTH CAROLINA
REGISTERED PROFESSIONAL ENGINEER

CASTLES ENGINEERING, INC.
No. 32541
STATE OF SOUTH CAROLINA
REGISTERED PROFESSIONAL ENGINEER


SHEET NUMBER:
2 OF 7

PROJECT: 18.005



REPRODUCTION OR REUSE OF THIS DRAWING IN WHOLE OR IN PART WITHOUT PRIOR WRITTEN PERMISSION IS STRICTLY FORBIDDEN

14-442-0024-46

DWG NAME: P:\18005 CMC SOCASSEE MOB AND RETAIL CONSTRUCTION\RECORD DRAWINGS\18005_2019-03-14\RECORD_DRAWING_RECOVER.DWG

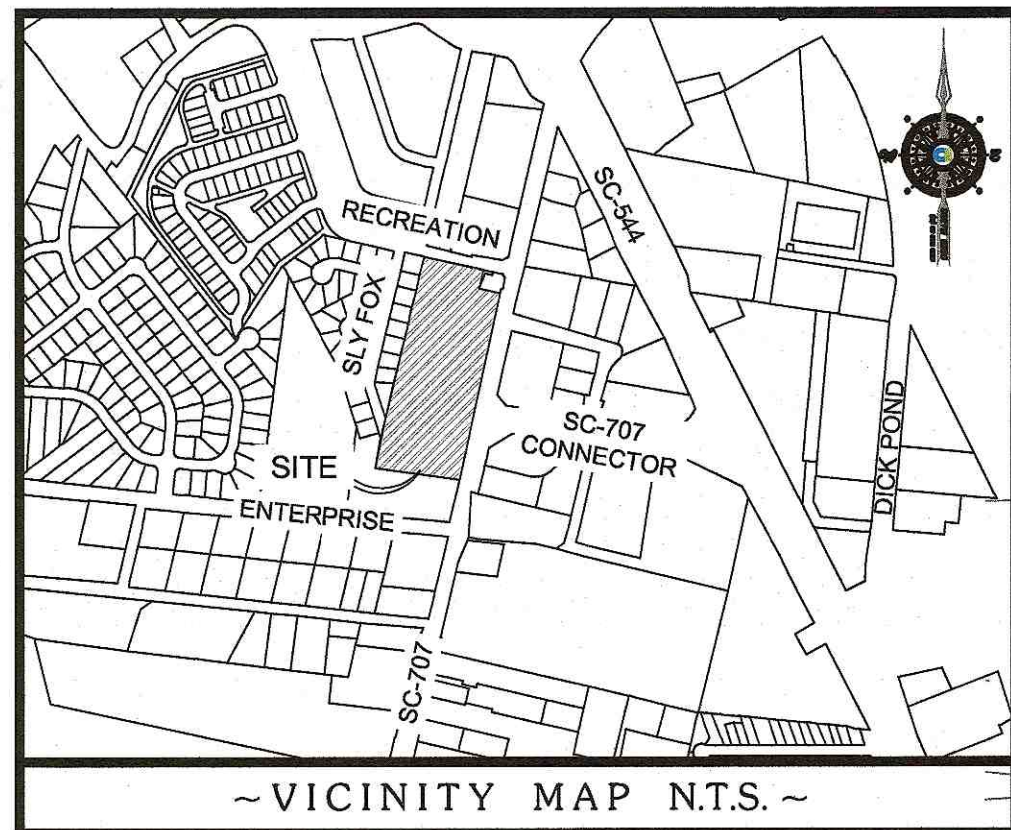

~ VICINITY MAP N.T.S. ~

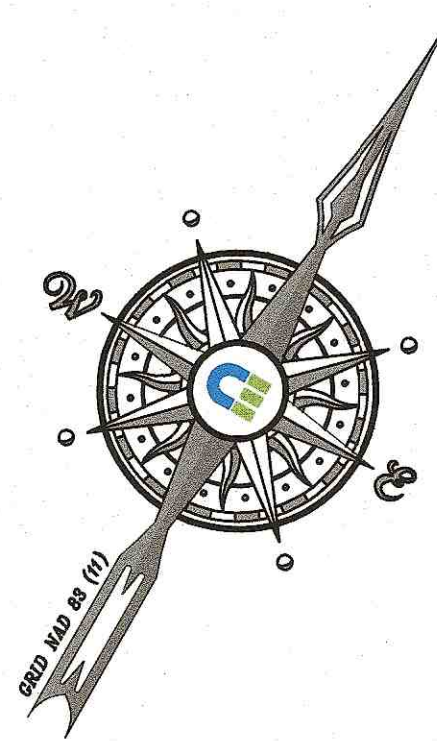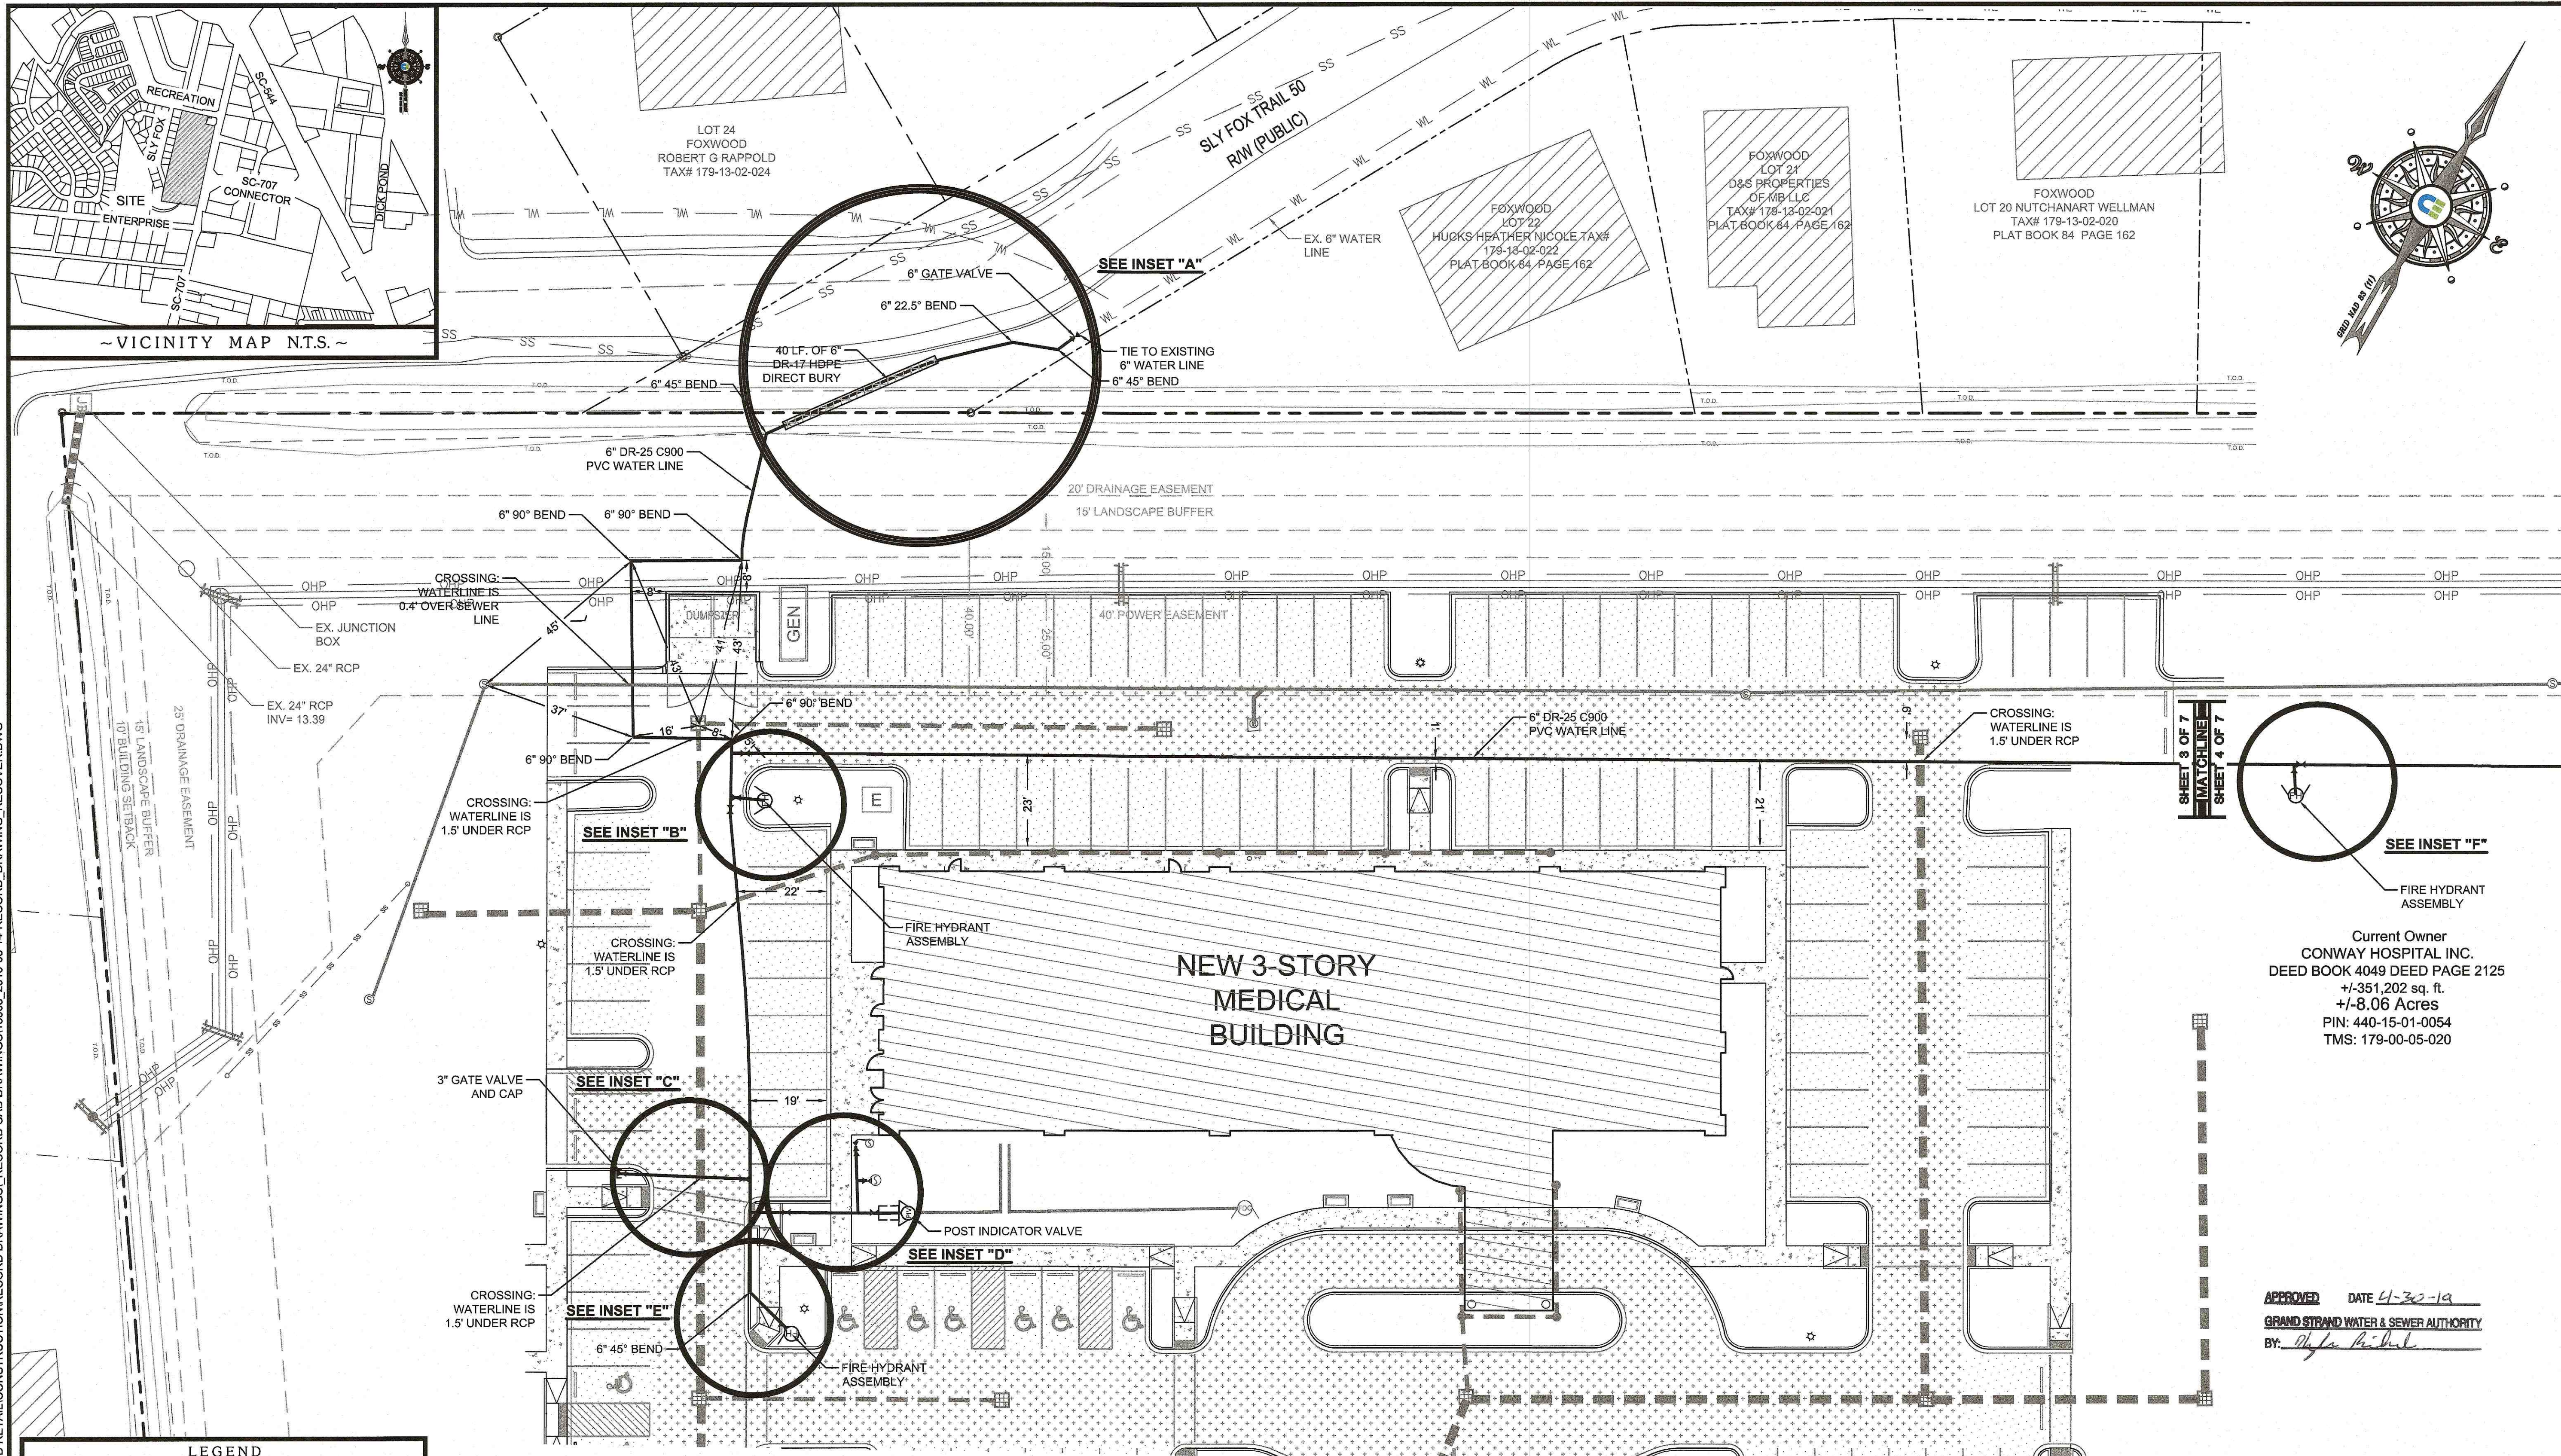

ENGINEERING / PLANNING
LAND SURVEYING
2024 Corporate Centre Drive
Suite 102
Myrtle Beach, SC 29577
Telephone: 843-448-0910
Fax: 843-448-0969
www.castlesengineering.com

**WATER DISTRIBUTION SYSTEM
RECORD DRAWING**

**CONWAY MEDICAL CENTER
SOCASSEE CAMPUS BUILDING**

GRAND STRAND WATER AND SEWER AUTHORITY
MYRTLE BEACH, Horry County, SOUTH CAROLINA

SCALE: 1" = 20'
DESIGNED BY: WAG
DRAWN BY: TCM
CHECKED BY: ERS
DATE ISSUED: 01/06/19

Current Owner
CONWAY HOSPITAL INC.
DEED BOOK 4049 DEED PAGE 2125
+/-351,202 sq. ft.
+/-8.06 Acres
PIN: 440-15-01-0054
TMS: 179-00-05-020

APPROVED DATE 4-30-19
GRAND STRAND WATER & SEWER AUTHORITY
BY: *[Signature]*

Number	Date	Revisions
1		
2		
3		
4		
5		
6		
7		




SHEET NUMBER:

3 OF 7


PROJECT#18.005

LEGEND	
SEWER MANHOLE	TREE
SEWER CLEANOUT	WATER LINE
WATER SERVICE	SEWER LINE
FIRE HYDRANT	DRAINAGE PIPE
VALVE	CATCH BASIN
POST INDICATOR VALVE	JUNCTION BOX
FDC	POWER POLE
GAS VALVE MARKER	OVERHEAD POWER
TELEPHONE PEDESTAL	UNDERGROUND POWER
CABLE PEDESTAL	CONCRETE
LIGHT POLE	TRANSFORMER
POWER BOX	SIGN

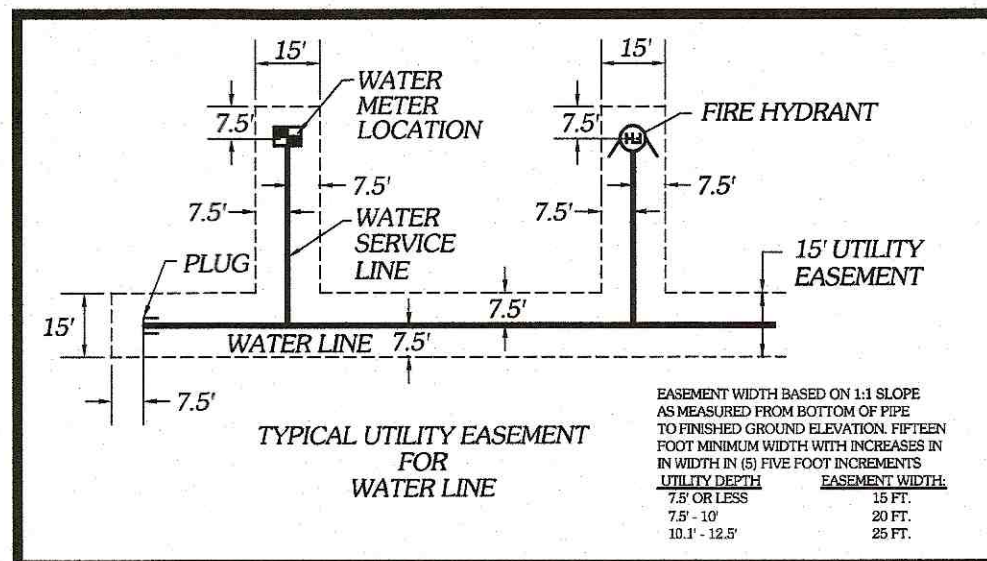

LIST OF WATER MATERIALS DATE OF INSTALLATION: WINTER 2018	
1,203 LF. OF 6" DR-25 C-900 WATER LINE 18 LF. OF 6" DR-25 C-900 WATER LINE (HYDRANT LATERALS) 40 LF. OF 6" DR-17 WATER LINE (DIRECT BURY) 50 LF. OF 3" HDPE WATER LINE 4 LF. OF 2" HDPE WATER LINE	
8 - 6" GATE VALVES	12 - 6" 90° BENDS
4 - 3" GATE VALVES	3 - 6" 45° BENDS
4 - FIRE HYDRANTS	1 - 6" 22.5° BEND
3 - 6" HYDRANT VALVES	1 - 3" 2" REDUCER
2 - 6" 3" 6" HYDRANT TEES	1 - 6" 8" TAPPING
2 - 6" 3" 6" TEES	SLEEVE AND VALVE
2 - 6" 3" 6" TEES	(BY GSW&SA)
1 - 3" 3" 3" TEE	1 - POST INDICATOR VALVE
1 - 2" GATE VALVE	1 - DCVA
1 - 2" WHEEL VALVE	
1 SINGLE WATER SERVICE 1 IRRIGATION SERVICE	

HORIZONTAL DATUM: NAD 83(11)
VERTICAL DATUM: NAVD 88

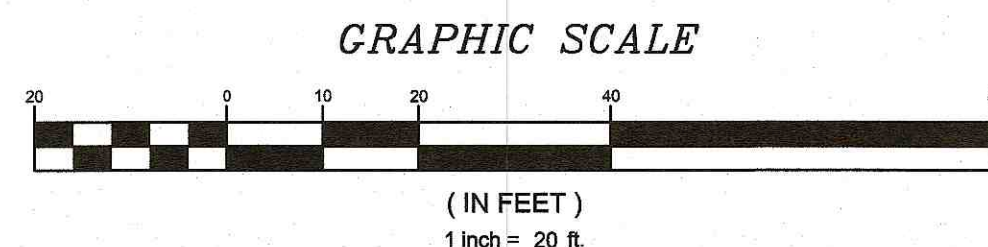

UTILITY CONTRACTOR:
EXPRESS CONSTRUCTION
635 HARRY ROAD
CONWAY, SC 29525
PHONE: 843-241-5761

CONTRACTOR:
KING CONSTRUCTION
111 WHITE OAK FOREST PLACE
CONWAY, SC 29527
PHONE: 843-397-8000

CONTRACTOR:
MONTEITH CONSTRUCTION CORP.
1200 48TH AVENUE
MYRTLE BEACH, SC 29577
PHONE: 843-839-2040

OWNER:
CONWAY HOSPITAL INC.
300 SINGLETON RIDGE ROAD
CONWAY, SC 29526
PHONE: 843-347-7111

ENGINEER:
CASTLES ENGINEERING, INC.
2024 CORPORATE CENTRE DRIVE
SUITE 102
MYRTLE BEACH, SC 29577
PHONE: 843-448-0910

RECORD DRAWING NOTES:

- PARENT NUMBER# PIN# 44015010054 AND TMS# 1790005020
- OWNER OF RECORD: CONWAY HOSPITAL INC. 300 SINGLETON RIDGE ROAD CONWAY, SC 29526 PHONE: 843-347-7111
- ALL DISTANCES SHOWN ARE HORIZONTAL DISTANCES.
- VERTICAL SEPARATION OF THE UTILITY LINES & DRAINAGE PIPES SHOWN HEREIN DETERMINED BY CALCULATION ARE APPROXIMATE.
- RECORD DRAWINGS PREPARED FROM FIELD SURVEY AND INFORMATION PROVIDED BY CONTRACTOR.


I HEREBY CERTIFY THAT THE WATER DISTRIBUTION AND SANITARY SEWER SYSTEM SHOWN HAVE BEEN INSTALLED IN SUBSTANTIAL ACCORDANCE WITH THE APPROVED CONSTRUCTION DRAWINGS AND SPECIFICATIONS AND ARE, TO THE BEST OF MY KNOWLEDGE, AS SHOWN ON THESE RECORD DRAWINGS.

W. JUSTIN GRAHAM P.E.
#32541
REGISTRATION NUMBER


4-26-19
DATE

14-42-0037-W/S

DWG NAME: P-18005 CMC SOCASSEE MOB AND RETAIL CONSTRUCTION RECORD DRAWINGS 18005 2019-03-14 RECORD DRAWING RECOVER DWG

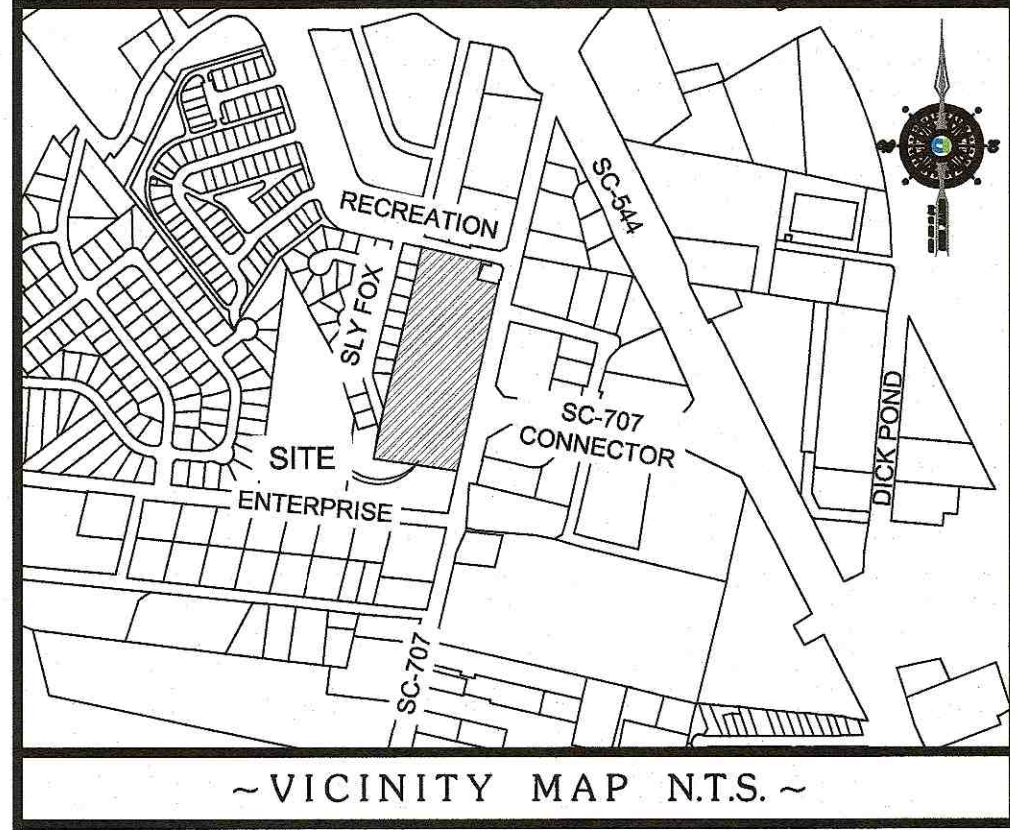


~VICINITY MAP N.T.S.~

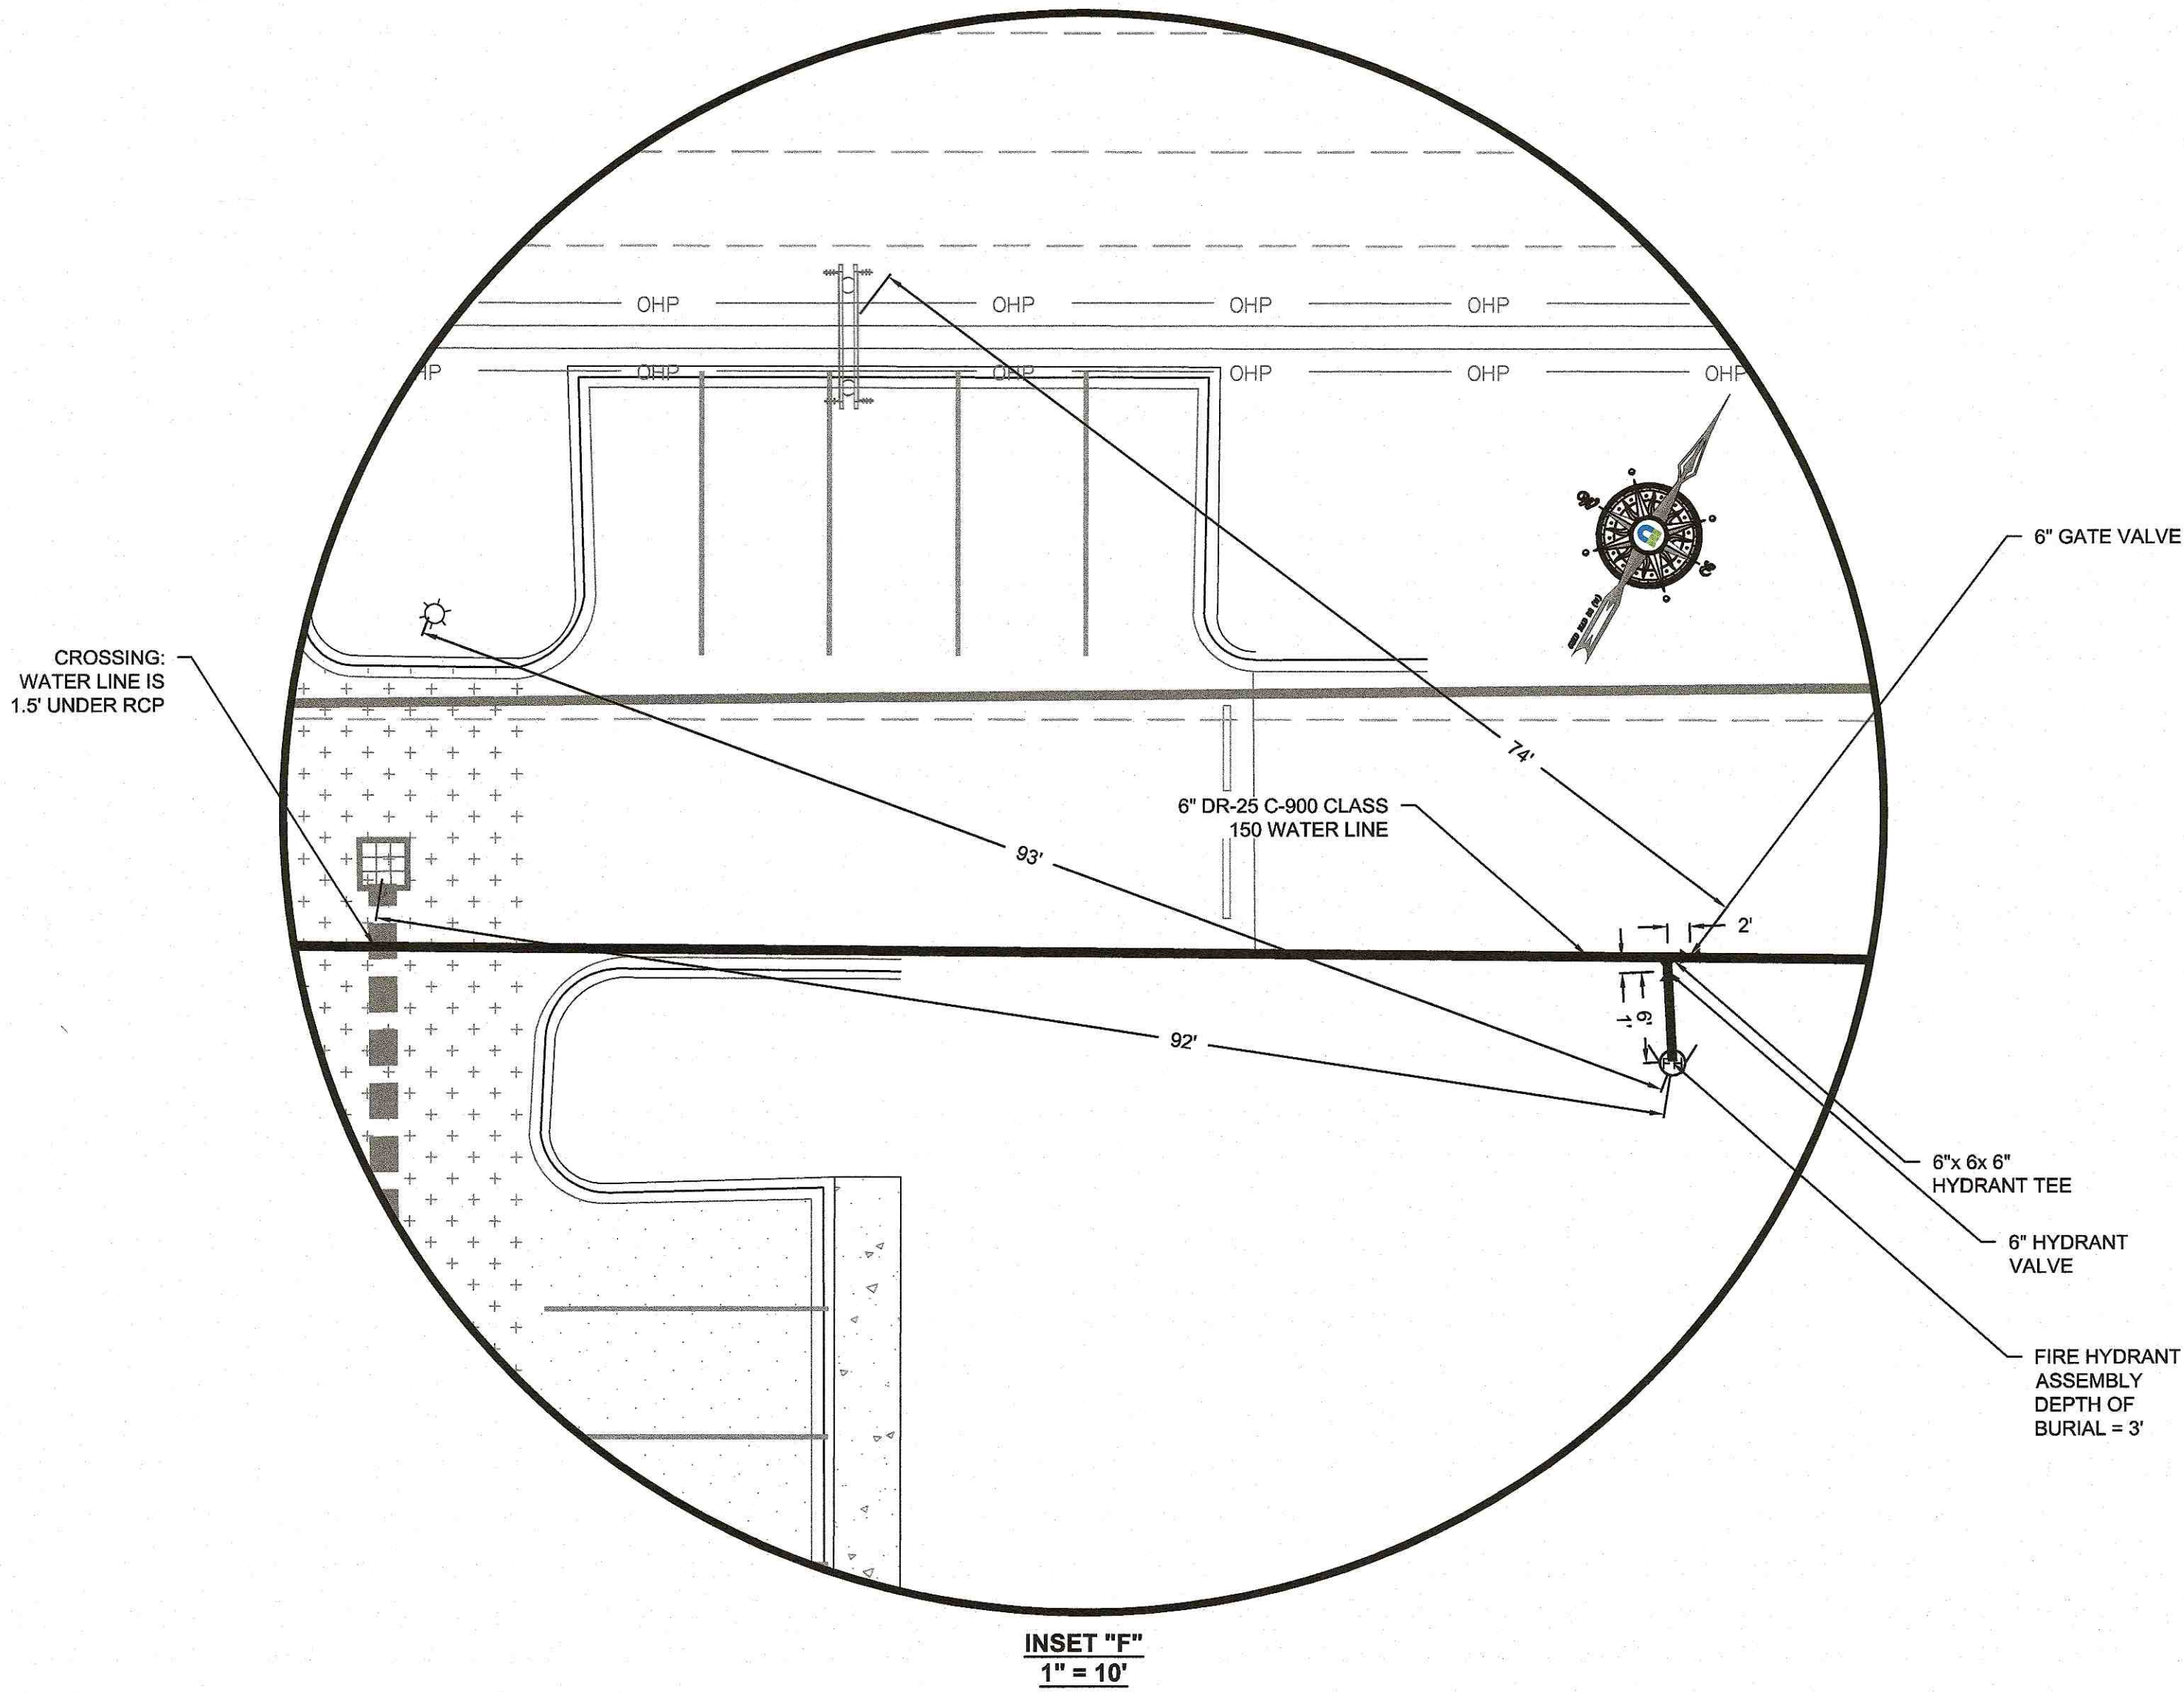


INSET "F"
1" = 10'

LEGEND			
⊙	SEWER MANHOLE	⊙	TREE
⊙	SEWER CLEANOUT	—	WATER LINE
⊙	WATER SERVICE	—	SEWER LINE
⊙	FIRE HYDRANT	—	DRAINAGE PIPE
⊙	VALVE	⊙	CATCH BASIN
⊙	POST INDICATOR VALVE	⊙	JUNCTION BOX
⊙	FDC	⊙	POWER POLE
⊙	GAS VALVE MARKER	⊙	OVERHEAD POWER
⊙	TELEPHONE PEDESTAL	⊙	UNDERGROUND POWER
⊙	CABLE PEDESTAL	⊙	CONCRETE
⊙	LIGHT POLE	⊙	TRANSFORMER
⊙	POWER BOX	⊙	SIGN

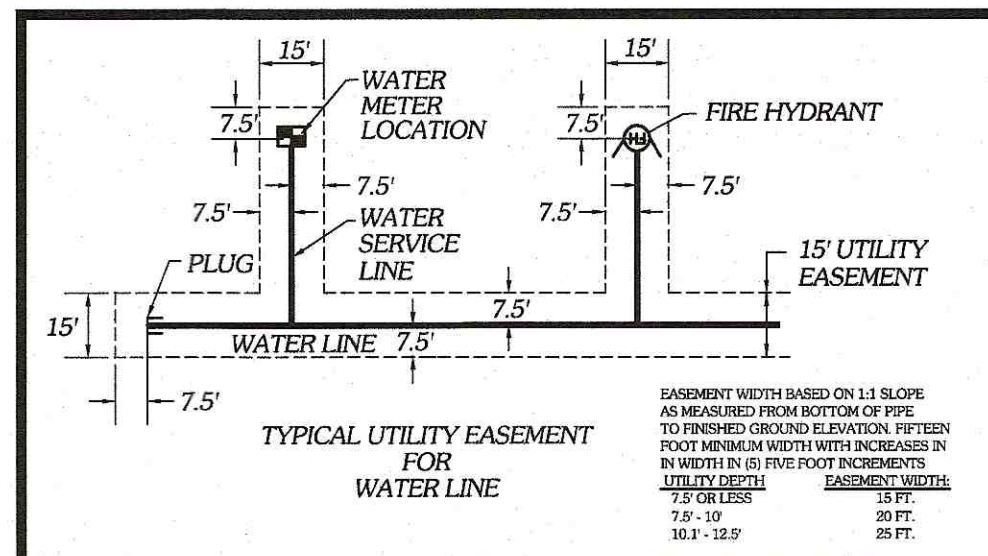

LIST OF WATER MATERIALS	
DATE OF INSTALLATION: WINTER 2018	
1,203 LF. OF 6" DR-25 C-900 WATER LINE	
18 LF. OF 6" DR-25 C-900 WATER LINE (HYDRANT LATERALS)	
40 LF. OF 6" DR-17 WATER LINE (DIRECT BURY)	
50 LF. OF 3" HDPE WATER LINE	
4 LF. OF 2" HDPE WATER LINE	
8 - 6" GATE VALVES	12 - 6" 90° BENDS
4 - FIRE HYDRANTS	3 - 6" 45° BENDS
3 - 6" HYDRANT VALVES	1 - 6" 22.5° BEND
3 - 6x6 3/4" HYDRANT TEES	3 - 3" x 2" REDUCER
2 - 6x3 3/4" TEES	1 - 6"x8" TAPPING SLEEVE AND VALVE (BY GSW&S)
2 - 6x6 3/4" TEES	1 - POST INDICATOR VALVE
1 - 3"x3 3/4" TEE	1 - DCVA
1 - 2" GATE VALVE	
2 - WHEEL VALVE	
1 SINGLE WATER SERVICE	
1 IRRIGATION SERVICE	

HORIZONTAL DATUM: NAD 83(11)
VERTICAL DATUM: NAVD 88

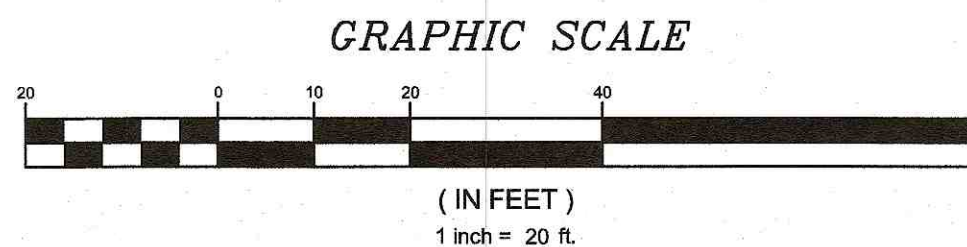

UTILITY CONTRACTOR:
EXPRESS CONSTRUCTION
635 HARRY ROAD
CONWAY, SC 29525
PHONE: 843-241-5761

CONTRACTOR:
KING CONSTRUCTION
111 WHITE OAK FOREST PLACE
CONWAY, SC 29527
PHONE: 843-397-8000

CONTRACTOR:
MONTEITH CONSTRUCTION CORP.
1200 48TH AVENUE
MYRTLE BEACH, SC 29577
PHONE: 843-339-2040

OWNER:
CONWAY HOSPITAL INC.
300 SINGLETON RIDGE ROAD
CONWAY, SC 29526
PHONE: 843-347-7111

ENGINEER:
CASTLES ENGINEERING, INC.
2024 CORPORATE CENTRE DRIVE
SUITE 102
MYRTLE BEACH, SC 29577
PHONE: 843-448-0910

RECORD DRAWING NOTES:

- PARENT NUMBER# PIN# 44015010054 AND TMS# 1790005020
- OWNER OF RECORD: CONWAY HOSPITAL INC. 300 SINGLETON RIDGE ROAD CONWAY, SC 29526 PHONE: 843-347-7111
- ALL DISTANCES SHOWN ARE HORIZONTAL DISTANCES.
- VERTICAL SEPARATION OF THE UTILITY LINES & DRAINAGE PIPES SHOWN HEREIN DETERMINED BY CALCULATION ARE APPROXIMATE.
- RECORD DRAWINGS PREPARED FROM FIELD SURVEY AND INFORMATION PROVIDED BY CONTRACTOR.

I HEREBY CERTIFY THAT THE WATER DISTRIBUTION AND SANITARY SEWER SYSTEM SHOWN HAVE BEEN INSTALLED IN SUBSTANTIAL ACCORDANCE WITH THE APPROVED CONSTRUCTION DRAWINGS AND SPECIFICATIONS AND ARE, TO THE BEST OF MY KNOWLEDGE, AS SHOWN ON THESE RECORD DRAWINGS.

W. AUSTIN GRAHAM P.E.
#32541
REGISTRATION NUMBER

DATE
4-26-19




WATER DISTRIBUTION SYSTEM RECORD DRAWING

CONWAY MEDICAL CENTER
SOCASSEE CAMPUS BUILDING
for
GRAND STRAND WATER AND SEWER AUTHORITY
MYRTLE BEACH, Horry County, SOUTH CAROLINA

SCALE: AS SHOWN
DESIGNED BY: WAG
DRAWN BY: TCM
CHECKED BY: ERB
DATE ISSUED: 01/06/19

Number	Date	Revisions
1		
2		
3		
4		
5		
6		
7		
8		
9		
10		

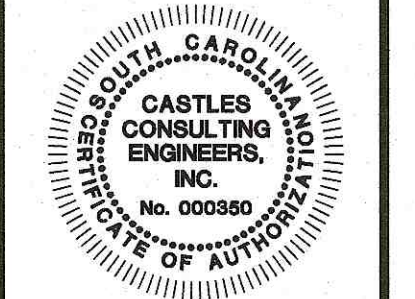

SHEET NUMBER:


5 OF 7

PROJECT# 18.005


REPRODUCTION OR REUSE OF THIS DRAWING IN WHOLE OR IN PART WITHOUT PRIOR WRITTEN PERMISSION IS STRICTLY FORBIDDEN

14-42-005/7-1/5

DWG NAME: P:\18005 CMC SOCASTEE MOB AND RETAIL CONSTRUCTION\RECORD DRAWINGS\18005_2019-03-14-RECORD_DRAWING_RECOVER.DWG

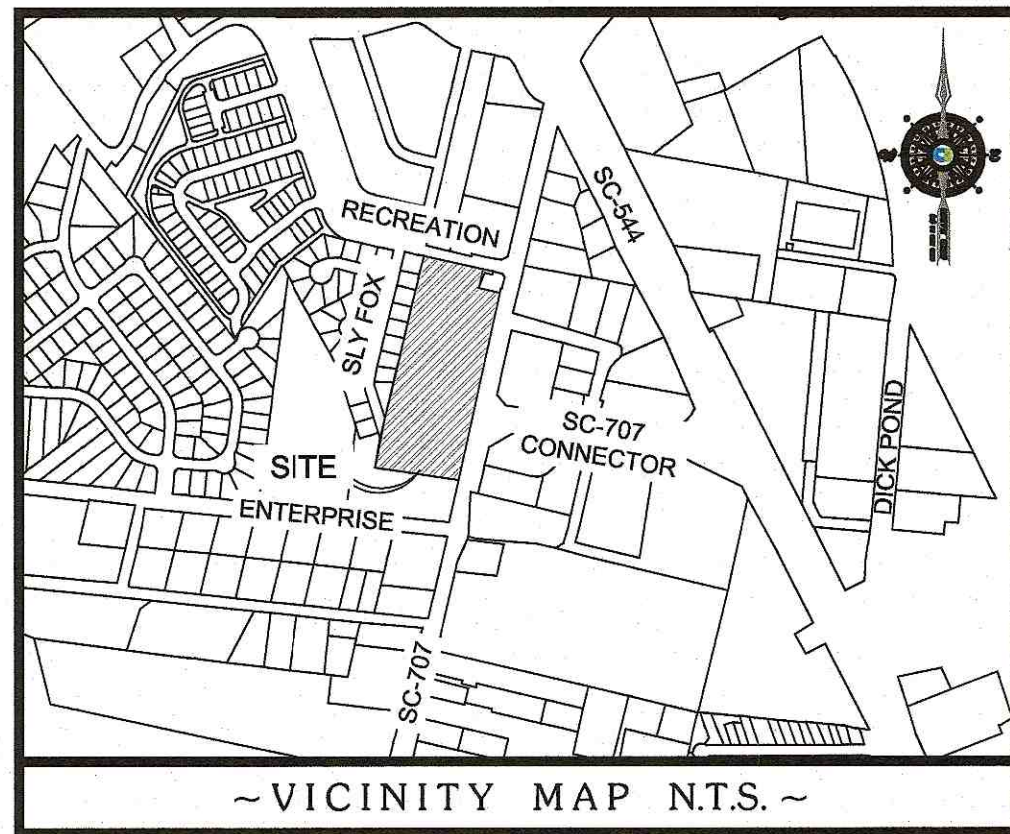


~VICINITY MAP N.T.S.~

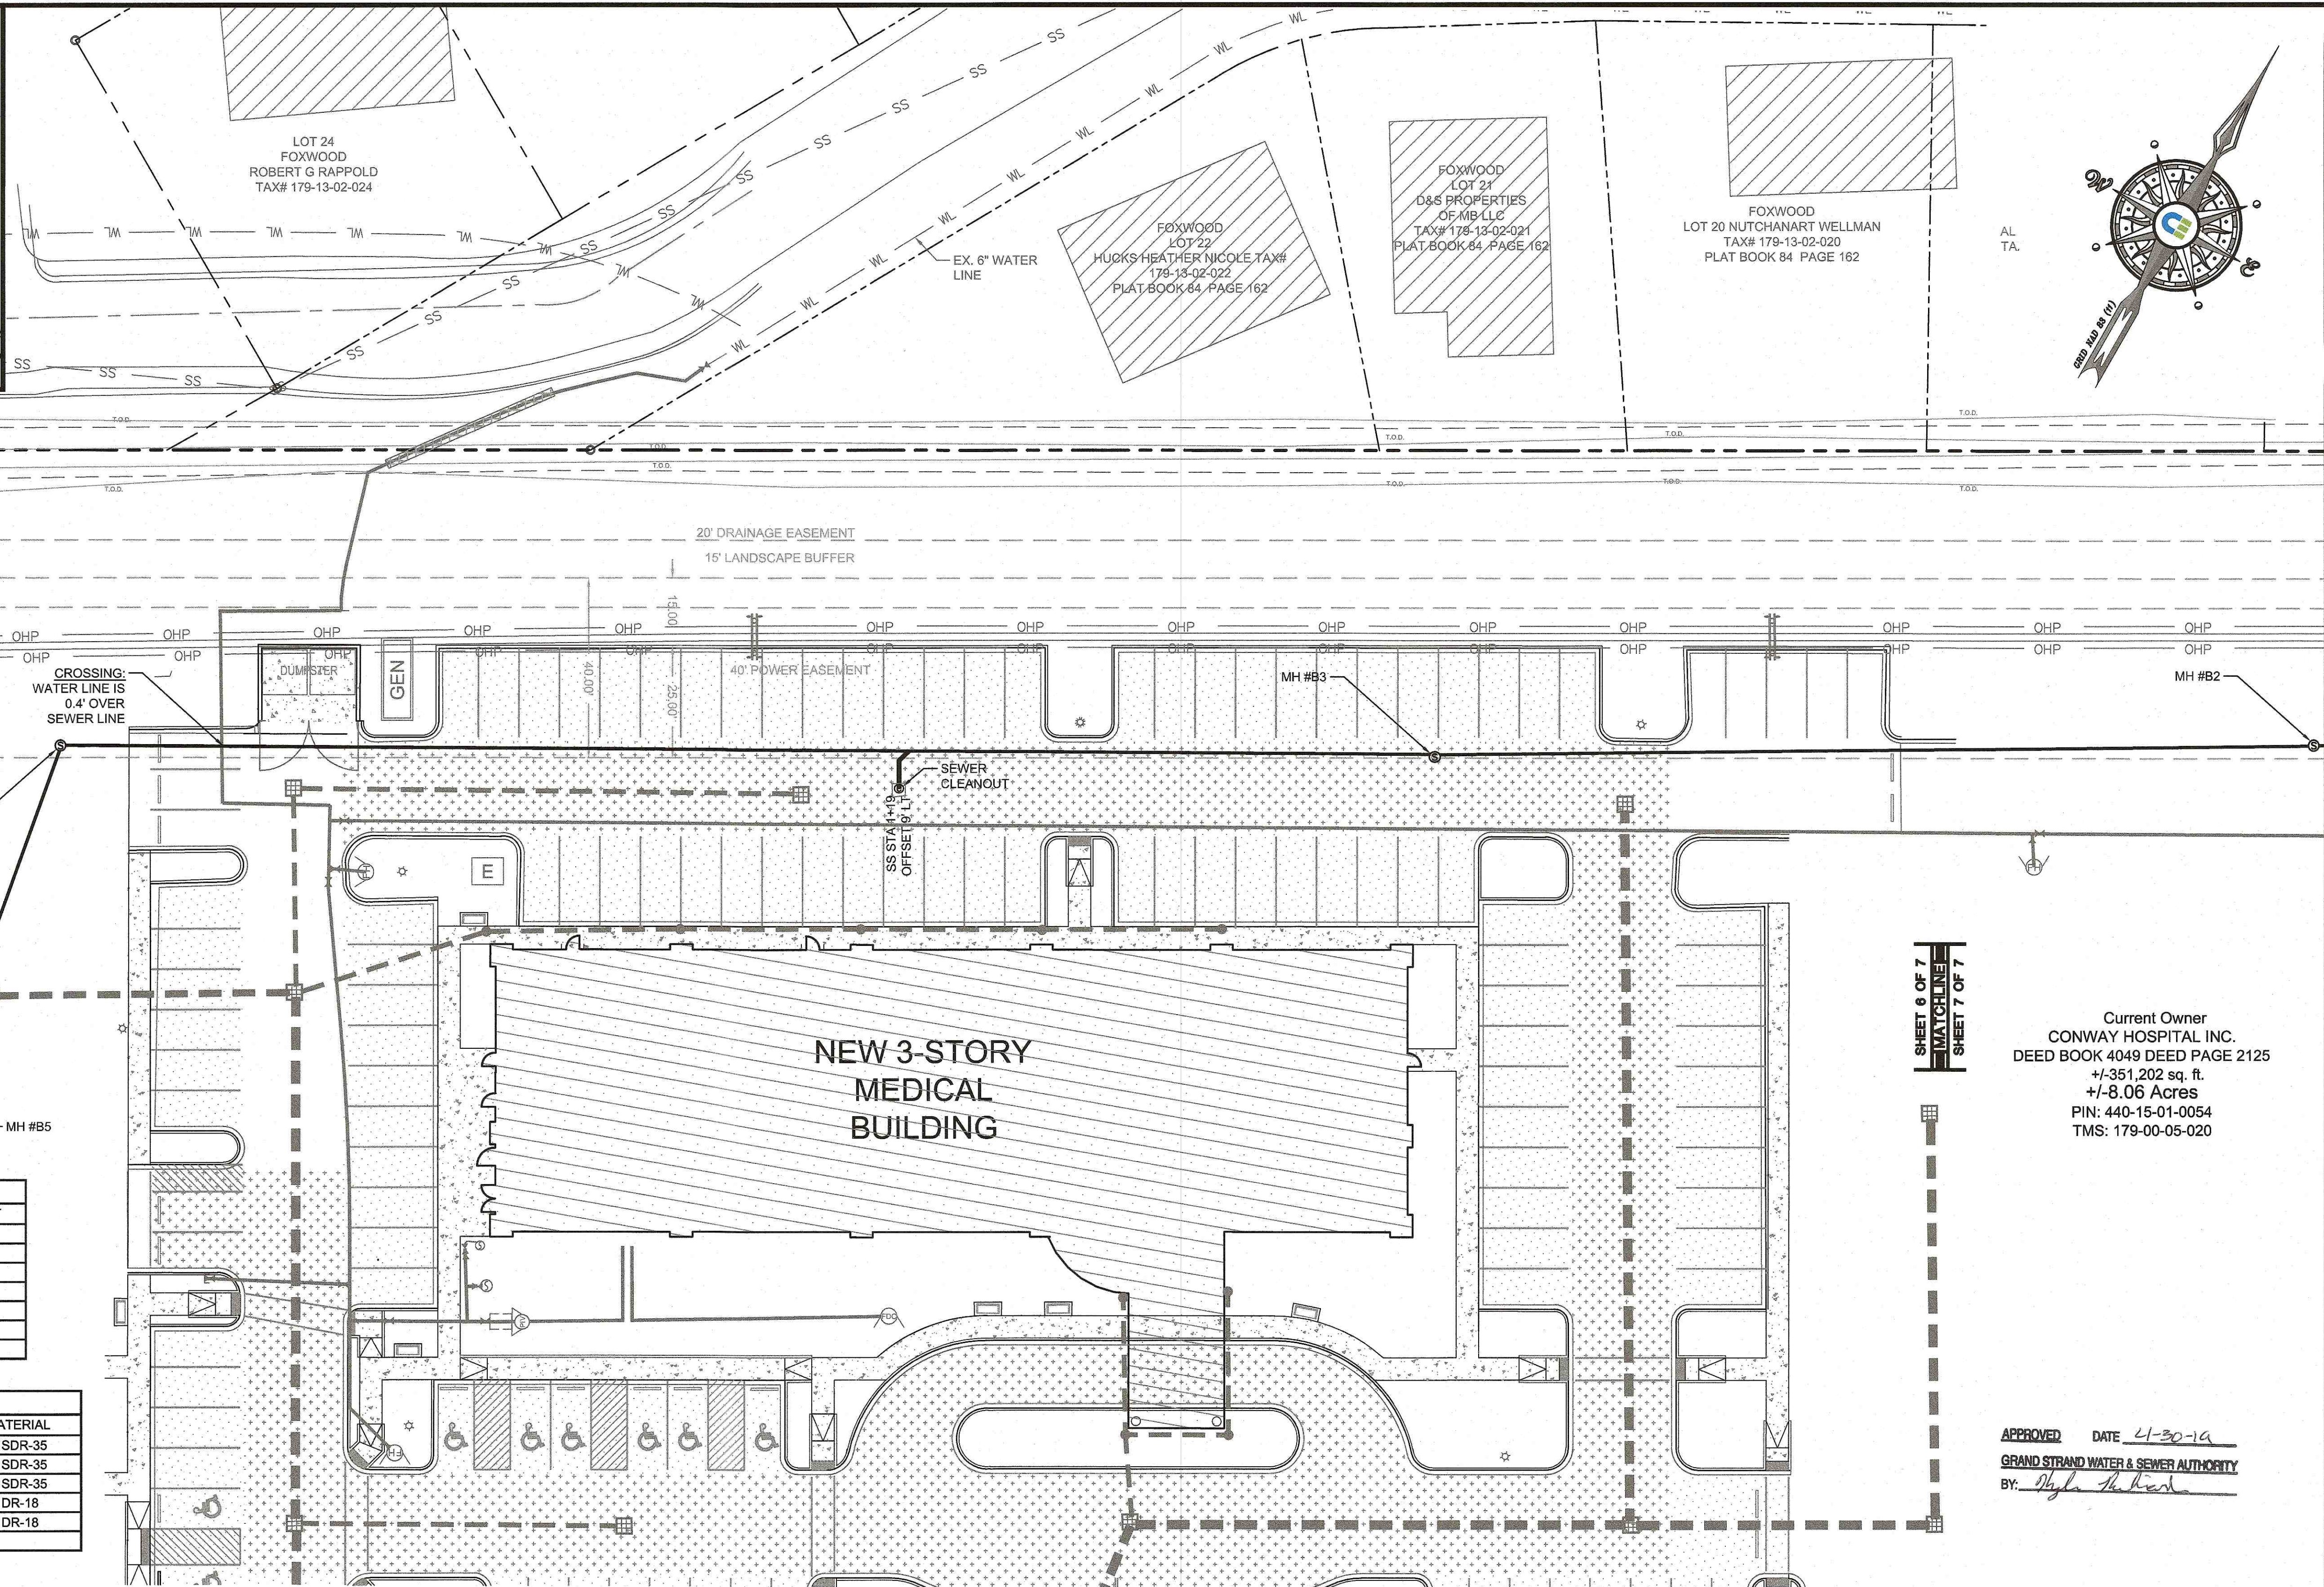

MANHOLE SCHEDULE			
MH #	RIM	INV. IN	INV. OUT
MH# B5	19.85	----	13.59
MH# B4	20.28	13.32	13.26
MH# B3	20.50	12.05	11.90
MH# B2	20.50	11.14	10.94
MH# B1	18.88	9.44	9.37
EX. MH# 09	17.93	8.72	


PIPE SCHEDULE				
FROM MH #	TO MH #	DISTANCE	SLOPE	MATERIAL
MH# B5	MH# B4	78 LF	0.35%	8" SDR-35
MH# B4	MH# B3	303 LF	0.40%	8" SDR-35
MH# B3	MH# B2	193 LF	0.39%	8" SDR-35
MH# B2	MH# B1	365 LF	0.41%	8" DR-18
MH# B1	EX. MH# 09	79 LF	0.82%	8" DR-18

LEGEND	
	SEWER MANHOLE
	SEWER CLEANOUT
	WATER SERVICE
	FIRE HYDRANT
	VALVE
	POST INDICATOR VALVE
	FDC
	GAS VALVE MARKER
	TELEPHONE PEDESTAL
	CABLE PEDESTAL
	LIGHT POLE
	POWER BOX
	TREE
	WATER LINE
	SEWER LINE
	DRAINAGE PIPE
	CATCH BASIN
	JUNCTION BOX
	POWER POLE
	OVERHEAD POWER
	UNDERGROUND POWER
	CONCRETE
	TRANSFORMER
	SIGN

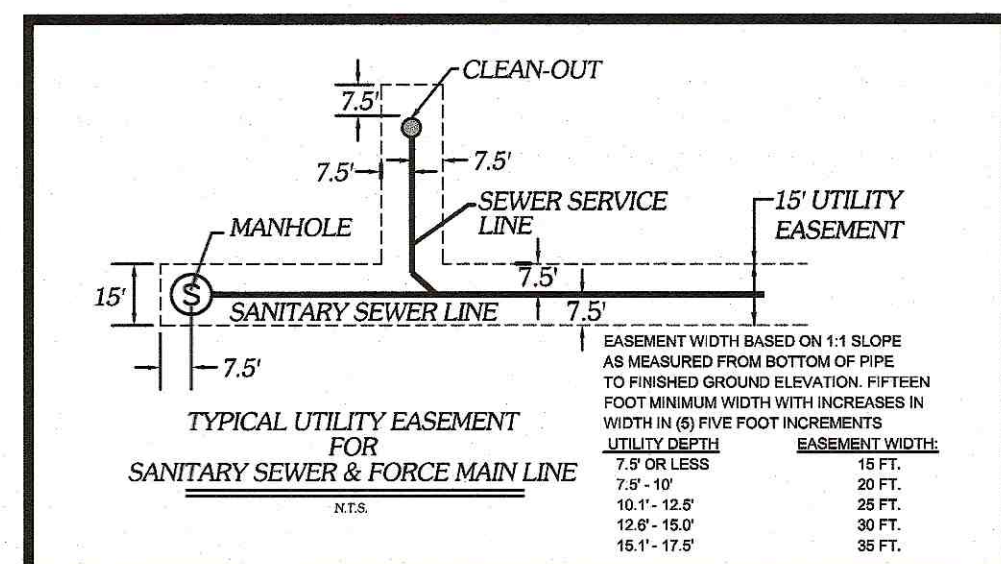

LIST OF SEWER MATERIALS	
DATE OF INSTALLATION: SPRING / SUMMER 2018	
574 LF. OF 8" SDR-35 SEWER LINE	
444 LF. OF 8" DR-18 SEWER LINE	
79 LF. OF 12" STEEL SLEEVE CASING	
5 - SEWER MANHOLES	
1 SINGLE SEWER SERVICES	

HORIZONTAL DATUM: NAD 83(11)
VERTICAL DATUM: NAVD 88

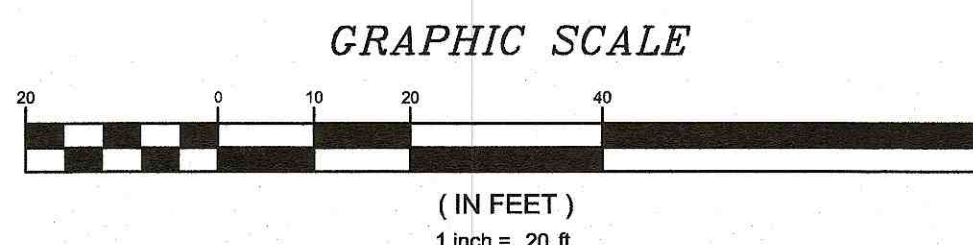

UTILITY CONTRACTOR:
EXPRESS CONSTRUCTION
635 HARRY ROAD
CONWAY, SC 29525
PHONE: 843-241-5761

CONTRACTOR:
KING CONSTRUCTION
111 WHITE OAK FOREST PLACE
CONWAY, SC 29527
PHONE: 843-397-8000

CONTRACTOR:
MONTETH CONSTRUCTION CORP.
1200 48TH AVENUE
MYRTLE BEACH, SC 29577
PHONE: 843-839-2040

OWNER:
CONWAY HOSPITAL INC.
300 SINGLETON RIDGE ROAD
CONWAY, SC 29526
PHONE: 843-347-7111

ENGINEER:
CASTLES ENGINEERING, INC.
2024 CORPORATE CENTRE DRIVE
SUITE 102
MYRTLE BEACH, SC 29577
PHONE: 843-448-0910

RECORD DRAWING NOTES:

- PARENT NUMBER# PIN# 44015010054 AND TMS# 1790005020
- OWNER OF RECORD: CONWAY HOSPITAL INC. 300 SINGLETON RIDGE ROAD CONWAY, SC 29526 PHONE: 843-347-7111
- ALL DISTANCES SHOWN ARE HORIZONTAL DISTANCES.
- VERTICAL SEPARATION OF THE UTILITY LINES & DRAINAGE PIPES SHOWN HEREIN DETERMINED BY CALCULATION ARE APPROXIMATE.
- RECORD DRAWINGS PREPARED FROM FIELD SURVEY AND INFORMATION PROVIDED BY CONTRACTOR.

I HEREBY CERTIFY THAT THE WATER DISTRIBUTION AND SANITARY SEWER SYSTEM SHOWN HAVE BEEN INSTALLED IN SUBSTANTIAL ACCORDANCE WITH THE APPROVED CONSTRUCTION DRAWINGS AND SPECIFICATIONS AND ARE, TO THE BEST OF MY KNOWLEDGE, AS SHOWN ON THESE RECORD DRAWINGS.

W. AUSTIN GRAHAM P.E.
#32541
REGISTRATION NUMBER


DATE 4-26-19



SANITARY SEWER SYSTEM
RECORD DRAWING
CONWAY MEDICAL CENTER
SOCASTEE CAMPUS BUILDING
GRAND STRAND WATER AND SEWER AUTHORITY
MYRTLE BEACH, Horry County, SOUTH CAROLINA

SCALE: 1" = 20'
DESIGNED BY: WAG
DRAWN BY: TCM
CHECKED BY: ERB
DATE ISSUED: 01/08/19


Number	Date	Revisions
1		
2		
3		
4		
5		
6		
7		

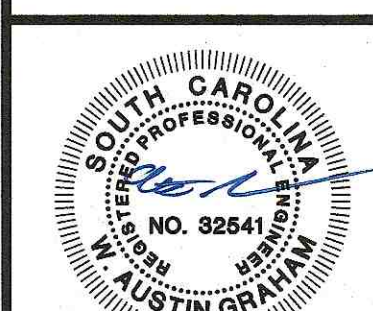



SHEET NUMBER:
6 OF 7
PROJECT#: 18.005

14-482-0067-56

DWG NAME: P:\18005 CMC SOCASSEE MOB AND RETAIL CONSTRUCTION\RECORD DRAWINGS\18005_2019-03-14-RECORD_DRAWING_RECOVER.DWG

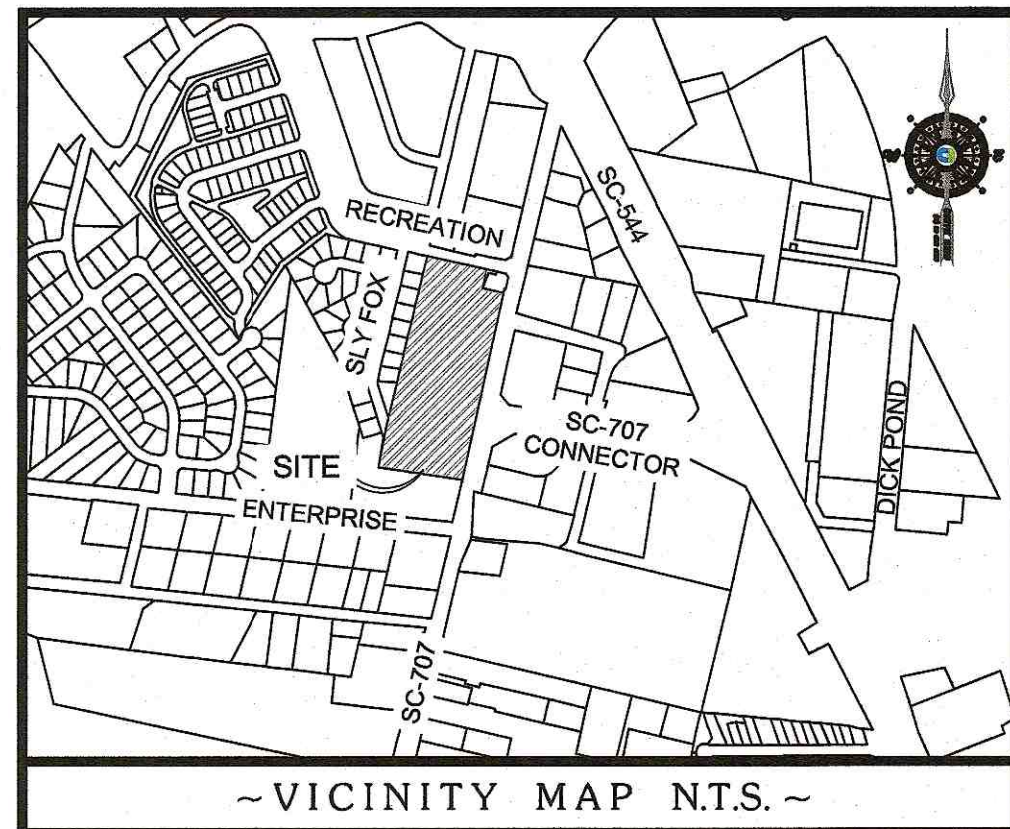

~VICINITY MAP N.T.S.~

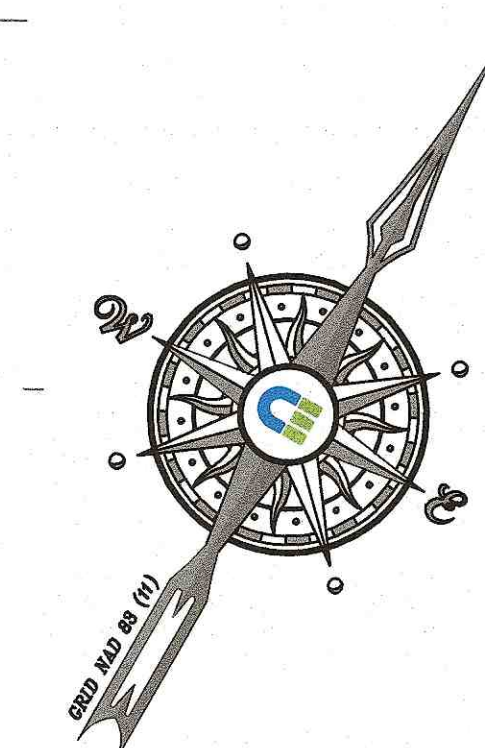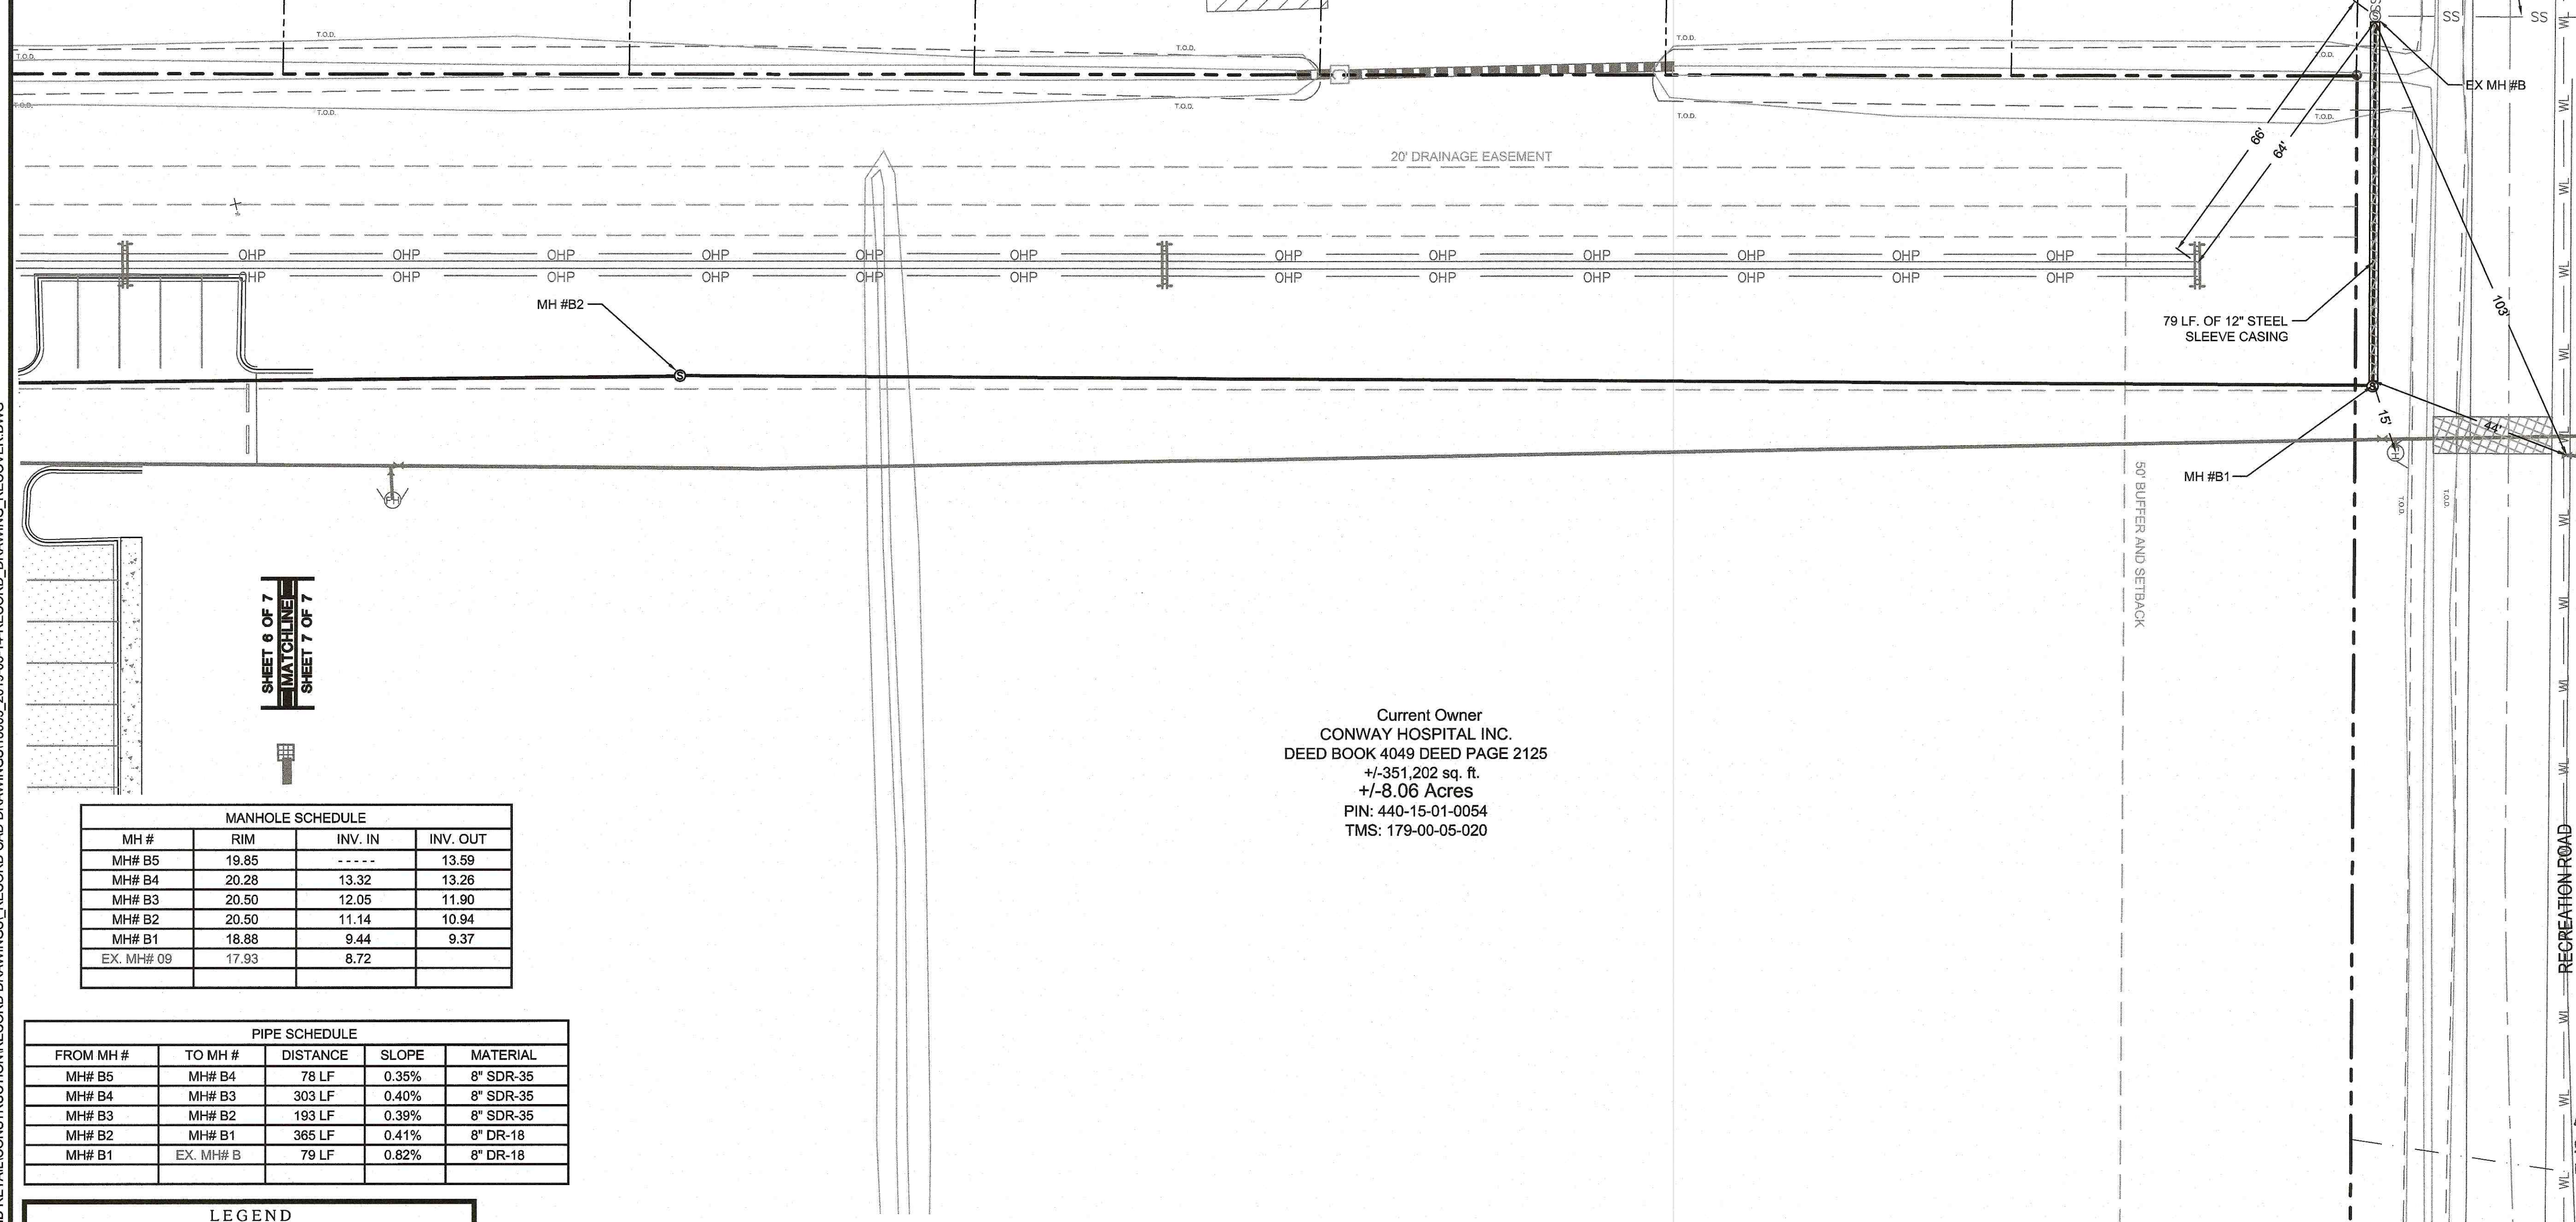

ENGINEERING / PLANNING
LAND SURVEYING
2024 Corporate Centre Drive
Suite 102
Myrtle Beach, SC 29577
Telephone: 843-448-0910
Fax: 843-448-0969
www.castlesengineering.com

Castles Engineering

**SANITARY SEWER SYSTEM
RECORD DRAWING**


**CONWAY MEDICAL CENTER
SOCASSEE CAMPUS BUILDING**

GRAND STRAND WATER AND SEWER AUTHORITY
MYRTLE BEACH, Horry County, SOUTH CAROLINA

SCALE: 1" = 20'

DESIGNED BY:	WAG
DRAWN BY:	TCM
CHECKED BY:	ERB
DATE ISSUED:	01/06/19

Number	Date	Revisions
1		
2		
3		
4		
5		
6		
7		
8		
9		
10		

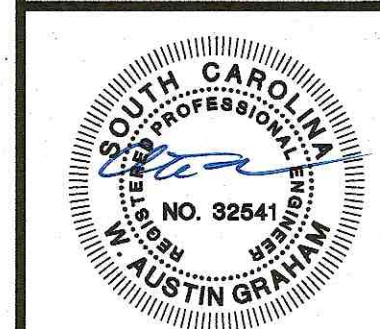


SHEET NUMBER:
7 OF 7

PROJECT#: 18.005

MANHOLE SCHEDULE			
MH #	RIM	INV. IN	INV. OUT
MH# B5	19.85	-----	13.59
MH# B4	20.28	13.32	13.26
MH# B3	20.50	12.05	11.90
MH# B2	20.50	11.14	10.94
MH# B1	18.88	9.44	9.37
EX. MH# 09	17.93	8.72	


PIPE SCHEDULE				
FROM MH #	TO MH #	DISTANCE	SLOPE	MATERIAL
MH# B5	MH# B4	78 LF	0.35%	8" SDR-35
MH# B4	MH# B3	303 LF	0.40%	8" SDR-35
MH# B3	MH# B2	193 LF	0.39%	8" SDR-35
MH# B2	MH# B1	365 LF	0.41%	8" DR-18
MH# B1	EX. MH# B	79 LF	0.82%	8" DR-18

LEGEND	
SEWER MANHOLE	TREE
SEWER CLEANOUT	WATER LINE
WATER SERVICE	SEWER LINE
FIRE HYDRANT	DRAINAGE PIPE
VALVE	CATCH BASIN
POST INDICATOR VALVE	JUNCTION BOX
FDC	POWER POLE
GAS VALVE MARKER	OVERHEAD POWER
TELEPHONE PEDESTAL	UNDERGROUND POWER
CABLE PEDESTAL	CONCRETE
LIGHT POLE	TRANSFORMER
POWER BOX	SIGN

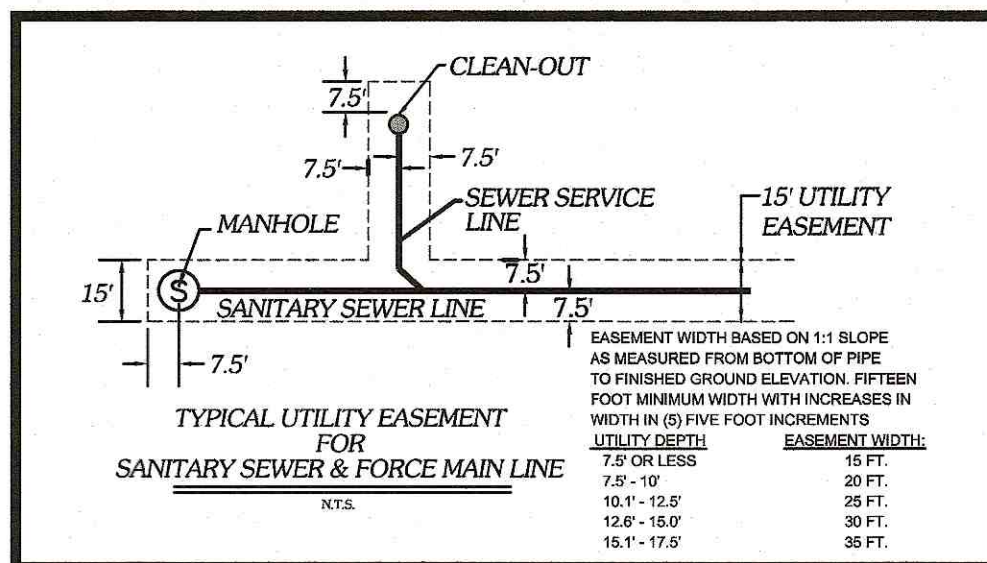

LIST OF SEWER MATERIALS	
DATE OF INSTALLATION: SPRING / SUMMER 2018	
574 LF. OF 8" SDR-35 SEWER LINE	
444 LF. OF 8" DR-18 SEWER LINE	
79 LF. OF 12" STEEL SLEEVE CASING	
5 - SEWER MANHOLES	
1 SINGLE SEWER SERVICES	

HORIZONTAL DATUM: NAD 83(11)
VERTICAL DATUM: NAVD 88

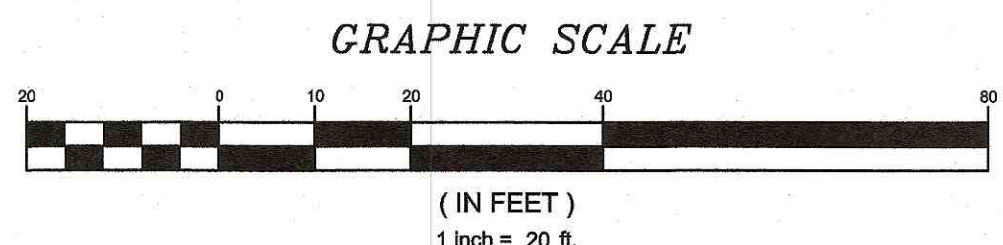

UTILITY CONTRACTOR:
EXPRESS CONSTRUCTION
635 HARRY ROAD
CONWAY, SC 29525
PHONE: 843-241-5761

CONTRACTOR:
RING CONSTRUCTION
111 WHITE OAK FOREST PLACE
CONWAY, SC 29527
PHONE: 843-397-8000

CONTRACTOR:
MONTETH CONSTRUCTION CORP.
1200 48TH AVENUE
MYRTLE BEACH, SC 29577
PHONE: 843-839-2040

OWNER:
CONWAY HOSPITAL INC.
300 SINGLETON RIDGE ROAD
CONWAY, SC 29526
PHONE: 843-347-7111

ENGINEER:
CASTLES ENGINEERING, INC.
2024 CORPORATE CENTRE DRIVE
SUITE 102
MYRTLE BEACH, SC 29577
PHONE: 843-448-0910

RECORD DRAWING NOTES:

- PARENT NUMBER# PIN# 44015010054 AND TMS# 1790005020
- OWNER OF RECORD: CONWAY HOSPITAL INC. 300 SINGLETON RIDGE ROAD CONWAY, SC 29526 PHONE: 843-347-7111
- ALL DISTANCES SHOWN ARE HORIZONTAL DISTANCES.
- VERTICAL SEPARATION OF THE UTILITY LINES & DRAINAGE PIPES SHOWN HEREIN DETERMINED BY CALCULATION ARE APPROXIMATE.
- RECORD DRAWINGS PREPARED FROM FIELD SURVEY AND INFORMATION PROVIDED BY CONTRACTOR.

I HEREBY CERTIFY THAT THE WATER DISTRIBUTION AND SANITARY SEWER SYSTEM SHOWN HAVE BEEN INSTALLED IN SUBSTANTIAL ACCORDANCE WITH THE APPROVED CONSTRUCTION DRAWINGS AND SPECIFICATIONS AND ARE, TO THE BEST OF MY KNOWLEDGE, AS SHOWN ON THESE RECORD DRAWINGS.

W. AUSTIN GRAHAM P.E.
#32541
REGISTRATION NUMBER

DATE: 4-26-19

14-482-0077-1/5