


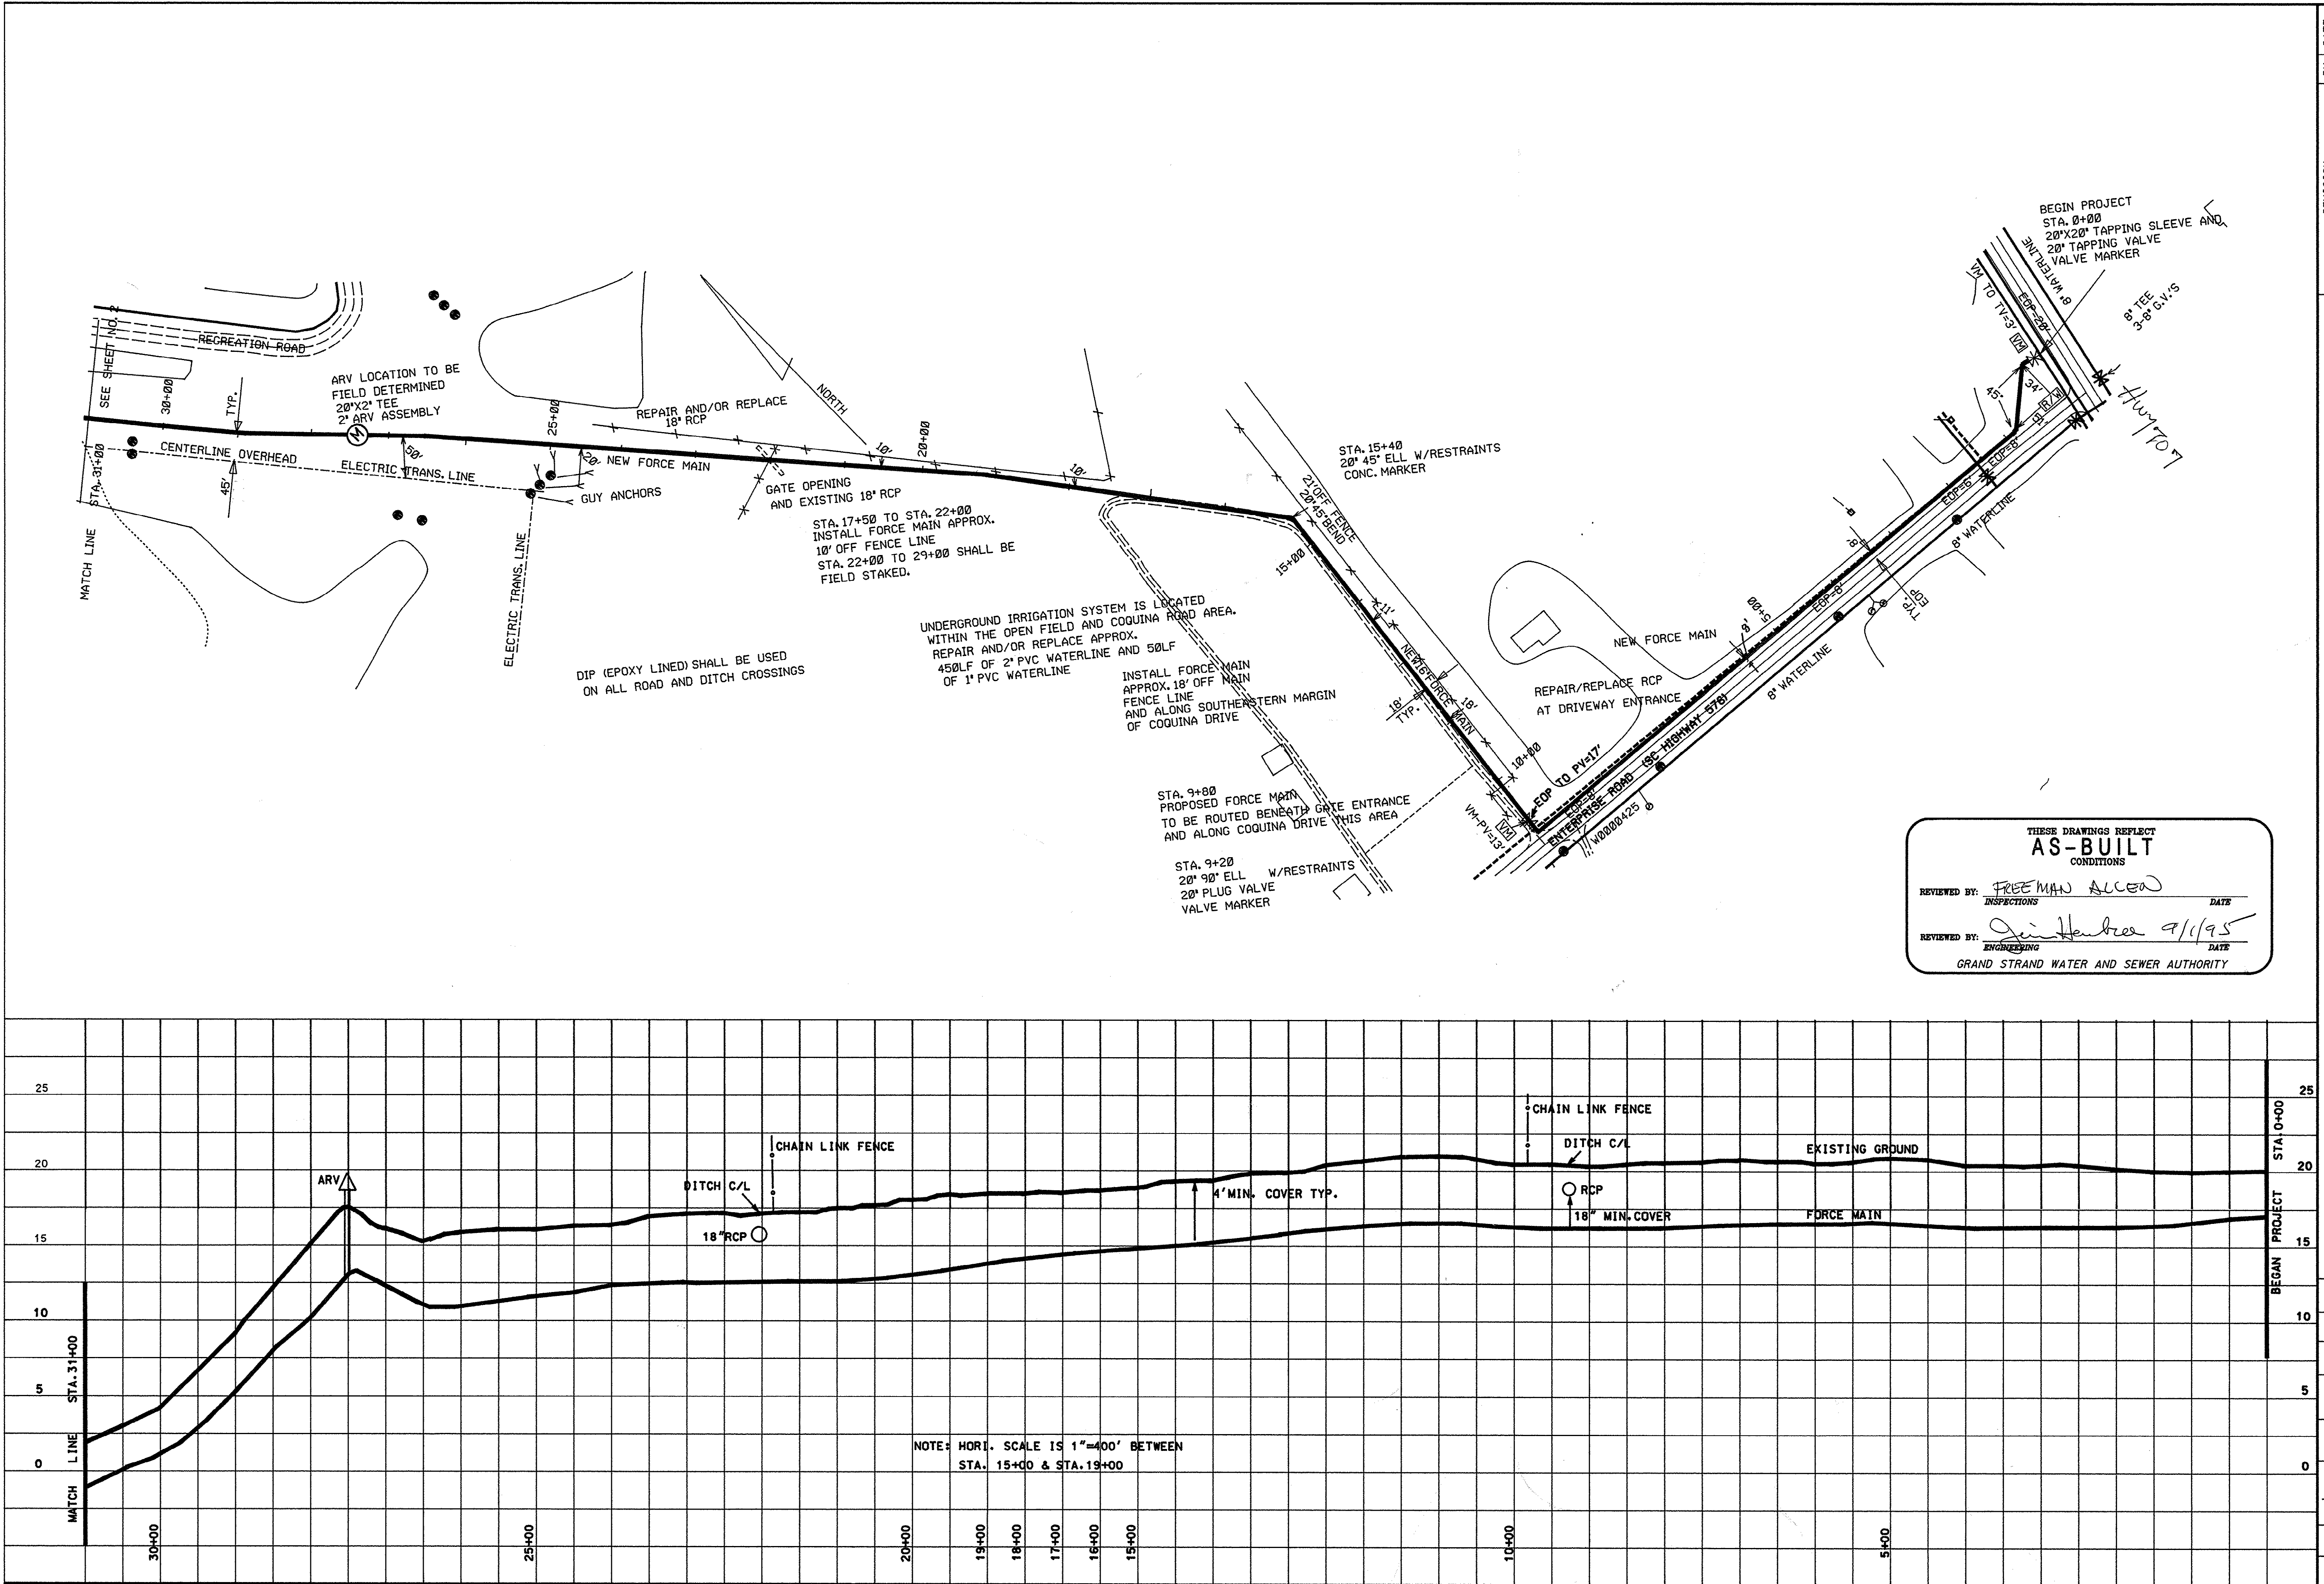


THESE DRAWINGS REFLECT
AS-BUILT
CONDITIONS

REVIEWED BY: Freeman Alcedo DATE: _____
INSPECTIONS

REVIEWED BY: Jim Hembree 9/1/95 DATE: _____
ENGINEERING

GRAND STRAND WATER AND SEWER AUTHORITY

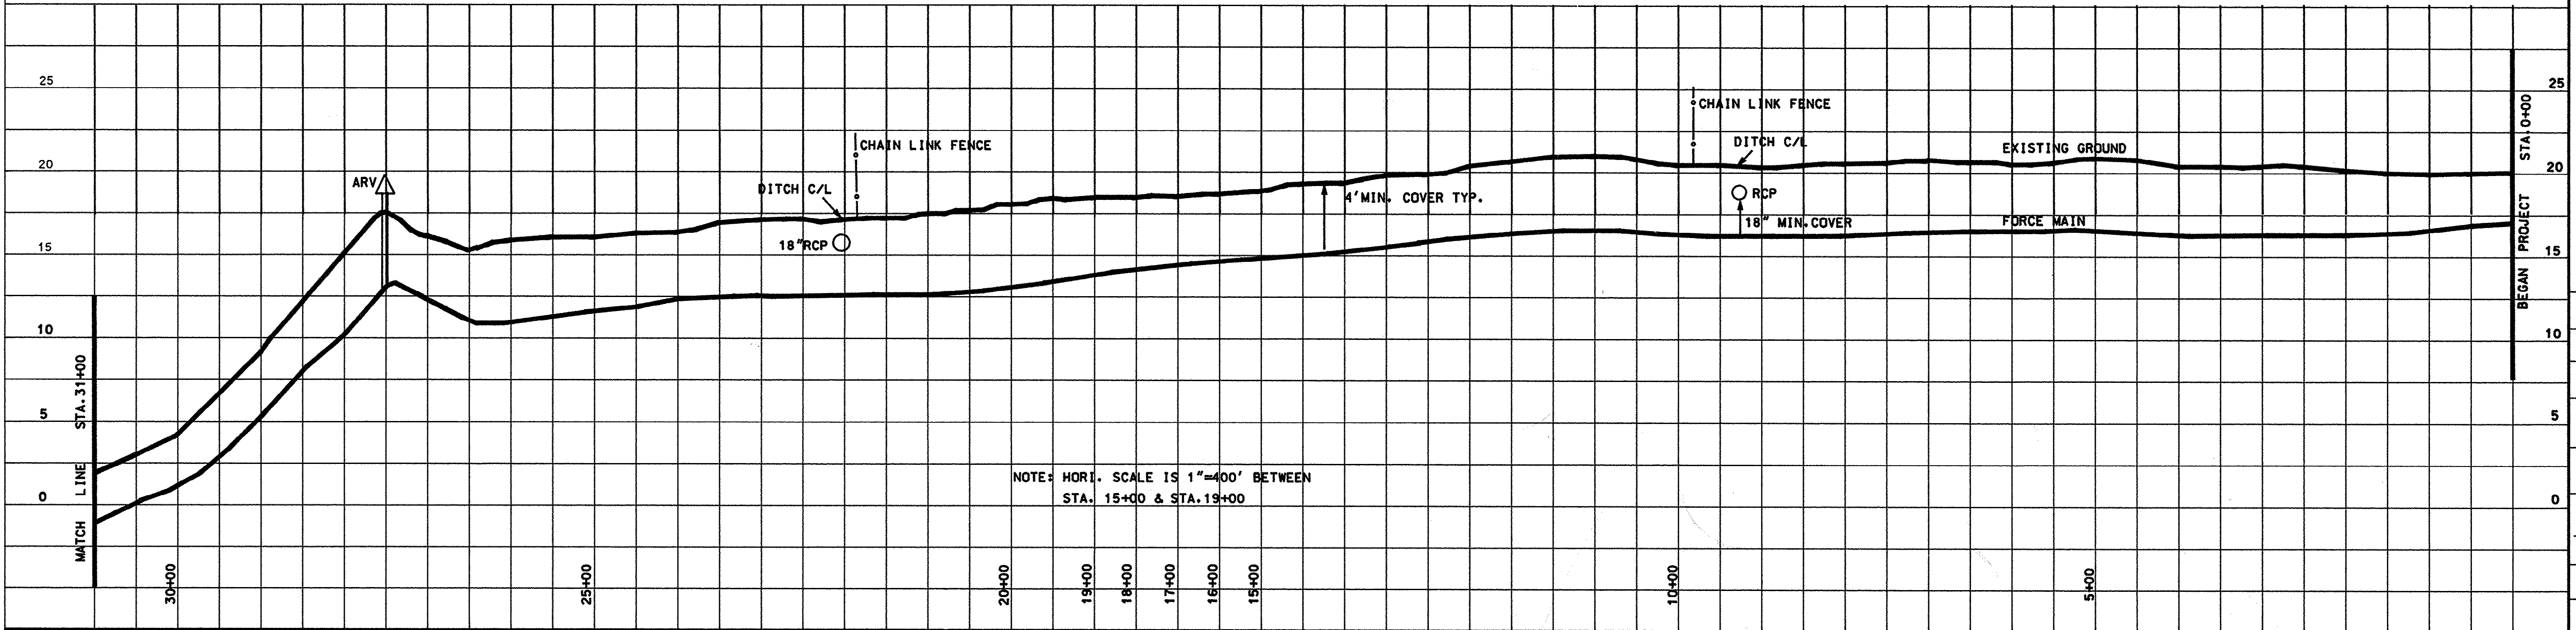

REVISION	AS-BUILT	BY	DATE
		AW	7/14/95

**SC HWY 544 (CABOT'S CREEK SD) TO
SC HWY 707 FORCE MAIN**

GRAND STRAND WATER & SEWER AUTHORITY

P.O. BOX 187, CONWAY, SC 29526
TELEPHONE 803-247-4641 OR 449-1646

PERMIT # 18754-DW
DATE OCT. 13, 1993
PROJECT # 08-734-01

DATE: JAN. 1993
SCALE: H 1" = 100'
V 1" = 5'

FILENAME: CS.DGN

DRAWN BY: **ROBERT PERKINS**

CHECKED BY: Jim Hembree
JIM HEMBREE

APPROVED BY: Fred E. Akel
FRED E. AKEL P.E. #12859

SHEET 1 OF 7

DRAWING NO. 16-53-007/8-S