

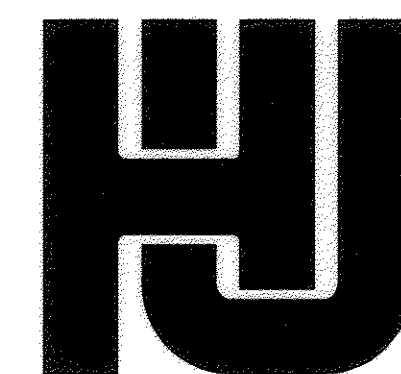
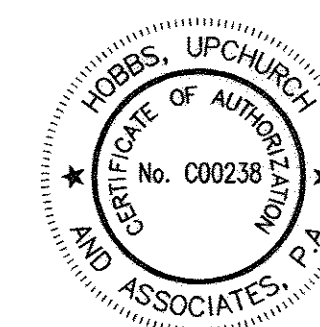


PERRY ROAD WATER BOOSTER PUMP STATION (UPGRADE)

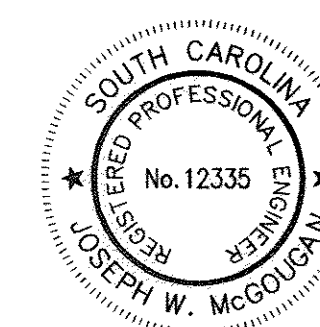

11x17 ARE TRUE 1/2 SCALE
AS-BUILT
9-5-2008

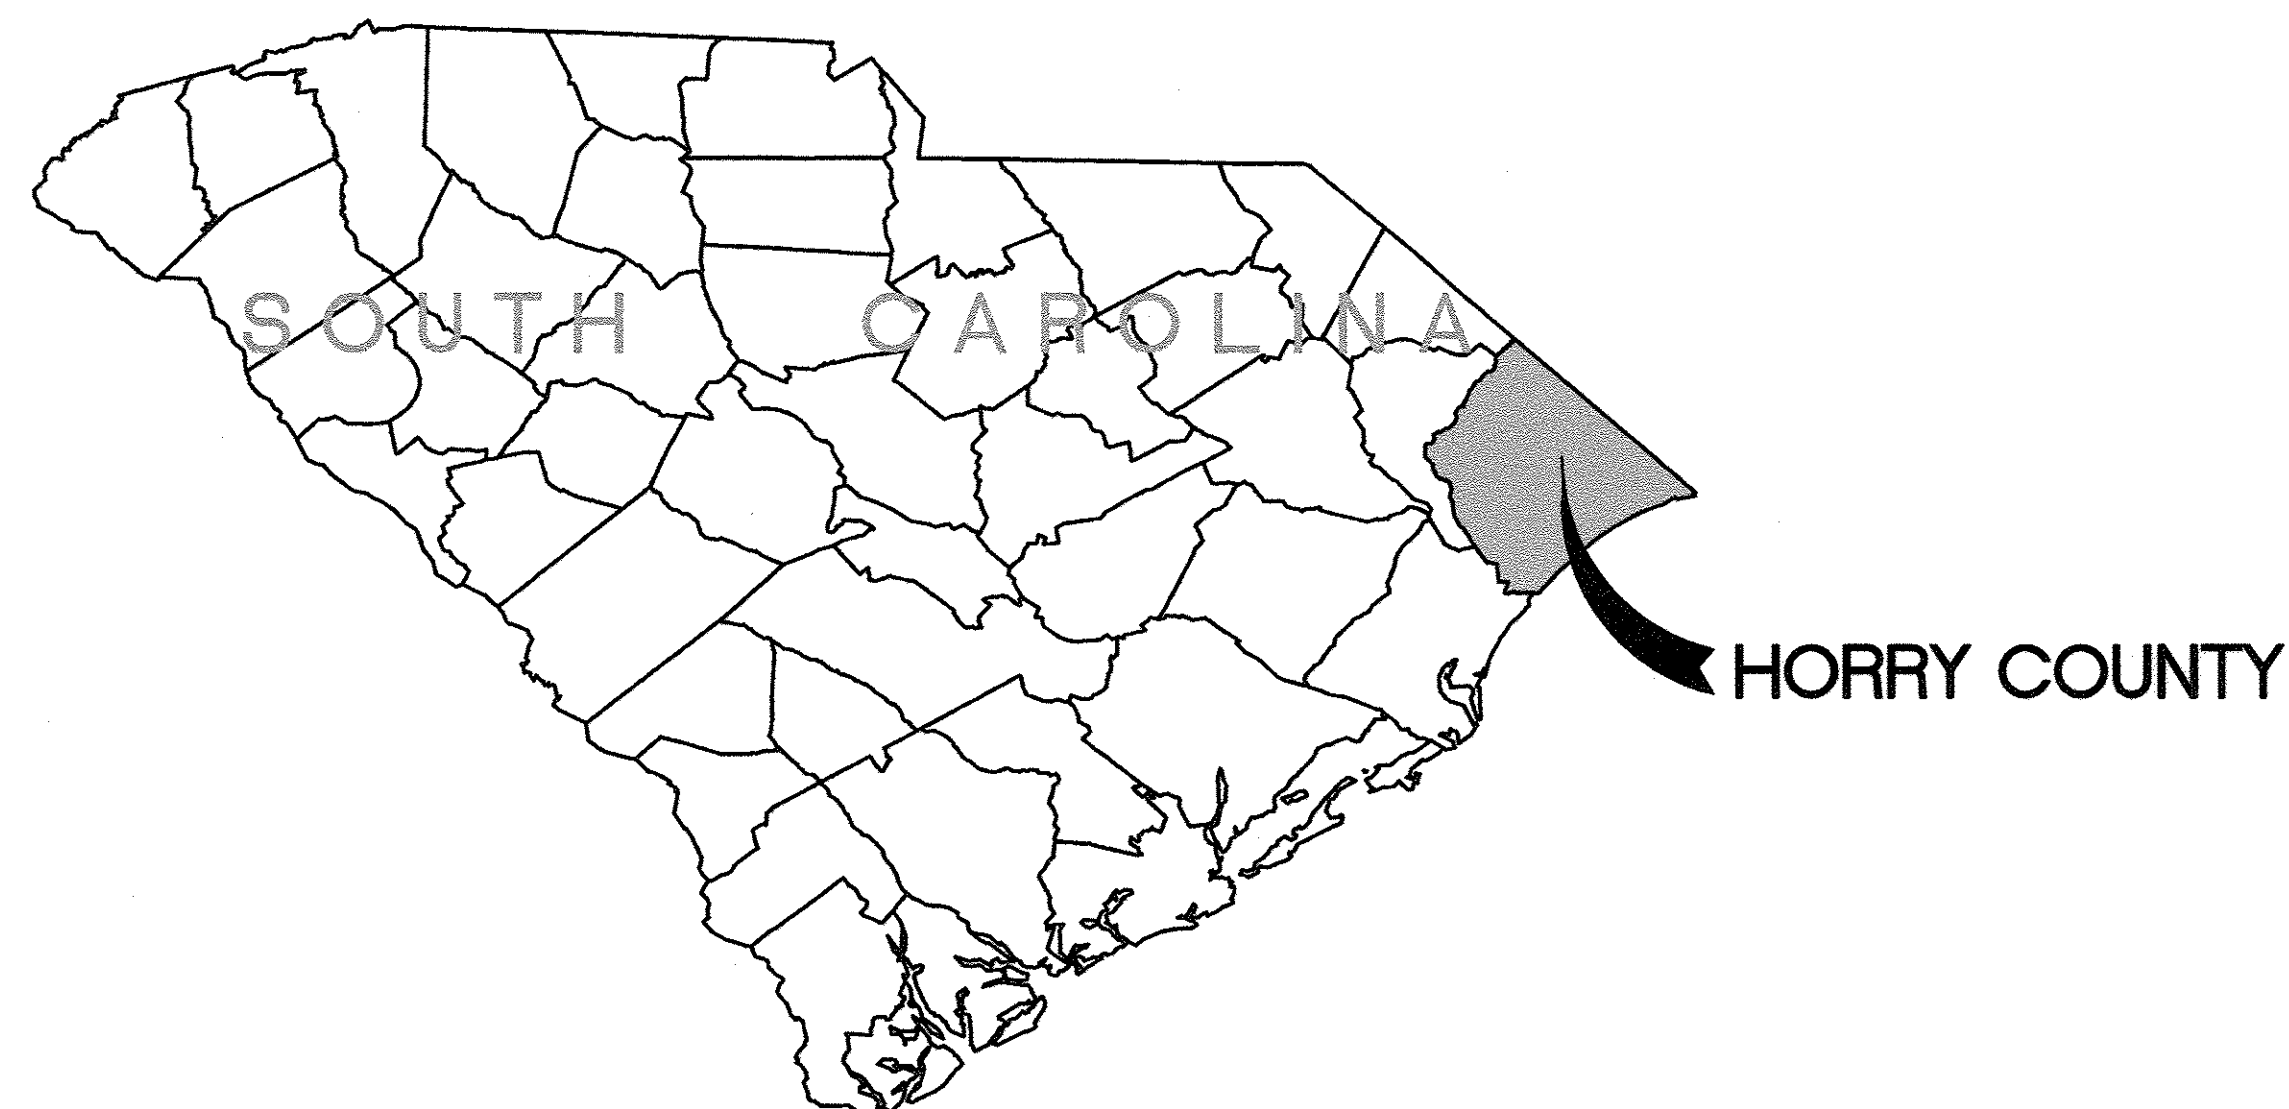

HOBBS, UPCHURCH & ASSOCIATES, P.A.

CONSULTING ENGINEERS



MYRTLE BEACH, SOUTH CAROLINA 29577

PHONE: (843) 626-1910 FAX: (843) 626-1745

GENERAL CONSTRUCTION ABBREVIATIONS

•	NUMBER OR FOUND	D	DIAMETER	INFL	INFLUENT	R.C.P.	REINFORCED CONCRETE PIPE
φ	DIAMETER	DIA	DIAMETER	INS.	INSIDE	RAD.	RADIUS
+	AND	D.I.P.	DUCTILE IRON PIPE	INV.	INVERT	RAS	RETURN ACTIVATED SLUDGE
<	LESS THAN	DISCH.	DISCHARGE	JT.	JOINT	RED	REDUCER
<=	LESS THAN OR EQUAL TO	DP	DEEP	JTS	JOINTS	REF	REFERENCE
>	GREATER THAN	DWLS.	DOWELS	L.L.O.	LONG LEG OUT	REINF	REINFORCING OR REINFORCED
@	AT	EF	EACH FACE	LB	POUND	REQ'D	REQUIRED
A.B.	ANCHOR BOLT	EJ.	EXPANSION JOINT	LG	LONG	S.S.	STAINLESS STEEL
AFF.	ABOVE FINISHED FLOOR	EA	EACH	L.P.	LOW POINT	SCH.	SCHEDULE
ADDL.	ADDITIONAL	EFF.	EFLUENT	M.J.	MECHANICAL JOINT	SH	SHEET
ALUM	ALUMINUM OR ALUM	EL	ELEVATION	MATL.	MATERIAL	SIM	SIMILAR
APPROX	APPROXIMATE(LY)	ELEV	ELEVATION	MAS	MASONRY	SO2	SULFUR DIOXIDE
ARCH	ARCHITECTURAL	EQ	EQUAL	MAX	MAXIMUM	SPA	SPACES
BM	BENCH MARK OR BEAM	EQUIP	EQUIPMENT	MECH	MECHANICAL	SQ.	SQUARE
BOTT.	BOTTOM	EXIST.	EXISTING	MFR	MANUFACTURER	STD.	STANDARD
B.W.	BLOCK WALL	EXP.	EXPANSION	MH	MANHOLE	STL	STEEL
C.I.	CAST IRON	F.E.S.	FLARED END SECTION	MIN	MINIMUM	STN	STAINLESS
C/C	CENTER TO CENTER	F.R.P.	FIBERGLASS	MNTG	MOUNTING	SW.	SLAB WIDTH
CAP	CAPACITY	FIG	FIGURE	N.P.W.	NONPOTABLE WATER	SWD.	SIDE WALL DEPTH
CIRCUM	CIRCUMFERENCE	FIN	FINISHED	N.T.S.	NOT TO SCALE	T/	TOP OF
CL	CLAY	FL	FLANGE	NO.	NUMBER	T.C.J.	TYP. CONTROL JOINT, CONSTRUCTION JOINT
CLR.	CLEARANCE	FLR	FLOOR	O.C.	ON CENTER	THRD	THREAD(S,ED)
CL	CENTERLINE	FTG	FOOTING	O/O	OUTSIDE TO OUTSIDE	TRICK	TRICKLING
CL2	CHLORINE	GALV	GALVANIZED	OPNG	OPENING	TYP	TYPICAL
CLARIF	CLARIFIER	HDUE	HARDWARE	OX	OXIDATION	U.O.N.	UNLESS OTHERWISE NOTED
CHEM.	CHEMICAL	HK	HOOK	PE	PLAIN END	VERT	VERTICAL
COL	COLUMN	HORIZ	HORIZONTAL	FED	PEDESTAL	WWF.	WELDED WIRE FABRIC
CONC.	CONCRETE	H.P.	HIGH POINT	PL	PLATE	W/	WITH
CONST	CONSTRUCTION	HYD	HYDRANT	PLCS.	PLACES	W/O	WITHOUT
CONT	CONTINUOUS	ID	INSIDE DIAMETER	PROJ	PROJECTION	WAS	WASTE ACTIVATED SLUDGE
CONTR	CONTRACTOR	O.D.	OUTSIDE DIAMETER	P.S.	PUMP STATION	W/L	WATER LEVEL
CU	COPPER			P.V.C.	POLYVINYL CHLORIDE		
C.W.	CONCRETE WALL						

SECTION/DETAIL LEGEND

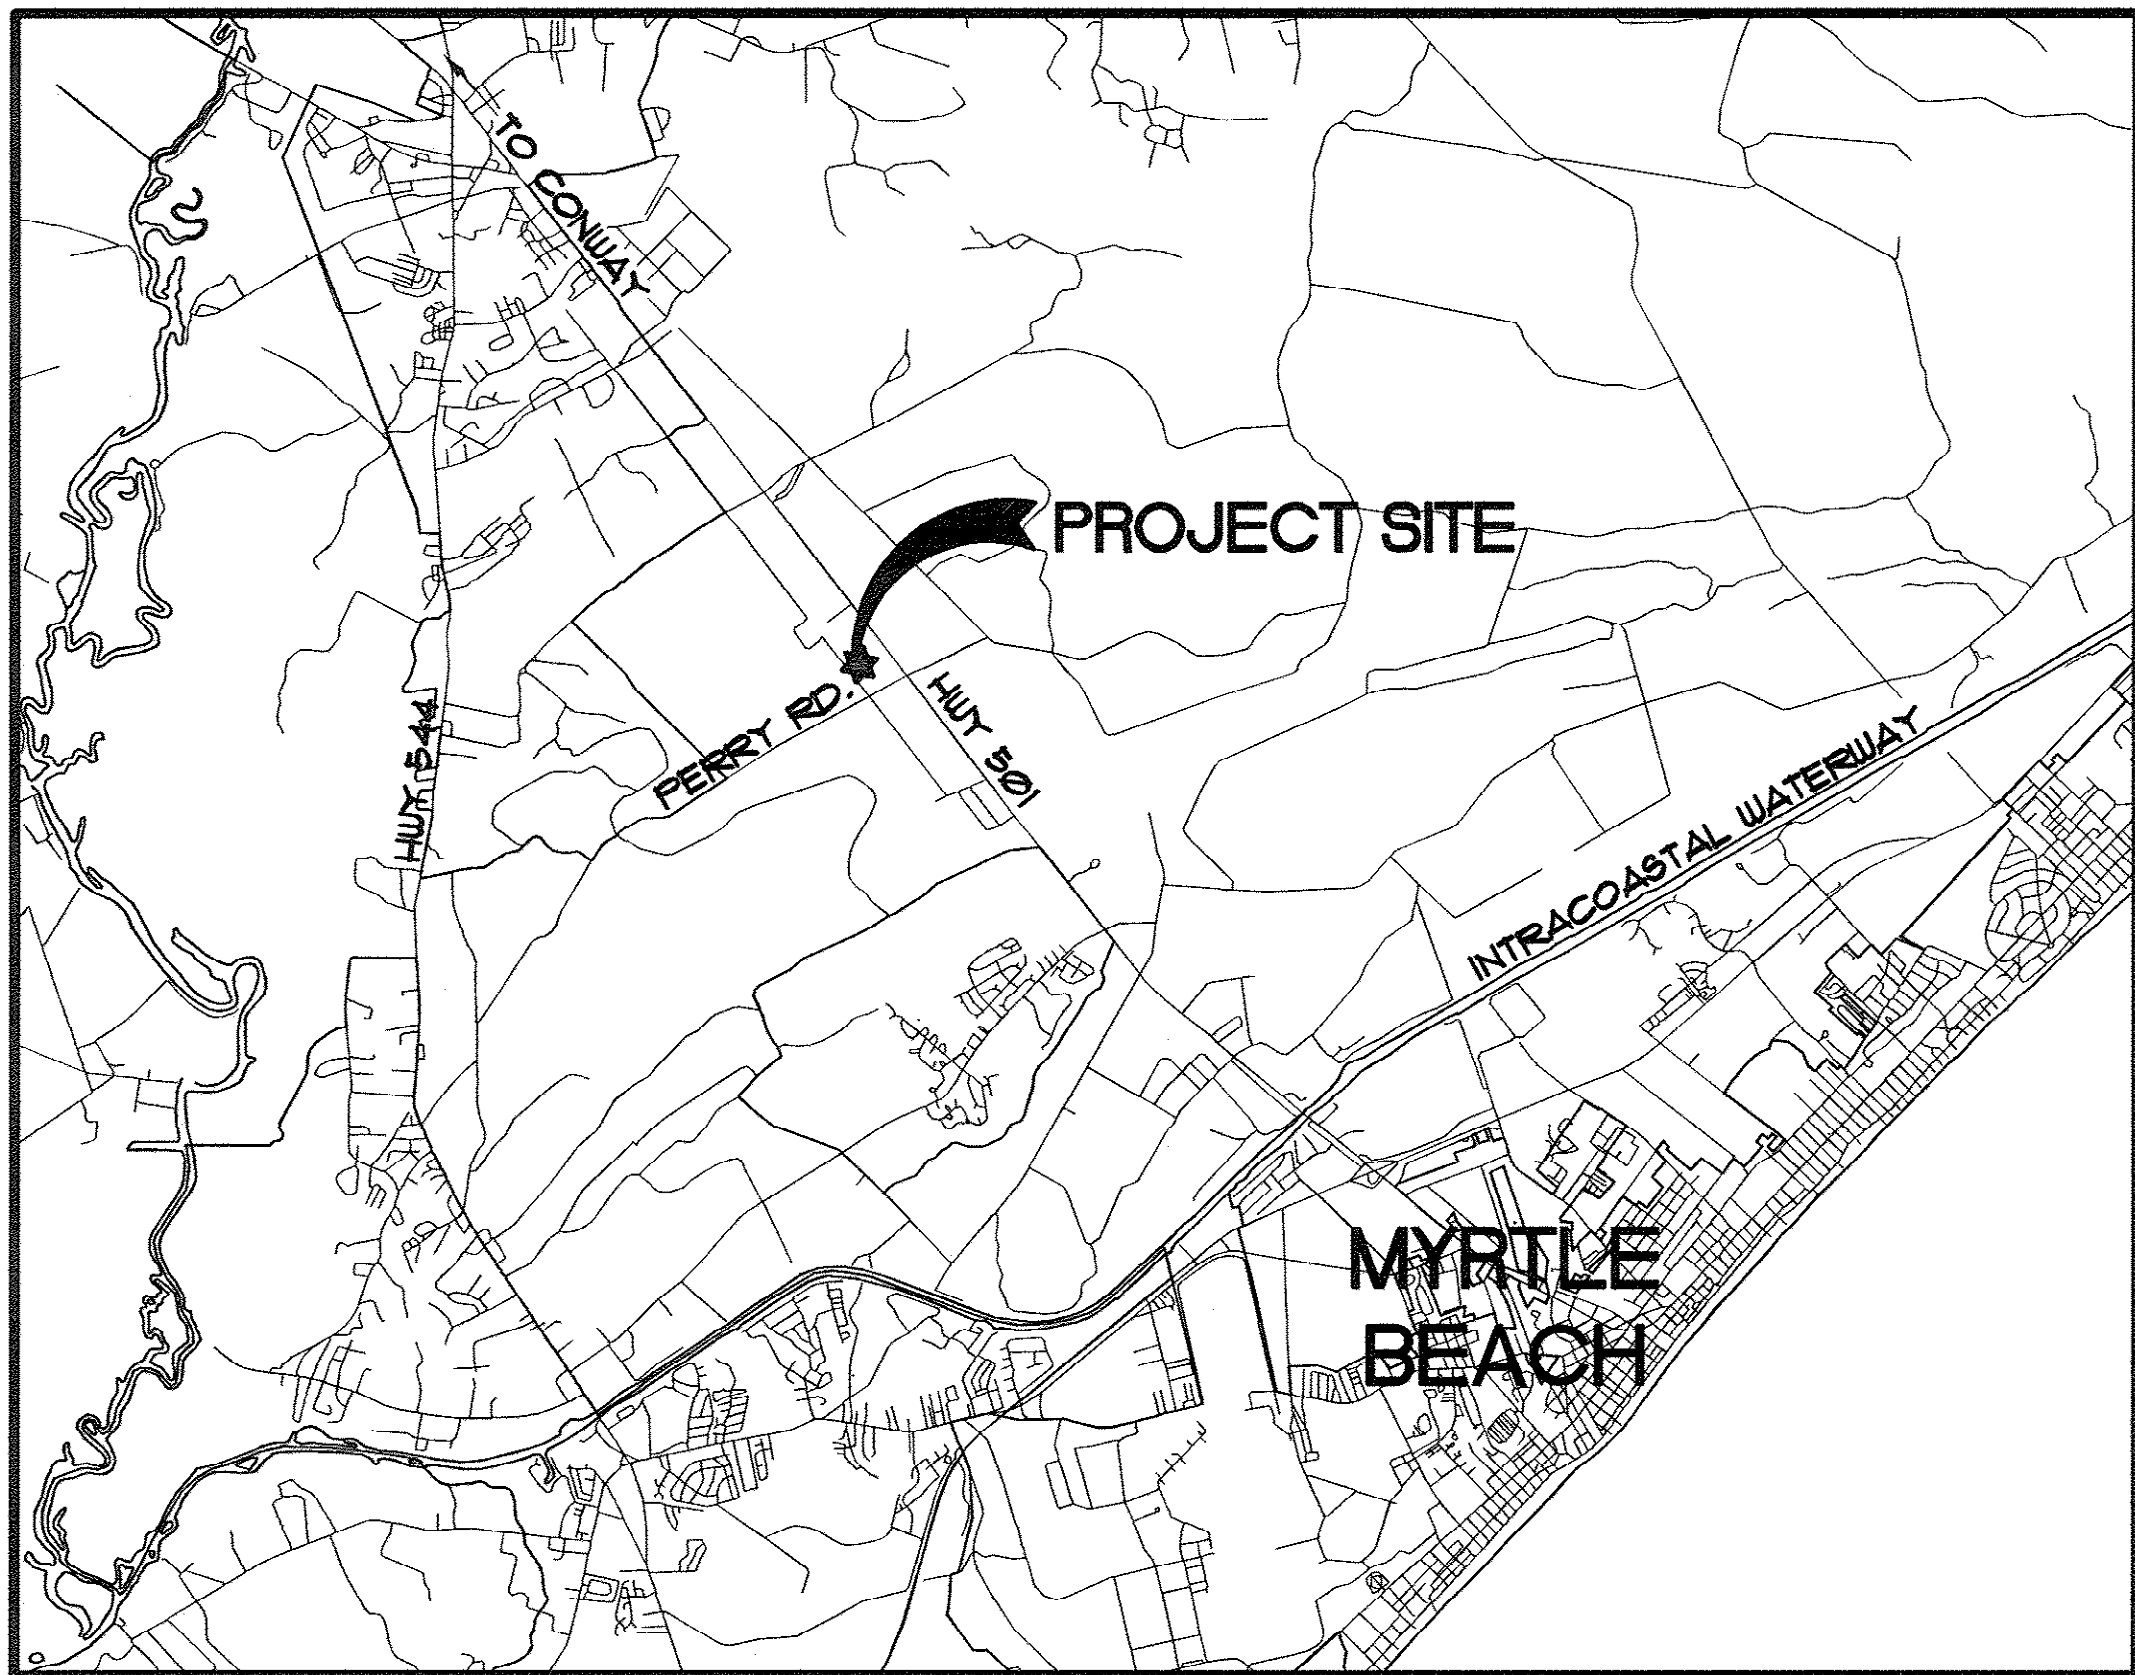
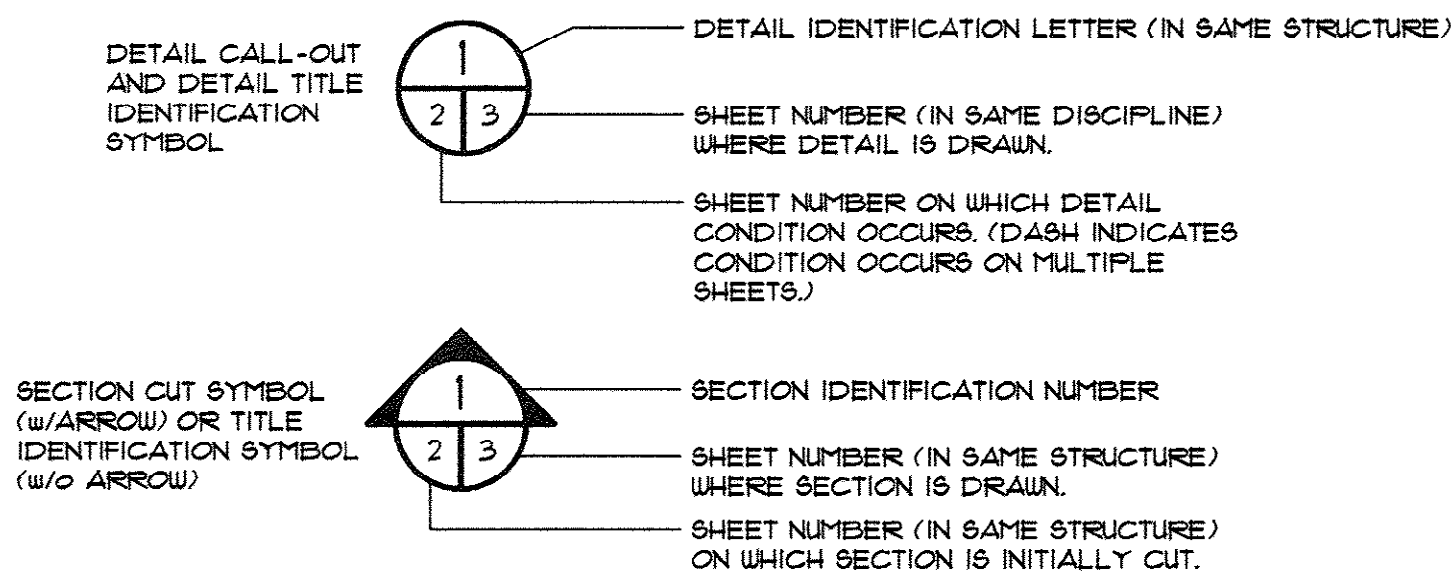


VICINITY MAP
N.T.S.

INDEX OF SHEETS

- COVER SHEET
 - VICINITY MAP AND INDEX
 - EXISTING SITE PLAN
 - NEW SITE PLAN
 - EXISTING PUMP STATION DEMOLITION LAYOUT
 - EXTERIOR DEMOLITION ELEVATIONS
 - EXISTING PUMP DEMOLITION ELEVATIONS
 - EXISTING PUMP STATION ARCHITECTURAL MODIFICATION LAYOUT
 - EXTERIOR MODIFICATION ELEVATIONS
 - WALL SECTIONS & DOOR DETAILS
 - EXISTING PUMP STATION MECHANICAL MODIFICATION LAYOUT
 - EXISTING PUMP MODIFICATION ELEVATIONS
 - EROSION CONTROL DETAILS
 - MISCELLANEOUS DETAILS
 - MISCELLANEOUS DETAILS
-
- FOUNDATION PLAN & DETAILS
 - ROOF FRAMING PLAN & DETAILS
 - TRUSS ELEVATIONS & DETAILS
 - DETAILS
-
- SYMBOL SCHEDULE, EQUIPMENT SCHEDULE AND DETAILS
 - ELECTRICAL SITE PLAN
 - EXISTING ONE-LINE POWER DIAGRAM
 - ONE-LINE POWER DIAGRAM MODIFICATIONS & ADDITIONS
 - ONE-LINE POWER DIAGRAM MODIFICATIONS & ADDITIONS
 - FINAL ONE-LINE POWER DIAGRAM
 - EXISTING POWER PLAN - DEMOLITION
 - PUMP STATION POWER PLAN-PHASE I
 - PUMP STATION POWER PLAN-PHASE II
 - PUMP CONTROL RISER DIAGRAMS
 - LIGHTING & SECURITY PLANS
 - SCHEDULES & ELEVATION
 - MISCELLANEOUS DETAILS
 - ENGINE GENERATOR SET PLAN & DETAILS
 - ENGINE GENERATOR SET CONC PAD DETAILS
-
- FLOOR PLAN, MECHANICAL LEGEND, GENERAL NOTES & SCHEDULES
 - MECHANICAL DETAILS, CONTROL SEQUENCE

REVISIONS			
SYM.	DESCRIPTION	DATE	BY

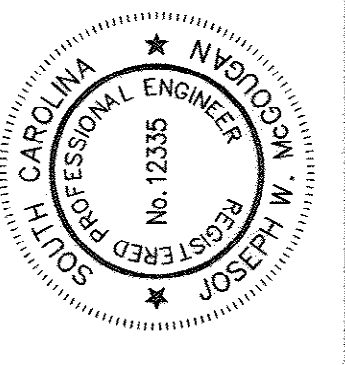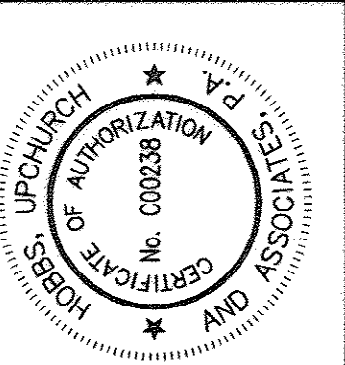

Hobbs, Upchurch & Associates, P.A.
Consulting Engineers
Myrtle Beach, South Carolina 29577
PHONE (843) 628-1910 FAX (843) 628-1748

VICINITY MAP
AND INDEX


PERRY ROAD
PUMP STATION
GRAND STRAND WATER &
SEWER AUTHORITY

DATE:	9-5-2008
DESIGNED:	JWM
DRAWN:	ALG
CHECKED:	JWM
SCALE:	AS SHOWN



SHEET NO.	2
OF 15	VERSION 4

AS-BUILT 9-5-08

12-250-002/36 W

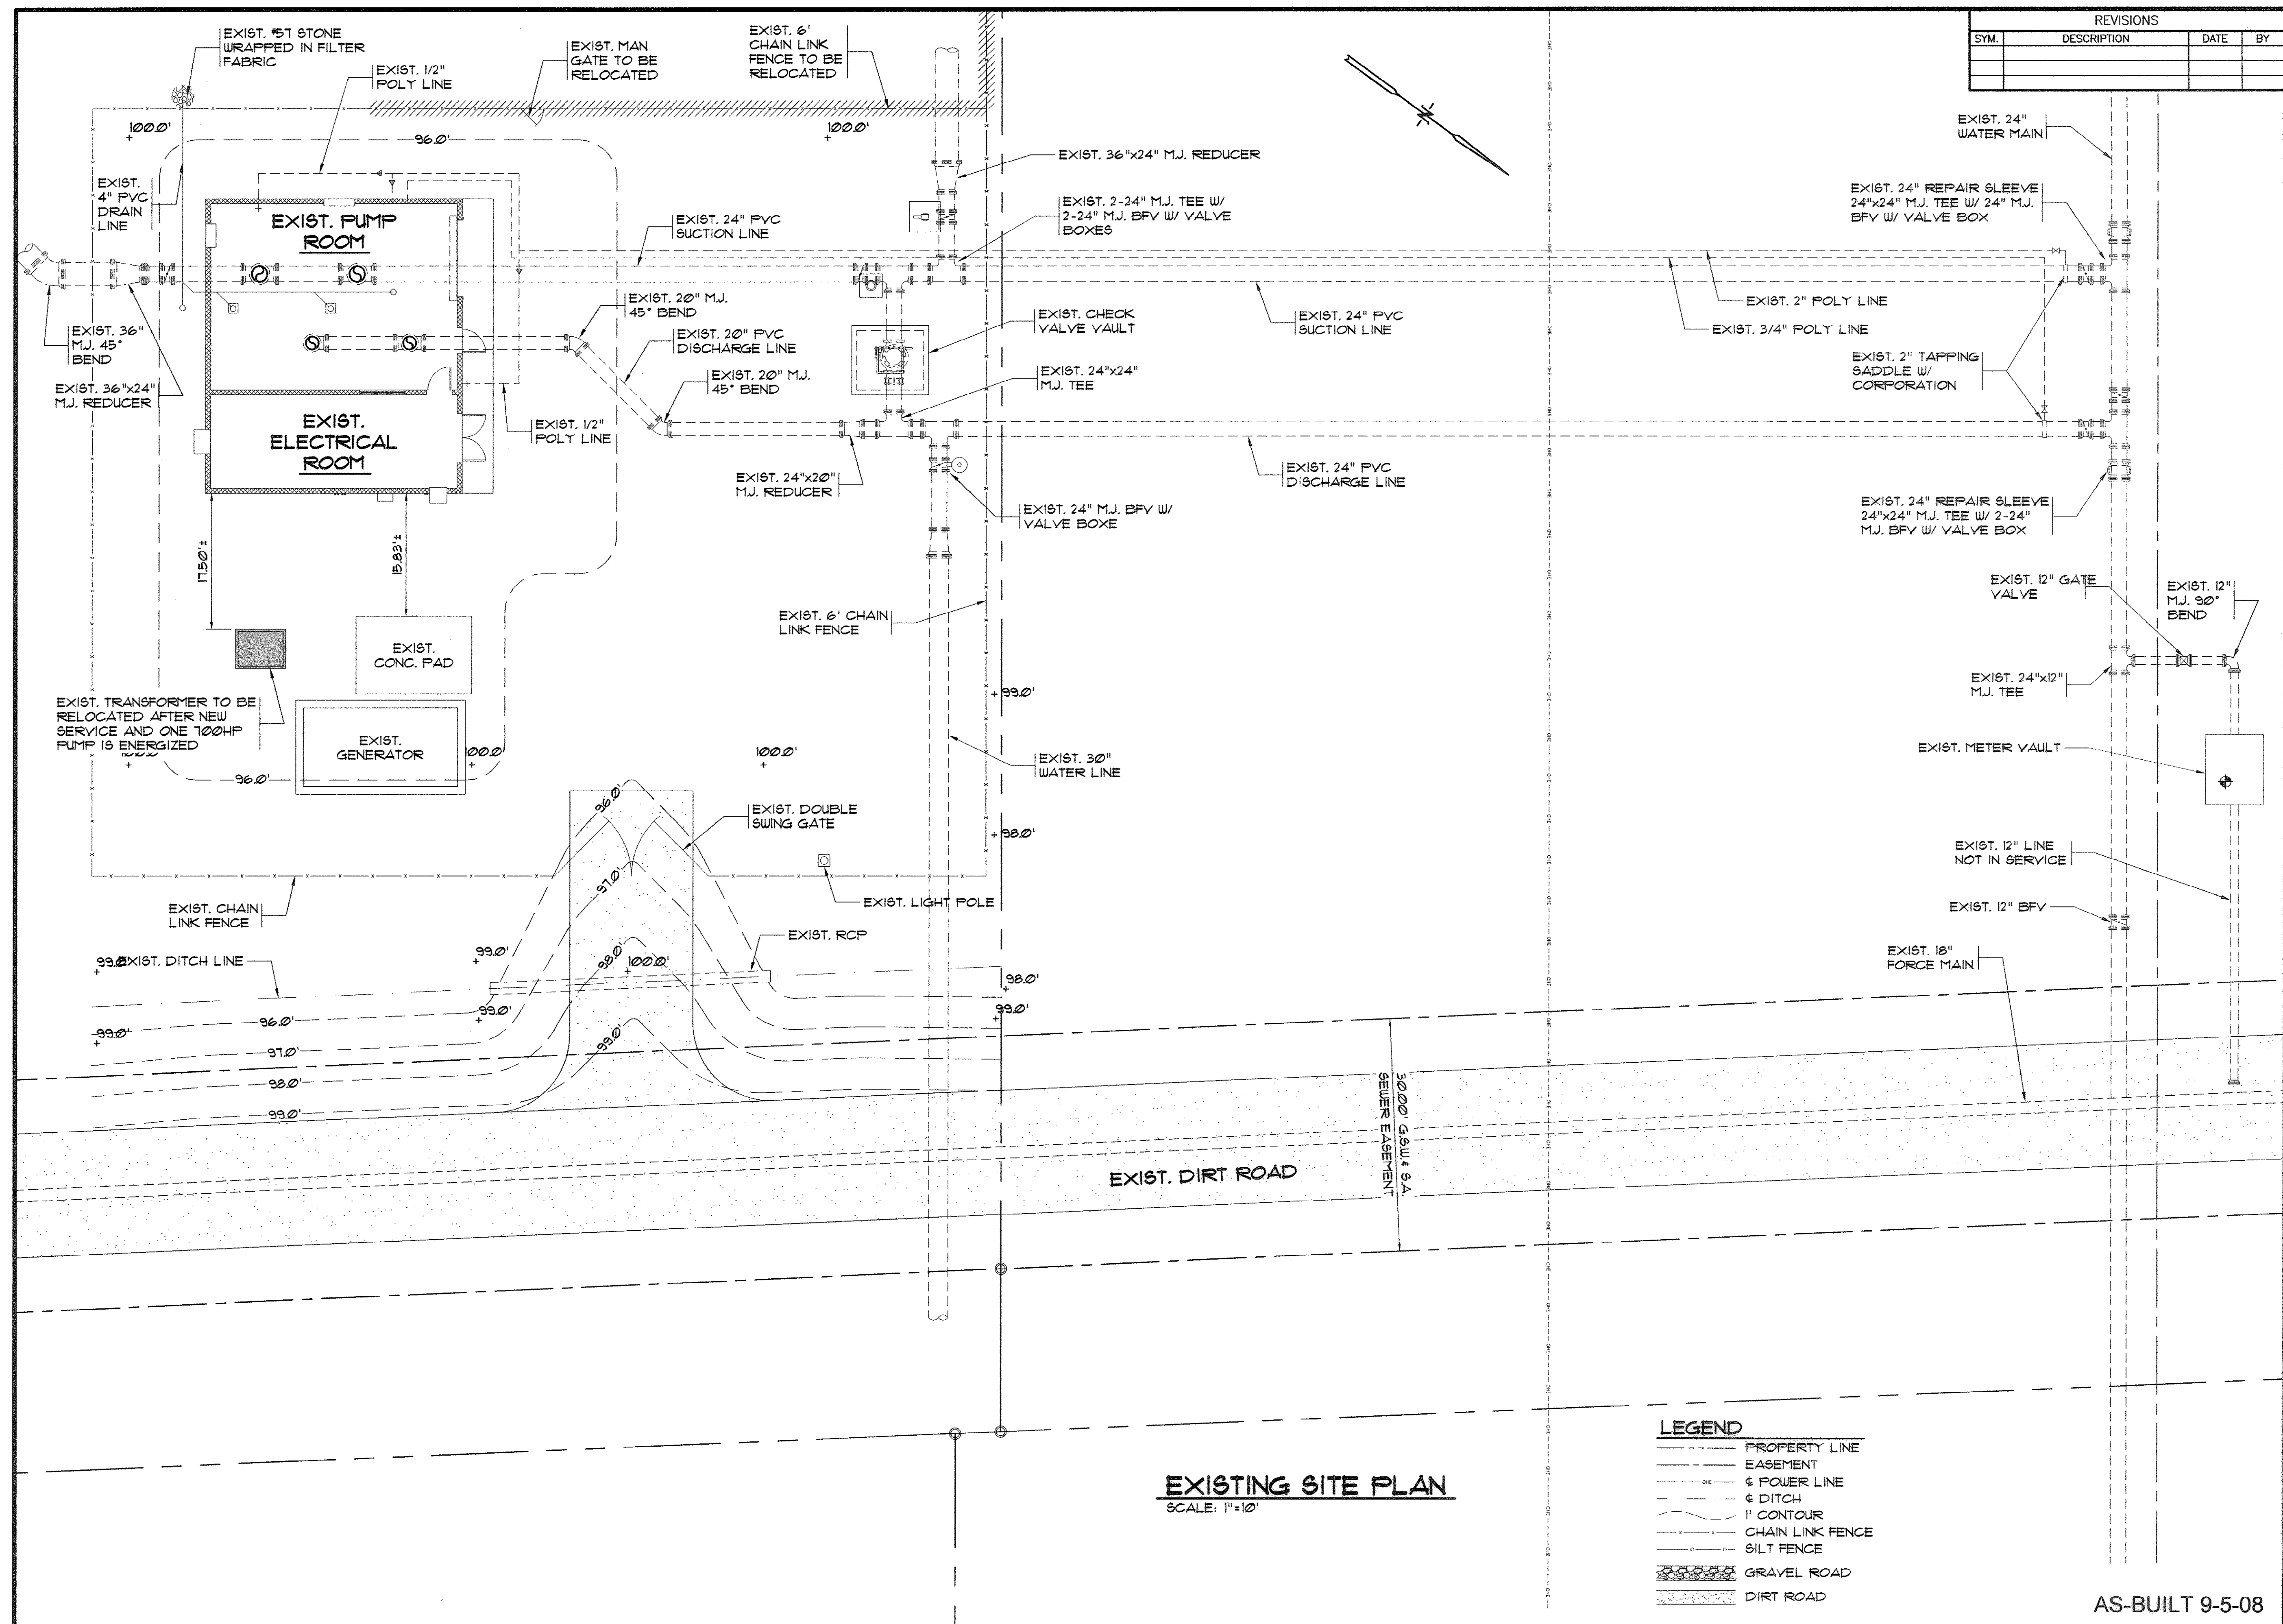

REVISIONS			
SYM.	DESCRIPTION	DATE	BY

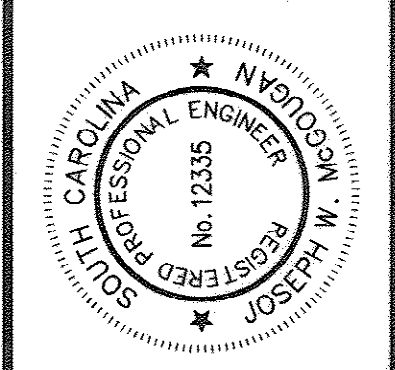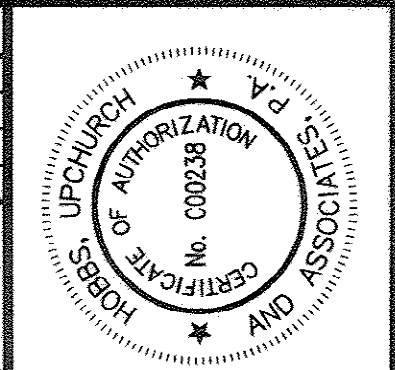

Upchurch & Associates, P.A.
 Consulting Engineers
 Myrtle Beach, South Carolina 29577
 PHONE (843) 688-1910 FAX (843) 688-1746


EXISTING SITE PLAN

**PERRY ROAD
 PUMP STATION
 GRAND STRAND WATER &
 SEWER AUTHORITY**

DATE:	9-5-2008
DESIGNED:	JWM
DRAWN:	ALG
CHECKED:	JWM
SCALE:	AS SHOWN
SHEET NO.:	3
OF:	15
VERSION:	4


AS-BUILT 9-5-08

13-350-003/36 2W

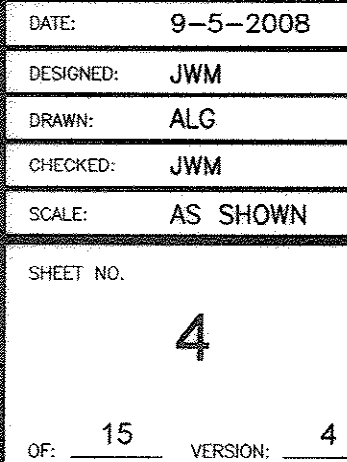

12-250-004/30

12-250-004/36 2W


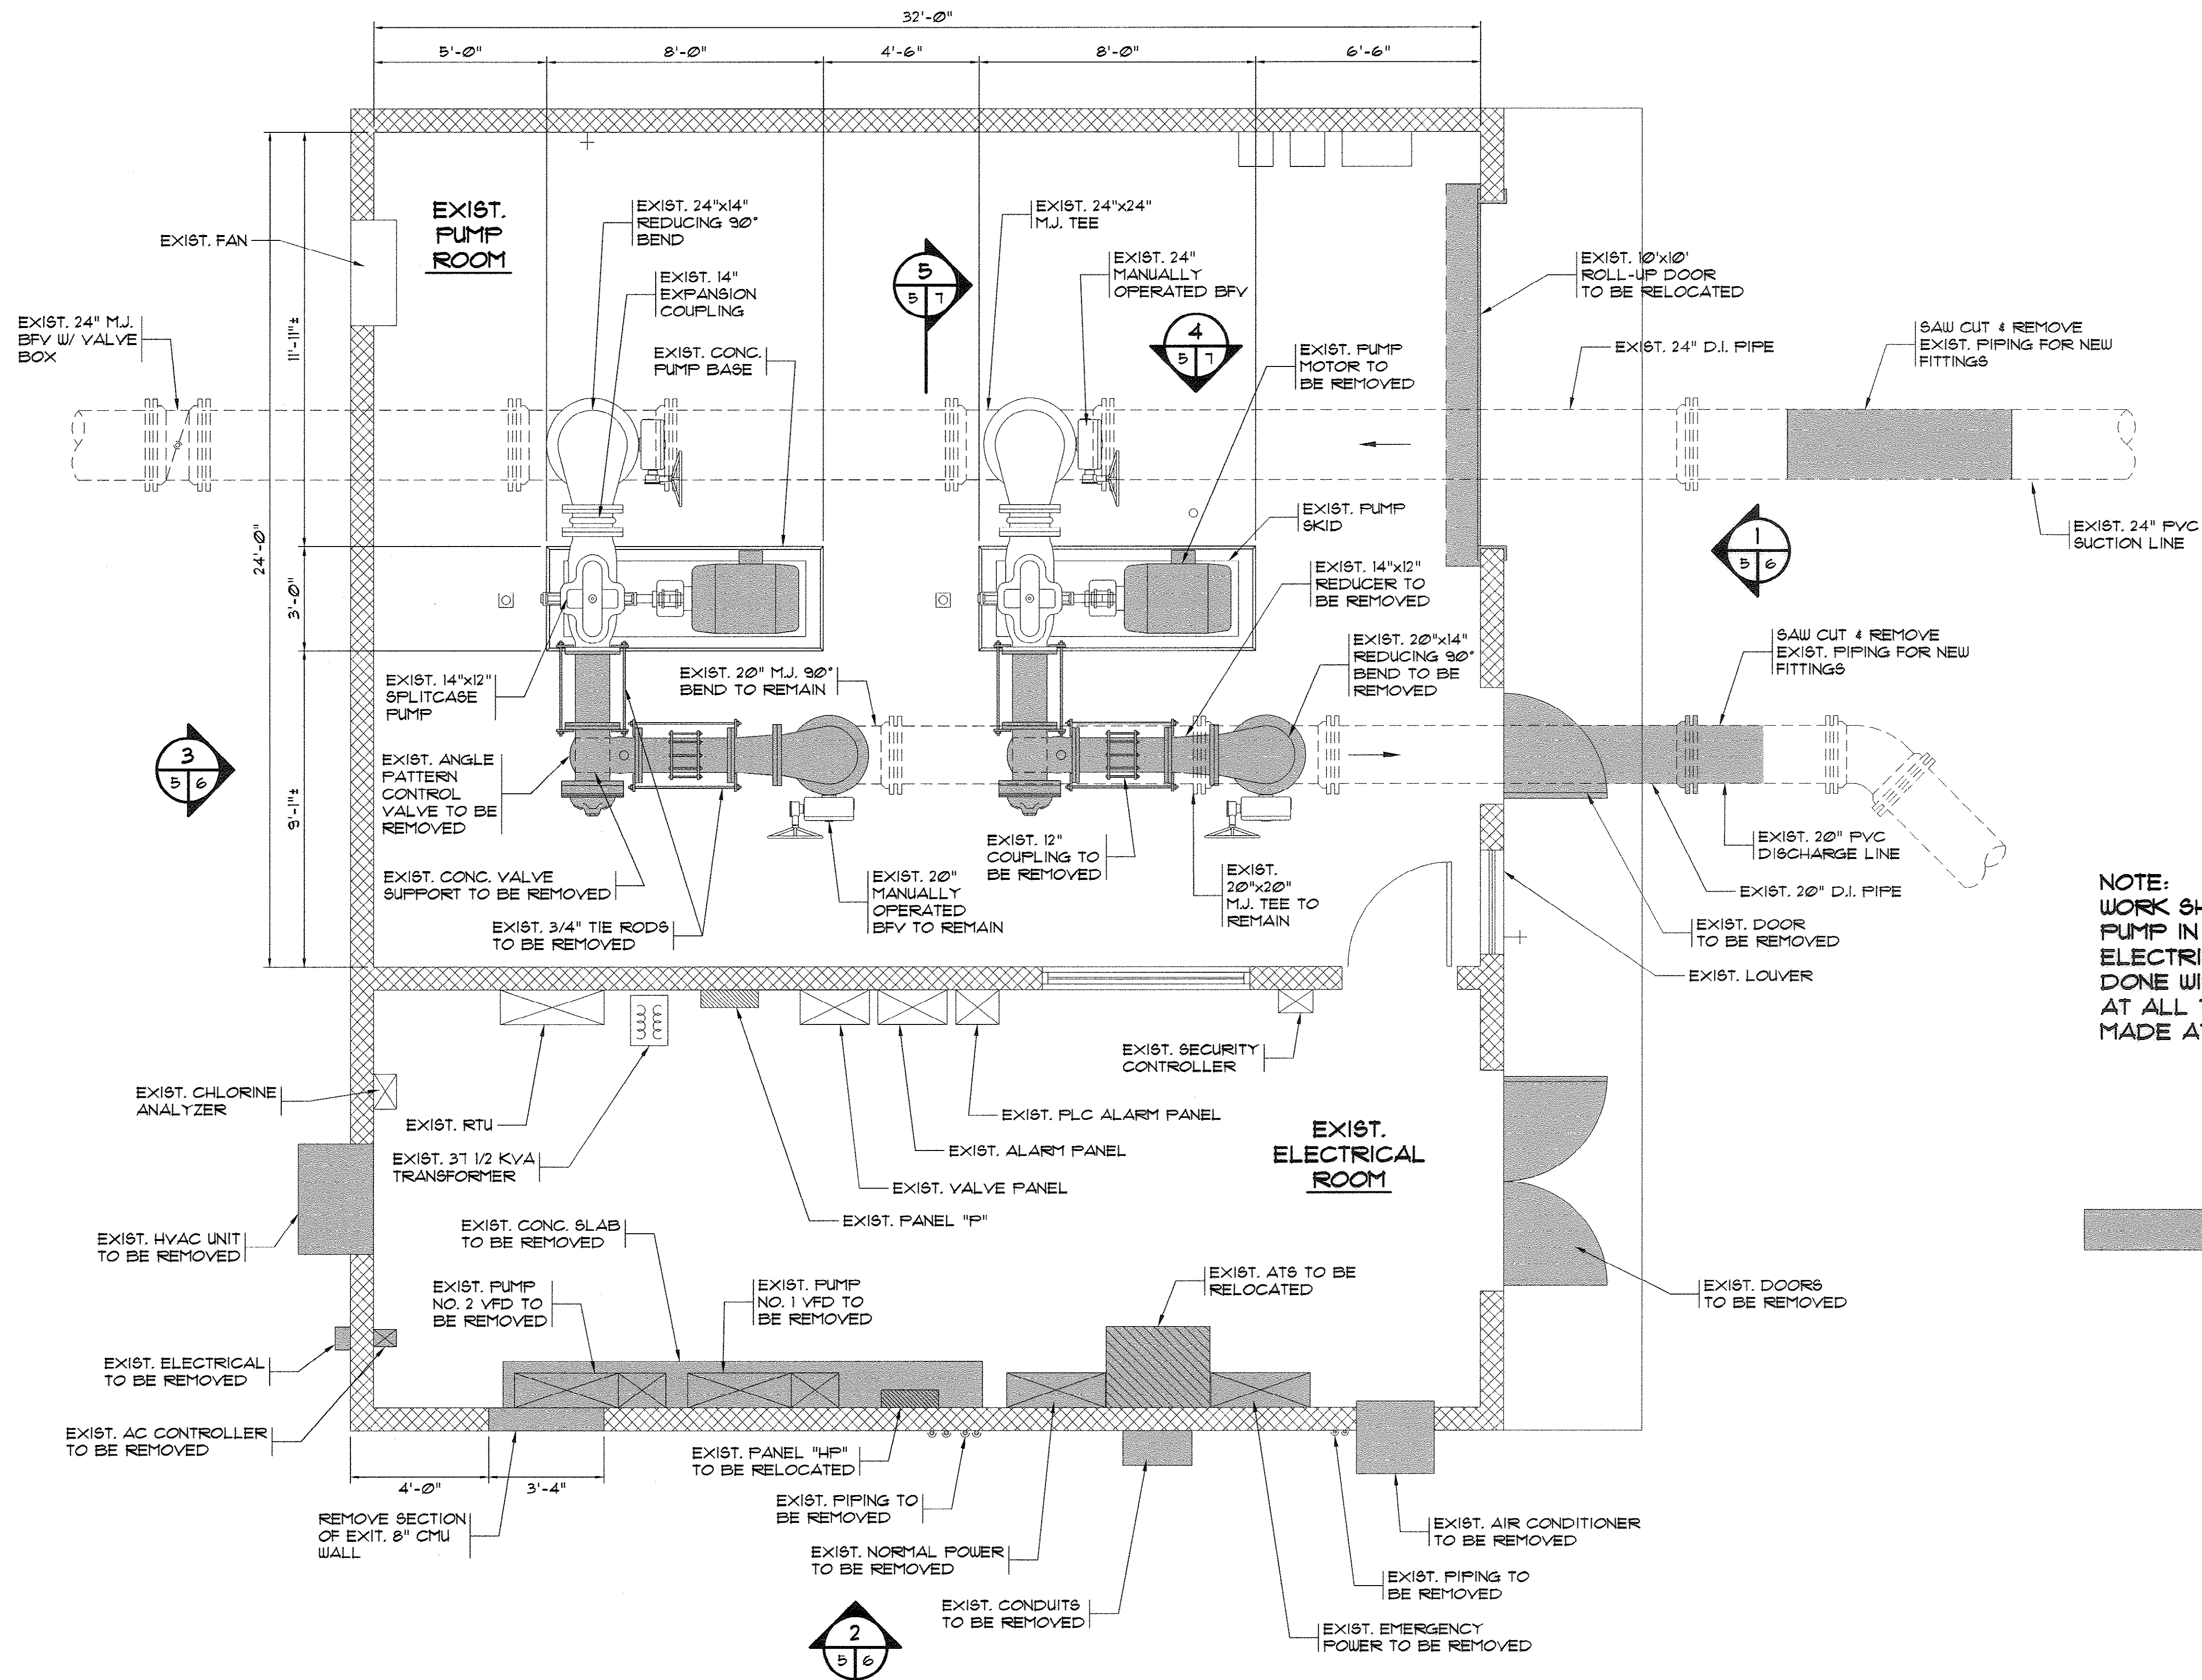


NOTE:
WORK SHALL BE DONE WITH ONE PUMP IN OPERATION AT ALL TIMES. ELECTRICAL TRANSITION MUST BE DONE WITH ONE PUMP IN OPERATION AT ALL TIMES. EXCEPTIONS MAY BE MADE AT OWNERS DISCRETION.

INDICATES PORTIONS
= TO BE REMOVED OR
RELOCATED

**EXISTING PUMP STATION
DEMOLITION LAYOUT**
SCALE: 3/8" = 1'-0"

REVISIONS			
SYM.	DESCRIPTION	DATE	BY

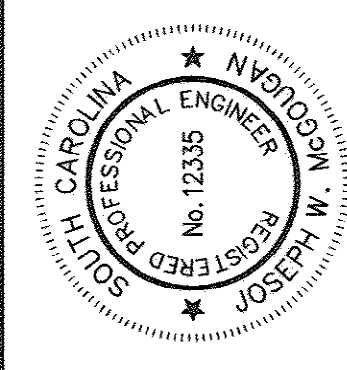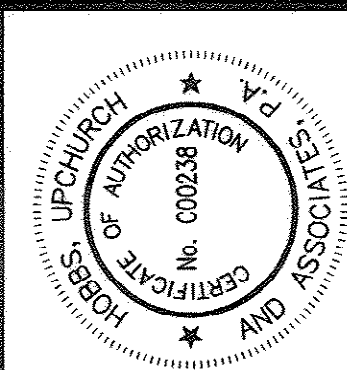

Upchurch & Associates, P.A.
Consulting Engineers
Myrtle Beach, South Carolina 29577
PHONE: (843) 654-1910 FAX: (843) 654-1745

**EXISTING PUMP STATION
DEMOLITION LAYOUT**



**PERRY ROAD
PUMP STATION
GRAND STRAND WATER &
SEWER AUTHORITY**

DATE:	9-5-2008
DESIGNED:	JWM
DRAWN:	ALG
CHECKED:	JWM
SCALE:	AS SHOWN
SHEET NO.	5

AS-BUILT 9-5-08

12-250-005/36 2/

REVISIONS			
SYM.	DESCRIPTION	DATE	BY

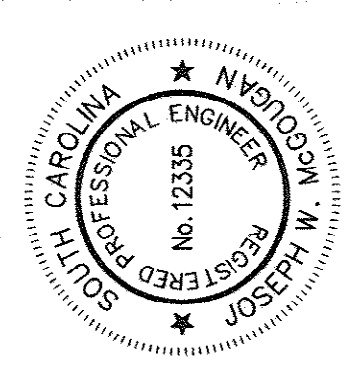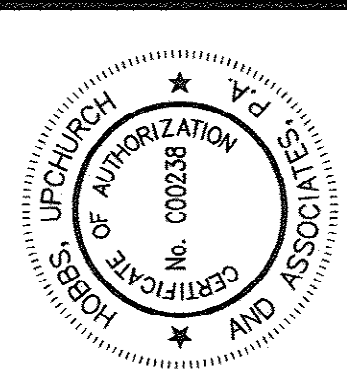

Hobbs, Upchurch & Associates, P.A.
 Consulting Engineers
 Myrtle Beach, South Carolina 29577
 PHONE: (843) 684-1910 FAX: (843) 684-1748


**EXTERIOR
 DEMOLITION
 ELEVATIONS**

**PERRY ROAD
 PUMP STATION
 GRAND STRAND WATER &
 SEWER AUTHORITY**



DATE:	9-5-2008
DESIGNED:	JWM
DRAWN:	ALG
CHECKED:	JWM
SCALE:	AS SHOWN
SHEET NO.	6
OF:	15
VERSION:	4

AS-BUILT 9-5-08



12-250-006/36 2/

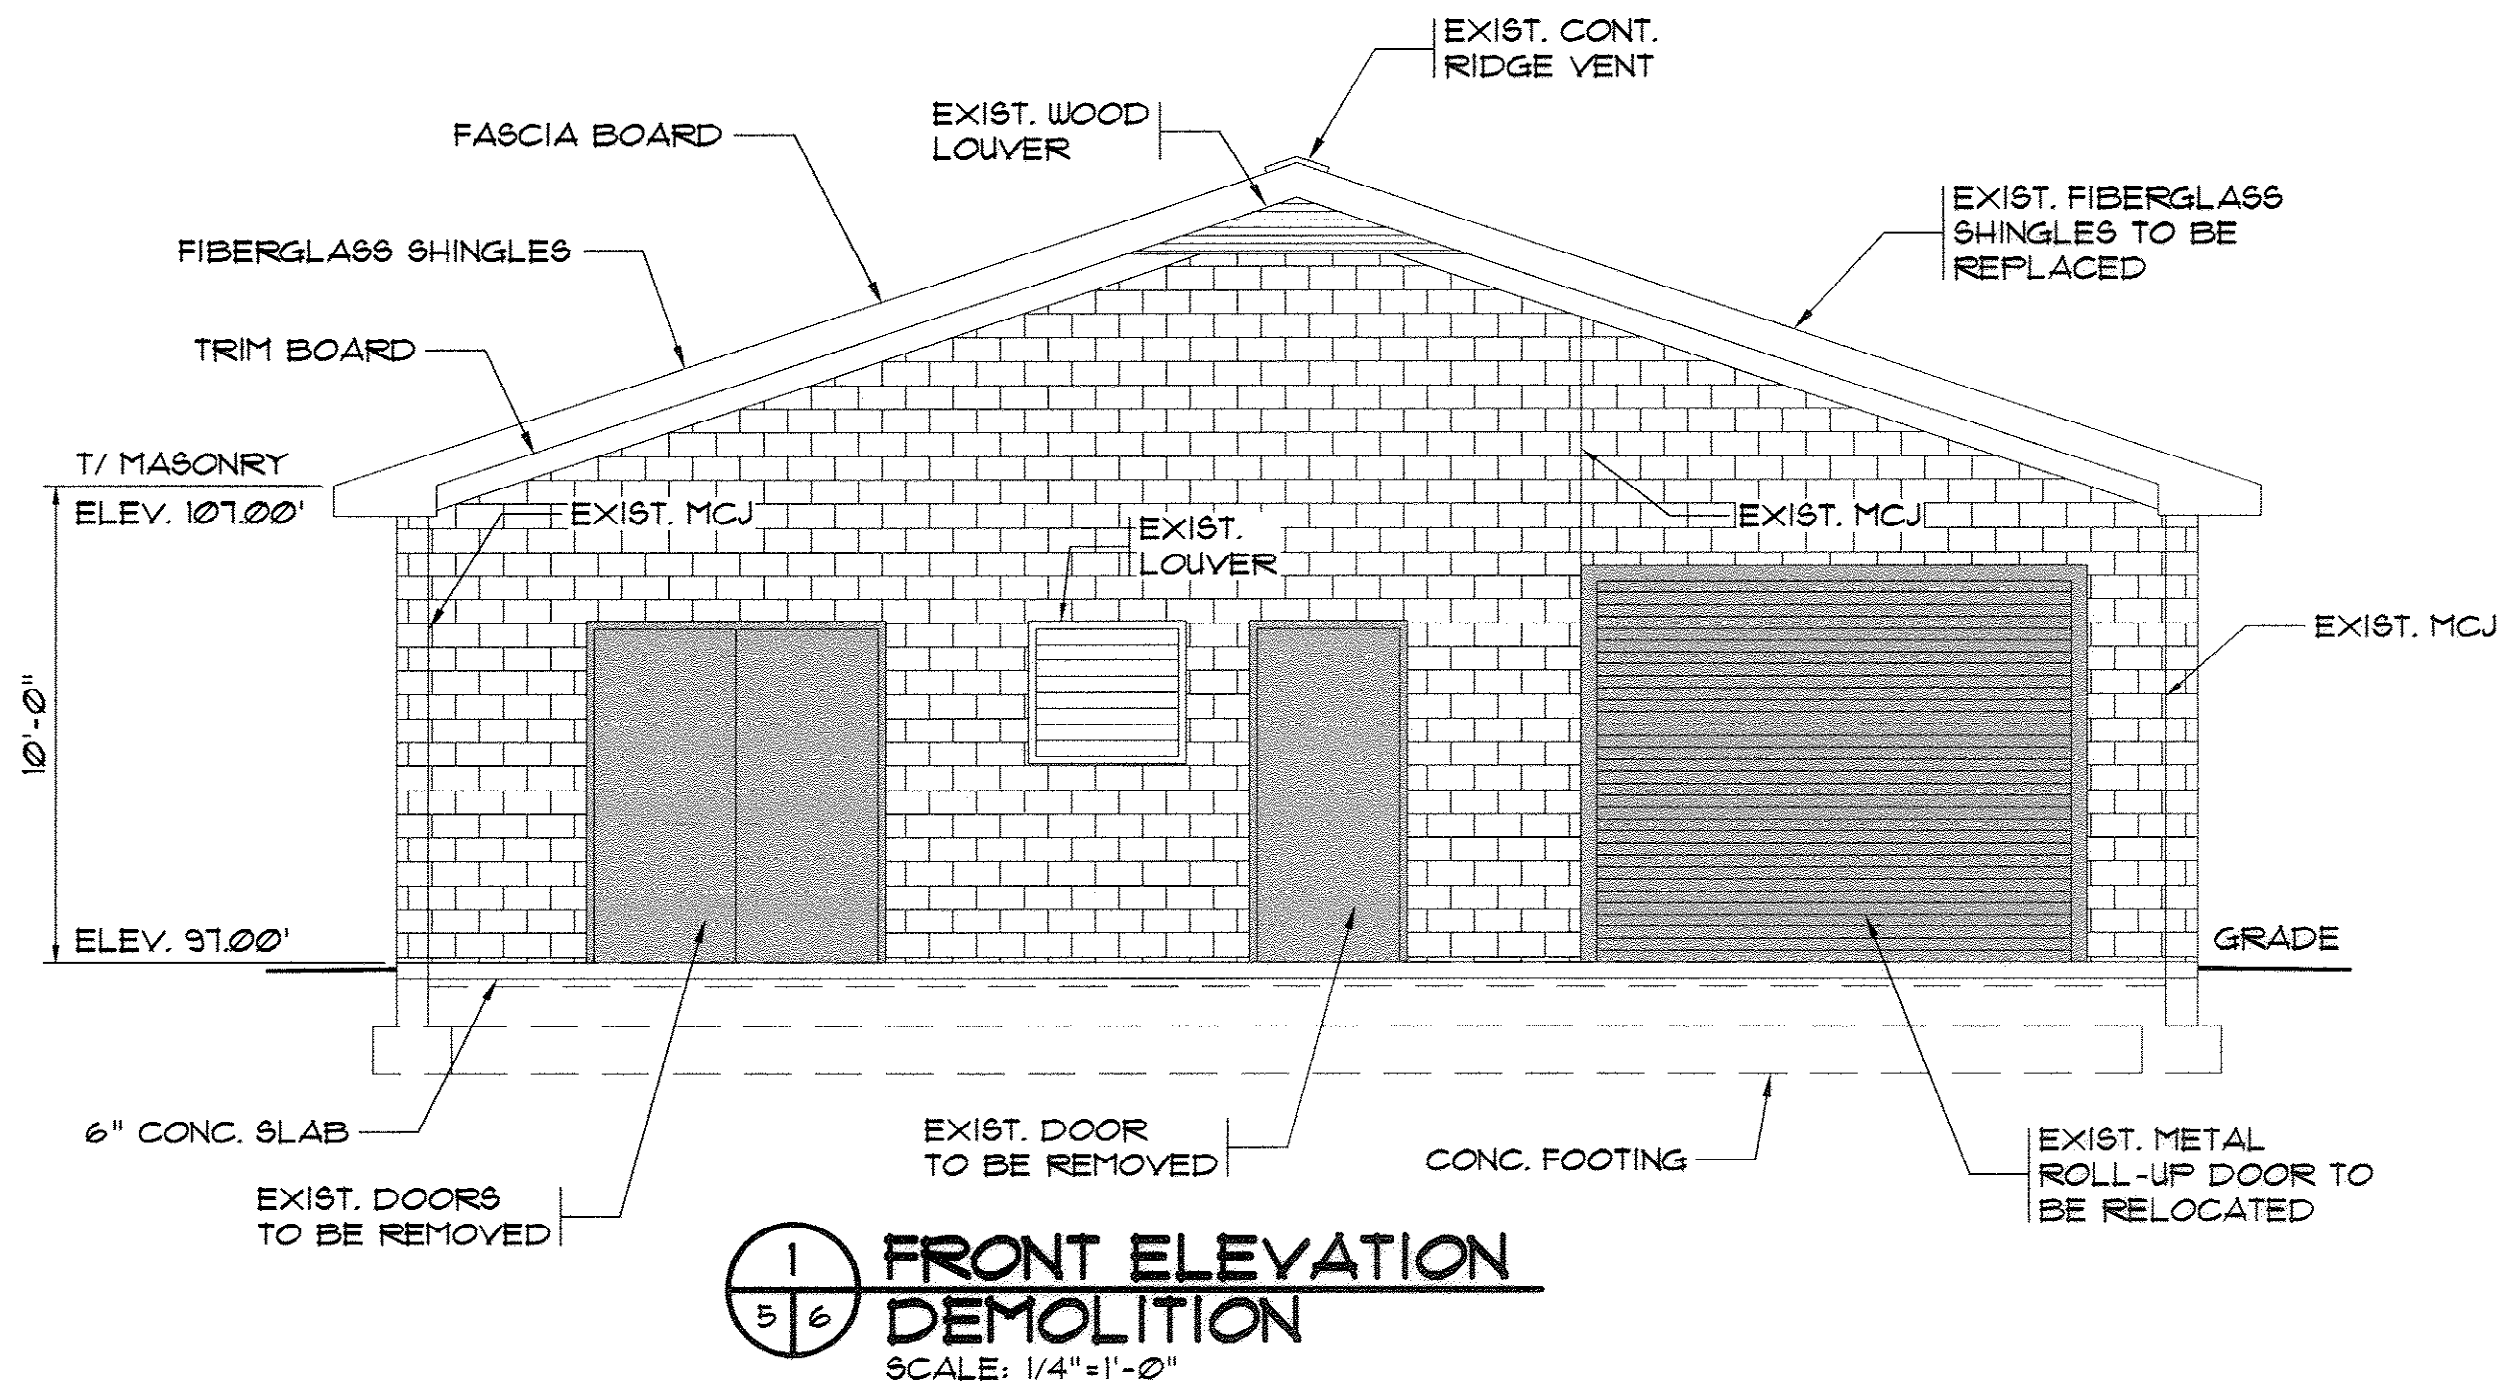

INDICATES PORTIONS
 = TO BE REMOVED OR
 RELOCATED

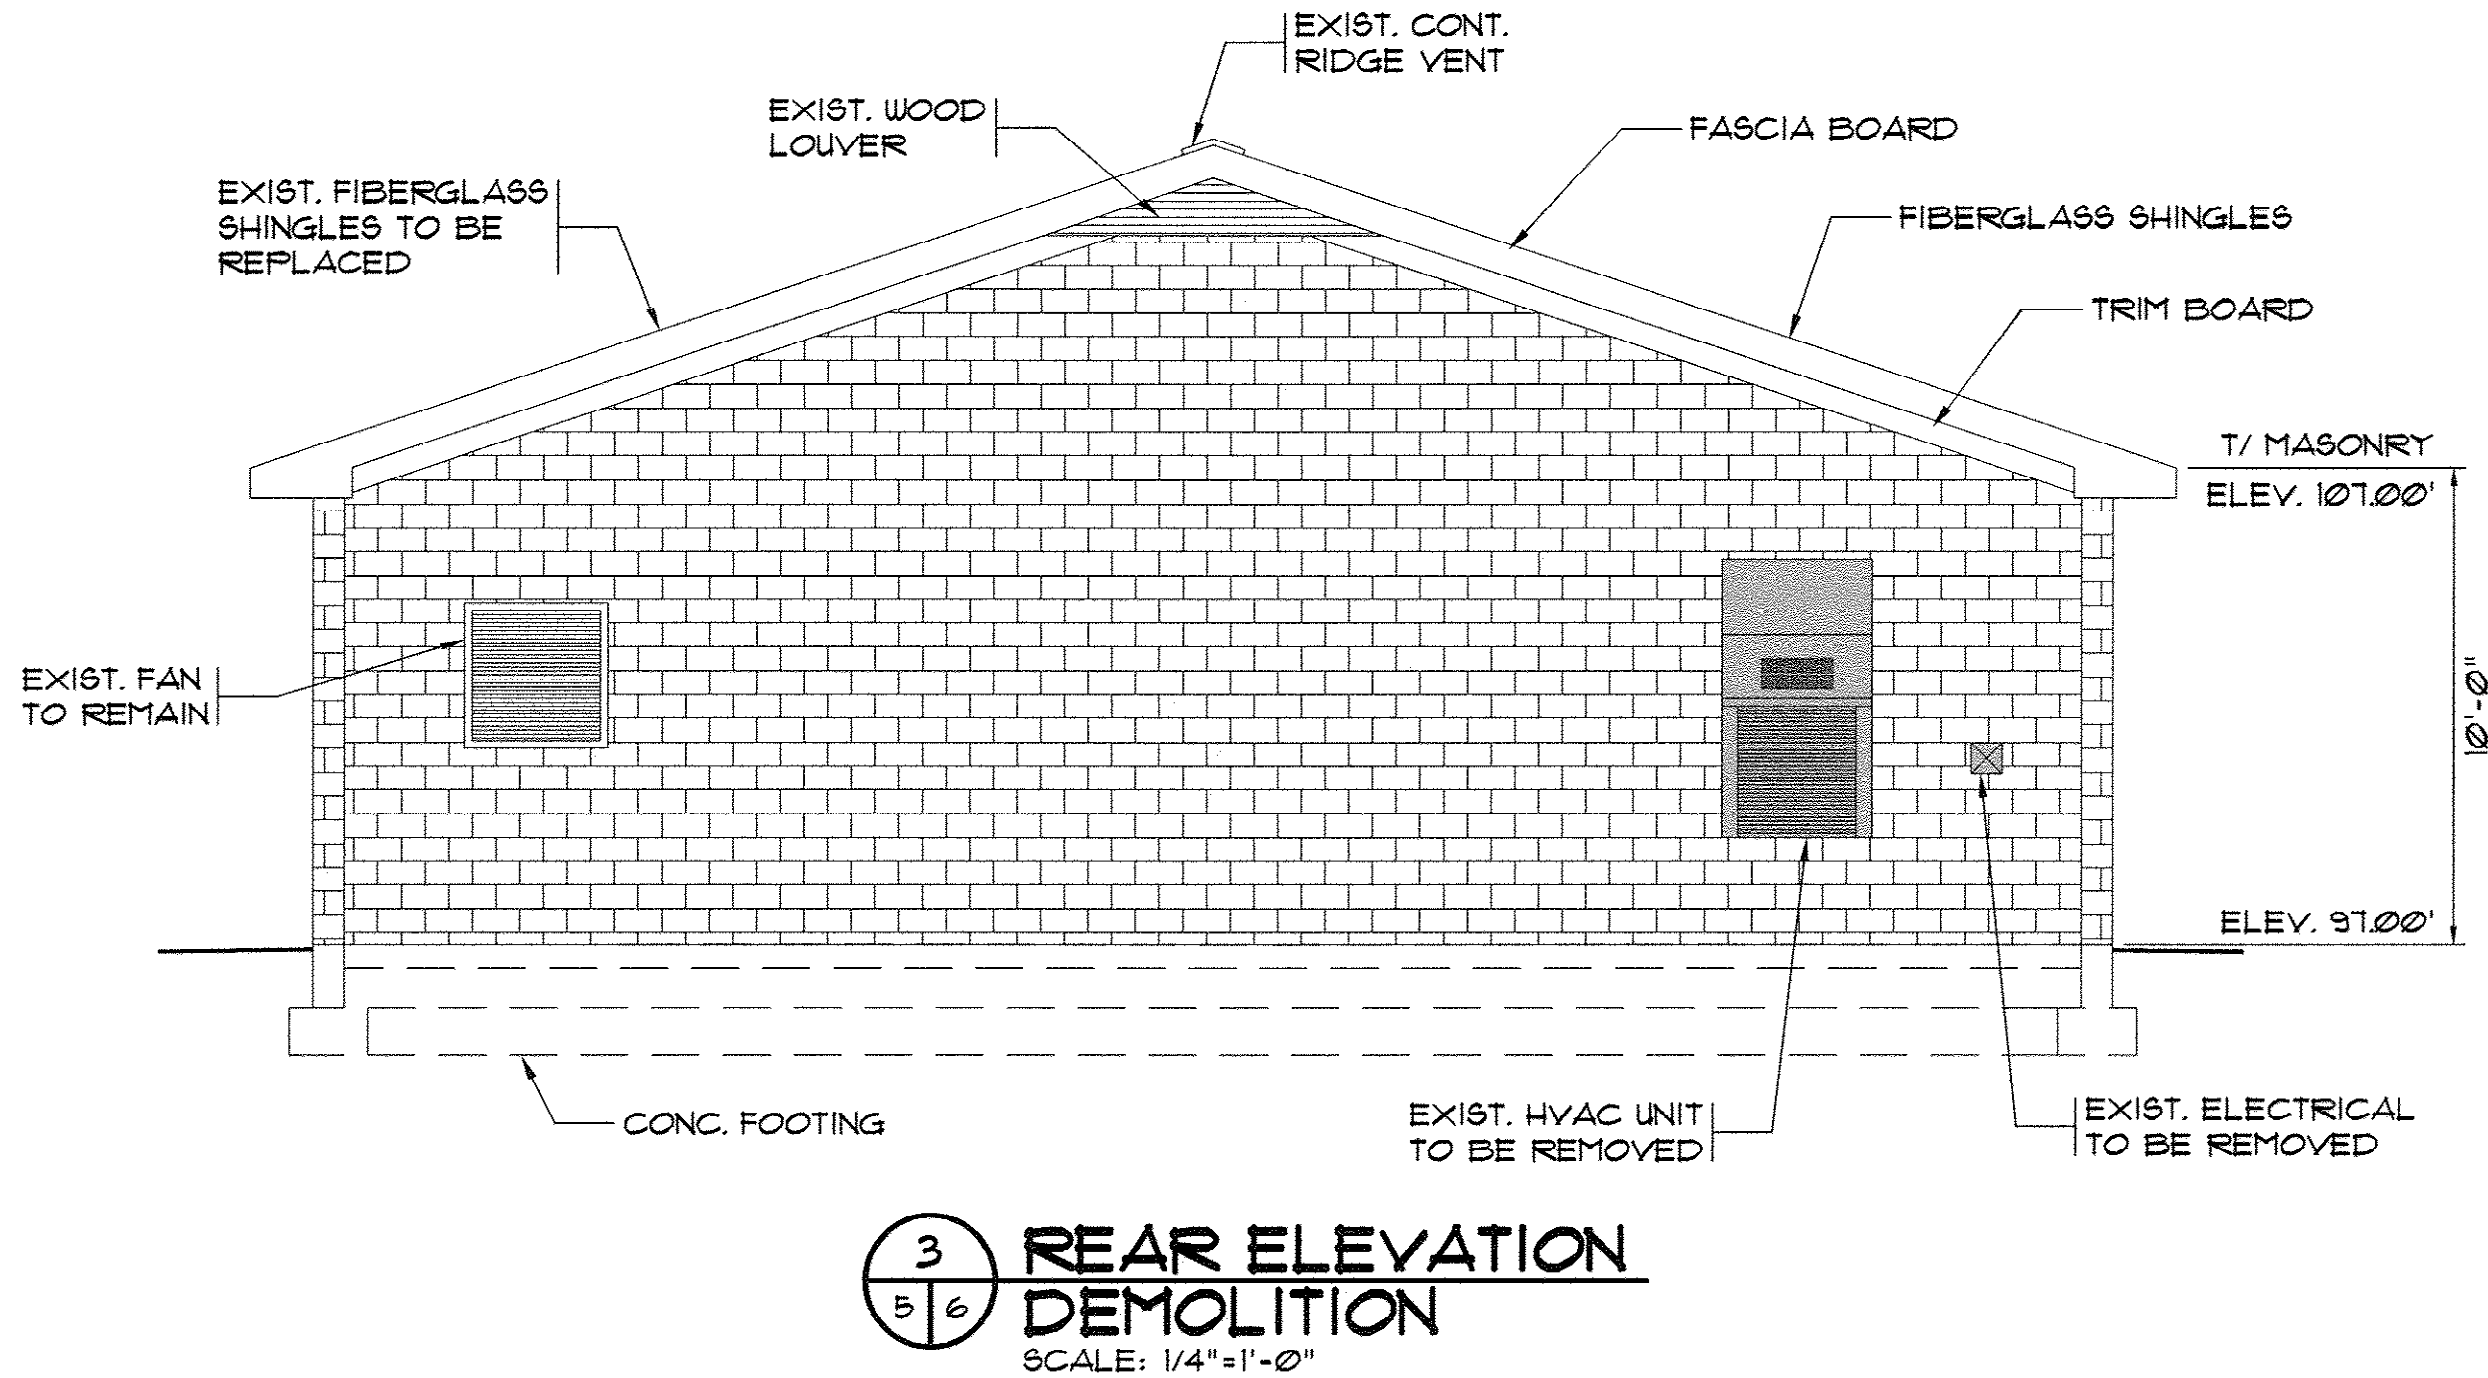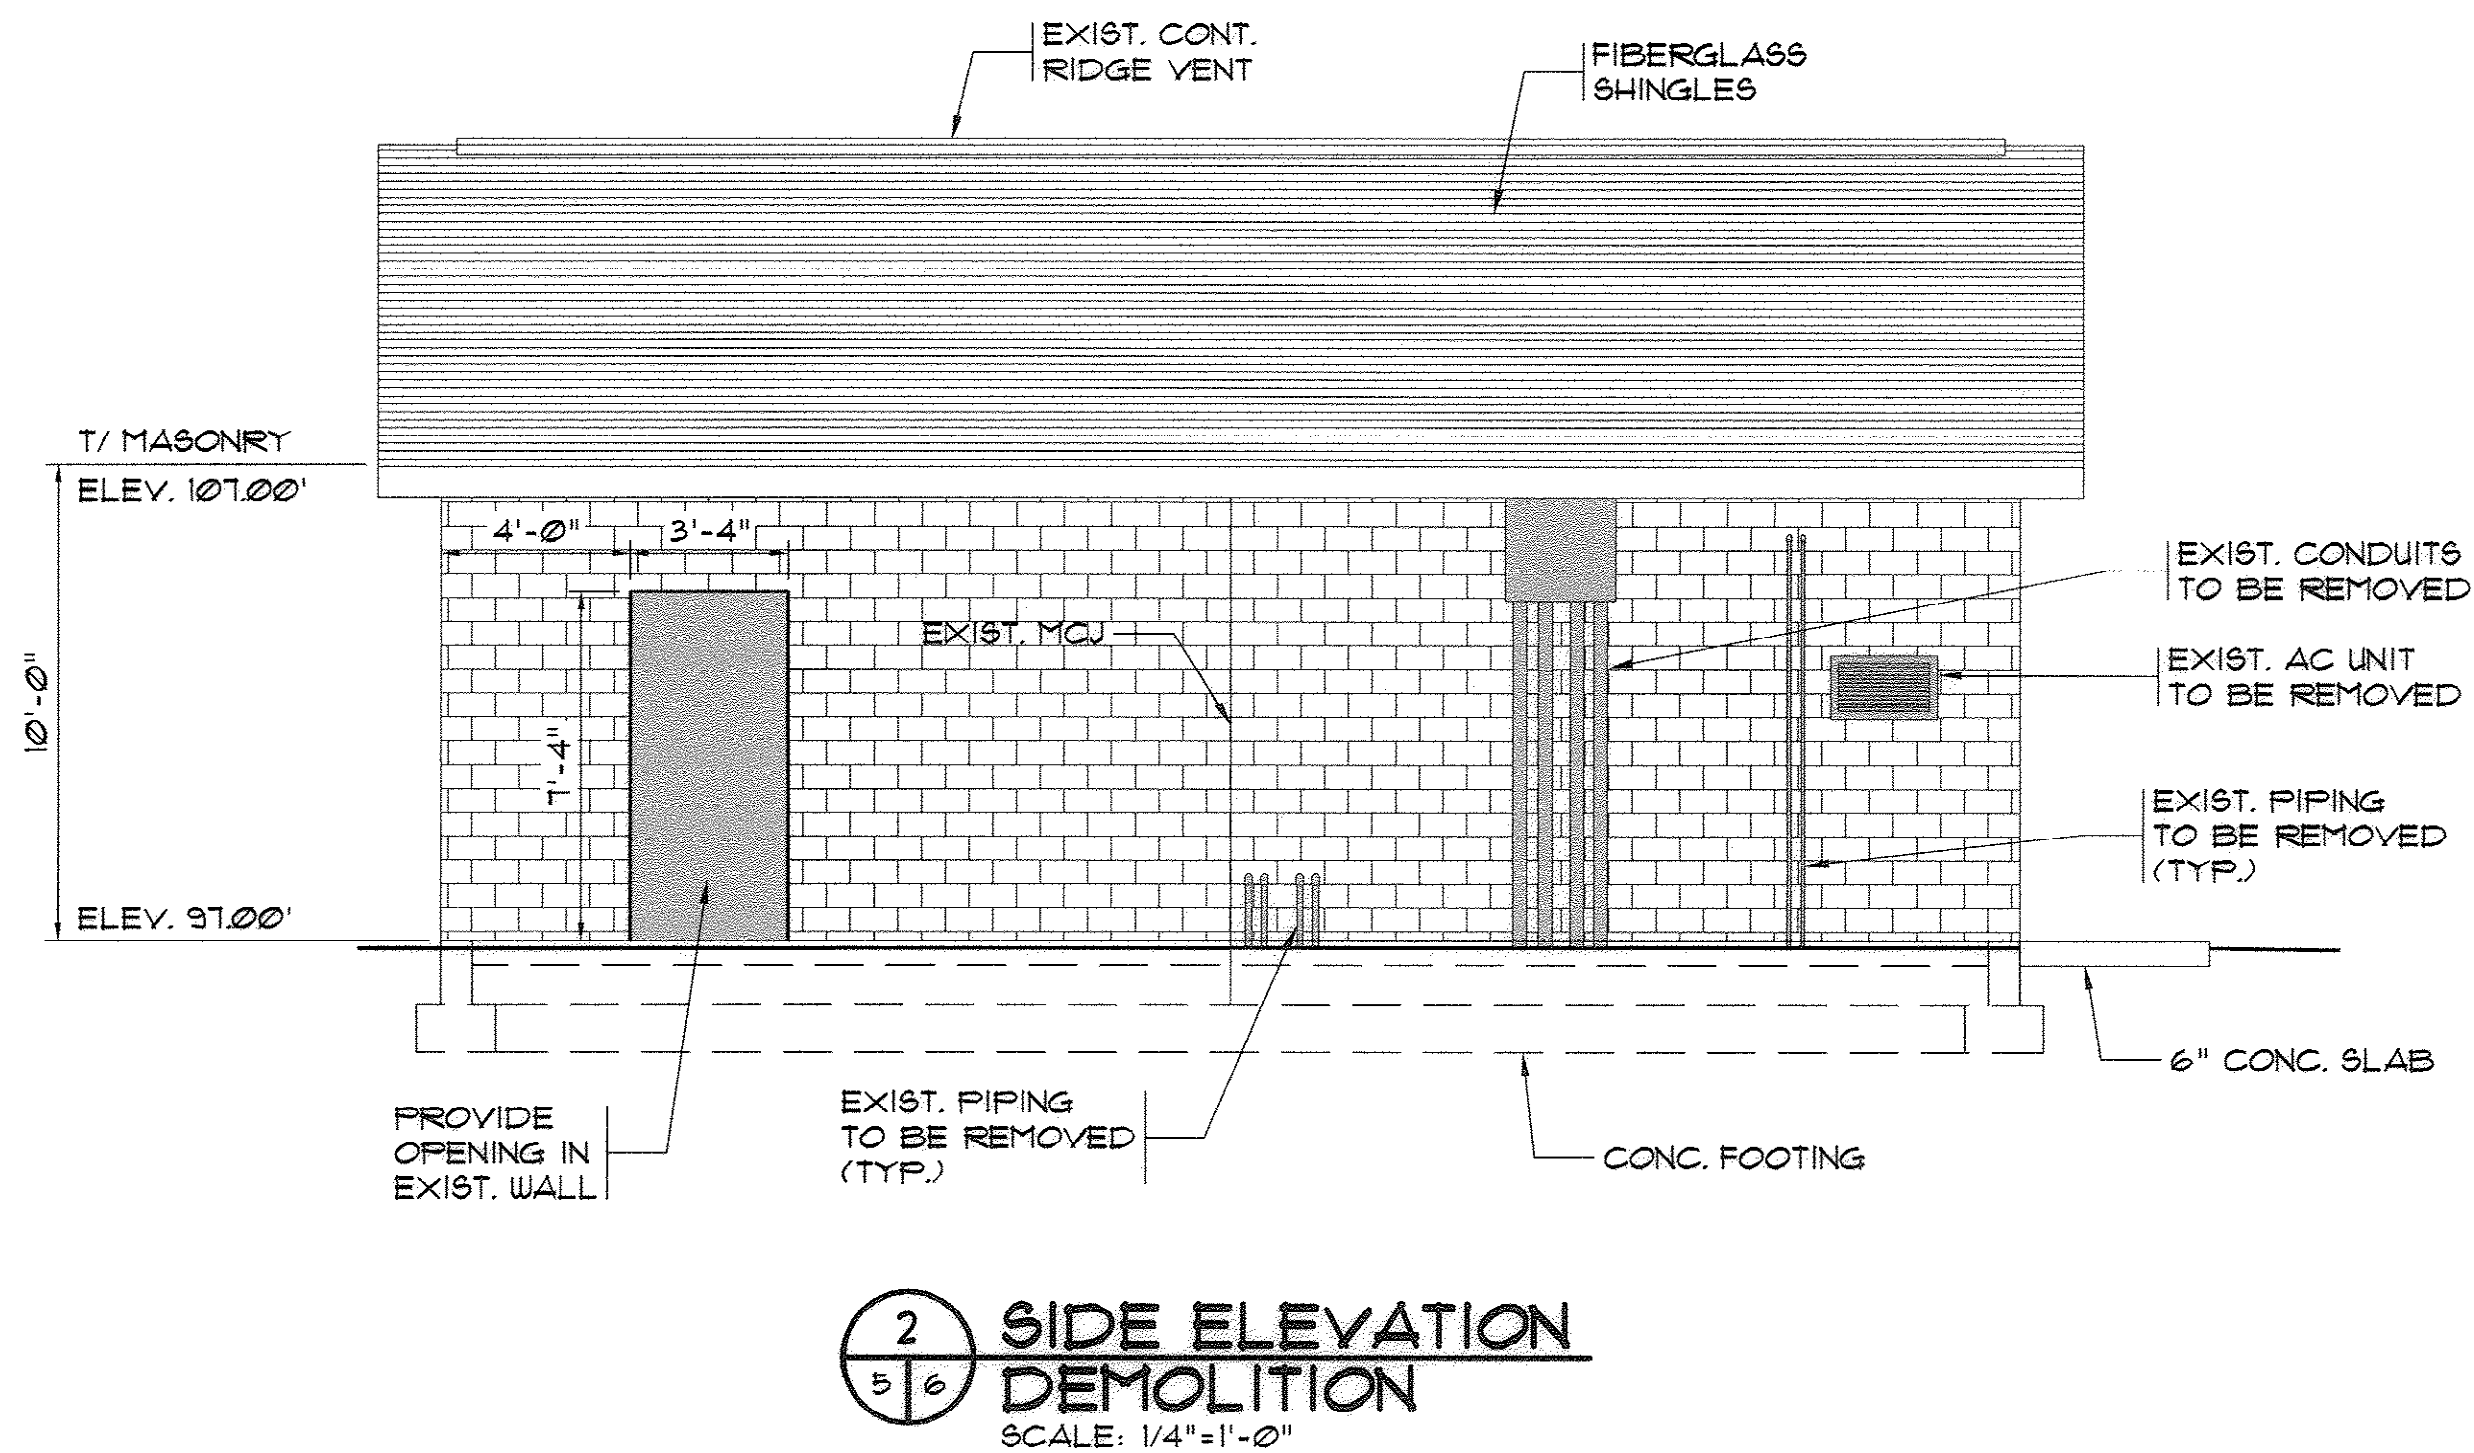

REVISIONS			
SYM.	DESCRIPTION	DATE	BY

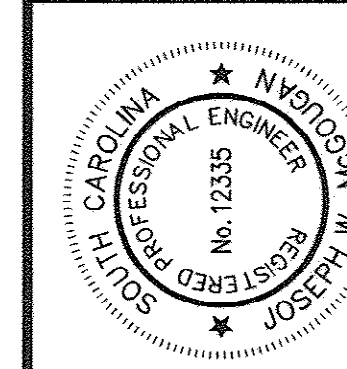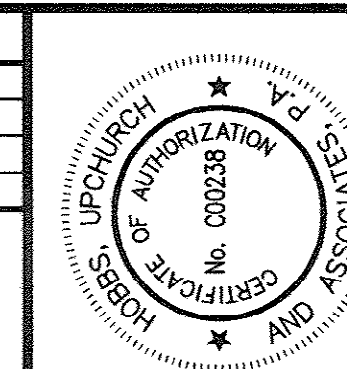

Upchurch & Associates, P.A.
 Consulting Engineers
 Myrtle Beach, South Carolina 29577
 PHONE: (843) 626-1810 FAX: (843) 626-1745




**EXISTING PUMP
 DEMOLITION ELEVATIONS**

**PERRY ROAD
 PUMP STATION
 GRAND STRAND WATER &
 SEWER AUTHORITY**


DATE:	9-5-2008
DESIGNED:	JWM
DRAWN:	ALG
CHECKED:	JWM
SCALE:	AS SHOWN

SHEET NO.	7
OF 15	VERSION: 4

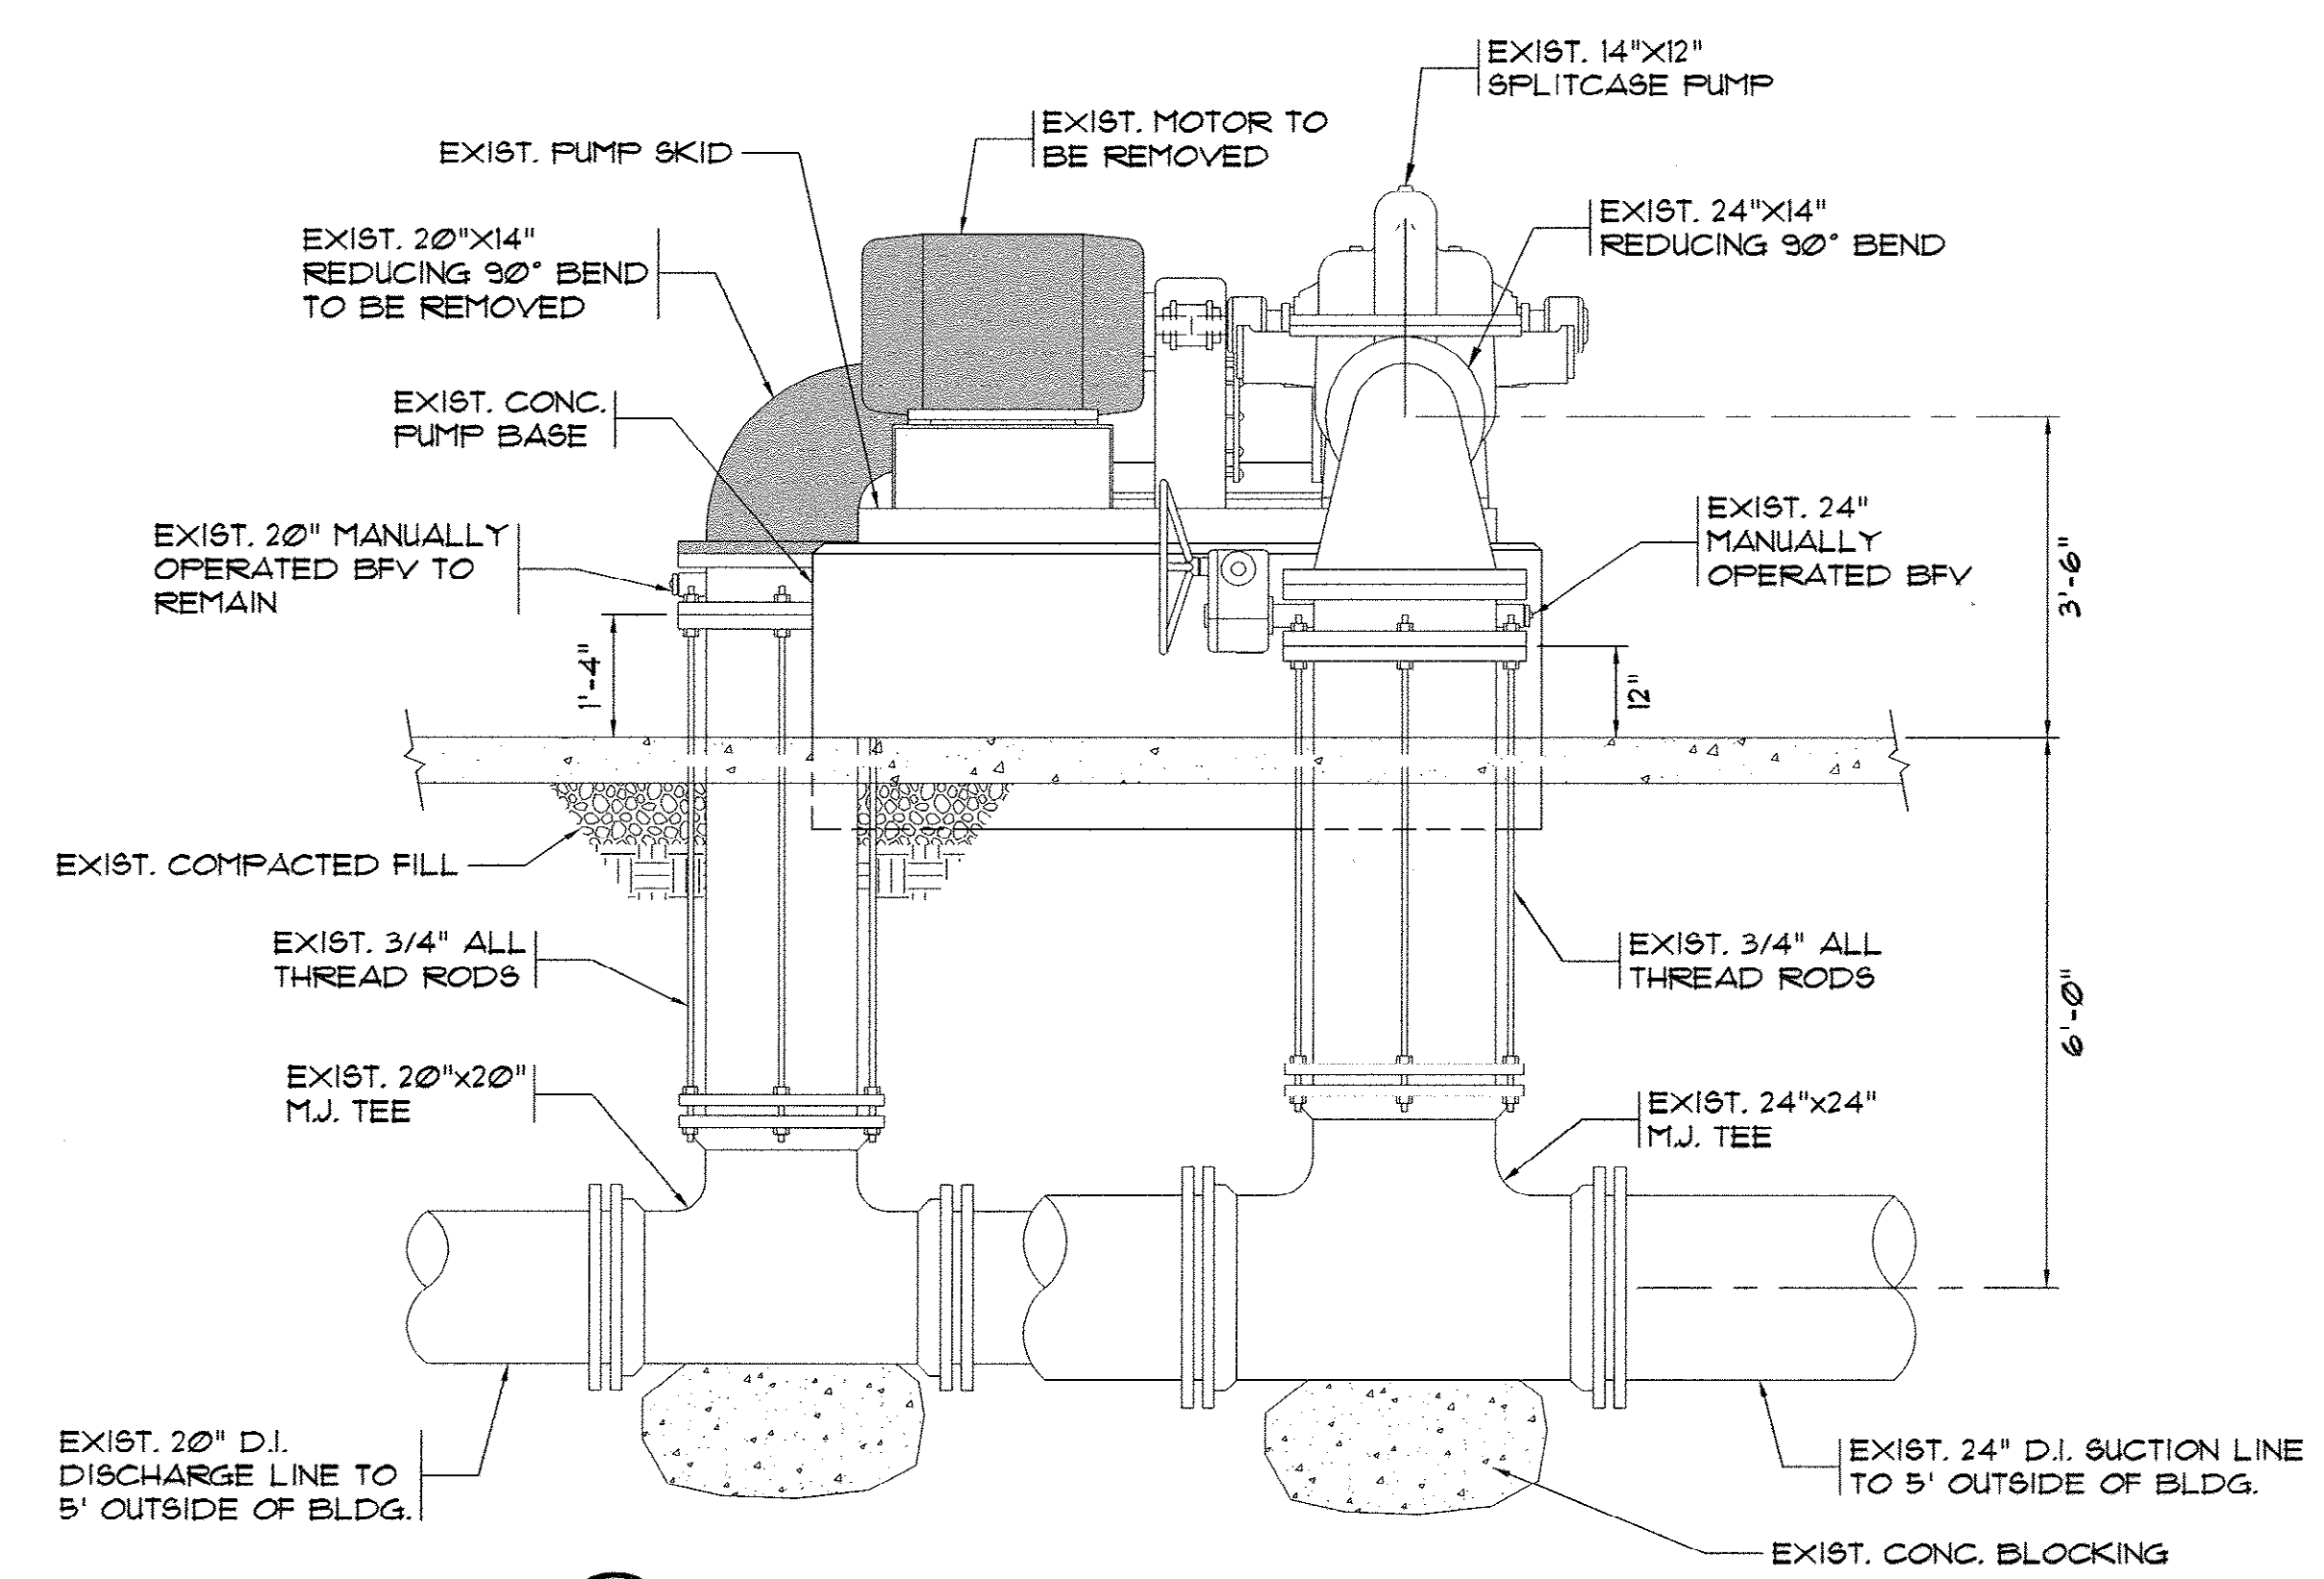

**4 EXISTING PUMP ELEVATION
 DEMOLITION**
 SCALE: 1/2" = 1'-0"

= INDICATES PORTIONS TO BE REMOVED


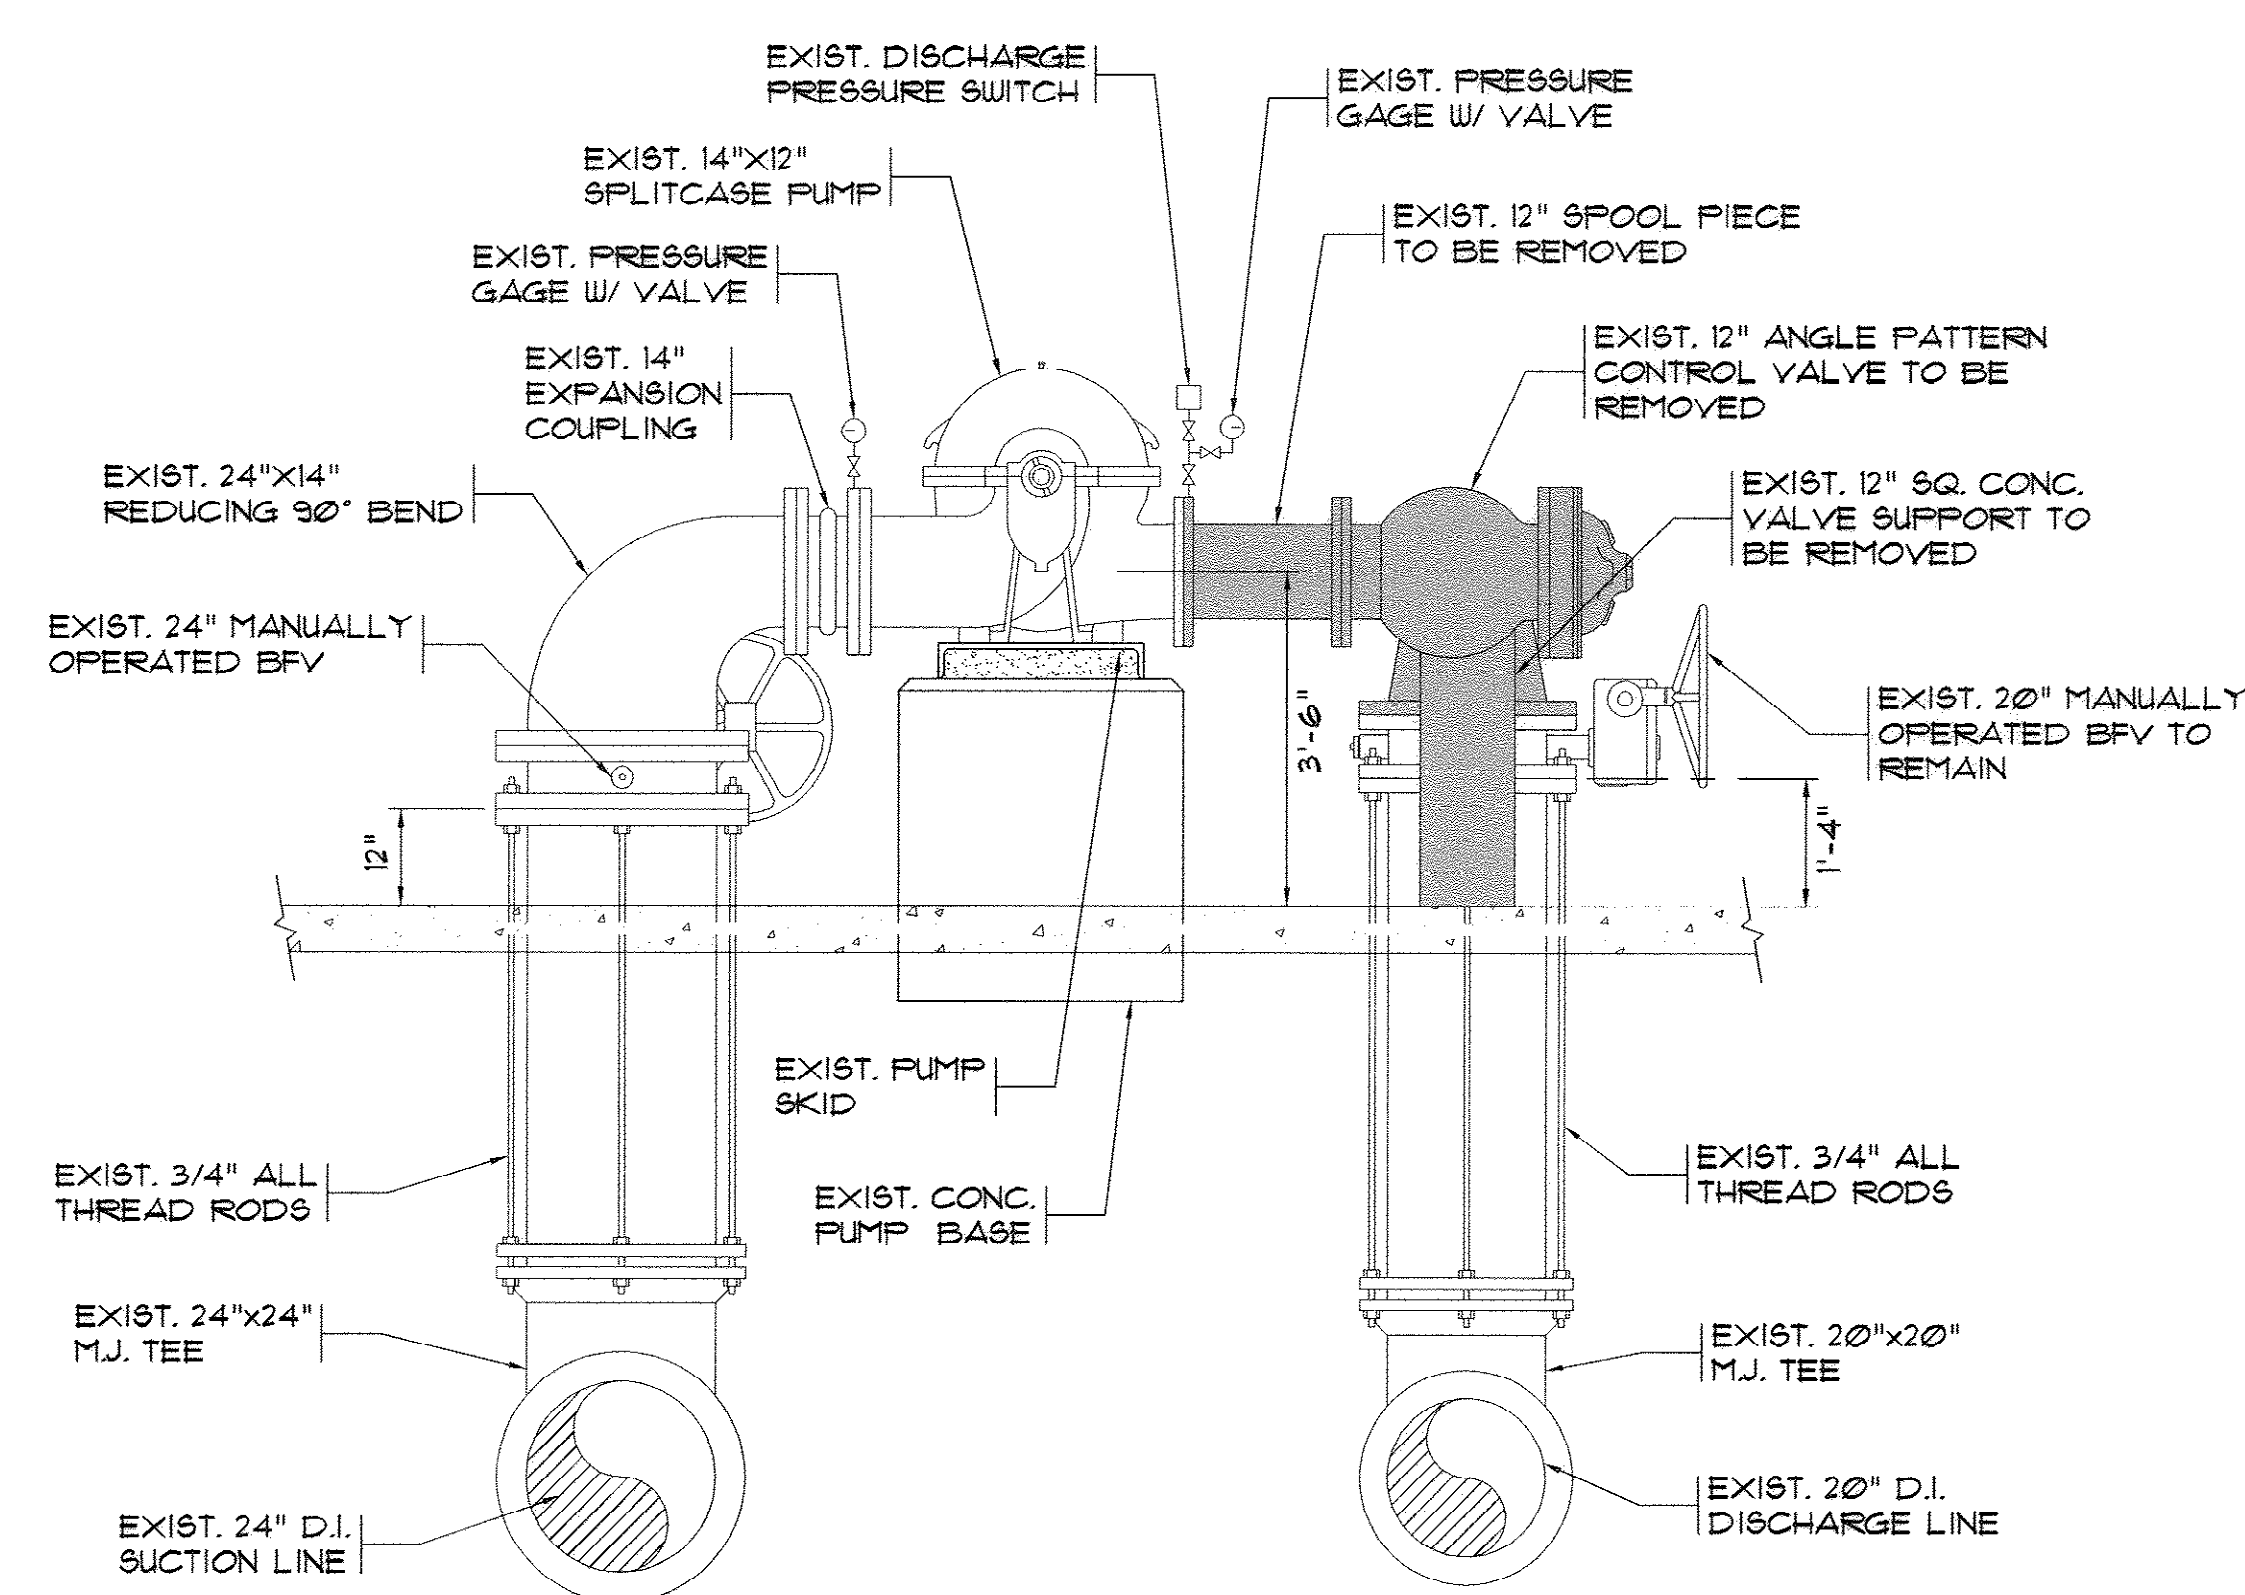


**5 EXISTING PUMP ELEVATION
 DEMOLITION**
 SCALE: 1/2" = 1'-0"

AS-BUILT 9-5-08

12-250-007/36 9W

REVISIONS			
SYM.	DESCRIPTION	DATE	BY

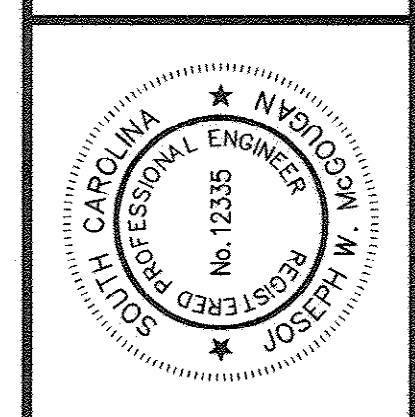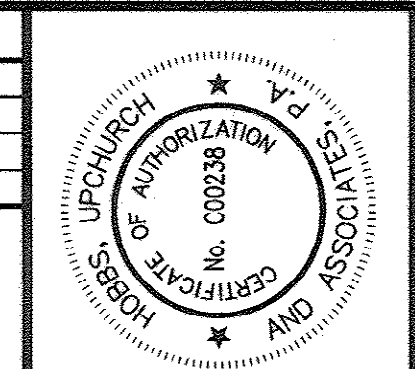


Hobbs, Upchurch & Associates, P.A.
 Consulting Engineers
 Myrtle Beach, South Carolina 29577
 PHONE (843) 668-1910 FAX (843) 668-1745

**EXISTING PUMP STATION
 ARCHITECTURAL
 MODIFICATION LAYOUT**

**PERRY ROAD
 PUMP STATION
 GRAND STRAND WATER &
 SEWER AUTHORITY**


DATE:	9-5-2008
DESIGNED:	JWM
DRAWN:	ALG
CHECKED:	JWM
SCALE:	AS SHOWN
SHEET NO:	8
OF 15	VERSION: 4

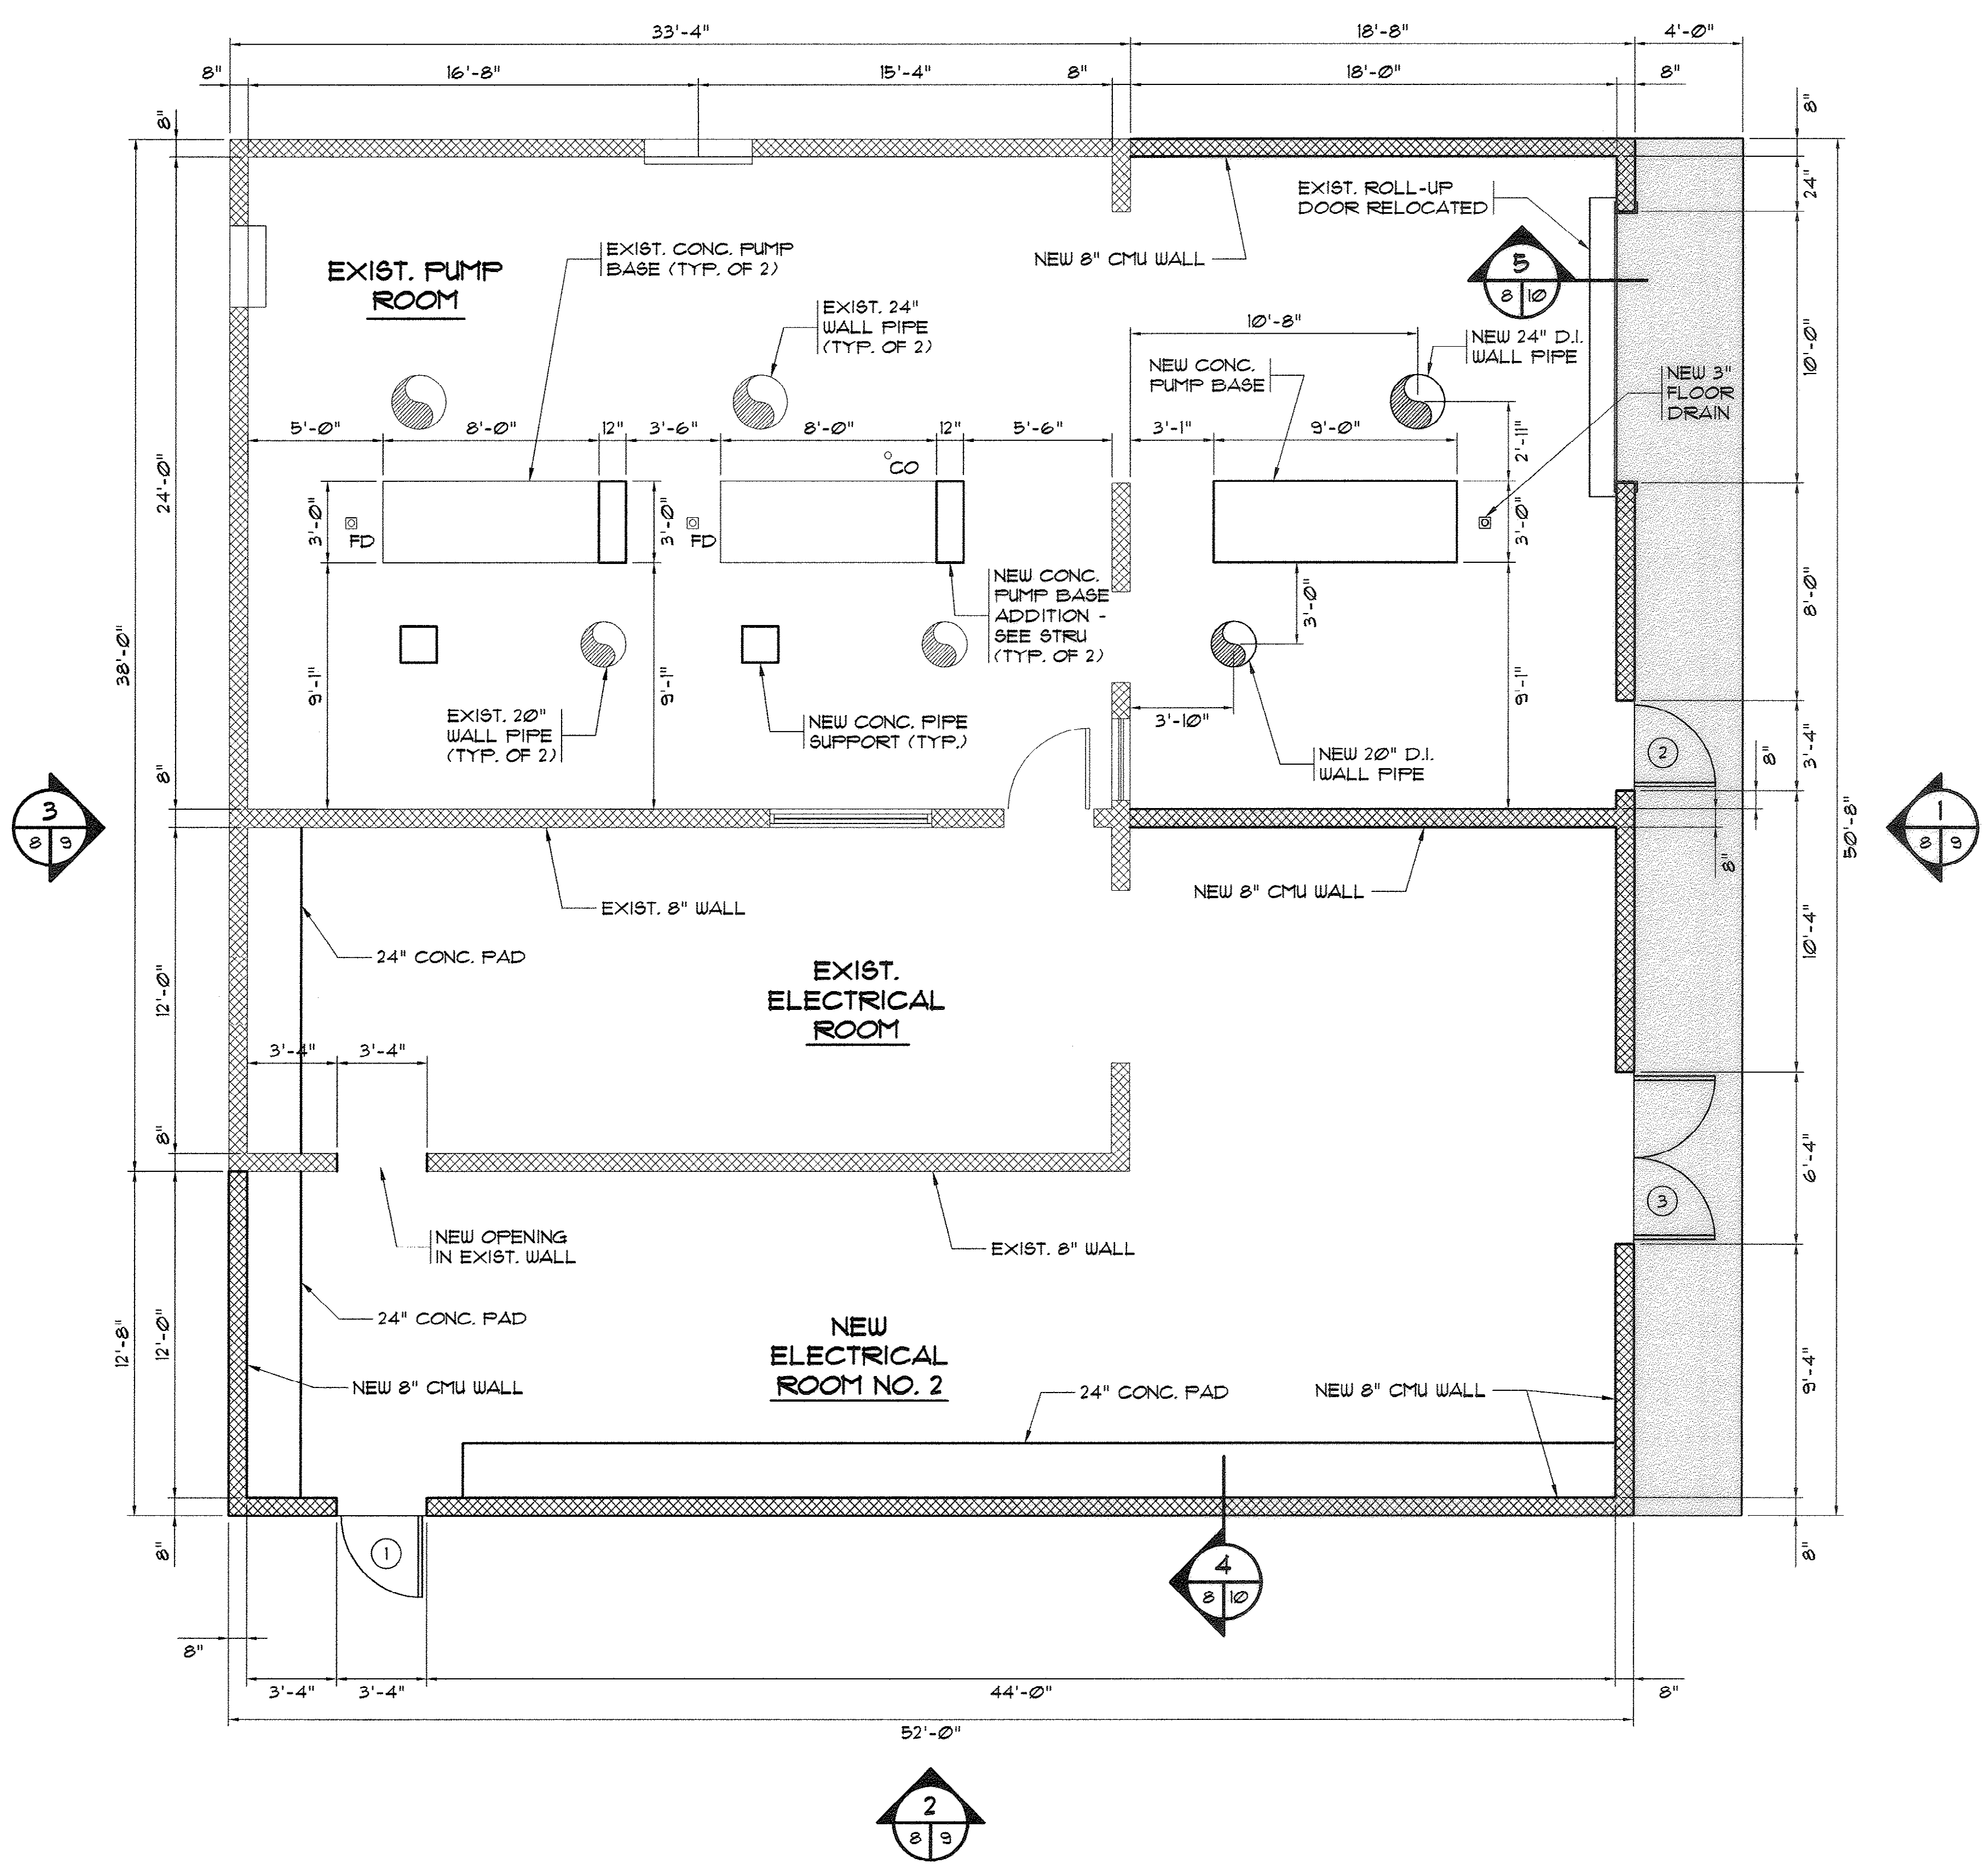

**EXISTING PUMP STATION
 ARCHITECTURAL MODIFICATION LAYOUT**
 SCALE: 1/4" = 1'-0"

AS-BUILT 9-5-08


13-250-008/36 W

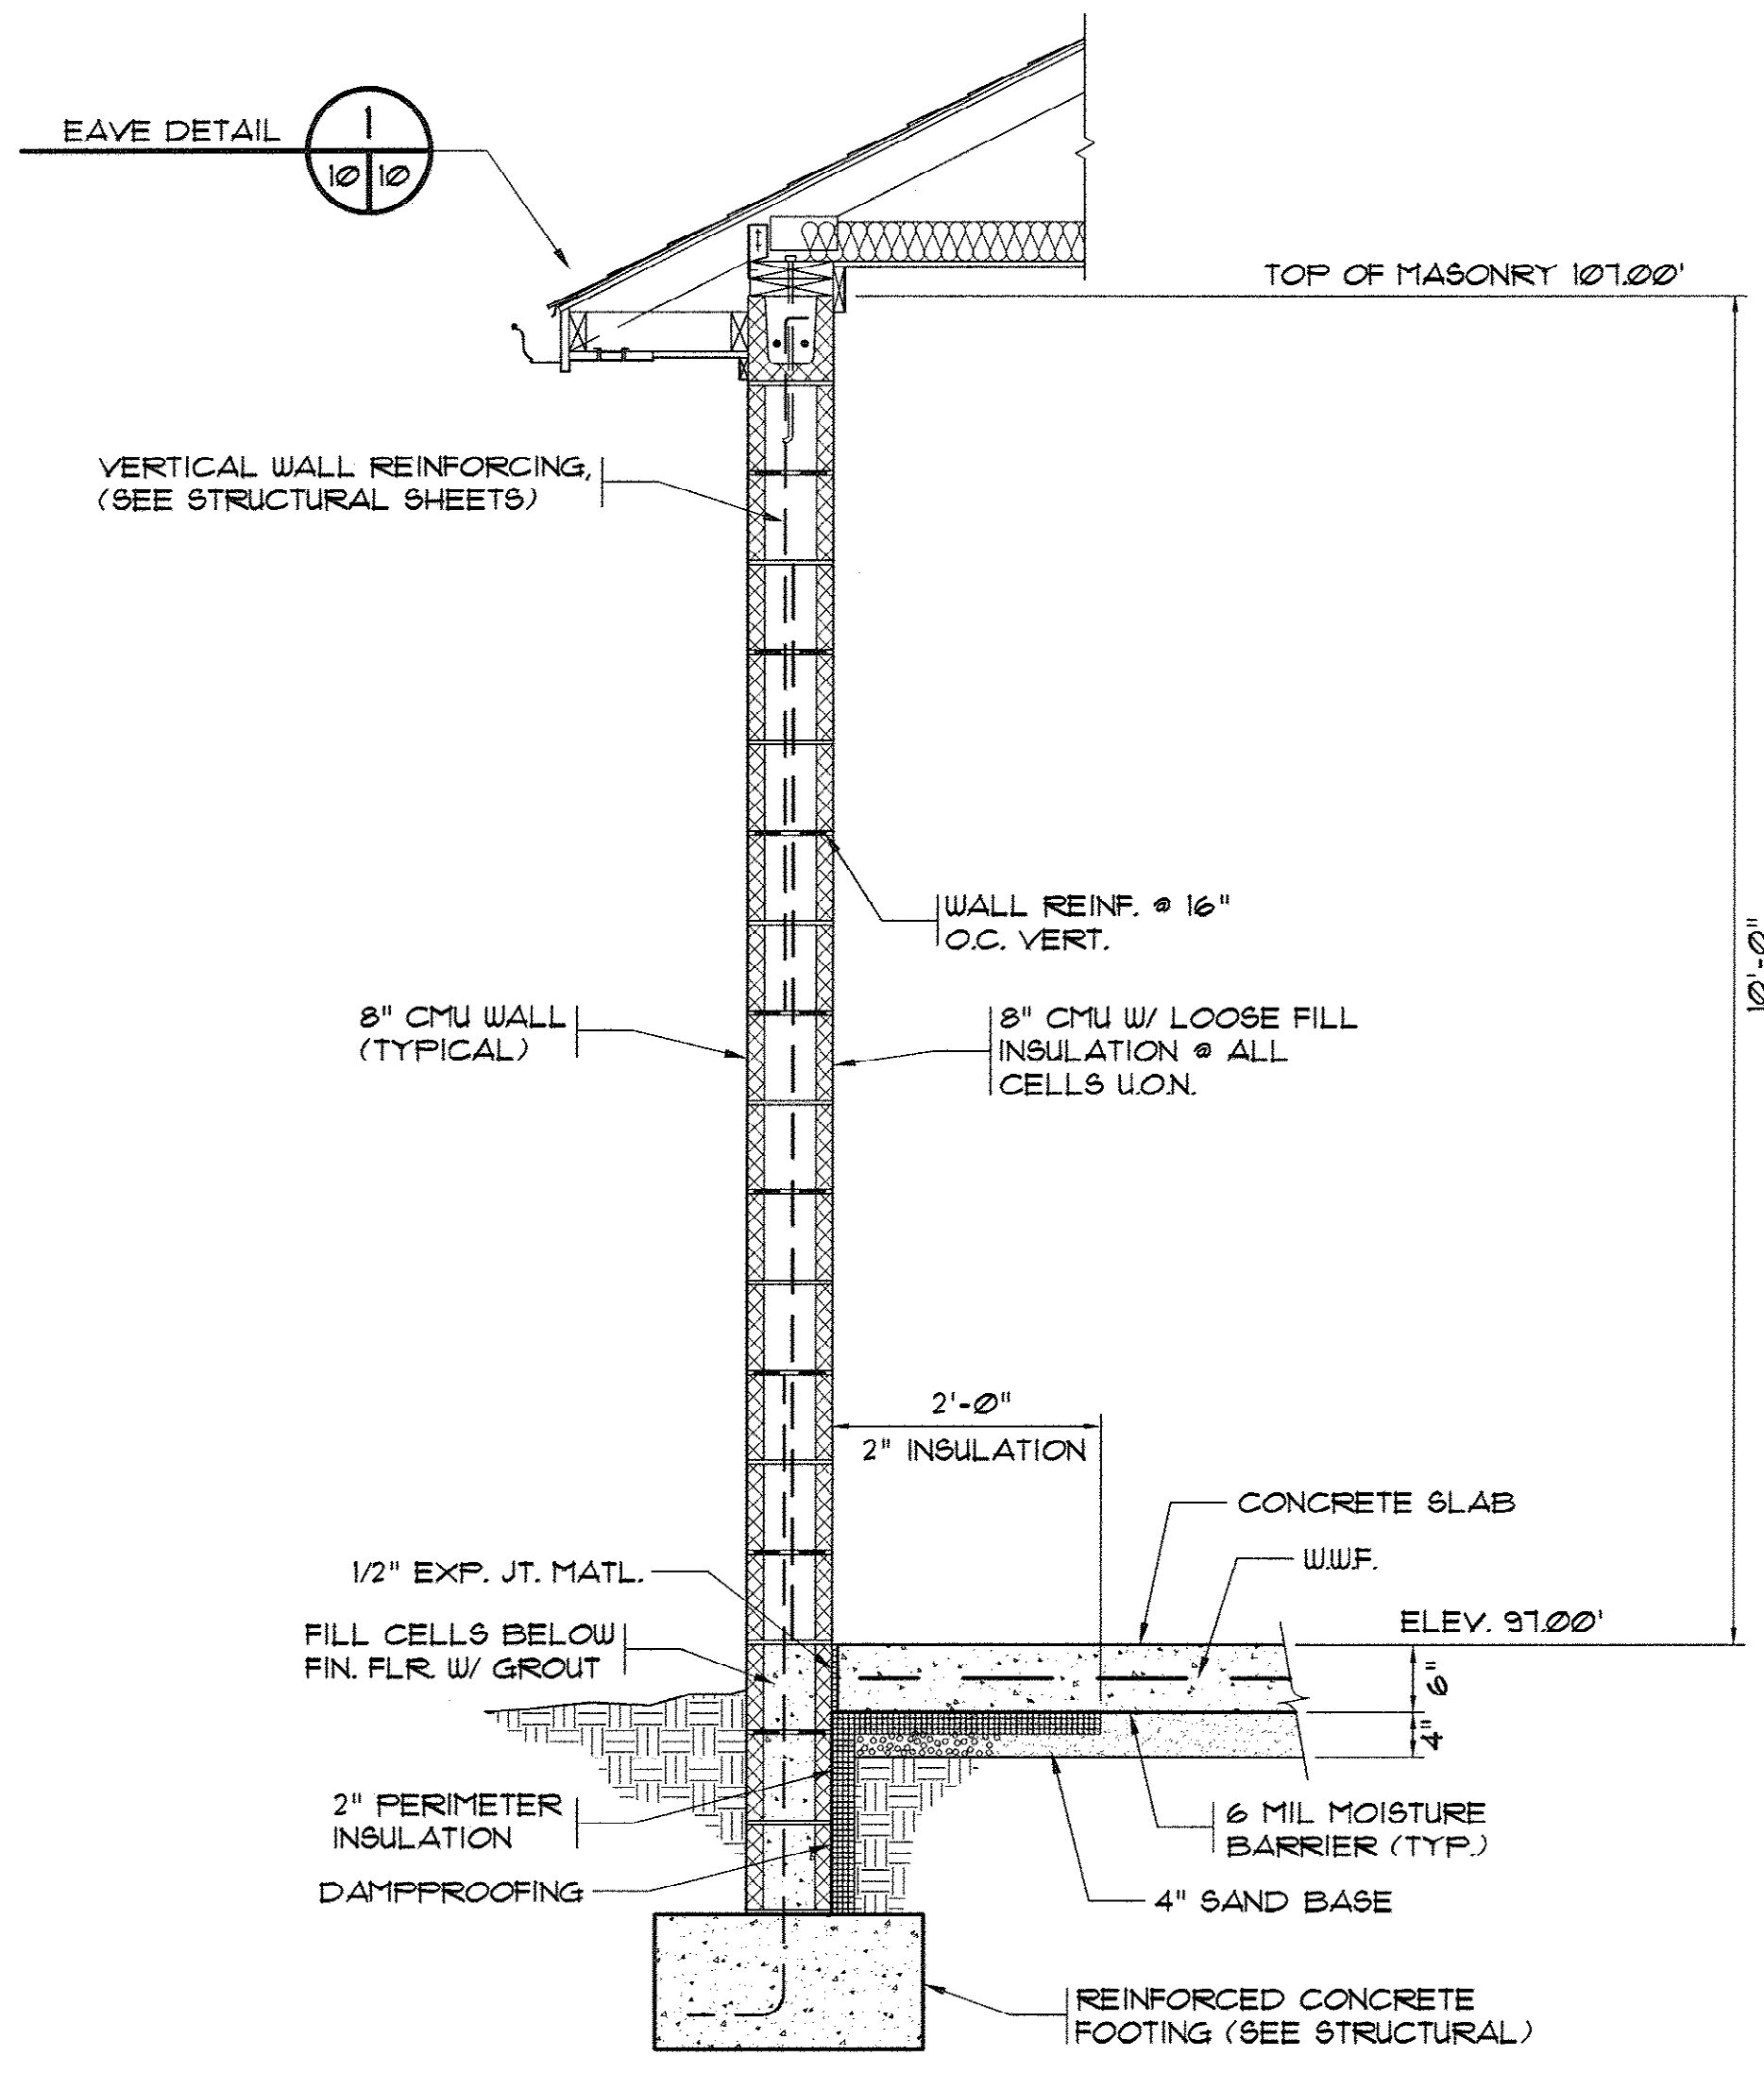


4 TYP. EXTERIOR WALL SECTION
SCALE: 3/4" = 1'-0"

DOOR SCHEDULE										
NO.	DOOR						FRAME			REMARKS
	SIZE	TYPE	MTL.	GLASS	LOUVER	LABEL	TYPE	MTL.	GLASS	
①	3'X1'X1.75"	A	INSUL. H.M.	NONE	NONE	NONE	1	H.M.	NONE	PAINT DOOR + FRAME
②	3'X1'X1.75"	A	INSUL. H.M.	NONE	NONE	NONE	1	H.M.	NONE	PAINT DOOR + FRAME
③	PR. 3'X8'-8"X1.75"	B	INSUL. H.M.	NONE	NONE	NONE	2	H.M.	NONE	PAINT DOOR + FRAME


NOTE:
PROVIDE HURRICANE ANCHORS EACH
END OF EACH RAFTER, W/ MIN. CAPACITY
AS REQUIRED.

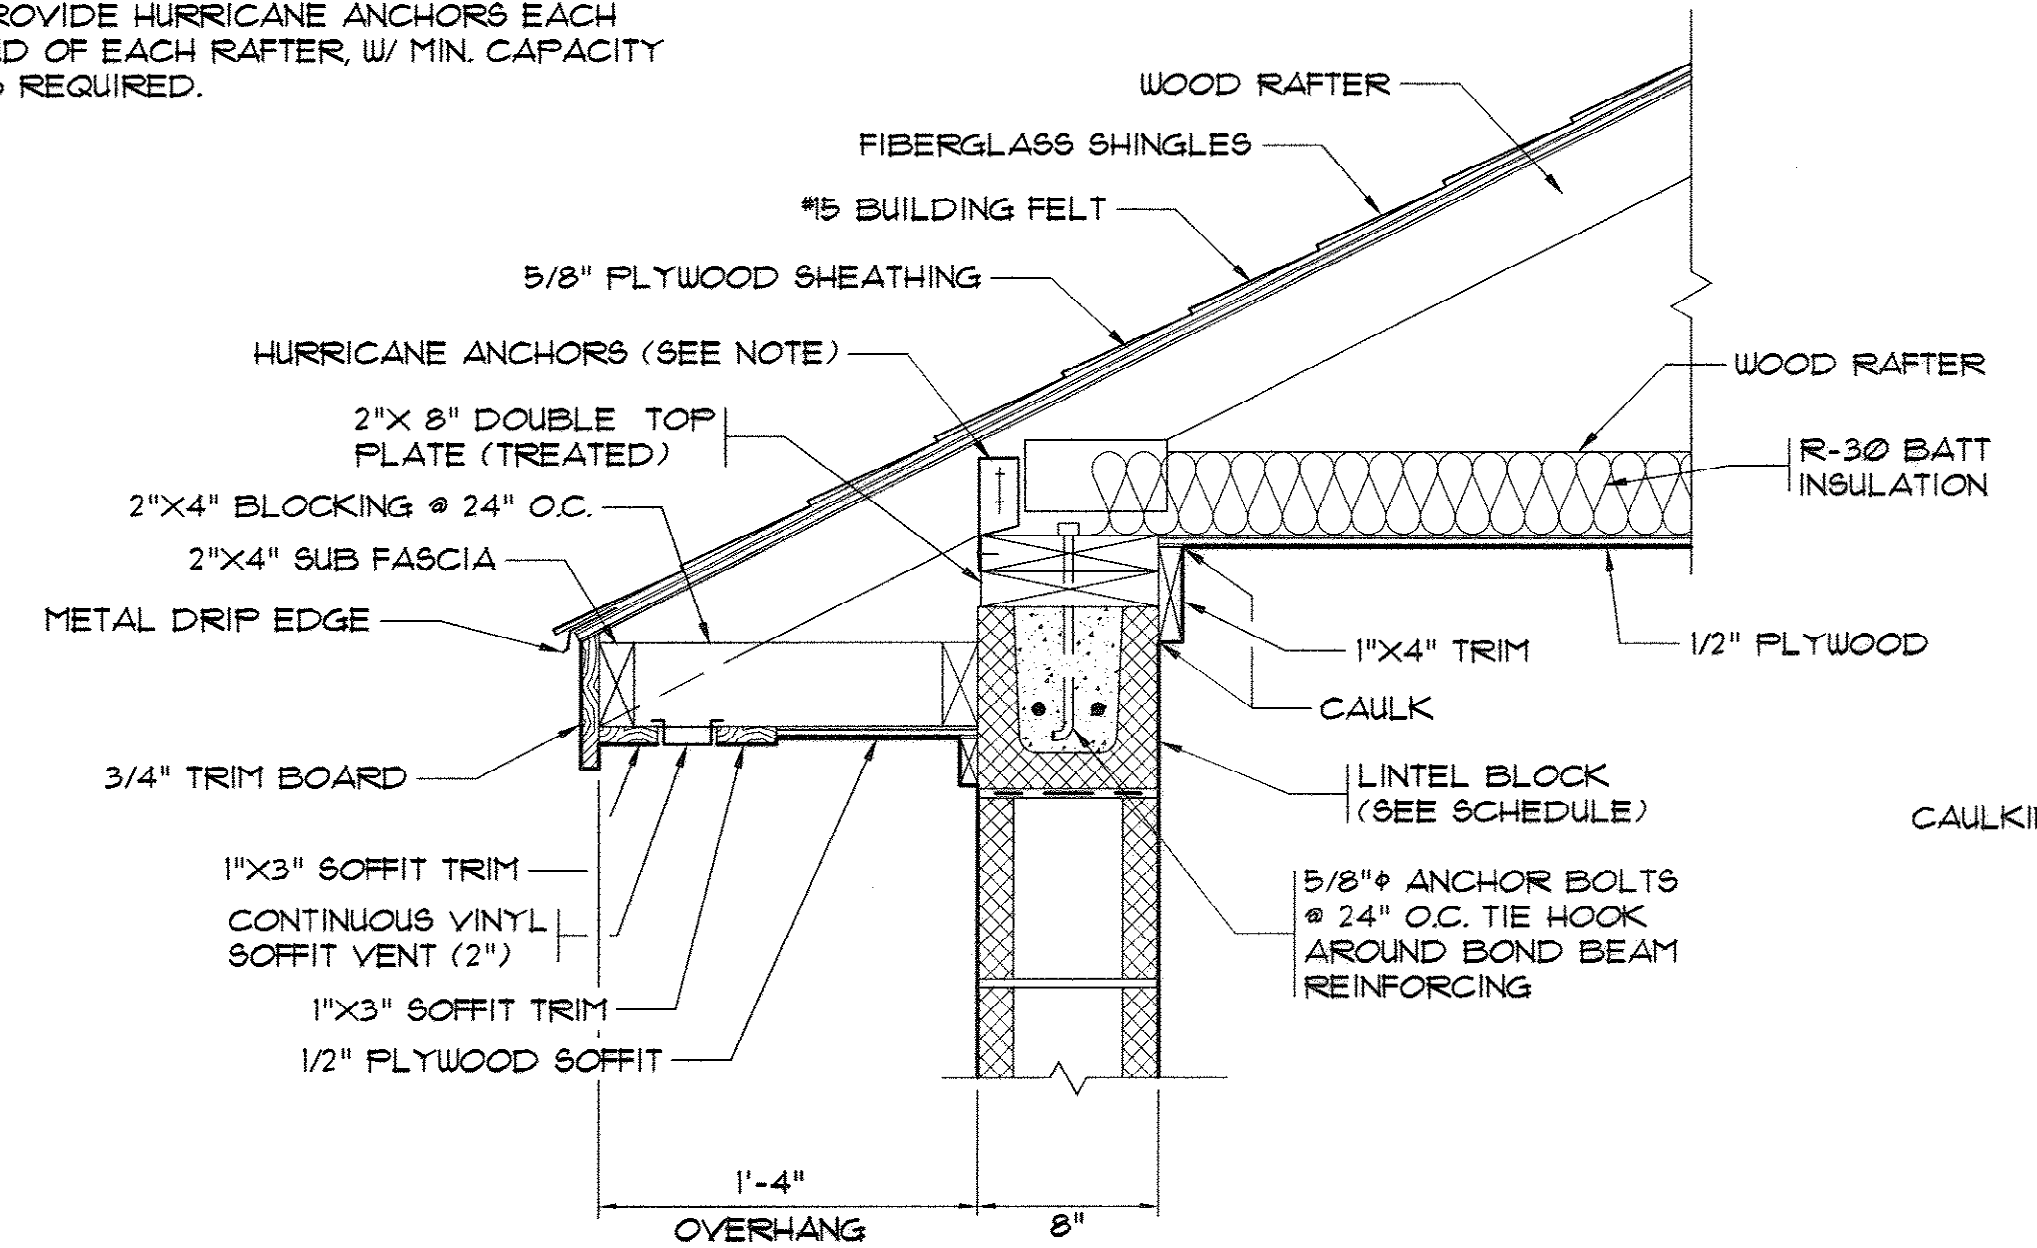

1 TYPICAL EAVE DETAIL
SCALE: 1 1/2" = 1'-0"

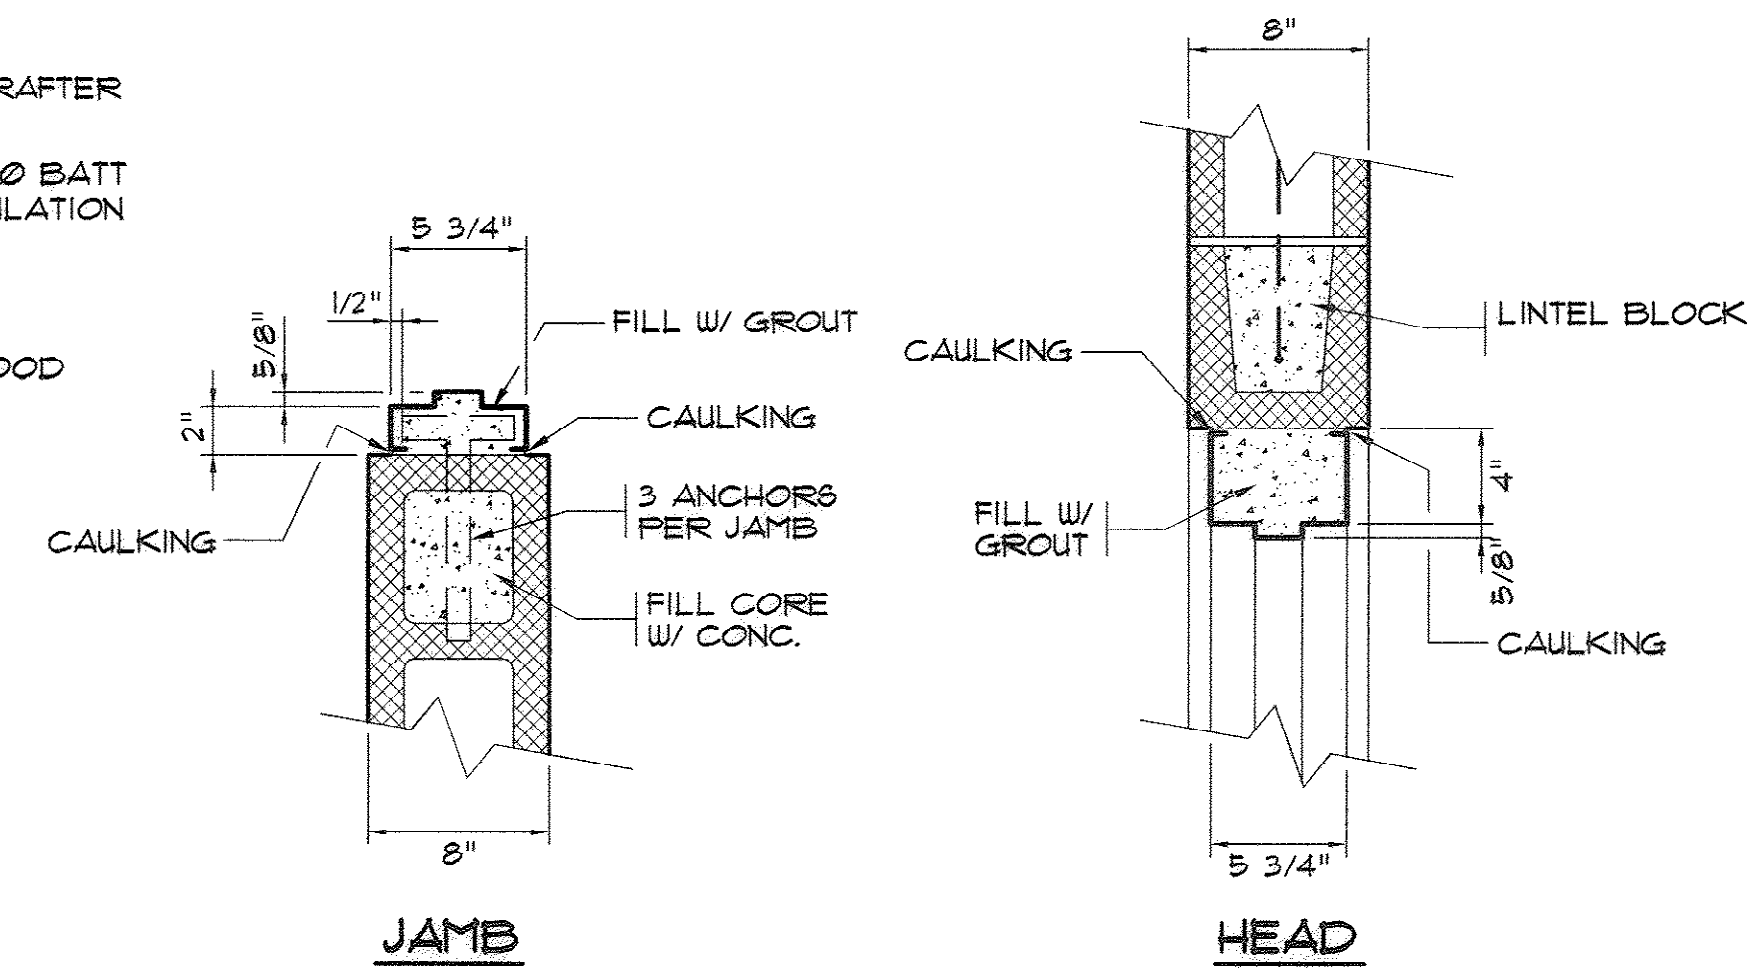


DOOR DETAILS
NTS

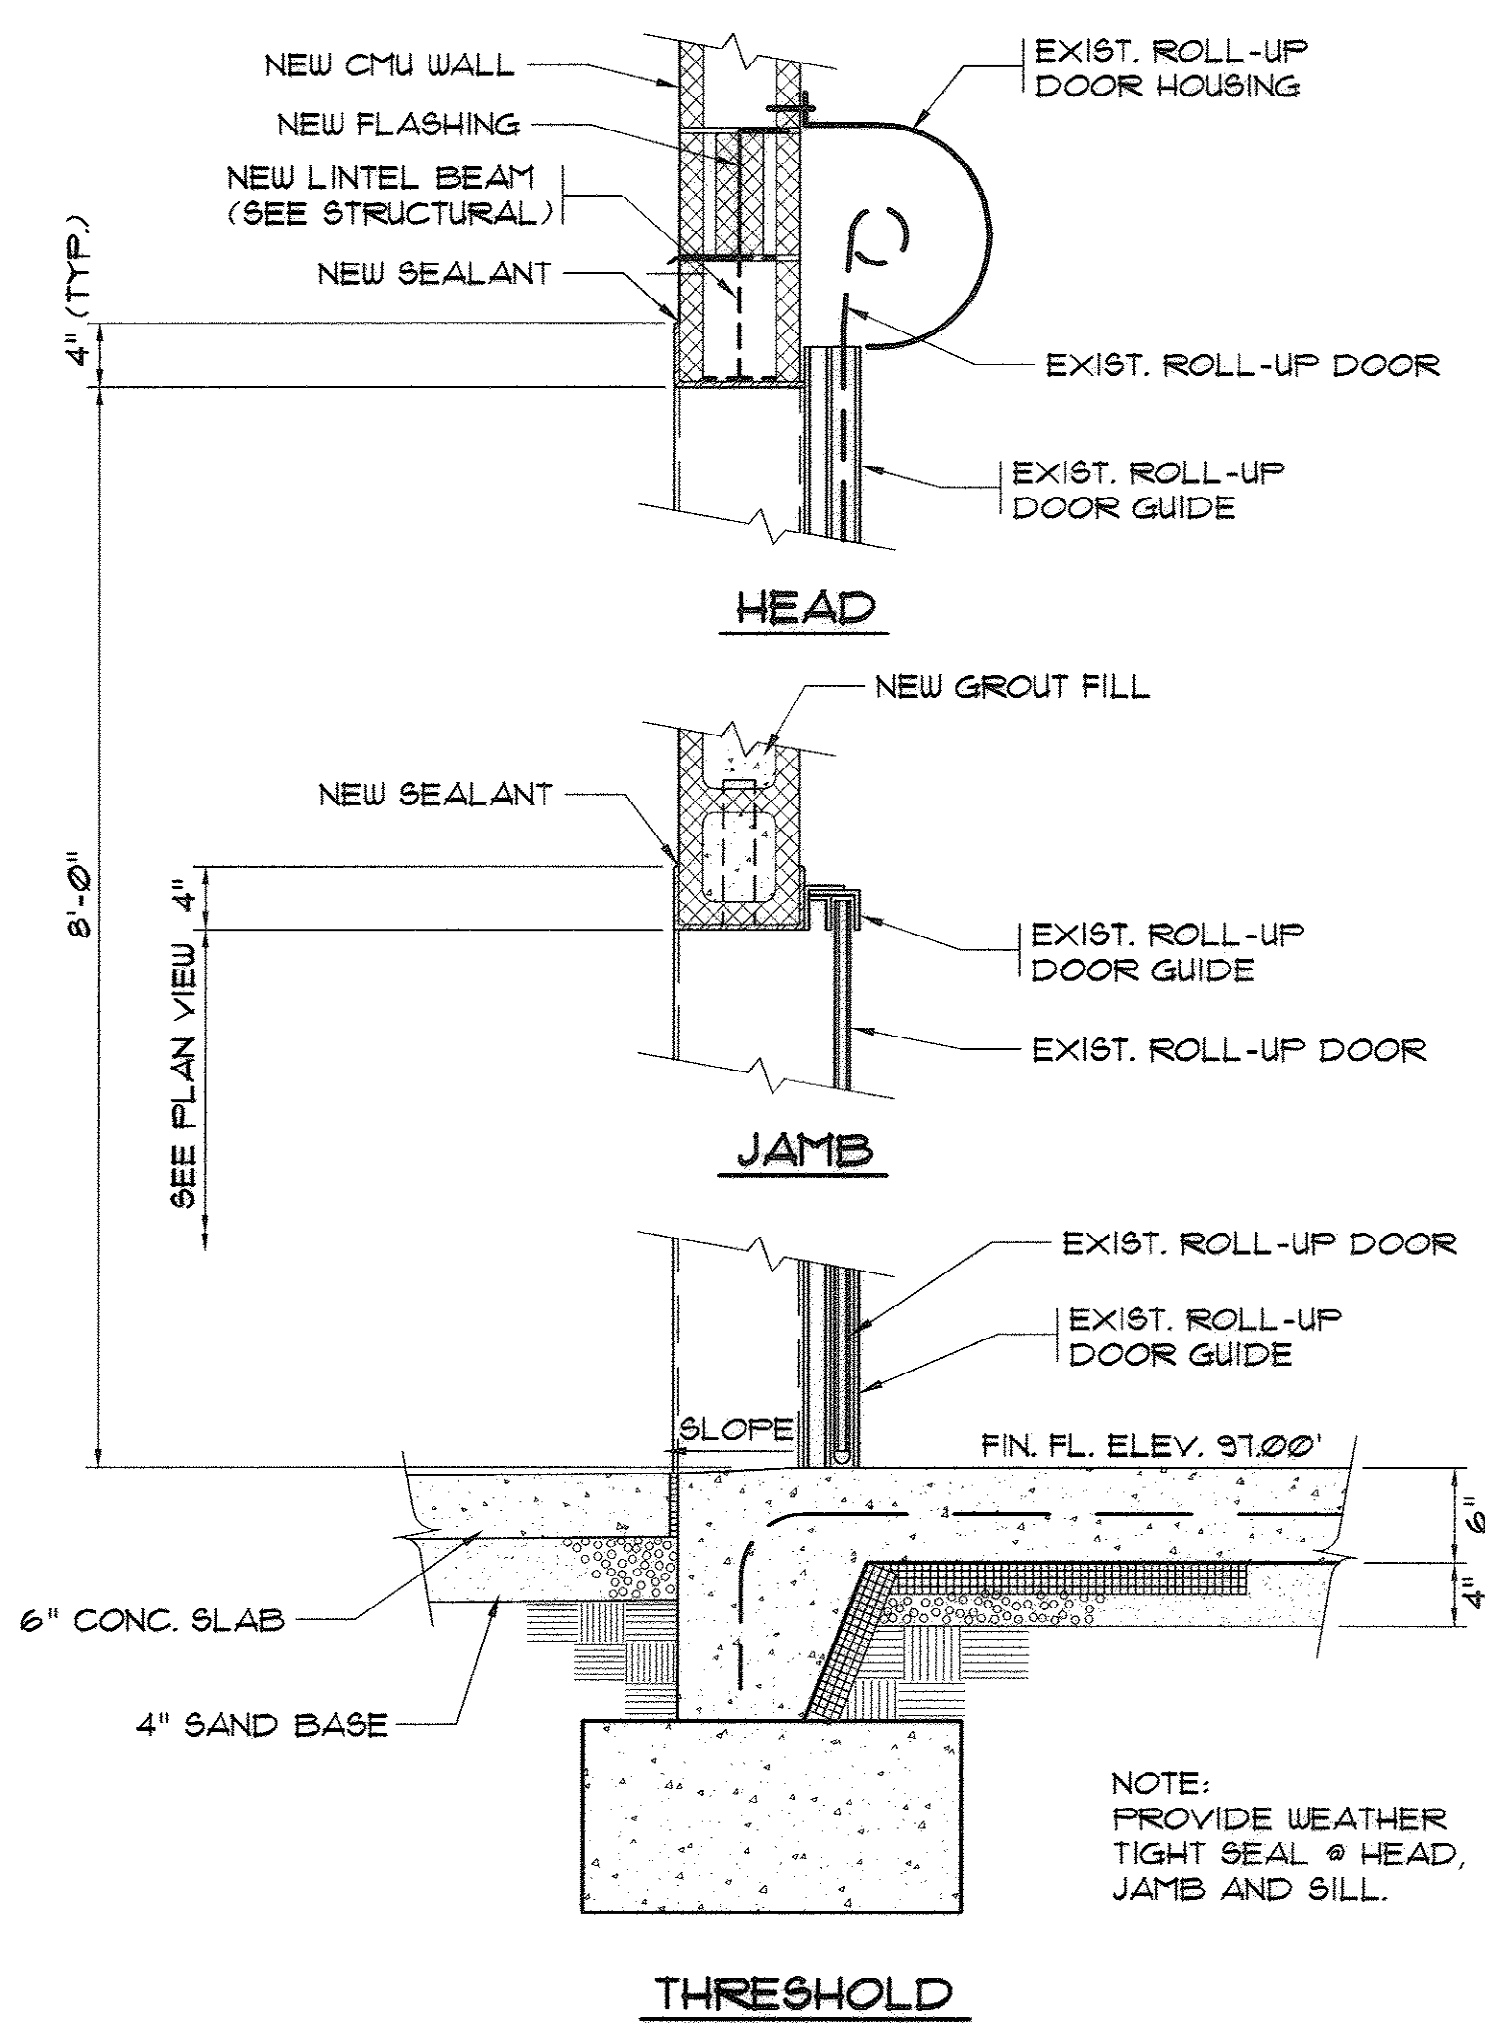


5 TYPICAL SECTION THRU ROLL-UP DOOR
SCALE: 1" = 1'-0"



NOTE:
PROVIDE WEATHER
TIGHT SEAL @ HEAD,
JAMB AND SILL.

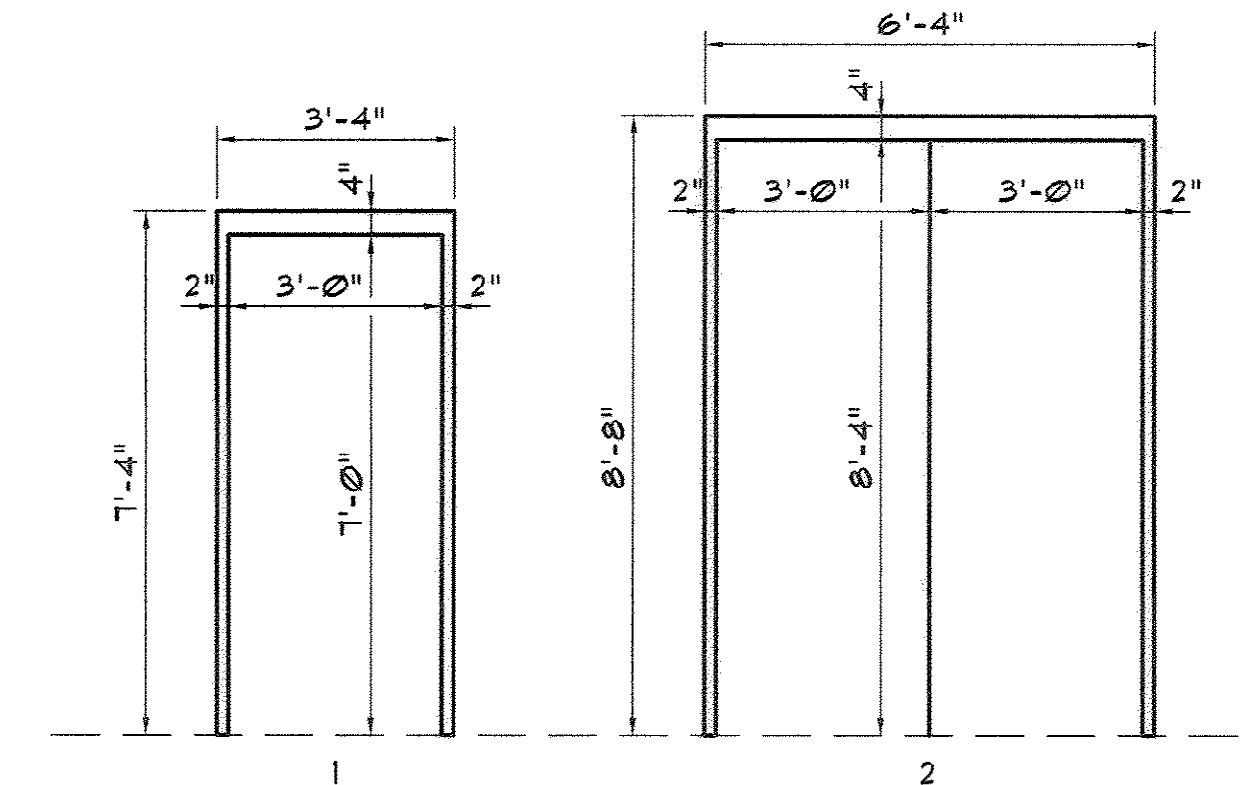

FRAME ELEVATIONS
NTS

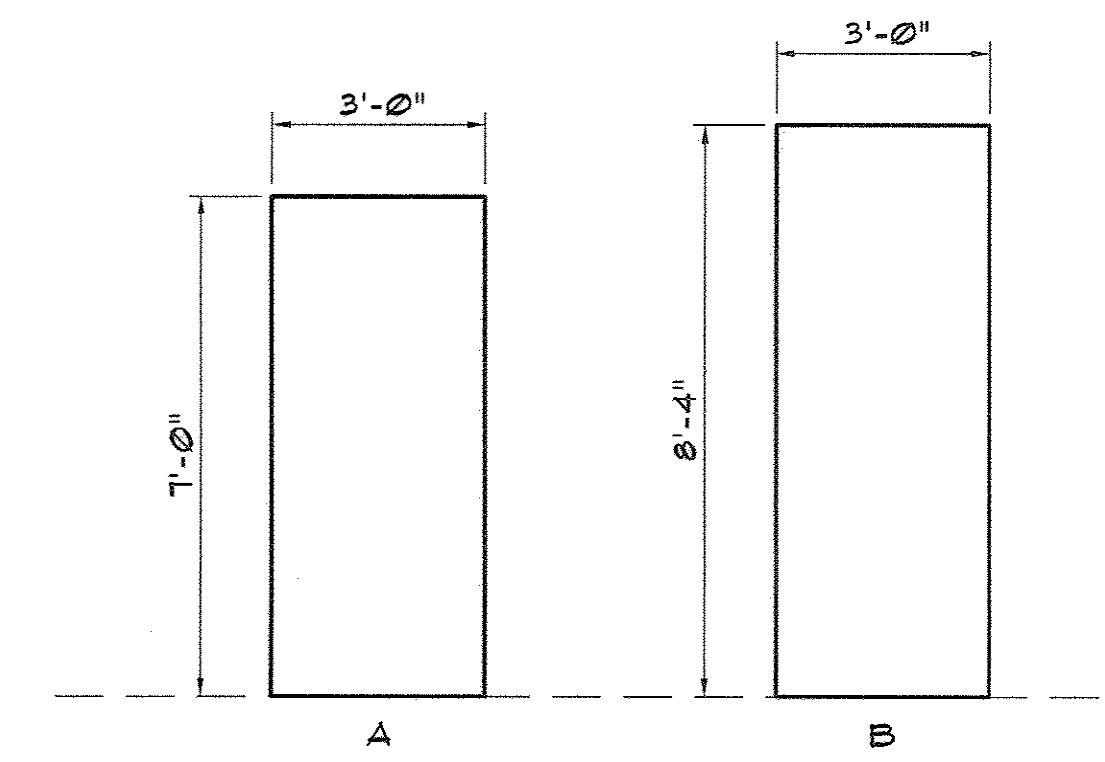

DOOR ELEVATIONS
NTS

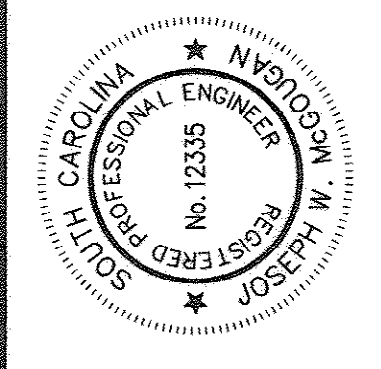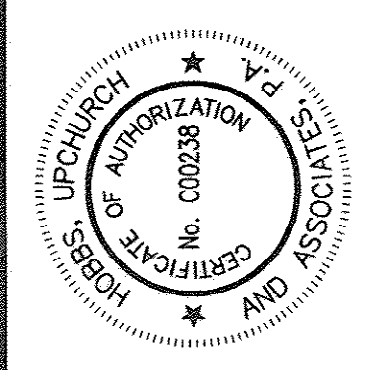

Upchurch & Associates, P.A.
Consulting Engineers
Myrtle Beach, South Carolina 29577
PHONE (843) 628-1910 FAX (843) 628-1748

**WALL SECTIONS &
DOOR DETAILS**



**PERRY ROAD
PUMP STATION
GRAND STRAND WATER &
SEWER AUTHORITY**

DATE:	9-5-2008
DESIGNED:	JWM
DRAWN:	ALG
CHECKED:	JWM
SCALE:	AS SHOWN
SHEET NO.	10


AS-BUILT 9-5-08

13-250-010/362W

REVISIONS			
SYM.	DESCRIPTION	DATE	BY

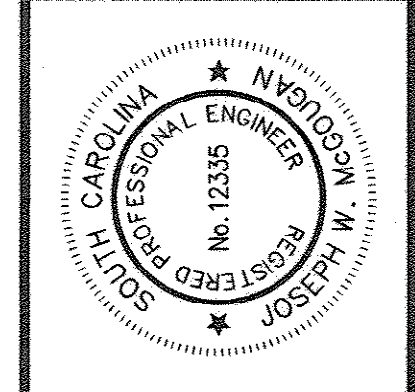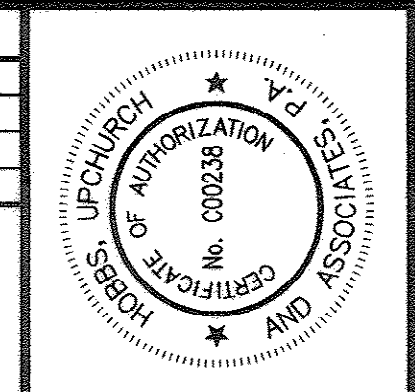


Hobbs, Upchurch & Associates, P.A.
 Consulting Engineers
 Myrtle Beach, South Carolina 29577
 PHONE: (843) 668-1910 FAX: (843) 668-1748

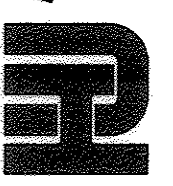


**EXTERIOR
MODIFICATION
ELEVATIONS**

**PERRY ROAD
PUMP STATION
GRAND STRAND WATER &
SEWER AUTHORITY**


DATE:	9-5-2008
DESIGNED:	JWM
DRAWN:	ALG
CHECKED:	JWM
SCALE:	AS SHOWN
SHEET NO.	9
OF:	15
VERSION:	4

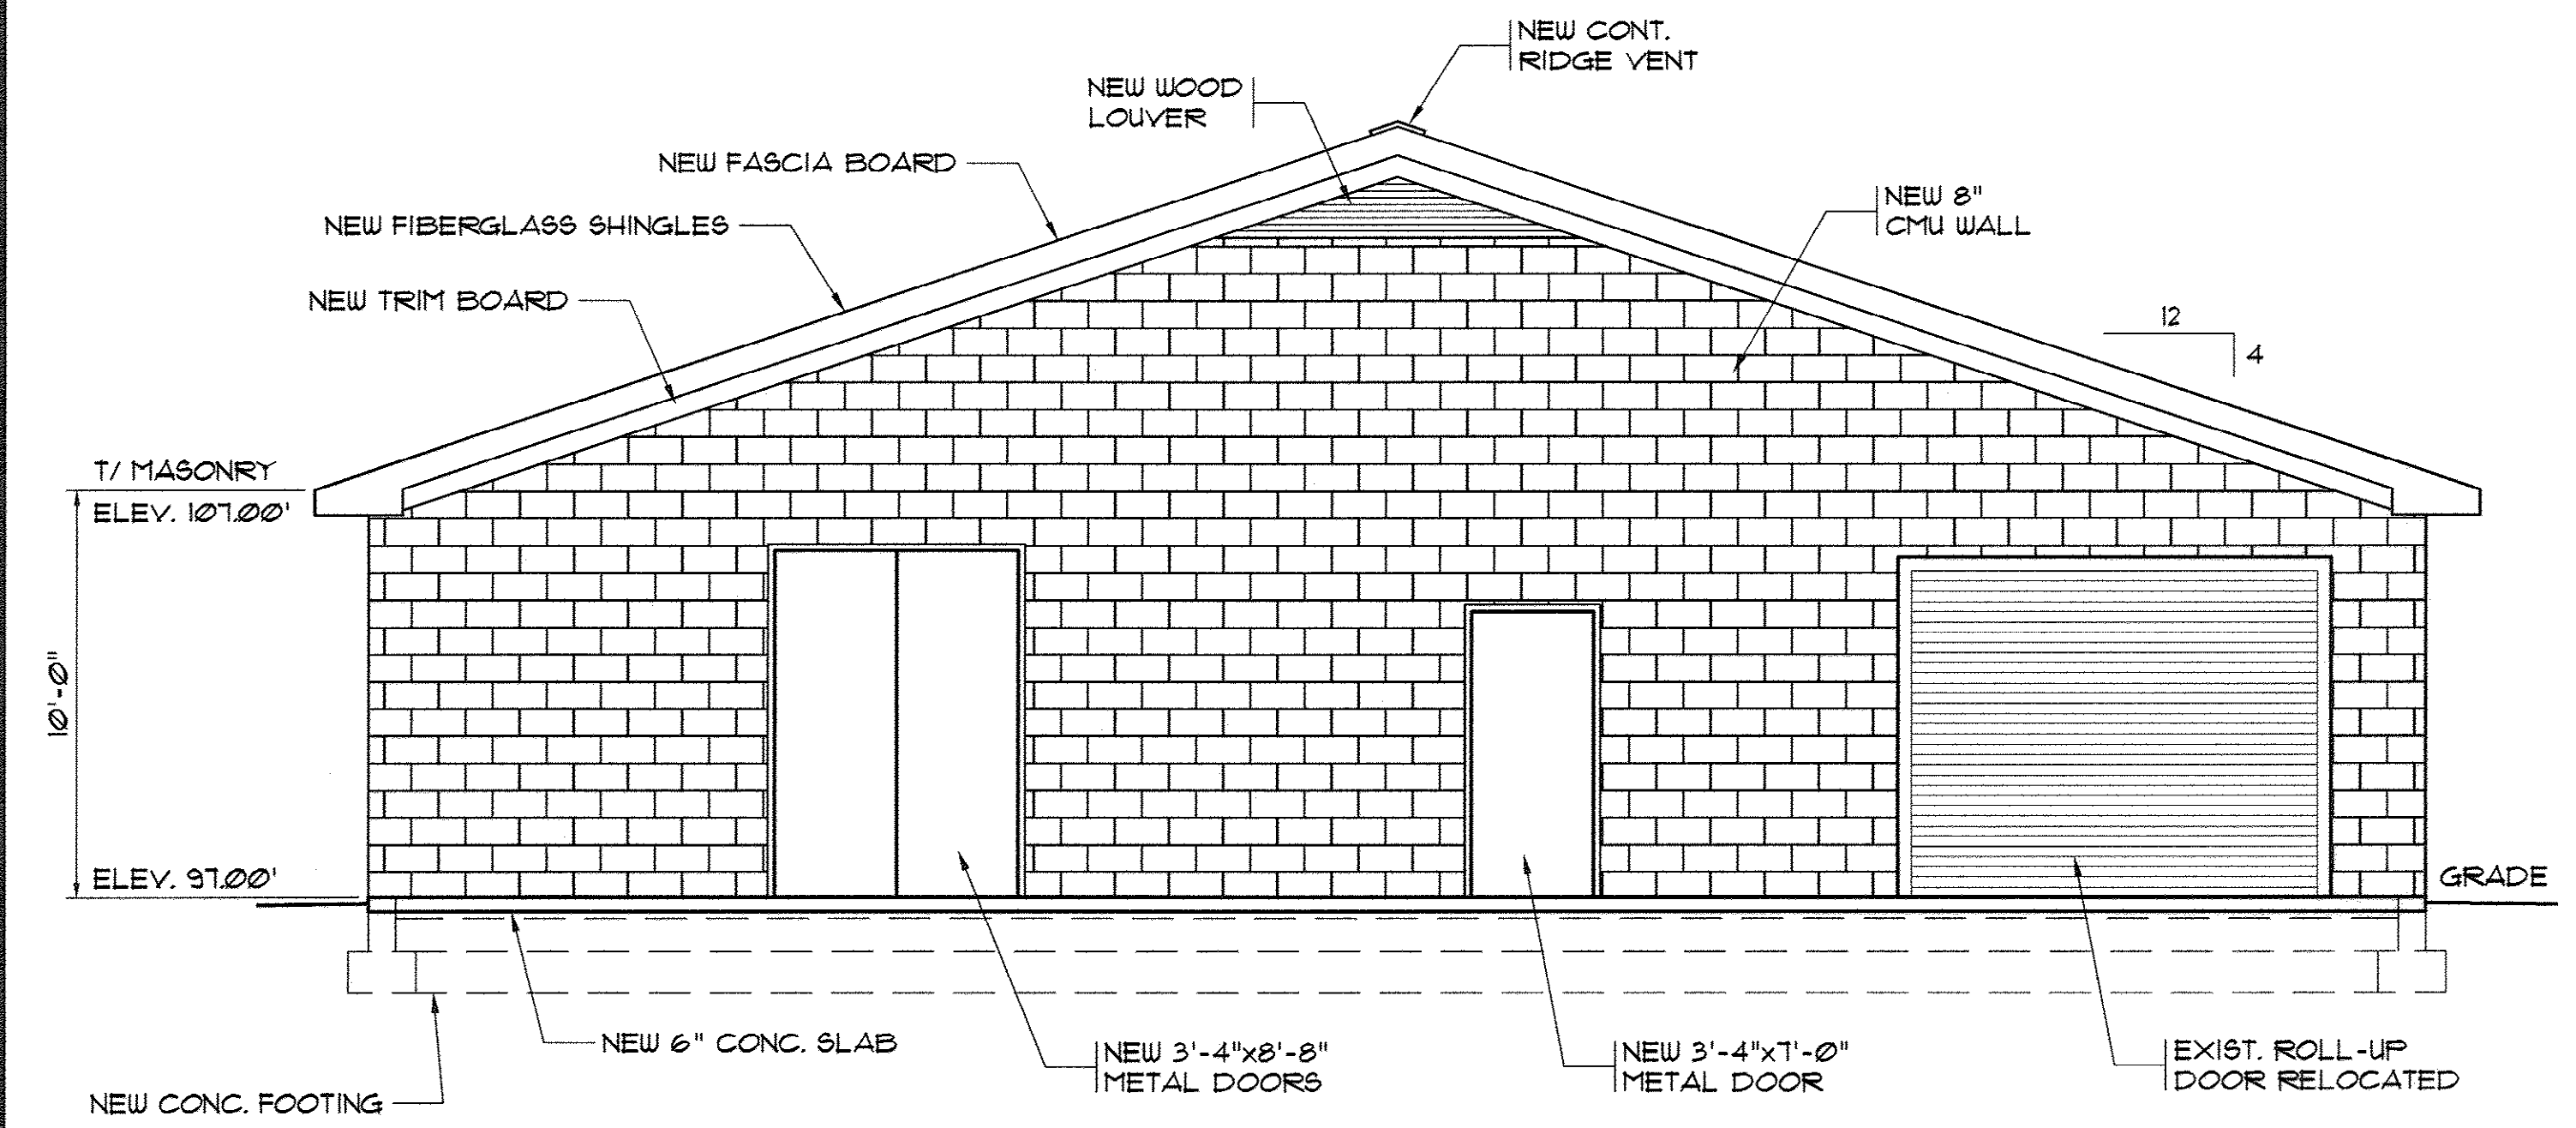

**1 FRONT ELEVATION
MODIFICATION**
 SCALE: 1/4"=1'-0"

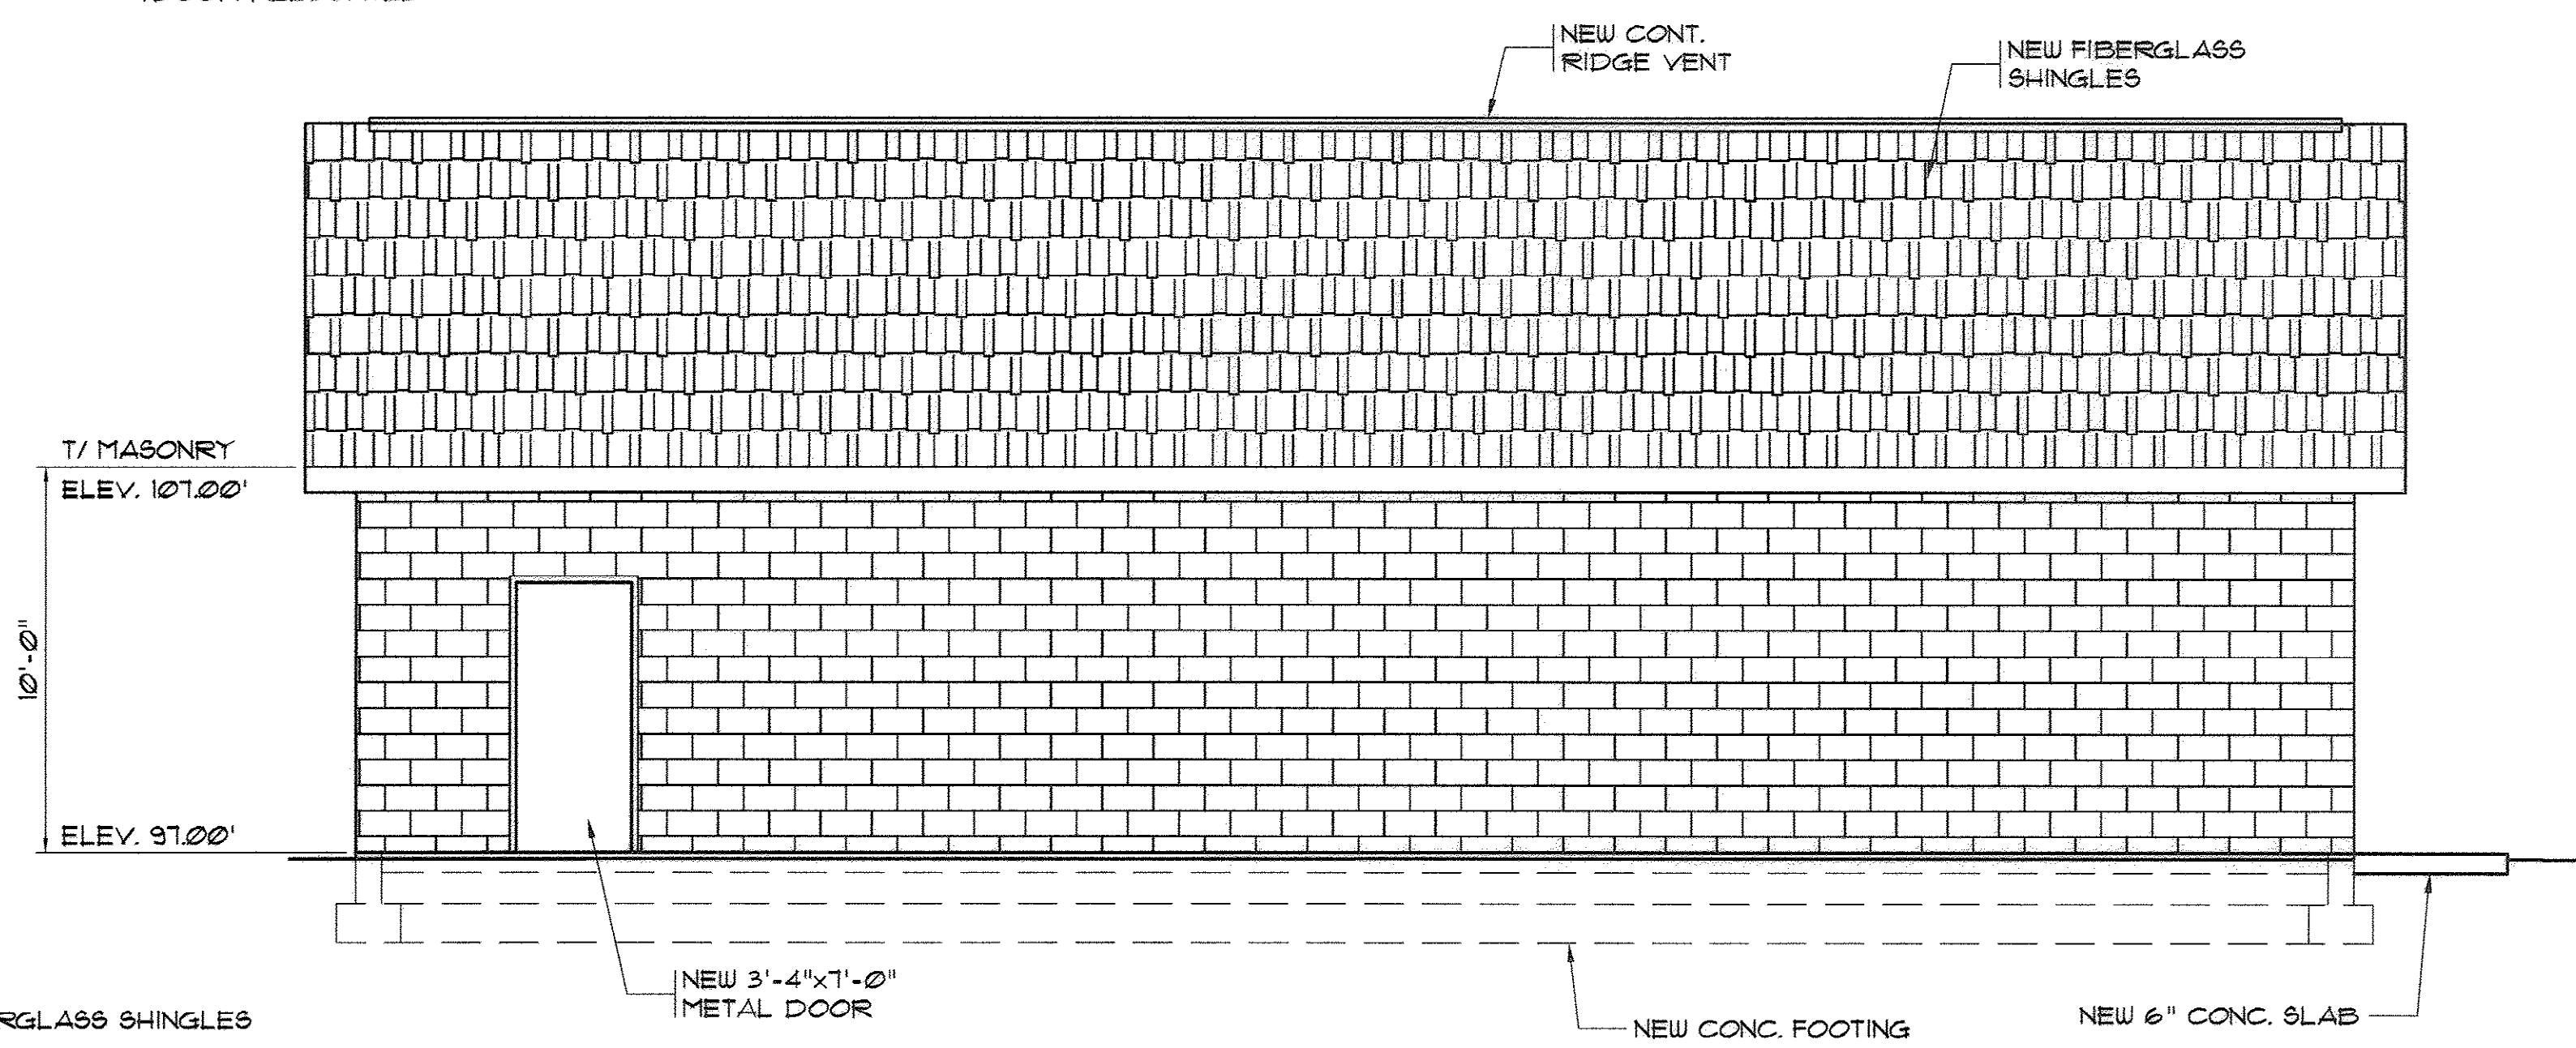

**2 SIDE ELEVATION
MODIFICATION**
 SCALE: 1/4"=1'-0"


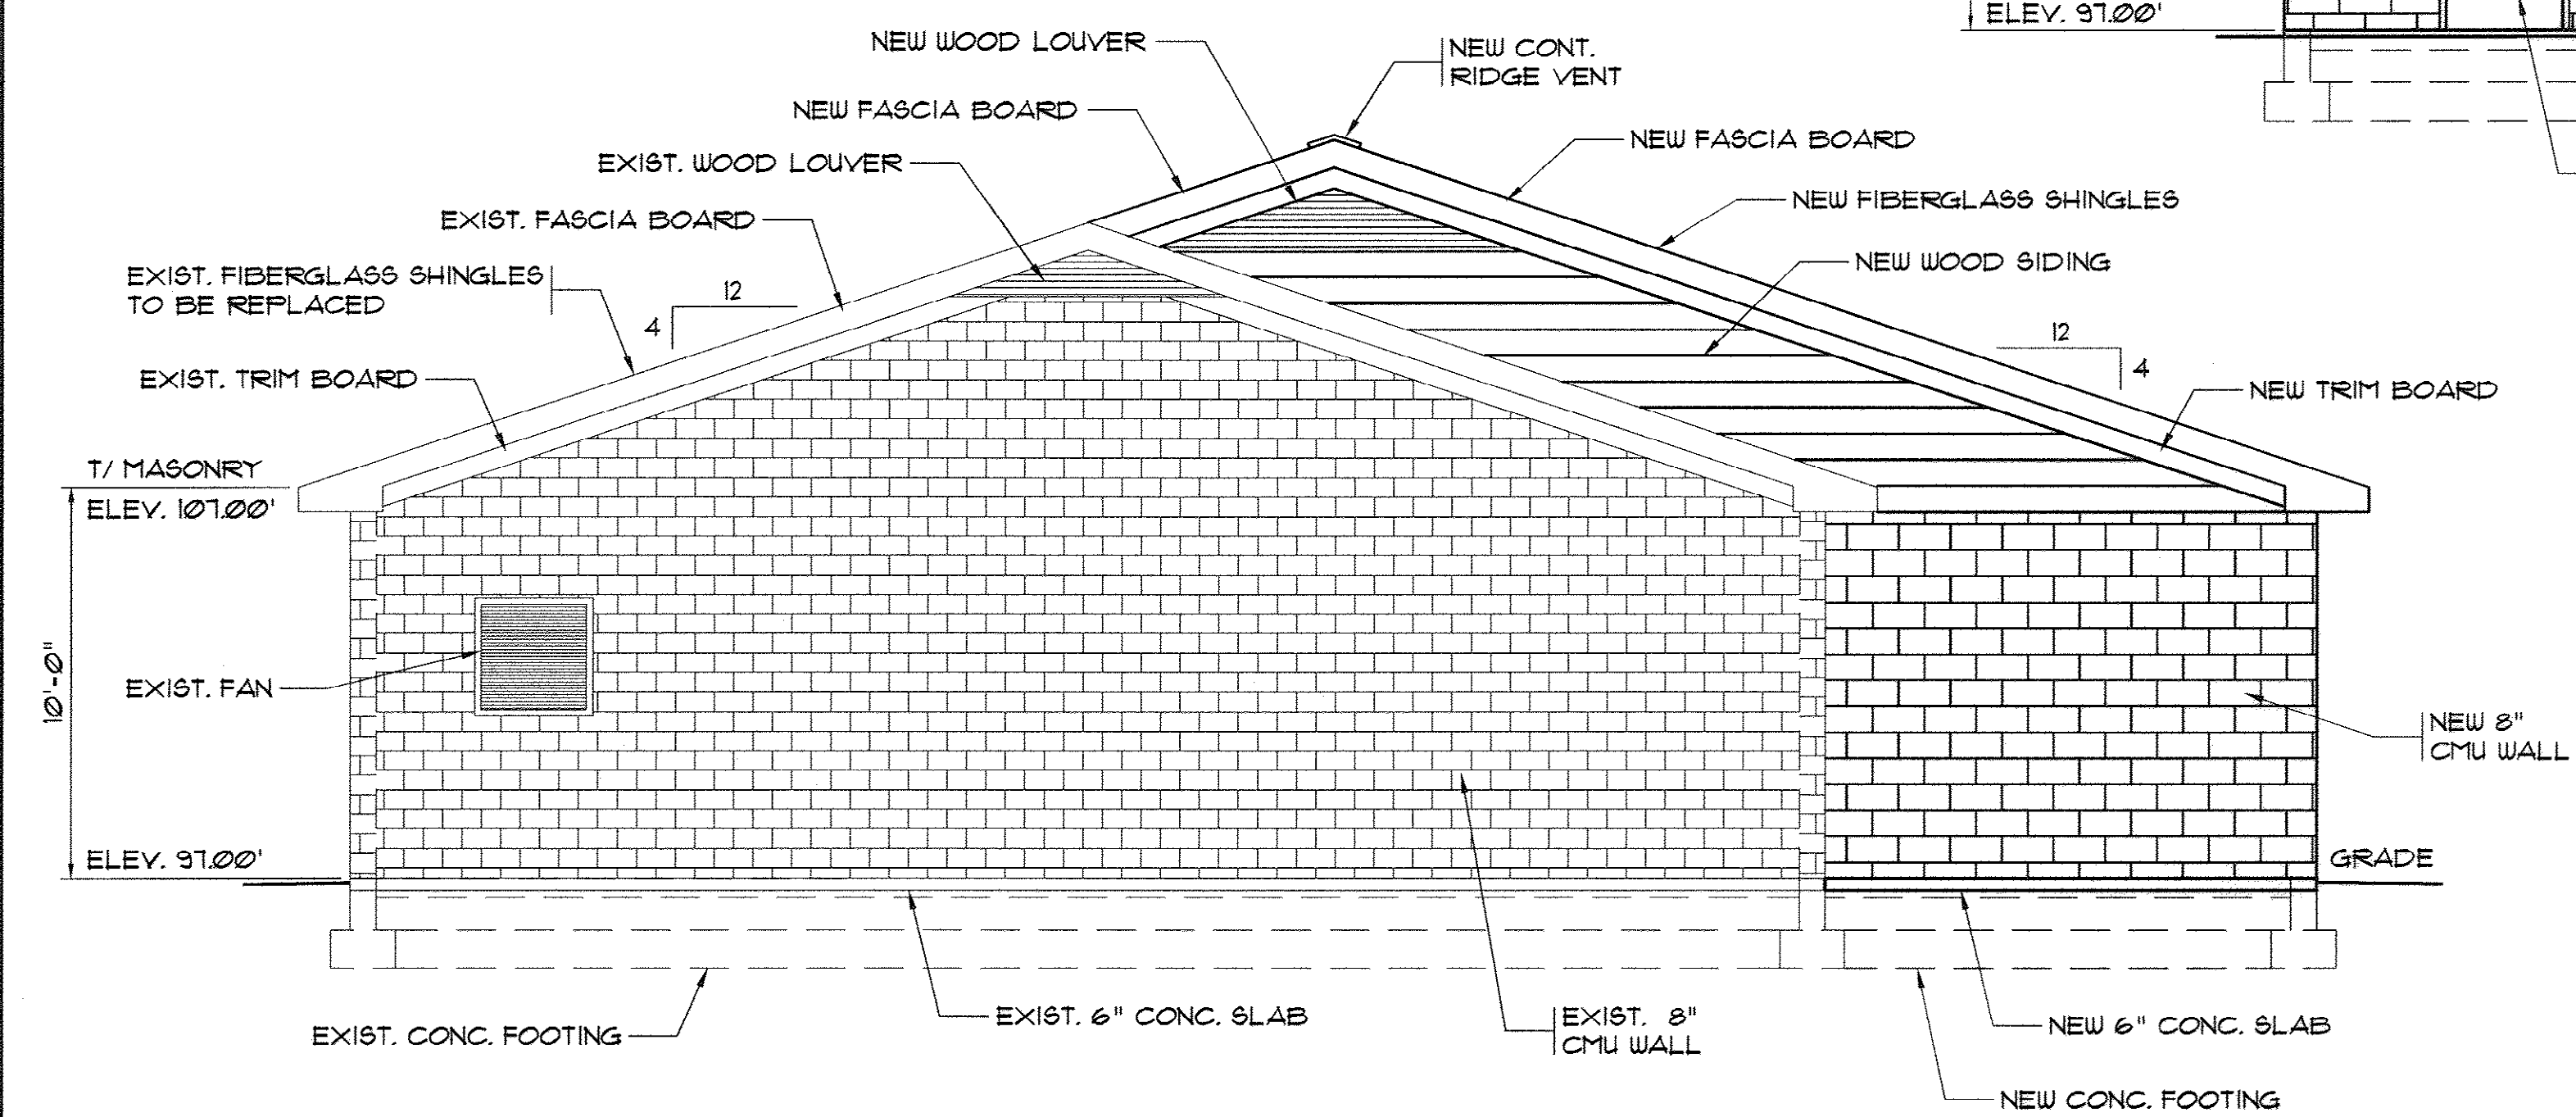


**3 REAR ELEVATION
MODIFICATION**
 SCALE: 1/4"=1'-0"

AS-BUILT 9-5-08

~~13-009~~
 13-250-009/36 W

REVISIONS			
SYM.	DESCRIPTION	DATE	BY

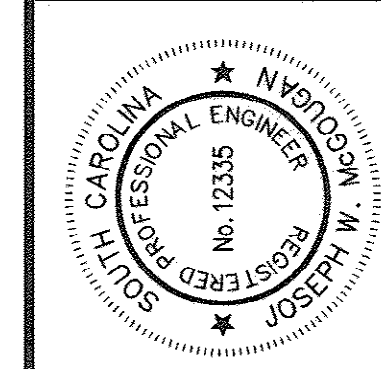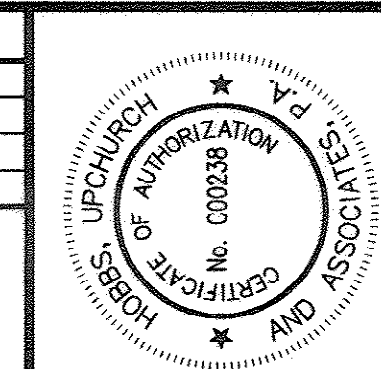


Upchurch & Associates, P.A.
 Consulting Engineers
 Myrtle Beach, South Carolina 29577
 PHONE (843) 658-1910 FAX (843) 658-1748

**EXISTING PUMP STATION
 MECHANICAL
 MODIFICATION LAYOUT**

**PERRY ROAD
 PUMP STATION
 GRAND STRAND WATER &
 SEWER AUTHORITY**

DATE:	9-5-2008
DESIGNED:	JWM
DRAWN:	ALG
CHECKED:	JWM
SCALE:	AS SHOWN
SHEET NO.	11
OF 15	VERSION: 4

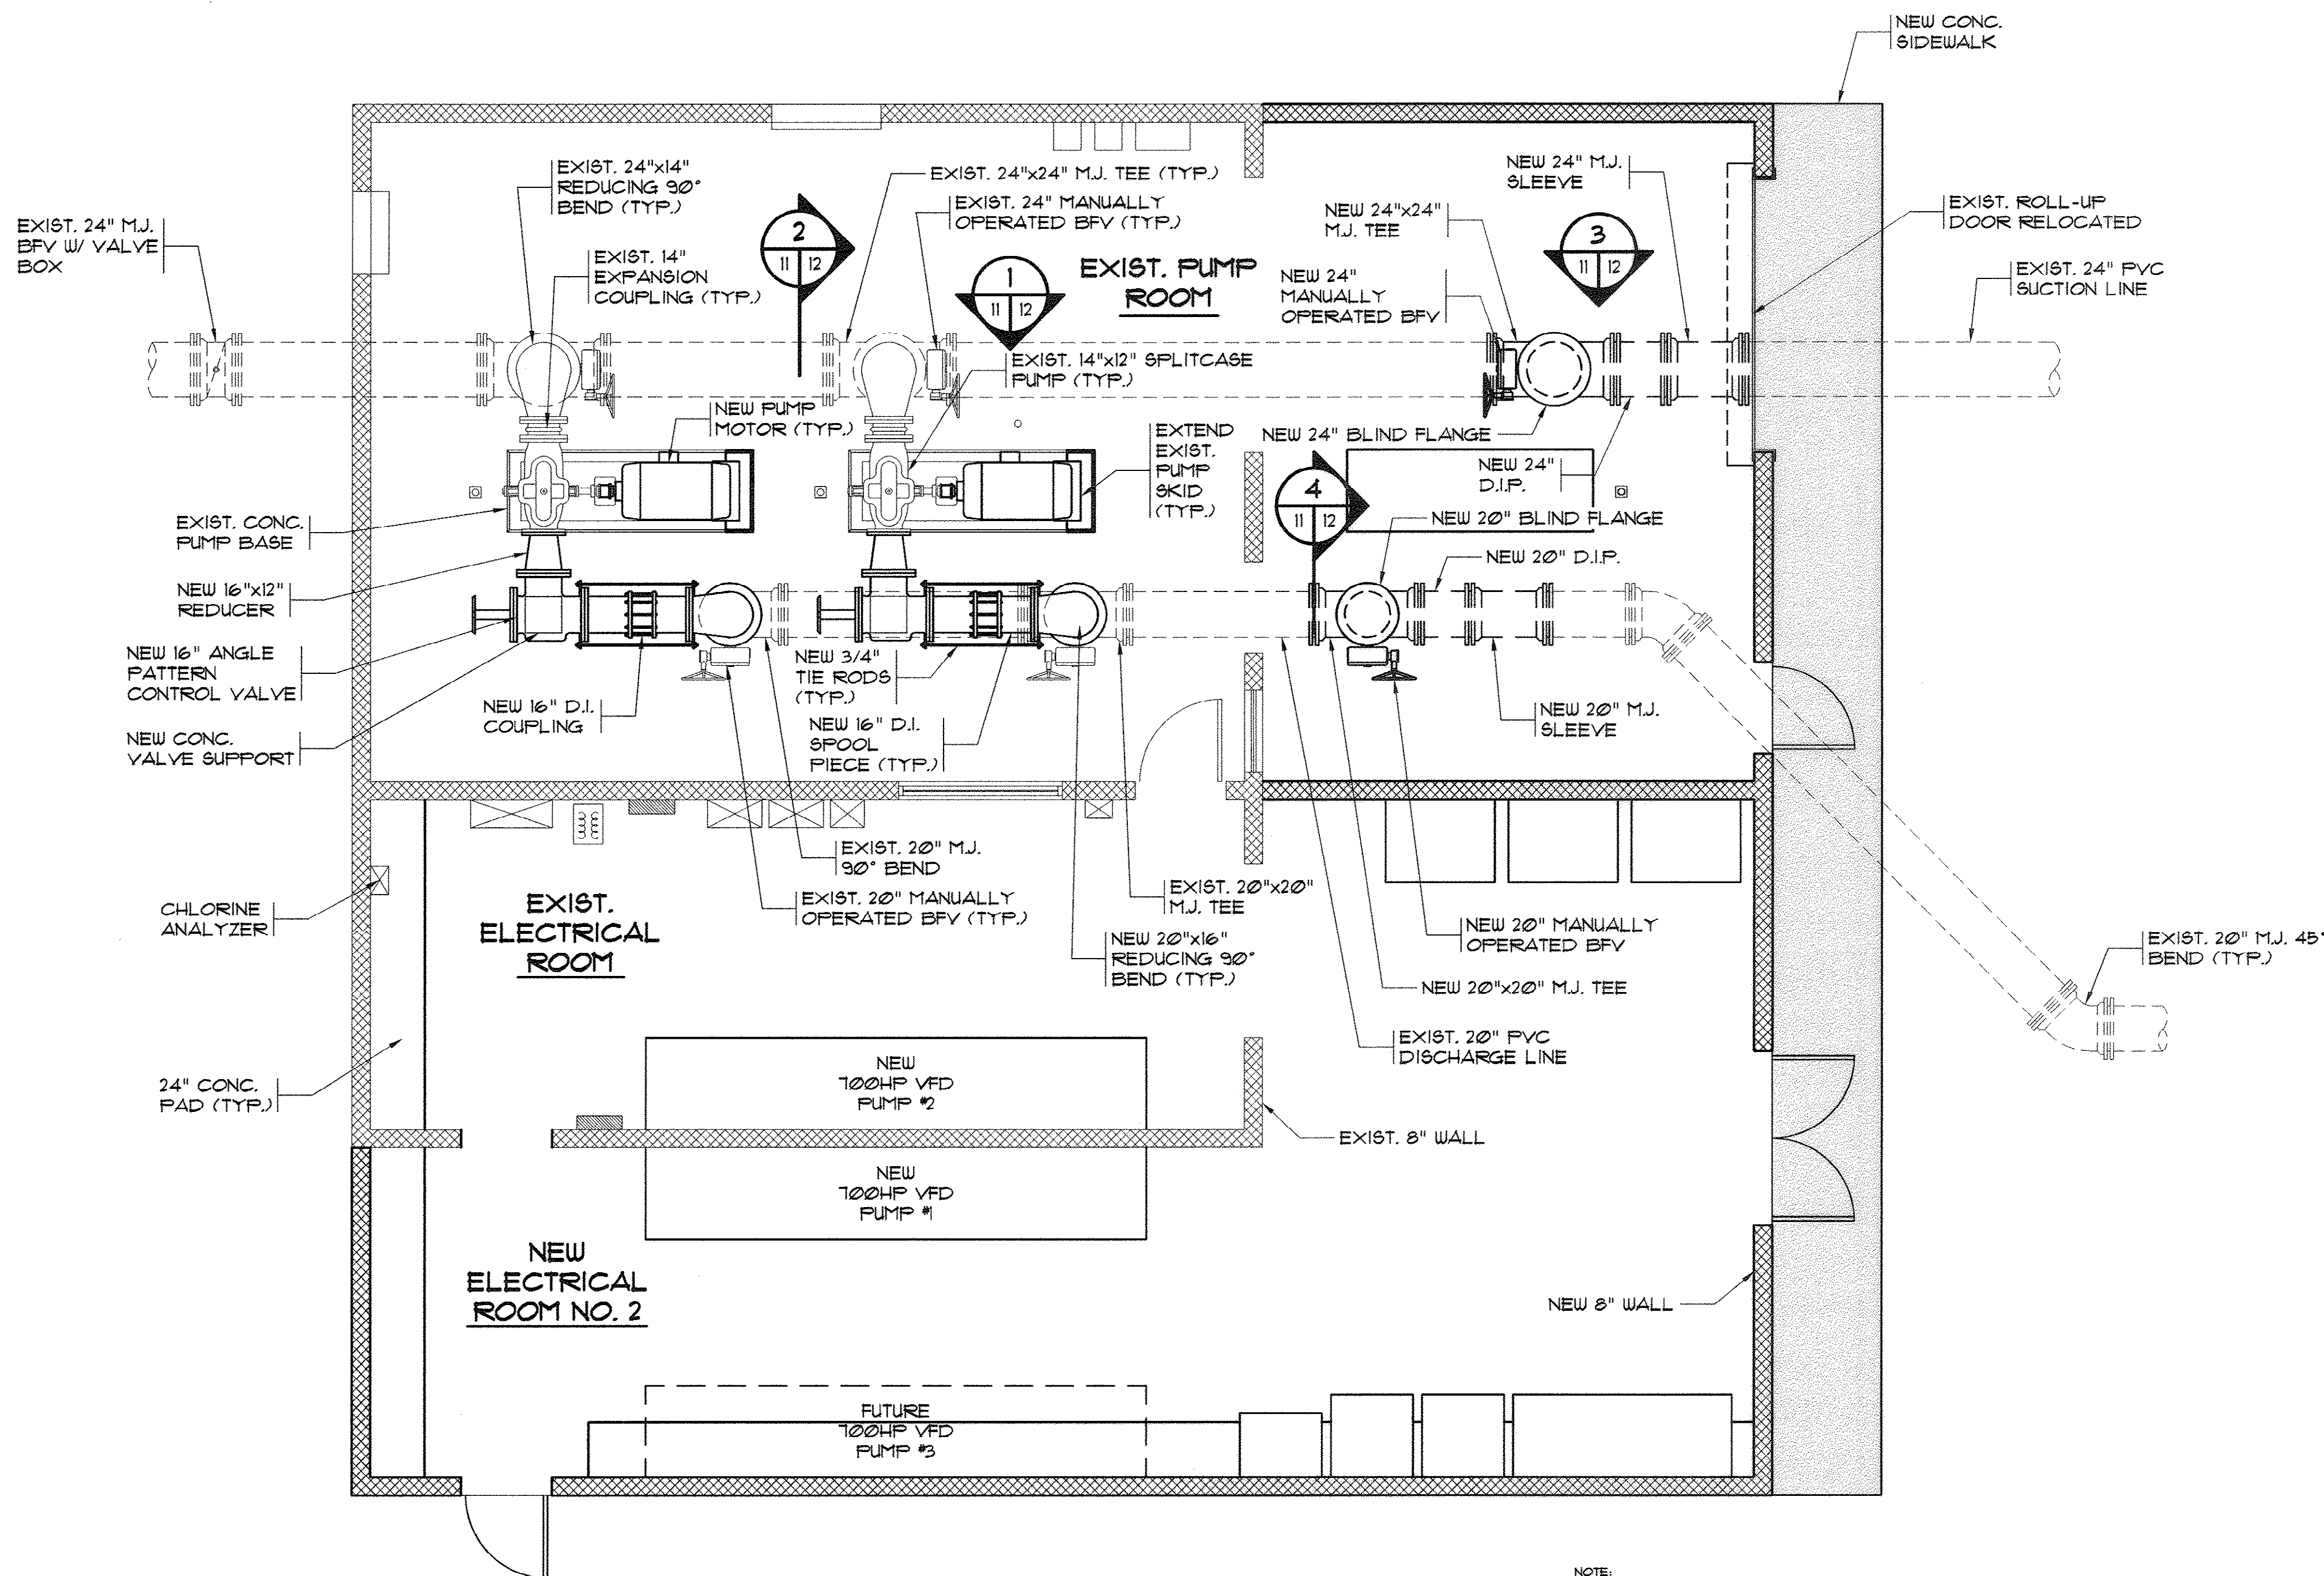


NOTE:
 CONTRACTOR SHALL INSTALL A 16" GOLDEN
 ANDERSON INDUSTRIES ANGLE PATTERN
 CONTROL VALVE. CONTRACTOR IS
 RESPONSIBLE FOR ALL MODIFICATIONS TO
 FULLY INSTALL THE VALVE INCLUDING PIPING,
 CONTROLS AND VALVE CONTROL PANEL.


**EXISTING PUMP STATION
 MECHANICAL MODIFICATION LAYOUT**
 SCALE: 1/4" = 1'-0"

AS-BUILT 9-5-08


12-250-011/36 W

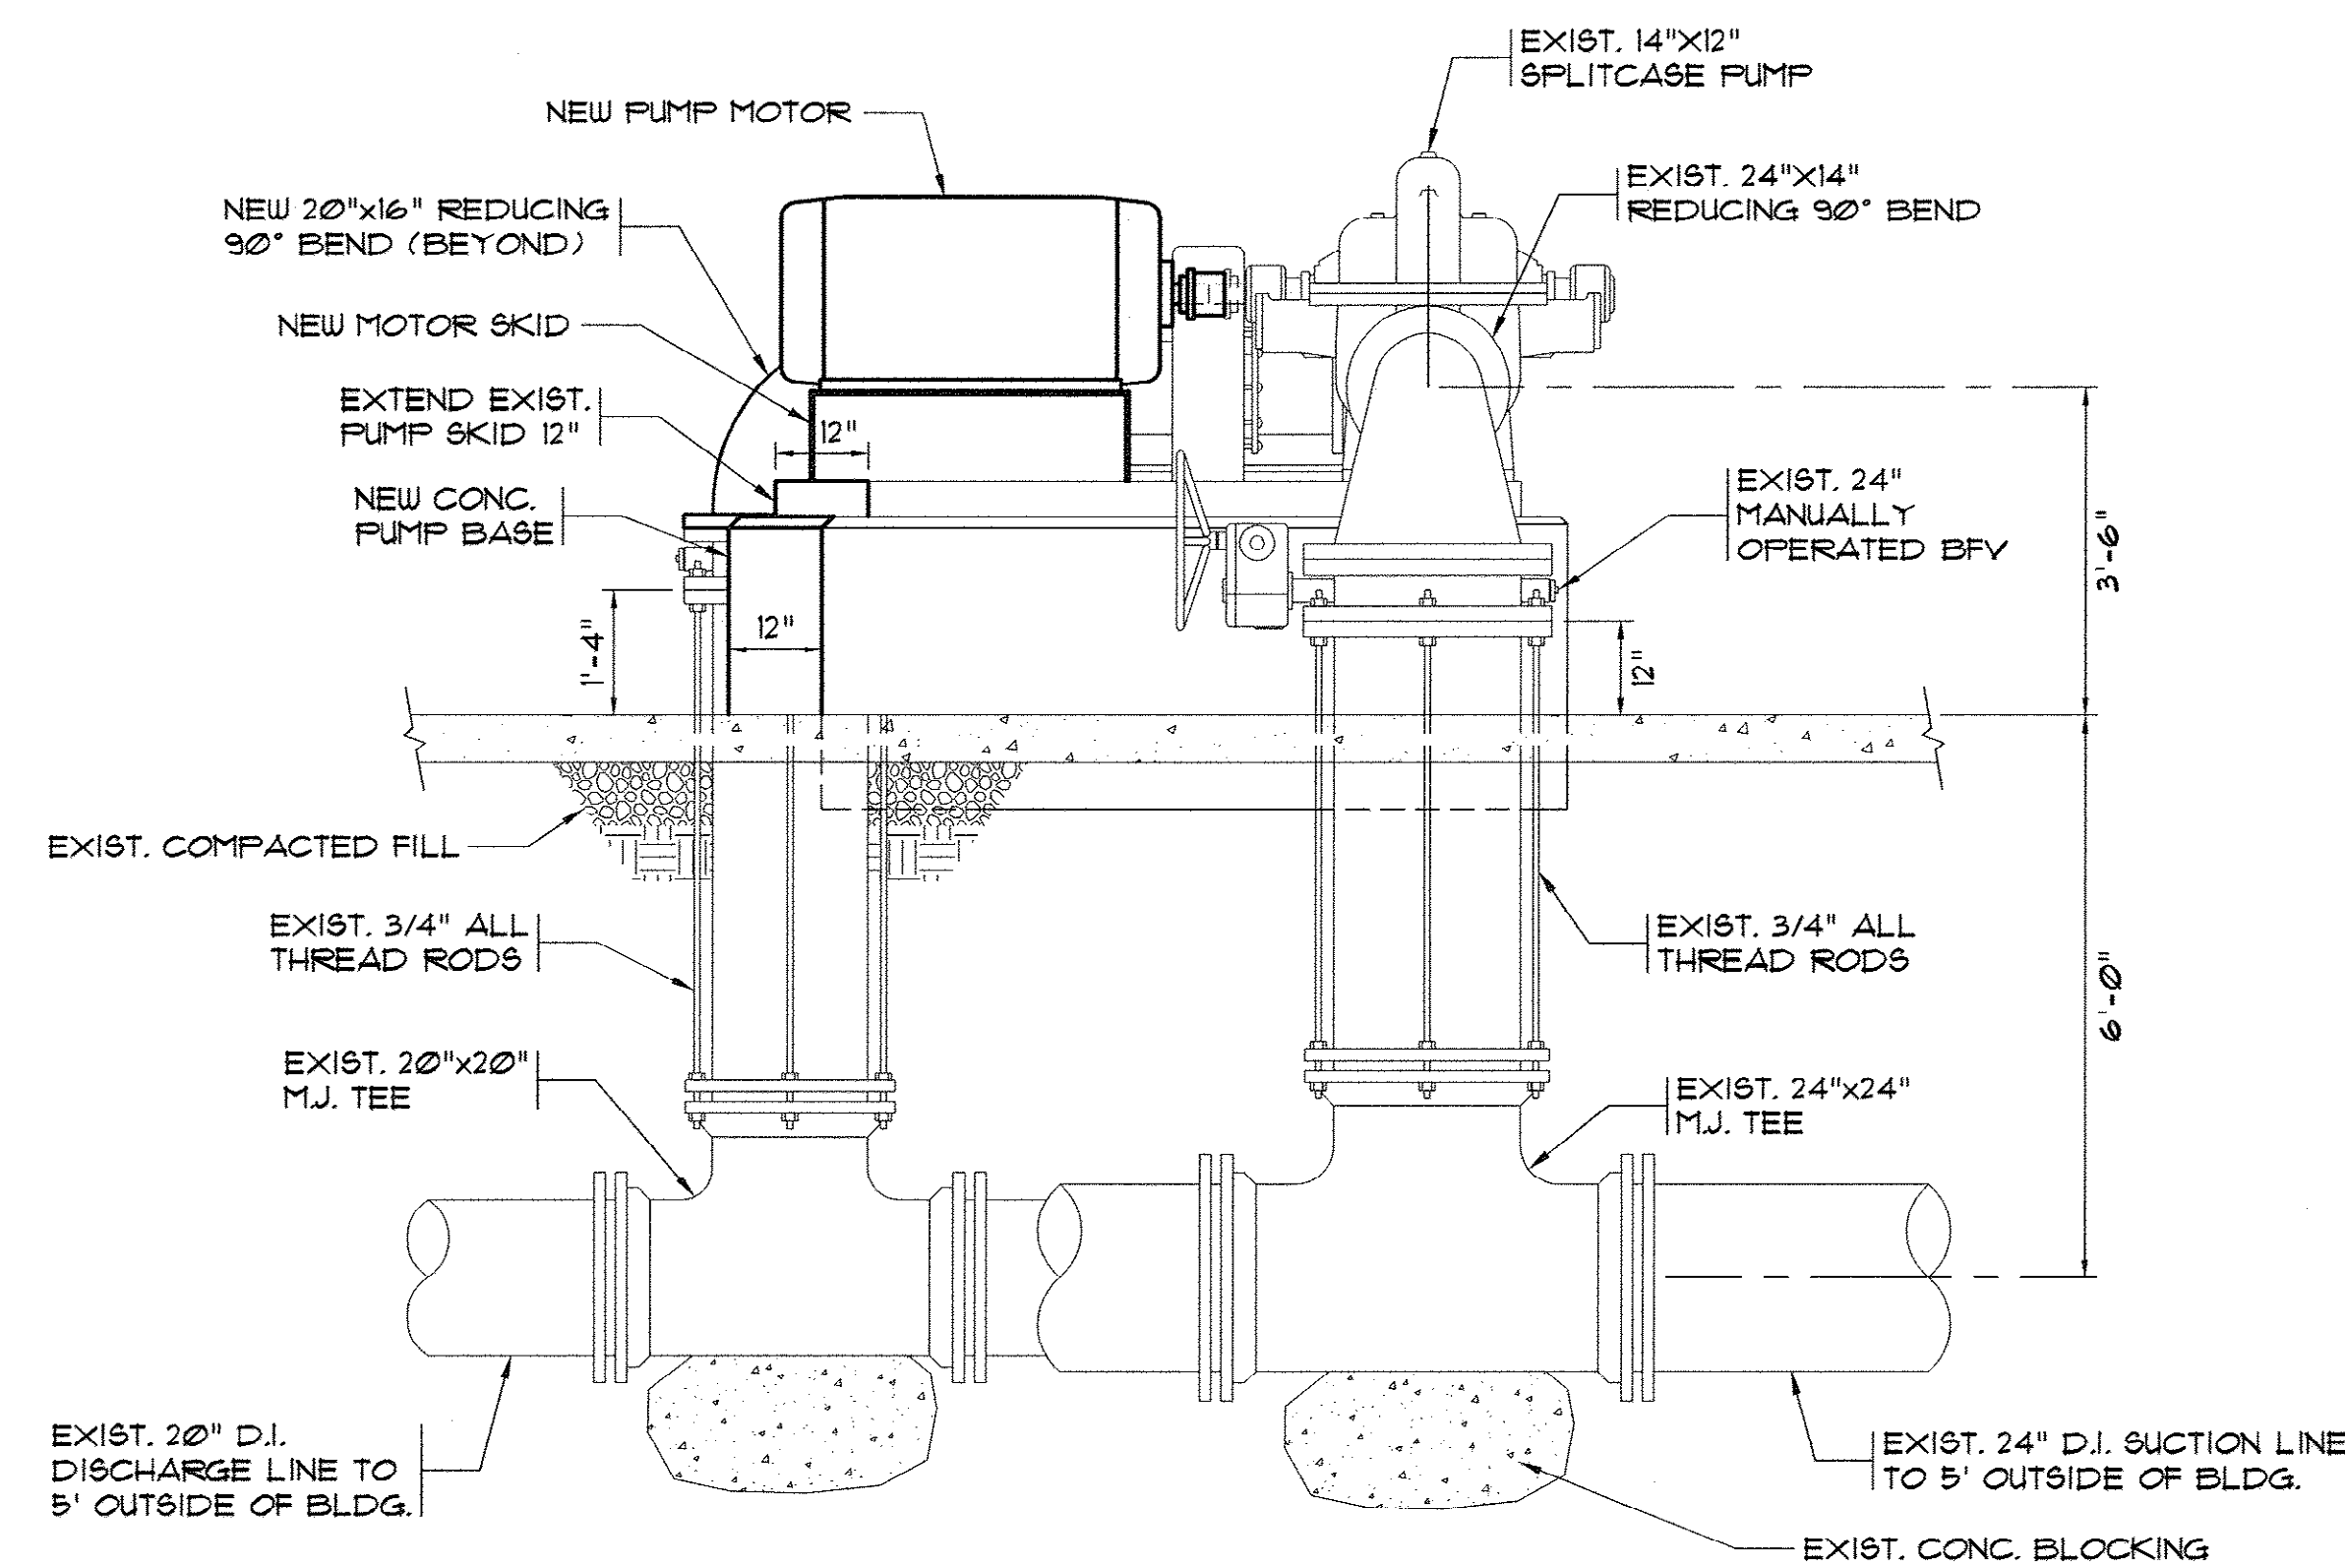

1 EXISTING PUMP ELEVATION MODIFICATION
SCALE: 1/2" = 1'-0"

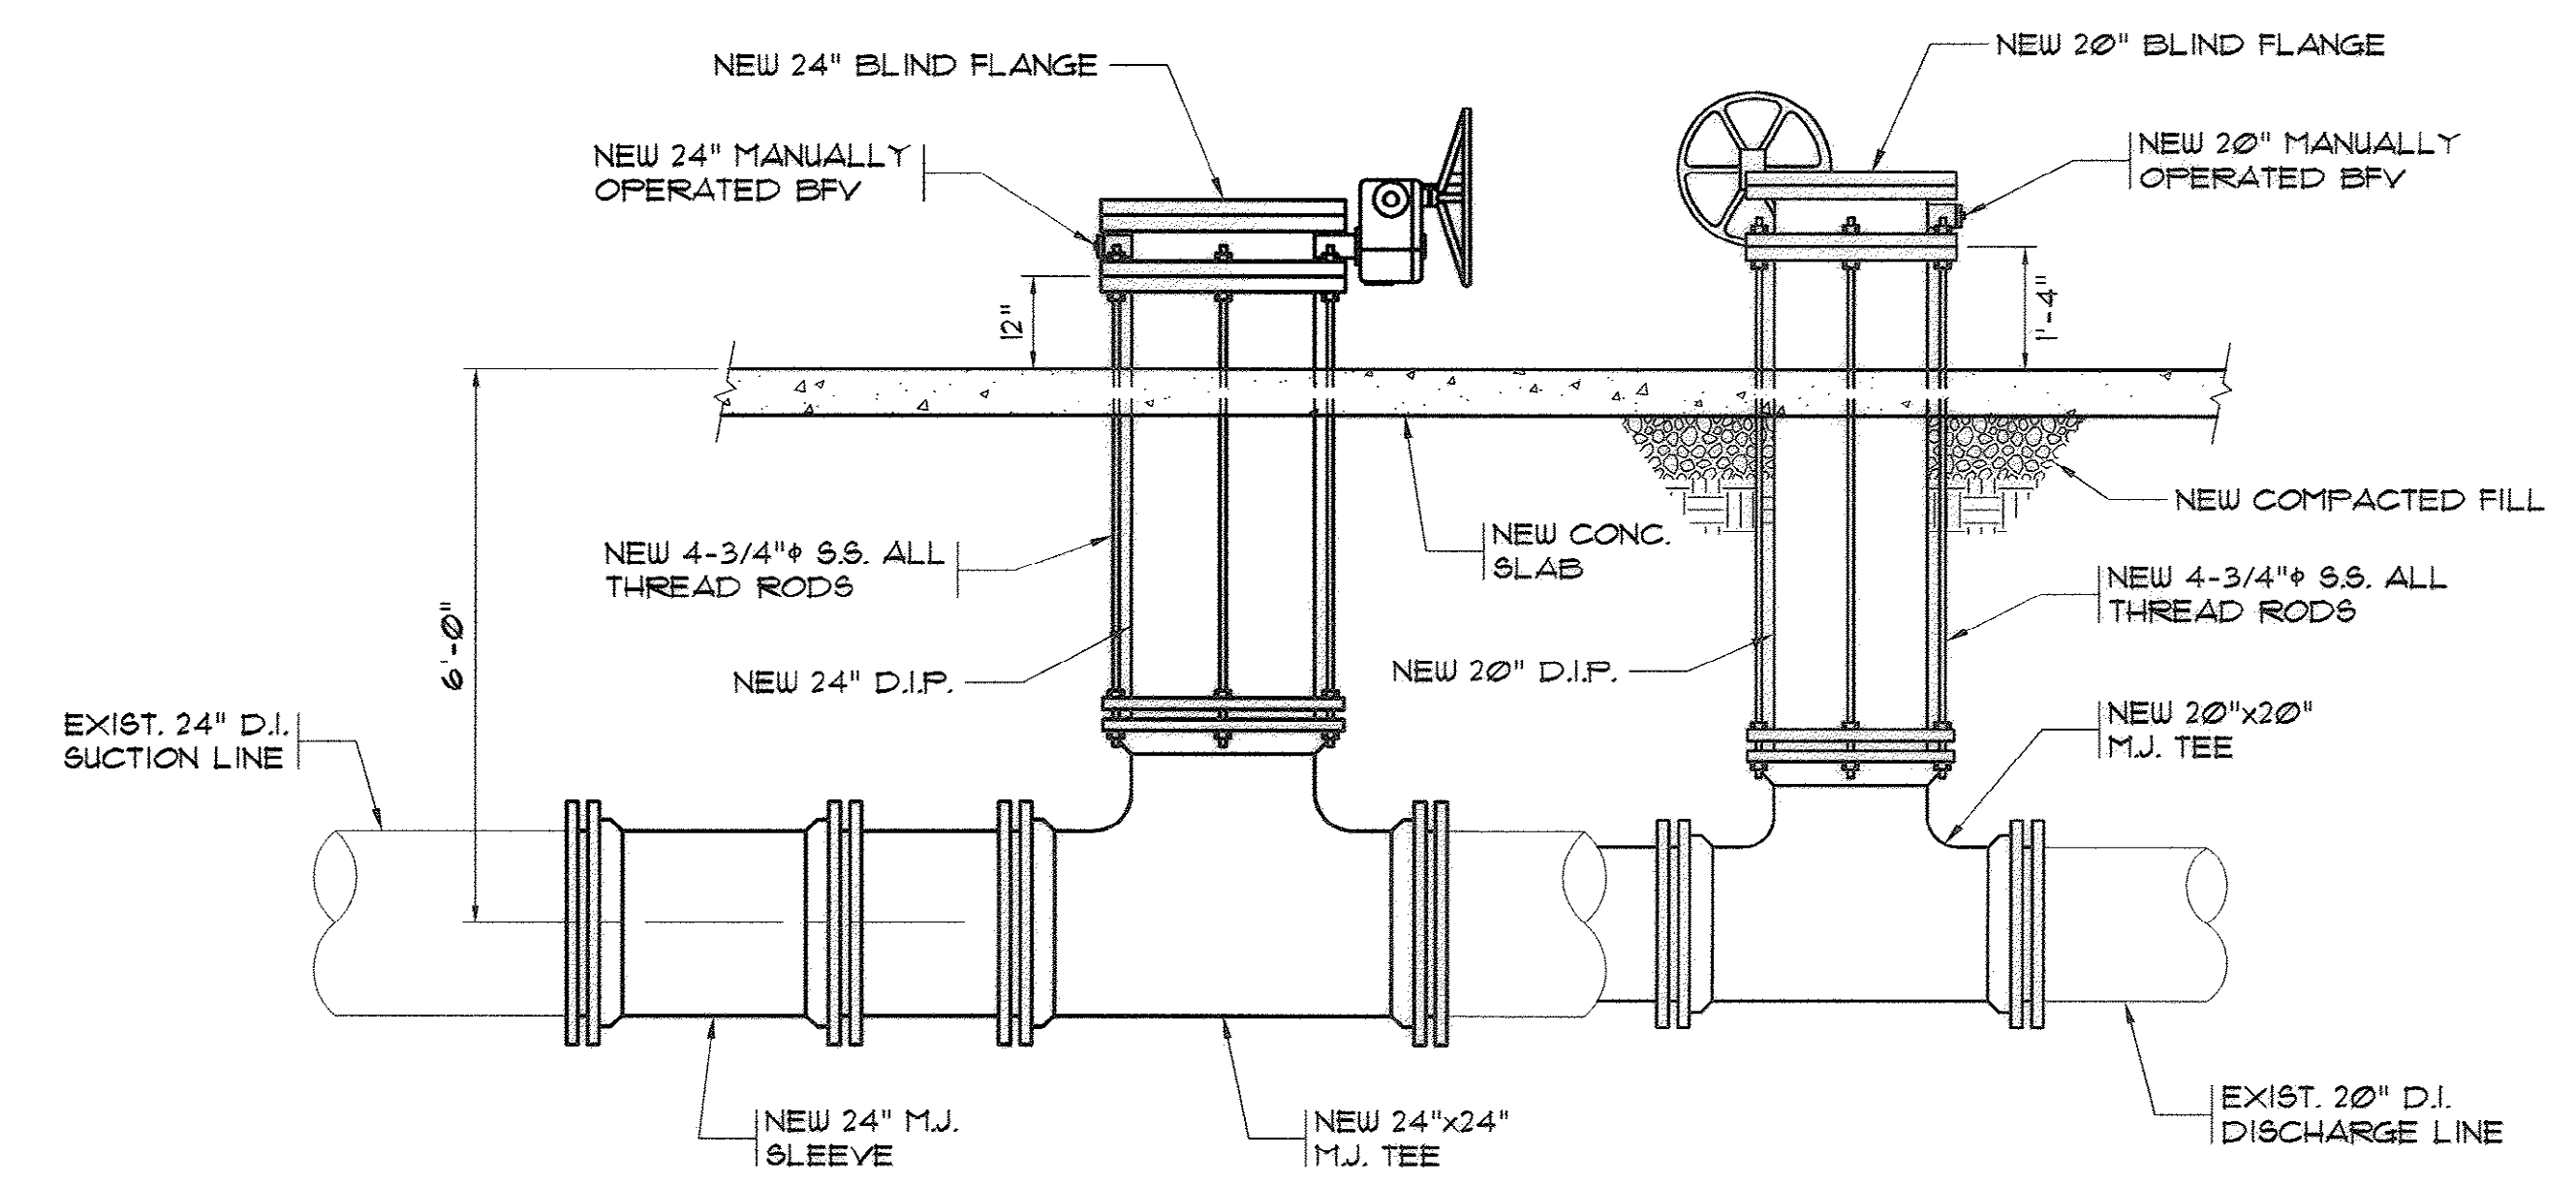


3 PIPE ELEVATION
SCALE: 1/2" = 1'-0"

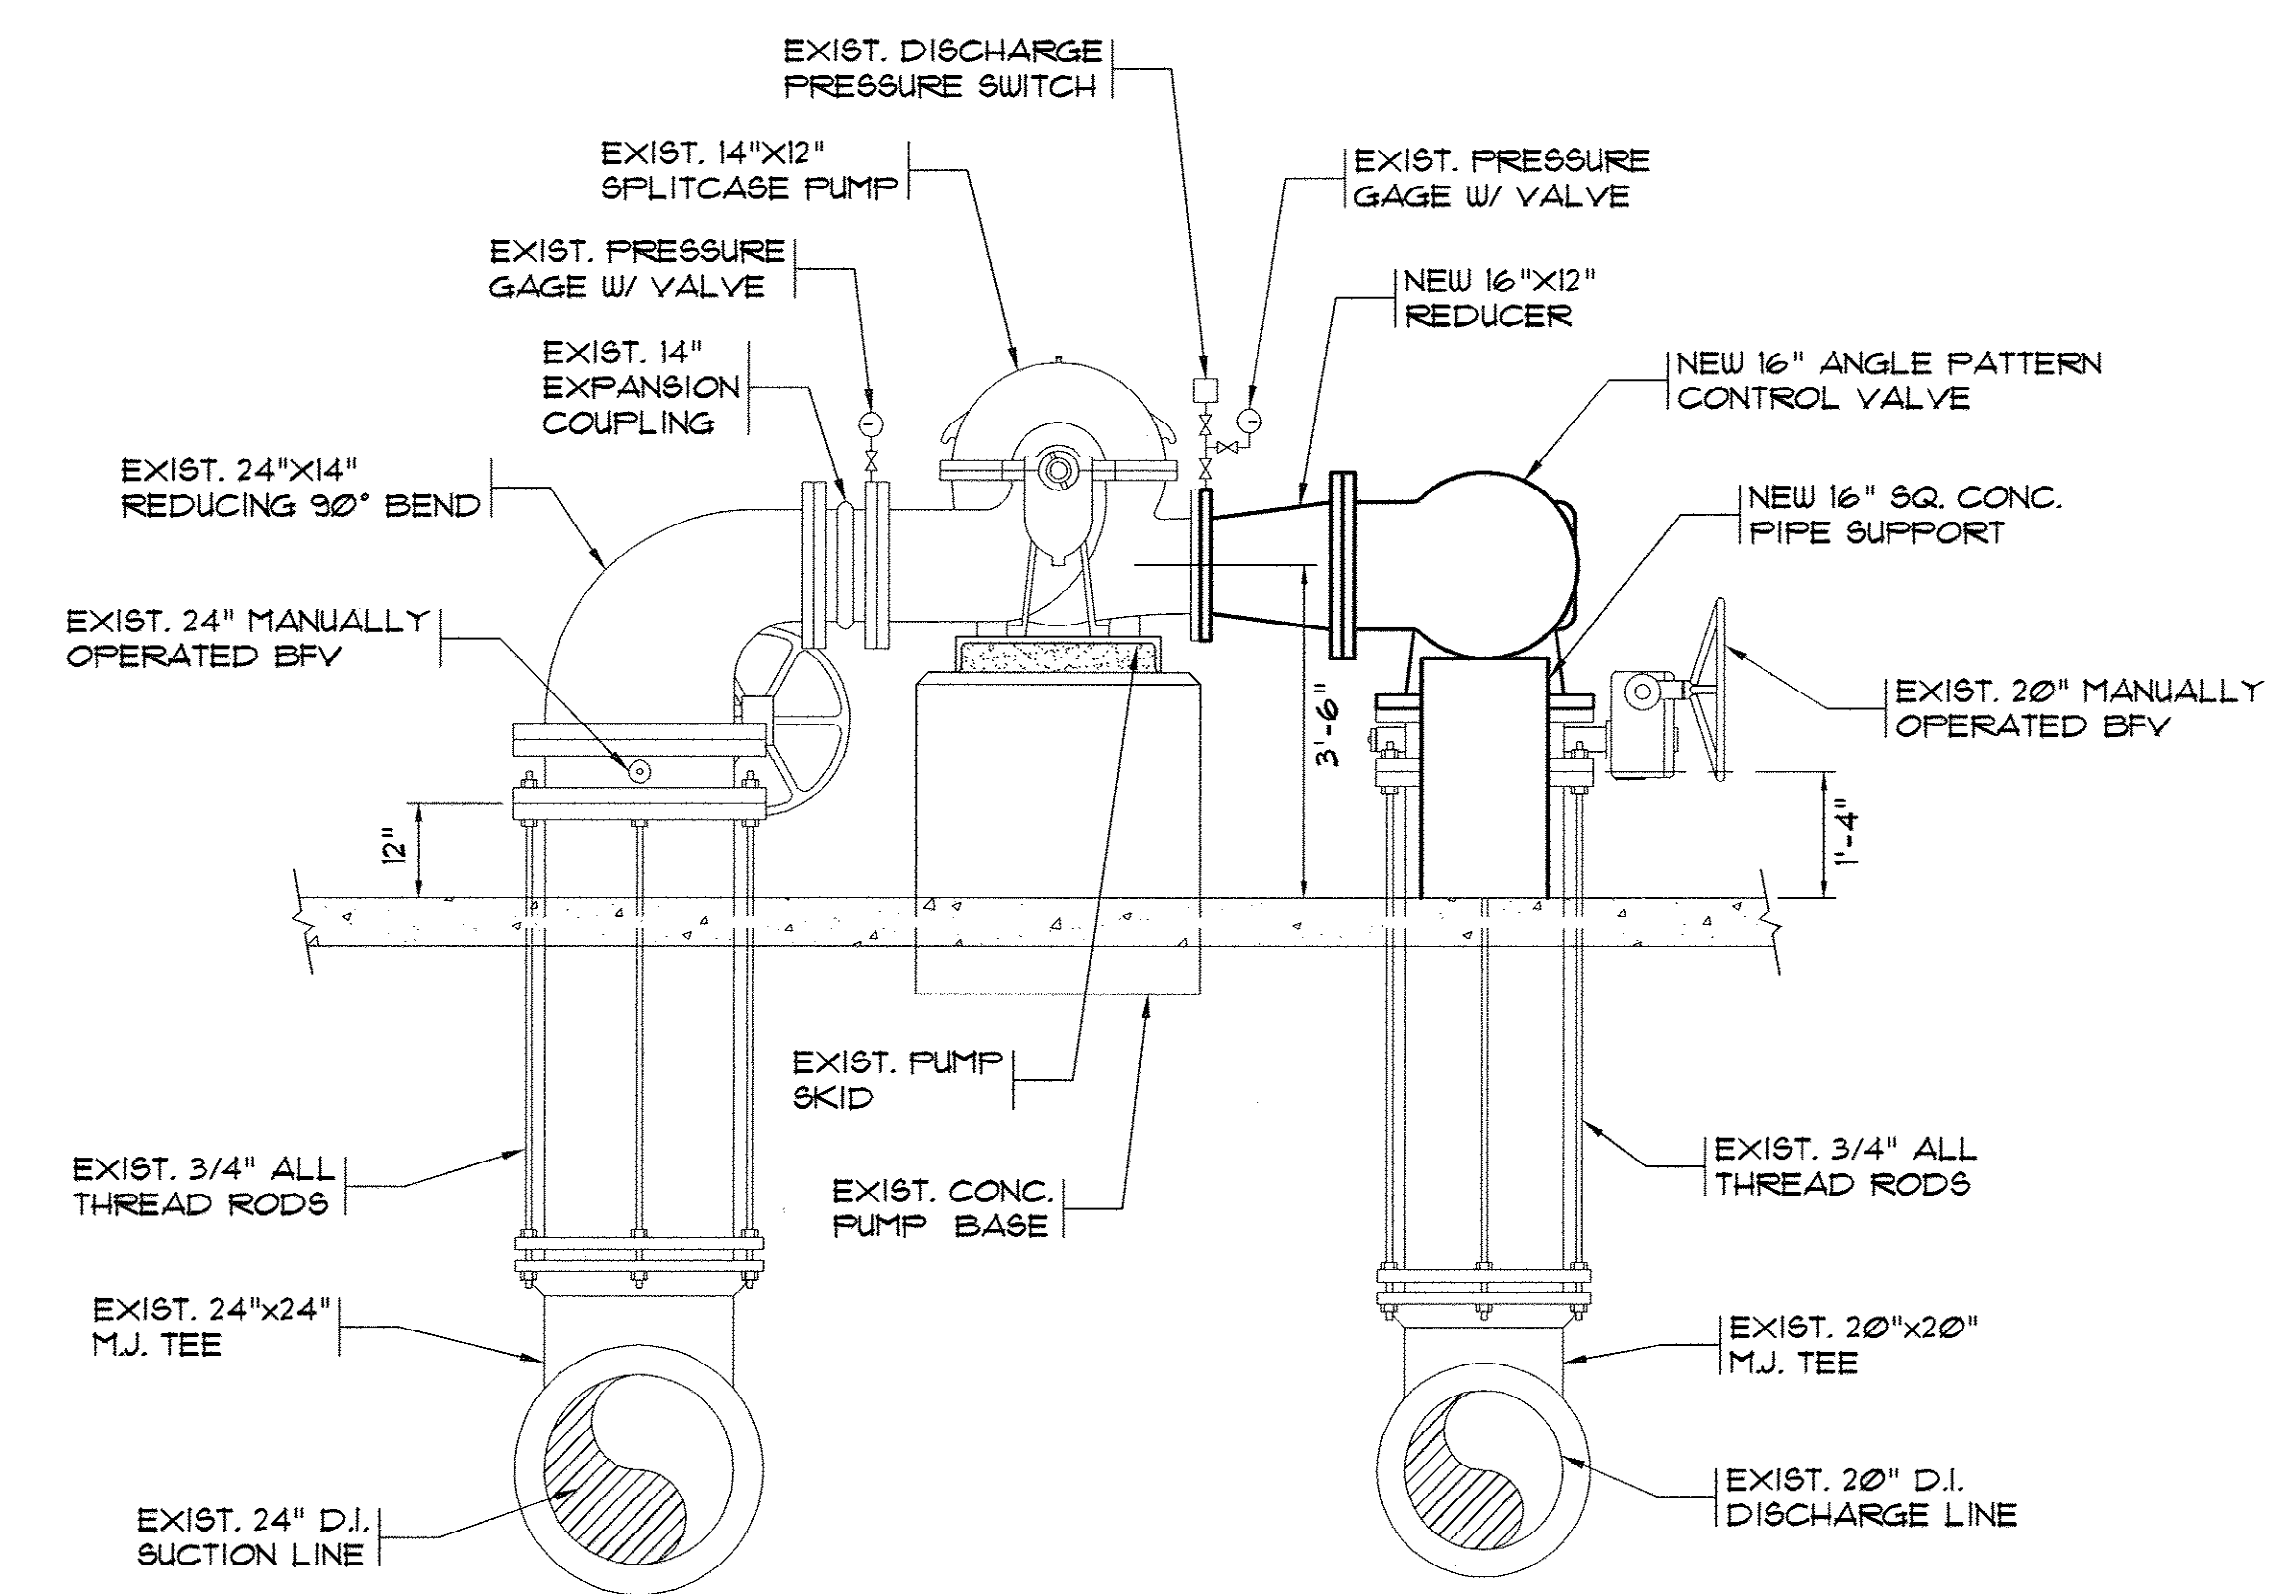



2 EXISTING PUMP ELEVATION MODIFICATION
SCALE: 1/2" = 1'-0"

NOTES:
1. ALL NEW PIPING TO BE INSTALLED WITH MEGA-LUG.

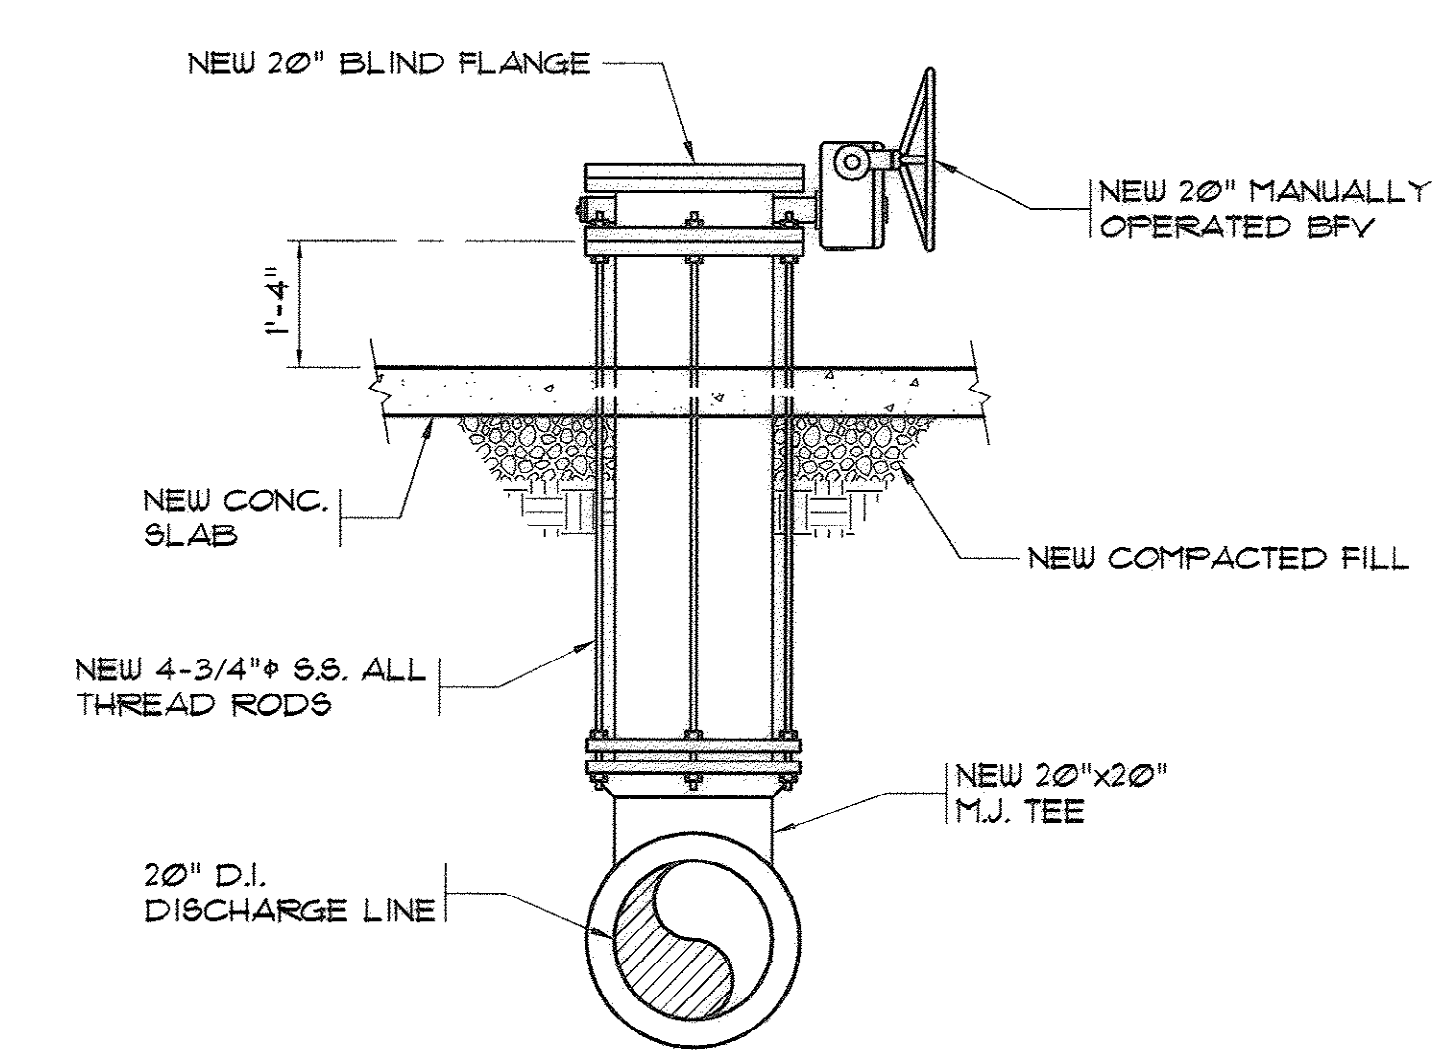

4 PIPE ELEVATION
SCALE: 1/2" = 1'-0"

REVISIONS			
SYM.	DESCRIPTION	DATE	BY

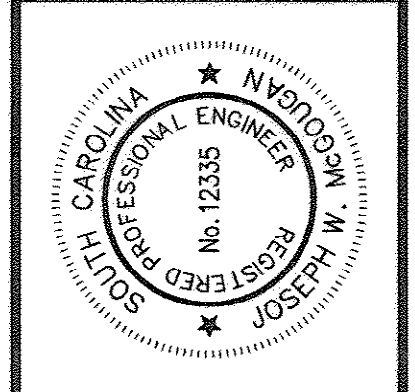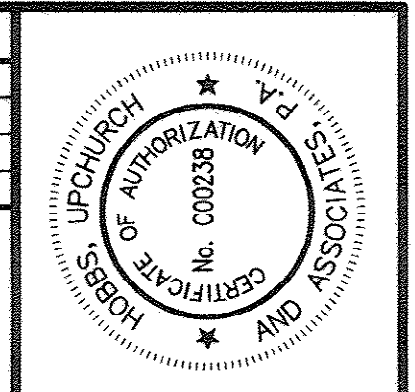

Hobbs, Upchurch & Associates, P.A.
Consulting Engineers
Myrtle Beach, South Carolina 29577
PHONE (843) 686-1910 FAX (843) 686-1748

EXISTING PUMP MODIFICATION ELEVATIONS & PIPING DETAILS

PERRY ROAD PUMP STATION GRAND STRAND WATER & SEWER AUTHORITY

DATE:	9-5-2008
DESIGNED:	JWM
DRAWN:	ALG
CHECKED:	JWM
SCALE:	AS SHOWN
SHEET NO.	12
OF:	15
VERSION:	4

AS-BUILT 9-5-08

12-250-012/36 W

SEEDBED PREPARATION

- 1. CHISEL COMPACTED AREAS AND SPREAD TOPSOIL 3 INCHES DEEP OVER ADVERSE SOIL CONDITIONS.
- 2. RIP THE ENTIRE AREA TO 6" DEPTH.
- 3. REMOVE ALL LOOSE ROCK, ROOTS AND OTHER OBSTRUCTIONS LEAVING SURFACE REASONABLY SMOOTH AND UNIFORM.
- 4. APPLY AGRICULTURAL LIME, FERTILIZER AND SUPER PHOSPHATE UNIFORMLY AND MIX WITH SOIL.
- 5. CONTINUE TILLAGE UNTIL A WELL-FULVERIZED, FIRM REASONABLY UNIFORM SEEDBED IS PREPARED 4 TO 6 INCHES DEEP.
- 6. COVER SEED LIGHTLY WITH SEEDING EQUIPMENT OR CULTIPACK AFTER SEEDING.
- 7. MULCH IMMEDIATELY AFTER SEEDING.
- 8. INSPECT ALL SEEDED AREAS AND MAKE NECESSARY REPAIRS OR RESEED WITHIN THE PLANTING SEASON. IF STAND SHOULD BE OVER 60% DAMAGED, REESTABLISH FOLLOWING ORIGINAL LIME, FERTILIZER AND SEEDING RATES.
- 9. FERTILIZER SHALL BE APPLIED AT THE RATE OF 1000 POUNDS PER ACRE.
- 10. LIME SHALL BE APPLIED AT THE RATE OF 3000 POUNDS PER ACRE.

II. PERMANENT VEGETATION.

A. SUMMER (MARCH 1 - AUGUST 14)	
COMMON BERMUDA (HULLED)	25 lbs./ACRE
GERMAN MILLET	10 lbs./ACRE
B. WINTER (AUGUST 15 - FEBRUARY 28)	
ANNUAL RYE	40 lbs./ACRE
COMMON BERMUDA (UNHULLED)	30 lbs./ACRE

12. RYE GRAIN AND MILLET SHALL BE ADDED IN ORDER TO ESTABLISH QUICK GROUND COVER FOR EROSION CONTROL PURPOSES.

13. TEMPORARY VEGETATION:

A. (APRIL 1 - AUGUST 15)	
ANNUAL SUDAN GRASS (SHEET OF TIF)	40 lbs./ACRE
BROWN TOP MILLET	50 lbs./ACRE
B. (AUGUST 15 - MARCH 1)	
RYE GRAIN	55 lbs./ACRE

14. OAT GRAIN IS TO BE ADDED IF SEEDING DATE IS BETWEEN MARCH 1 AND APRIL 10, AT THE RATE OF 10 POUNDS PER ACRE.

15. OTHER PLANTINGS OR SEEDING AS CONTAINED IN THE CRITICAL AREA STABILIZATION SECTION OF SCS HANDBOOK "EROSION AND SEDIMENT CONTROL IN DEVELOPING AREAS" MAY BE USED PROVIDED THE WORK COMPLIES WITH ALL APPLICABLE SPECIFICATIONS CONTAINED IN SCS HANDBOOK.


16. CONSULT CONSERVATION INSPECTOR ON MAINTENANCE AND FERTILIZATION AFTER PERMANENT COVER IS ESTABLISHED

EROSION CONTROL SEQUENCE OF CONSTRUCTION


- 1. CLEARING AND GRUBBING THOSE AREAS NECESSARY FOR INSTALLATION OF PERIMETER CONTROLS.
- 2. INSTALLATION OF SEDIMENT BASINS AND TRAPS.
- 3. CONSTRUCTION OF PERIMETER CONTROLS.
- 4. REMAINING CLEARING AND GRUBBING.
- 5. ROAD GRADING.
- 6. GRADING FOR THE REMAINDER OF THE SITE.
- 7. CONSTRUCTION, PROTECT STORM DRAINS UNTIL AFTER COMPLETION OF CONSTRUCTION.
- 8. FINAL GRADING, LANDSCAPING AND STABILIZATION.
- 9. REMOVABLE OF SEDIMENT MEASURES.

SOIL EROSION CONTROL NOTES


- 1. ALL SEDIMENT CONTROL MEASURES SHALL BE INSPECTED ONCE EVERY SEVEN CALENDAR DAYS AFTER ANY STORM EVENT OF GRATER THAN 0.5 INCHES OF PRECIPITATION DURING AND 24-HOURS PERIOD. ALL SEDIMENTS CONTROL FEATURES SHALL BE MAINTAINED UNTIL FINAL STABILIZATION HAS BEEN OBTAINED.
- 2. STABILIZATION MEASURES SHALL BE INITIATED AS SOON AS PRACTICABLE IN PORTIONS OF THE SITE WHERE CONSTRUCTION ACTIVITIES HAVE TEMPORARY OR PERMANENTLY CEASED. BUT IN NO CASE MORE THAN 14 DAYS AFTER THE CONSTRUCTION ACTIVITY IN THAT PORTION OF THE SITE TEMPORARY OR PERMANENTLY CEASED. UNLESS ACTIVITY IN THE PORTION OF THE SITE WILL RESUME WITHIN 21 DAYS.
- 3. PROVIDE SILT FENCE AND/OR OTHER DEVICES, AS MAY BE REQUIRED TO CONTROL SOIL EROSION DURING UTILITY CONSTRUCTION. ALL DISTURBED AREAS SHALL BE CLEANED, GRADED AND STABILIZED WITH GRASSING IMMEDIATELY AFTER THE CONSTRUCTION ACTIVITY.
- 4. ALL EROSION CONTROL DEVICES SHALL BE PROPERLY MAINTAINED DURING ALL PHASES OF CONSTRUCTION UNTIL THE COMPLETION OF ALL CONSTRUCTION ACTIVITIES AND ALL DISTURBED AREAS HAVE BEEN STABILIZED. ADDITIONAL CONTROL DEVICES MAY BE REQUIRED DURING CONSTRUCTION IN ORDER TO CONTROL EROSION AND/OR OFF SITE SEDIMENTATION. ALL TEMPORARY CONTROL DEVICES SHALL BE REMOVED ONCE CONSTRUCTION IS COMPLETE AND THE SITE IS STABILIZED.
- 5. TEMPORARY DIVERSION BERMS AND/OR DITCHES WILL BE PROVIDED AS NEEDED DURING CONSTRUCTION TO PROTECT WORK AREAS FROM UPSLOPE RUNOFF AND/OR TO DIVERT SEDIMENT LADEN WATER TO APPROPRIATE TRAPS OR STABLE OUTLETS.
- 6. IF NECESSARY, SLOPES WHICH EXCEED EIGHT (8) VERTICAL FEET SHOULD BE STABILIZED WITH SYNTHETIC OR VEGETATIVE MATS. IN ADDITION TO HYDROSEEDING, IT MAY BE NECESSARY TO INSTALL TEMPORARY SLOPE DRAINS DURING CONSTRUCTION. TEMPORARY BERMS MAY BE NEEDED UNTIL SLOPE IS BROUGHT TO GRADE.
- 7. COMPLY WITH ALL REQUIREMENTS OF SPECIFICATIONS.

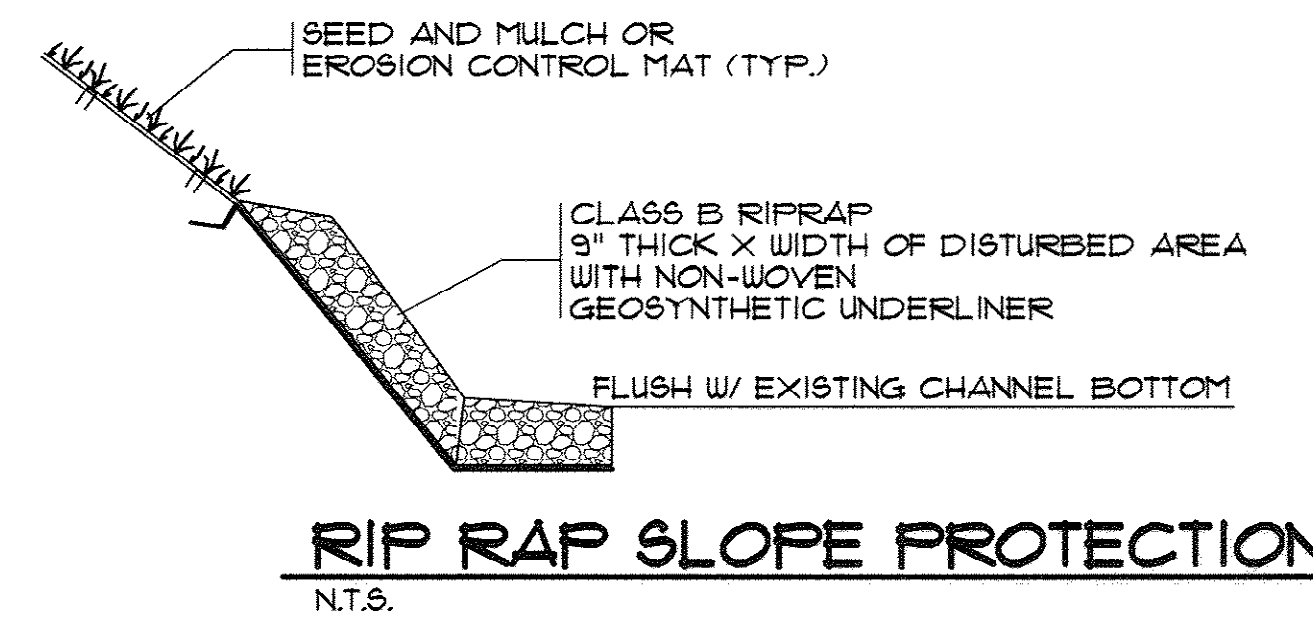

RIP RAP SLOPE PROTECTION

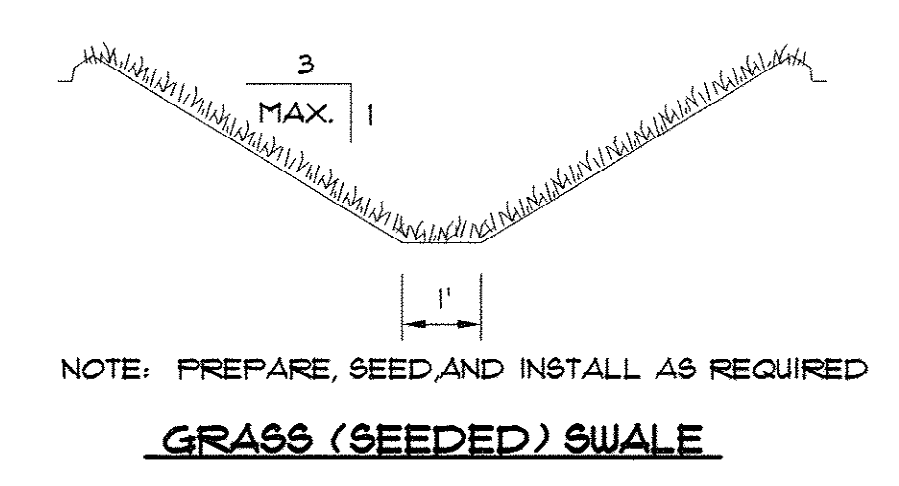

GRASS (SEEDED) SWALE

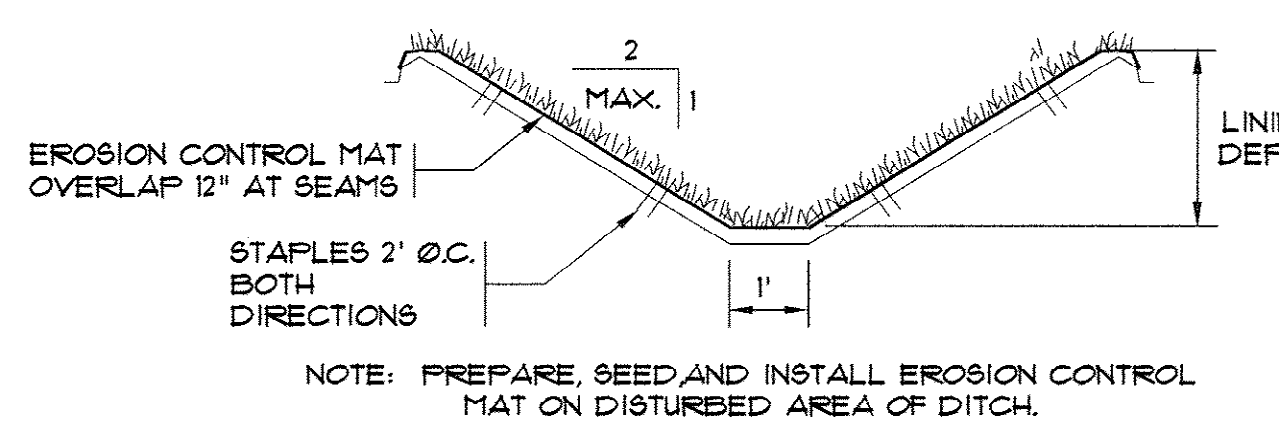


EROSION CONTROL MAT SWALE

- A.) BURY THE TOP OF THE MAT IN A TRENCH 6" OR MORE IN DEPTH.
- B.) TAMP THE TRENCH FULL OF SOIL. SECURE WITH STAPLES EVERY 12" ACROSS THE TOP AND EVERY 3' AROUND THE EDGES AND BOTTOM.
- C.) OVERLAP BURY UPPER END OF LOWER STRIP AS IN 'A' AND 'B'. OVERLAP END OF TOP STRIP 18" AND STAPLE EVERY 12" JUST BELOW THE ANCHOR SLOT.
- D.) EROSION STOP FOLD OF MAT BURIED IN SLIT TRENCH AND TAMPED. DOUBLE ROW OF STAPLES.


MAINTENANCE

INSPECT ALL MULCHES PERIODICALLY, AND AFTER RAINSTORMS TO CHECK FOR RILL EROSION DISLOCATION, OR FAILURE. WHERE EROSION IS OBSERVED, APPLY ADDITIONAL MULCH. IF WASHOUT OCCURS, REPAIR THE SLOPE GRADE, RESEED, AND REINSTALL MULCH. CONTINUE INSPECTIONS UNTIL VEGETATION IS FIRMLY ESTABLISHED.


DETAILS FOR STABILIZING SWALES

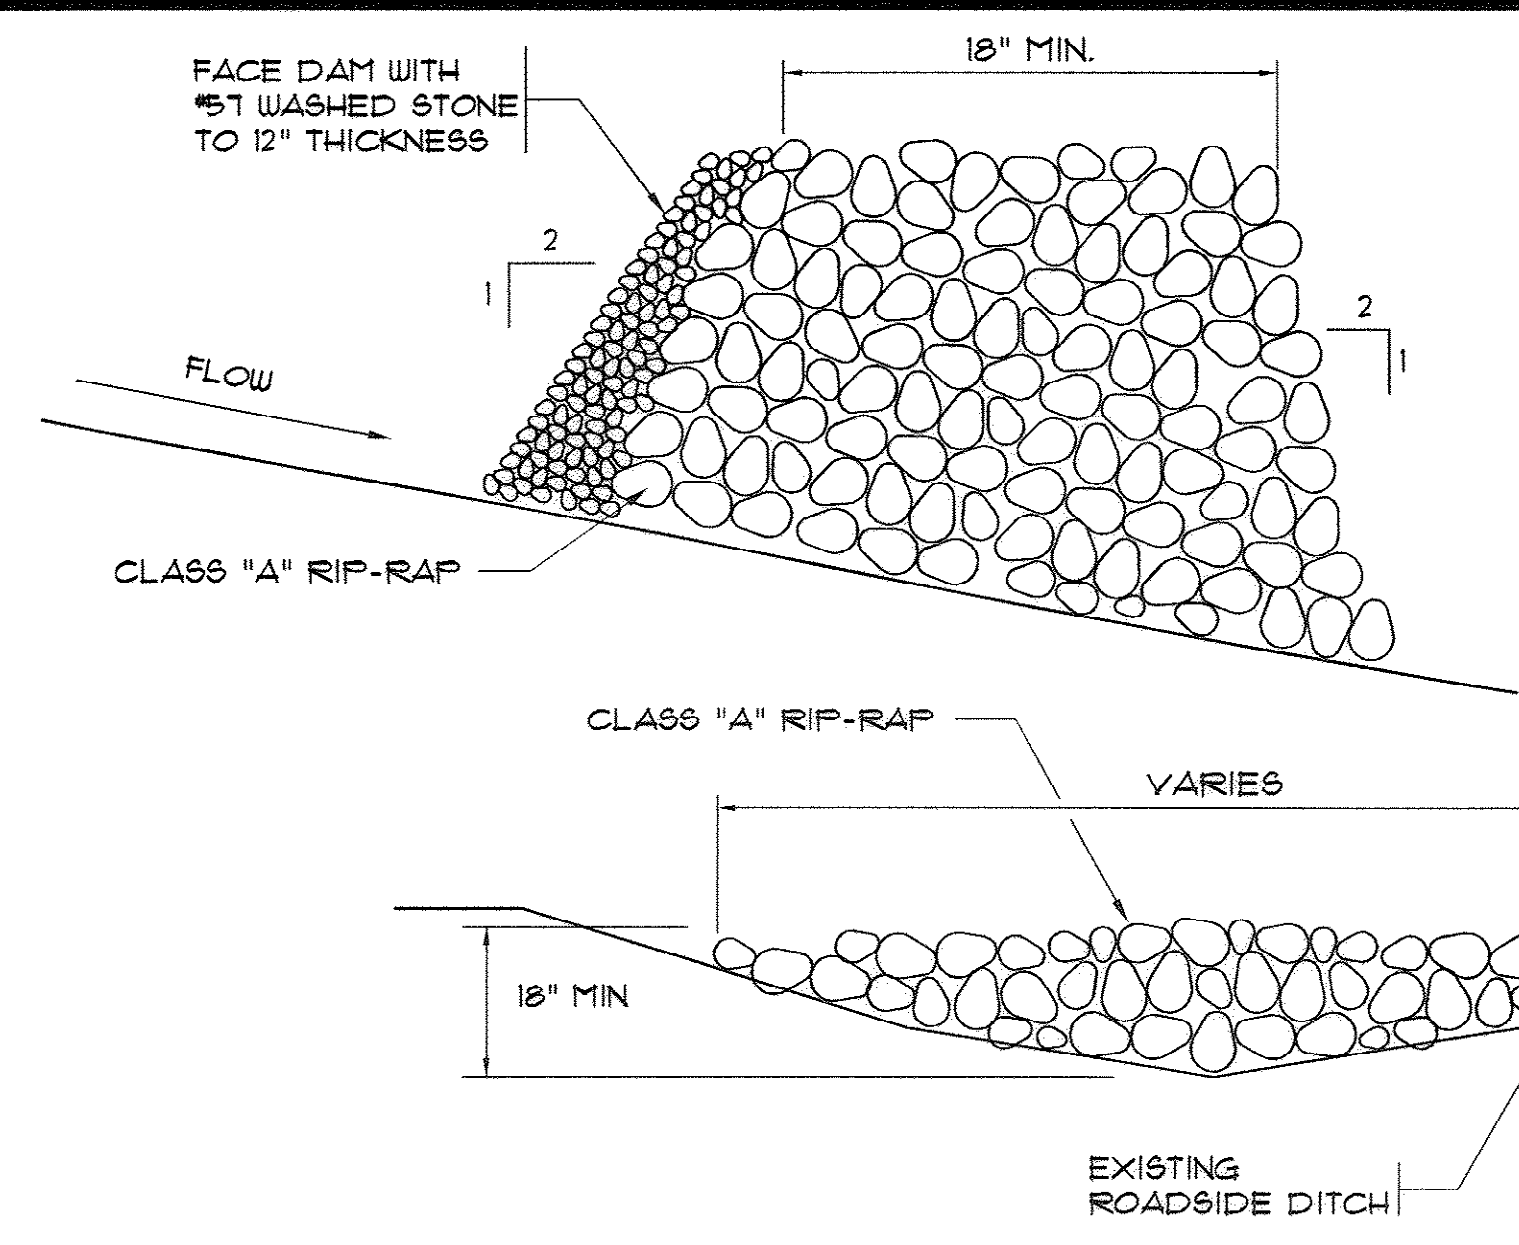


RIP RAP CHECK DAM DETAIL

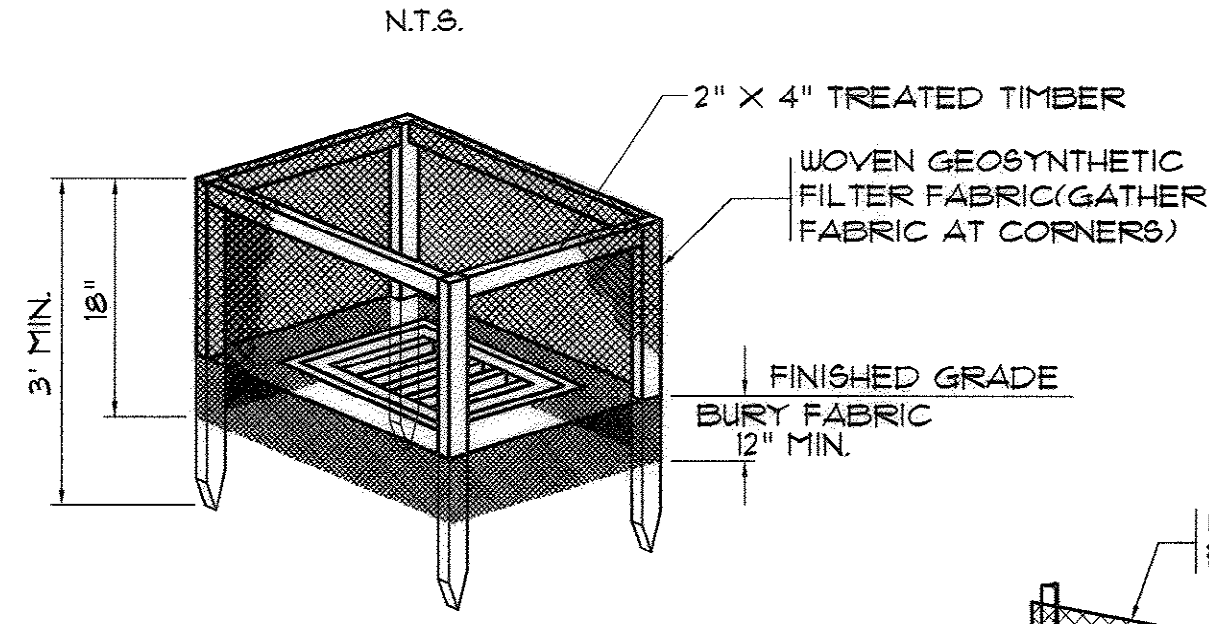

TEMPORARY INLET PROTECTION DETAIL

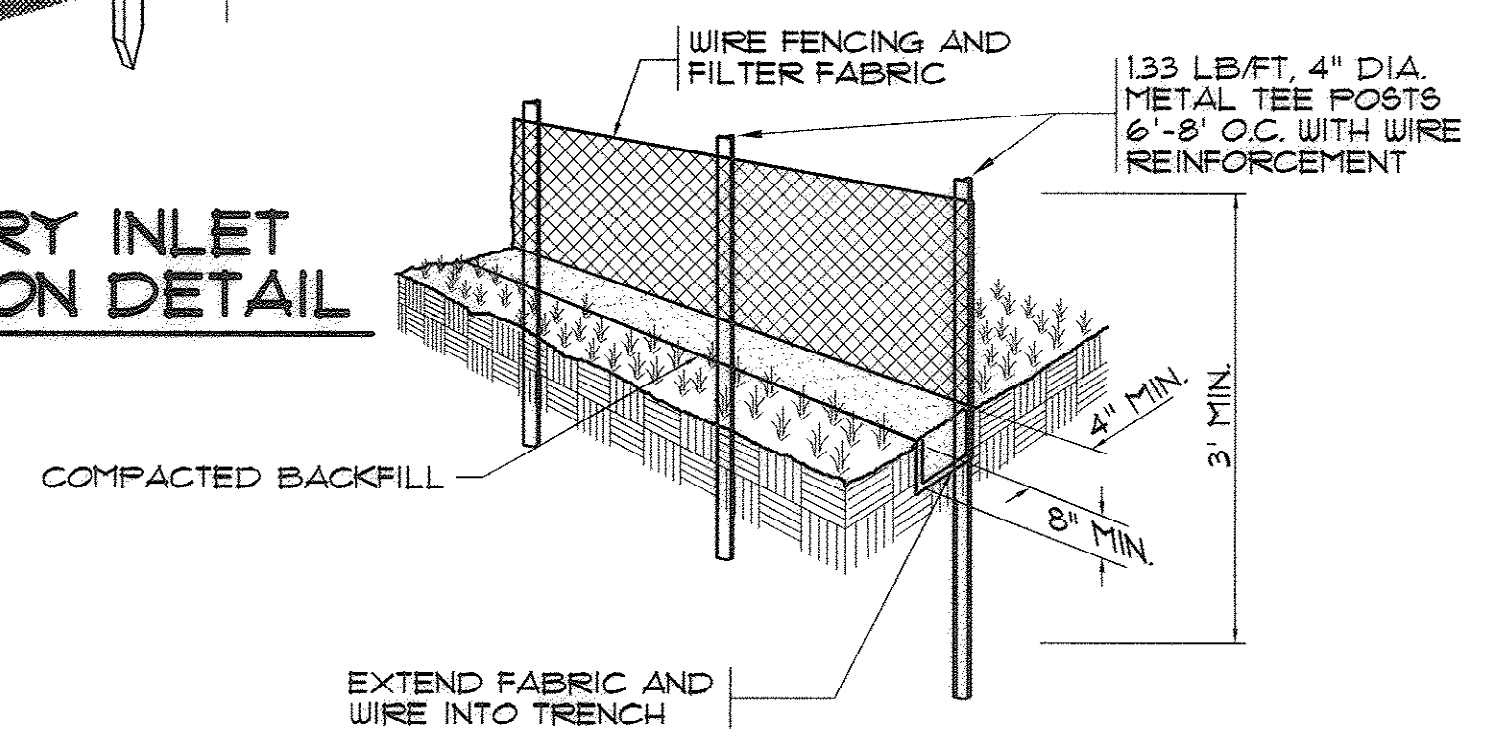

SILT FENCE DETAIL


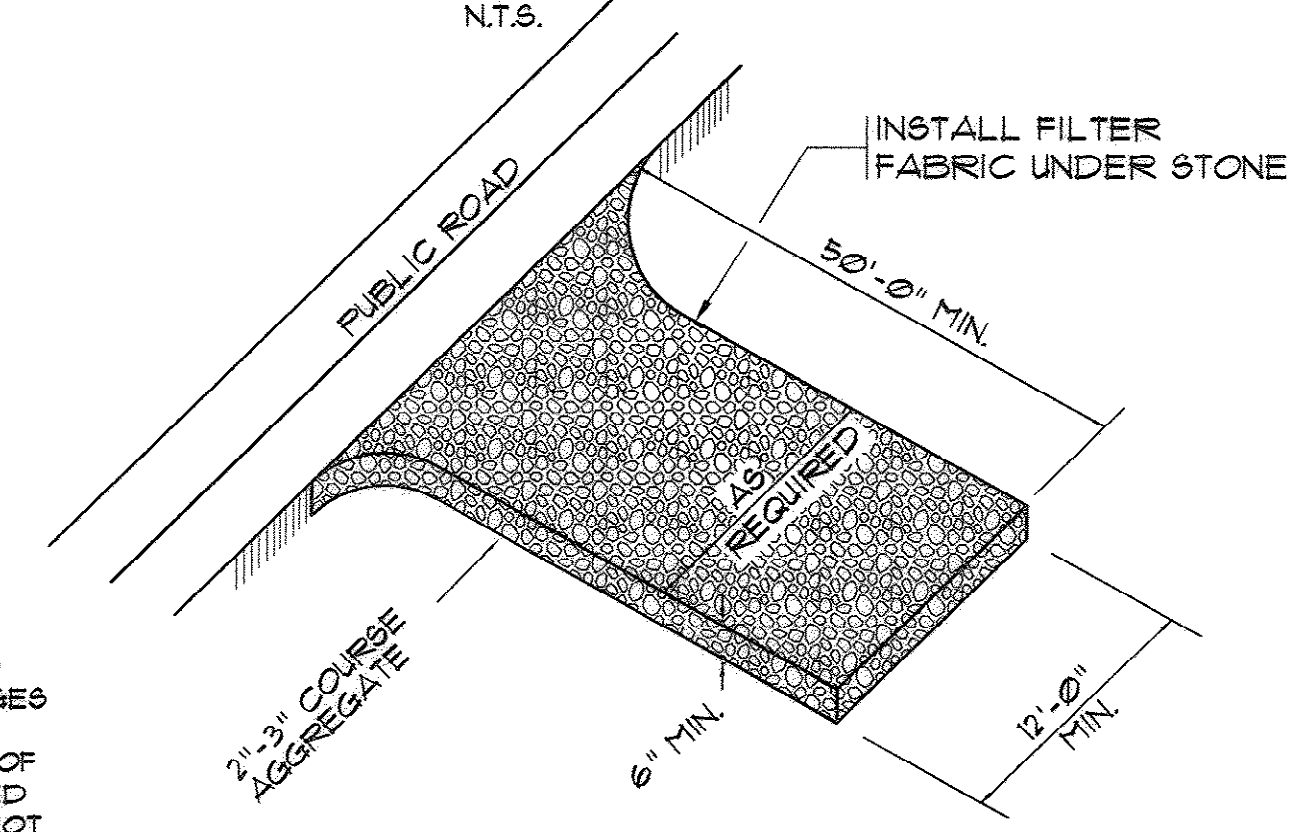


TEMPORARY GRAVEL CONSTRUCTION ENTRANCE

REVISIONS

SYM.	DESCRIPTION	DATE	BY

- NOTES:
- 1.) CHECK DAMS SHALL BE REQUIRED ONLY IF TEMPORARY DITCH LINERS DO NOT CONTROL EROSION OR AS DIRECTED BY THE ENGINEER.
 - 2.) CONTRACTOR SHALL REMOVE SEDIMENT ACCUMULATED BEHIND THE DAM TO PREVENT DAMAGE TO CHANNEL VEGETATION.
 - 3.) CONTRACTOR SHALL REMOVE ROCK CHECK DAMS AFTER PERMANENT VEGETATION HAS BEEN ESTABLISHED.

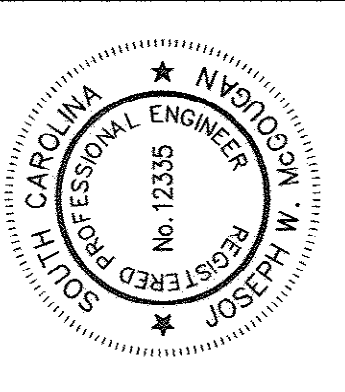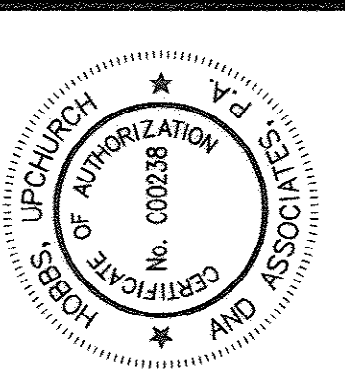

Hobbs, Upchurch & Associates, P.A.
Consulting Engineers
Myrtle Beach, South Carolina 29577
PHONE (843) 688-1910 FAX (843) 688-7468



EROSION CONTROL DETAILS



PERRY ROAD
PUMP STATION
GRAND STRAND WATER & SEWER AUTHORITY

DATE:	9-5-2008
DESIGNED:	JWM
DRAWN:	ALC
CHECKED:	JWM
SCALE:	AS SHOWN
SHEET NO.	13
OF:	15
VERSION:	4

AS-BUILT 9-5-08

12-250-013/36 2

REVISIONS			
SYM.	DESCRIPTION	DATE	BY

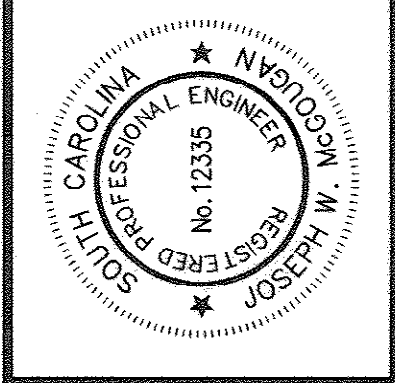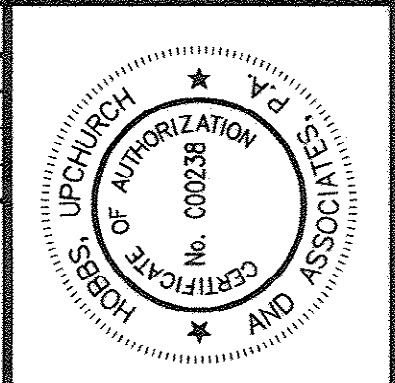


Hobbs, Upchurch & Associates, P.A.
 Consulting Engineers
 Myrtle Beach, South Carolina 29577
 PHONE (843) 666-1910 FAX (843) 666-1945


MISCELLANEOUS DETAILS

**PERRY ROAD
 PUMP STATION
 GRAND STRAND WATER &
 SEWER AUTHORITY**


DATE:	9-5-2008
DESIGNED:	JWM
DRAWN:	ALG
CHECKED:	JWM
SCALE:	AS SHOWN
SHEET NO.	14
OF:	15
VERSION:	4

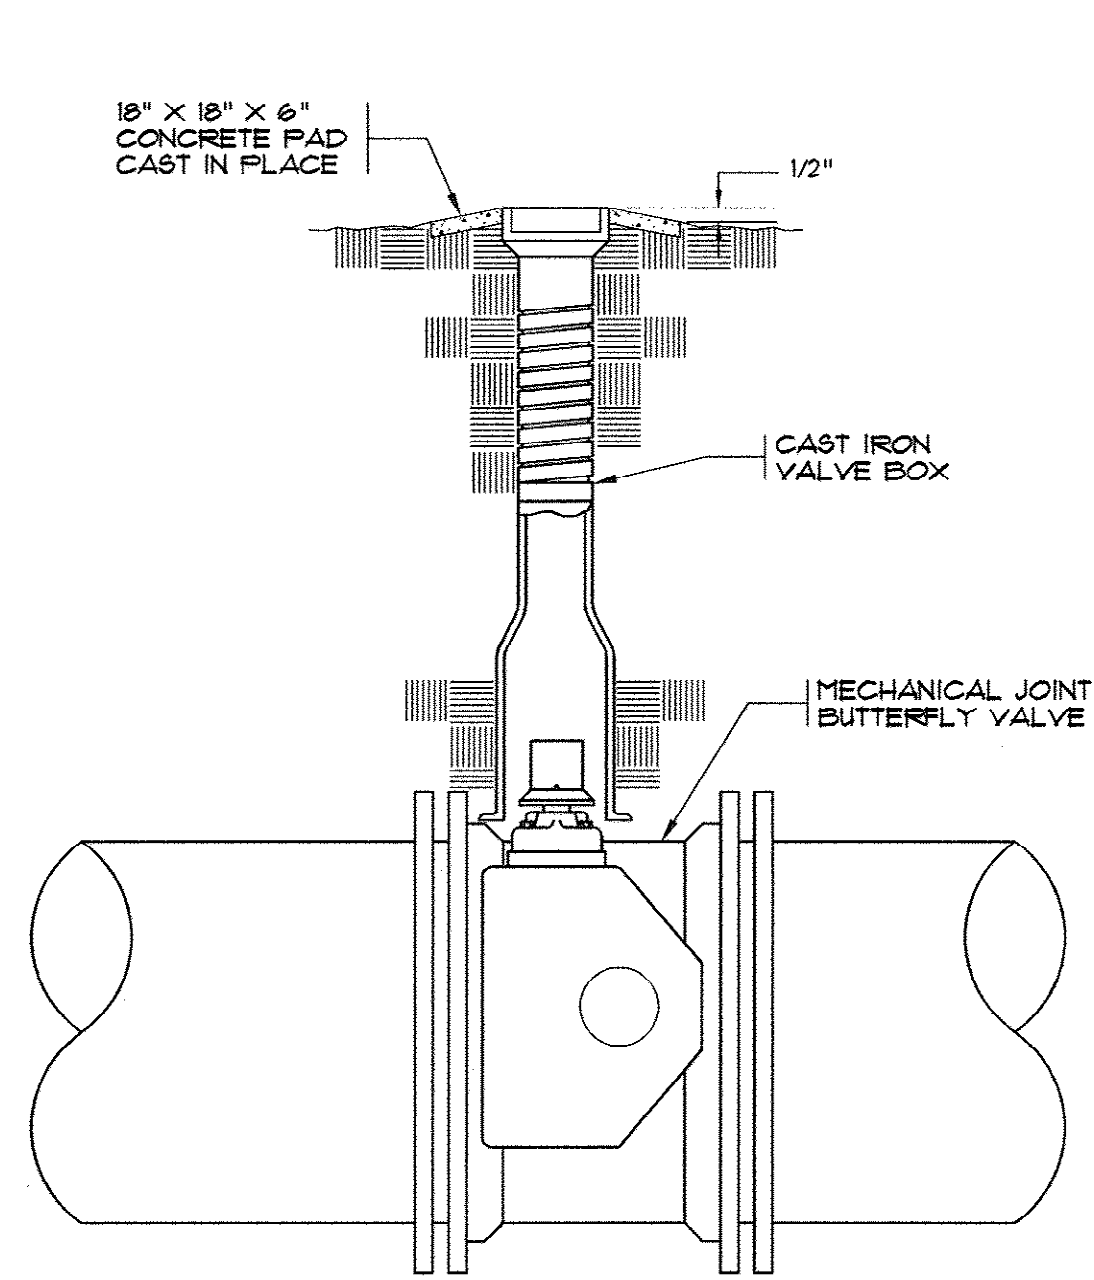


BUTTERFLY VALVE ASSEMBLY
 N.T.S.

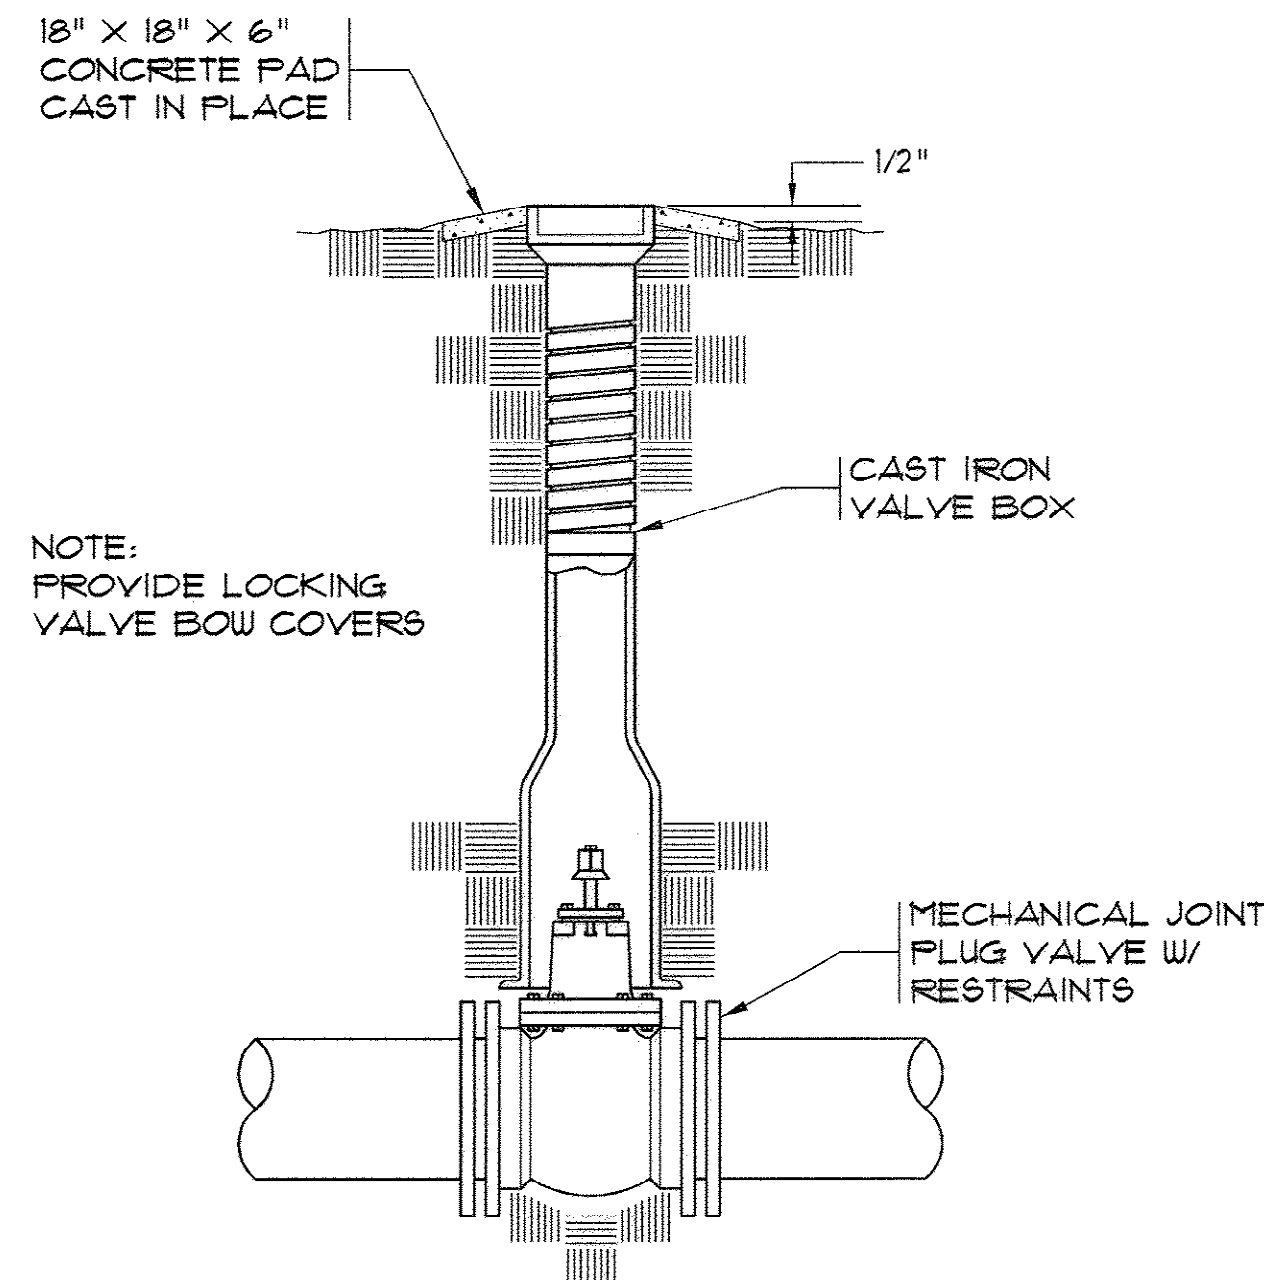


PLUG VALVE ASSEMBLY
 N.T.S.

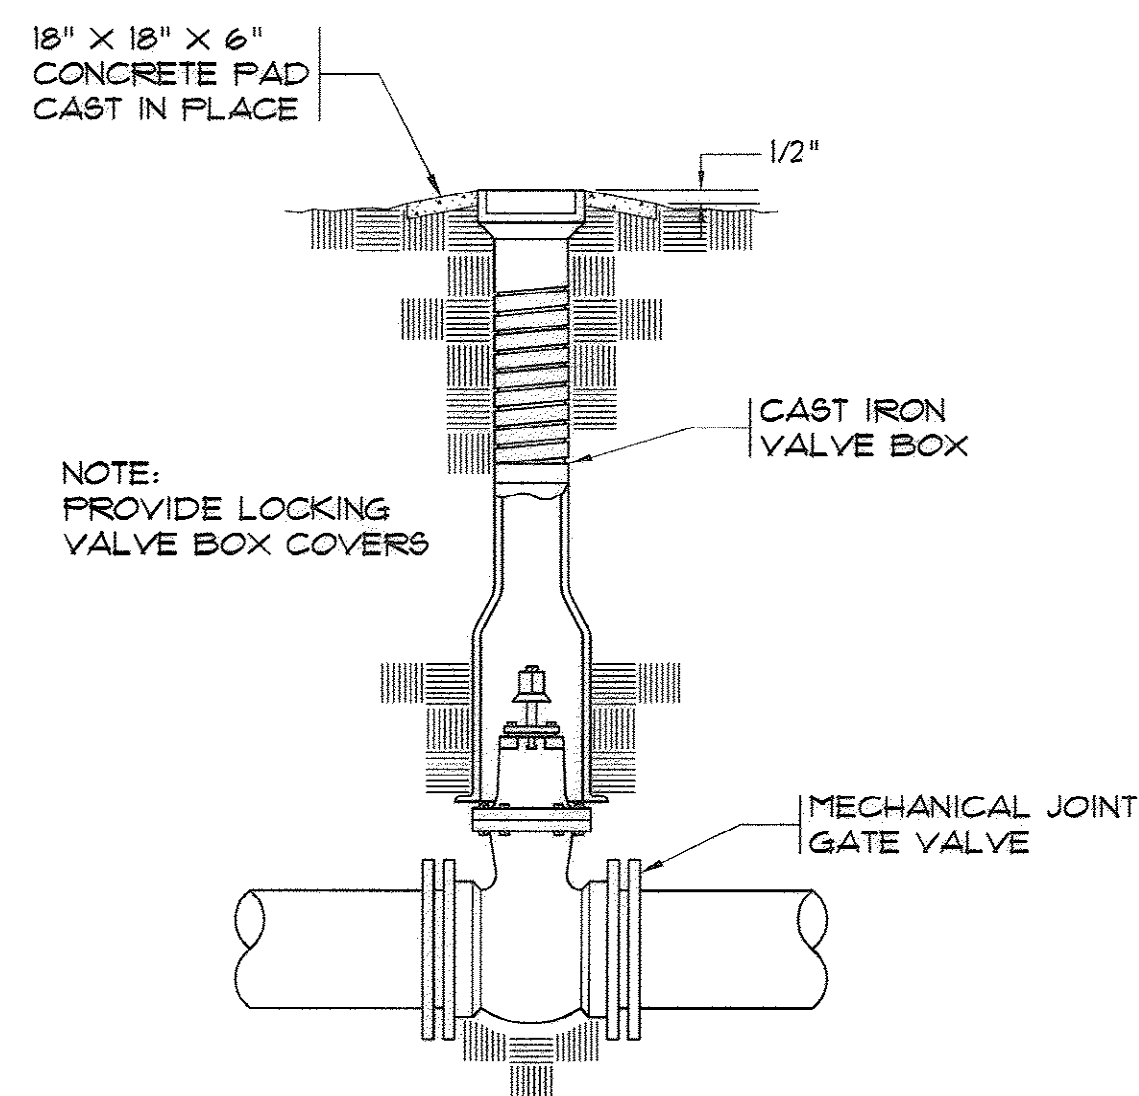

GATE VALVE ASSEMBLY
 N.T.S.

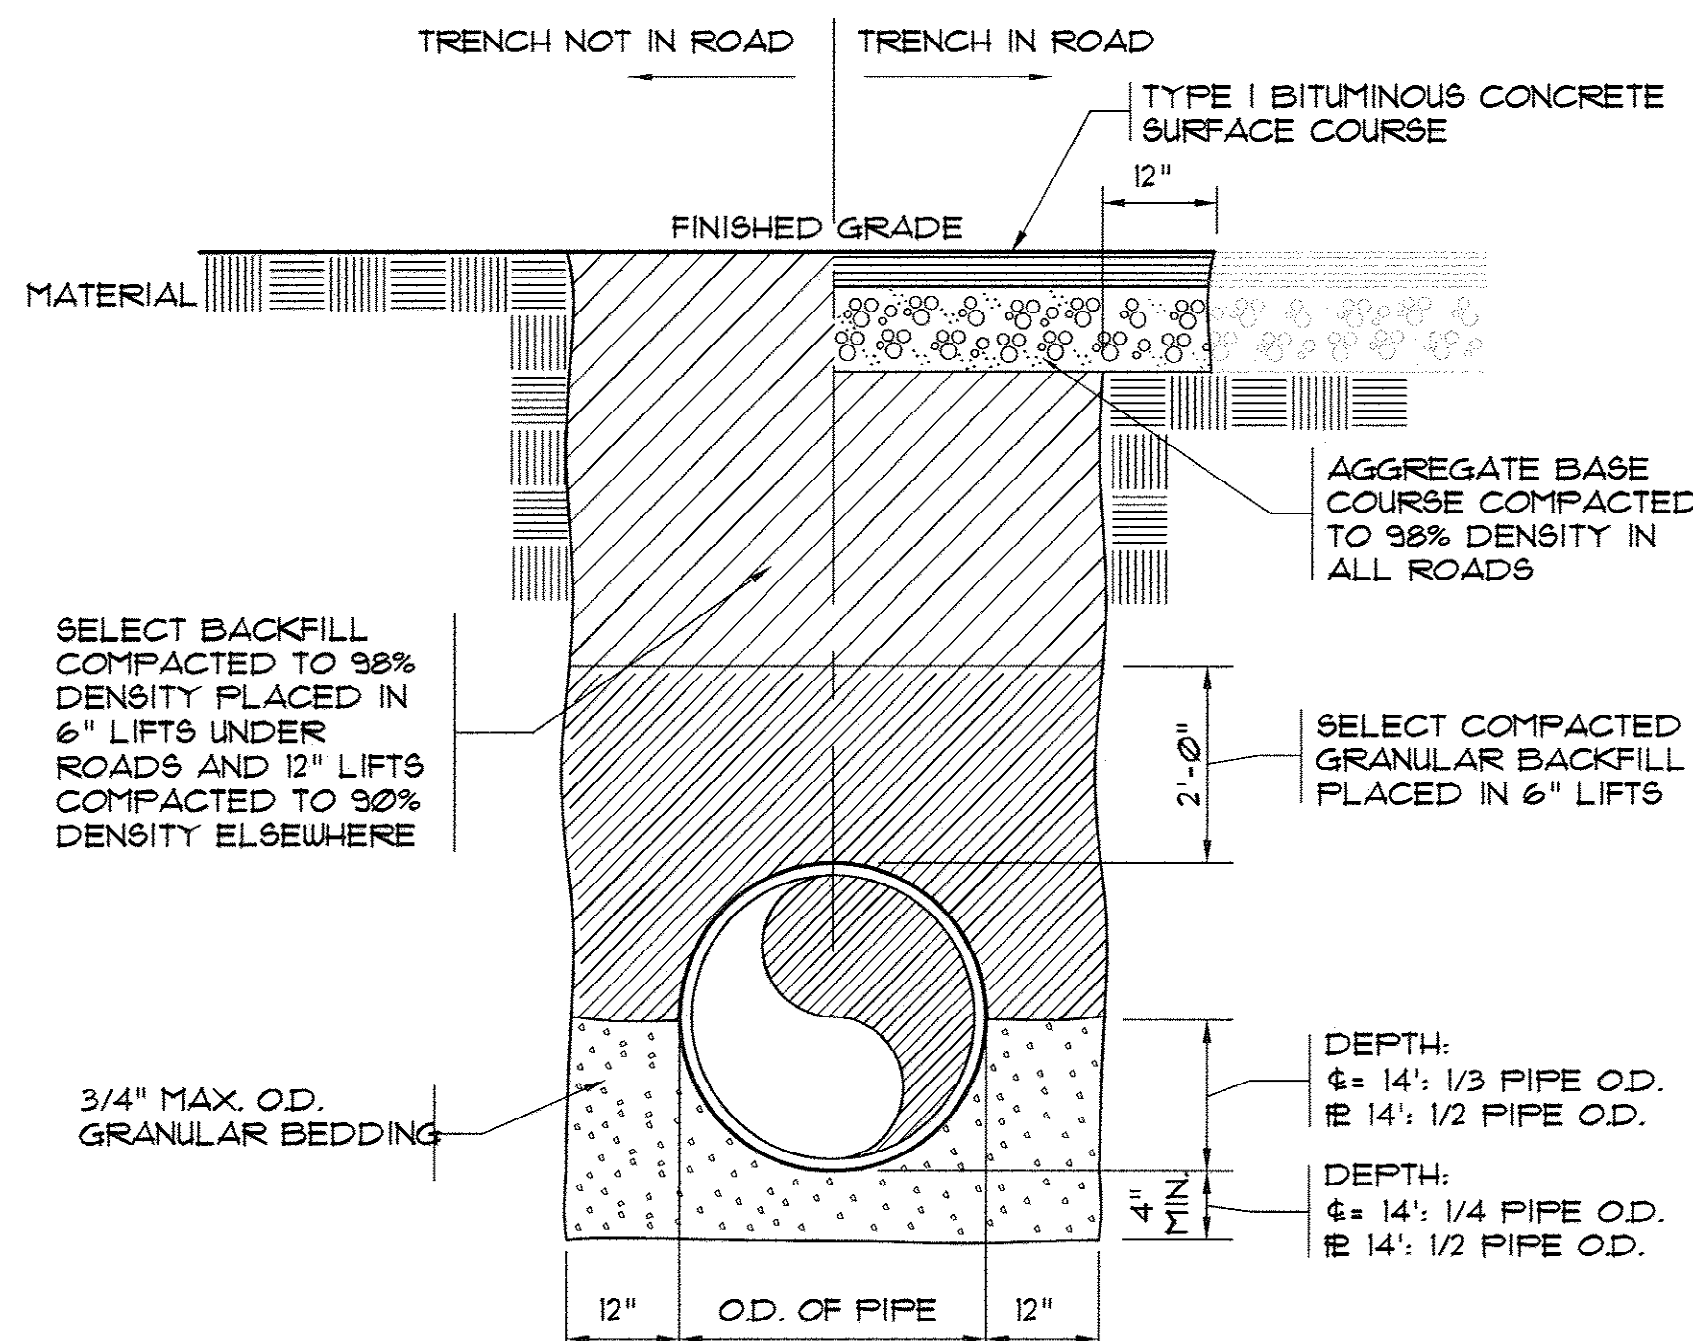

PIPE BEDDING DETAIL
 N.T.S.


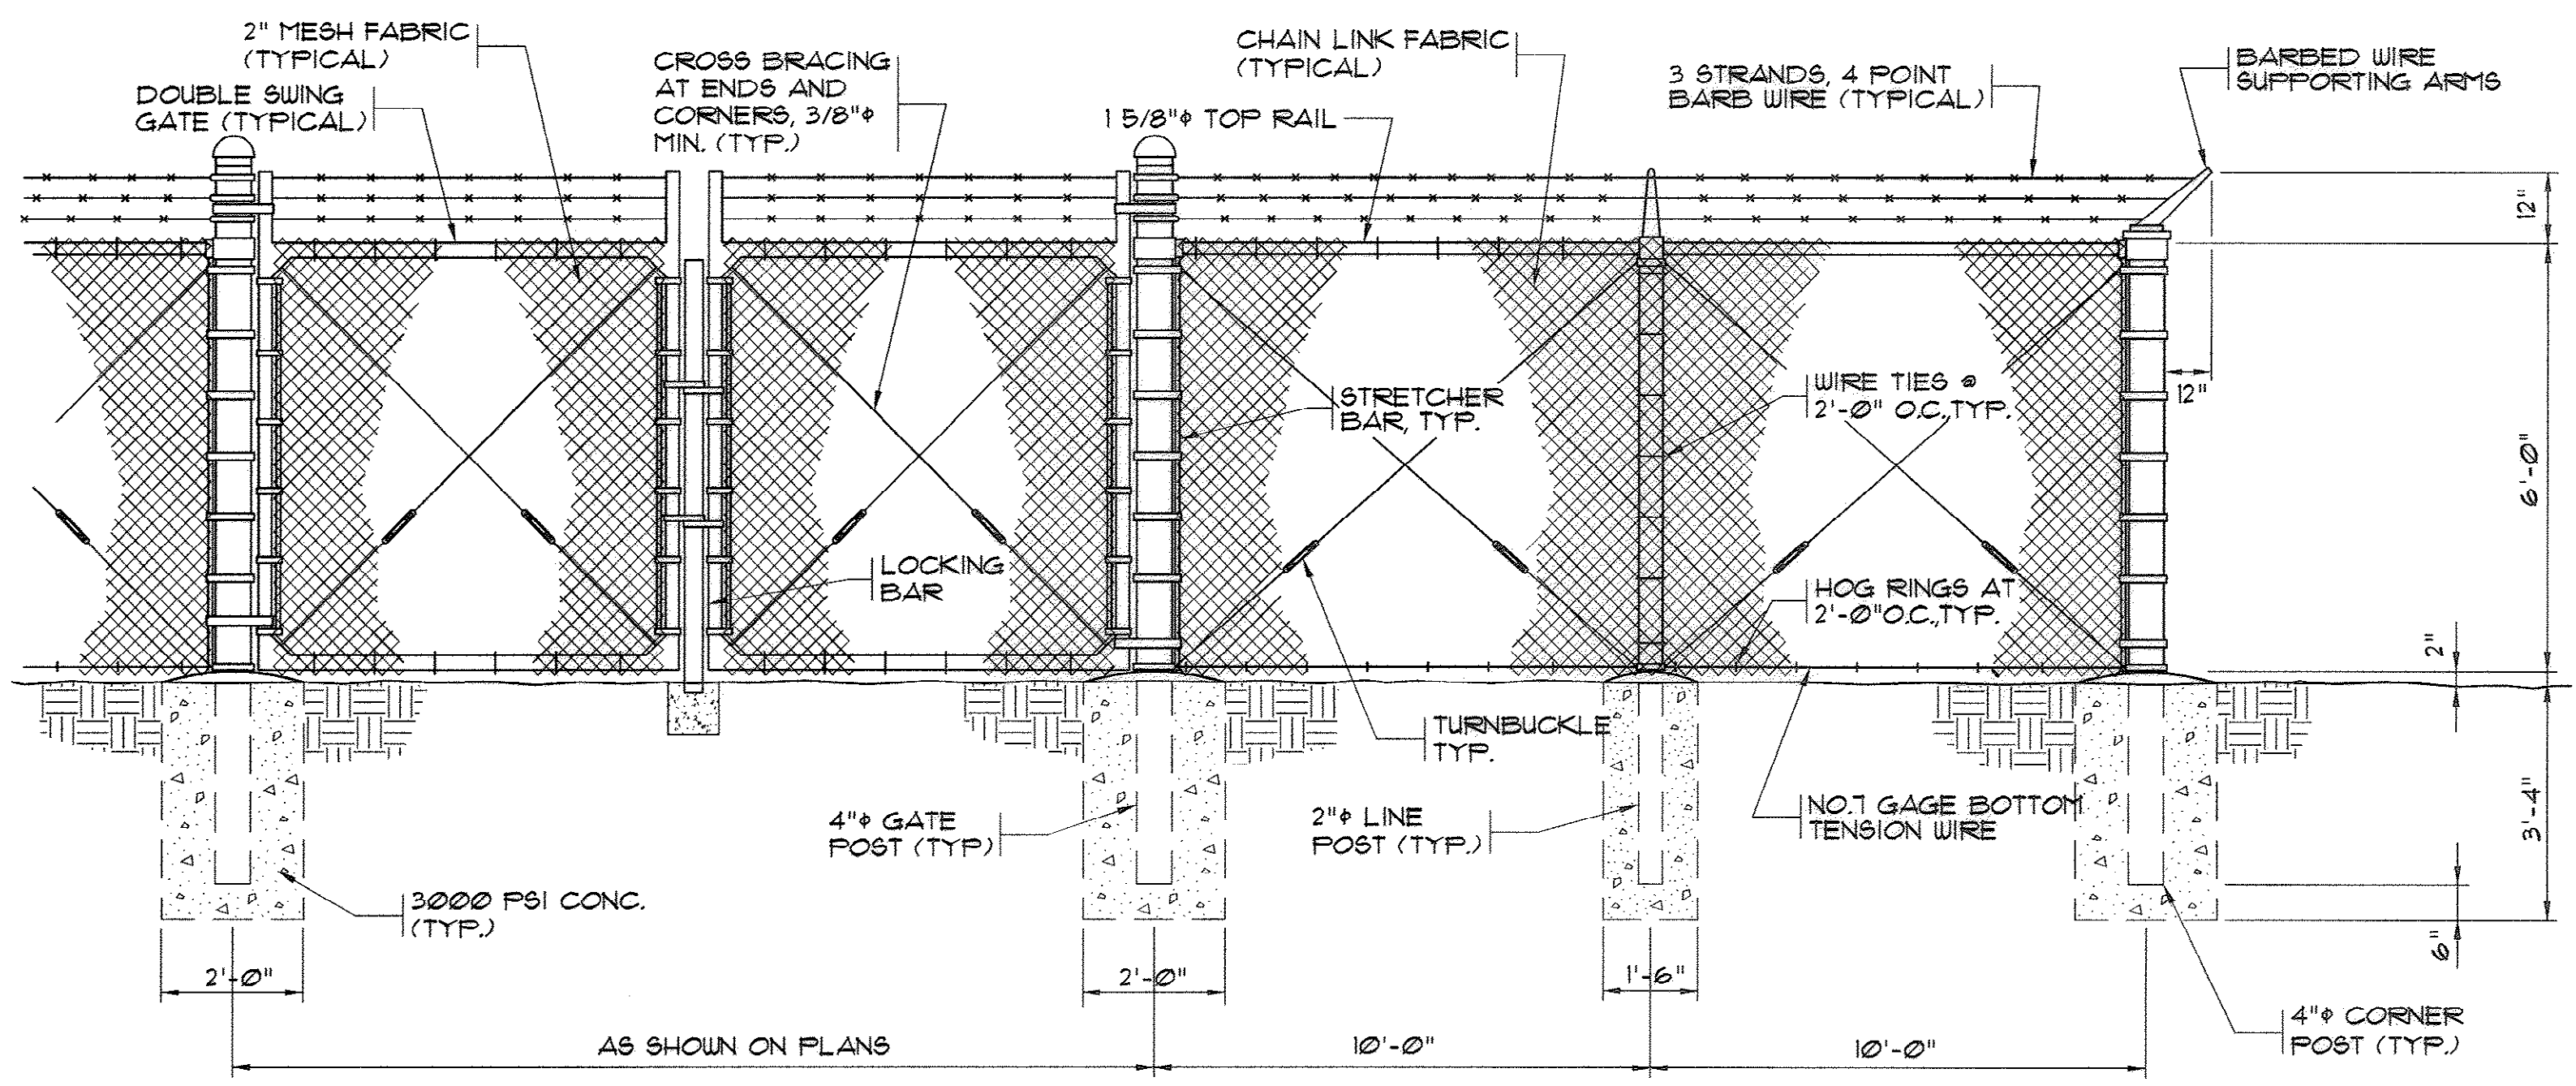


6' CHAIN LINK FENCE W/ DOUBLE SWING GATE DETAIL
 N.T.S.

AS-BUILT 9-5-08

12-250-04/36 W

REVISIONS			
SYM.	DESCRIPTION	DATE	BY

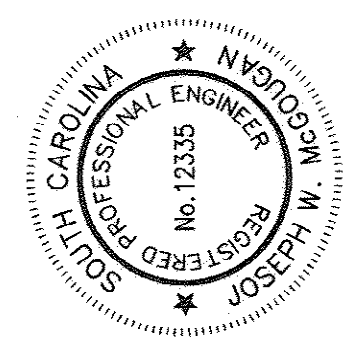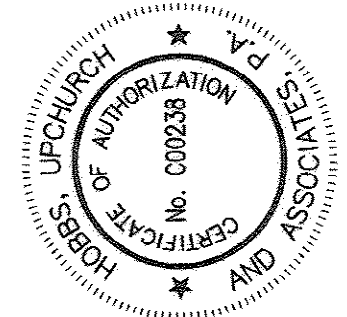


Hobbs, Upchurch & Associates, P.A.
 Consulting Engineers
 Myrtle Beach, South Carolina 29577
 PHONE (843) 658-1910 FAX (843) 658-1745

MISCELLANEOUS DETAILS


PERRY ROAD
 PUMP STATION
 GRAND STRAND WATER &
 SEWER AUTHORITY

DATE:	9-5-2008
DESIGNED:	JWM
DRAWN:	ALG
CHECKED:	JWM
SCALE:	AS SHOWN
SHEET NO.	15
OF:	15
VERSION:	4

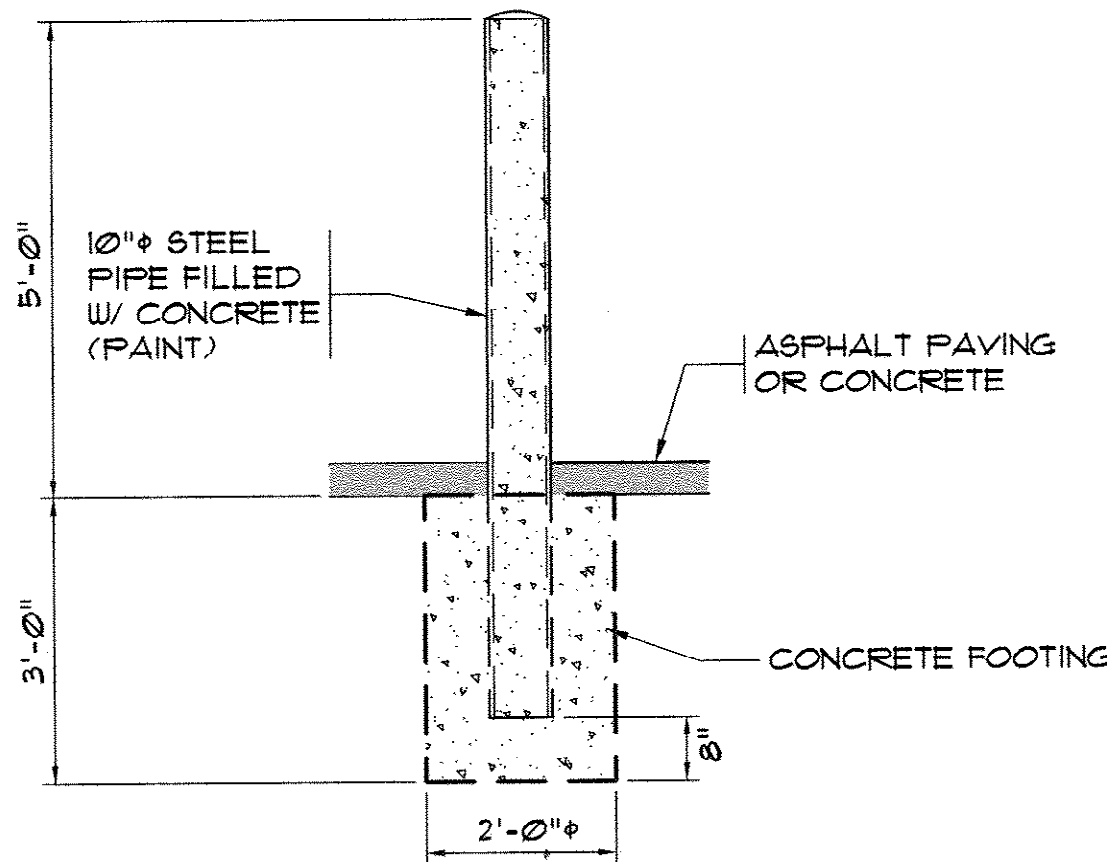


BOLLARD DETAIL
 N.T.S.

FORM JOINT BETWEEN SLABS WITH CONC. JOINTING TOOL TO PROVIDE NOM. 3" WIDE TOOLED SURFACE PROFILED AS SHOWN

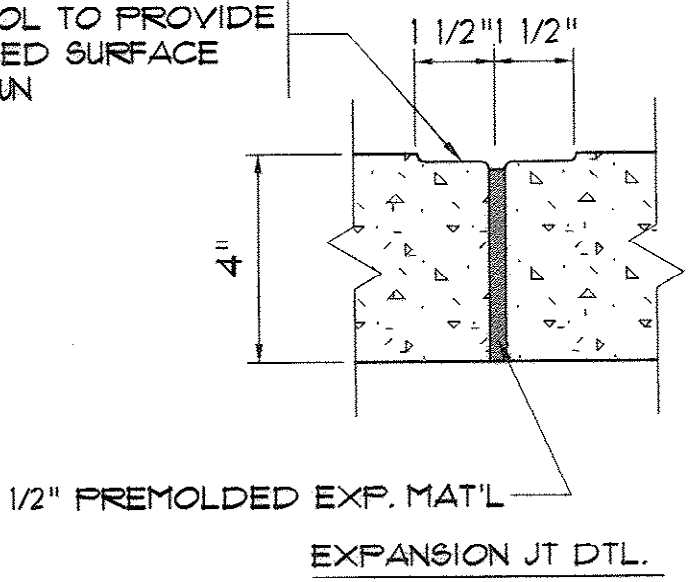


FORM JOINT BETWEEN SLABS WITH CONC. JOINTING TOOL TO PROVIDE NOM. 3" WIDE TOOLED SURFACE PROFILED AS SHOWN

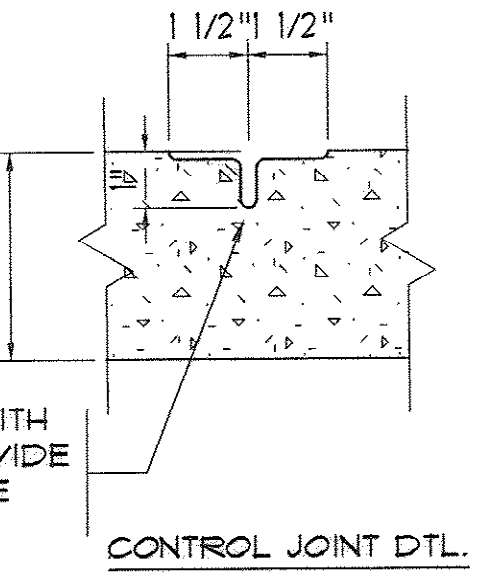


CONTROL JOINT AND EXPANSION JOINT DETAIL
 N.T.S.


NOTE:
 PROVIDE CONTROL JOINTS IN WALKS @ 5'-0" O.C. PROVIDE EXP. JTS @ MIN. 25'-0" O.C. & @ ALL EDGES W/ OTHER MATERIALS

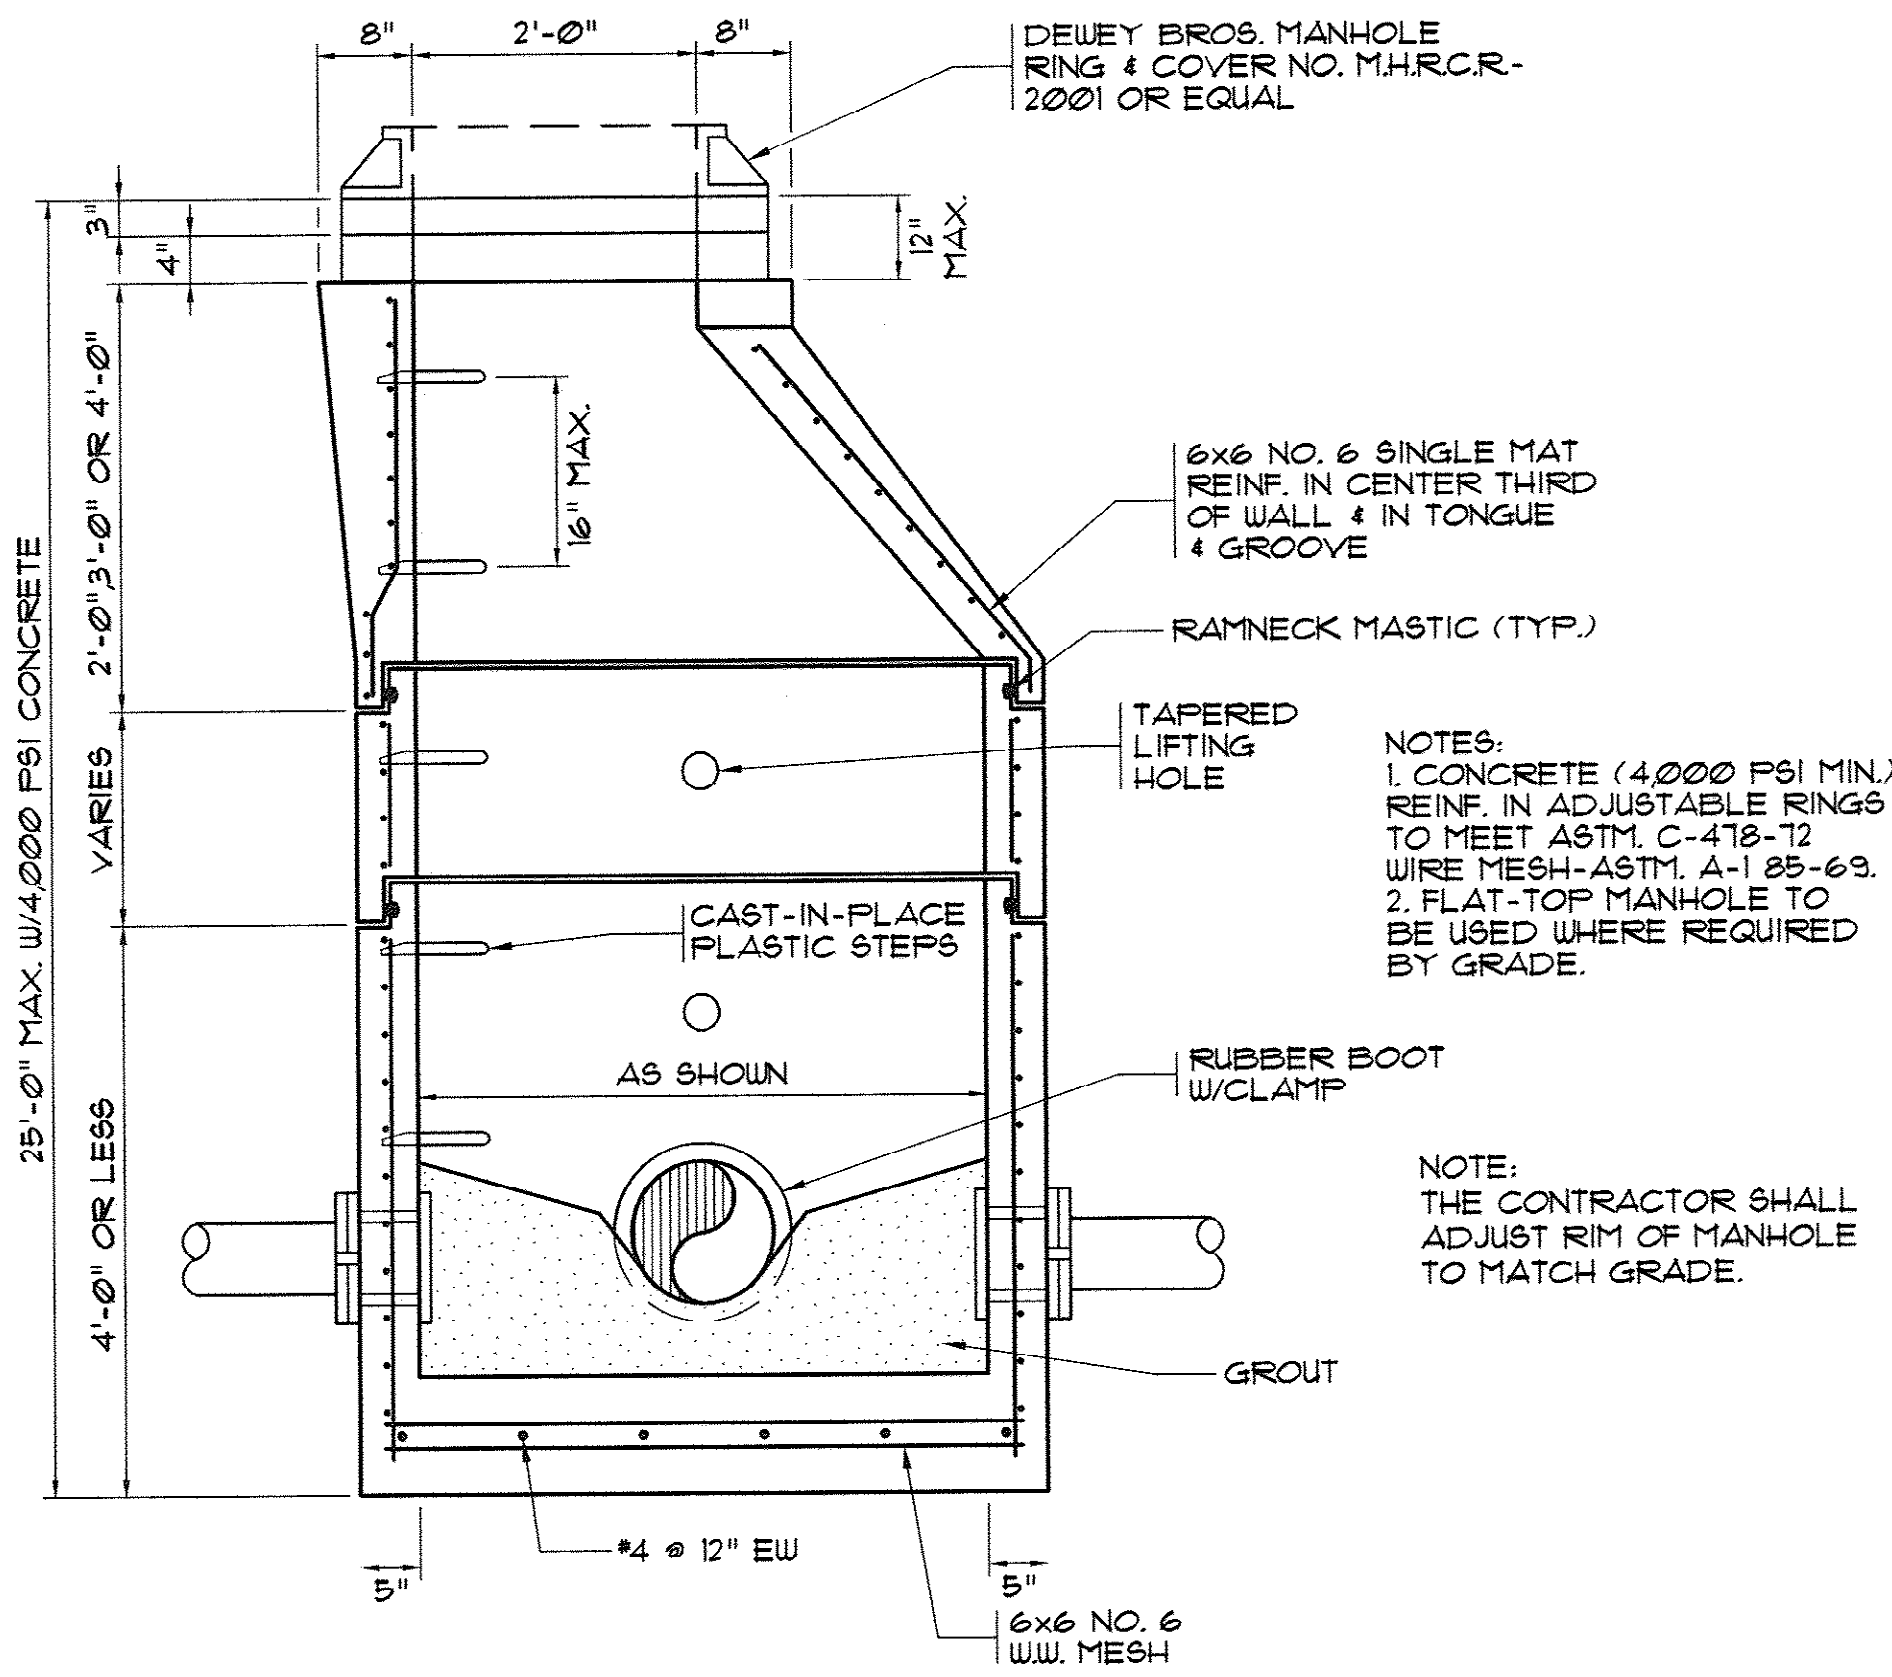

PRECAST MANHOLE DETAIL
 N.T.S.

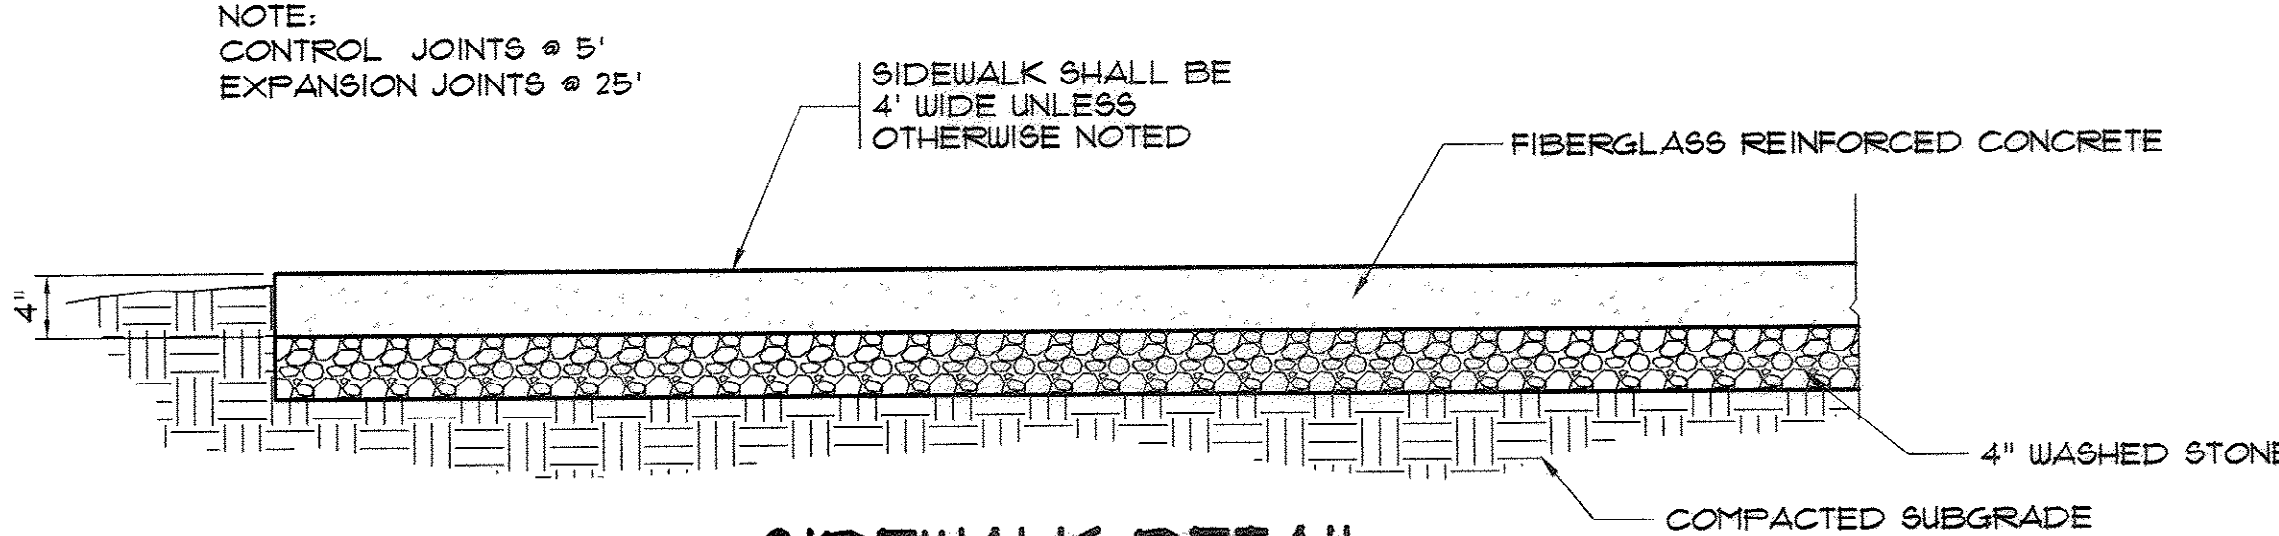

SIDEWALK DETAIL
 N.T.S.

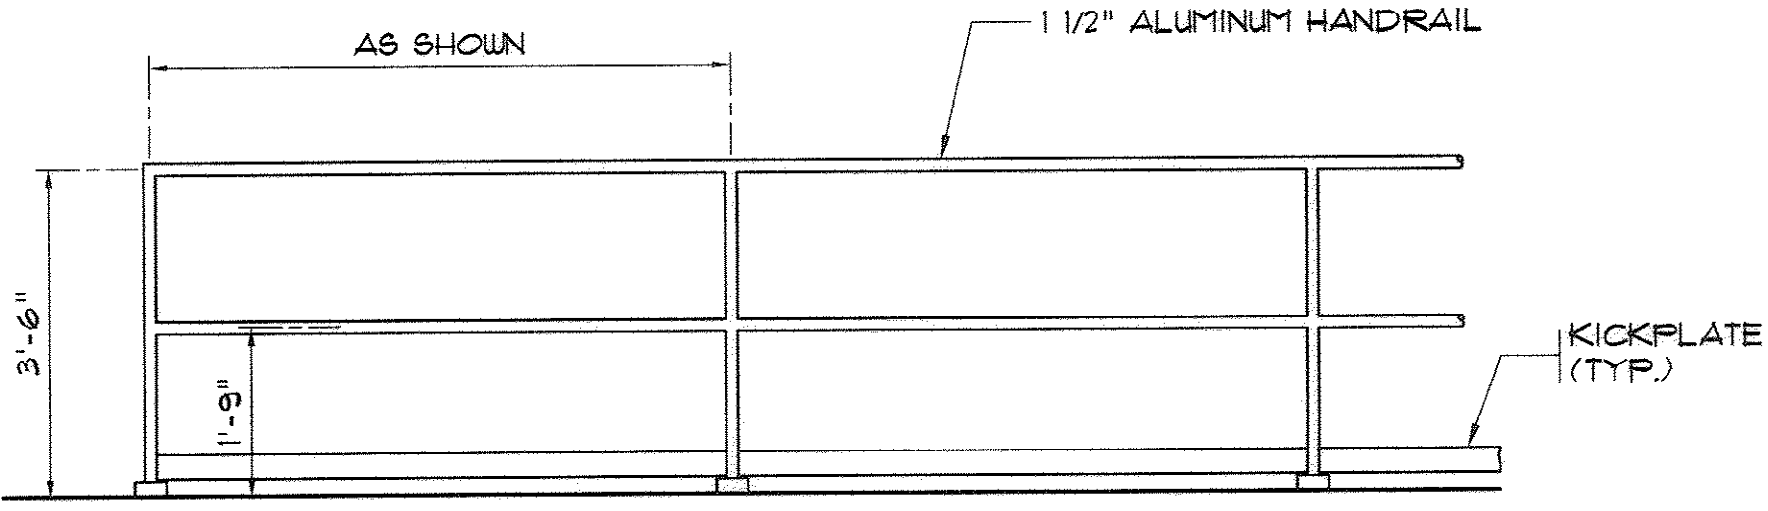

TYPICAL HANDRAIL DETAIL
 N.T.S.

AS-BUILT 9-5-08

12-250-015/36 W

ELECTRICAL SYMBOL SCHEDULE

SYMBOL	DESCRIPTION
	CONDUIT CONCEALED IN OR ABOVE CEILING: IN OVERHEAD SLAB: OR IN WALL
	CONDUIT CONCEALED IN OR BELOW FLOOR: BELOW GRADE: OR IN WALL
	CONDUIT RUN EXPOSED AS HIGH AS POSSIBLE
	IF SHOWN, CROSS LINES INDICATE NUMBER OF CURRENT CARRYING CONDUCTORS. EQUIPMENT GROUNDING CONDUCTORS ARE GENERALLY NOT INCLUDED IN THE QUANTITY INDICATED.
	#1/0 THHW/THWN COPPER - 24" BELOW GRADE
	HOME RUN TO PANEL - WITH PANEL AND CIRCUIT DESIGNATION.
	CONDUIT STUB-IN WITH CONNECTION TO EQUIPMENT
	JUNCTION OR PULL BOX. SIZE PER N.E.C.
	FLUORESCENT FIXTURE, CEILING, WALL OR RECESS MOUNTED AS SCHEDULED DRAWN APPROXIMATELY TO SCALE
	WALL OUTLET - INCANDESCENT, COMPACT FLUORESCENT, OR HID FIXTURE AS SCHEDULED.
	WALL MOUNTED, STANDBY BATTERY POWERED FIXTURE AS SCHEDULED - MOUNT 12" BELOW JOIST. SEE LIGHTING FIXTURE SCHEDULE.
	3-WAY, SINGLE POLE SWITCH - 20A, 120-277V. MOUNT 46" AFF TO TOP AND 2" FROM STRIKE SIDE OF DOOR FRAME.
	4-WAY, SINGLE POLE SWITCH, OTHERWISE SAME AS "S ₃ ".
	BRANCH CIRCUIT OR DISTRIBUTION PANELBOARD, AS INDICATED
	CONTROL PANEL
	CONVENIENCE RECEPTACLE - MOUNT 18" AFF. NEMA 5-20R, DUPLEX
	SPECIAL CONFIGURATION OUTLET.
	WALL TELEPHONE OUTLET, 54" AFF.
	NONFUSIBLE DISCONNECT SWITCH.
	FUSIBLE DISCONNECT SWITCH.
	ENCLOSED CIRCUIT BREAKER.
	COMBINATION MAGNETIC STARTER WITH NONFUSIBLE DISCONNECT.
	THERMOSTAT, LINE VOLTAGE
	Δ-Y DRY TYPE TRANSFORMER - THREE PHASE, 480-120/208 VOLTS.
	460 VOLT, 3 PHASE MOTOR - NUMERAL INDICATES HORSEPOWER.
	INDICATES GROUNDING ELECTRODE CONDUCTOR AS REQUIRED BY ARTICLES 250-26 OR 250-81 OF THE NATIONAL ELECTRICAL CODE.
	SA SURGE ARRESTER
	*GR GROUND ROD
	FAC FIRE ALARM CONTROL PANEL
	CEILING MOUNTED SMOKE DETECTOR, PHOTOELECTRIC TYPE
	DD DUCT SMOKE DETECTOR
	H CEILING MOUNTED COMBINATION RATE-OF-RISE/FIXED TEMPERATURE FIRE DETECTOR
	FP FIRE ALARM COMBINATION ADA BELL/STROBE APPLIANCE - MOUNT 6"-8" AFF. FROM BOTTOM OF APPLIANCE, OR 0'-6" BELOW CEILING, WHICHEVER IS LESS.
	END OF LINE DEVICE

SYMBOL	DESCRIPTION
	MS DOOR SECURITY MAGNETIC SWITCH, SENTROL 1078 SERIES WITH CLOSED CONTACTS WHEN DOOR IS CLOSED. SEE DETAILS 5 AND 6 ON E-13. WIRE TOGETHER WITH 2#14, 1/2" C. TO SECURITY PANEL. CONNECT AS DIRECTED IN PUMP STATION. SEE DETAILS ON THIS SHEET.
	RS ROLL UP DOOR MONITORING SWITCH. MICROSWITCH BL2N SERIES ENCLOSED SWITCH WITH STRAIGHT PLUNGER OR ROLLER ARM ACTUATOR, AS REQUIRED. MOUNT NEAR FLOOR ON INSIDE OF FRAME. SWITCH IS TO BE "CLOSED" WHEN ROLL-UP DOOR IS CLOSED.
	RTU EXISTING SCADA REMOTE TERMINAL UNIT (RTU). RUN CONDUCTORS AND CABLES, AS REQUIRED BY CONSTRUCTION DOCUMENTS, TO RTU AND CONNECT AS DIRECTED BY OWNER. TAG EACH CONDUCTOR TO INDICATE DEVICE OR EQUIPMENT SERVED AND LEAVE SPARE SLACK AS SPECIFIED.
	NORMALLY OPEN AUXILIARY CONTACT
	NORMALLY CLOSED AUXILIARY CONTACT
	ELECTRICALLY ASSISTED CHECK VALVE WITH NORMAL AND EMERGENCY SOLENOID VALVES, LIMIT SWITCHES AND REMOTE VALVE CONTROL PANEL.
	SV SOLENOID VALVE
	ZIS POSITION INDICATING SWITCH
	PS PRESSURE SWITCH DOUBLE POLE TYPE
	HO "HAND-OFF" MAINTAINED CONTACT, REMOTE MOTOR CONTROL STATION TO PREVENT MOTOR FROM STARTING OR BEING ENERGIZED WHEN PUSHED IN THE OFF POSITION. MOUNT 48" AFF.
	RVSS TRANSIENT VOLTAGE SURGE SUPPRESSOR
	A AMPERE
	AFF ABOVE FINISHED FLOOR - MEASURED FROM FLOOR TO CENTER OF DEVICE, EXCEPT AS OTHERWISE SPECIFICALLY NOTED.
	ATS AUTOMATIC TRANSFER SWITCH
	C CONDUIT
	FVNR COMBINATION FVNR AND FUSED SWITCH
	DHC "DATA HIGHWAY" SHIELDED CABLE. SEE SECTION 16158.
	F FUSE
	FAC FIRE DETECTION ALARM PANEL
	FVNR FULL VOLTAGE NON-REVERSIBLE MAGNETIC MOTOR STARTER
	G GROUND
	MCB MAIN CIRCUIT BREAKER
	MCM Kcmil (THOUSAND CIRCULAR MILS)
	NEC NATIONAL ELECTRICAL CODE
	N NEUTRAL, OR NORMAL, AS APPLICABLE
	NC NORMALLY CLOSED
	NO NORMALLY OPEN
	P POLE
	PH PHASE
	RMC RIGID SCHEDULE 40 METAL CONDUIT
	RTU REMOTE TERMINAL DATA UNIT
	RVSS REDUCED VOLTAGE SOFT-START MOTOR CONTROLLER.
	SCIR SHORT CIRCUIT INTERRUPTING RATING IN RMS AMPS
	SO SPACE ONLY (WITH PROVISIONS FOR FUTURE OVERCURRENT PROTECTIVE DEVICE)
	WP INDICATES DEVICE TO HAVE WEATHERPROOF COVER

CIRCUITING LEGEND

HOMERUNS TO PANELBOARDS ARE SHOWN AS POLES RATHER THAN CIRCUITS. SIMILARLY, PANEL SCHEDULES LIST POLES RATHER THAN CIRCUITS, BUT INDICATE WHICH POLES ARE COMMON TRIP FORMING TWO AND THREE POLE CIRCUITS. HOMERUN DESIGNATIONS INDICATE PANELBOARD AND POLES TO WHICH PHASE WIRES ARE TO BE CONNECTED. NUMBER OF ARROWS INDICATE NUMBER OF CIRCUITS INVOLVED. CROSS HATCHES, SHOWN ONLY WHEN THE NUMBER OF POLES EXCEEDS THE NUMBER OF CIRCUITS, INDICATE THE NUMBER OF WIRES. FOR EXAMPLE:

SYMBOL	NO. OF POLES	CIRCUITS	PHASE WIRES	NEUTRAL
	1	1	1	1
	2	1	2	0
	2	1	2	1
	3	1	3	0
	3	1	3	1
	2	2	2	1
	3	3	3	1


FEEDERS:

NO. () INDICATES QUANTITY OF CONDUITS AND CONDUCTORS IN PARALLEL. SEE NEC 250-122, 250-95, 300-20 AND 310-4 FOR SPECIAL REQUIREMENTS. EXAMPLE: 3(3 #3/0, 1 #1/0 N, 1 1/2" 2 1/2" C) REQUIRES THREE 2 1/2" CONDUITS EACH HAVING THREE NO. 3/0 PHASE CONDUCTORS, ONE NO. 1/0 NEUTRAL CONDUCTOR AND ONE NO. 1 GROUNDING CONDUCTOR.

EQUIPMENT GROUNDING CONDUCTORS:

EQUIPMENT GROUNDING CONDUCTORS ARE GENERALLY NOT SHOWN ON CIRCUITING PLANS BUT SHALL BE PROVIDED IN THE SIZES AS SCHEDULED ON N.E.C. TABLE 250-122 ON ALL CIRCUITS.

TYPICAL PANEL DIAGRAM

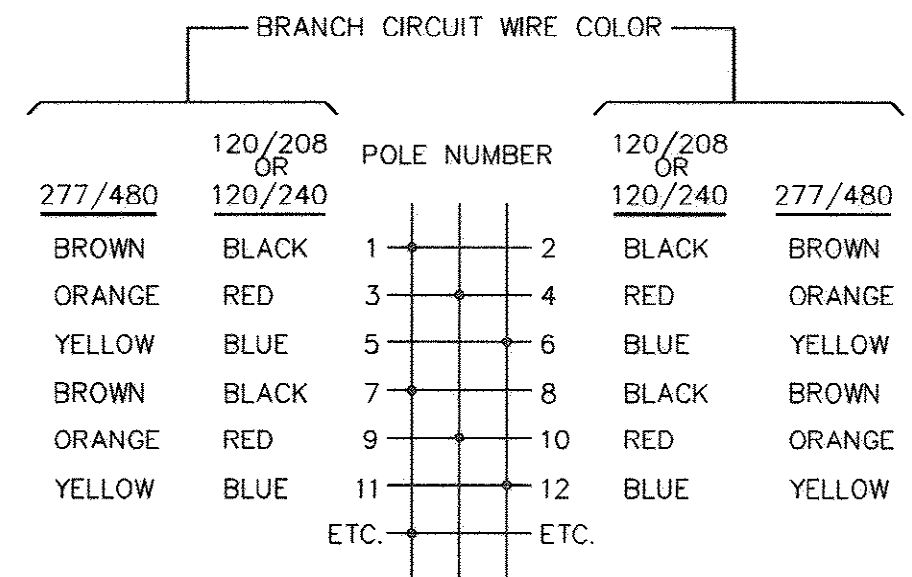

NEUTRAL

120/240 OR 120/208 VOLTS - WHITE

277/480 VOLTS - WHITE WITH IDENTIFIABLE COLOR STRIPE (NOT GREEN). IF NOT AVAILABLE AT TIME OF INSTALLATION, CLEAR USE OF GRAY WITH ELECTRICAL INSPECTOR.

GROUND WIRE SHALL BE GREEN FOR ALL VOLTAGES.

ELECTRICAL DRAWING LIST


E1	SYMBOL SCHEDULE, EQUIPMENT SCHEDULES AND DETAILS
E2	ELECTRICAL SITE PLAN
E3	EXISTING ONE-LINE POWER DIAGRAM
E4	ONE-LINE POWER DIAGRAM MODIFICATIONS AND ADDITIONS PHASE 1 OF WORK
E5	ONE-LINE POWER DIAGRAM MODIFICATIONS AND ADDITIONS PHASE 2 OF WORK
E6	FINAL ONE-LINE POWER DIAGRAM
E7	EXISTING POWER PLAN - DEMOLITION
E8	NEW BOOSTER PUMP STATION POWER PLAN PHASES 1 NEW WOK AND PHASE 2 DEMOLITION
E9	NEW BOOSTER PUMP STATION POWER PLAN PHASE 2 NEW WORK
E10	PUMP CONTROLS RISER DIAGRAMS
E11	LIGHTING AND SECURITY PLANS
E12	SCHEDULES AND ELEVATION
E13	MISCELLANEOUS DETAILS
E14	ENGINE GENERATOR SET PLAN AND DETAILS
E15	ENGINE GENERATOR SET CONCRETE PAD DETAILS, SCHEDULES AND DIAGRAMS

LIGHTING FIXTURE SCHEDULE

FIXTURE TYPE	MANUFACTURER & CATALOG INFORMATION	LAMPS			BALLAST			TOTAL WATTS	DESCRIPTION
		QTY.	TYPE	WATTS	QTY.	TYPE	WATTS		
A	LITHONIA UNS232GEB-LWGCUN	2	F32T8	32	1	ELECTRONIC	58	58	STRIP LIGHT WITH WIRE GUARD - SUSPEND TO BE ALIGNED WITH BOTTOM OF DUCT WORK.
B	LITHONIA	2	F32T8	32	1	ELECTRONIC	58	58	TOTALLY ENCLOSED, CORROSION RESISTANT. MOUNT ON UNISTRUT SPACES ON CEILING.
C	LITHONIA TW SERIES 70S120-PET OR EQUIVALENT	1	HPS	70	1	HRHPF	90	90	OUTDOOR WEATHERPROOF FIXTURE WITH POLYCARBONATE LENS, PE SWITCH. MUST MATCH EXISTING ONES IN APPEARANCE AND MOUNTING HEIGHT
E	LITHONIA ELT24HAMVMD	2	HALOGEN	8	-	-	-	16	EMERGENCY BATTERY LIGHT WITH 90-MINUTE NICKEL-CADMIUM BATTERY.
SA	LUMINAIRE: GE-P17M-10-S-0-A-2-AMN3-GRU + PE SWITCH POLE: GE-ARTA-10-3S-5.0-B-SN-A (TYPE III JES DISTRIBUTION) WITH PE SWITCH	1	HPS	100	1	AUTOREG, 120/208/240/277 VOLTS	130	130	POST TOP LIGHT FIXTURE ON 3-INCH DIAMETER SCHEDULE 40 ALUMINUM POLE, 10'-0" LONG. POLE SHALL HAVE 2 1/2" DIAMETER TENON, GRAY FINISH. PROVIDE PE SWITCH. CONNECT TO NEW 120 VOLT CIRCUIT. PROVIDE CONCRETE PAD.

NOTES:

1. EQUIVALENT FIXTURES, AS JUDGED BY THE ENGINEER, FROM LITHONIA, DAYBRITE, G.E., WILLIAMS, STONCO, COOPER LIGHTING, WIDELITE OR HUBBELL ARE EQUALLY ACCEPTABLE.

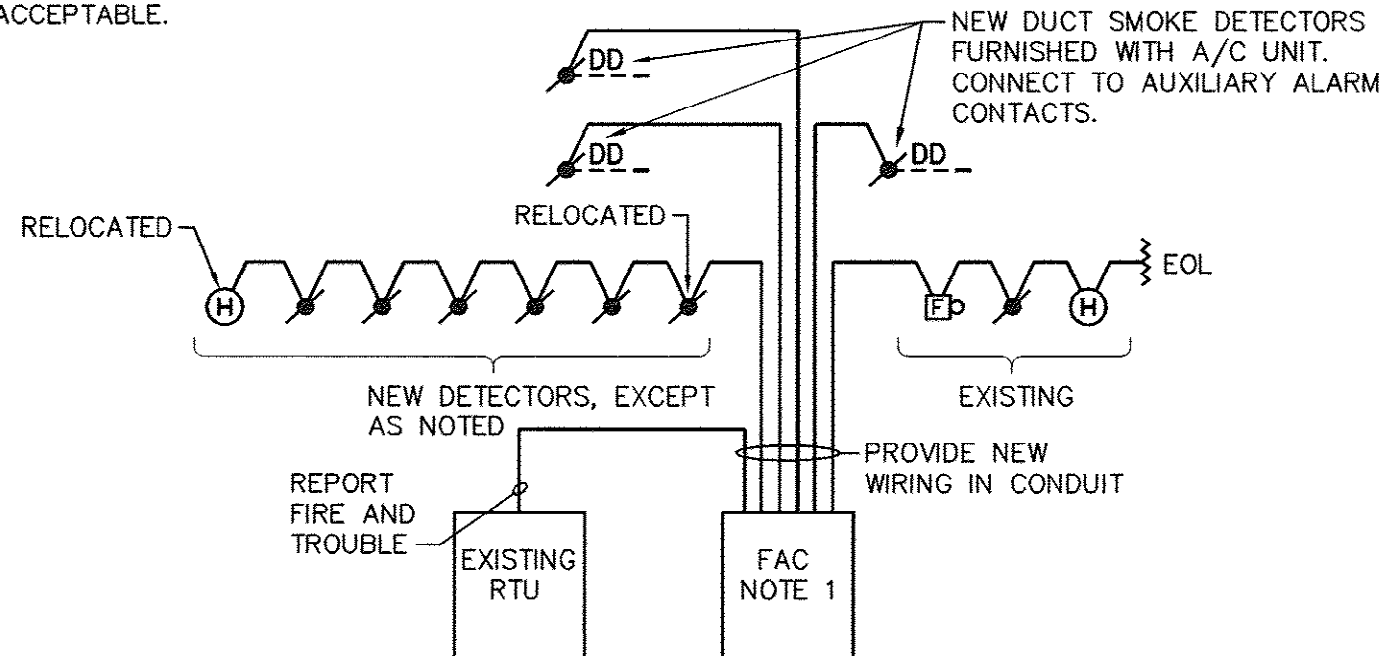

FIRE DETECTION RISER DIAGRAM

NOT TO SCALE

1. IT IS ACCEPTABLE, IF FEASIBLE TO EXPAND AS REQUIRED EXISTING FIRE ALARM CONTROL PANEL TO PROVIDE ADDITIONAL POWER SUPPLY, BATTERY BACKUP AND ZONES AS REQUIRED BY THE NEW ADDITIONS AND MODIFICATIONS WITH MANUFACTURER'S, UL AND FM APPROVAL. NEW SMOKE DETECTORS SHALL BE IONIZATION TYPE 24V DC POWER, UL LISTED. PROVIDE NEW WIRING AS DIRECTED BY FAC MANUFACTURER.

Hobbs, Upchurch & Associates, P.A.
Consulting Engineers, Surveyors & Land Planners
Southern Pines, North Carolina 28387
300 S.W. Broad Street, Southern Pines, North Carolina 28387
Phone: (910) 692-5616 - Fax: (910) 692-1342

SYMBOL SCHEDULE,
EQUIPMENT SCHEDULE
AND DETAILS

PERRY ROAD WATER
BOOSTER PUMP STATION
UPGRADE
GRAND STRAND WATER &
SEWER AUTHORITY

DATE:	9-5-2008
DESIGNED:	DL
DRAWN:	SMI
CHECKED:	DL
SCALE:	AS SHOWN


SHEET NO.

E-1

OF 15 VERSION: 4

AS-BUILT 9-5-08

12-250-016/36 W

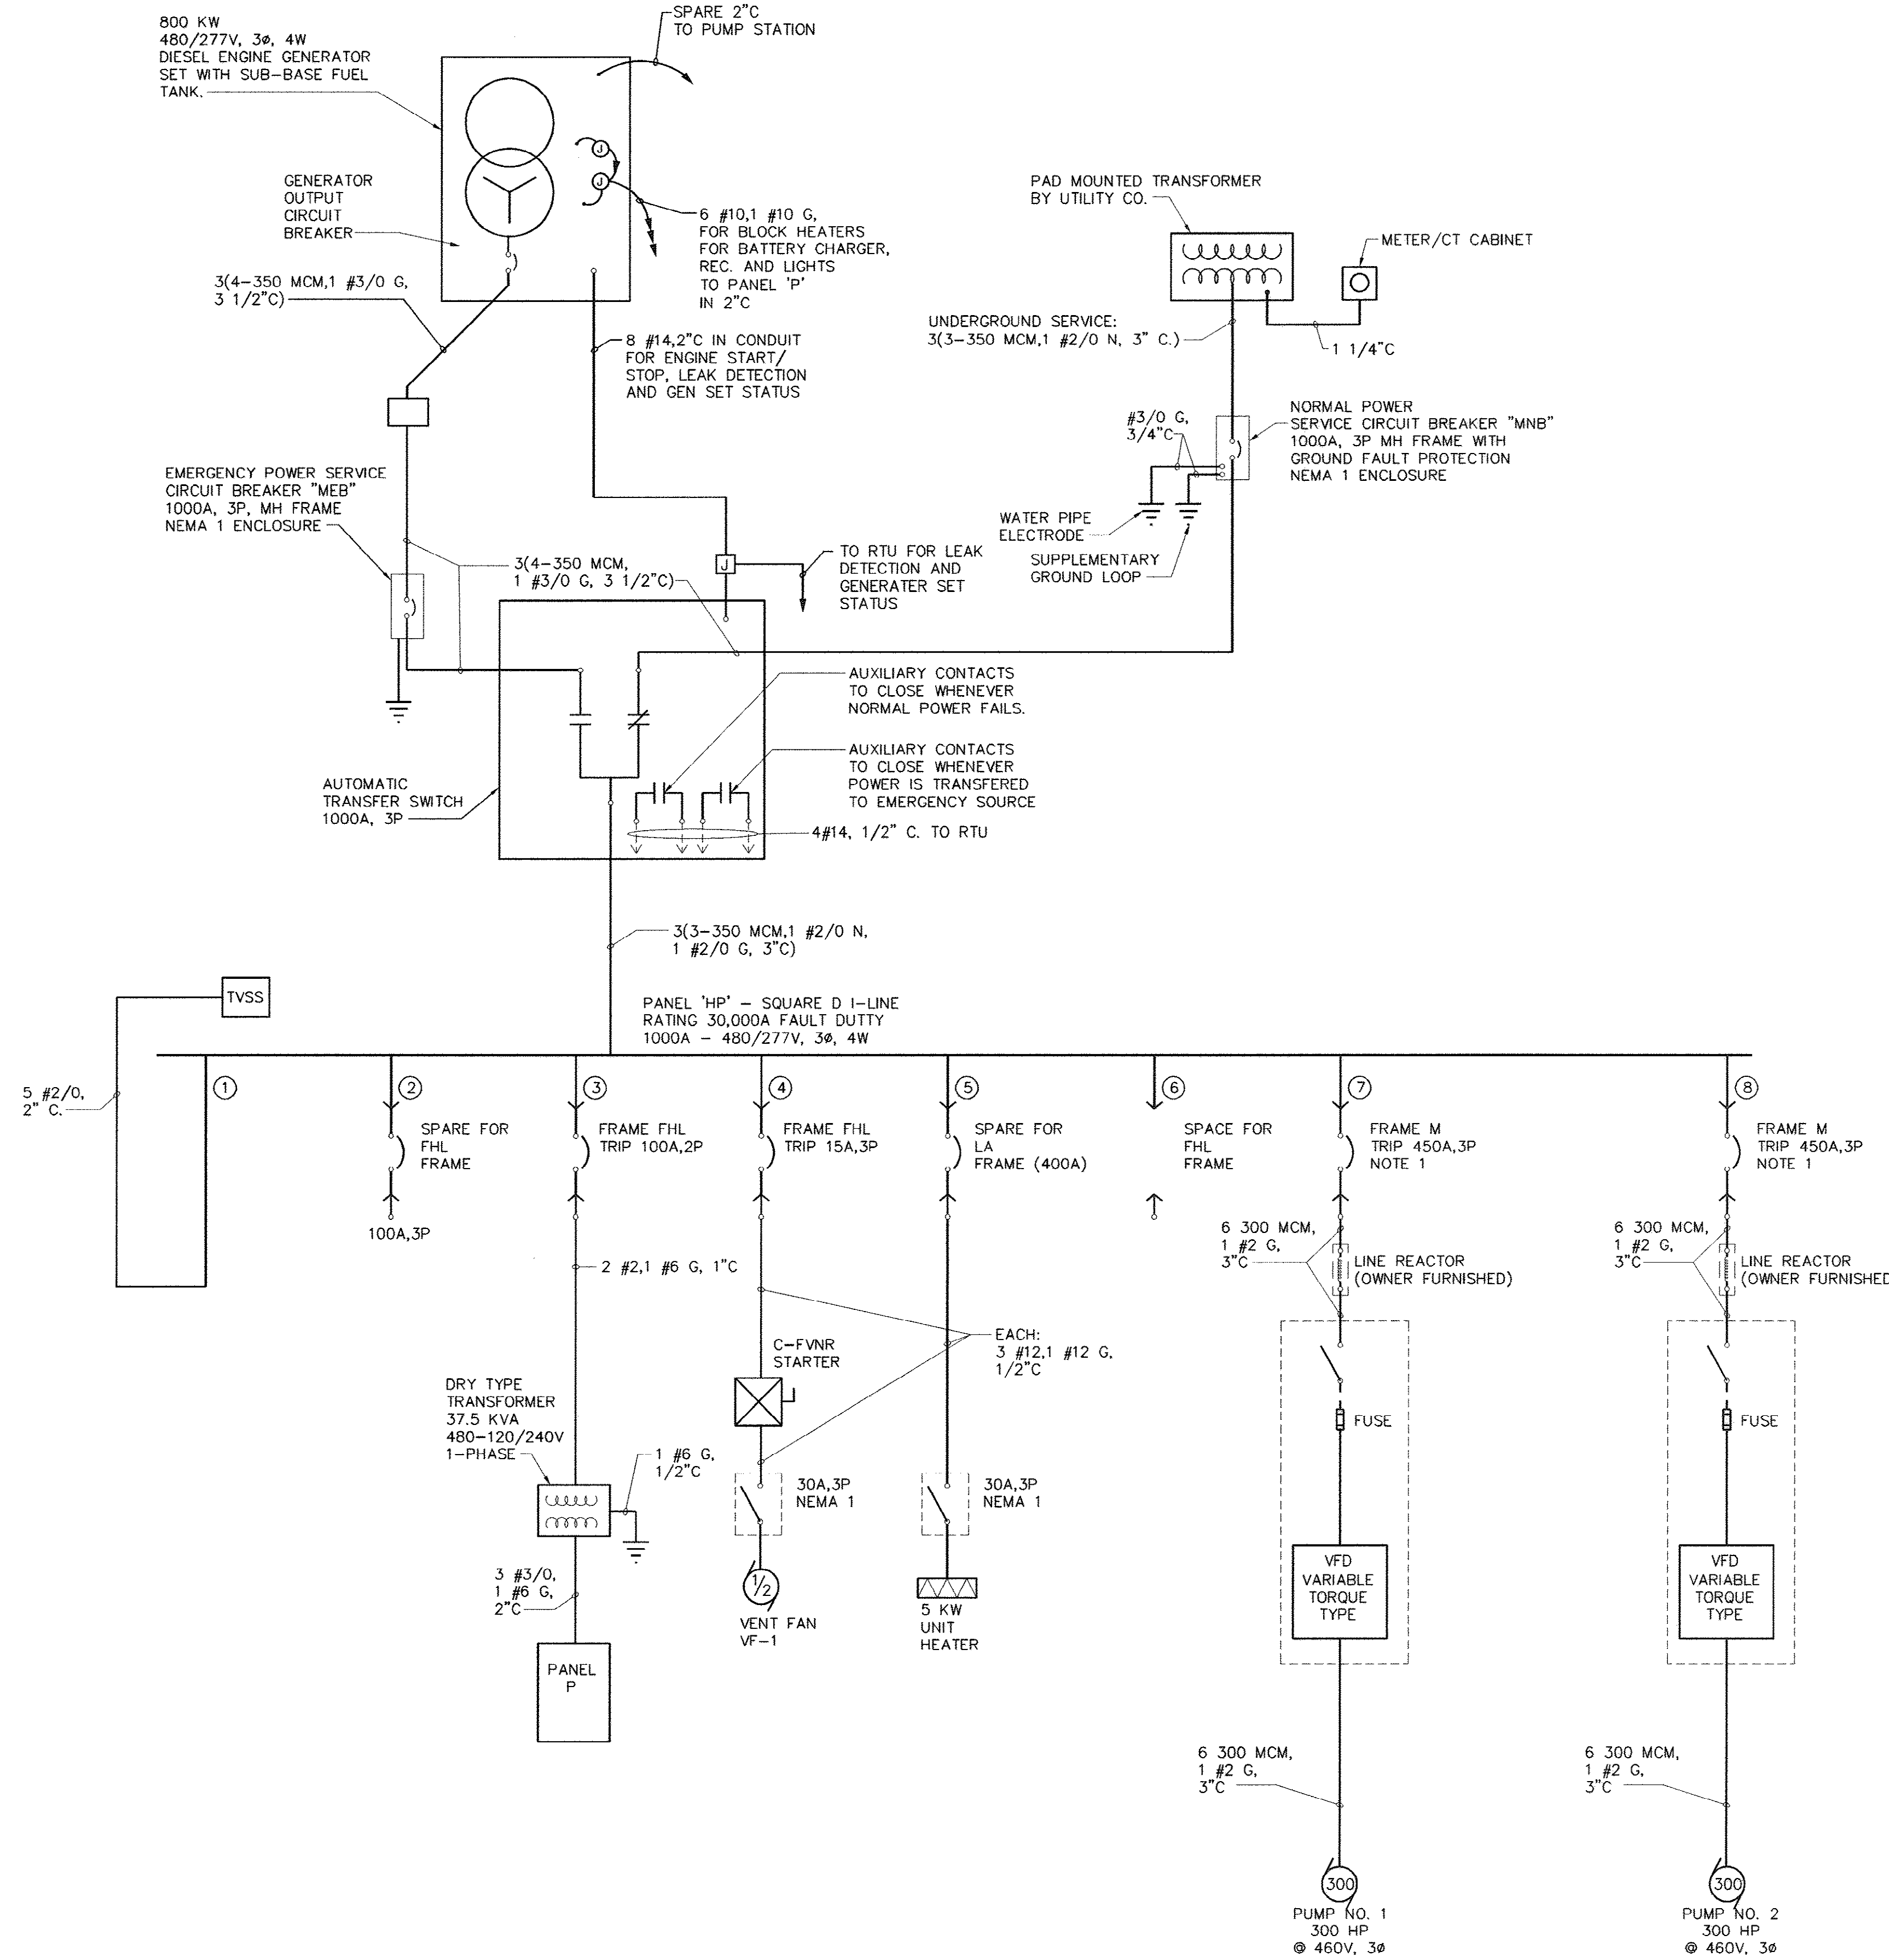

EXISTING ONE-LINE POWER DIAGRAM

NOT TO SCALE

NOTES:

A. BREAKERS FOR EACH PUMP HAVE PROVISIONS FOR PAD LOCKING IN "OFF" POSITION AND AUXILIARY 5A, 120V CONTACTS ON EACH CIRCUIT BREAKER TO OPEN WHEN BREAKER IS IN OPEN POSITION.

B. VERIFY EXACT EXISTING CONDITIONS PRIOR TO STARTING ANY WORK AT THIS SITE.

REVISIONS			
SYM.	DESCRIPTION	DATE	BY

McCracken & Lopez, P.A.
Consulting Engineers
1300 Baxter Street, Suite 350
Charlotte, North Carolina 28204
Post Office Box 32515
Charlotte, North Carolina 28232
Telephone 704/376-7072
Fax 704/376-4465

ONE-LINE DIAGRAM LEGEND - FOR SHEETS E-3 THROUGH E-6

- ELECTRONIC POWER MONITORING SYSTEM WITH AMPERES/PHASE VOLTAGE EACH PHASE-PHASE & PHASE TO NEUTRAL AND ADDITIONAL FEATURES. REFER TO SECTION 16442 FOR REQUIREMENTS.
- FUSE
- BOLT-ON CIRCUIT BREAKER: FIRST NUMERAL = FRAME IN AMPERES, SECOND NUMERAL = TRIP IN AMPERES, THIRD NUMERAL = POLES
- POWER SWITCH: RATING IN AMPERES AND POLES AS INDICATED BY NUMERALS
- DRAW-OUT, POWER CIRCUIT BREAKER CONFORMING TO UL 1066.
- PLUG-IN, MOLDED CASE CIRCUIT BREAKER, OTHERWISE SAME AS BOLT-ON CIRCUIT BREAKER.
- GROUNDING BUS
- NEUTRAL BUS
- GROUNDING ELECTRODE
- TRANSFORMER VOLTAGE AND TYPE
- MOTOR 460V, 3Ø, HORSEPOWER RATING AS INDICATED BY NUMERAL
- TRANSIENT VOLTAGE SUPPRESSOR SYSTEM COMPLYING WITH SECTION 16289
- AUTOMATIC TRANSFER SWITCH
- EMERGENCY (STANDBY GENERATOR SET) SIDE
- TYPICAL ELECTRICAL TRIP FUNCTIONS, AS APPLICABLE:
L = LONG TIME
S = SHORT TIME
I = INSTANTANEOUS
FLA = FULL LOAD AMOERE
GF = GROUND FAULT
AM = AMMETER
- NORMAL (COMMERCIAL) FEED SIDE, OR NEUTRAL, AS APPLICABLE
- NORMALLY CLOSED
- NORMALLY OPEN
- OVERLOAD PROTECTION
- REDUCED VOLTAGE SOFT STARTER MOTOR CONTROLLER
- VARIABLE FREQUENCY DRIVE CONTROLLER ASSEMBLY. REFER TO SECTION 16161.

Hobbs, Upchurch & Associates, P.A.
Consulting Engineers, Surveyors & Land Planners
Southern Pines, North Carolina 28387
300 S.W. Broad Street, Southern Pines, North Carolina 28387
Phone: (910) 692-5816 - Fax: (910) 692-7342


EXISTING ONE-LINE
POWER DIAGRAM

PERRY ROAD WATER
BOOSTER PUMP STATION
UPGRADE
GRAND STRAND WATER &
SEWER AUTHORITY

DATE:	9-5-2008
DESIGNED:	DL
DRAWN:	SMI
CHECKED:	DL
SCALE:	AS SHOWN
SHEET NO.	E-3
OF:	15
VERSION:	4

AS-BUILT 9-5-08

12-250-018/36 W

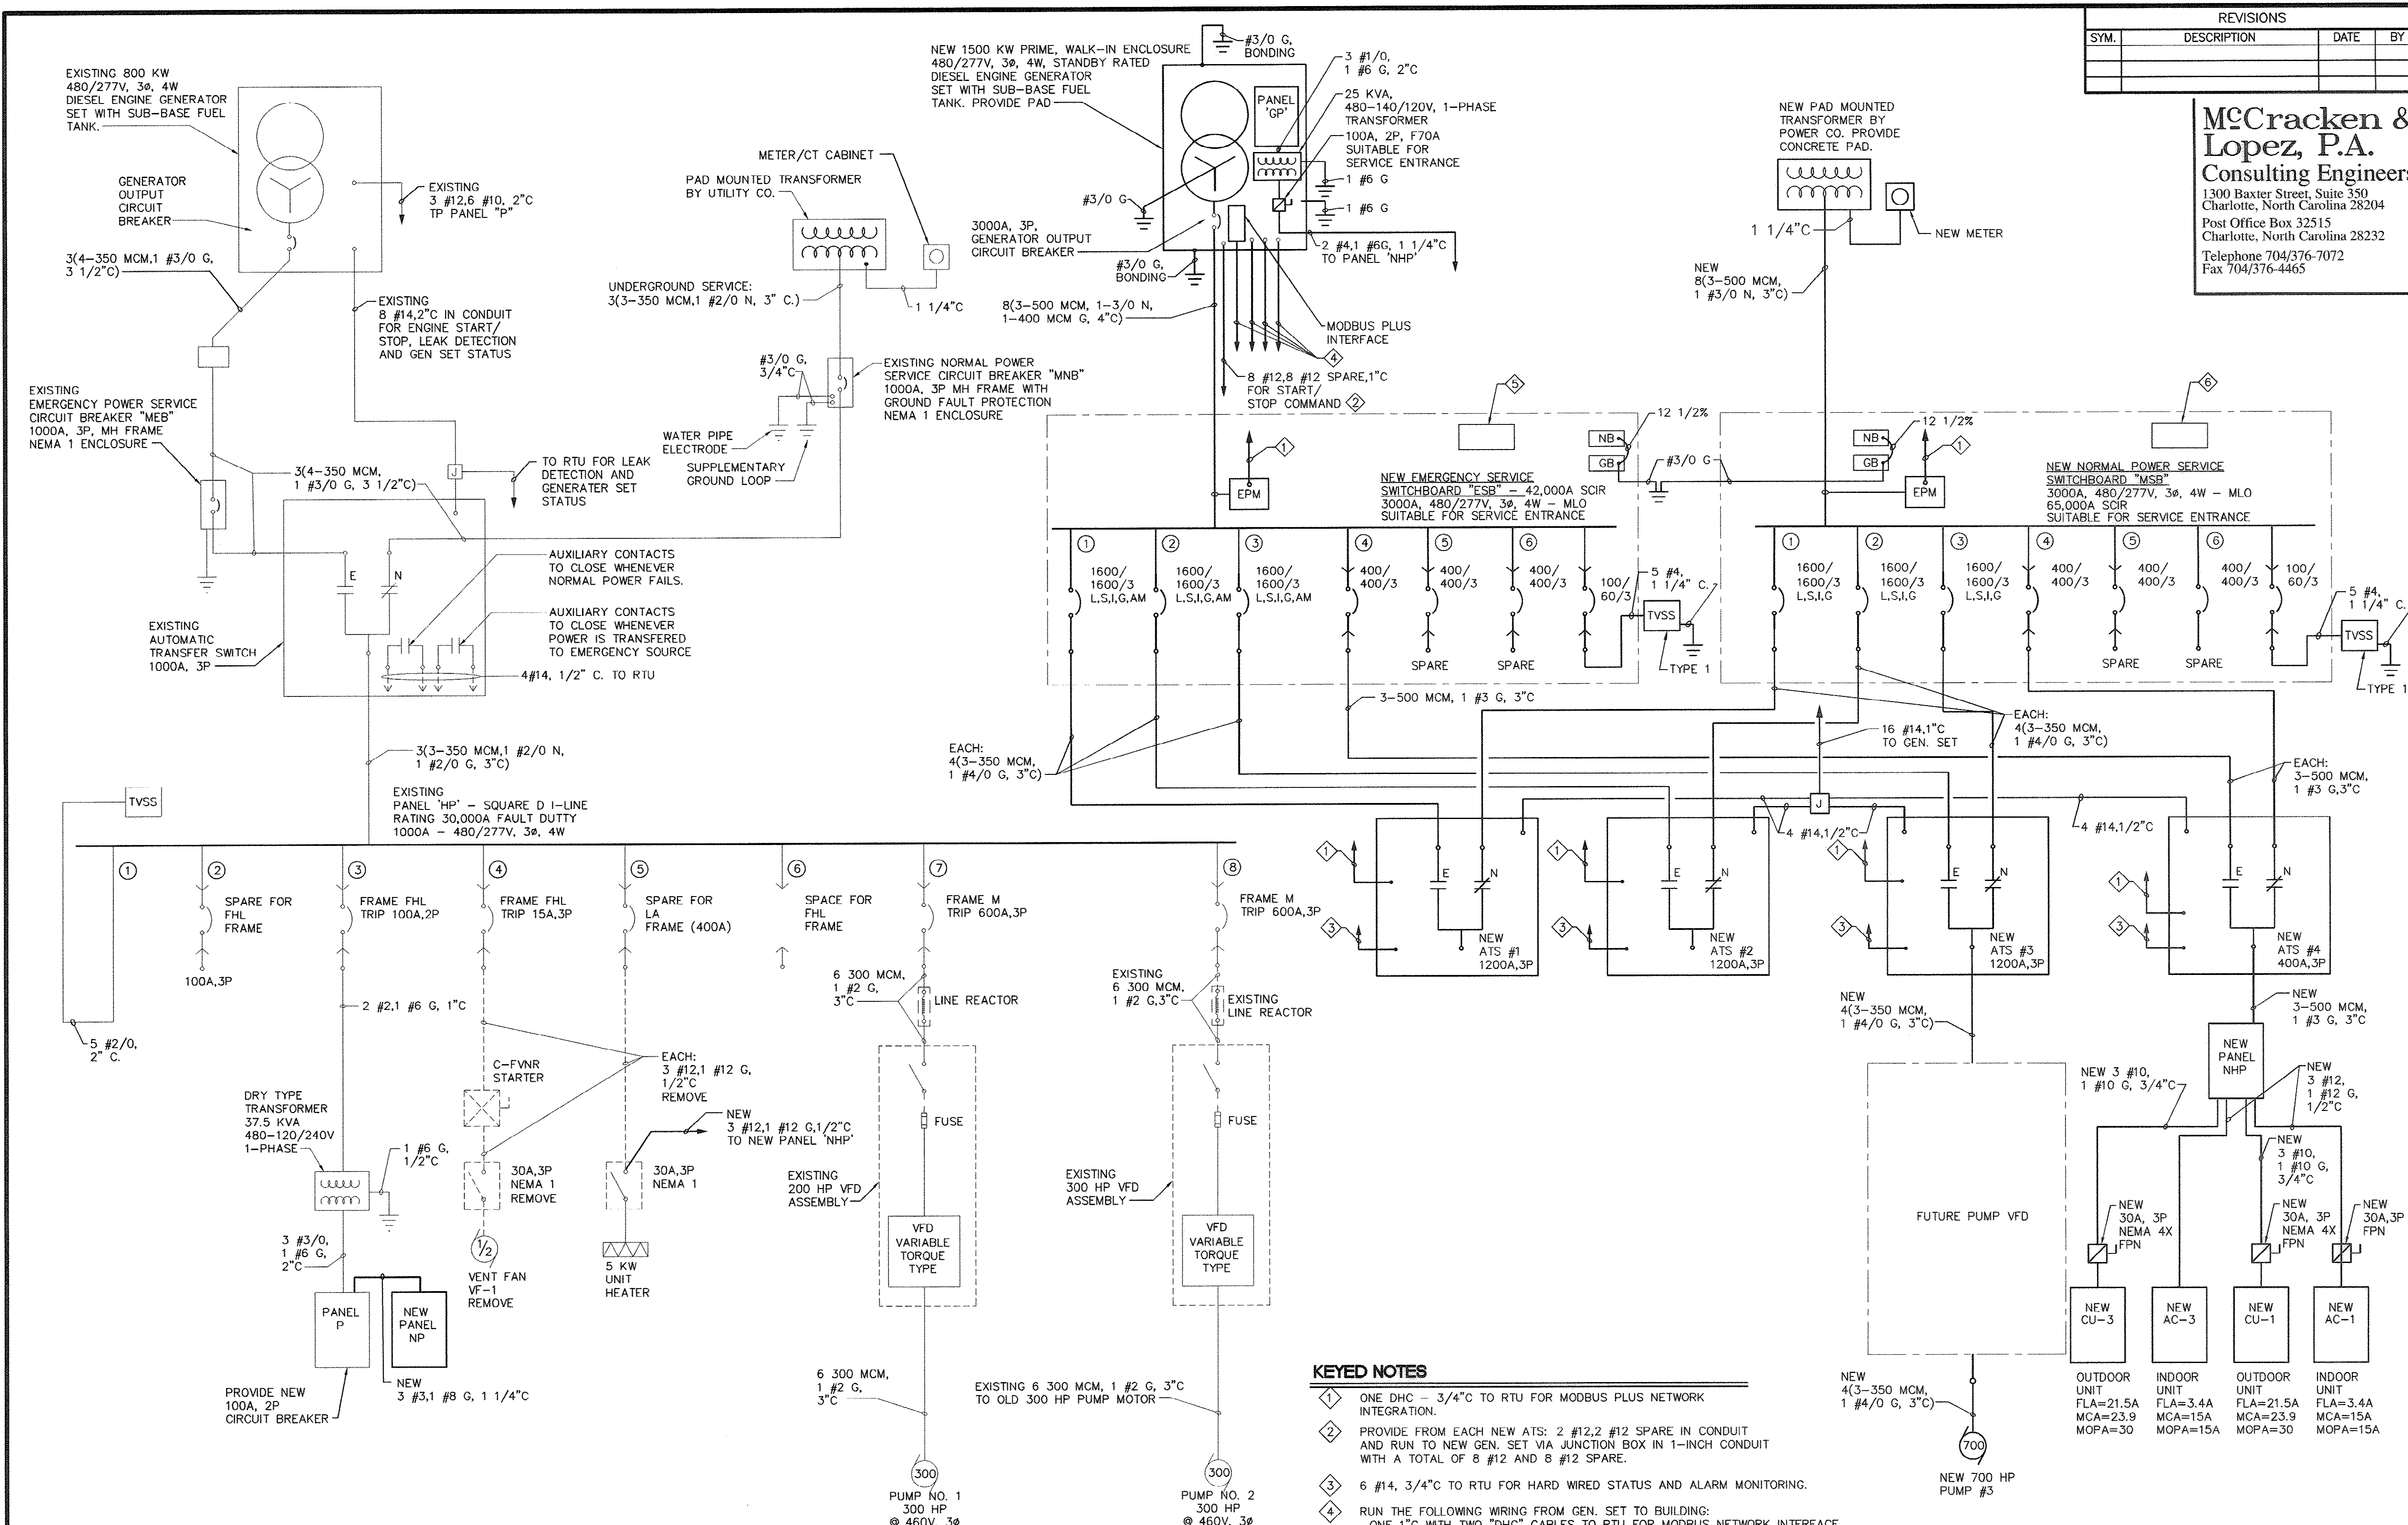

REVISIONS			
SYM.	DESCRIPTION	DATE	BY

McCracken & Lopez, P.A.
Consulting Engineers
1300 Baxter Street, Suite 350
Charlotte, North Carolina 28204
Post Office Box 32515
Charlotte, North Carolina 28232
Telephone 704/376-7072
Fax 704/376-4465

Hobbs, Upchurch & Associates, P.A.
Consulting Engineers, Surveyors & Land Planners
Southern Pines, North Carolina 28387
300 S.W. Broad Street, Southern Pines, North Carolina 28387
Phone: (910) 692-5616 - Fax: (910) 692-7592

ONE-LINE POWER DIAGRAM
MODIFICATIONS AND
ADDITIONS
PHASE I OF WORK

PERRY ROAD WATER
BOOSTER PUMP STATION
UPGRADE
GRAND STRAND WATER &
SEWER AUTHORITY


- KEYED NOTES**
- ① ONE DHC - 3/4" C TO RTU FOR MODBUS PLUS NETWORK INTEGRATION.
 - ② PROVIDE FROM EACH NEW ATS: 2 #12, 2 #12 SPARE IN CONDUIT AND RUN TO NEW GEN. SET VIA JUNCTION BOX IN 1-INCH CONDUIT WITH A TOTAL OF 8 #12 AND 8 #12 SPARE.
 - ③ 6 #14, 3/4" C TO RTU FOR HARD WIRED STATUS AND ALARM MONITORING.
 - ④ RUN THE FOLLOWING WIRING FROM GEN. SET TO BUILDING:
 - ONE 1" C WITH TWO "DHC" CABLES TO RTU FOR MODBUS NETWORK INTERFACE.
 - ONE 1" C WITH DOOR MONITORING SWITCH CONDUCTORS TO RTU.
 - ONE 1" C WITH CABLES AS REQUIRED TO ELECTRICAL BUILDING FOR REMOTE ALARMS ANNUNCIATOR.
 - ONE 1" C SPARE TO ELECTRICAL BUILDING.
 - ⑤ PROVIDE PLAQUE: "EMERGENCY SERVICE DISCONNECTS - TOTAL OF SIX - NORMAL POWER DISCONNECTS ARE IN SWITCHBOARD MSB".
 - ⑥ PROVIDE PLAQUE: "NORMAL SERVICE DISCONNECTS - TOTAL OF SIX - EMERGENCY POWER DISCONNECTS ARE IN SWITCHBOARD ESB".

ONE-LINE POWER RISER DIAGRAM - PHASE 1 WORK
NOT TO SCALE
NOTES:
A. EXISTING EQUIPMENT AND FEEDERS REMAIN, EXCEPT AS OTHERWISE NOTED.
B. REFER TO SHEET E-3 FOR LEGEND.

AS-BUILT 9-5-08

DATE:	9-5-2008
DESIGNED:	DL
DRAWN:	SMI
CHECKED:	DL
SCALE:	AS SHOWN
SHEET NO.	E-4
OF:	15
VERSION:	4


12-250-019/36 W

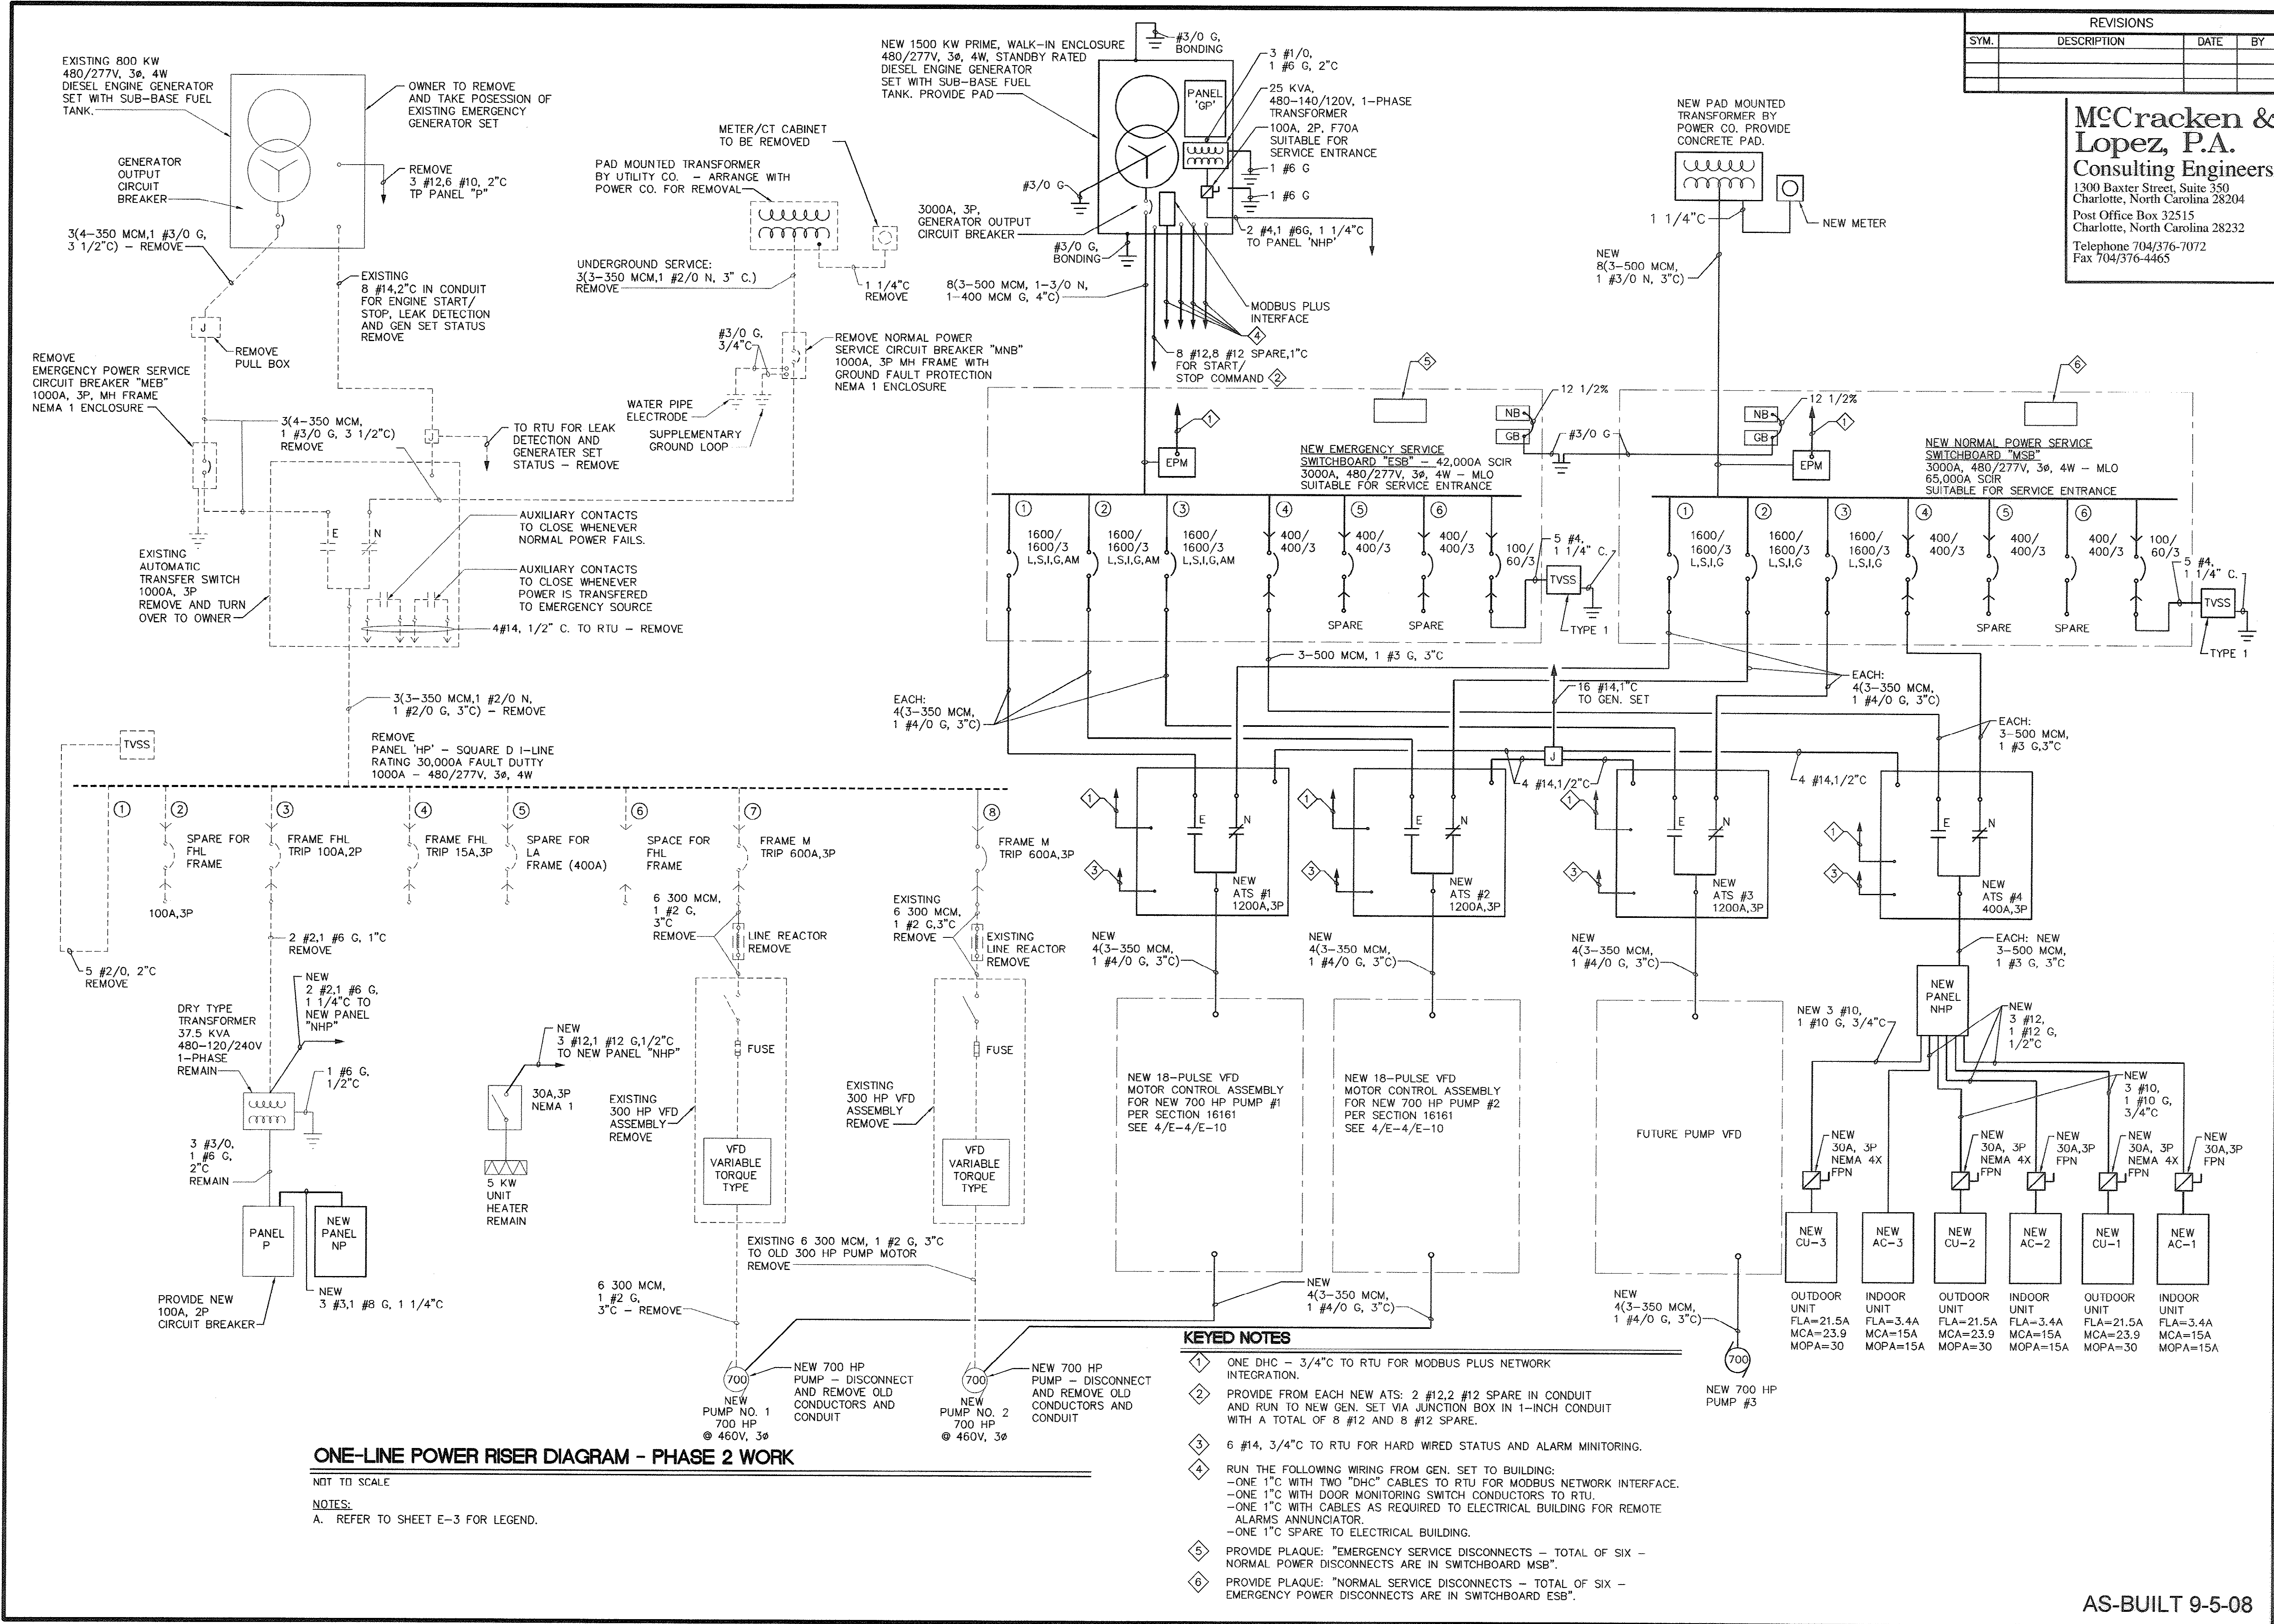

REVISIONS			
SYM.	DESCRIPTION	DATE	BY

McCracken & Lopez, P.A.
Consulting Engineers
1300 Baxter Street, Suite 350
Charlotte, North Carolina 28204
Post Office Box 32515
Charlotte, North Carolina 28232
Telephone 704/376-7072
Fax 704/376-4465

Hobbs, Upchurch & Associates, P.A.
Consulting Engineers, Surveyors & Land Planners
Southern Pines, North Carolina 28387
300 S.W. Broad Street, Southern Pines, North Carolina 28387
Phone: (910) 692-5616 - Fax: (910) 692-7342

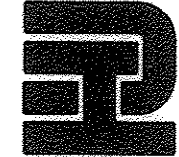

ONE-LINE POWER DIAGRAM
MODIFICATIONS AND
ADDITIONS
PHASE II OF WORK

PERRY ROAD WATER
BOOSTER PUMP STATION
UPGRADE
GRAND STRAND WATER &
SEWER AUTHORITY

DATE:	9-5-2008
DESIGNED:	DL
DRAWN:	SMI
CHECKED:	DL
SCALE:	AS SHOWN

SHEET NO.
E-5

AS-BUILT 9-5-08

OF 15 VERSION: 4


17-250-020/36 W

12-250-021/36W

REVISIONS			
SYM.	DESCRIPTION	DATE	BY

McCracken & Lopez, P.A.
Consulting Engineers
 1300 Baxter Street, Suite 350
 Charlotte, North Carolina 28204
 Post Office Box 32515
 Charlotte, North Carolina 28232
 Telephone 704/376-7072
 Fax 704/376-4465

Hobbs, Upchurch & Associates, P.A.
Consulting Engineers, Surveyors & Land Planners
 Southern Pines, North Carolina 28387
 300 S.W. Broad Street, Southern Pines, North Carolina 28387
 Phone: (910) 692-5616 - Fax: (910) 692-7342

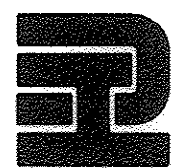

**EXISTING POWER
 PLAN - DEMOLITION**


**PERRY ROAD WATER
 BOOSTER PUMP STATION
 UPGRADE
 GRAND STRAND WATER &
 SEWER AUTHORITY**

DATE:	9-5-2008
DESIGNED:	DL
DRAWN:	SMI
CHECKED:	DL
SCALE:	AS SHOWN

SHEET NO.
E-7

AS-BUILT 9-5-08

OF: 15 VERSION: 4

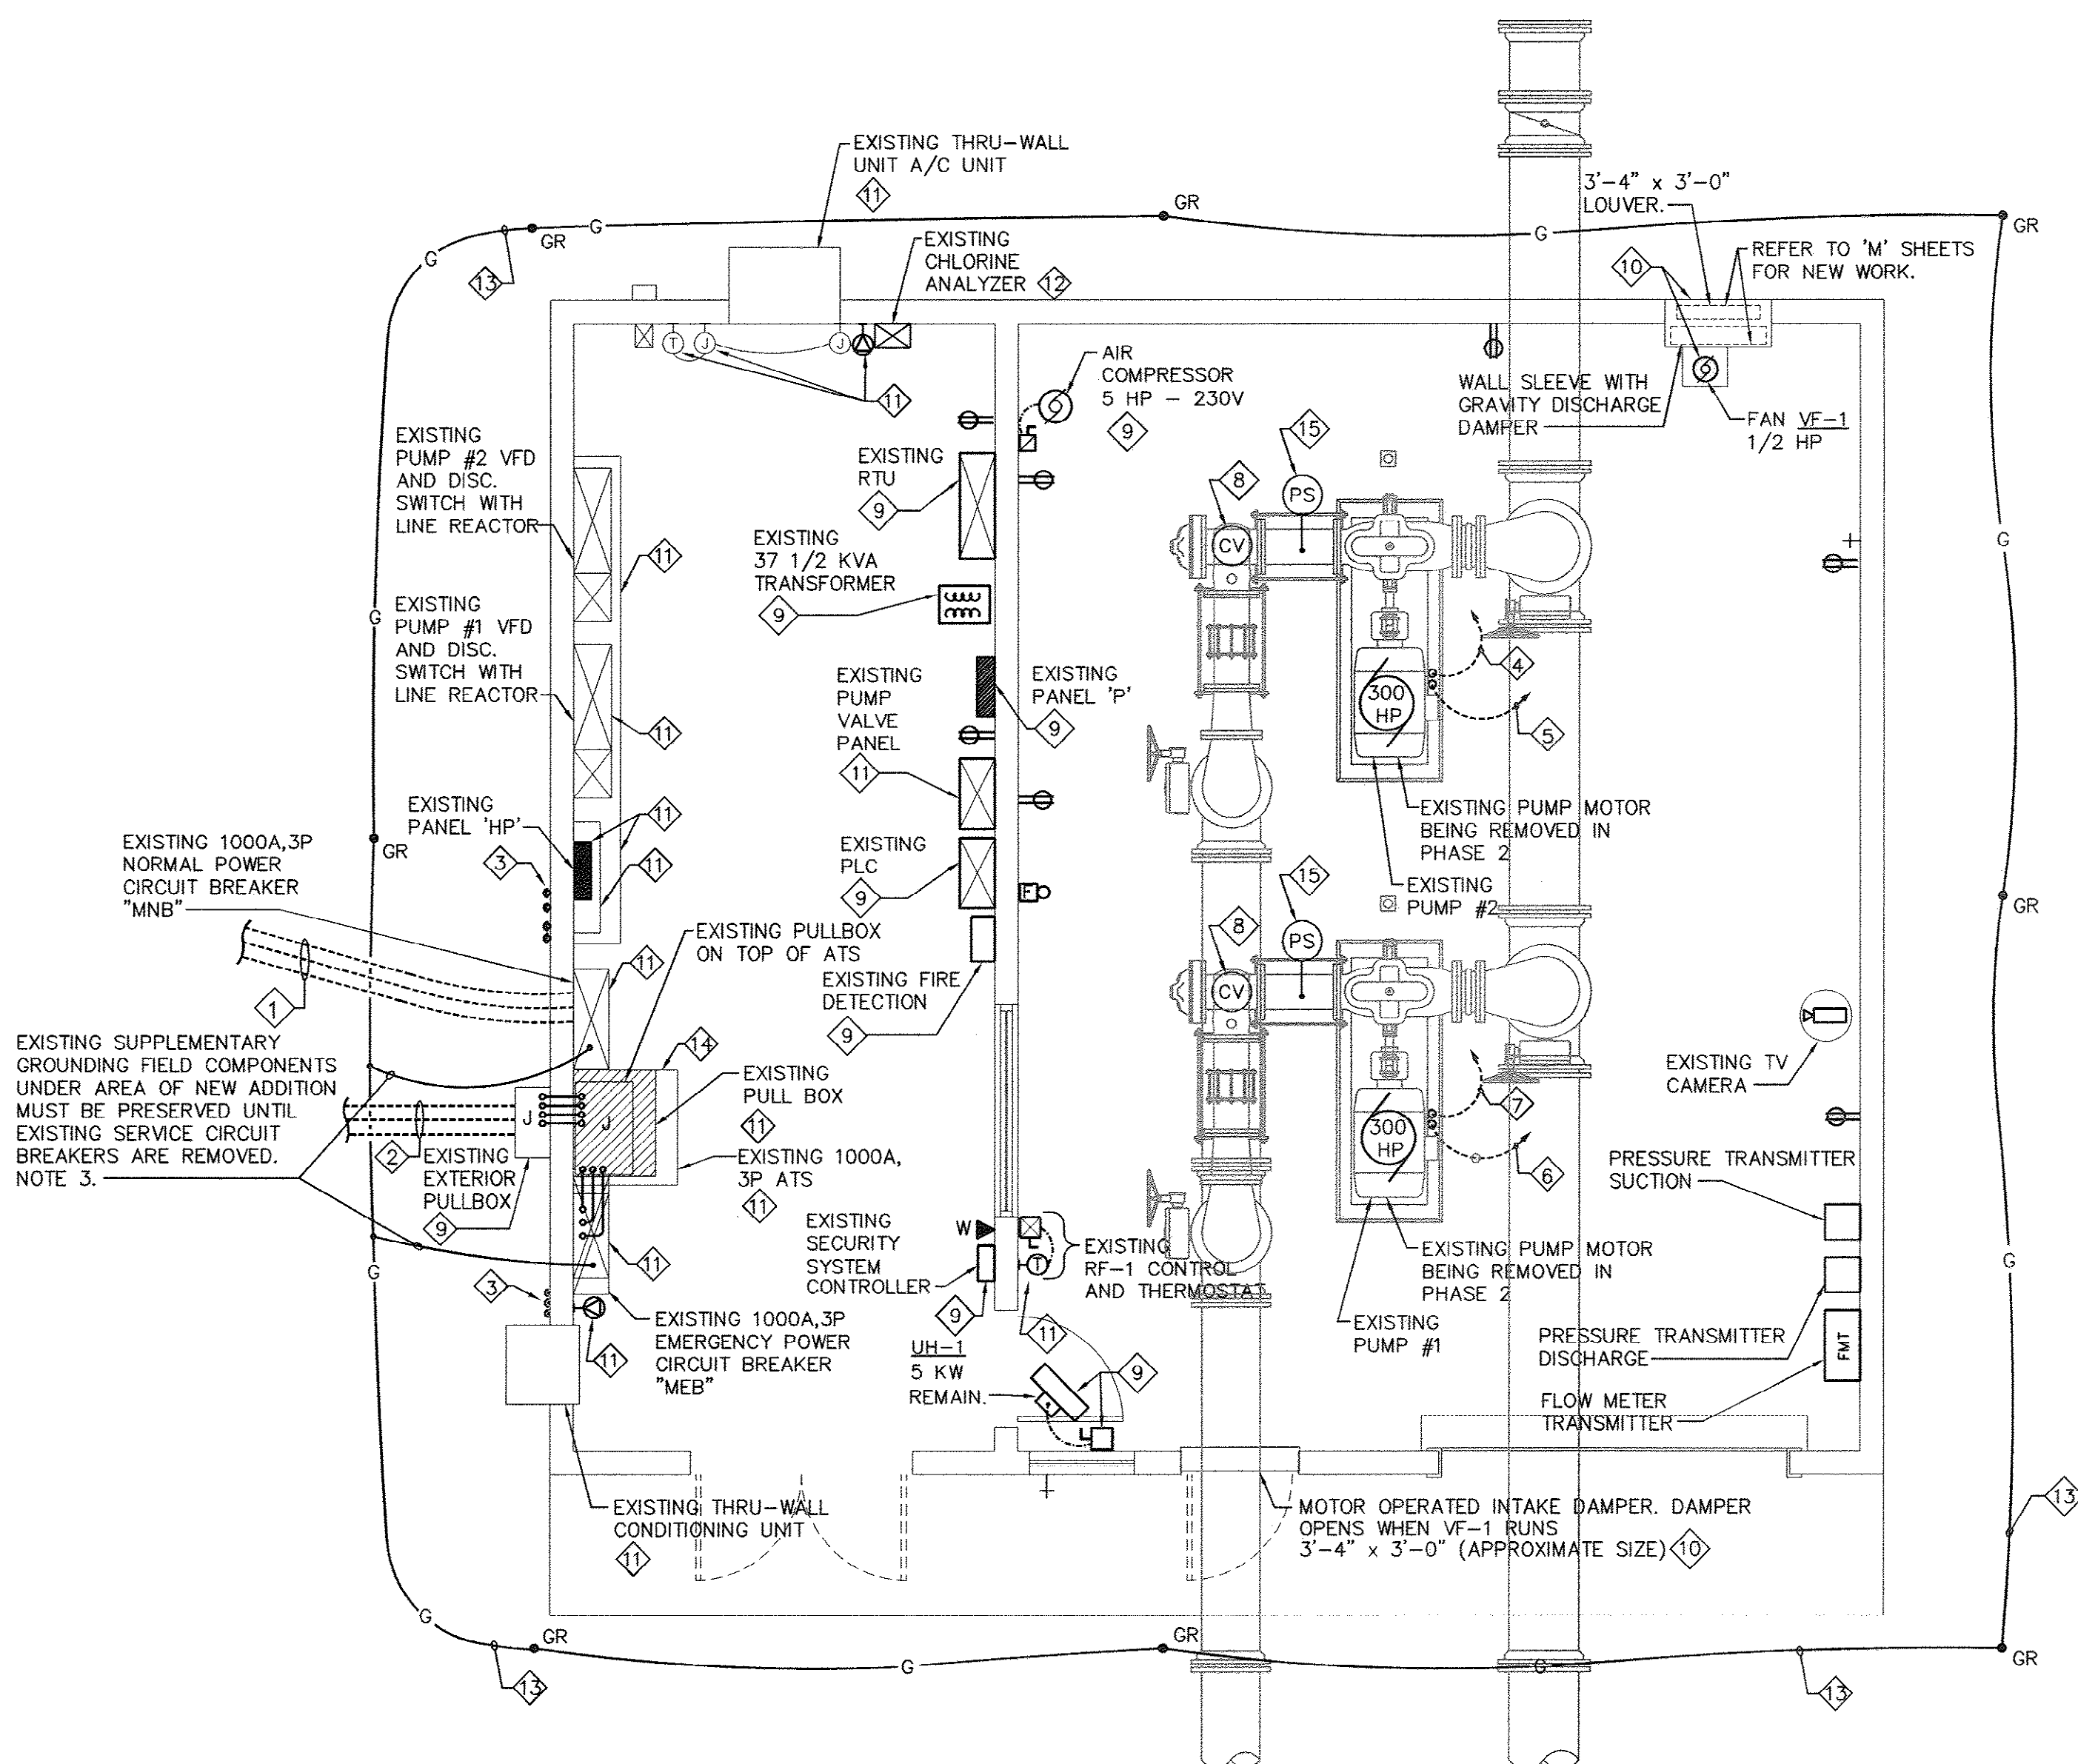

KEYED NOTES:

- 1 EXISTING U.G. SERVICE CONDUITS FROM PAD MOUNTED TRANSFORMER. EXACT LOCATION IS UNKNOWN. REMOVE DURING PHASE 2.
- 2 EXISTING U.G. SERVICE CONDUITS FROM 800 KW EMERGENCY GENERATOR SET. EXACT LOCATION IS UNKNOWN. REMOVE DURING PHASE 2.
- 3 EXISTING PIPING TO BE REMOVED.
- 4 PUMP #2 POWER CONDUIT STUB-UP FROM PUMP VFD. REMOVE CONDUCTORS DURING PHASE 2.
- 5 PUMP MOTOR #2 SAFETY CONDUCTORS FROM PUMP VFD. REMOVE CONDUCTORS DURING PHASE 2.
- 6 PUMP #1 POWER CONDUIT STUB-UP FROM PUMP VFD. REMOVE CONDUCTORS DURING PHASE 2.
- 7 PUMP MOTOR #1 SAFETY CONDUCTORS FROM PUMP VFD. REMOVE CONDUCTORS DURING PHASE 2.
- 8 EXISTING ELECTRICALLY ASSISTED PUMP CHECK VALVE - REMAIN.
- 9 EXISTING ITEM - REMAIN.
- 10 REMOVE THIS ITEM DURING PHASE 1.
- 11 REMOVE THIS ITEM DURING PHASE 2.
- 12 RELOCATE CHLORINE ANALYZER AND RELATED WIRING DURING PHASE 2.
- 13 APPROXIMATE LOCATION OF EXISTING SUPPLEMENTARY GROUNDING FIELD. REFER TO SHEET E-8 FOR MODIFICATIONS.
- 14 REMOVE EXISTING EQUIPMENT PAD DURING PHASE 2 AND BUILD NEW CONCRETE PAD FOR VFD FOR 700 HP PUMP #3 MOTOR. REFER TO DETAIL ON SHEET E-12.
- 15 EXISTING PRESSURE SWITCHES SHALL BE REPLACED WITH NEW MATCHING ONES, EXCEPT WITH 2-POLE CONTACTS, UNDER PHASE 2.

EXISTING BOOSTER PUMP STATION POWER PLAN - EXISTING CONDITIONS/DEMOLITION


SCALE: 3/8"=1'-0"



NOTES:

1. EXISTING ITEMS AND RELATED POWER AND CONTROLS CIRCUITS REMAIN EXCEPT AS OTHERWISE NOTED.
2. REFER TO SHEET E-11 FOR LIGHTING, FIRE ALARM AND DOOR MONITORING.
3. ALL EXISTING GROUNDING ELECTRODES AND GROUNDING ELECTRODE CONDUCTORS SHALL BE PRESERVED AND MAINTAINED DURING CONSTRUCTION AND LEFT IN PROPER CONDITION IN ACCORDANCE WITH NEC RULES.
4. INFORMATION SHOWN HERE ARE BASED ON INFORMATION CONTAINED IN ORIGINAL CONSTRUCTION BID DOCUMENTS AND IT IS NOT NECESSARILY CORRECT. BIDDER SHALL PERFORM FIELD VISIT PRIOR TO BID TO CHECK VERIFIABLE CONDITIONS AND SHALL INCLUDE IN BID THE COST OF PERFORMING WORK BASED ON EXISTING CONDITIONS.
5. CONTRACTOR SHALL PERFORM A SUBSOIL CONDUIT AND WIRING SURVEY TO PINPOINT LOCATION OF EXISTING UNDERGROUND CIRCUITS PRIOR TO STARTING ANY CONSTRUCTION.

12-250-022/36 W

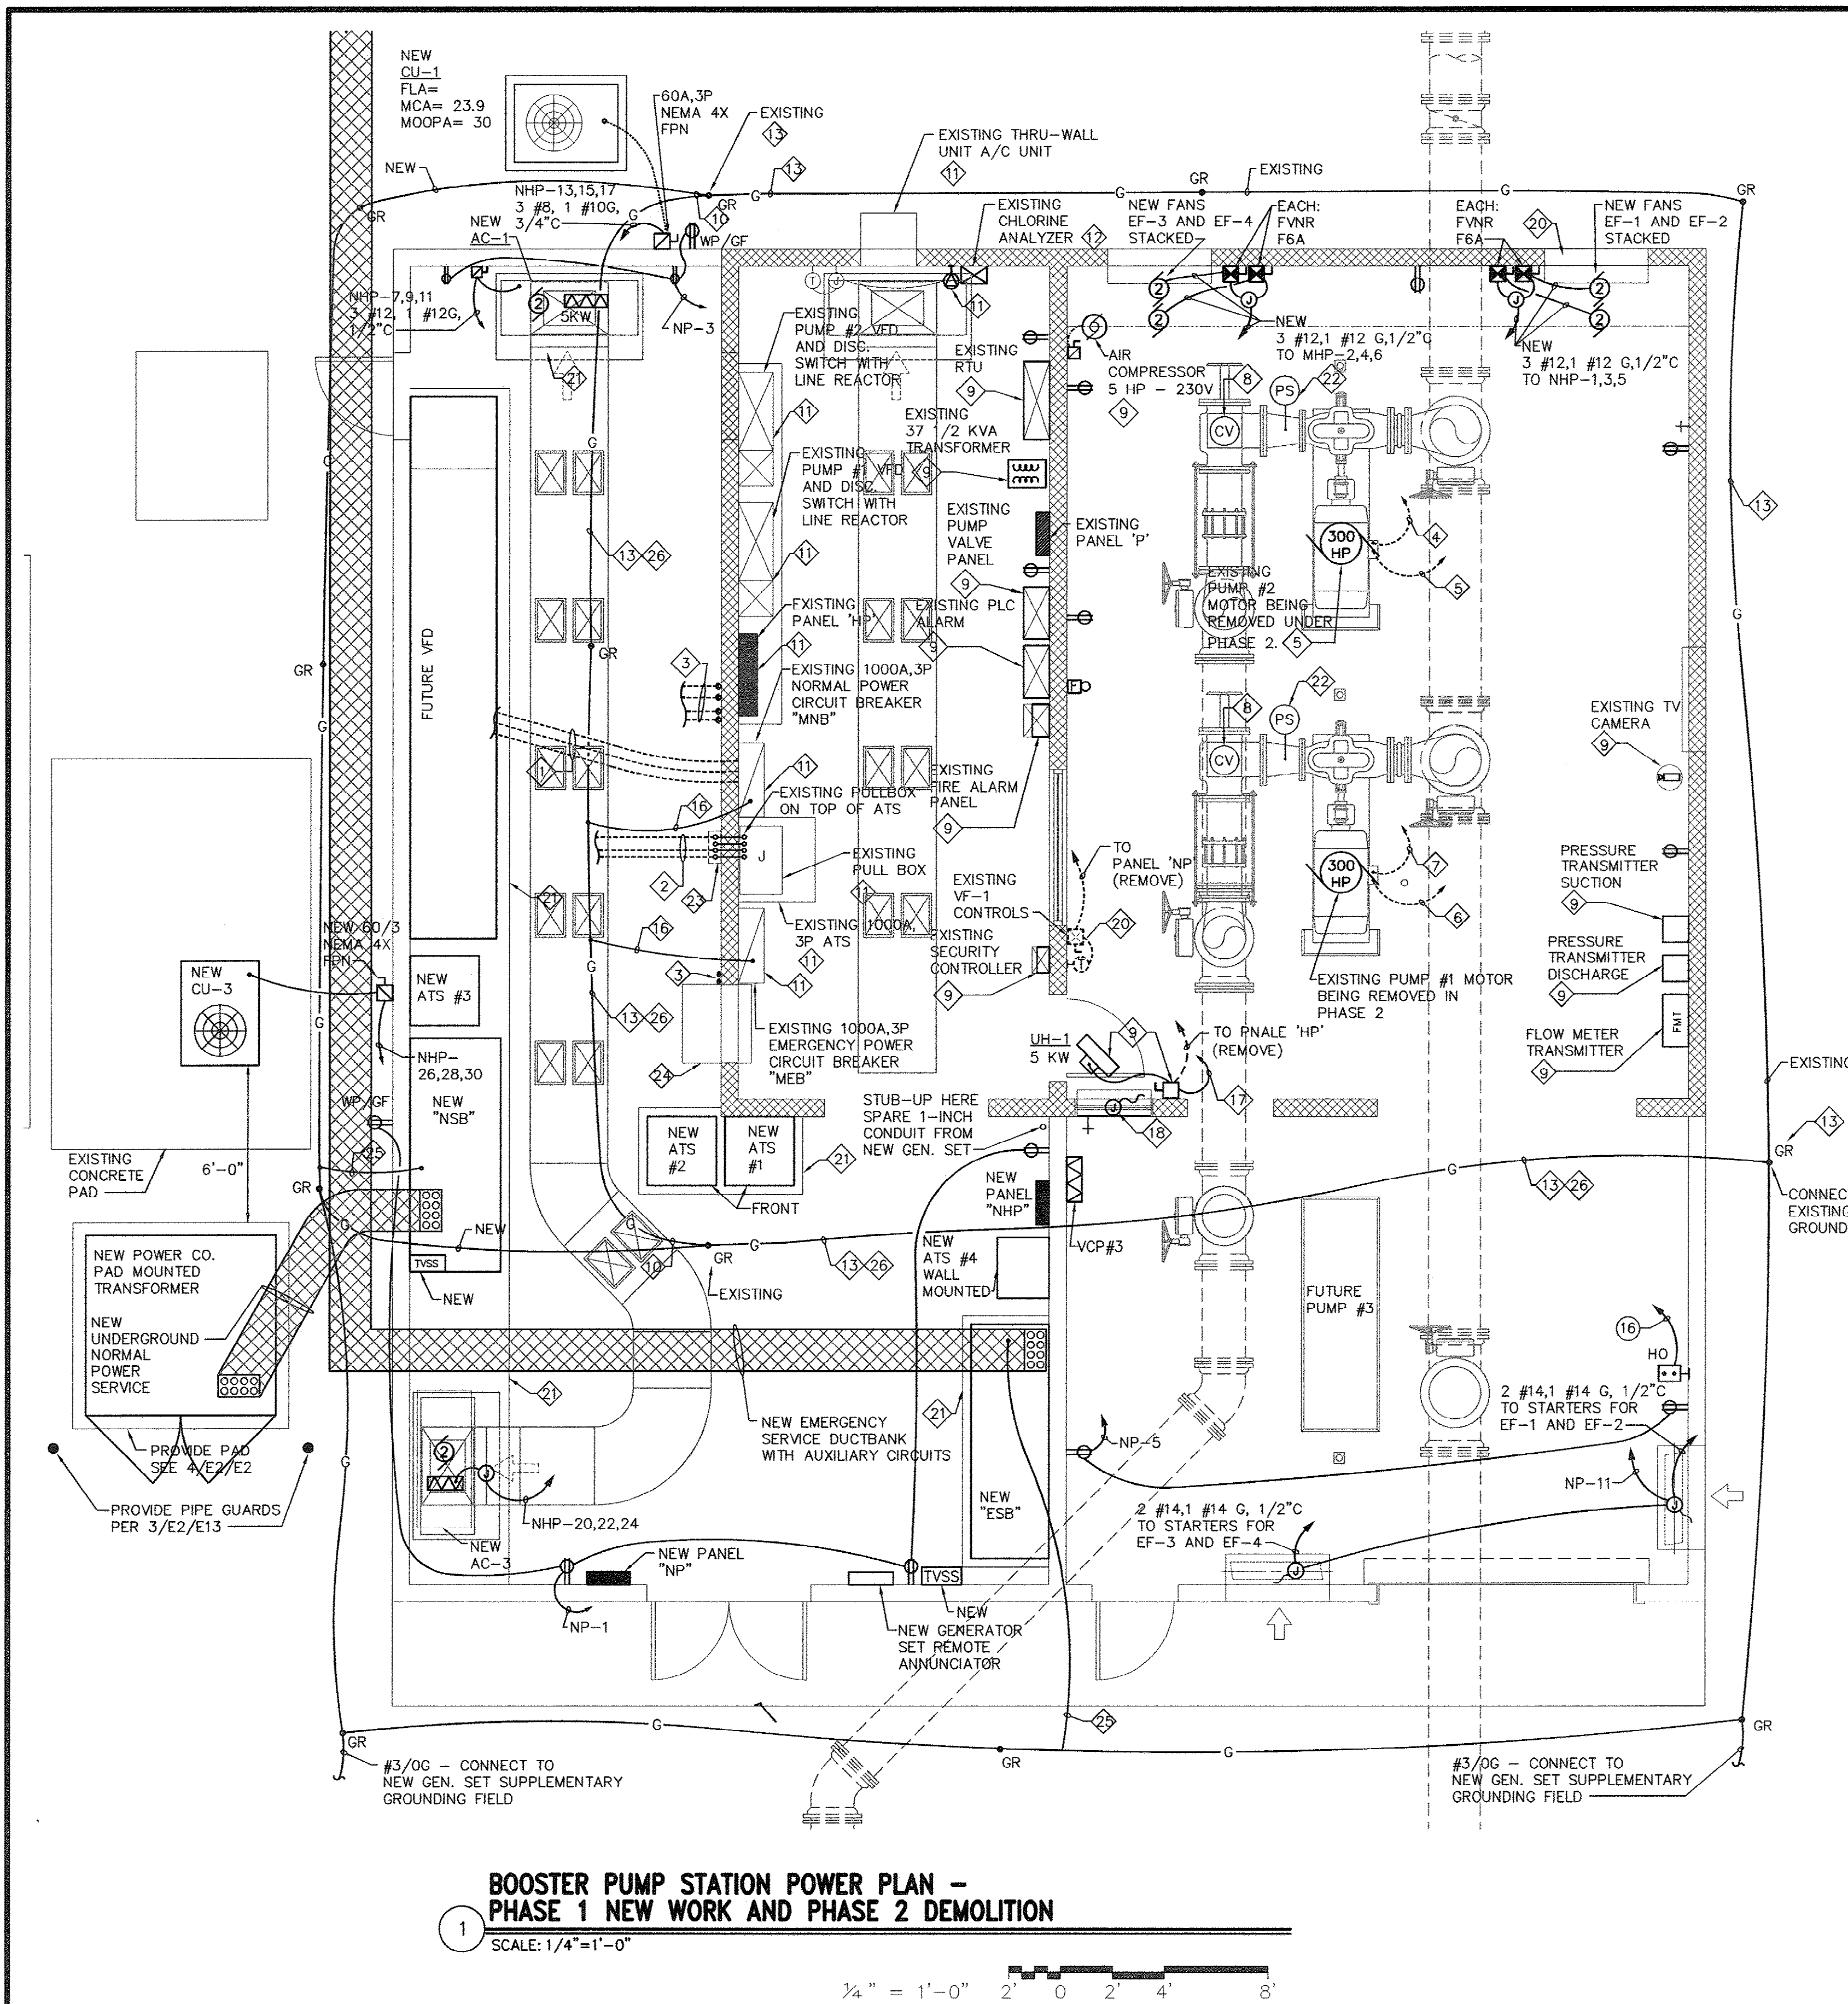

**BOOSTER PUMP STATION POWER PLAN -
PHASE 1 NEW WORK AND PHASE 2 DEMOLITION**

SCALE: 1/4" = 1'-0"

1/4" = 1'-0" 2' 0' 2' 4' 8'

NOTES:

A. CONNECT NEW VFD'S FROM OVERHEAD FOR BOTH INPUT AND OUTPUT WIRING. REFER TO ONE-LINE POWER DIAGRAM.

KEYED NOTES:

- 1 EXISTING U.G. SERVICE CONDUITS FROM PAD MOUNTED TRANSFORMER. EXACT LOCATION IS UNKNOWN. REMOVE DURING PHASE 2.
- 2 EXISTING U.G. SERVICE CONDUITS FROM 800 KW EMERGENCY GENERATOR SET. EXACT LOCATION IS UNKNOWN. REMOVE ALONG WITH EXTERIOR PULL BOX DURING PHASE 2.
- 3 EXISTING PIPE TO BE REMOVED DURING PHASE 2.
- 4 PUMP #2 POWER CONDUIT STUB-UP FROM PUMP VFD. REMOVE CONDUCTORS DURING PHASE 2.
- 5 PUMP MOTOR #2 SAFETY CONDUCTORS FROM PUMP VFD. REMOVE CONDUCTORS DURING PHASE 2.
- 6 PUMP #1 POWER CONDUIT STUB-UP FROM PUMP VFD. REMOVE CONDUCTORS DURING PHASE 2.
- 7 PUMP MOTOR #1 SAFETY CONDUCTORS FROM PUMP VFD. REMOVE CONDUCTORS DURING PHASE 2.
- 8 REMOVE EXISTING CABLES AND PROVIDE RECEPTACLES.
- 9 EXISTING ITEM - REMAIN.
- 10 CONNECT NEW SUPPLEMENTARY GROUNDING FIELD CONDUCTOR TO EXISTING GROUND ROD.
- 11 REMOVE THIS ITEM DURING PHASE 2.
- 12 RELOCATE CHLORINE ANALYZER AND RELATED WIRING DURING PHASE 2.
- 13 APPROXIMATE LOCATION OF EXISTING SUPPLEMENTARY GROUNDING FIELD.
- 14 #3/0 G. TO "NSB" AND "ESB".
- 15 PROVIDE SUITABLE GROUNDING FITTING AND BOND WATERPIPE.
- 16 EXISTING GROUNDING CABLE TO REMAIN UNTIL EQUIPMENT IS REMOVED UNDER PHASE 2.
- 17 REMOVE UNIT HEATER BRANCH CIRCUIT FROM EXISTING PANEL AND CONNECT IT TO NEW PANEL "NHP".
- 18 REMOVE 120V CONNECTION TO EXISTING DAMPER.
- 19 PROVIDE MOTOR BOX TERMINAL EXTENSION AS REQUIRED TO ACCOMPLISH MOTOR POWER AND CONTROL CONNECTION.
- 20 REMOVE EXISTING FAN VF-1 AND RELATED WIRING AND CONTROLS.
- 21 PROVIDE NEW 4-INCH CONCRETE PAD.
- 22 EXISTING PRESSURE SWITCH - REPLACE DURING PHASE 2 WITH A SIMILAR ONE WITH TWO POLE CONTACTS (TWO SETS OF CONTACTS).
- 23 EXISTING OUTDOOR PULL BOX, REMOVE DURING PHASE 2.
- 24 EXISTING THROUGH THE WALL A/C UNIT - REMOVE DURING PHASE 2.
- 25 NEW #3/0 G, 3/4"
- 26 MAINTAIN EXISTING SUPPLEMENTARY GROUNDING FIELD CONDUCTORS AND GROUNDING RODS DURING CONSTRUCTION OF ADDITION.
- 27 NEW PUMP/VALVE CONTROL PANEL.

LEGEND OF POWER CONTROL MONITORING WIRING BETWEEN PUMP CHECK VALVE, PUMP/VALVE CONTROL PANEL, RTU AND PUMP VFD


- 1 2 #14, 1 #14G - IN CONDUIT BETWEEN CHECK VALVE EMERGENCY SOLENOID PILOT VALVE AND PUMP CONTROL PANEL "VCP".
- 2 2 #14, 1 #14G - IN CONDUIT BETWEEN CHECK VALVE NORMAL SOLENOID PILOT VALVE AND PUMP CONTROL PANEL "VCP".
- 3 3 #14, 4 #14 SPARE, 1 #14G IN CONDUIT BETWEEN CHECK VALVE ZONE INDICATING SWITCH ("ZIS") AND RTU FOR VALVE POSITION INDICATION.
- 4 4 #14, 1 #14G IN CONDUIT BETWEEN CHECK VALVE ZONE INDICATING SWITCH AND "VCP".
- 5 2 #14, 4 #14 SPARE, 1 #14G IN CONDUIT BETWEEN "VCP" AND VFD FOR PUMP MOTOR RUN COMMAND.
- 6 2 #14, 2 #14 SPARE, 1 #14G IN CONDUIT BETWEEN "VCP" AND RTU FOR "COMMON" ALARM (VALVE FAILURE, POWER FAILURE, PUMP FAILURE).
- 7 2 #14, 1 #14G IN CONDUIT BETWEEN PRESSURE SWITCH AT DISCHARGE SIDE OF PUMP AND "VCP".
- 8 2 #14, 2 #14 SPARE, 1 #14G IN CONDUIT BETWEEN RTU AND "VCP" FOR RUN COMMAND FROM RTU.
- 9 2 #14, 6 #14 SPARE, 1 #14G BETWEEN PUMP MOTOR VFD AND MOTOR FOR 120-VOLT MOTOR ENVIRONMENTAL HEATER, IF ANY.
- 10 SIX(6) 4-CONDUCTORS #16, SHIELDED CABLES, BELDEN #83704 FROM VFD TO MOTOR FOR HIGH TEMPERATURE AND VIBRATION PROTECTION SYSTEM.
- 11 16 #14, 1 #14G IN 3/4" BETWEEN EACH VFD AND RTU.
- 12 SIX - SC CABLES - 1" BETWEEN EACH VFD AND RTU.
- 13 2 #14, 1 #14 G BETWEEN PRESSURE SWITCH AND RTU FOR REMOTE WATER FLOW SIGNAL.
- 14 SPARE 3/4" WITH PULL CORD.
- 15 POWER CIRCUIT FROM 700 PH MOTOR TO RESPECTIVE VFD: 4(3-350 MCM, 1 #4/0 G, 3"C).
- 16 2 #14, 1 #14 G FROM "H-O" PUSHBUTTON STATION TO VFD.
- 17 POWER CIRCUIT FROM 700 PH MOTOR TO RESPECTIVE VFD: 4(3-350 MCM, 1 #4/0 G, 3"C).
- 18 120V, 60 HZ, CONTROL POWER CIRCUIT TO PANEL "NP" - 2 #12, 1 #12 G, 1/2"

REVISIONS			
SYM.	DESCRIPTION	DATE	BY

McCracken & Lopez, P.A.
Consulting Engineers

1300 Baxter Street, Suite 350
Charlotte, North Carolina 28204
Post Office Box 32515
Charlotte, North Carolina 28232
Telephone 704/376-7072
Fax 704/376-4465

Hobbs, Upchurch & Associates, P.A.
Consulting Engineers, Surveyors & Land Planners
Southern Pines, North Carolina 28387
300 S.W. Broad Street, Southern Pines, North Carolina 28387
Phone: (910) 692-5616 - Fax: (910) 692-7342

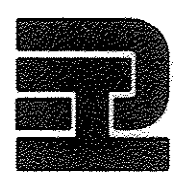

**NEW BOOSTER PUMP
STATION POWER PLAN
PHASE 1 NEW WORK
AND PHASE 2 DEMOLITION**


**PERRY ROAD WATER
BOOSTER PUMP STATION
UPGRADE
GRAND STRAND WATER &
SEWER AUTHORITY**

DATE:	9-5-2008
DESIGNED:	DL
DRAWN:	SMI
CHECKED:	DL
SCALE:	AS SHOWN
SHEET NO.	E-8

AS-BUILT 9-5-08

OF: 15 VERSION: 4

12-250-023/36 W

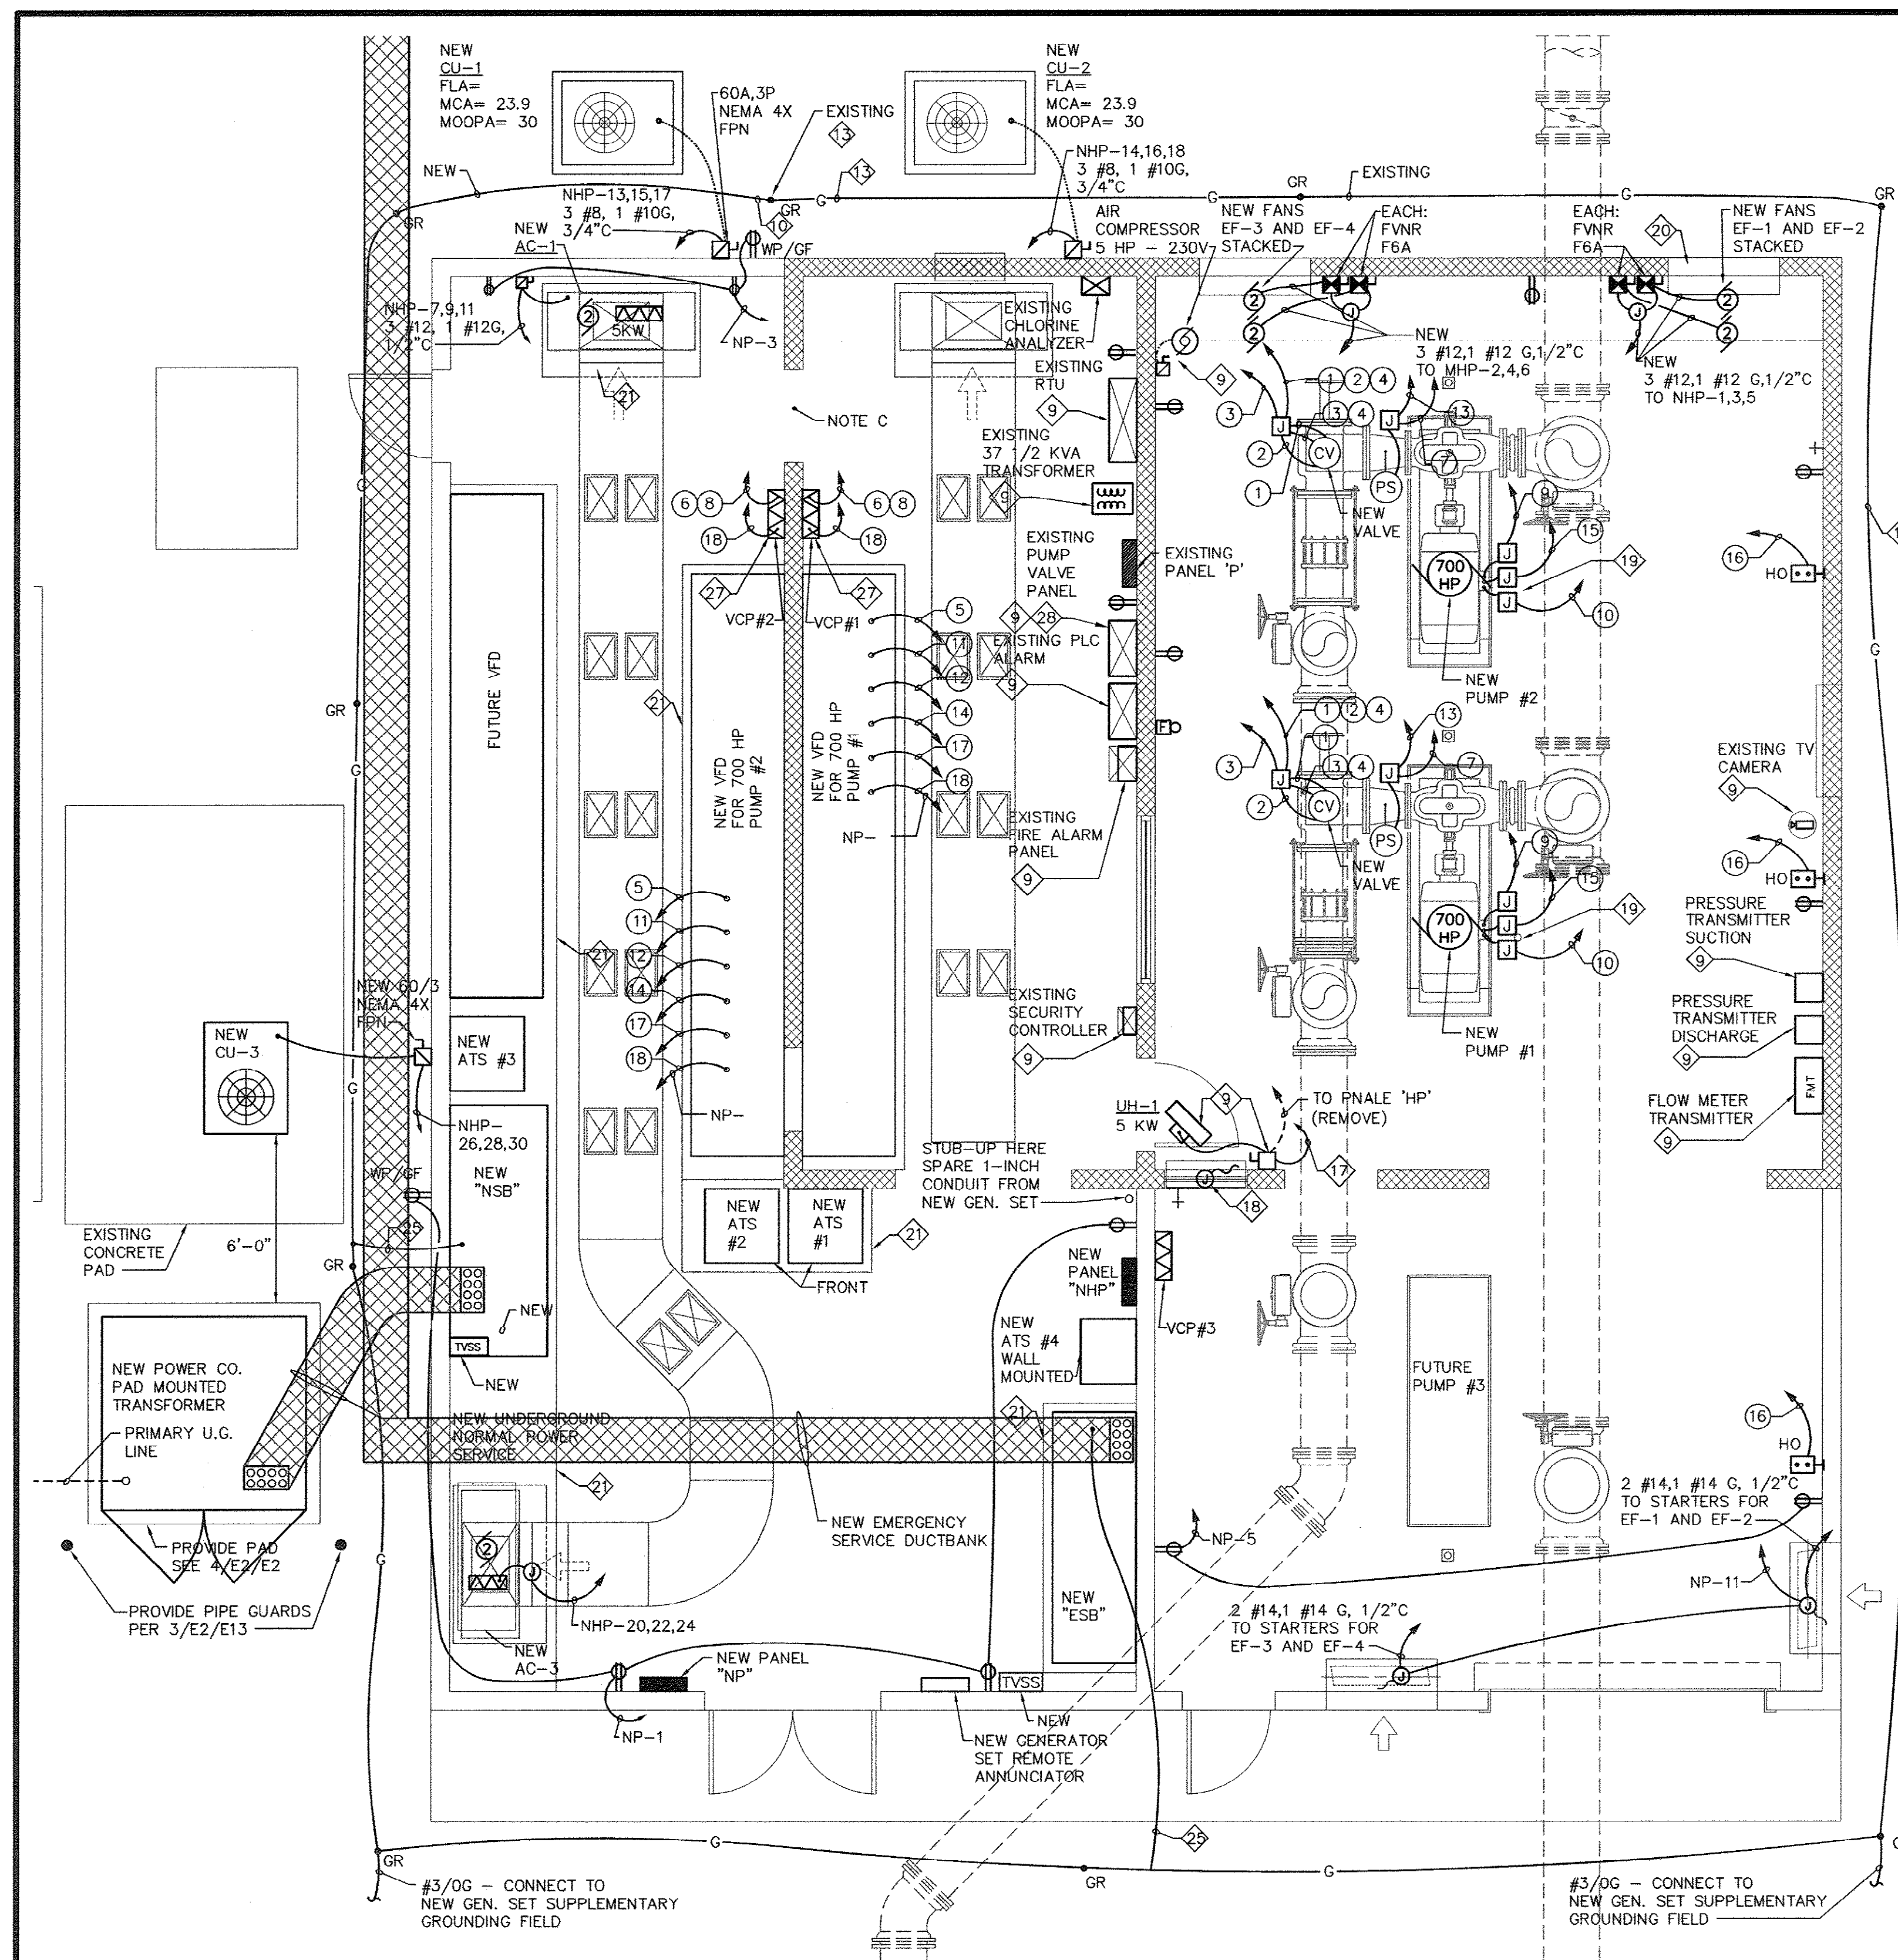

BOOSTER PUMP STATION POWER PLAN - PHASE 2 NEW WORK

SCALE: 1/4"=1'-0"

1/4" = 1'-0" 2' 0' 2' 4' 8'

- NOTES:
- CONNECT NEW VFD'S FROM OVERHEAD FOR BOTH INPUT AND OUTPUT WIRING. REFER TO ONE-LINE POWER DIAGRAM.
 - EXACT LOCATION OF ROUGH-IN POINT FOR VFD'S AND MOTORS SHALL BE ADJUSTED IN ACCORDANCE WITH EQUIPMENT SUBMITTED.
 - CUT NEW OPENING IN EXISTING WALL PRIOR TO INSTALLING NEW EQUIPMENT. PROVIDE DUST BARRIER AT BOTH SIDES OF OPENING TO AVOID DUCT CONTAMINATION OF NEW AND EXISTING EQUIPMENT.

KEYED NOTES:

- NOT APPLICABLE
- NOT APPLICABLE
- EXISTING ITEM - REMAIN.
- NOT APPLICABLE
- NOT APPLICABLE
- NOT APPLICABLE
- APPROXIMATE LOCATION OF EXISTING SUPPLEMENTARY GROUNDING FIELD.
- #3/0 G. TO "NSB" AND "ESB".
- PROVIDE SUITABLE GROUNDING FITTING AND BOND WATERPIPE.
- NOT APPLICABLE
- NOT APPLICABLE
- NOT APPLICABLE
- PROVIDE MOTOR BOX TERMINAL EXTENSION AS REQUIRED TO ACCOMPLISH MOTOR POWER AND CONTROL CONNECTION.
- NOT APPLICABLE
- PROVIDE NEW 4-INCH CONCRETE PAD.
- EXISTING PRESSURE SWITCH - REPLACE DURING PHASE 2 WITH A SIMILAR ONE WITH DOUG POLE CONTACTS (TWO SETS OF CONTACTS).
- NOT APPLICABLE
- NOT APPLICABLE
- NEW PUMP/VALVE CONTROL PANEL.
- EXISTING PUMP VALVE PANEL SHALL BE REMOVED ONCE THE NEW VALVES AND PUMP VALVE PANELS FOR EXISTING PUMPS #1 AND #2 ARE INSTALLED. REMOVE ALL WIRING RELATED TO THIS PANEL THAT IS NO LONGER NEEDED.

LEGEND OF POWER CONTROL MONITORING WIRING BETWEEN PUMP CHECK VALVE, PUMP/VALVE CONTROL PANEL, RTU AND PUMP VFD


- 2 #14, 1 #14G - IN CONDUIT BETWEEN CHECK VALVE EMERGENCY SOLENOID PILOT VALVE AND PUMP CONTROL PANEL "VCP".
- 2 #14, 1 #14G - IN CONDUIT BETWEEN CHECK VALVE NORMAL SOLENOID PILOT VALVE AND PUMP CONTROL PANEL "VCP".
- 3 #14, 4 #14 SPARE, 1 #14G IN CONDUIT BETWEEN CHECK VALVE ZONE INDICATING SWITCH ("ZIS") AND RTU FOR VALVE POSITION INDICATION.
- 4 #14, 1 #14G IN CONDUIT BETWEEN CHECK VALVE ZONE INICATING SWITCH AND "VCP".
- 2 #14, 4 #14 SPARE, 1 #14G IN CONDUIT BETWEEN "VCP" AND VFD FOR PUMP MOTOR RUN COMMAND.
- 2 #14, 2 #14 SPARE, 1 #14G IN CONDUIT BETWEEN "VCP" AND RTU FOR "COMMON" ALARM (VALVE FAILURE, POWER FAILURE, PUMP FAILURE).
- 2 #14, 1 #14G IN CONDUIT BETWEEN PRESSURE SWITCH AT DISCHARGE SIDE OF PUMP AND "VCP".
- 2 #14, 2 #14 SPARE, 1 #14G IN CONDUIT BETWEEN RTU AND "VCP" FOR RUN COMMAND FROM RTU.
- 2 #14, 6 #14 SPARE, 1 #14G BETWEEN PUMP MOTOR VFD AND MOTOR FOR 120-VOLT MOTOR ENVIRONMENTAL HEATER, IF ANY.
- SIX(6) 4-CONDUCTORS #16, SHIELDED CABLES, BELDEN #83704 FROM VFD TO MOTOR FOR HIGH TEMPERATURE AND VIBRATION PROTECTION SYSTEM.
- 16 #14, 1 #14G IN 3/4" BETWEEN EACH VFD AND RTU.
- SIX - SC CABLES - 1" BETWEEN EACH VFD AND RTU.
- 2 #14, 1 #14 G BETWEEN PRESSURE SWITCH AND RTU FOR REMOTE WATER FLOW SIGNAL.
- SPARE 3/4" WITH PULL CORD.
- POWER CIRCUIT FROM 700 PH MOTOR TO RESPECTIVE VFD: 4(3-350 MCM, 1 #4/0 G, 3"C).
- 2 #14, 1 #14 G FROM "H-O" PUSHBUTTON STATION TO VFD.
- POWER CIRCUIT FROM 700 PH MOTOR TO RESPECTIVE VFD: 4(3-350 MCM, 1 #4/0 G, 3"C)
- 120V, 60 HZ, CONTROL POWER CIRCUIT TO PANEL "NP" - 2 #12, 1 #12 G, 1/2"C

REVISIONS			
SYM.	DESCRIPTION	DATE	BY

McCracken & Lopez, P.A.
Consulting Engineers

1300 Baxter Street, Suite 350
Charlotte, North Carolina 28204
Post Office Box 32515
Charlotte, North Carolina 28232
Telephone 704/376-7072
Fax 704/376-4465

Hobbs, Upchurch & Associates, P.A.
Consulting Engineers, Surveyors & Land Planners
Southern Pines, North Carolina 28387
300 S.W. Broad Street, Southern Pines, North Carolina 28387
Phone: (910) 692-5816 - Fax: (910) 692-7542

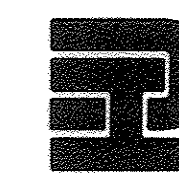

**NEW BOOSTER PUMP
STATION POWER PLAN
PHASE 2 NEW WORK**

**PERRY ROAD WATER
BOOSTER PUMP STATION
UPGRADE
GRAND STRAND WATER &
SEWER AUTHORITY**

DATE: 9-5-2008
DESIGNED: DL
DRAWING: SMI
CHECKED: DL
SCALE: AS SHOWN


SHEET NO.

E-9

AS-BUILT 9-5-08

OF 15 VERSION: 4

12-250-024/36 W

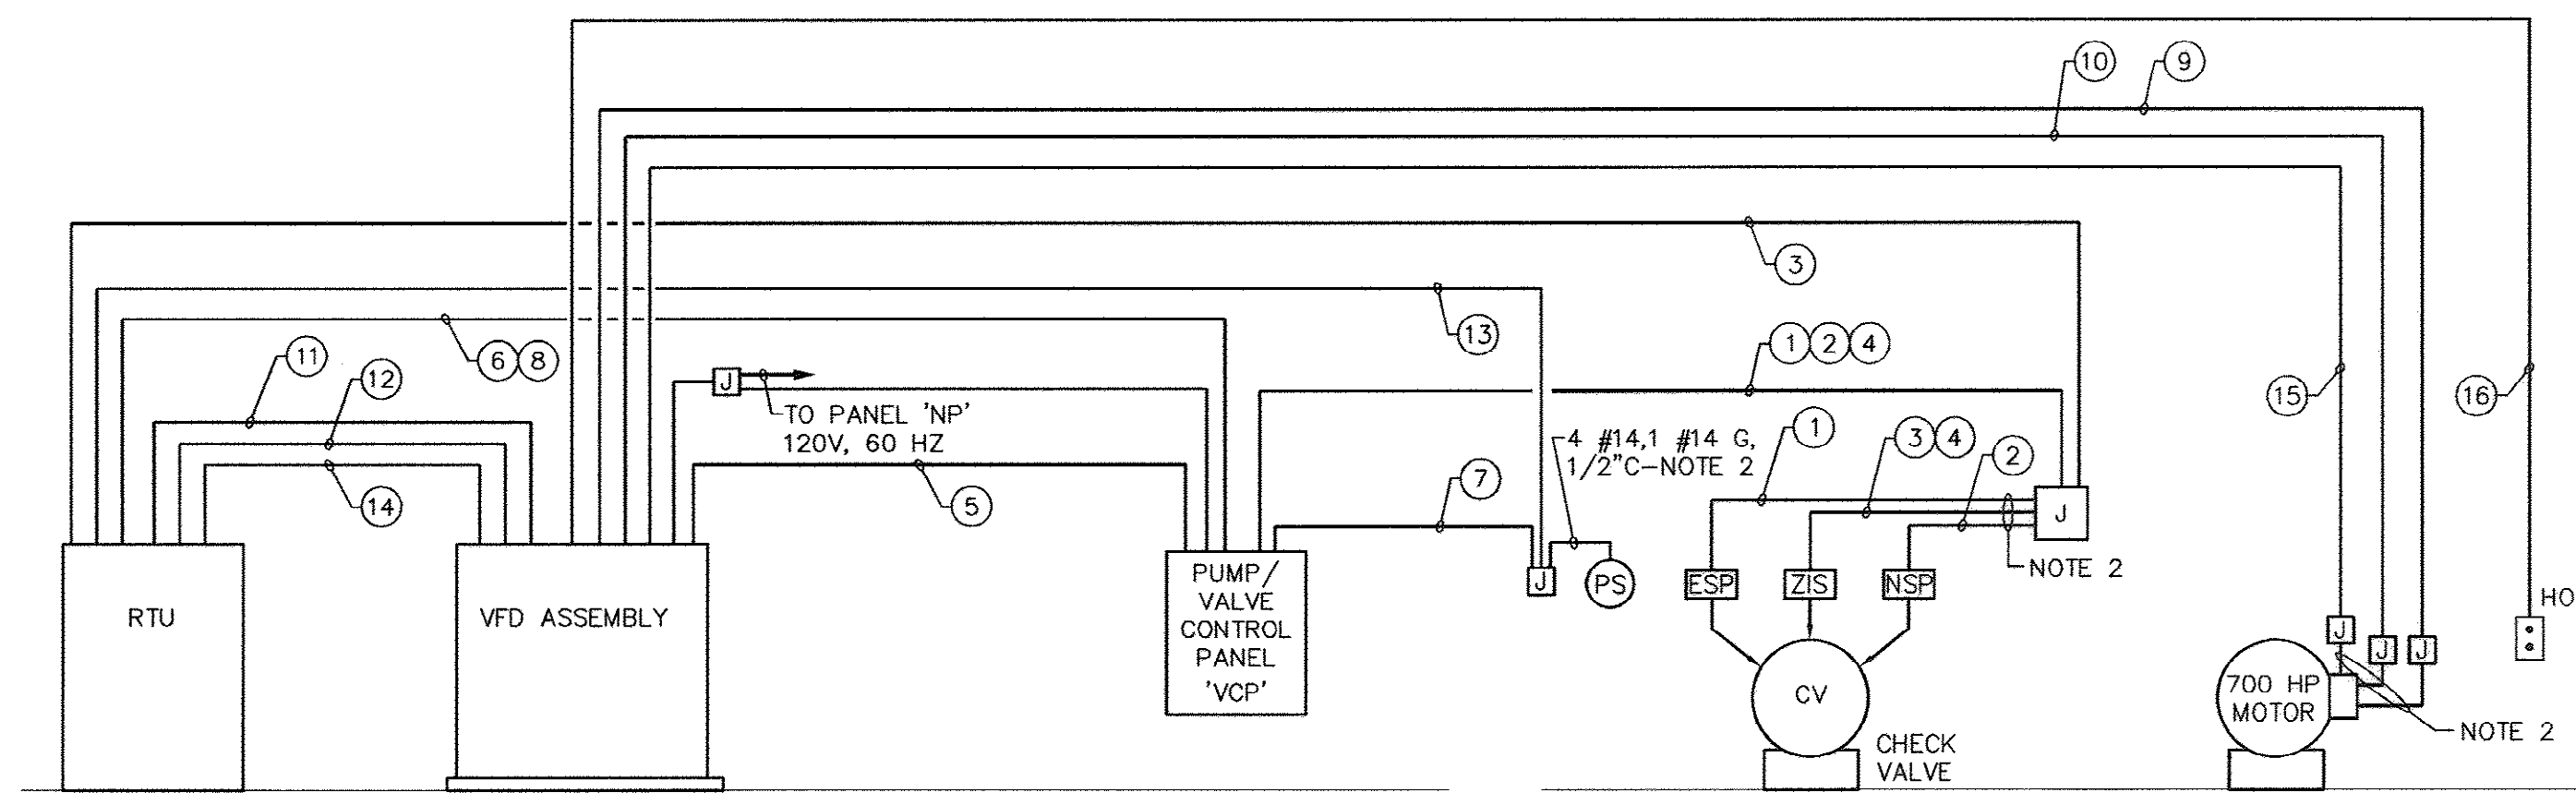


1 TYPICAL PUMP WIRING RISER DIAGRAM

SCALE: NONE


NOTES:

1. WIRING SHALL BE RUN IN 1/2-INCH MINIMUM SIZE CONDUIT, EXCEPT AS OTHERWISE NOTED FOR LARGER CONDUIT.
2. USE LIQUID-TIGHT FLEXIBLE METALLIC CONDUIT FOR FINAL CONNECTION FROM JUNCTION BOX, TO MOTOR OR INSTRUMENT.

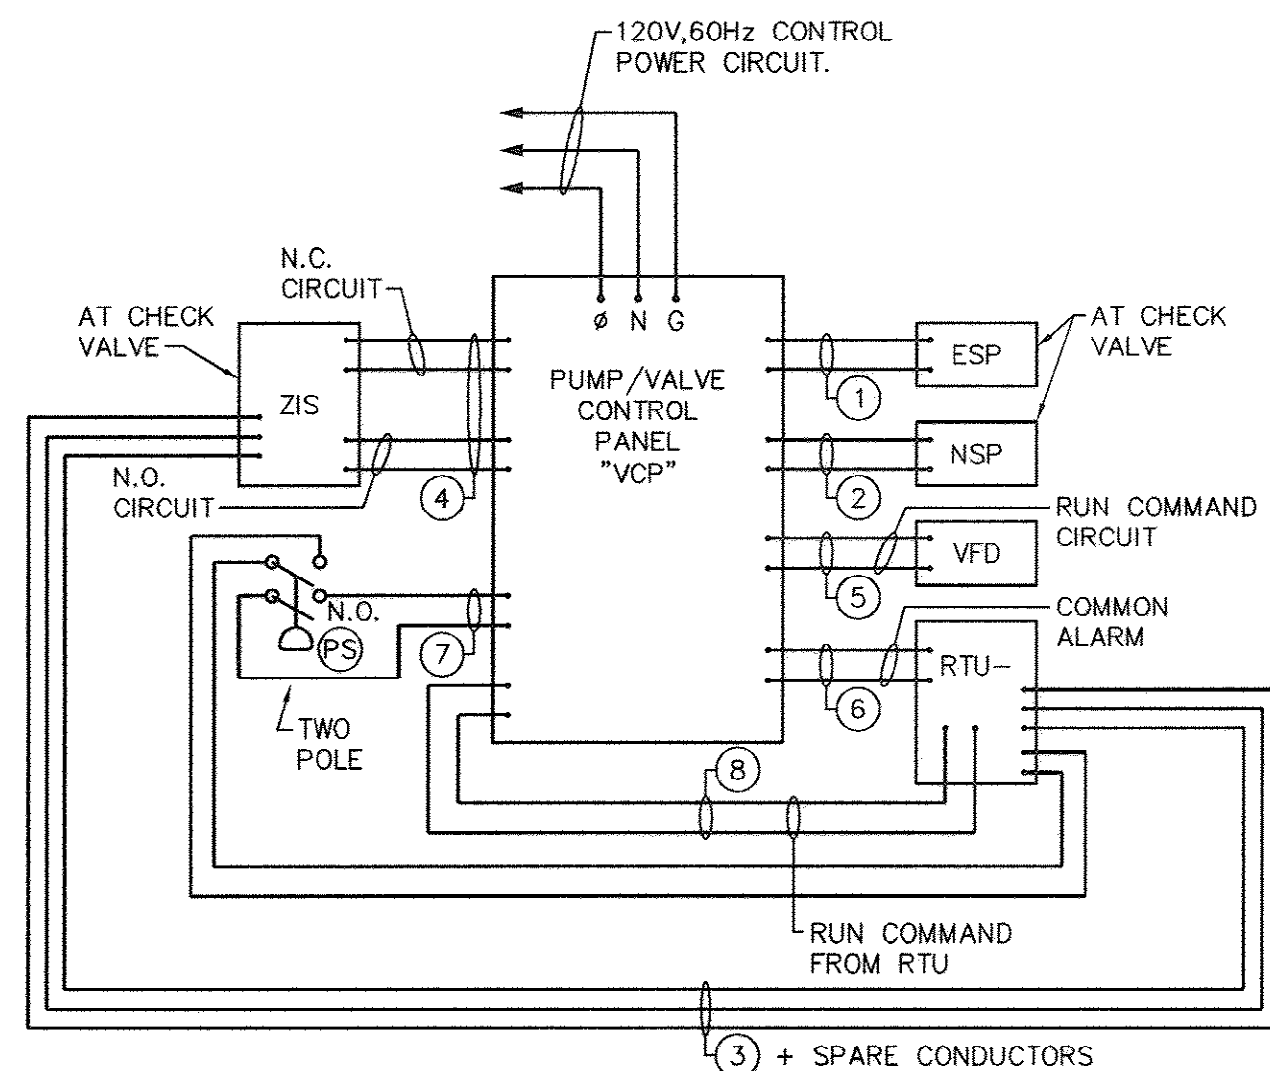


2 TYPICAL PUMP/VALVE CONTROL PANEL "VCP" WIRING DIAGRAM

SCALE: NONE

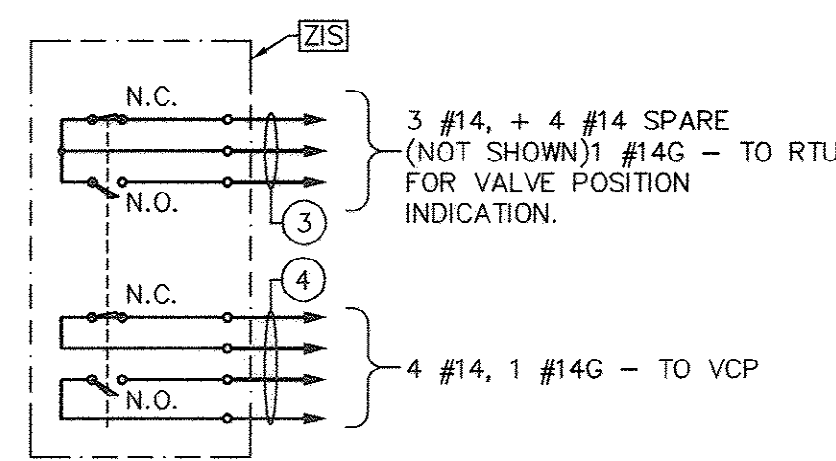

3 TYPICAL "ZIS" CONTROL WIRING DIAGRAM

SCALE: NONE

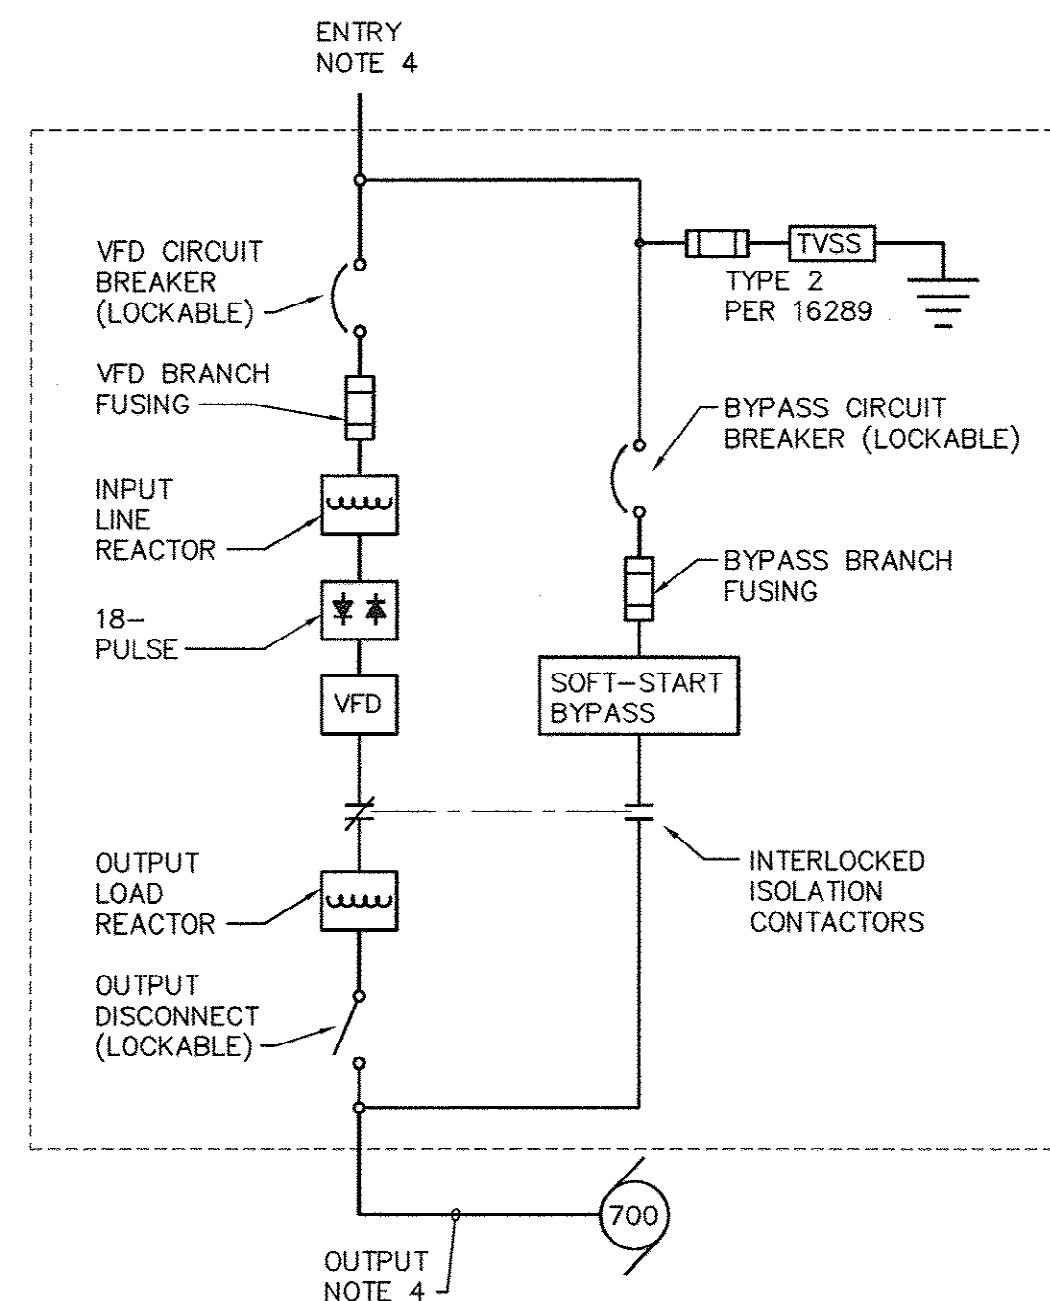

4 TYPICAL ONE-LINE POWER DIAGRAM - VFD ASSEMBLY

SCALE: NONE

NOTES:

1. REFER TO SECTION 16161 FOR ADDITIONAL REQUIREMENTS.
2. CONTENTS WITHIN DASHED LINES ARE INSIDE THE SYSTEM ENCLOSURE.
3. TVSS NOT SHOWN BUT WILL BE INCLUDED IN SYSTEM ENCLOSURE (TYPE 2, PTE160 SERICE PER SECTION 16289).
4. PROPOSED WIRING METHOD FOR MOTORS AND VFD IS BASED ON USING OVERHEAD CONDUIT AND TOP ENTRY/EXIT ROUGHIN FOR VFD. CONTRACTOR SHALL BE RESPONSIBLE FOR ALL VFD COORDINATION MODIFICATIONS, AND COSTS REQUIRED TO ACCOMPLISH BOTTOM ENTRY AND/OR EXIT IF SO DESIRED BY CONTRACTOR.

REVISIONS			
SYM.	DESCRIPTION	DATE	BY

McCracken & Lopez, P.A.
Consulting Engineers
1300 Baxter Street, Suite 350
Charlotte, North Carolina 28204
Post Office Box 32515
Charlotte, North Carolina 28232
Telephone 704/376-7072
Fax 704/376-4465

LEGEND OF CONTROL MONITORING WIRING BETWEEN PUMP CHECK VALVE, PUMP CONTROL PANEL, RTU-FPS2 AND PUMP VFD

- 1 2 #14, 1 #14G - IN CONDUIT BETWEEN CHECK VALVE EMERGENCY SOLENOID PILOT VALVE AND PUMP CONTROL PANEL "VCP".
- 2 2 #14, 1 #14G - IN CONDUIT BETWEEN CHECK VALVE NORMAL SOLENOID PILOT VALVE AND PUMP CONTROL PANEL "VCP".
- 3 #14, 4 #14 SPARE, 1 #14G IN CONDUIT BETWEEN CHECK VALVE ZONE INDICATING SWITCH ("ZIS") AND RTU FOR VALVE POSITION INDICATION.
- 4 #14, 1 #14G IN CONDUIT BETWEEN CHECK VALVE ZONE INICATING SWITCH AND "VCP".
- 5 2 #14, 4 #14 SPARE, 1 #14G IN CONDUIT BETWEEN "VCP" AND VFD FOR PUMP MOTOR RUN COMMAND.
- 6 2 #14, 2 #14 SPARE, 1 #14G IN CONDUIT BETWEEN "VCP" AND RTU FOR "COMMON" ALARM (VALVE FAILURE, POWER FAILURE, PUMP FAILURE).
- 7 2 #14, 1 #14G IN CONDUIT BETWEEN PRESSURE SWITCH AT DISCHARGE SIDE OF PUMP AND "VCP".
- 8 2 #14, 2 #14 SPARE, 1 #14G IN CONDUIT BETWEEN RTU AND "VCP" FOR RUN COMMAND FROM RTU.
- 9 2 #14, 6 #14 SPARE, 1 #14G BETWEEN PUMP MOTOR VFD AND MOTOR FOR 120-VOLT MOTOR ENVIRONMENTAL HEATER, IF ANY.
- 10 SIX(6) 4-CONDUCTORS #16, SHIELDED CABLES, BELDEN #83704 FROM VFD TO MOTOR FOR HIGH TEMPERATURE AND VIBRATION PROTECTION SYSTEM.
- 11 16 #14, 1 #14G IN 3/4" C BETWEEN EACH VFD AND RTU.
- 12 SIX - SC CABLES - 1" C BETWEEN EACH VFD AND RTU.
- 13 2 #14, 1 #14 G BETWEEN PRESSURE SWITCH AND RTU FOR REMOTE WATER FLOW SIGNAL.
- 14 SPARE 3/4" C WITH PULL CORD.
- 15 POWER CIRCUIT FROM 700 PH MOTOR TO RESPECTIVE VFD: 4(3-350 MCM, 1 #4/0 G, 3" C).
- 16 2 #14, 1 #14 G FROM "H-O" PUSHBUTTON STATION TO VFD.

ELECTRICALLY ASSISTED CHECK VALVE SYSTEM COMPONENTS:

- (CV) ELECTRICALLY ASSISTED CHECK VALVE WHICH INCLUDES "NSP", "ESP" AND "ZIS" AS DESCRIBED BELOW.
- (NSP) NORMAL SOLENOID PILOT VALVE, 3-WAY TYPE. REQUIRES ENERGIZATION TO OPEN VALVE.
- (ESP) EMERGENCY SOLENOID PILOT VALVE, 2-WAY TYPE. REQUIRES DEENERGIZATION, OR POWER FAILURE TO CLOSE VALVE.
- (ZIS) POSITION INDICATING SWITCH. INCLUDES:
- NO/NC INDICATING CONTACTS FOR REMOTE MONITORING
- NO CONTACT THAT CLOSSES TO INDICATE CHECK VALVE IS OPEN
- NC CONTACT THAT OPENS UPON CLOSING VALVE CYCLE WHEN VALVE IS APPROXIMATELY 95% CLOSE AND OPENS THE MOTOR STARTING CIRCUIT.
- VCP VALVE PUMP CONTROL PANEL TO BE FURNISHED AS PART OF ELECTRONICALLY ASSISTED CHECK VALVE.
- (XXXXX) VALVE. INCLUDES RELAYS, TIMERS, PILOT LIGHT AND SWITCHES IN ADDITION TO:
- HAND-OFF-AUTOMATIC PUMP START SWITCH ("H-O-A").
- VALVE FAILURE CIRCUITS
- POWER FAILURE CIRCUITS
- PUMP FAILURE CIRCUITS
- (PS) PRESSURE SWITCH TO PROVIDE PANEL "VCP" WITH INDICATION OF POSITION PRESSURE PRIOR TO OPENING VALVE AND TO SEND SIGNAL TO REMOTE LOCATION VIA SCADA RTU THAT MOTOR IS RUNNING.

Hobbs, Upchurch & Associates, P.A.
Consulting Engineers, Surveyors & Land Planners
Southern Pines, North Carolina 28387
300 S.W. Broad Street, Southern Pines, North Carolina 28387
Phone: (910) 692-5616 - Fax: (910) 692-7342

PUMP CONTROL RISER DIAGRAMS


PERRY ROAD WATER BOOSTER PUMP STATION UPGRADE GRAND STRAND WATER & SEWER AUTHORITY

DATE:	9-5-2008
DESIGNED:	DL
DRAWN:	SMI
CHECKED:	DL
SCALE:	AS SHOWN

SHEET NO.
E-10


AS-BUILT 9-5-08

12-250-075/36 W

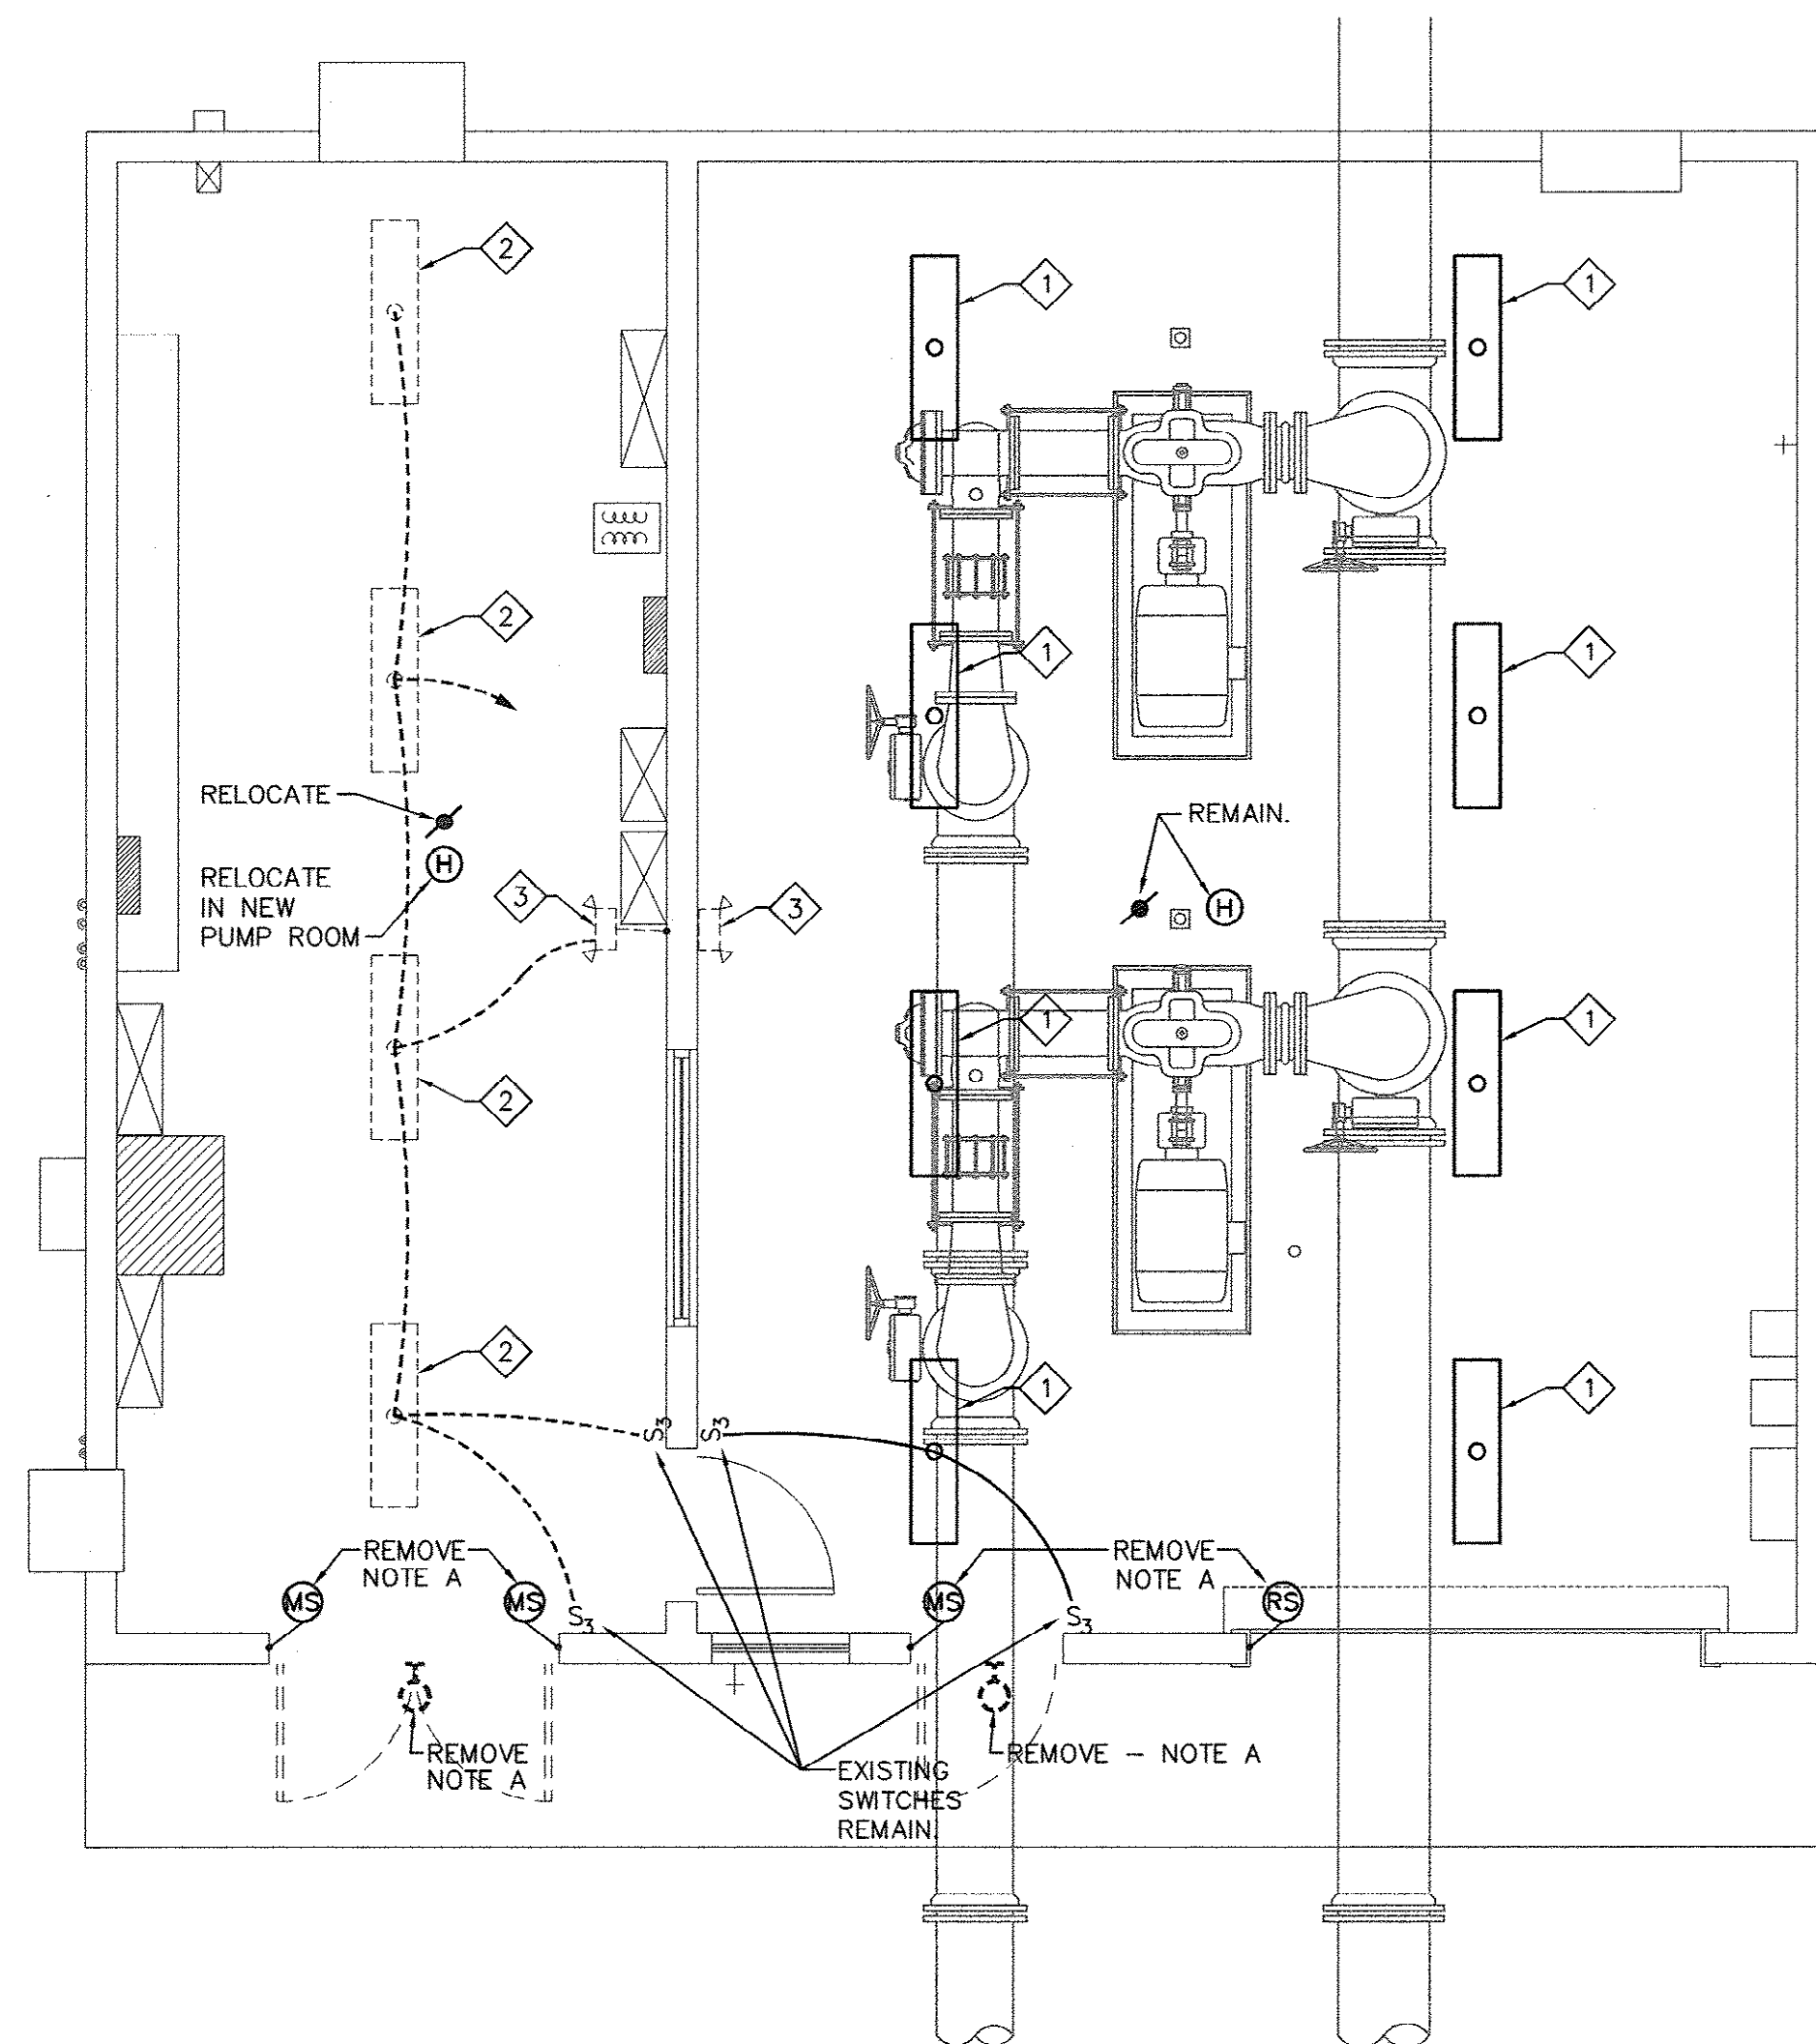

1 EXISTING BOOSTER PUMP STATION PLAN -
EXISTING LIGHTING & SECURITY/DEMOLITION
SCALE: 1/4"=1'-0"

NOTES:
A. REMOVE WIRING RELATED TO ITEMS BEING REMOVED.

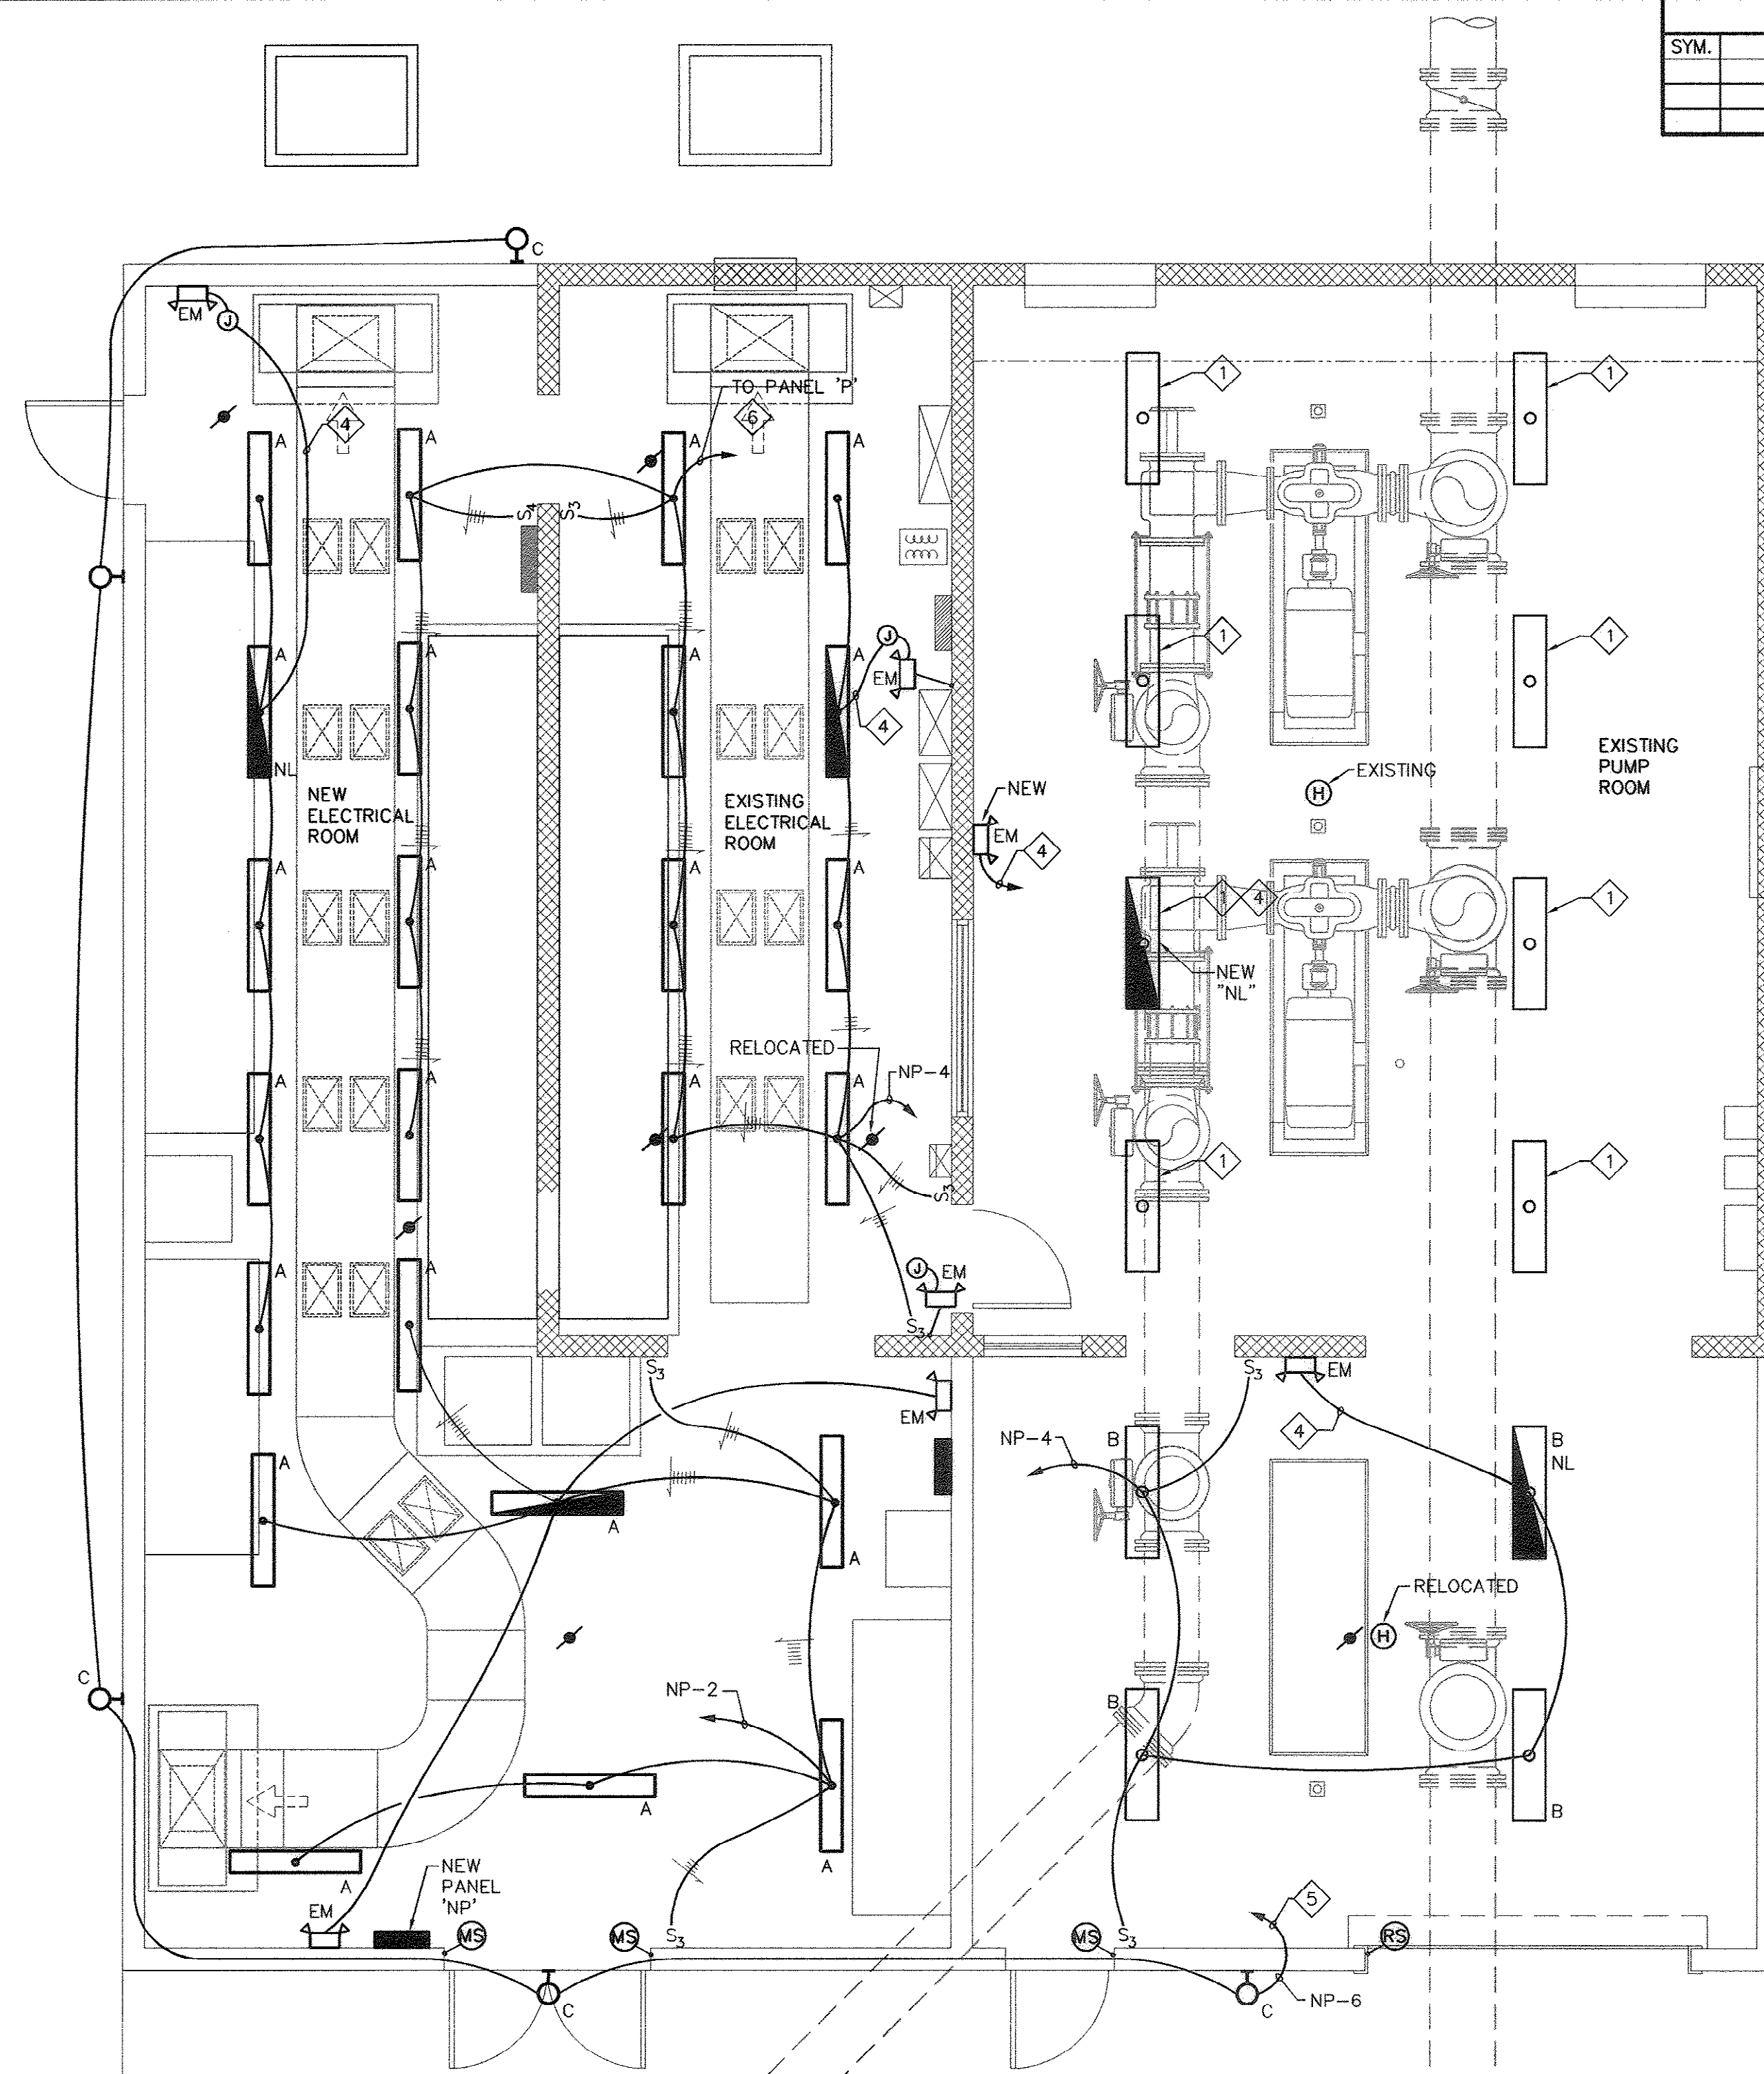

2 NEW BOOSTER PUMP STATION PLAN - NEW LIGHTING & SECURITY
SCALE: 1/4"=1'-0"

NOTES:
1. ALL LIGHTING FIXTURES ARE NEW EXCEPT AS OTHERWISE NOTED.

KEYED NOTES:

- 1 EXISTING FLUORESCENT FIXTURES - REMAIN.
- 2 EXISTING FLUORESCENT FIXTURES, REMOVE ALONG WITH RELATED WIRING.
- 3 EXISTING EMERGENCY BATTERY LIGHT REMOVE ALONG WITH RELATED WIRING.
- 4 CONNECT NEW EMERGENCY BATTERY LIGHTS, AND FLUORESCENT NIGHT LIGHTS "NL" TO LIGHTING CIRCUIT IN SAME ROOM AHEAD OF ANY SWITCH.
- 5 EXISTING OUTDOOR LIGHTING FIXTURES SHALL REMAIN. NEW OUTDOOR LIGHT FIXTURE SHALL MATCH EXISTING AS CLOSE TO POSSIBLE. CONNECT NEW FIXTURES TO SAME 120V CIRCUIT AS EXISTING ONES.
- 6 CONNECT NEW FLUORESCENT LIGHT FIXTURES WITH 2 #12, 1 #12G, 1/2" C TO PANEL "P". PROVIDE NEW 120V, 20A CIRCUIT BREAKER.

REVISIONS			
SYM.	DESCRIPTION	DATE	BY

McCracken & Lopez, P.A.
Consulting Engineers
1300 Baxter Street, Suite 350
Charlotte, North Carolina 28204
Post Office Box 32515
Charlotte, North Carolina 28232
Telephone 704/376-7072
Fax 704/376-4465

Hobbs, Upchurch & Associates, P.A.
Consulting Engineers, Surveyors & Land Planners
Southern Pines, North Carolina 28387
300 S.W. Broad Street, Southern Pines, North Carolina 28387
Phone: (910) 692-5616 - Fax: (910) 692-7342



**LIGHTING AND
SECURITY PLANS**

**PERRY ROAD WATER
BOOSTER PUMP STATION
UPGRADE
GRAND STRAND WATER &
SEWER AUTHORITY**


DATE: 9-5-2008
DESIGNED: DL
DRAWN: SMI
CHECKED: DL
SCALE: AS SHOWN

SHEET NO.
E-11

AS-BUILT 9-5-08

13-250-036/36 9J

LOAD (KVA)			DESCRIPTION	WIRE SIZE	BRKR RATG	CKT. NO.		CKT. NO.	BRKR RATG	WIRE SIZE	DESCRIPTION	LOAD (KVA)		
A	B	C										A	B	C
1.8			NEW FANS EF-1 & EF-2	12	20/3	1		2	20/3	12	NEW FANS EF-3 & EF-4	1.8		
	1.8		2 HP	12		3		4		12			1.8	
		1.8		12		5		6		12				1.8
2.5			NEW AC-1	12	15/3	7		8	15/3	12	NEW AC-2	2.6		
	2.6			12		9		10		12			2.5	
		2.6		12		11		12		12				2.6
5.5			NEW CU-1	8	40/3	13		14	40/3	8	NEW CU-2	5.5		
	5.5			8		15		16		8			5.5	
		5.5		8		17		18		8				5.5
10.0			PANEL P	3	100/2	19		20	15/3	12	NEW AC-3	2.6		
	10.0		VIA 37 1/3 KVA	3		21		22		12			2.6	
		0.0	SPARE		40/3	23		24		12				2.6
0.0						25		26	40/3	8	NEW CU-3	5.5		
	0.0					27		28		8			5.5	
		0.0	SPARE		15/3	29		30		8				5.5
						31		32	50/3		SPARE	0.0		
0.0						33		34					0.0	
	0.0		9.8 PANEL GP VIA 25 KVA	4	70/2	35		36						0.0
		10.3		4		37		38	60/3		SPARE	0.0		0.0
			S.D.			39		40					0.0	
		0.0	S.D.			41		42					0.0	0.0
TYPE: BRANCH CIRCUIT			GROSS PHASE TOTALS			CONNECTED LOAD CURRENT: 149 AMPERES			0.4 KVA					
MOUNTING: SURFACE			A= 48.1 KVA			LIGHTING			27.5 KVA					
SUPPLY: 480V, 3-PH, 3W			B= 37.8 KVA			HEATING			57.3 KVA					
MAINS: 400 AMP MAIN CIRCUIT BREAKER			C= 37.7 KVA			A/C MOTORS & HEAT PUMPS			17.5 KVA					
SCIR: 65,000 AMPERES						AIR HANDLING & EXH FANS			0.4 KVA					
NOTES:						RECEPTACLES			0.0 KVA					
1. WITH EQUIPMENT GROUND BUS.						ELECTRIC WATER HEATING			0.0 KVA					
						ELEVATORS			0.0 KVA					
						FOOD PROCESSING			0.0 KVA					
						PROCESS			0.0 KVA					
						MISCELLANEOUS			20.6 KVA					
PANEL NHP						TOTAL CONNECTED LOAD			123.7 KVA					

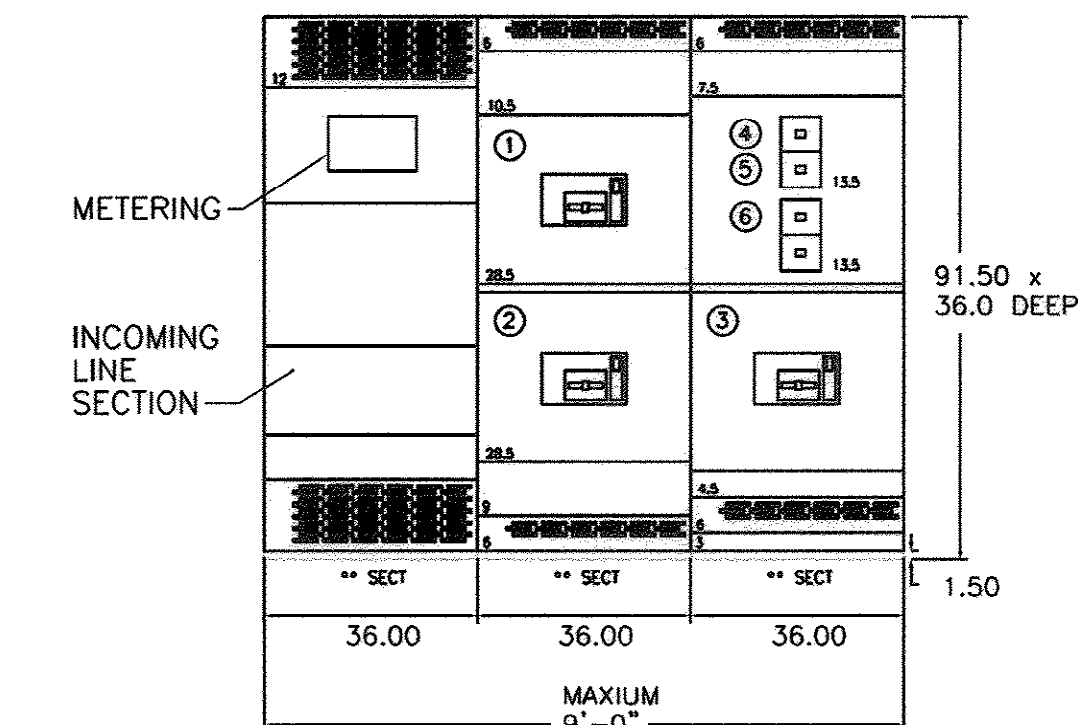

2 SWITCHBOARD "NSB" ELEVATION


SCALE: NONE

NOTES:


1. SWITCHBOARD "ESB" ELEVATION IS SIMILAR TO SWITCHBOARD "NSB".

LOAD (KVA)			DESCRIPTION	WIRE SIZE	BRKR RATG	CKT. NO.		CKT. NO.	BRKR RATG	WIRE SIZE	DESCRIPTION	LOAD (KVA)		
PH1	PH2											PH1	PH2	
0.8			RECEPTACLES	12	20/1	1		2	20/1	12	INDOOR LTG.	1.0		
	0.8		RECEPTACLES	12	20/1	3		4	20/1	12	INDOOR LTG.		0.7	
0.8			RECEPTACLES	12	20/1	5		6	20/1	12	OUTDOOR LTG.	0.8		
	0.5		VFD #3 CONTROLS	12	20/1	7		8	20/1		SPARE		0.0	
0.5			VFD #2 CONTROLS	12	20/1	9		10	20/1		SPARE	0.0		
	0.5		VFD #1 CONTROLS	12	20/1	11		12	20/1		SPARE		0.0	
0.0			SPARE		20/1	13		14	20/1		SPARE	0.0		
	0.0		SPARE		20/1	15		16	20/1		SPARE		0.0	
0.0			SPARE		20/1	17		18	20/1		SPARE	0.0		
	0.0		SPARE		20/1	19		20	20/1		SPARE		0.0	
0.0			SPARE		20/1	21		22	20/1		SPARE	0.0		
	0.0		SPARE		20/1	23		24	20/1		SPARE		0.0	
0.0			SPARE		20/1	25		26				0.0		
	0.0		SPARE		20/1	27		28					0.0	
0.0			SPARE		20/1	29		30				0.0		
	0.0		SPARE		20/1	31		32					0.0	
0.0			SPARE		20/1	33		34				0.0		
	0.0		SPARE		20/1	35		36					0.0	
0.0			SPARE		20/1	37		38				0.0		
	0.0		SPARE		20/1	39		40					0.0	
0.0			SPARE		20/1	41		42				0.0		
TYPE: BRANCH CIRCUIT			GROSS PHASE TOTALS			CONNECTED LOAD: 27 AMPERES			2.5 KVA					
MOUNTING: SURFACE			PH1= 3.9 KVA			LIGHTING			0.0 KVA					
SUPPLY: 240/120V, 1-PH, 3W			PH2= 2.5 KVA			HEATING			0.0 KVA					
MAINS: 100A M.C.B.						A/C MOTORS & HEAT PUMPS			0.0 KVA					
SCIR: 10,000 A						AIR HANDLING & EXH FANS			0.0 KVA					
NOTES:						RECEPTACLES			2.4 KVA					
1. WITH EQUIPMENT GROUNDING BUS.						ELECTRIC WATER HEATING			0.0 KVA					
						ELEVATORS			0.0 KVA					
						FOOD PROCESSING			0.0 KVA					
						PROCESS			0.0 KVA					
						MISCELLANEOUS			1.5 KVA					
PANELS NP						TOTAL CONNECTED LOAD			6.4 KVA					

SWITCHBOARD NSB						CONNECTED LOAD (KVA)							
SERVICE: 480/277V, 3-PH, 4W						TYPE: FRONT ACCESSIBLE ONLY							
BUSES: 3000 AMPERES						S.C. RATING: 65,000 AMPERES							
NOTES:						LIGHTING 0.4							
1. SUITABLE FOR SERVICE REENTRY.						HEATING 27.5							
2. WITH EQUIPMENT GROUND BUS.						A/C & HEAT PUMPS 57.3							
3. REFER TO SECTION 16440 AND ONE-LINE POWER DIAGRAM FOR MORE REQUIREMENTS.						AIR HANDLING 17.5							
4. CIRCUIT BREAKER FOR TVSS IS NOT A POWER DISCONNECT IN ACCORDANCE WITH NEC 230-71.						RECEPTACLES 0.4							
						WATER HEATING 0.0							
						ELEVATORS 0.0							
						FOOD PROCESSING 0.0							
						PROCESS 1398.0							
						MISCELLANEOUS 20.6							
						TOTAL (KVA) 1521.7							
						CONNECTED LOAD: 1830 AMPERES							
UNIT		LOAD SERVED		PROTECTION		WIRE & CONDUIT		REMARKS		LOAD (KVA) PER PHASE			
				POLE	FRAME	TRIP					A	B	C
MAIN LUGS ONLY				-	-	-	SEE POWER DIAGRAM		ENTRY SECTION	514.1	503.8	503.7	
1	PUMP #1			3	1600	1600	SEE POWER DIAGRAM		L.S.I.G. AM	233.0	233.0	233.0	
2	PUMP #2			3	1600	1600	SEE POWER DIAGRAM		L.S.I.G. AM	233.0	233.0	233.0	
3	PUMP #3 (NON-CONCURRENT)			3	1600	1600	SEE POWER DIAGRAM		L.S.I.G. AM	0.0	0.0	0.0	
4	ATS-3/ NHP			3	400	400	SEE POWER DIAGRAM		-	48.1	37.8	37.7	
5	SPARE			3	400	400			-	0.0	0.0	0.0	
6	SPARE			3	400	400			-	0.0	0.0	0.0	
-	TVSS			3	100	60	SEE POWER DIAGRAM		NOTE 4	0.0	0.0	0.0	
-				-	-	-			-	0.0	0.0	0.0	

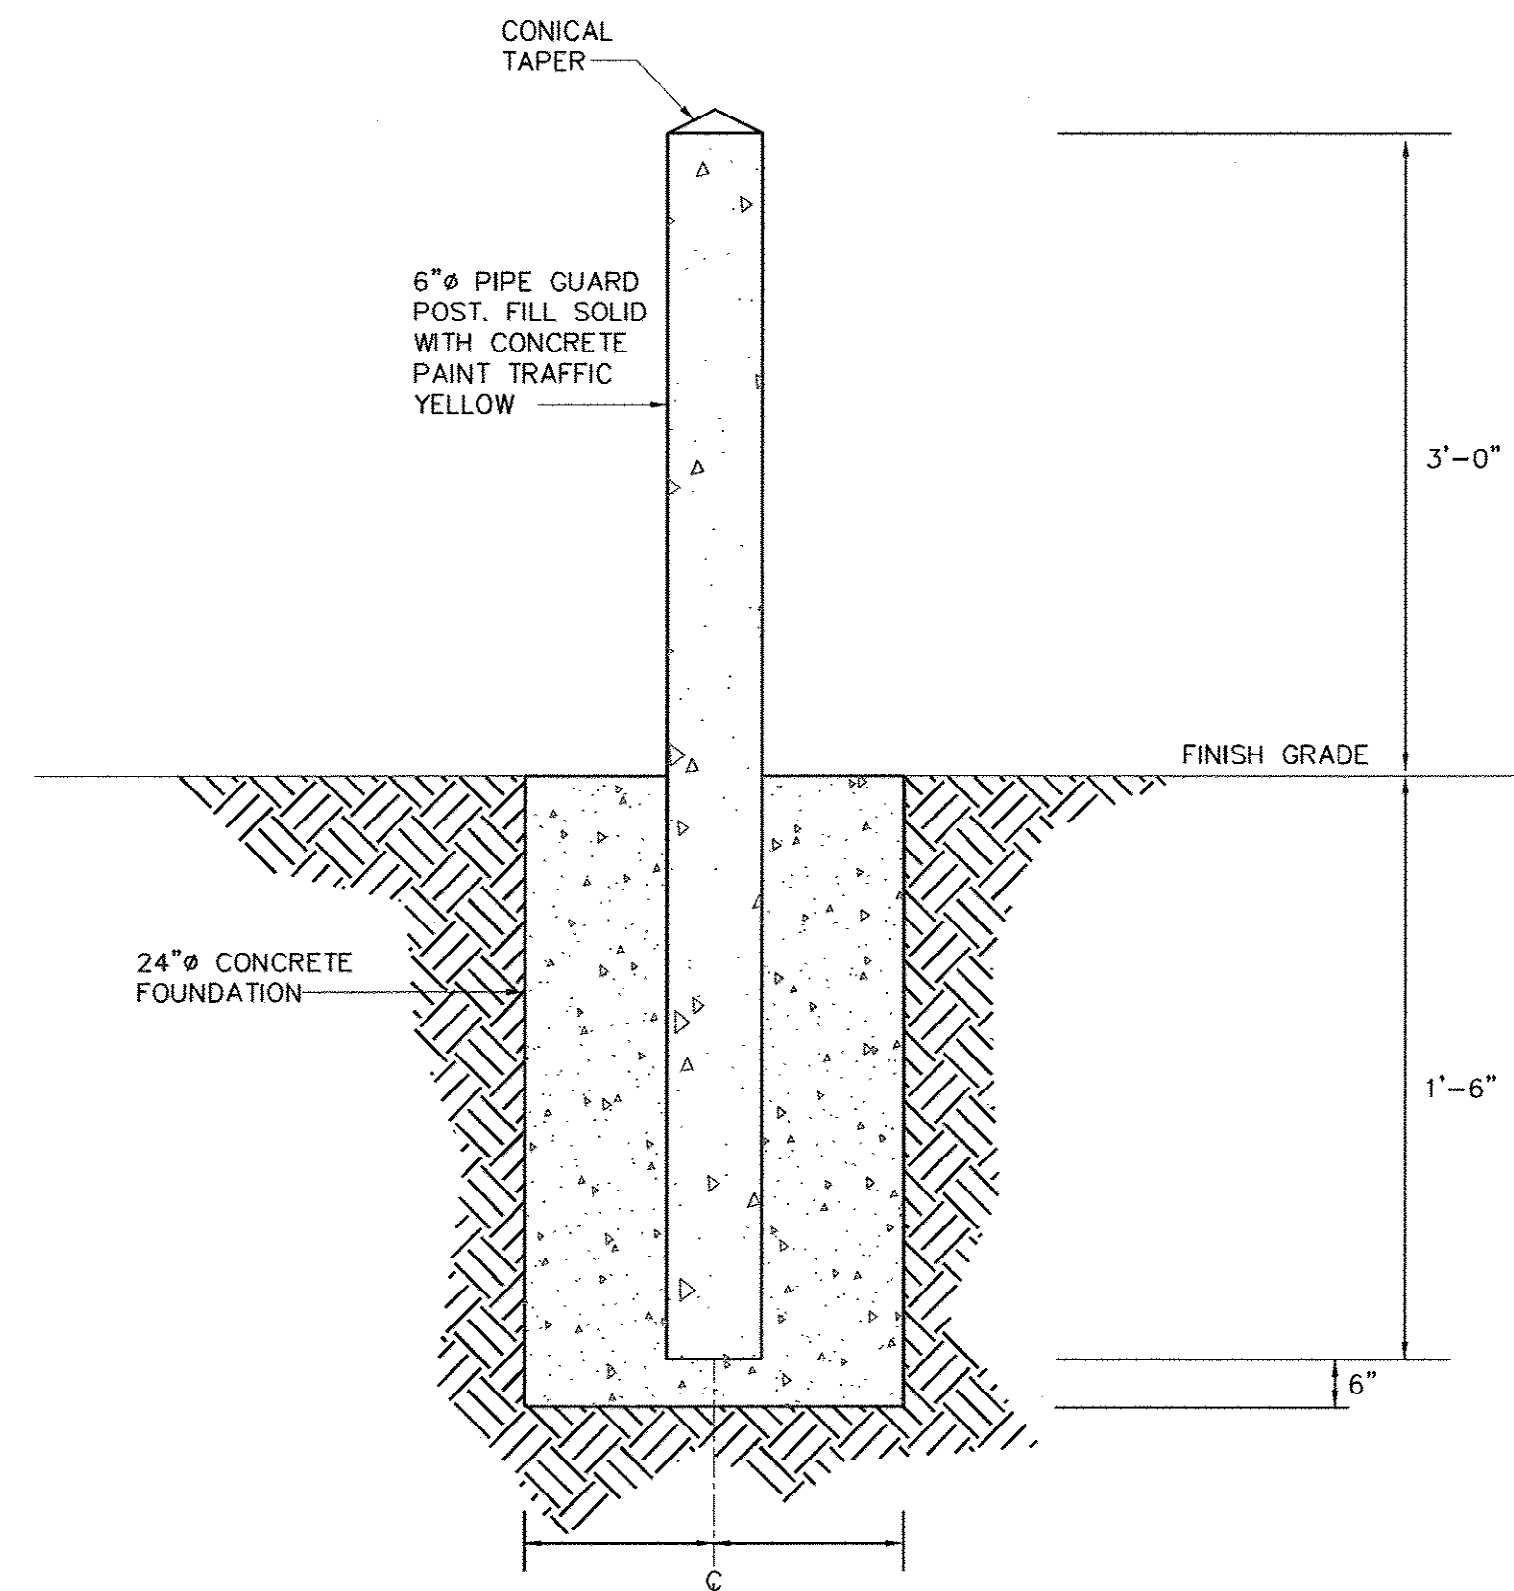


3
E-13
PIPE GUARD POST
SCALE: NONE

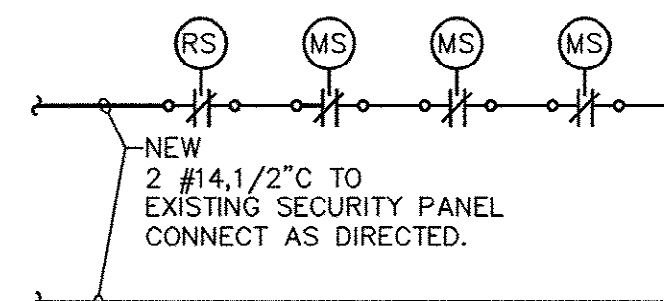


5
E-13
NEW PUMP STATION EXTERIOR DOORS
MONITORING WIRING DIAGRAM

- NOT TO SCALE
- NOTES:
1. COORDINATE WITH SECURITY SYSTEM PROVIDER PRIOR TO RUNNING ANY WIRING.
 2. REFER TO SHEET E-15 FOR NEW GENERATOR SET HOUSING ACCESS DOORS MONITORING.

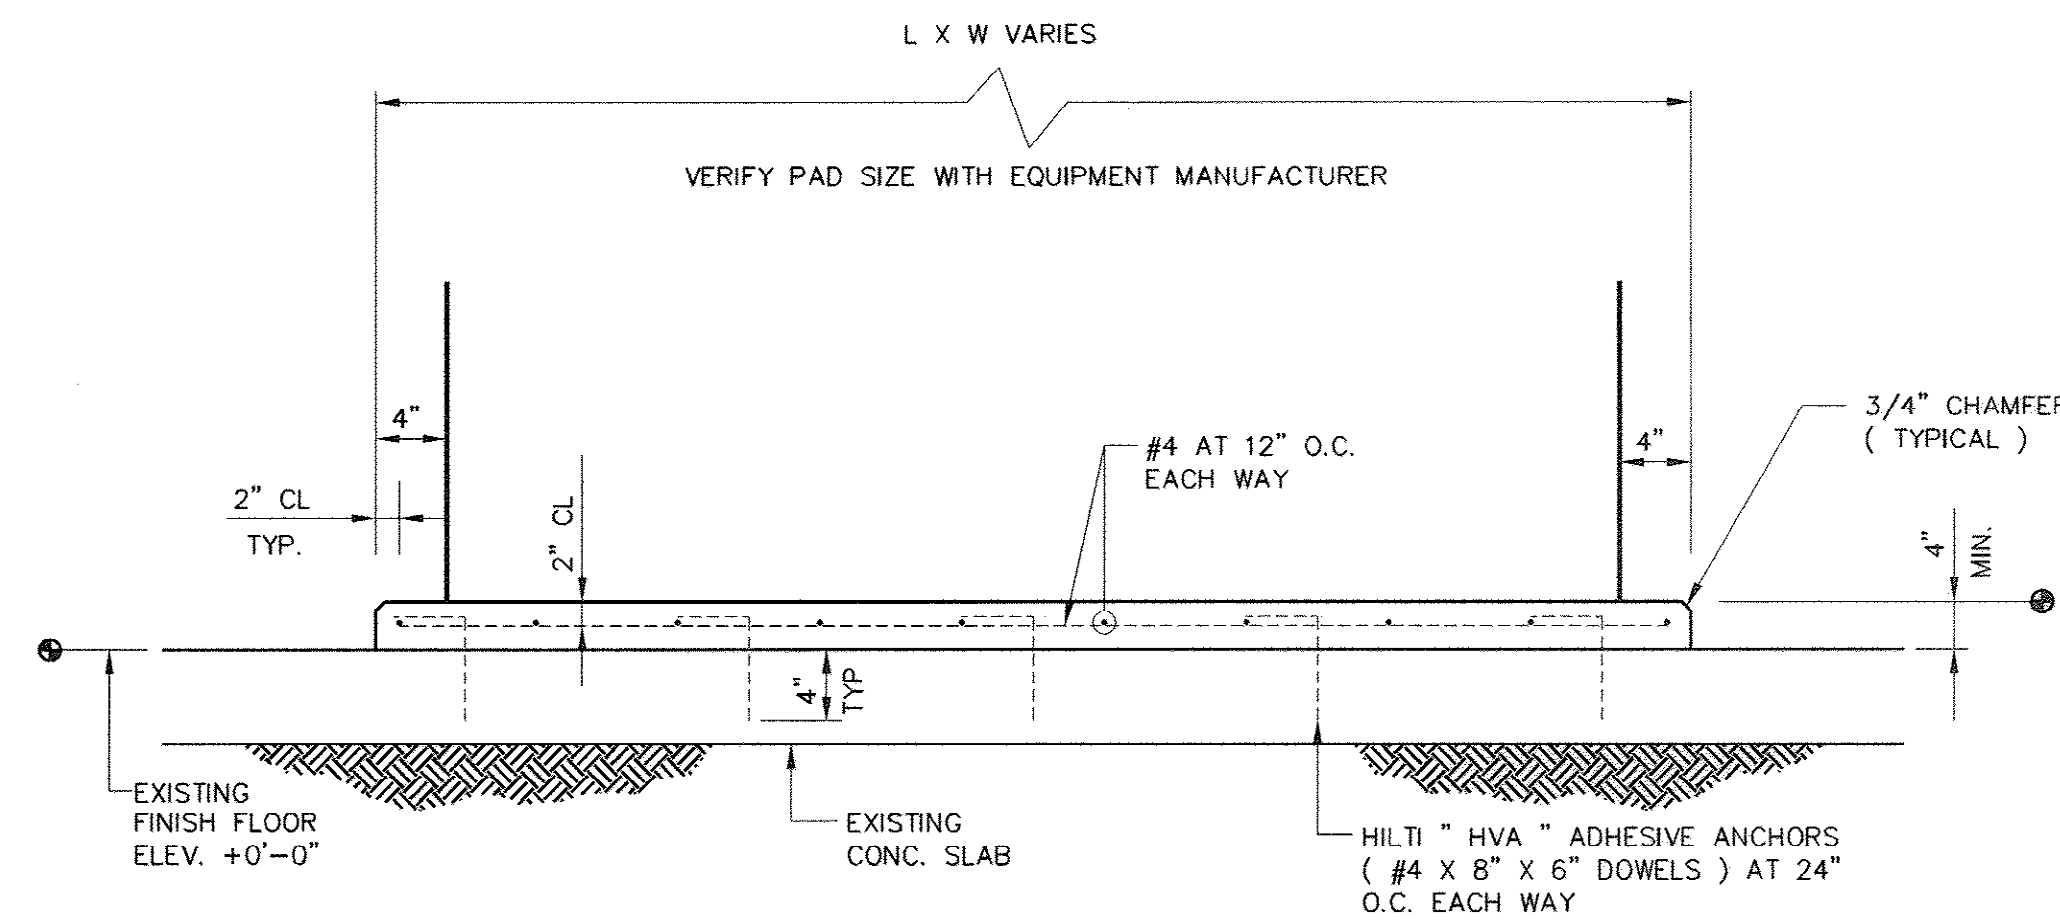


COORDINATE SIZE, LOCATION, AND NUMBER OF INTERIOR CONCRETE EQUIPMENT PADS WITH EQUIPMENT BEING SUBMITTED.

2
E-13
EQUIPMENT PAD AT EXISTING SLAB
SCALE: 3/4" = 1'-0"

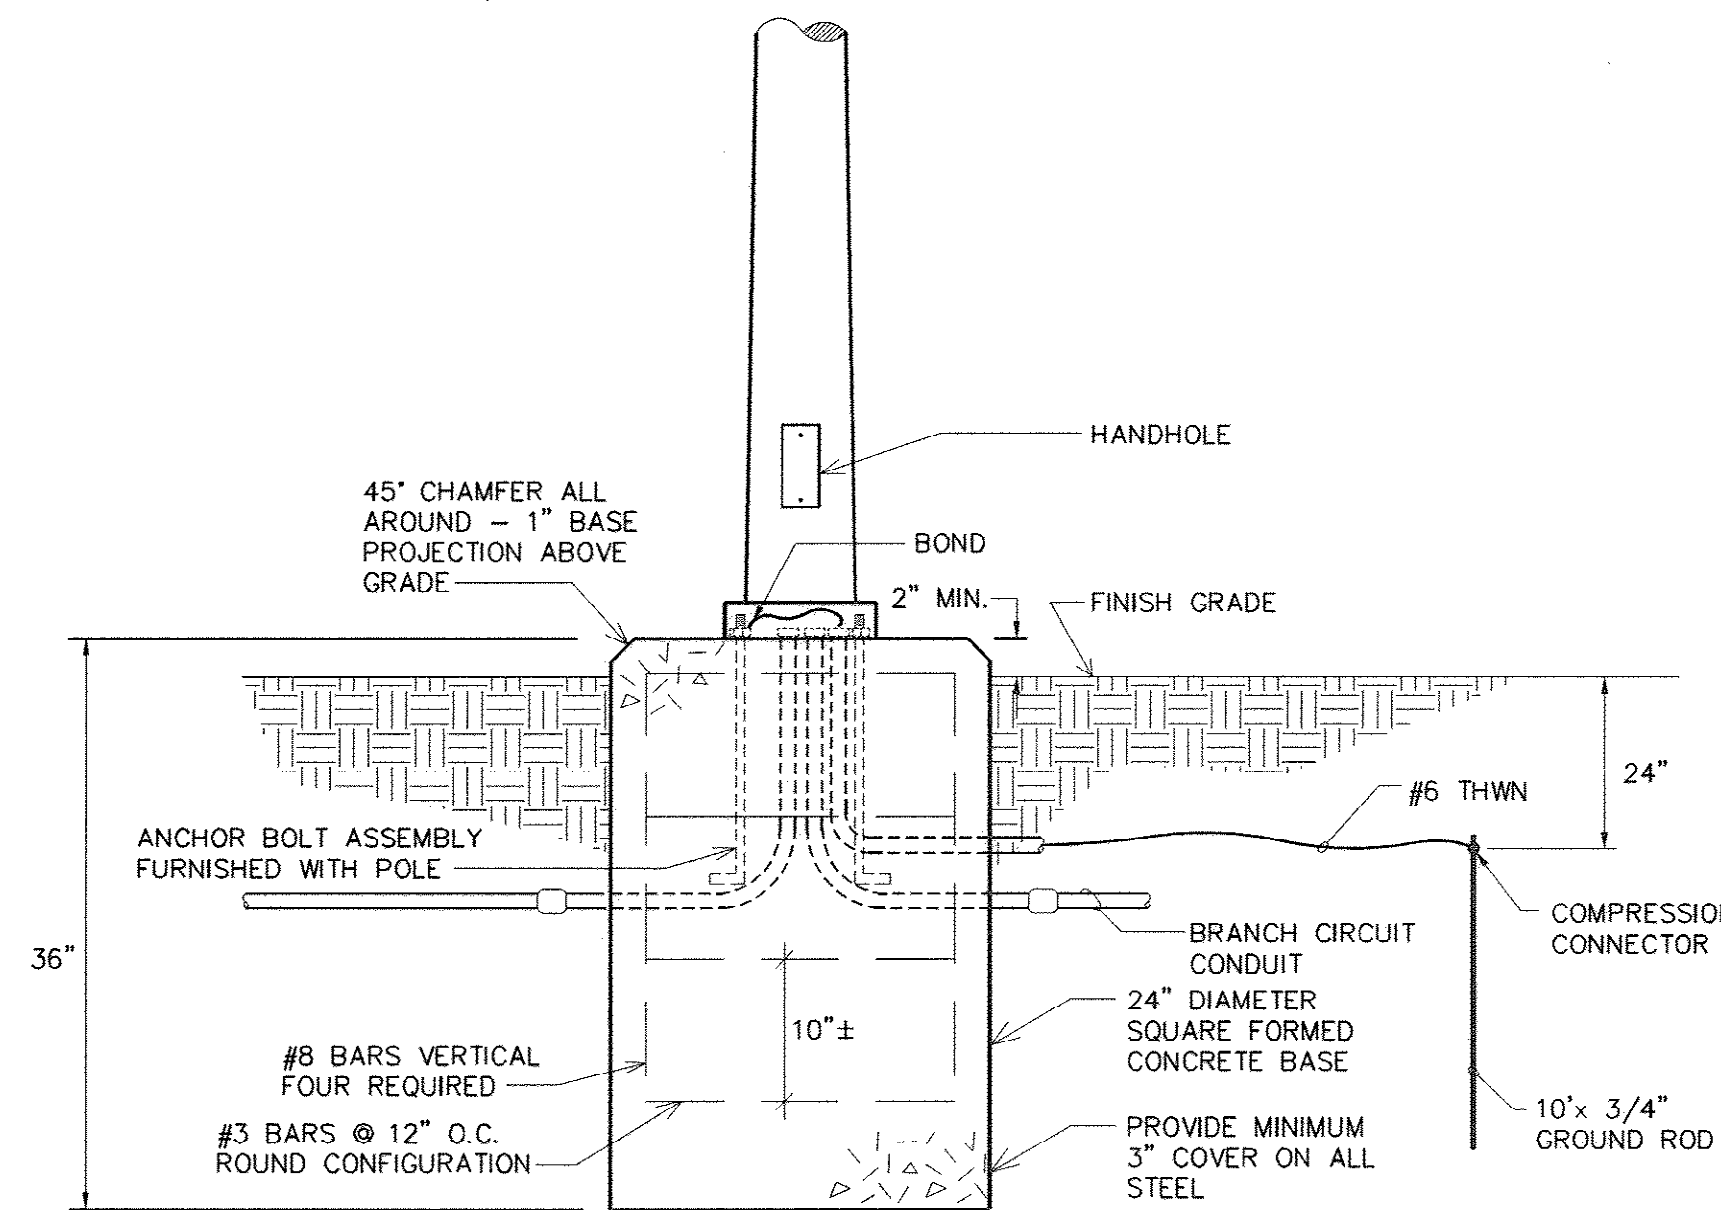


4
E-13
BASE DETAIL - FIXTURE TYPES 'SB'
NOT TO SCALE

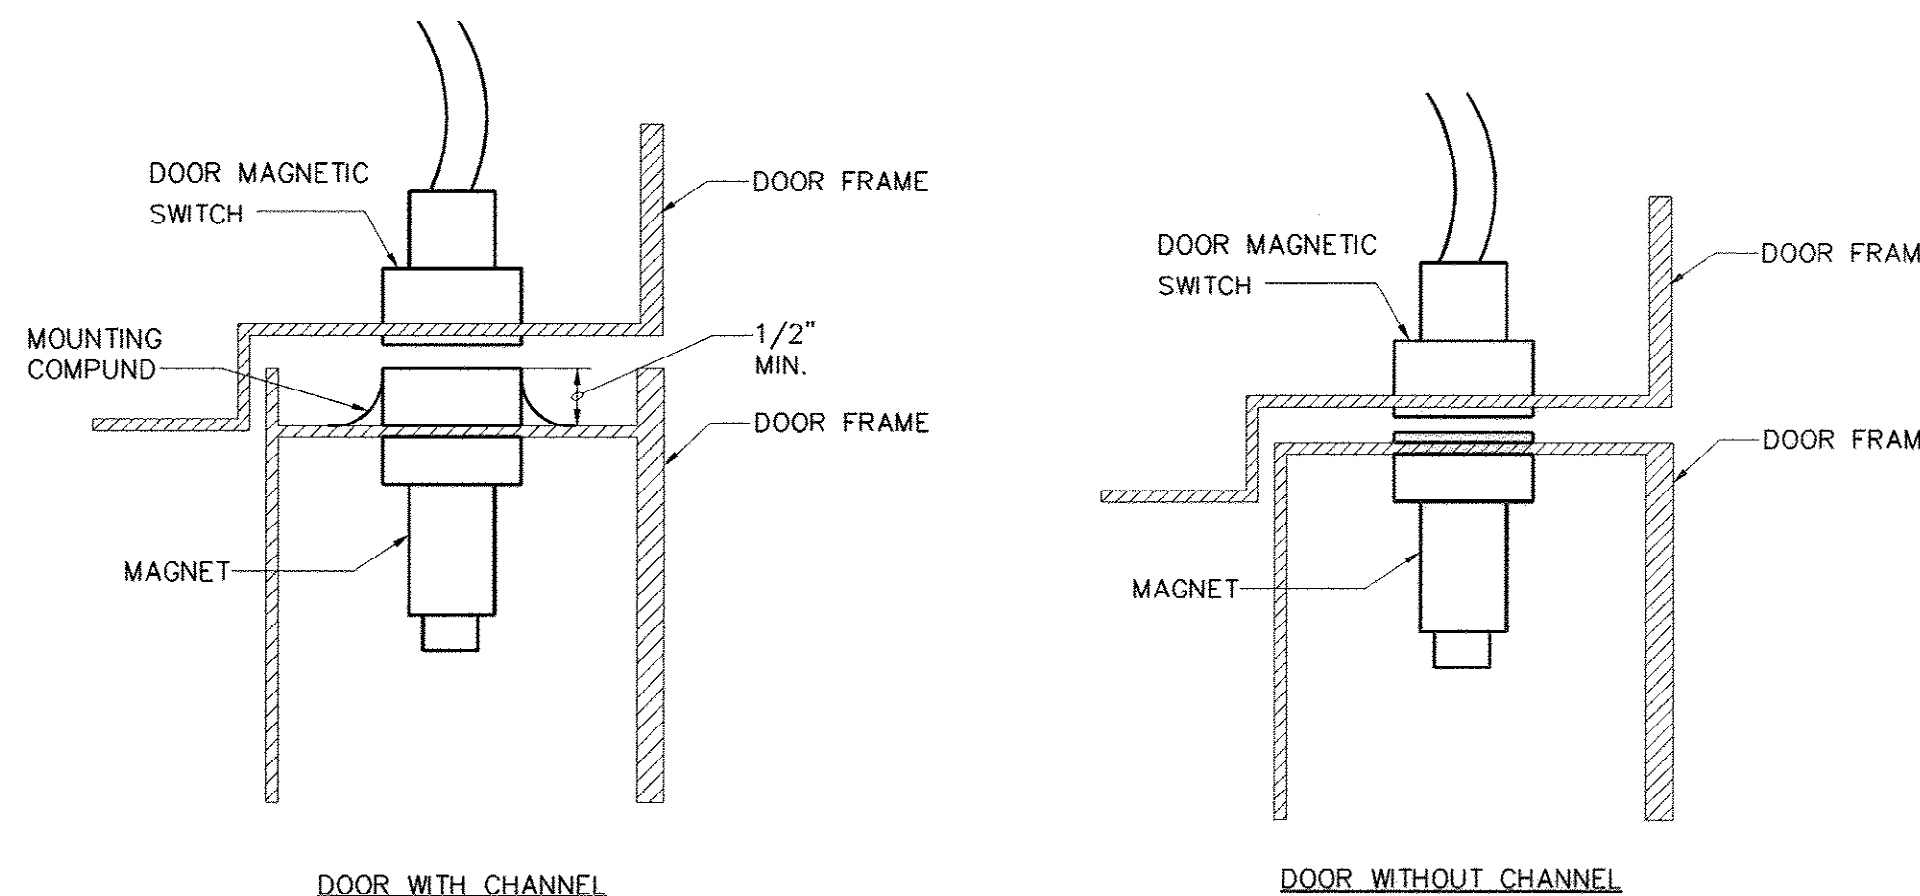

6
E-13
TYPICAL "MS" MOUNTING

- NOT TO SCALE
- NOTES:
1. USE SWITCHES FROM SENTROL, WIDE GAP TYPE, OR APPROVED EQUAL.

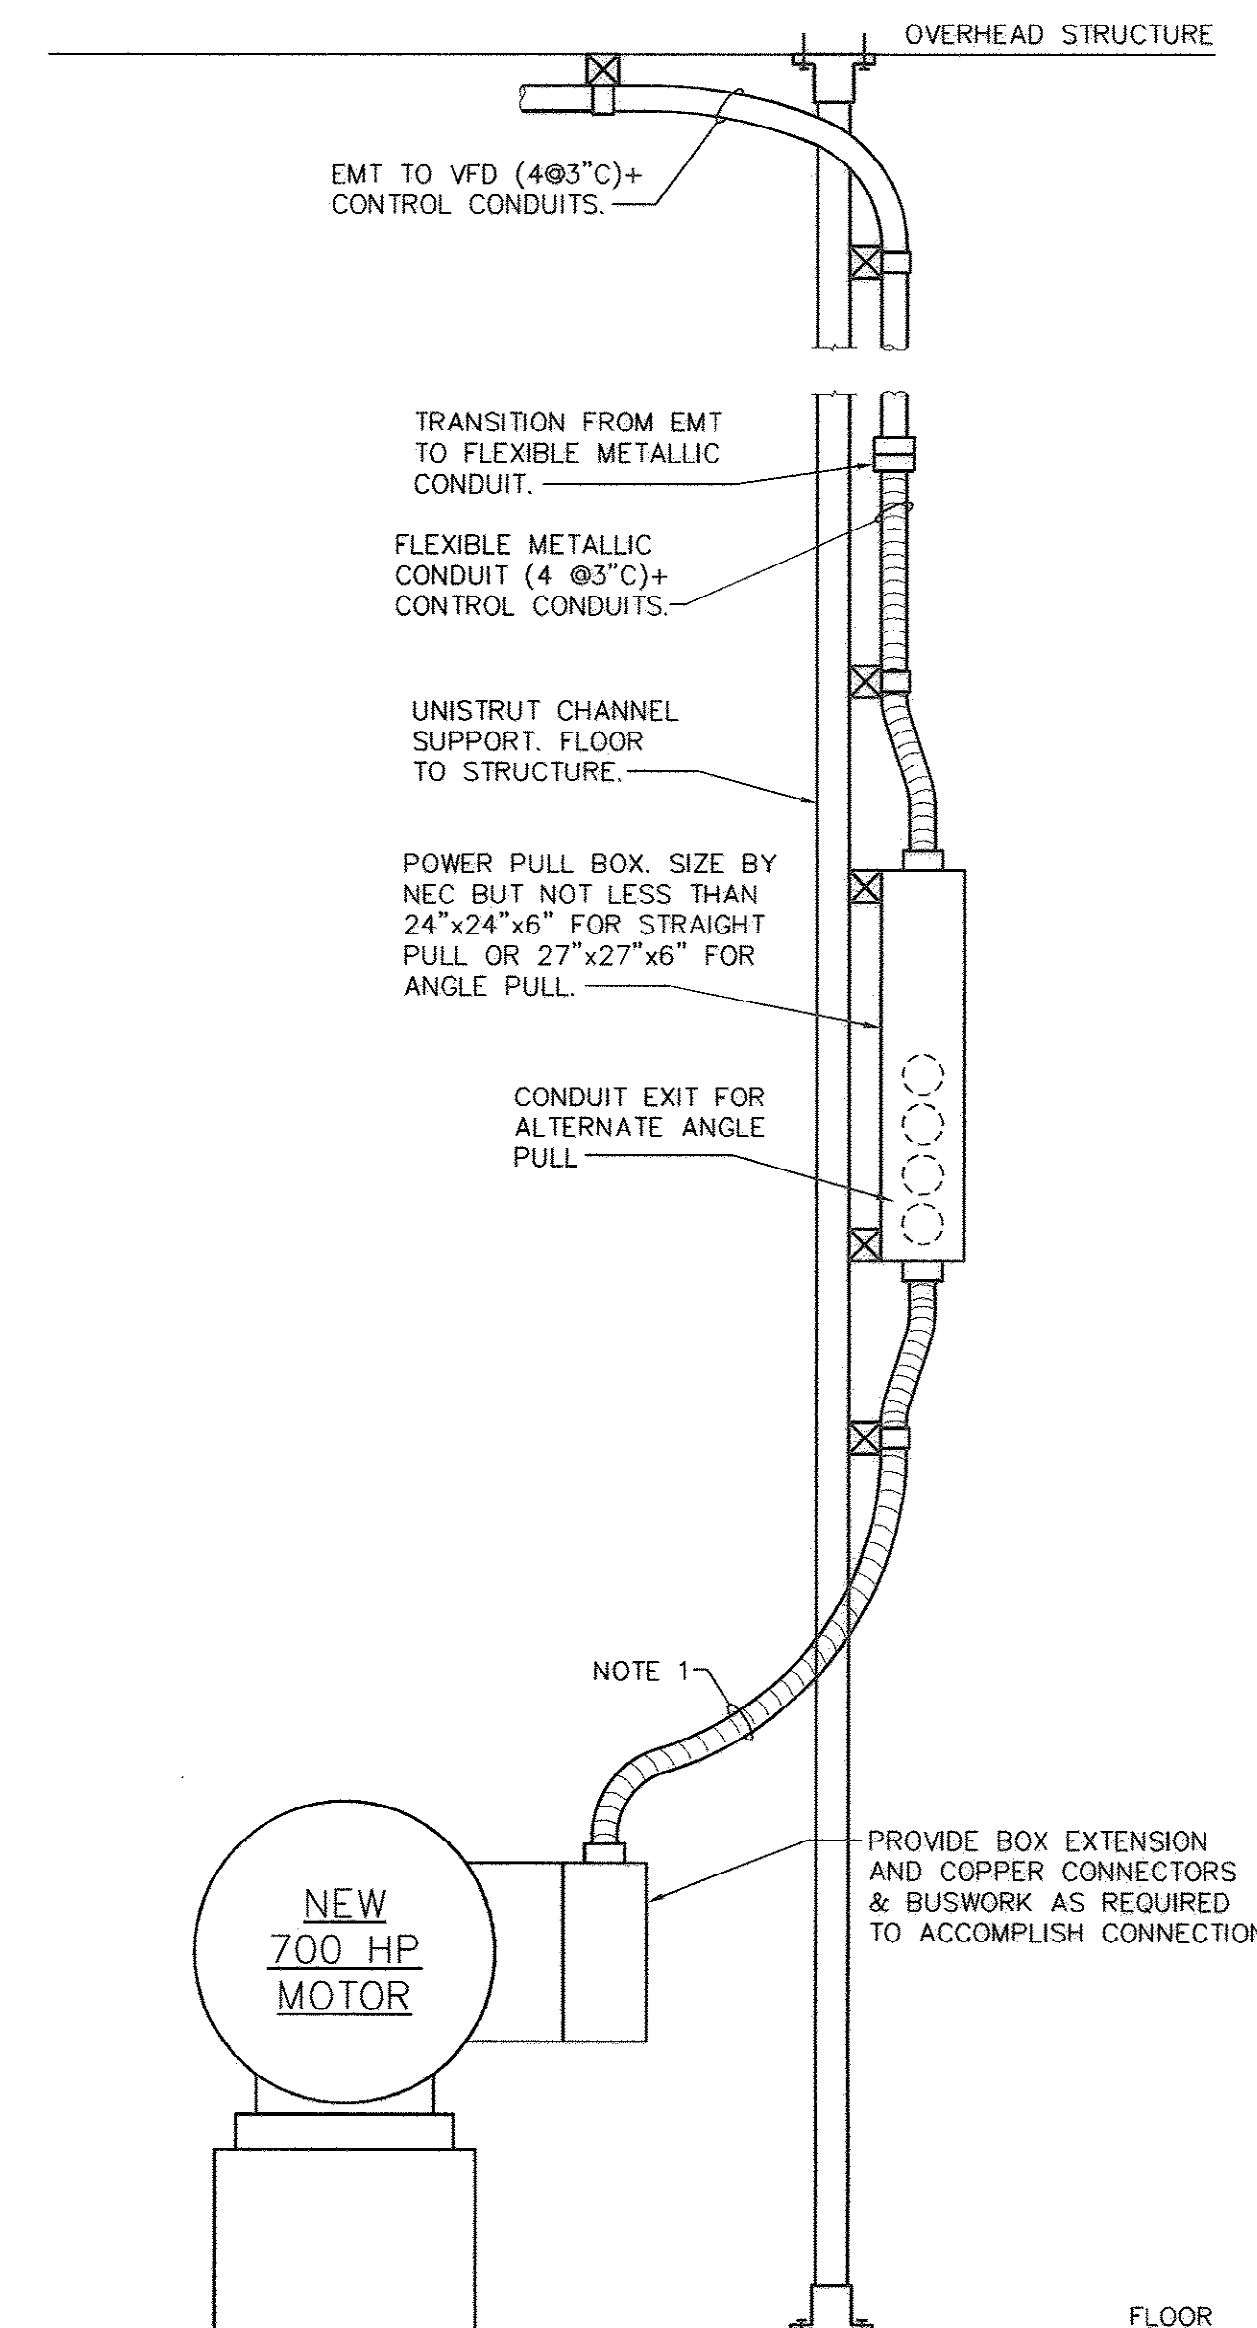

1
E-13
SIDE VIEW DETAIL OF PROPOSED METHOD FOR POWER
CONNECTION TO NEW PUMP MOTORS

- NOTES:
1. FINAL CONNECTION TO MOTOR SHALL BE LIQUID TIGHT FLEXIBLE METALLIC TYPE BONDED PER NEC.
 2. CONTROL, SAFETY AND POWER CONDUCTORS SHALL NOT BE INSTALLED IN SAME CONDUIT OR BOX.
 3. EXACT LOCATION OF PULL BOXES SHALL BE COORDINATED WITH PUMP MOTOR INSTALLER AND OWNER TO MAKE SURE THAT ACCESS TO PUMP & MOTOR IS NOT HINDERED.
 4. REFER TO 4/E8/E10 FOR REQUIRED CONTROL AND MONITORING CONDUITS NOT SHOWN HERE.

REVISIONS			
SYM.	DESCRIPTION	DATE	BY

McCracken & Lopez, P.A.
Consulting Engineers
1300 Baxter Street, Suite 350
Charlotte, North Carolina 28204
Post Office Box 32515
Charlotte, North Carolina 28232
Telephone 704/376-7072
Fax 704/376-4465

Hobbs, Upchurch & Associates, P.A.
Consulting Engineers, Surveyors & Land Planners
Southern Pines, North Carolina 28387
300 S.W. Broad Street, Southern Pines, North Carolina 28387
Phone: (910) 692-5616 - Fax: (910) 692-7342

MISCELLANEOUS
DETAILS


PERRY ROAD WATER
BOOSTER PUMP STATION
UPGRADE
GRAND STRAND WATER &
SEWER AUTHORITY

DATE:	9-5-2008
DESIGNED:	DL
DRAWN:	SMI
CHECKED:	DL
SCALE:	AS SHOWN


SHEET NO.
E-13

AS-BUILT 9-5-08

12-250-028/36 W

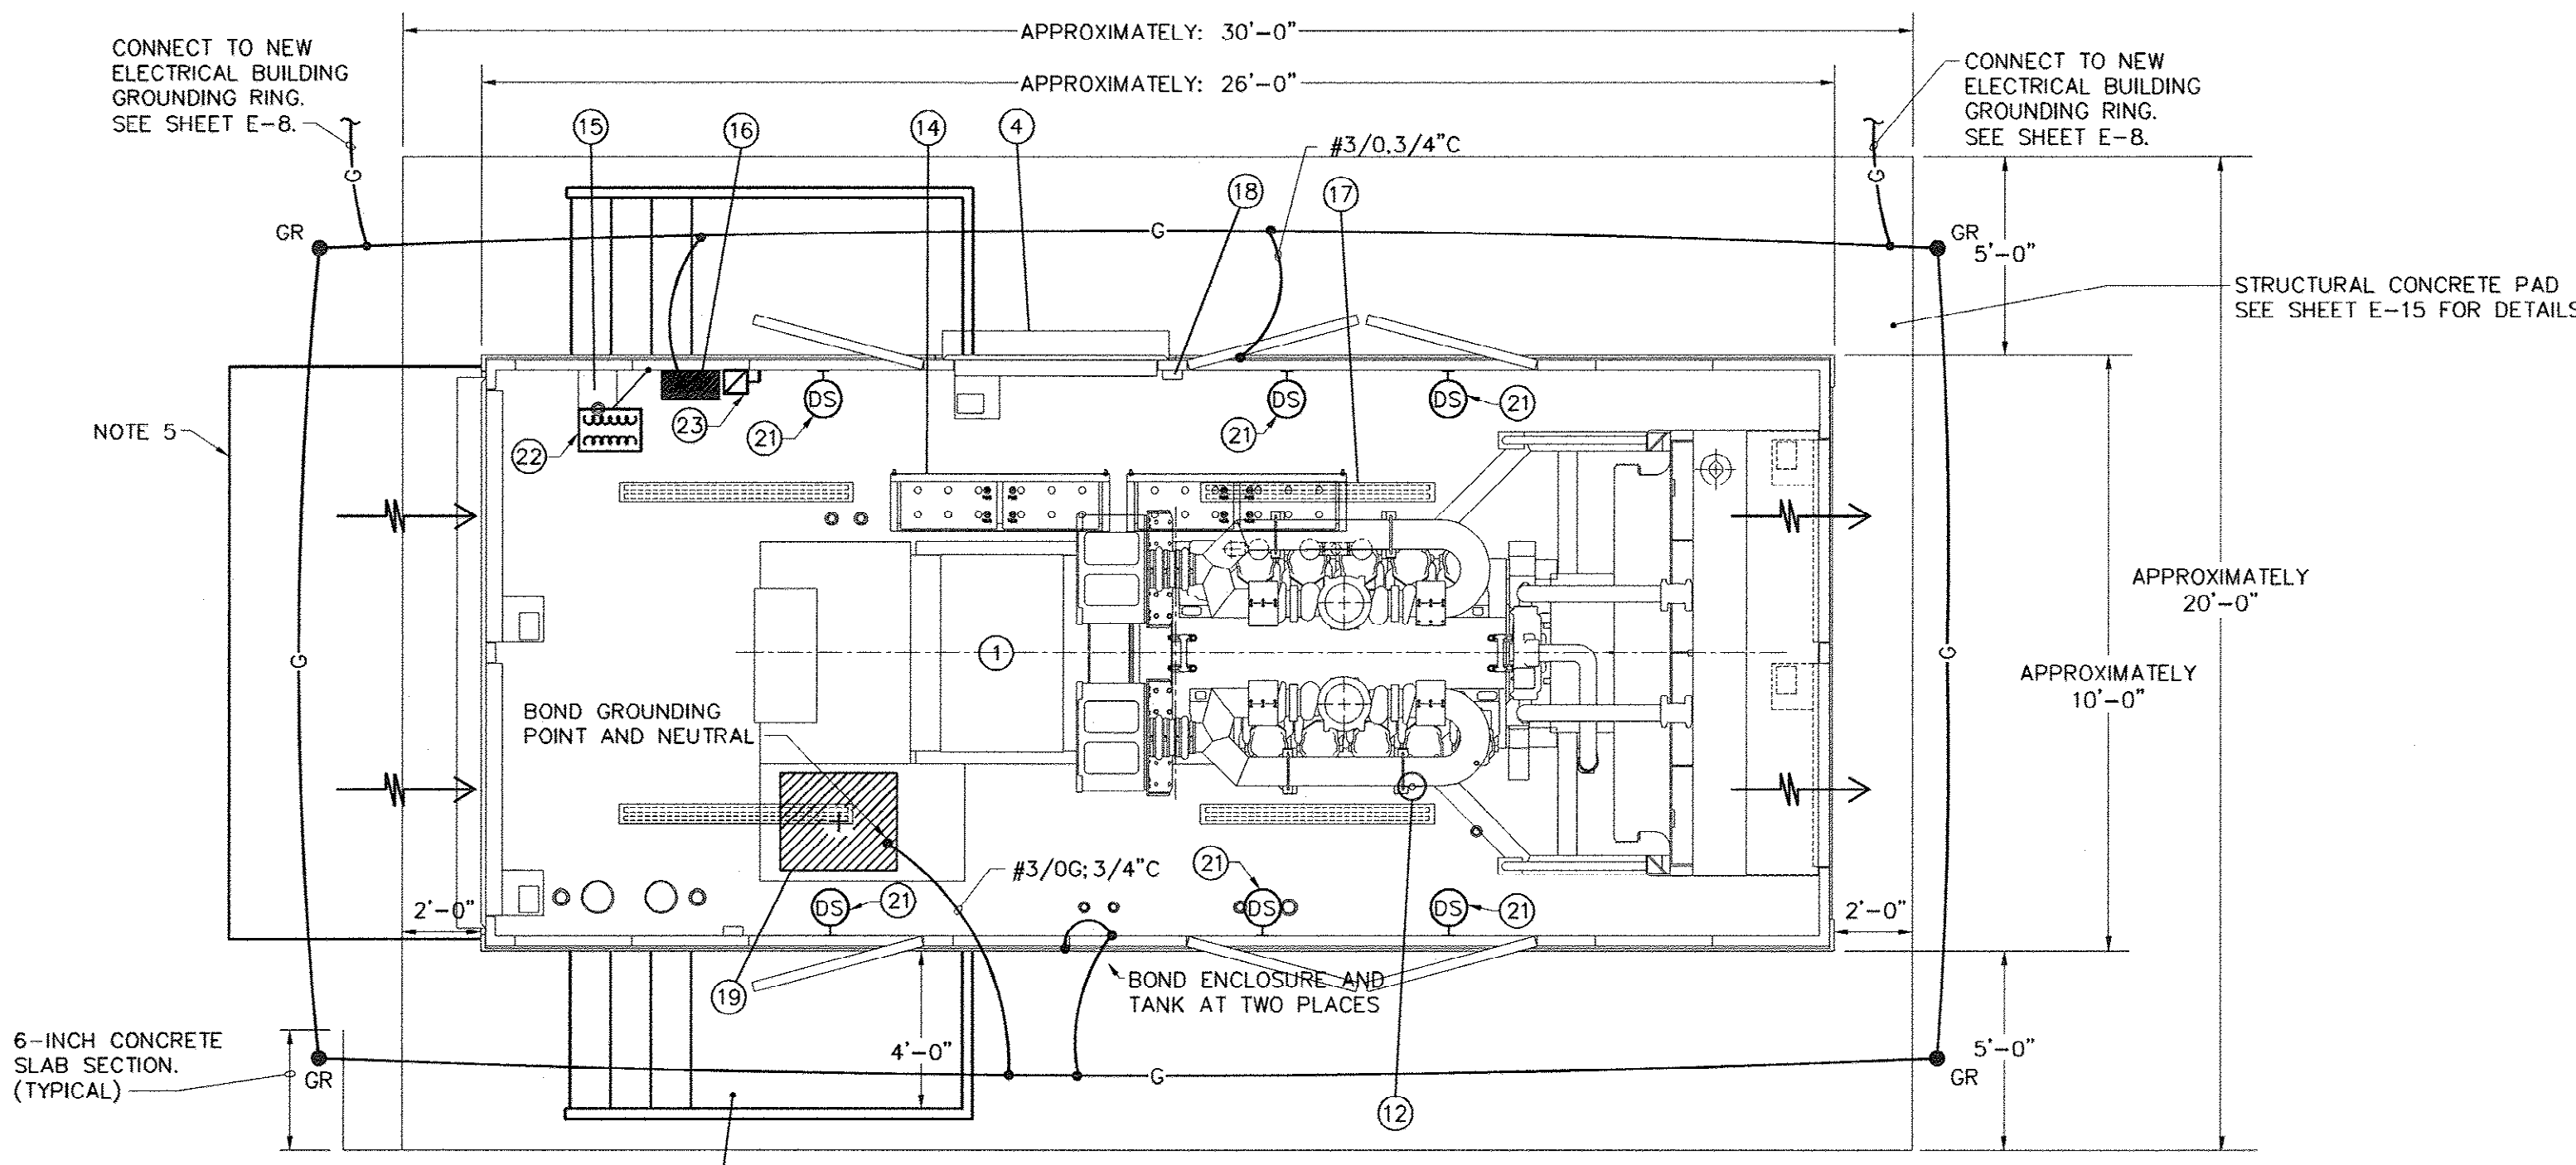

ENGINE GENERATOR SET - PLAN VIEW
NOT TO SCALE

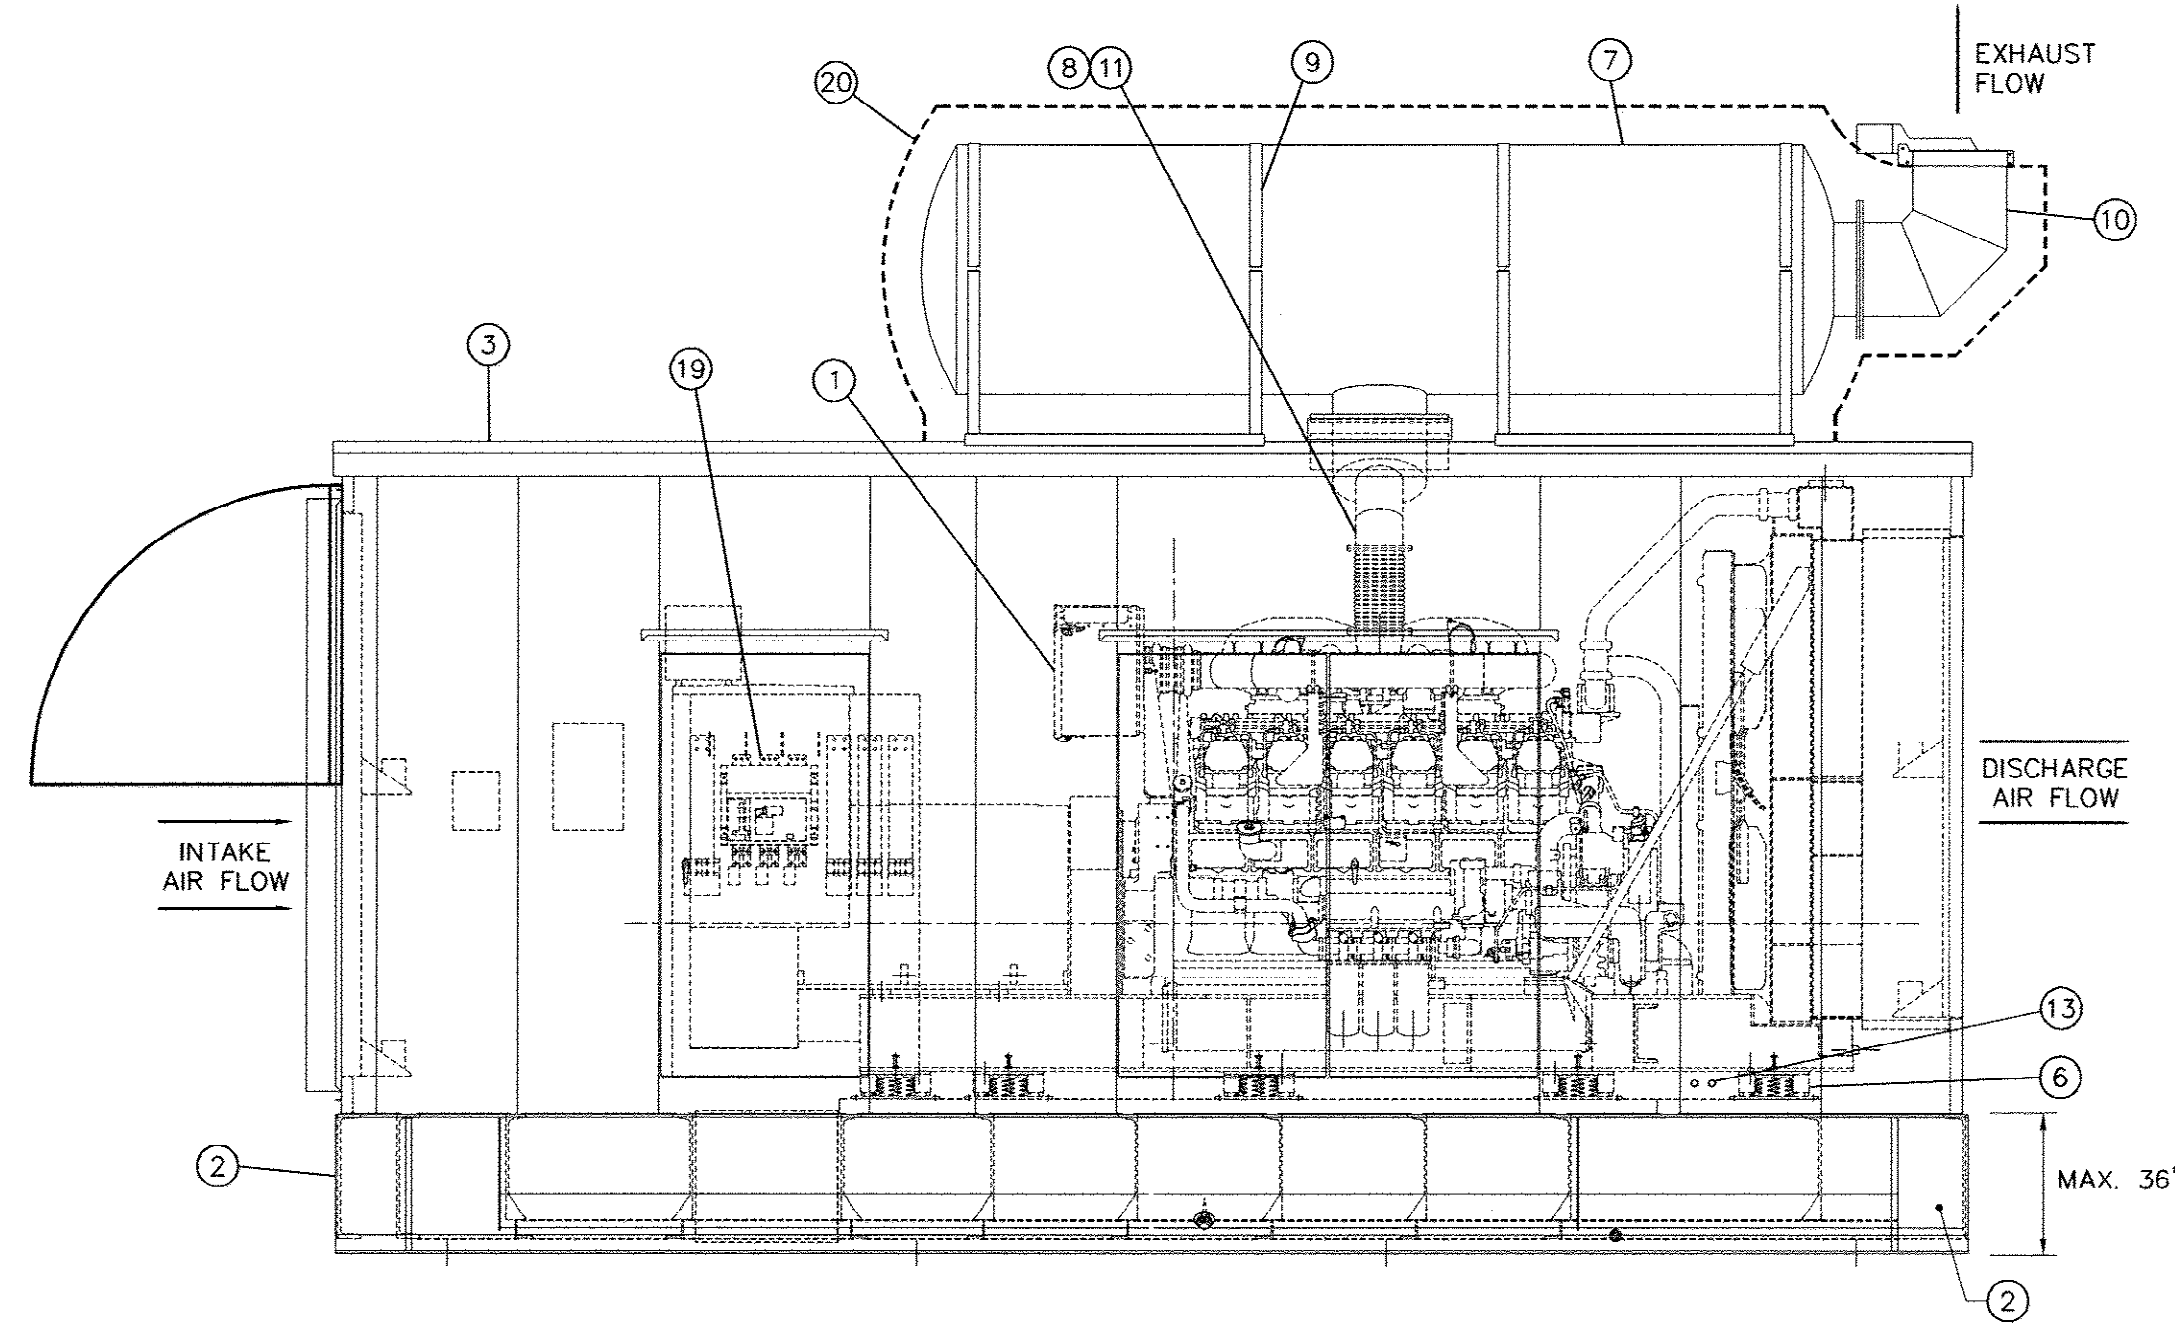

ENGINE GENERATOR SET - RIGHT SIDE VIEW
NOT TO SCALE


NEW GENERATOR SET
PREFABRICATED WALK-IN WEATHERPROOF HOUSING PLAN
SCALE: 1/4" = 1'-0"

- NOTES:
1. PROVIDE ALL THE NECESSARY GRADING AND EARTH BACKFILLING TO ACCOMPLISH PAD ELEVATIONS INDICATED.
 2. EXACT DIMENSIONS SHALL BE ADJUSTED TO FIT ENGINE GENERATOR SET AND EQUIPMENT SUBMITTAL.
 3. HOUSING OUTLETS AND HOUSING EQUIPMENT SHALL BE FACTORY PROVIDED WITH EQUIPMENT, CONDUIT, MATERIALS AND METHODS CONFORMING TO THE CONTRACT SPECIFICATIONS. REFER TO SECTION 16610 FOR SPECIFIC REQUIREMENTS RELATED TO SWITCHBOARD AND GENERATOR SET.
 4. ALL ELECTRICAL COMPONENTS SHALL BE U.L. LISTED.
 5. PROVIDE WEATHER PROTECTIVE HOODS OVER AIR INTAKE LOUVERS TO PREVENT RAIN FROM COMING INTO ENCLOSURE UNDER STORMY CONDITIONS.

COMP	QTY	DESCRIPTION
1	1	1500 KW PRIME RATED DIESEL ENGINE GENERATOR SET.
2	1	PROVIDE UL LABELED "IN-BASE" FUEL TANK WITH CAPACITY FOR 4000-GALLON RATED FUEL TANK. PROVIDE 10% CAPACITY SECONDARY CONTAINMENT TANK, LOW FUEL LEVEL ALARM SWITCHES, SECONDARY CONTAINMENT ALARM SWITCHES AND SIX-POINT LIFT PROVISIONS
3	1	ALUMINUM ENCLOSURE - WITH (2) 36W X 72H AND (2) 72W X 72H ACCESS DOORS AND STAINLESS STEEL DOOR HANDLES AND HINGES (APPROXIMATE DIMENSIONS)
4	3	MOTORIZED AIR INTAKE LOUVER WITH STAINLESS STEEL WIRE MESH BIRDSCREEN
5	2	MOTORIZED RADIATOR DISCHARGE LOUVER
6	10	VIBRATION SPRING ISOLATORS
7	1	EXHAUST SILENCER - CRITICAL GRADE
8	1	WYE TYPE EXHAUST FLEXIBLE CONNECTION WITH RAINSKIRT
9	4	SILENCER MOUNTING BRACKET
10	1	90 DEGREE EXHAUST ELBOW WITH RAINCAP
11	1	THERMAL INSULATION BLANKET GROUP FOR FLEX CONNECTION, MANIFOLDS AND TURBOCHARGER
12	1	FUEL/WATER SEPARATOR
13	1	OIL, WATER AND FUMES DISPOSAL LINES
14	1	BATTERIES, RACKS, CABLES AND 120VAC, 75 WATT HEATER PADS WITH THERMOSTAT
15	1	BATTERY CHARGER - 24VDC, 10 AMP
16	1	WALL MOUNTED PANELBOARD "GP" AS SCHEDULED ON SHEET E-8.
17	4	INTERIOR FLOURESCENT LIGHT WITH (2) 3-WAY WALL SWITCHES
18	2	DUPLEX RECEPTACLE - 120VAC, 20 AMP, GFI PROTECTED
19	1	CIRCUIT BREAKER - 3000 AMP, 3-POLE WITH 24VDC SHUNT TRIP AND GROUND FAULT ALARM.
20	1	INSULATION, AS SPECIFIED, FOR SILENCER AND RELATED PIPING WITH ALUMINUM SHEATHING/WEATHER PROTECTING JACKET
21	1	PROVIDE DOOR MONITORING SWITCHES WITH N.C. CONTACTS.
22	1	480-240/120V, 1-PHASE DRY TYPE TRANSFORMER - 25KVA
23	1	100A, 2P FUSED SWITCH SUITABLE FOR SERVICE ENTRANCE.

REVISIONS			
SYM.	DESCRIPTION	DATE	BY

McCracken & Lopez, P.A.
Consulting Engineers
1300 Baxter Street, Suite 350
Charlotte, North Carolina 28204
Post Office Box 32515
Charlotte, North Carolina 28232
Telephone 704/376-7072
Fax 704/376-4465

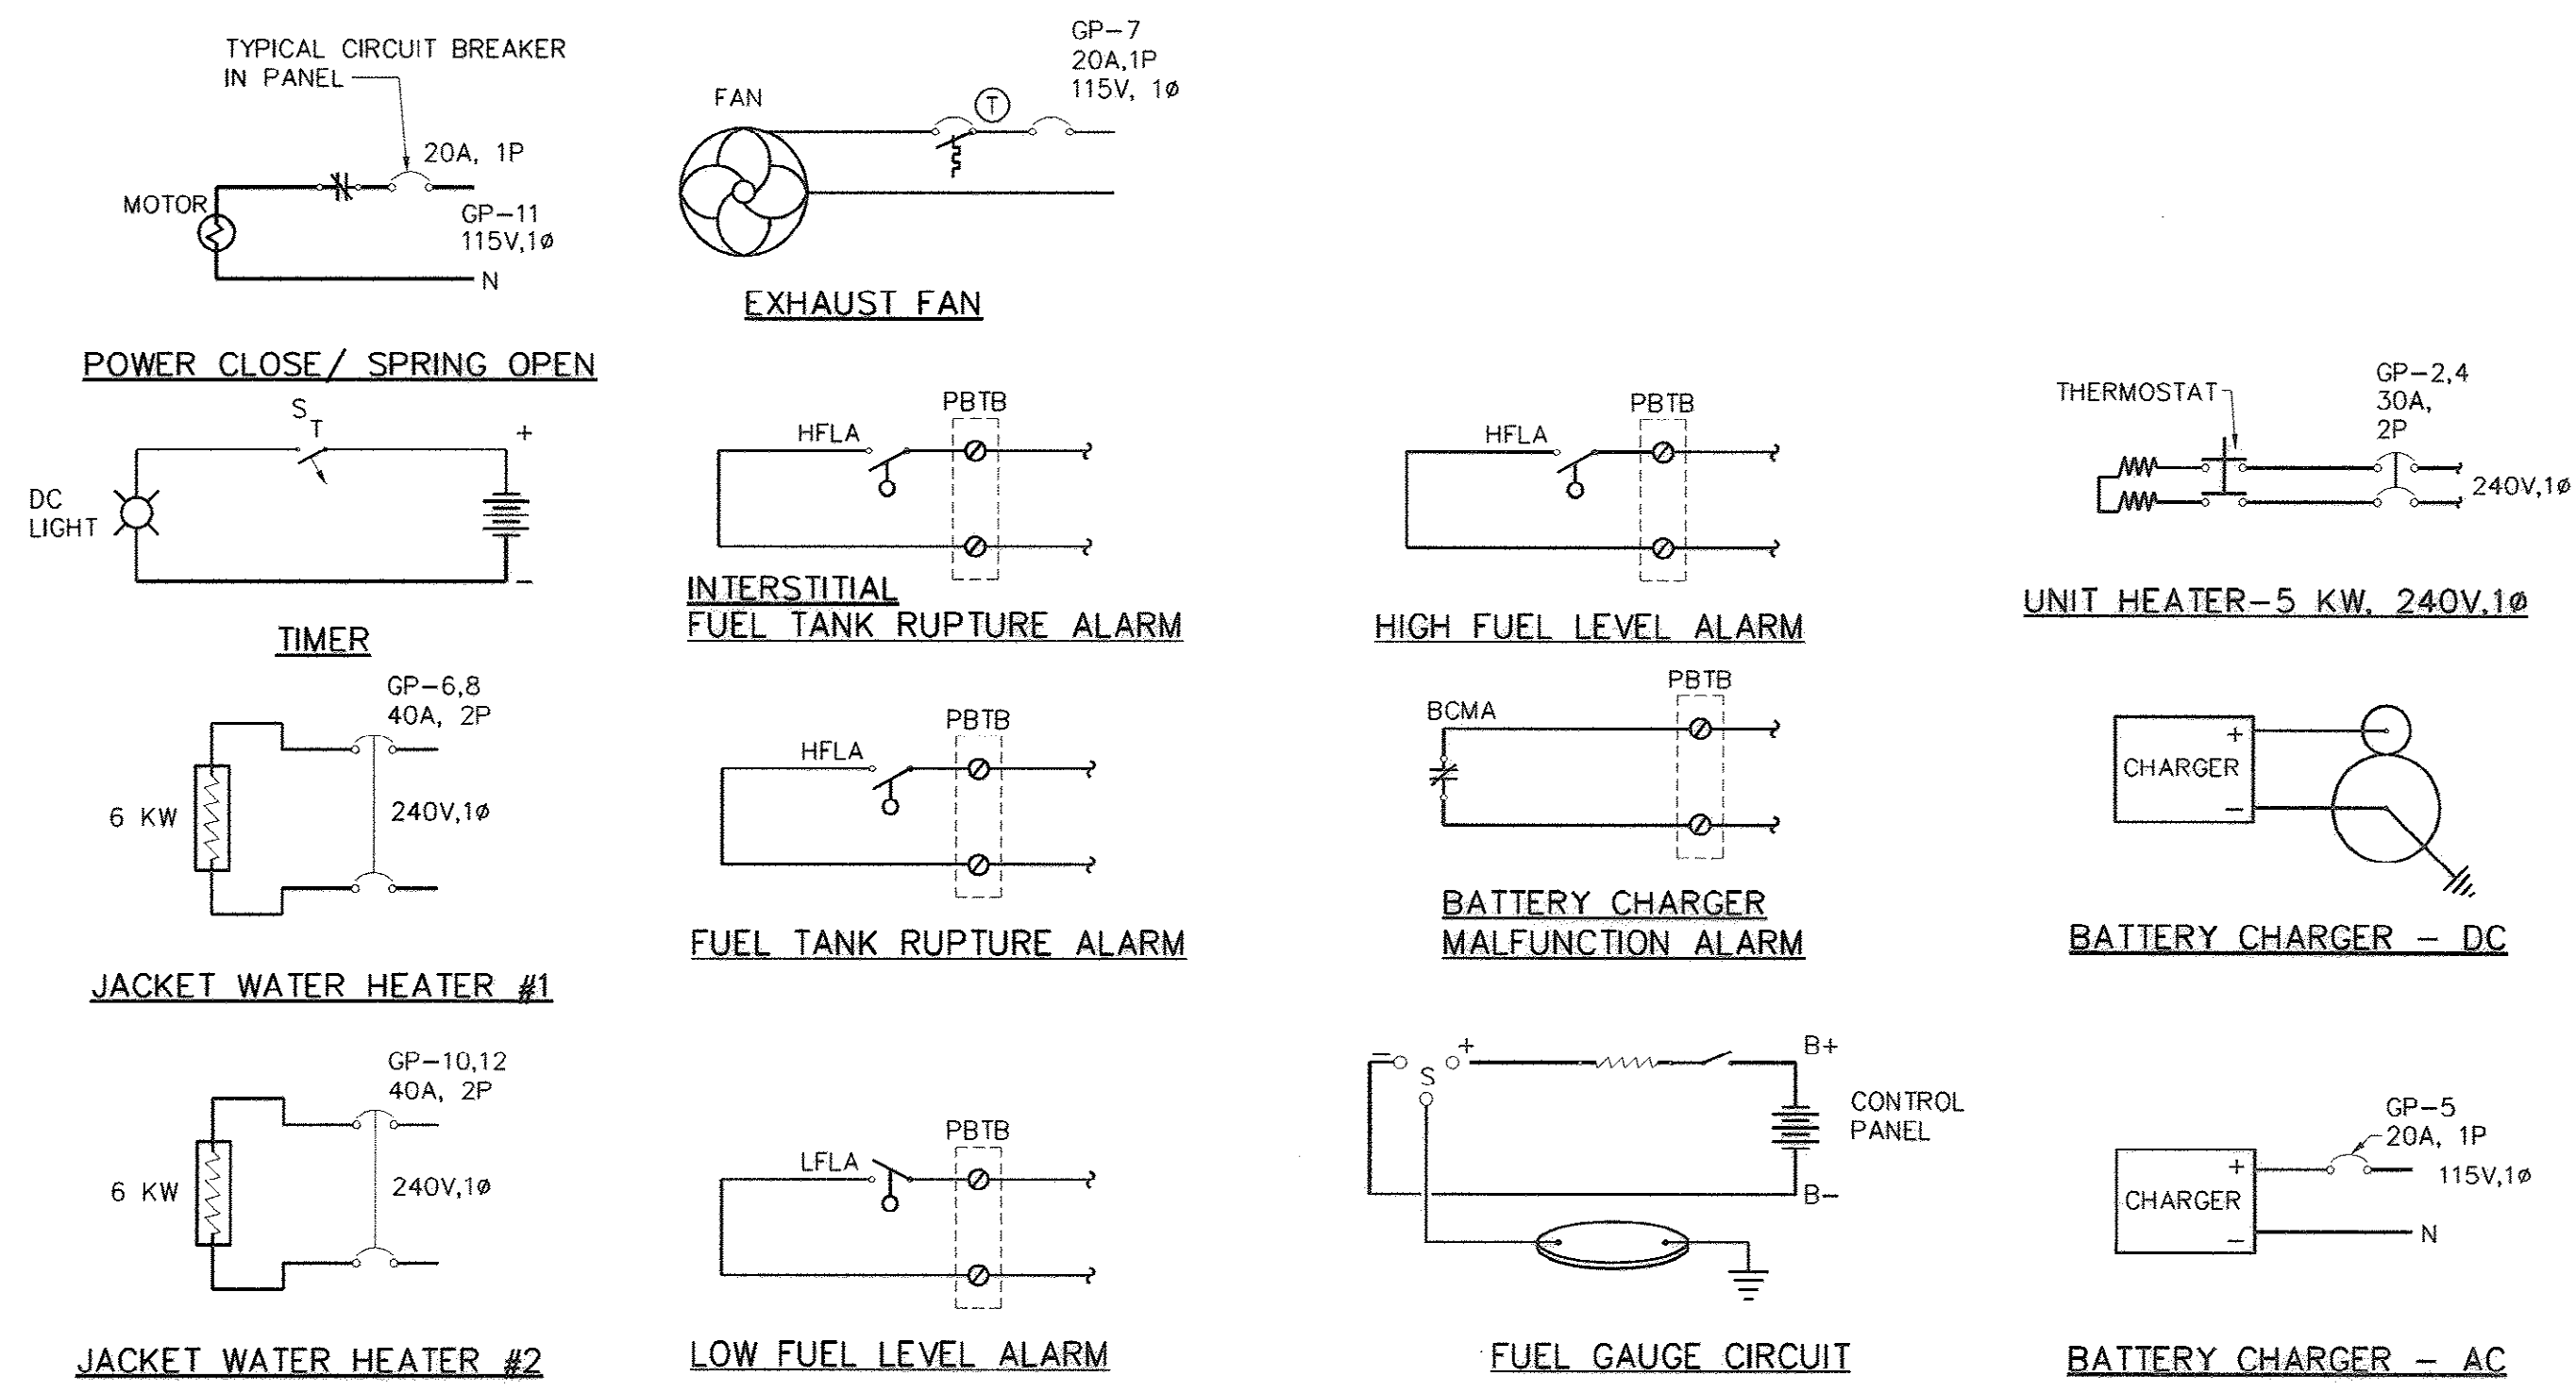

GENERATOR SET ENCLOSURE - ACCESSORY WIRING - CONNECT ALL LINE VOLTAGE WIRE TO PANEL
NOT TO SCALE

- NOTE:
1. TANK INSTALLER MUST OBTAIN SEPARATE TANK PERMIT TO SATISFY EPA AND STATE ENVIRONMENTAL PROTECTION REGULATIONS.
 2. ALARMS SHOWN HERE SHALL BE TRANSMITTED TO RTU VIA MODBUS NETWORK CONNECTION AS SPECIFIED ON SECTION 16610. IN ADDITION PROVIDE REMOTE ALARM ANNUNCIATOR IN ELECTRICAL BUILDING.
 3. PROVIDE ADDITIONAL CIRCUITS AS REQUIRED TO WIRE ALL ELECTRICAL ITEMS IN THE ENCLOSURE.
 4. PROVIDE ADDITIONAL ALARMS AND CONTROLS TO SATISFY IBC2003.

Hobbs, Upchurch & Associates, P.A.
Consulting Engineers, Surveyors & Land Planners
Southern Pines, North Carolina 28387
300 S.W. Broad Street, Southern Pines, North Carolina 28387
Phone: (910) 692-5516 - Fax: (910) 692-7342


ENGINE GENERATOR SET
PLAN AND DETAILS

PERRY ROAD WATER
BOOSTER PUMP STATION
UPGRADE
GRAND STRAND WATER &
SEWER AUTHORITY

DATE:	9-5-2008
DESIGNED:	DL
DRAWN:	SMI
CHECKED:	DL
SCALE:	AS SHOWN
SHEET NO.	E-14


AS-BUILT 9-5-08

12-250-039/36 W

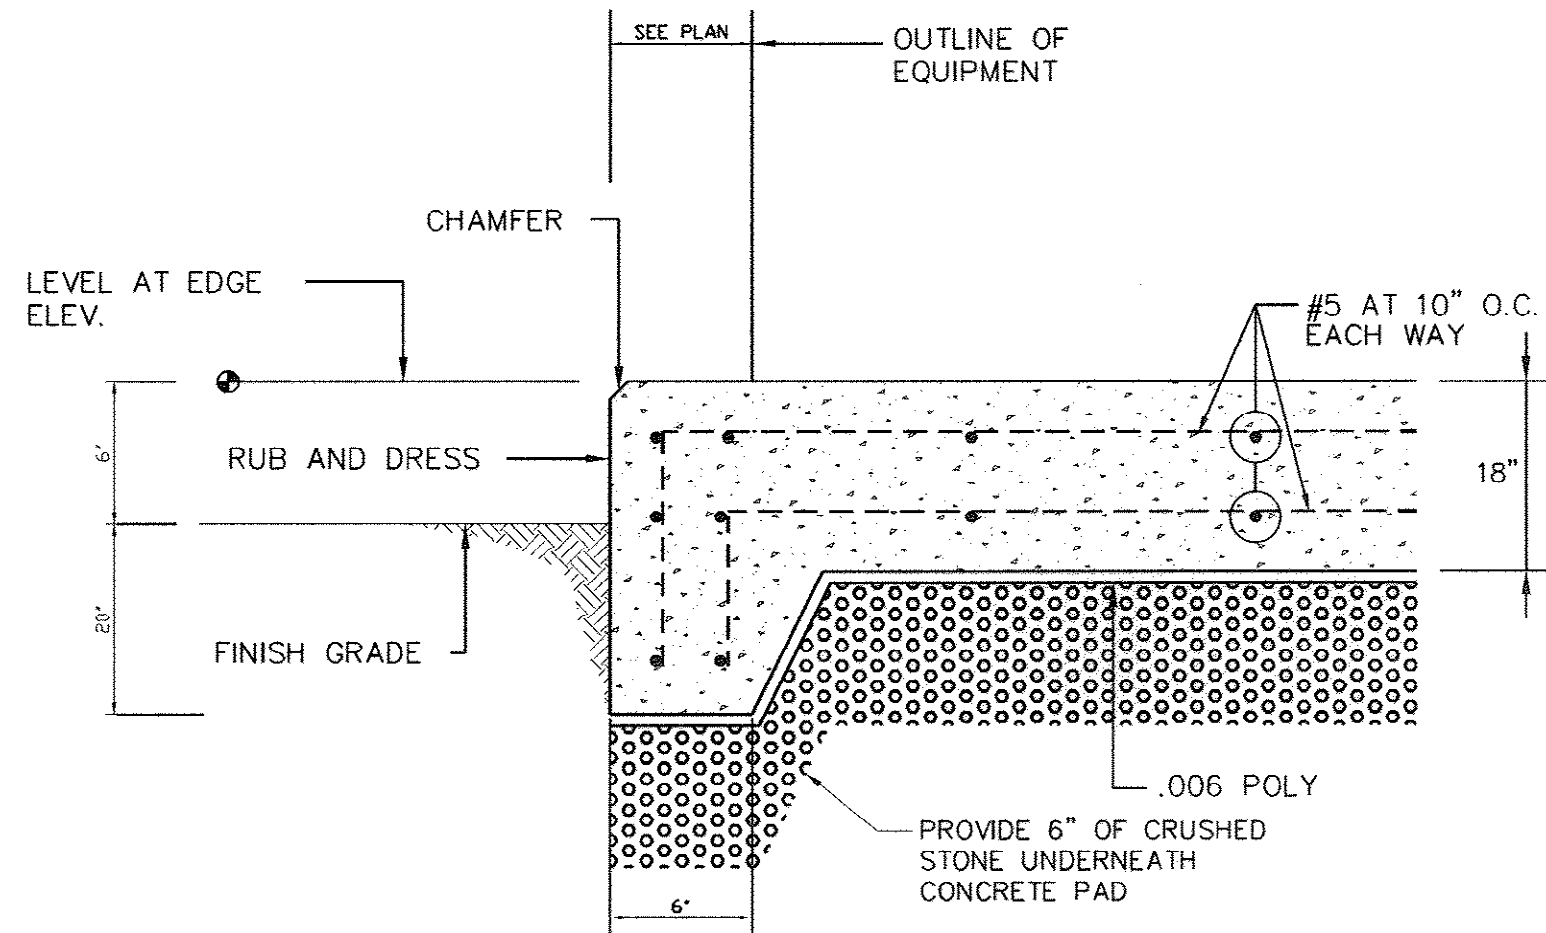

STRUCTURAL CONCRETE EQUIPMENT PAD


NOT TO SCALE

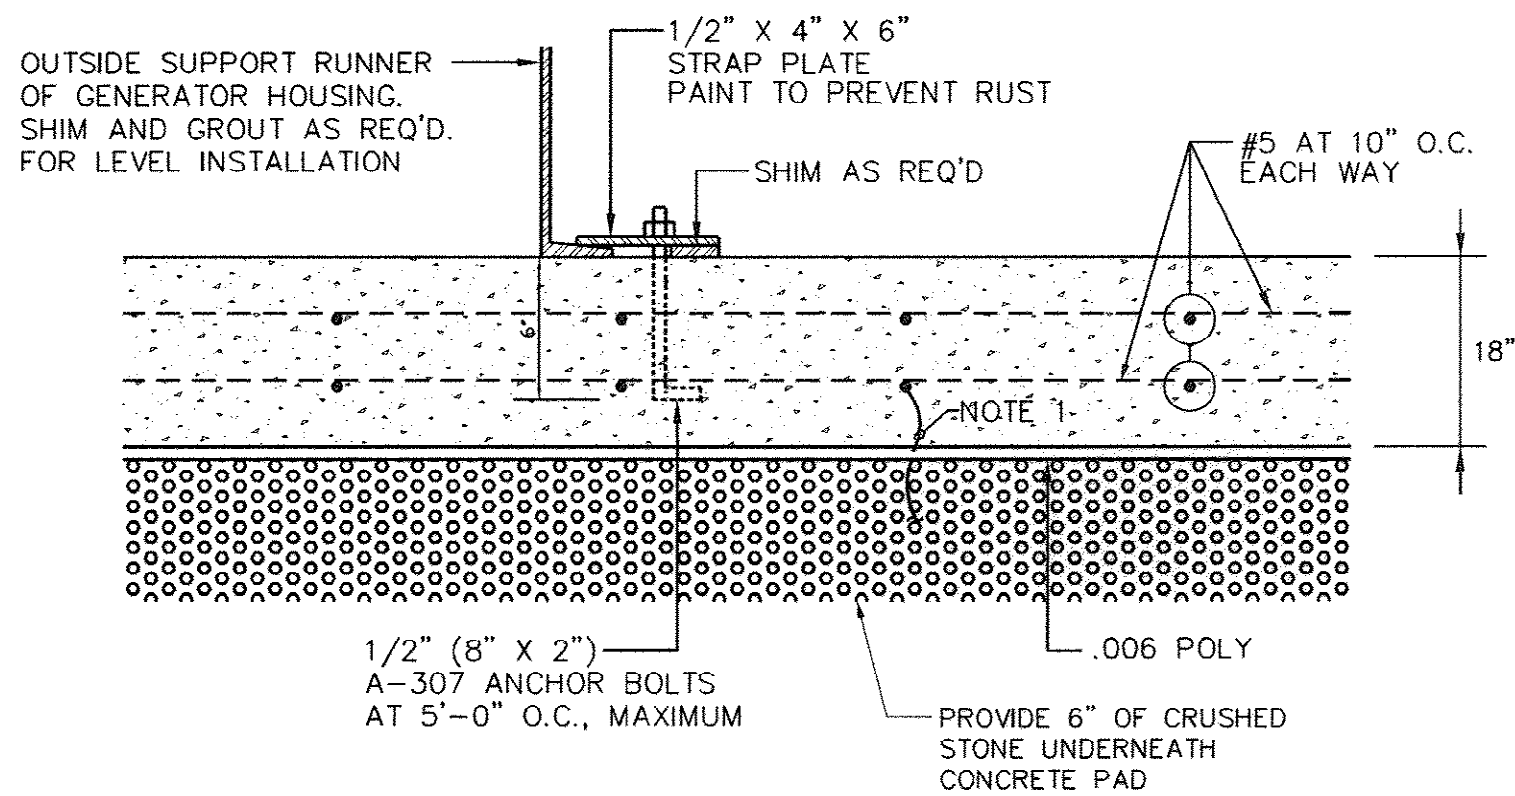


ANCHOR DETAIL

NOT TO SCALE


- NOTES:
1. CONNECT GROUNDING ELECTRODE TO REBAR UTILIZING A UL LISTED MECHANICAL CONNECTOR.

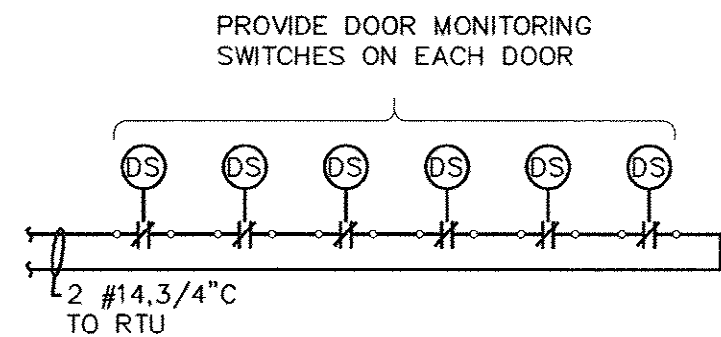


DOOR MONITORING ALARM

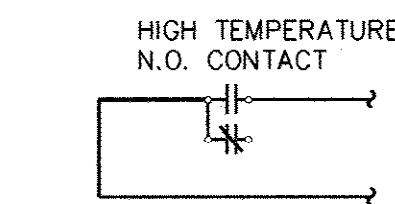


HIGH PRESSURE TEMPERATURE ALARM

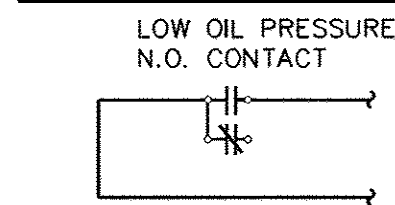

LOW OIL PRESSURE ALARM

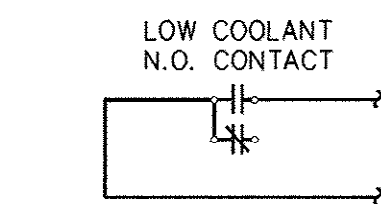

LOW COLLANT ALARM

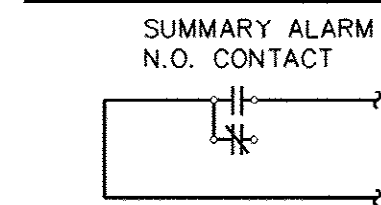

SUMMARY ALARM

GENERATOR SET ALARMS WIRING DIAGRAMS

NOT TO SCALE

CONSTRUCTION NOTES FOR GENERATOR SET CONCRETE PAD SITEWORK

1. CLEAR AND GRUB VEGETATION AND OTHER ORGANIC MATTER IN AREA FOR SITE WORK. STRIP TOPSOIL FOR ENTIRE DEPTH AND STOCK PILE FOR RESPREADING AT COMPLETION OF THIS PROJECT.
2. THE CONTRACTOR SHALL EMPLOY A TESTING LABORATORY TO CONFIRM AND TO CERTIFY THE SOIL AND CONCRETE REQUIREMENTS AS INDICATED ON THE DRAWINGS AND IN THE PROJECT SPECIFICATIONS.
3. FILLS AND BACKFILLS SHALL BE COMPACTED AS FOLLOWS:
A. TOP 12 INCHES = 100 PERCENT PER ASTM D698
B. ALL OTHERS = 95 PERCENT PER ASTM D698
4. FILL MATERIALS SHALL BE SELECT; FREE OF ANY ORGANIC MATTER, DEBRIS, HARD LUMPS, AND ROCK PARTICLES LARGER THAN 2 INCHES. MAXIMUM DRY DENSITY AT OPTIMUM MOISTURE CONTENT SHALL BE 100 POUNDS PER CUBIC FOOT AS DETERMINED BY ASTM D698. PLASTICITY INDEX (P.I.) SHALL NOT EXCEED 15.
5. SOIL BEARING PRESSURE USED IN FOUNDATION DESIGN IS 3000 PSF. HAVE SOILS ENGINEER CONFIRM AND CERTIFY BEARING CONDITIONS.
6. ELEVATIONS SHALL BE THE EDGE OF EXTERIOR CONCRETE PAD.
7. ALL DISTURBED LAWN AREAS SHALL BE SEEDED AND GRASSED.
8. ALL CONCRETE WORK SHALL COMPLY WITH ACI 318.
9. CAST-IN-PLACE CONCRETE SHALL BE 4000 PSI, AIR ENTRAINED.
10. REINFORCING STEEL SHALL BE AS FOLLOWS:
A. REINFORCING BARS: DEFORMED BARS HAVING A MINIMUM YIELD STRENGTH OF 60 KSI (ASTM A615, GRADE 60).
11. CONCRETE COVER FOR REINFORCING SHALL BE AS FOLLOWS:
A. UNFORMED CONCRETE IN CONTACT WITH THE EARTH = 3 INCHES.
12. CURE CONCRETE FOR A MINIMUM OF SEVEN (7) DAYS WITH LIQUID CURING COMPOUND CONFORMING TO ASTM C-309. ALLOW FOURTEEN (14) DAYS MINIMUM CURING TIME PRIOR TO SETTING GENERATORS.
13. GROUT SHALL BE PRE-MIXED, NON-METALLIC GROUT HAVING A MINIMUM COMPRESSIVE STRENGTH OF 7000 PSI AT 28 DAYS.
14. THE CONTRACTOR SHALL PERFORM A THOROUGH FIELD INSPECTION OF THE EXISTING CONDITIONS PRIOR TO BIDDING THE WORK. THE CONTRACTOR SHALL NOTE AND INCLUDE IN HIS BID ANY EXTRA WORK ITEMS NEEDED TO COMPLETE THIS PROJECT.
15. FIELD VERIFY ALL EXISTING CONDITIONS, ELEVATIONS, AND DIMENSIONS. REPORT FINDINGS AND ANY DISCREPANCIES TO THE ENGINEER FOR EVALUATION PRIOR TO BEGINNING WORK.
16. ALL NEW MATERIALS SHALL BE INSTALLED IN STRICT ACCORDANCE WITH THE MANUFACTURER'S RECOMMENDATIONS OR INSTRUCTIONS, AND STANDARD INDUSTRY PRACTICES.
17. CONTRACTOR SHALL ERECT AND MAINTAIN ALL SIGNS, BARRICADES, AND OTHER WARNING DEVICES REQUIRED TO SAFELY PREFORM THE WORK.
18. VERIFY CONCRETE PAD SIZE WITH THE GENERATOR SET SUPPLIER PRIOR TO COMMENCING WORK. DIMENSIONS SHOWN HERE ARE ONLY APPROXIMATE.
19. VERIFY EXACT LOCATION OF PAD WITH OWNER PRIOR TO STARTING.
20. VERIFY SPACING AND LOCATION OF ANCHOR BOLTS WITH THE GENERATOR SUPPLIER AND APPROVED SHOP DRAWINGS.
21. STEEL PLATES AND SHIMS SHALL BE A-36 - HOT DIP GALVANIZED.
22. PROVIDE ALL OF THE NECESSARY EARTH MOVING TO PREPARE SITE FOR GENERATOR PAD.

REVISIONS			
SYM.	DESCRIPTION	DATE	BY

McCracken & Lopez, P.A.
Consulting Engineers
1300 Baxter Street, Suite 350
Charlotte, North Carolina 28204
Post Office Box 32515
Charlotte, North Carolina 28232
Telephone 704/376-7072
Fax 704/376-4465

Hobbs, Upchurch & Associates, P.A.
Consulting Engineers, Surveyors & Land Planners
Southern Pines, North Carolina 28387
300 S.W. Broad Street, Southern Pines, North Carolina 28387
Phone: (910) 692-5616 - Fax: (910) 692-7342



ENGINE GENERATOR SET
CONCRETE PAD DETAILS
SCHEDULE AND DIAGRAMS

PERRY ROAD WATER
BOOSTER PUMP STATION
UPGRADE
GRAND STRAND WATER &
SEWER AUTHORITY

DATE: 9-5-2008

DESIGNED: DL

DRAWN: SMI

CHECKED: DL

SCALE: AS SHOWN

SHEET NO.

E-15

OF: 15 VERSION: 4


LOAD (KVA)										LOAD (KVA)				
PH1	PH2	DESCRIPTION	WIRE SIZE	BRKR RATG	NO.	CT.	NO.	BRKR RATG	WIRE SIZE	DESCRIPTION	PH1	PH2		
0.4		LIGHTING	12	20/1	1		2	30/2	10	UNIT HEATER, 3KW	2.5			
	0.4	RECEPTACLES	12	20/1	3		4		10			2.5		
0.4		BATTERY CHARGER	12	20/1	5		6	40/2	8	JACKET WATER NTR. #1	3.0			
	1.2	FAN	12	20/1	7		8		8	(6 KW)		3.0		
0.5		GEN. HEATER (IF NEEDED)	12	20/1	9		10	40/2	8	JACKET WATER NTR. #2	3.0			
	0.2	DAMPER CONTROLS	12	20/1	11		12		8	(6 KW)		3.0		
0.0		SPARE		20/1	13		14	15/3		SPARE	0.0			
	0.0	SPARE		20/1	15		16				0.0			
0.0		SPARE		20/1	17		18				0.0			
	0.0	S.O.			19		20			S.O.		0.0		
0.0		S.O.			21		22			S.O.		0.0		
	0.0	S.O.			23		24			S.O.		0.0		
0.0					25		26				0.0			
	0.0				27		28				0.0			
0.0					29		30				0.0			
	0.0				31		32				0.0			
0.0					33		34				0.0			
	0.0				35		36				0.0			
0.0					37		38				0.0			
	0.0				39		40				0.0			
0.0					41		42				0.0			
TYPE: BRANCH CIRCUIT					GROSS PHASE TOTALS					CONNECTED LOAD: 84 AMPERES				
MOUNTING: SURFACE					PH1= 9.8 KVA					LIGHTING				
SUPPLY: 240/120V, 1-PH, 3W					PH2= 10.3 KVA					HEATING				
MAINS: 150A M.C.B.										A/C MOTORS & HEAT PUMPS				
SCIR: 10,000 A										AIR HANDLING & EXH FANS				
NOTES:										RECEPTACLES				
1. SUITABLE FOR SERVICE ENTRANCE.										ELECTRIC WATER HEATING				
2. TO BE PROVIDED AS PART OF GENERATOR SET ENCLOSURE IN CONFORMANCE WITH SECTION 16470.										ELEVATORS				
										FOOD PROCESSING				
										PROCESS				
										MISCELLANEOUS				
										TOTAL CONNECTED LOAD				

PANELS GP

20.1 KVA

AS-BUILT 9-5-08

12-250-030/36W

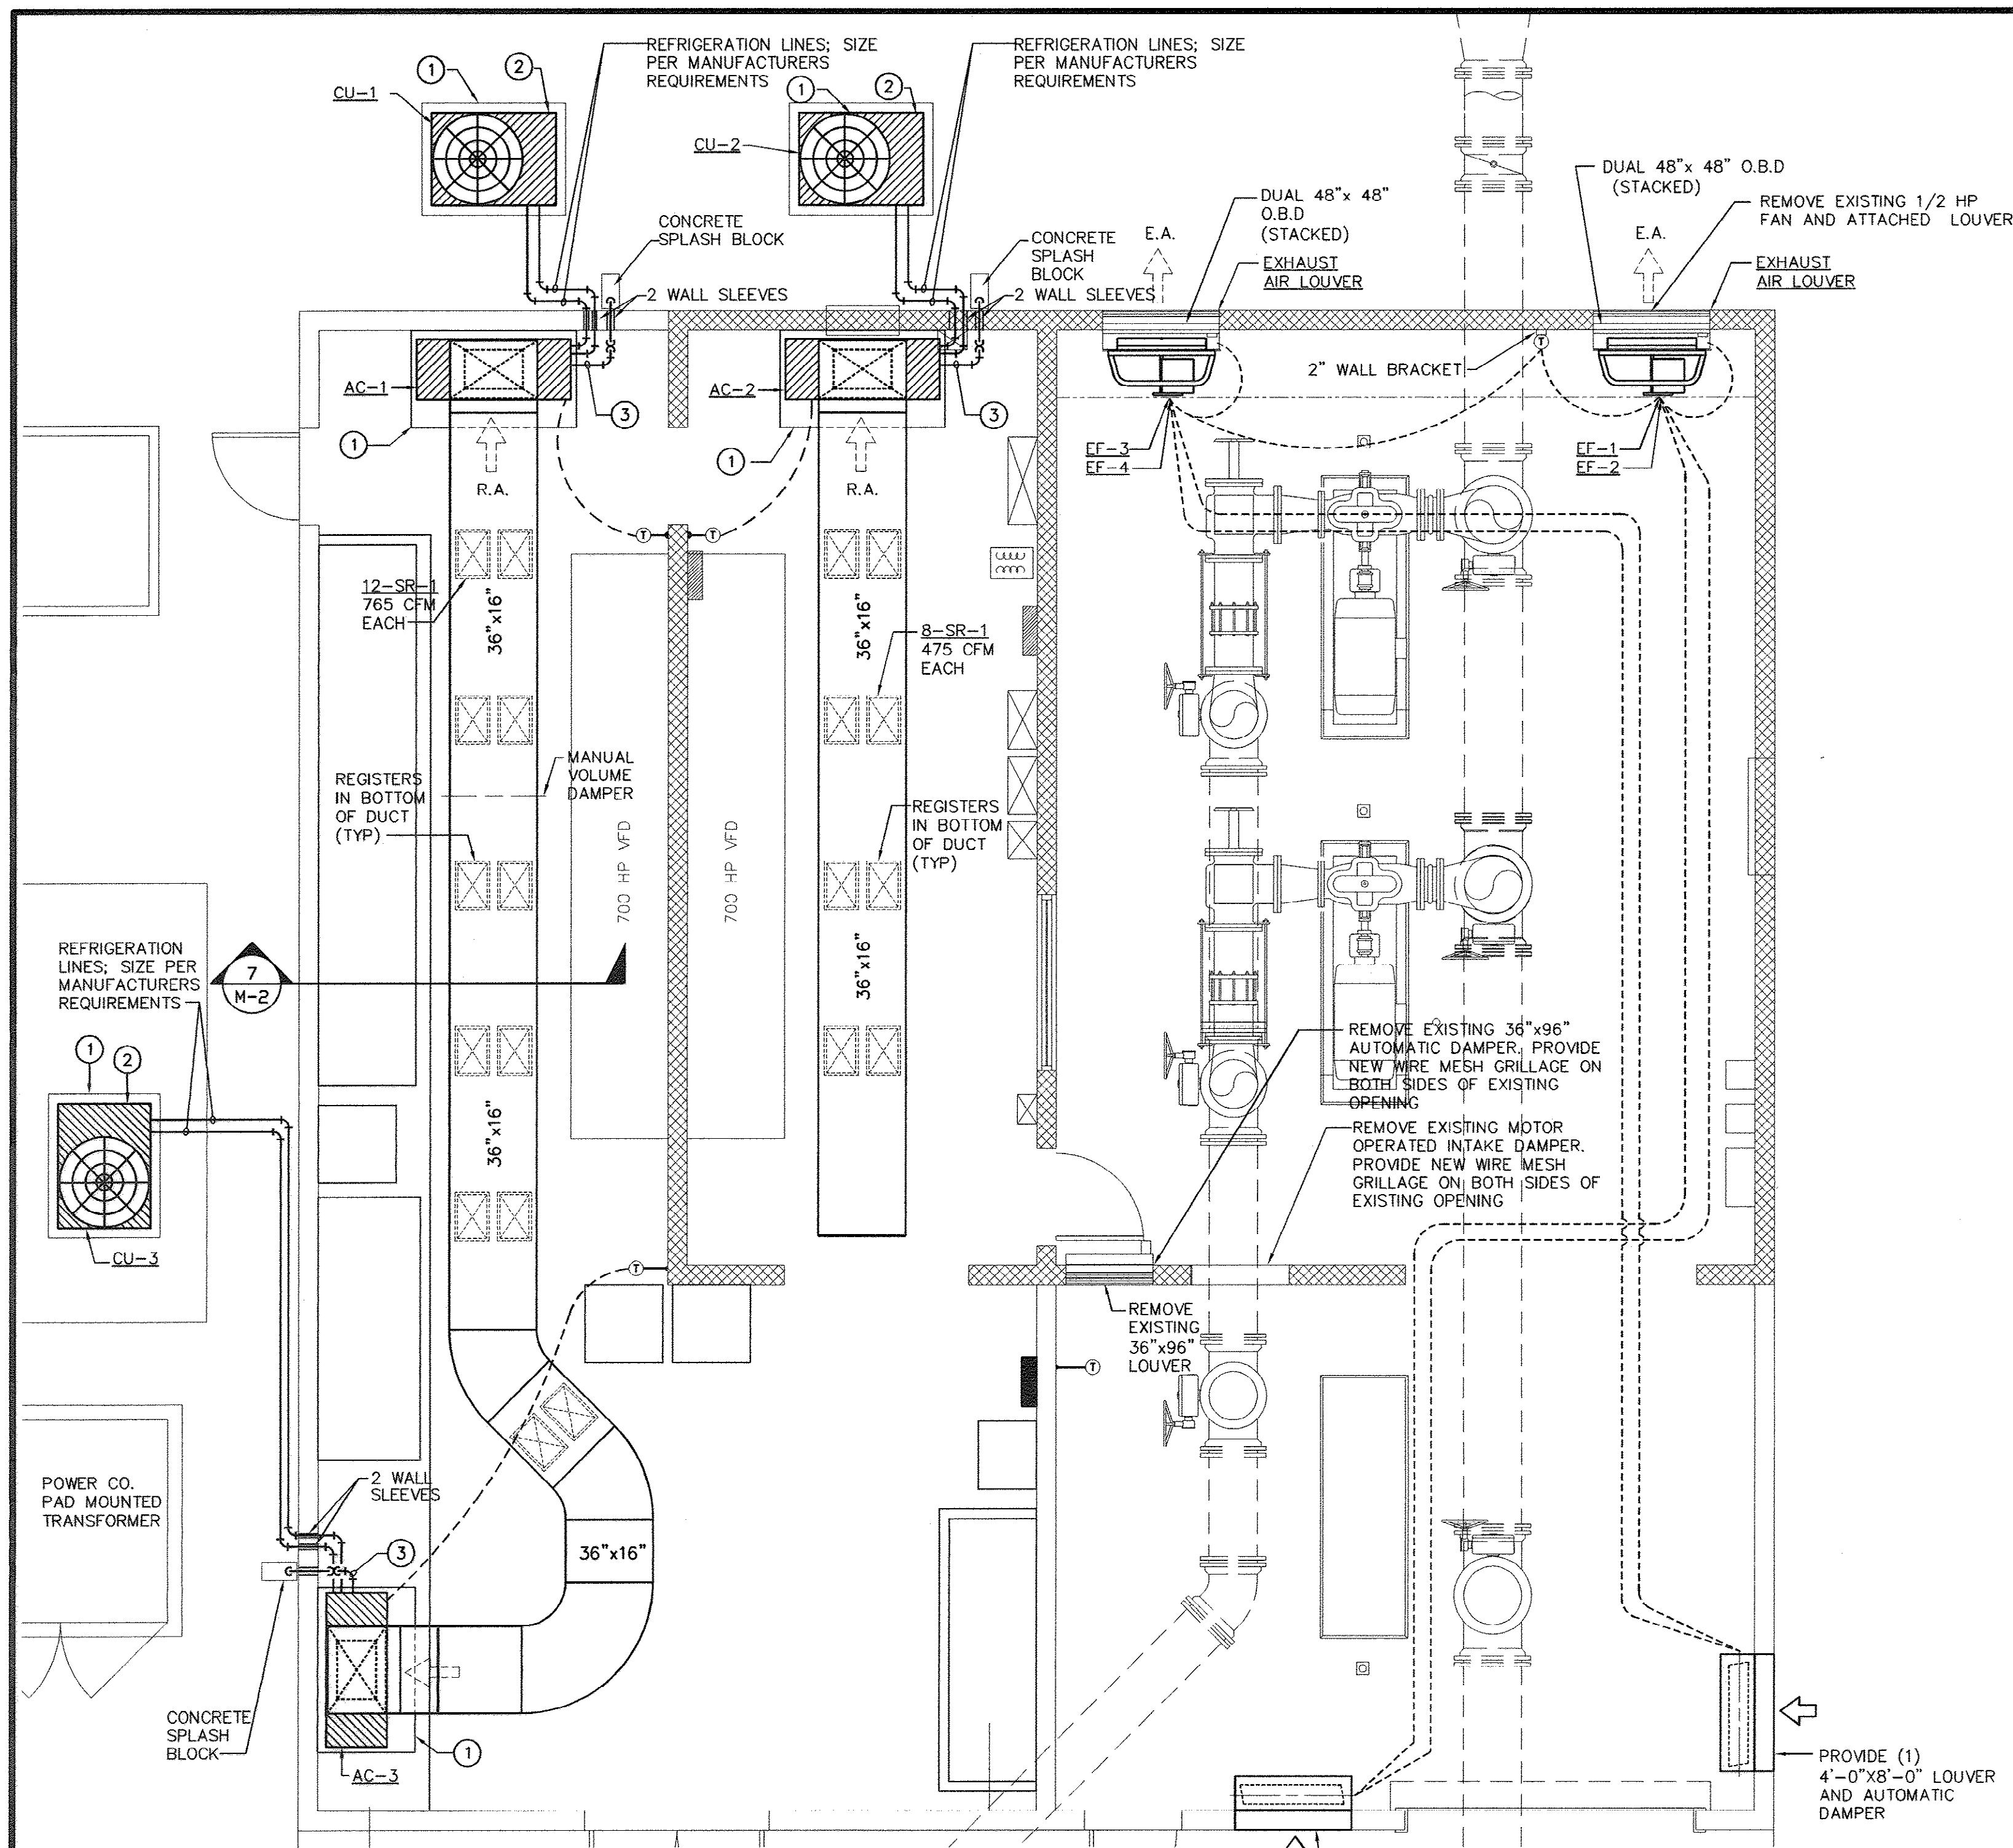

PERRY ROAD MECHANICAL PLAN
 SCALE: 1/4" = 1'-0"
 1/4" = 1'-0" 2' 0' 2' 4' 8'

DRAWING LIST

M-1 FLOOR PLAN, MECHANICAL LEGEND, GENERAL NOTES, SCHEDULES.

M-2 MECHANICAL DETAILS CONTROL SEQUENCES.

SYMBOL	DESCRIPTION
S.A.	SUPPLY AIR
R.A.	RETURN AIR
E.A.	EXHAUST AIR
O.A.	OUTSIDE AIR
①	THERMOSTAT
SR	SUPPLY REGISTER
—CD—	CONDENSATE DRAIN
—RS—	REFRIGERANT SUCTION
—RL—	REFRIGERANT LIQUID
C.U.	CONDENSING UNIT
A.C.	AIR CONDITIONING UNIT
E.F.	EXHAUST FAN
O.B.D.	OPPOSED BLADE DAMPER
F.C.	FLEXIBLE CONNECTION
----	CONTROL WIRING

KEYED NOTES

- INSTALL ON MINIMUM 4"x4"x1" THICK CORK NEOPRENE PADS ON 6" THICK REINFORCED CONCRETE PAD ON GRADE.
- CONCRETE PAD TO HAVE RUBBED 3/4" CHAMFERED EDGES. PADS TO BE MINIMUM 3,000 LB TEST CONCRETE.
- 1" PVC CONDENSATE DRAIN CONNECTION WITH 2" TRAP. INSULATE WITH 1/2" THICK ARMAFLEX, PAINT WITH TWO COATS OF WHITE ARMAFLEX PAINT.
- CONSTRUCT DUCTWORK OF TYPE 3003-H14 TEMPERED ALUMINUM SHEETS TO SMAGNA STANDARDS. ALL JOINTS AND SEAMS SHALL BE SEALED WITH MASTIC SUCH AS UNITED DUCT SEALER OR HARDCAST IRON GRIP.
- AIR CONDITIONING UNITS SHALL BE MANUFACTURED BY TRANE OR APPROVED EQUAL.
- GRILLE AND REGISTERS SHALL BE MANUFACTURED BY NAILOR OR APPROVED EQUAL.
- REFRIGERATION PIPING TO BE CONSTRUCTED OF HARD DRAWN "ACR" COPPER TUBING WITH FORGED COPPER FITTINGS. SOLDER WITH 95-5 OR SILFOS LEAD FREE SOLDER EXCEPT AT EXPANSION VALVES. INSULATE REFRIGERANT SUCTION PIPING WITH 3/4" THICK ARMSTRONG ARMAFLEX INSULATION. PAINT WITH TWO COATS OF ARMSTRONG ARMAFLEX WHITE PAINT.
- PROVIDE LINTELS (PAINTED) ABOVE ALL FRAMED OPENINGS IN MASONRY WALLS.
- INSULATE DUCT WORK WITH 2" THICK RIGID 4.25 LB DENSITY FIBERGLASS DUCT INSULATION WITH ALUMINUM JACKETING. INSTALL WITH GRIP NAILS OR STICK PINS AT 12" O.C. AND WITH IN 2" OF EACH EDGE. VAPOR SEAL ALL SEAMS AND EDGES WITH 4" WIDE MATCHING ALUMINUM TAPE APPLIED WITH TALCOTE 70 WHITE ADHESIVE. PAINT EXTERIOR WITH 2 COATS OF FLAT WHITE PAINT. PAINT AFTER CLEANING, PREPPING AND PRIMING. PAINT TOP, BOTTOM, SIDES, AND ENDS. DO NOT PAINT STAINLESS STEEL REGISTERS.

NEW AIR DISTRIBUTION DEVICE SCHEDULE

DESIGNATION	NAILOR MODEL NO.	C.F.M. MAX.	PANEL SIZE	NECK SIZE	MATERIAL	REMARKS
SR-1	67DV	765	20"x14"	18"x12"	STAINLESS STEEL	O.B.D. (ADJ THRU FACE)

NEW EXHAUST FAN SCHEDULE

DESIGNATION	CFM	SP IN. WG.	WHEEL DIA. IN.	WHEEL RPM	DRIVE	MOTOR			SELECTED ON
						HP	RPM	VOLTS/PH	
EF-1	11,000	0.55	36	814	BELT	2	1750	460/3	GREENHECK
EF-2	11,000	0.55	36	814	BELT	2	1750	460/3	GREENHECK
EF-3	11,000	0.55	36	814	BELT	2	1750	460/3	GREENHECK
EF-4	11,000	0.55	36	814	BELT	2	1750	460/3	GREENHECK

- PROVIDE WITH BLADE AND BELT GUARDS.
- 200,000 HOUR L10 BEARINGS (GEASEABLE).
- STATICALLY AND DYNAMICALLY BALANCED.
- ODD NUMBER OF BLADES, MINIMUM OF 5.

NEW CONDENSING UNIT SCHEDULE

DESIGNATION	TYPE	AMB O.A. °F	CAPACITY NOM. TONS	ELECTRICAL				SELECTED ON
				VOLTS/PH	F.L.A.	MCA	MOCP	
CU-1	AIR COOLED	95°	10 TONS	460/3	12.1A	23.9A	30A	TRANE TTA120
CU-2	AIR COOLED	95°	10 TONS	460/3	12.1A	23.9A	30A	TRANE TTA120
CU-3	AIR COOLED	95°	10 TONS	460/3	12.1A	23.9A	30A	TRANE TTA120

- PROVIDE TWO COMPRESSORS, SCROLL TYPE.
- UNITS SHALL HAVE TWO REFRIGERANT CIRCUITS.
- PROVIDE WITH HEAD PRESSURE CONTROL FOR OPERATION DOWN TO 20 °F.
- UNITS TO MATCH AC UNIT COOLING COIL REQUIREMENTS.
- UNIT FINISHES TO BE SUITABLE FOR COASTAL MARINE APPLICATIONS.
- PROVIDE FILTER-DRYER ASSEMBLIES.
- INSTALL ON 1" THICK CORK NEOPRENE PADS.(4).

NEW A/C UNIT SCHEDULE

DESIGNATION	TYPE	CFM	E.S.P. IN. WG	COOLING (DX)				ELECT. HEAT		FAN			SELECTED ON
				SUCT. ° F	TOTAL BTU/HR	SENSIBLE BTU/HR	NO. OF CIRC.	KW	V/P	DRIVE	HP	V/P	
A/C-1	VERT	4,590	0.50"	460/3	3.4A	15A	(2)	5.0	460/3ø	3.4A	2	460/3ø	TRANE 2TWE120B3
A/C-2	VERT	4,590	0.50"	460/3	3.4A	15A	(2)	5.0	460/3ø	3.4A	2	460/3ø	TRANE 2TWE120B3
A/C-3	VERT	4,590	0.50"	460/3	3.4A	15A	(2)	5.0	460/3ø	3.4A	2	460/3ø	TRANE 2TWE120B3

- PROVIDE WITH A RETURN AIR INLET GRILLE (LOUVER BAR).
- PROVIDE WITH 2 STAGE COOLING ONE STAGE HEATING WALL THERMOSTAT.
- INSTALL ON THE 1" THICK CORK NEOPRENE VIBRATION ISOLATORS.
- PROVIDE WITH (4) 16"x25"x2" THICK PLEATED MEDIA FILTERS PER UNIT.
- PROVIDE BUILT IN DUET TYPE SMOKE DETECTOR WITH EACH A/C UNIT THAT SHALL TURN UNIT OFF IF SMOKE IS DETECTED IN RETURN AIR AND INCLUDE AUXILIARY NC/NC CONTACTS FOR REMOTE ALARM SYSTEM.


AS-BUILT 9-5-08

12-250-031/36 W

REVISIONS			
SYM.	DESCRIPTION	DATE	BY

McCracken & Lopez, P.A.
 Consulting Engineers
 1300 Baxter Street, Suite 350
 Charlotte, North Carolina 28204
 Post Office Box 32515
 Charlotte, North Carolina 28232
 Telephone 704/376-7072
 Fax 704/376-4465

Hobbs, Upchurch & Associates, P.A.
 Consulting Engineers, Surveyors & Land Planners
 Southern Pines, North Carolina 28387
 300 S.W. Broad Street, Southern Pines, North Carolina 28387
 Phone: (910) 692-5816 - Fax: (910) 692-7542

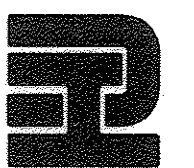


FLOOR PLAN,
 MECHANICAL
 LEGEND, GENERAL
 NOTES, SCHEDULES.

PERRY ROAD WATER
 BOOSTER PUMP STATION
 UPGRADE
 GRAND STRAND WATER &
 SEWER AUTHORITY


DATE: 9-5-2008
 DESIGNED: BG
 DRAWN: CADD
 CHECKED: RAM
 SCALE: AS SHOWN
 SHEET NO.

M-1


OF: 2 VERSION: 4

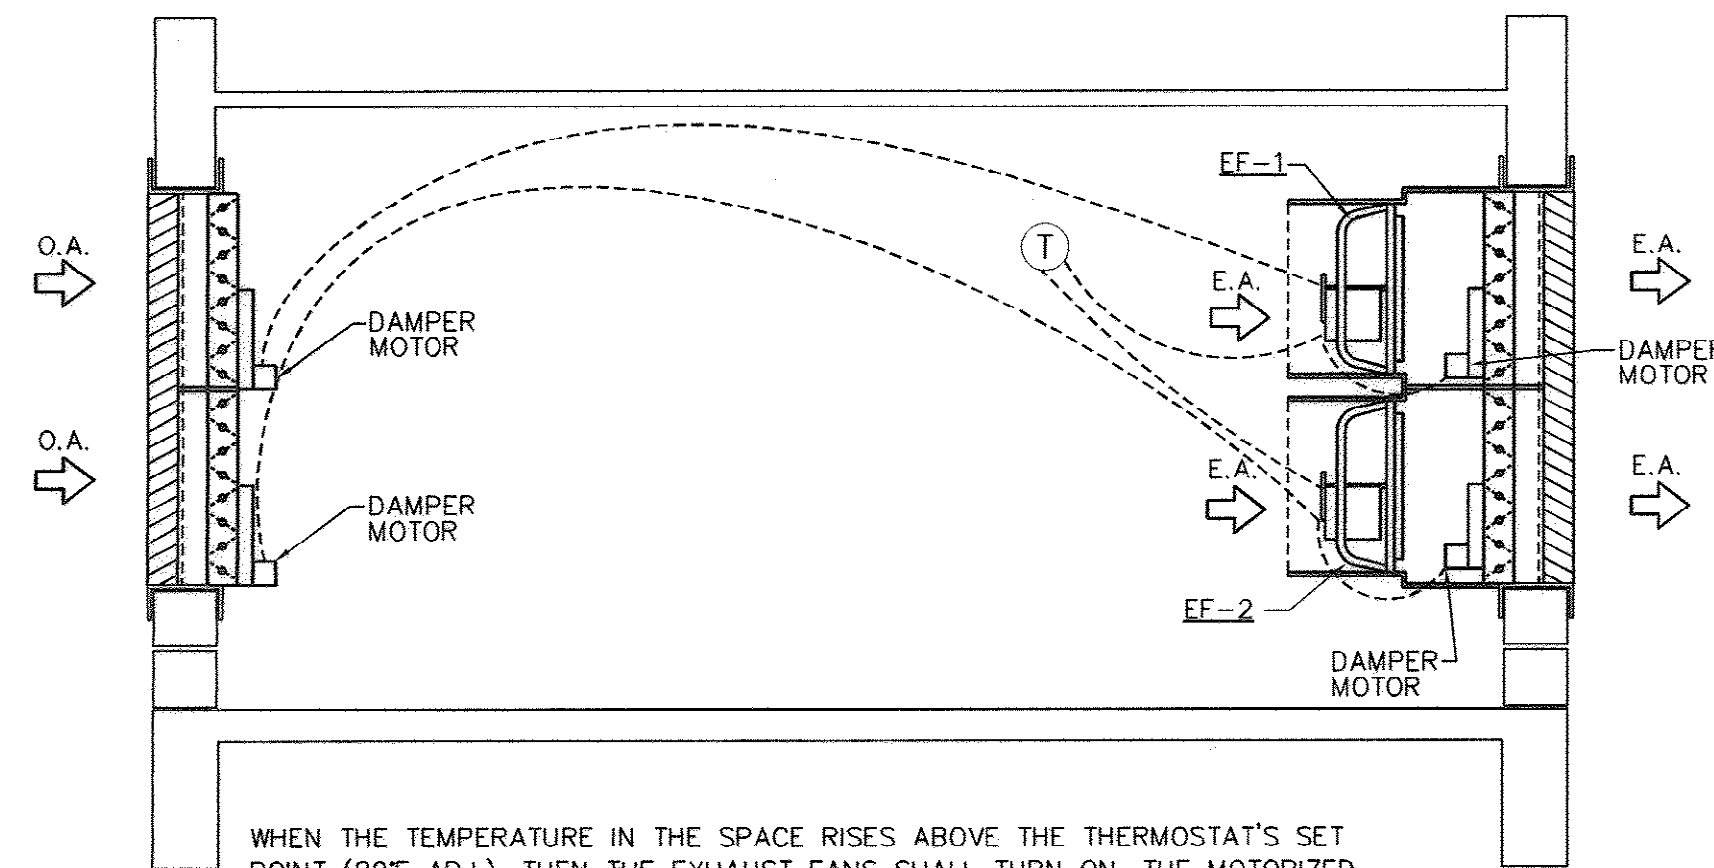

8 EXHAUST FAN CONTROL DIAGRAM / SEQUENCE OF OPERATION
M-2 NTS

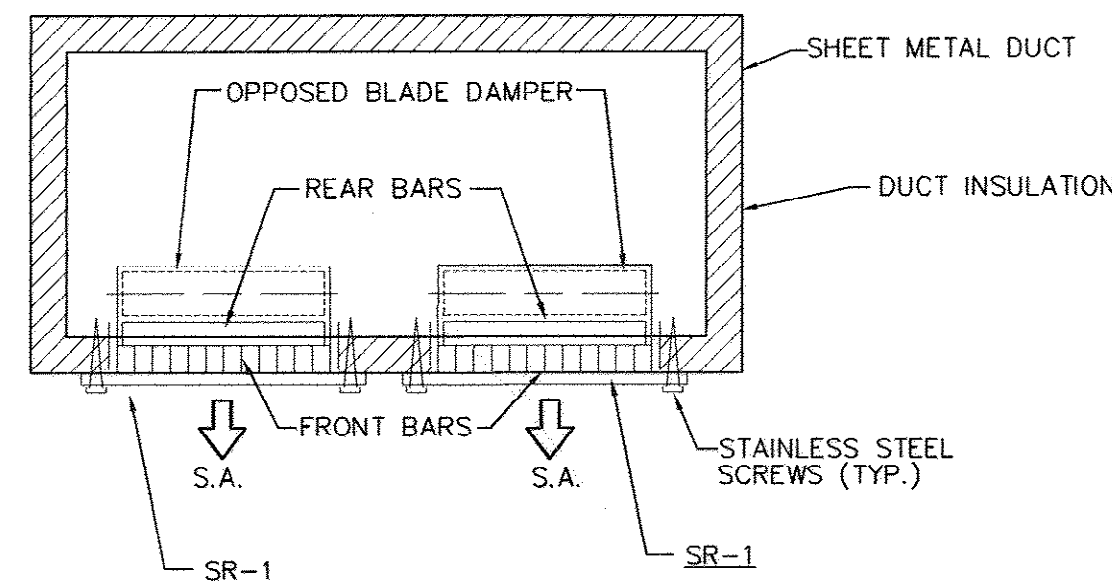


6 SUPPLY REGISTER DETAIL
M-2 NTS

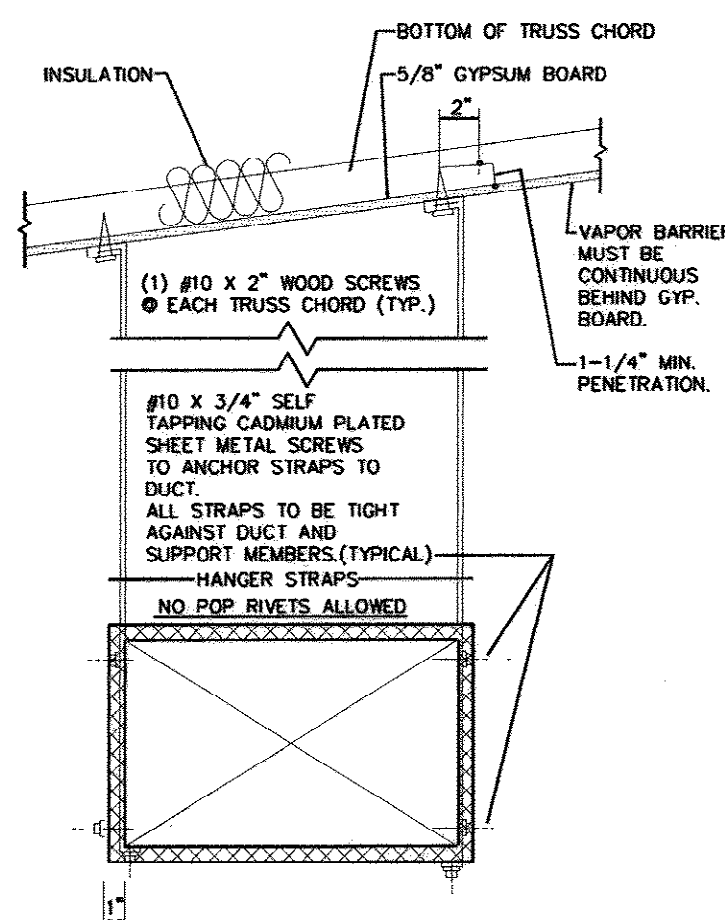


HANGER SIZES FOR RECTANGULAR DUCT			
MAX. SIDE	HANGER	HORIZONTAL SUPPORT ANGLE	MAXIMUM SPACING
UP TO 34"	1"x18" GAUGE STRAP	NONE REQUIRED	8'-0"


3 DUCT STRAP HANGER DETAIL
M-2 NTS

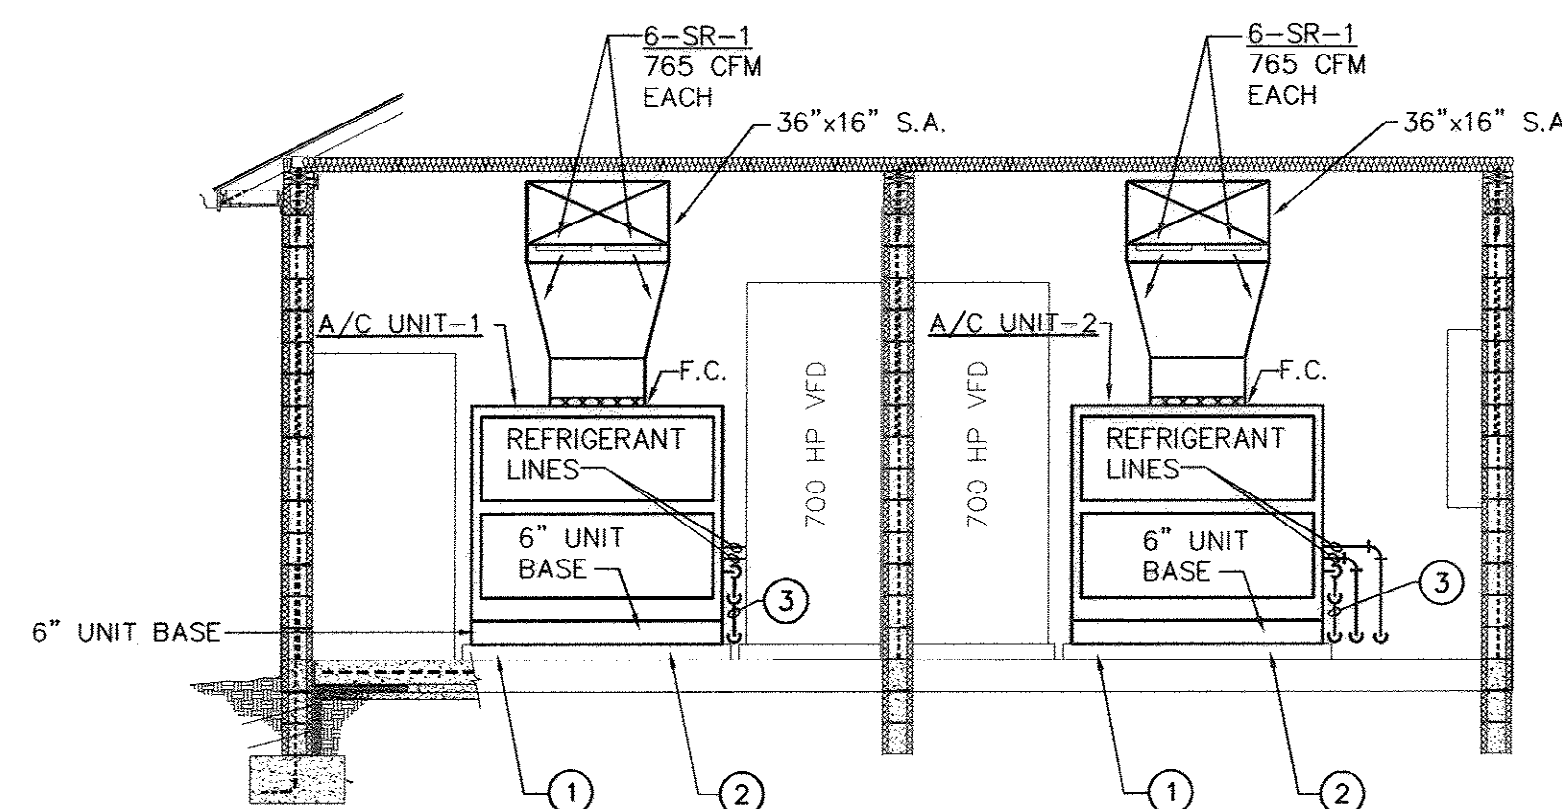


2 PERRY ROAD MECHANICAL SECTION
M-2
SCALE: 1/4"=1'-0"
1 INSTALL ON 6" HIGH REINFORCED CONCRETE PAD WITH 3/4" CHAMFERED EDGES.
2 INSTALL UNIT ON (4) 1" THICK CORK NEOPRENE PADS ON CONCRETE PAD.
3 2" DEEP CONDENSATE TRAP ASSEMBLY

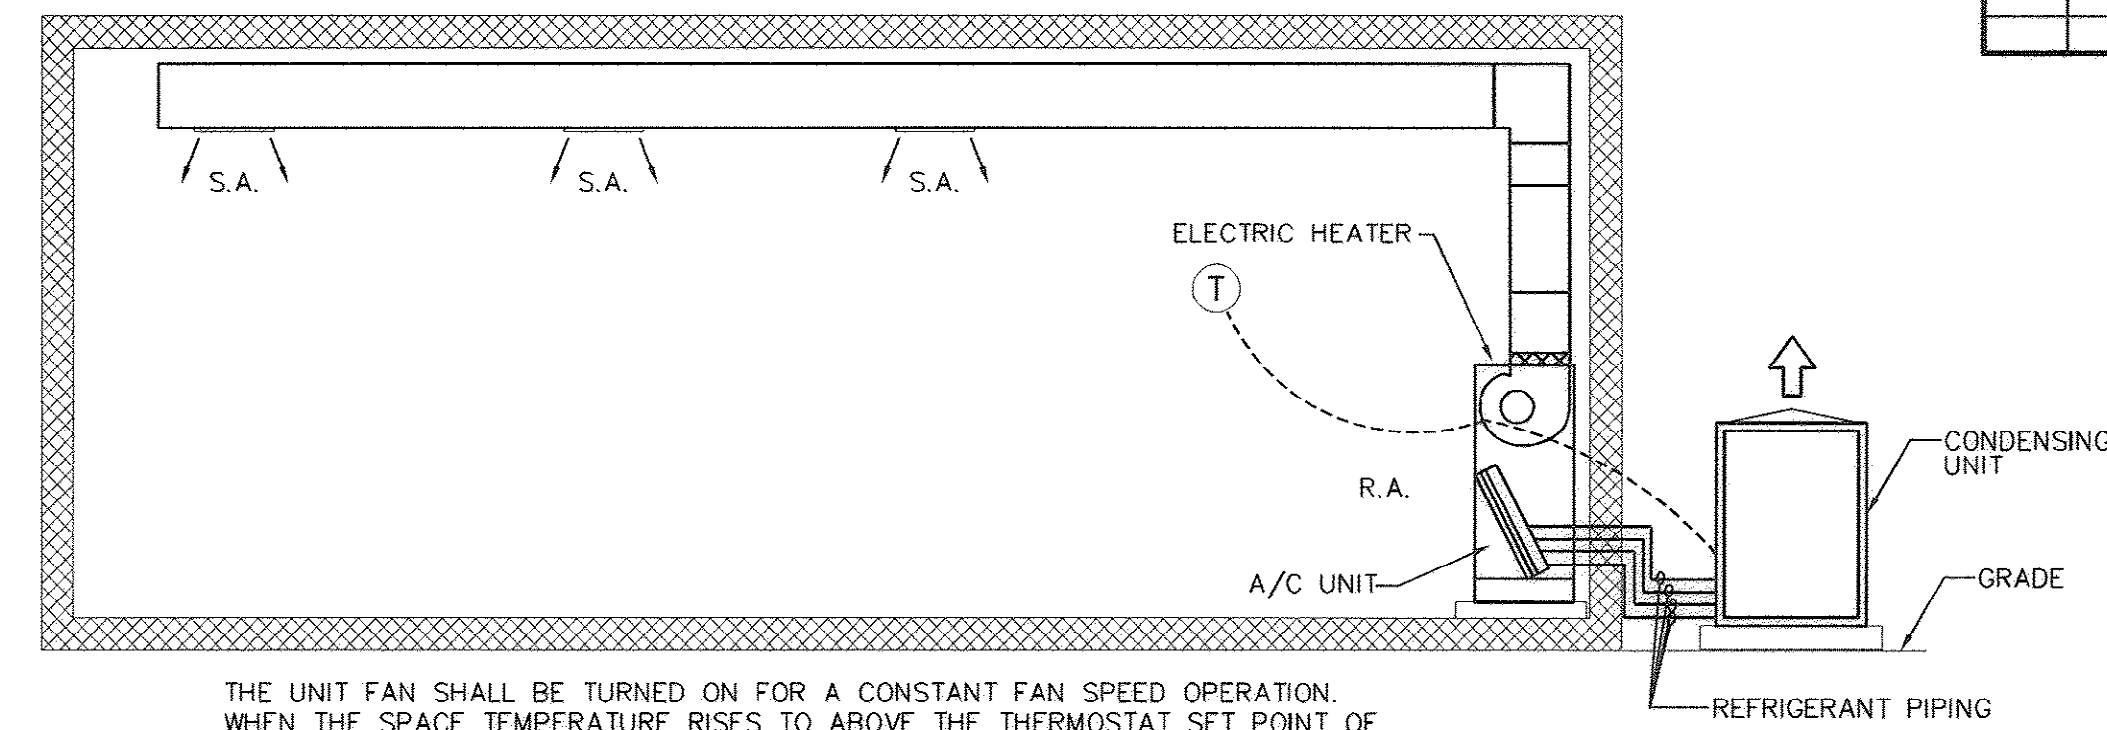


7 A/C UNIT SCHEMATIC CONTROL DIAGRAM
M-2 NTS

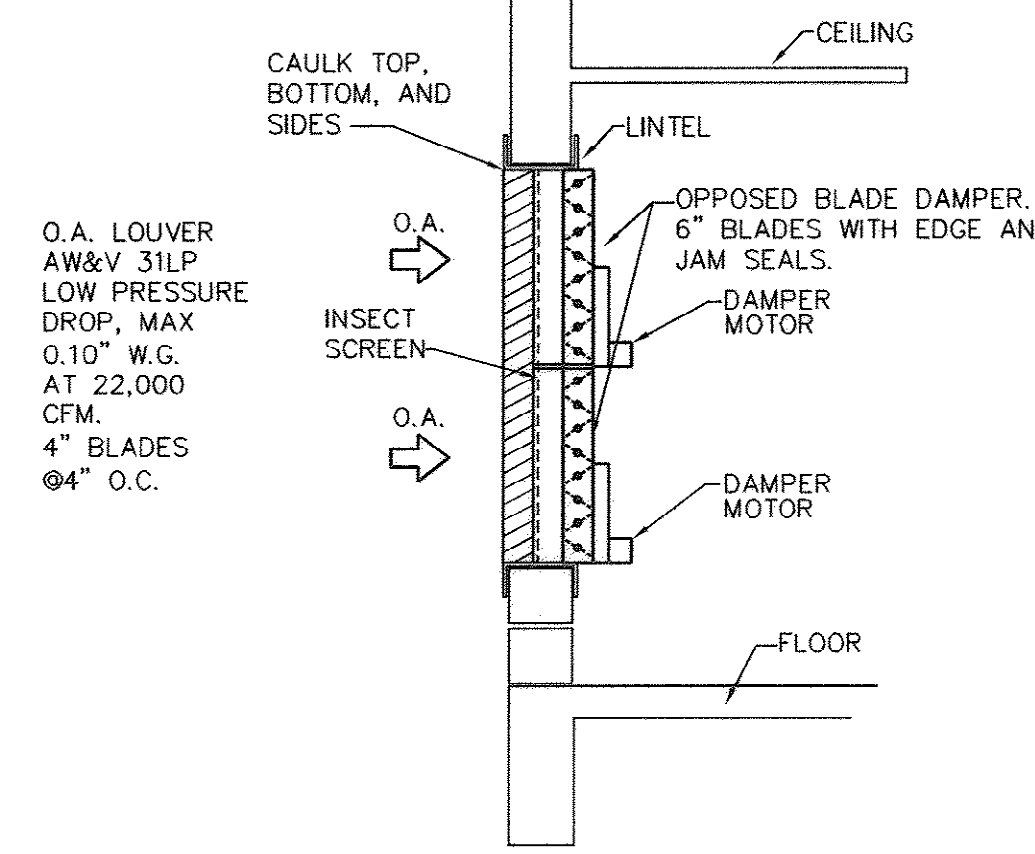

5 INTAKE LOUVER DETAIL
M-2 NTS

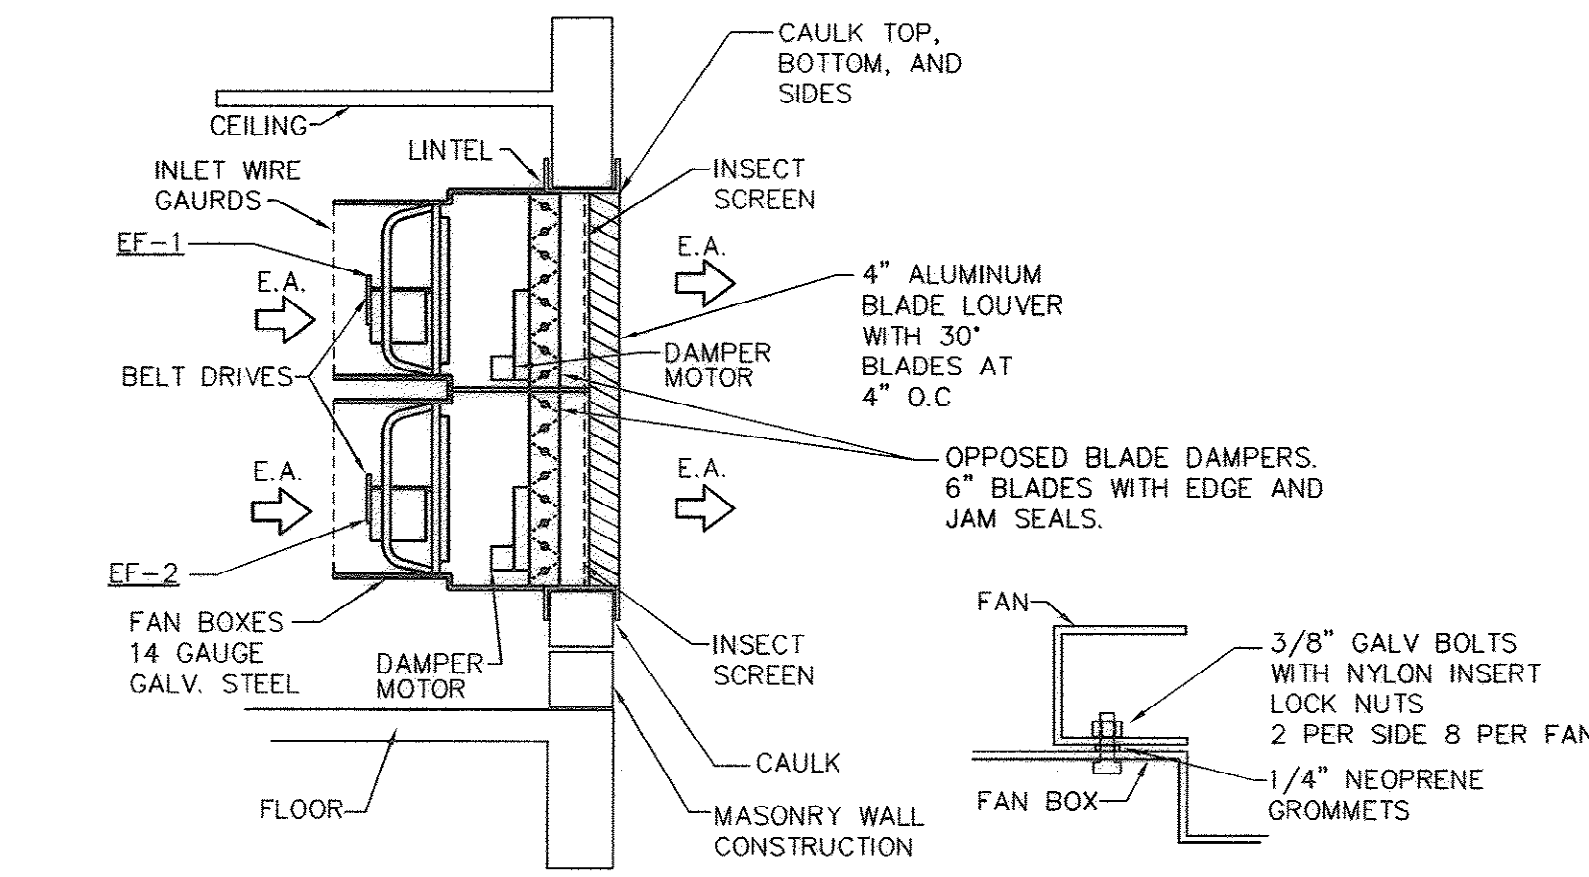

4 EXHAUST FAN / WALL LOUVER DETAIL
M-2 NTS

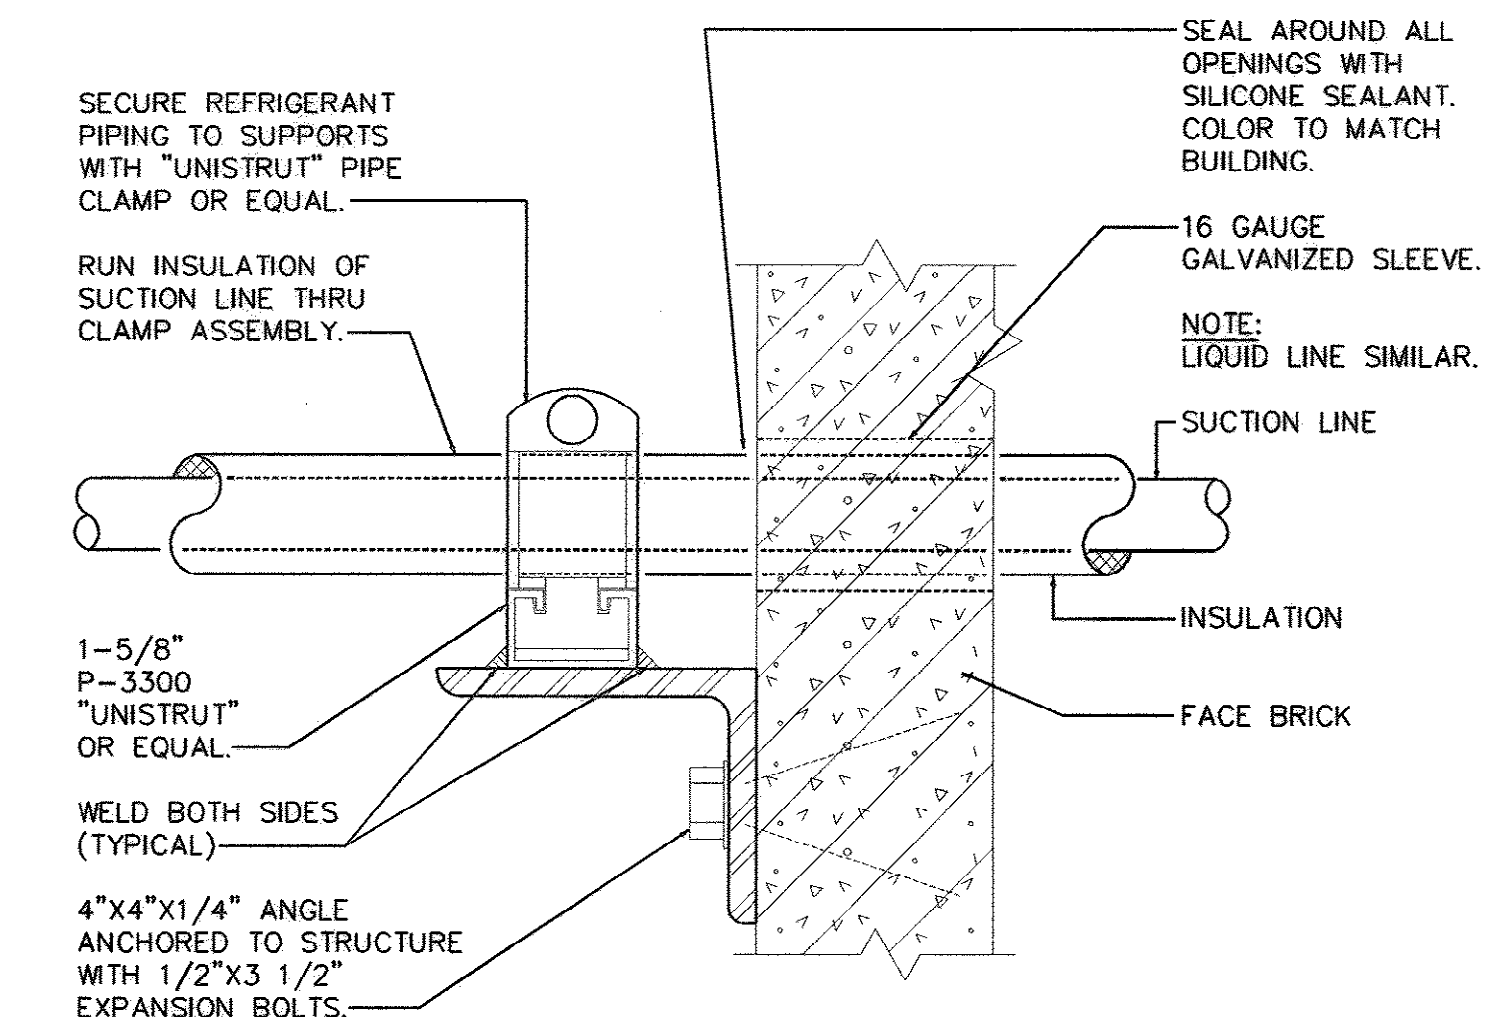


1 REFRIGERANT PIPE SUPPORT AT WALL
M-2 NTS

REVISIONS			
SYM.	DESCRIPTION	DATE	BY

McCracken & Lopez, P.A.
Consulting Engineers
1300 Baxter Street, Suite 350
Charlotte, North Carolina 28204
Post Office Box 32515
Charlotte, North Carolina 28232
Telephone 704/376-7072
Fax 704/376-4465

Hobbs, Upchurch & Associates, P.A.
Consulting Engineers, Surveyors & Land Planners
Southern Pines, North Carolina 28387
300 S.W. Broad Street, Southern Pines, North Carolina 28387
Phone: (910) 892-5616 - Fax: (910) 892-7342

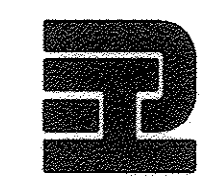

MECHANICAL DETAILS,
CONTROL SEQUENCES.


PERRY ROAD WATER
BOOSTER PUMP STATION
UPGRADE
GRAND STRAND WATER &
SEWER AUTHORITY

DATE:	9-5-2008
DESIGNED:	BC
DRAWN:	CADD
CHECKED:	RAM
SCALE:	AS SHOWN
SHEET NO.	

M-2
OF 2 VERSION: 4


AS-BUILT 9-5-08

12-250-032/362

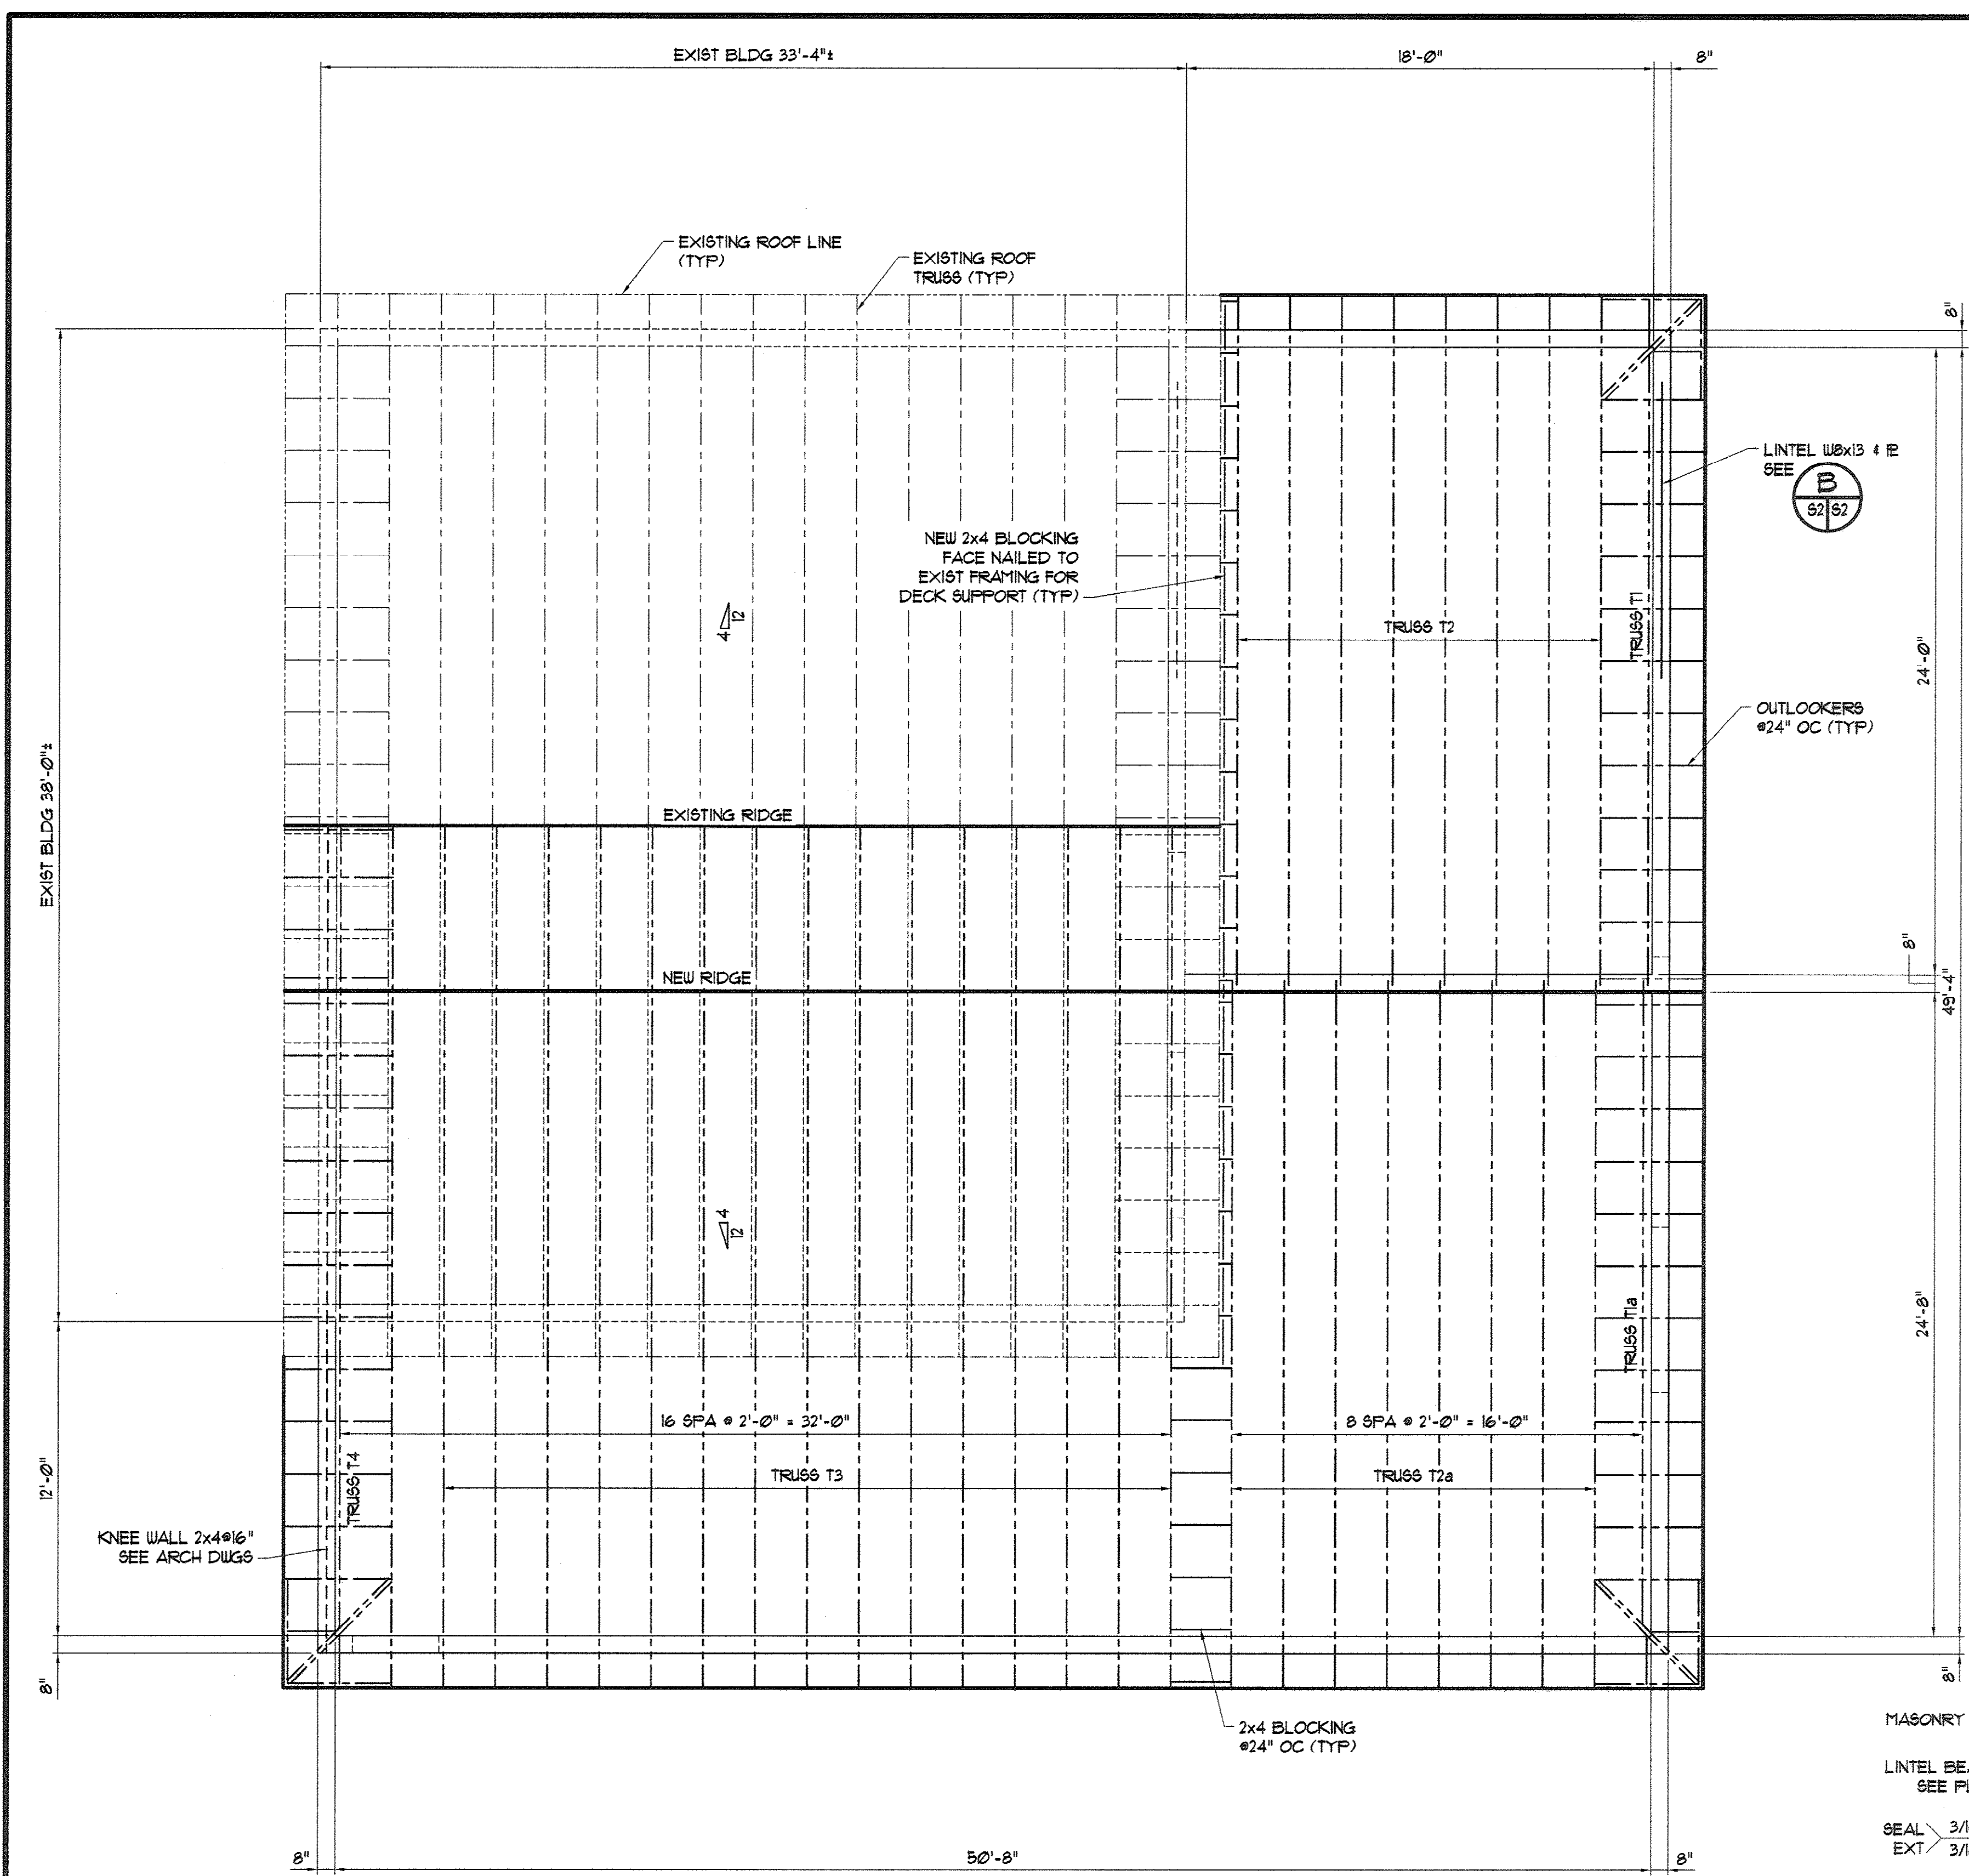


REVISIONS			
SYM.	DESCRIPTION	DATE	BY

SHEATHING SCHEDULE					
LOCATION	THICKNESS	NAILS	BLOCKING	NAIL SPACING	
				PERIMETER	INTERMEDIATE
WALLS	1/2" PLYWOOD	8d	NOT REQ'D	6"	12"
ROOF	5/8" PLYWOOD	10d	NOT REQ'D	6"	12" NOTE 2

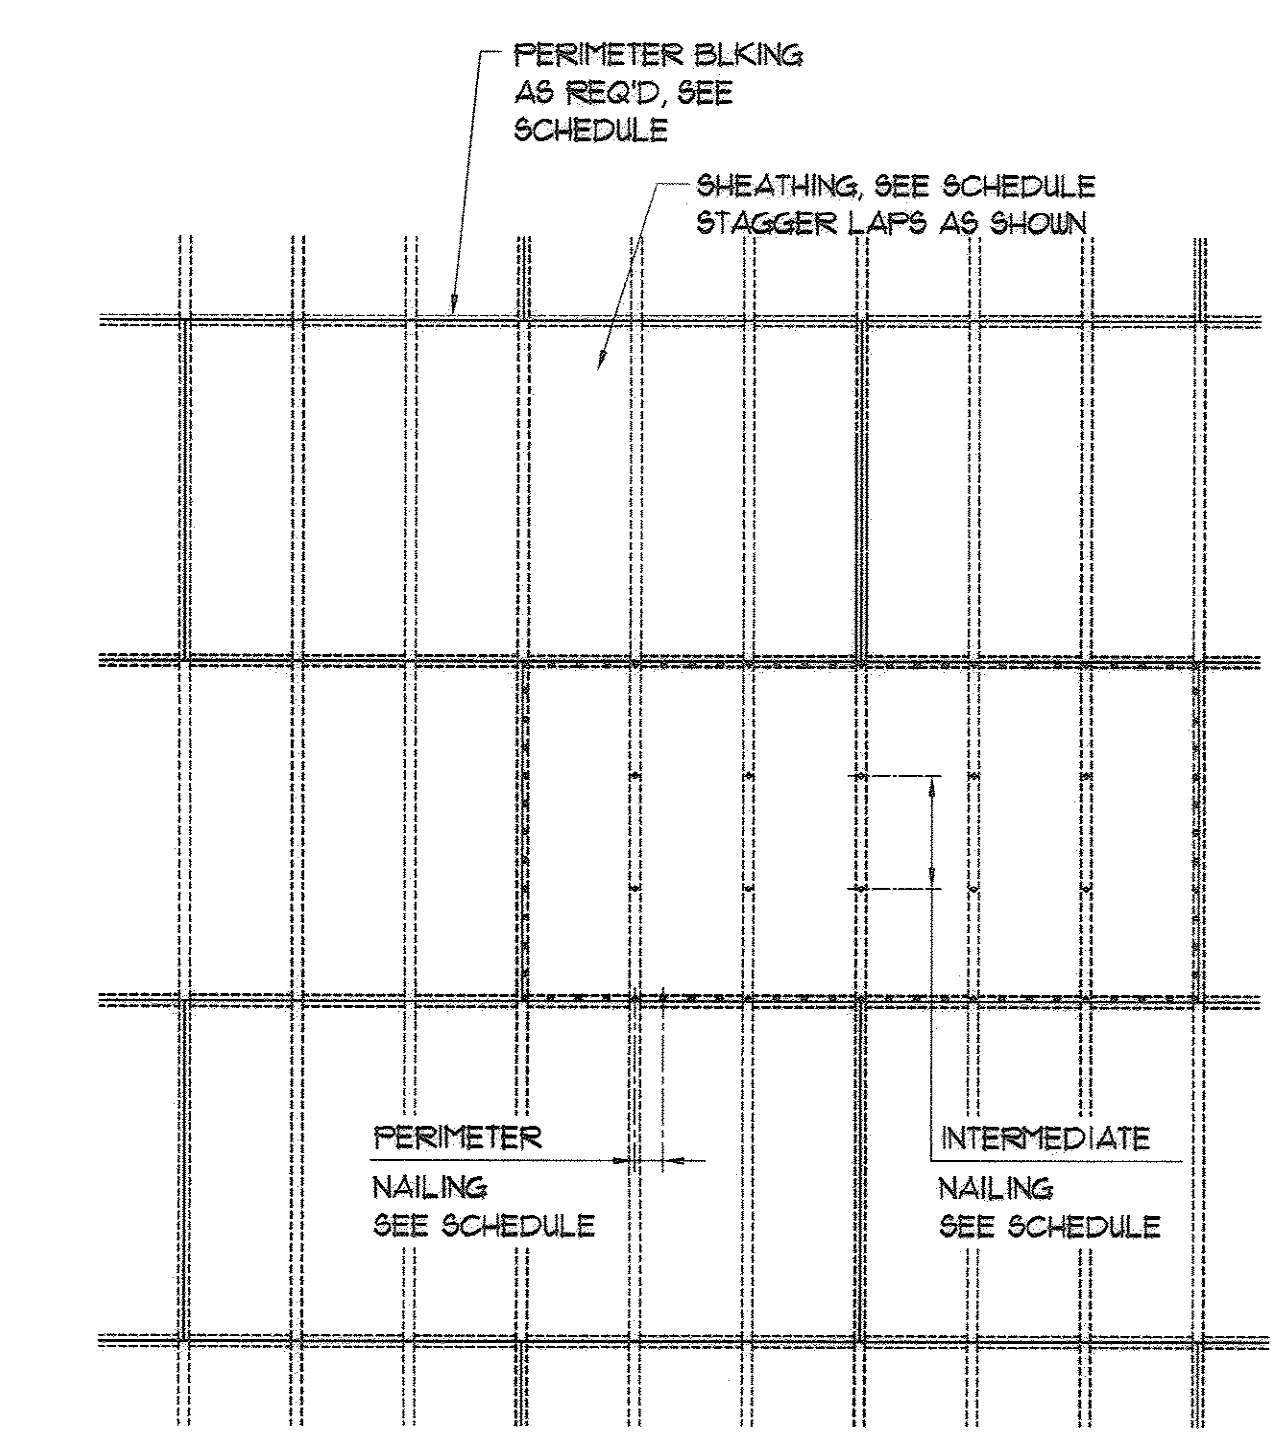

SHEATHING ATTACHMENT DETAIL


- NOTE:
 1. SHEATHING CONTINUOUS FROM TOP OF MASONRY FOUNDATION WALL TO ROOF FRAMING.
 2. PROVIDE BLOCKING AT 2'-0" OC FOR 5' MIN WIDTH AROUND PERIMETER. ALL NAILS 6" OC.

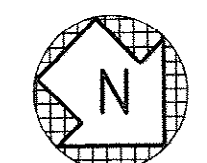


ROOF FRAMING PLAN

- NOTE:
 1. SEE ARCH DWGS FOR LOCATION AND ELEVATION OF LINTELS.
 2. CONTRACTOR TO VERIFY IN FIELD ALL DIMENSIONS TO EXISTING CONSTRUCTION.
 3. SEE ARCH AND MECH DWGS FOR LOCATION OF ROOF OFNGS.
 4. TRUSSES SPACED AT 2'-0" MAX. FRAMING PLAN IS SCHEMATIC AND MAY VARY SLIGHTLY AS REQUIRED BY TRUSS DESIGN.

1/4" = 1'-0"


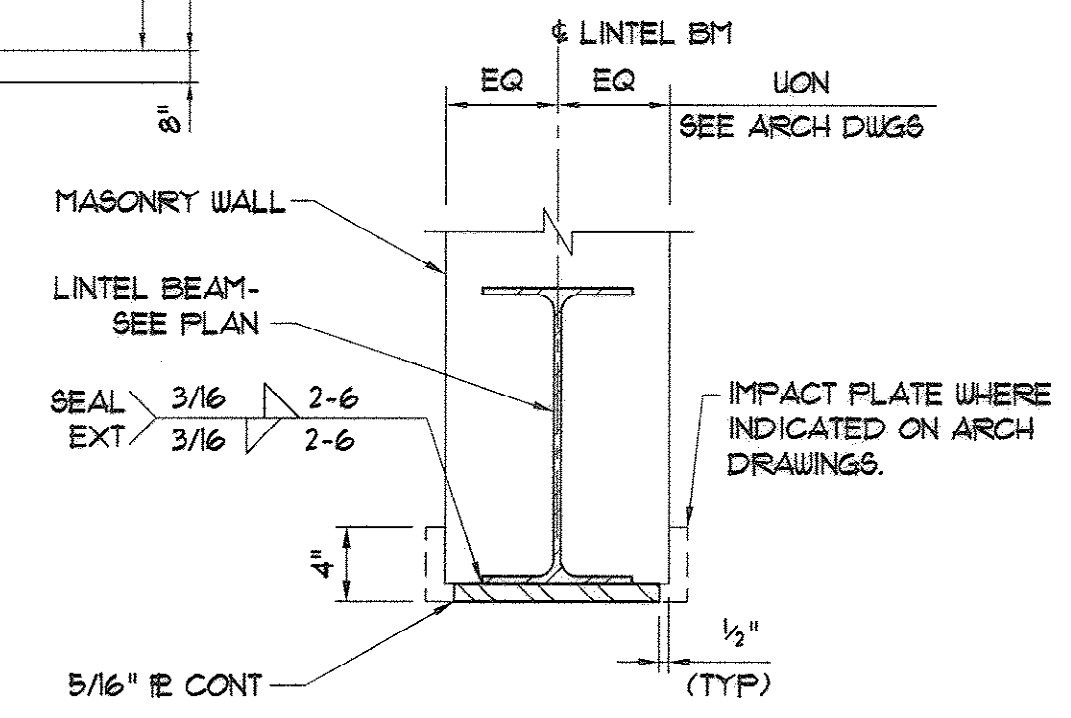


B TYP Lintel Detail
 52/52 NO SCALE

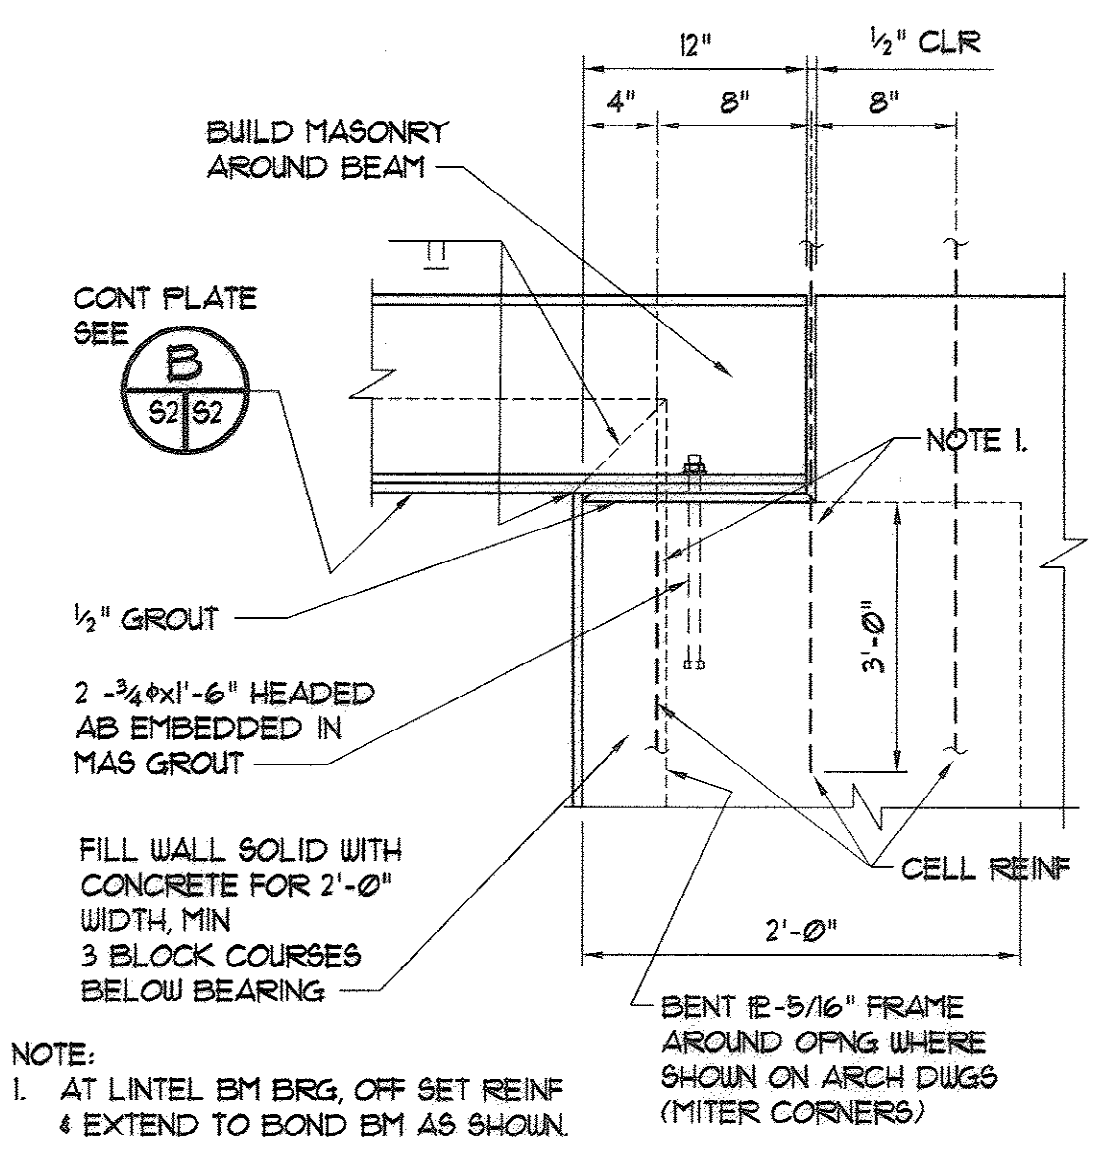

A TYP Lintel Bearing Detail
 52/52 NO SCALE

AS-BUILT 9-5-08

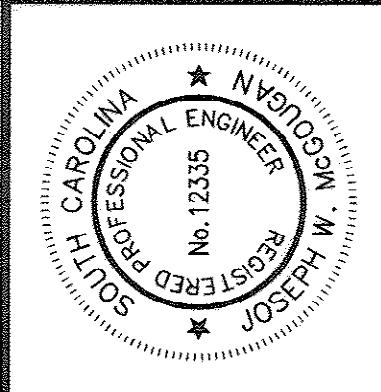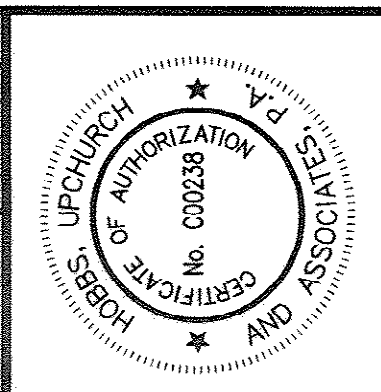


Upchurch & Associates, P.A.
 Consulting Engineers
 Myrtle Beach, South Carolina 29577
 PHONE: (843) 666-1910 FAX: (843) 666-1745

ROOF FRAMING PLAN AND DETAILS

PERRY ROAD PUMP STATION GRAND STRAND WATER & SEWER AUTHORITY


DATE:	9-5-2008
DESIGNED:	JWM
DRAWN:	DAC
CHECKED:	JWM
SCALE:	AS SHOWN
SHEET NO.	S2

12-250-034/36 W

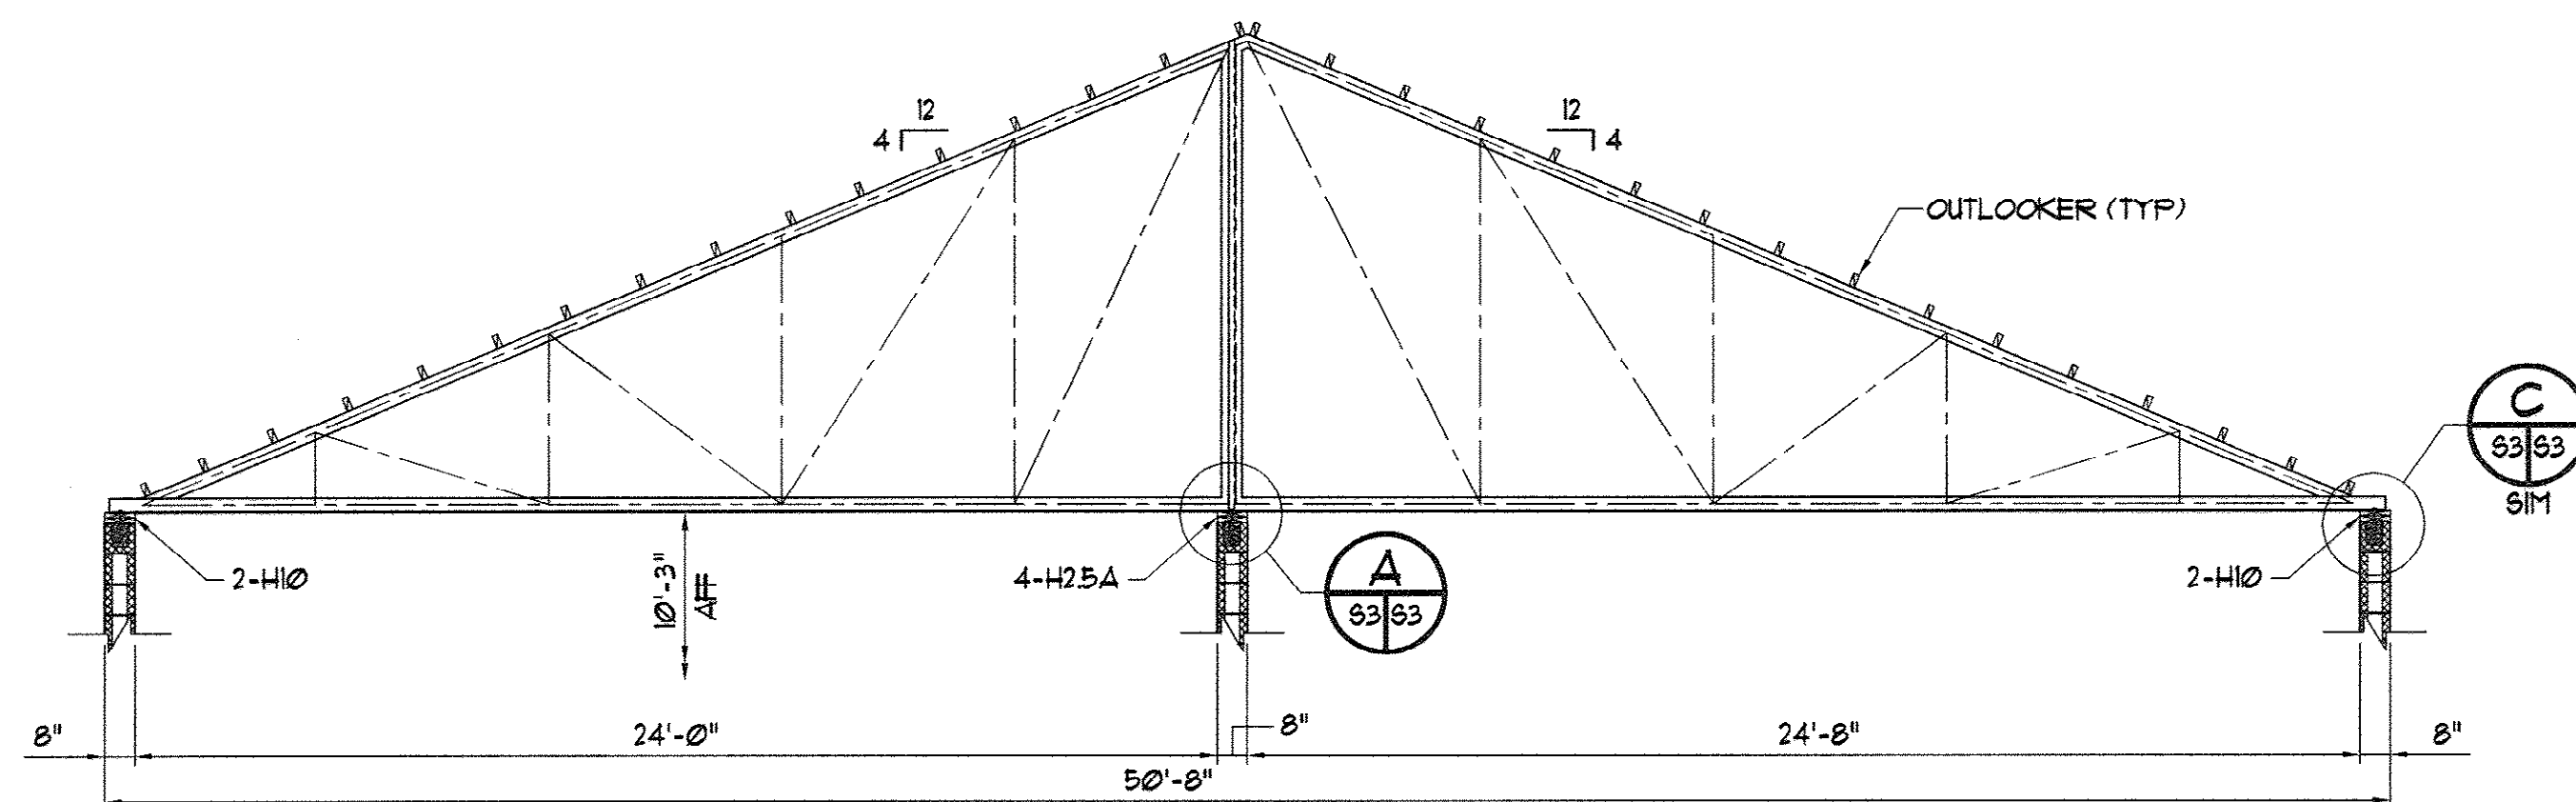


TRUSS T1

TRUSS T1a

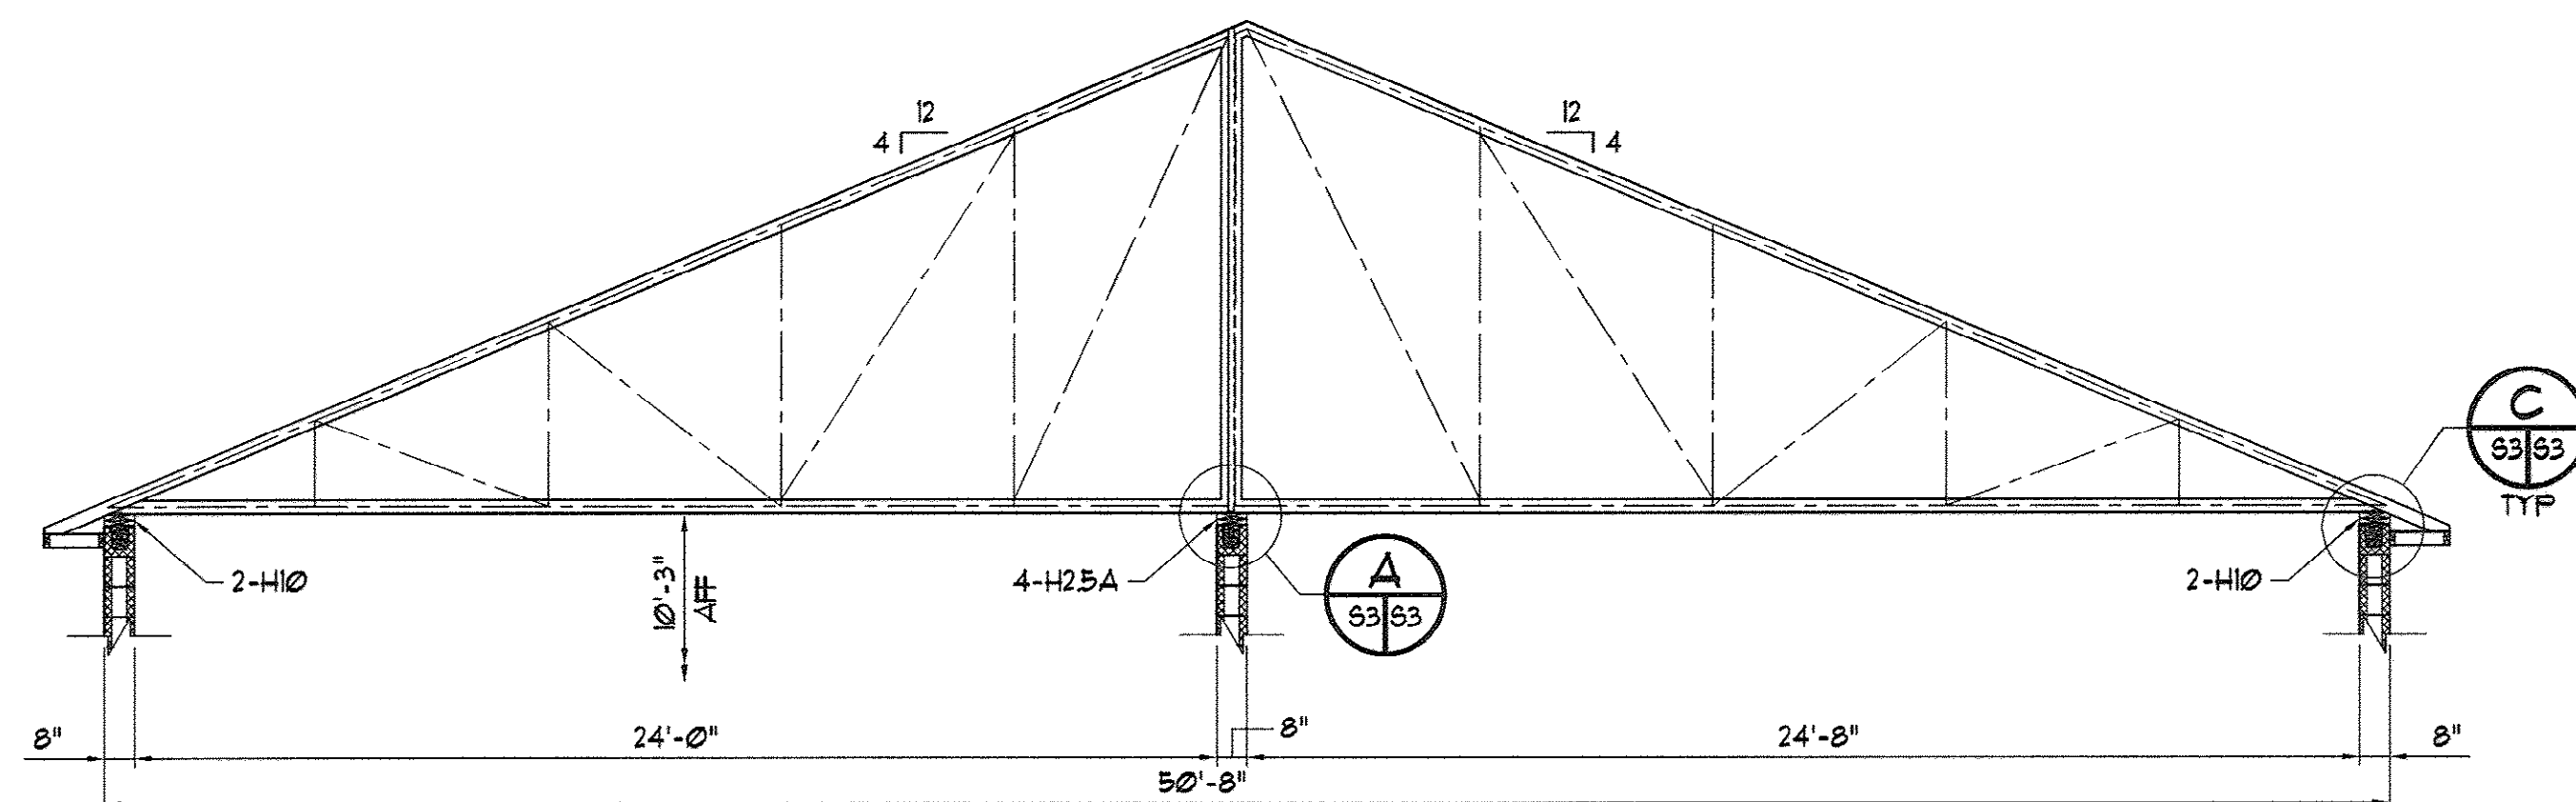


TRUSS T2

TRUSS T2a

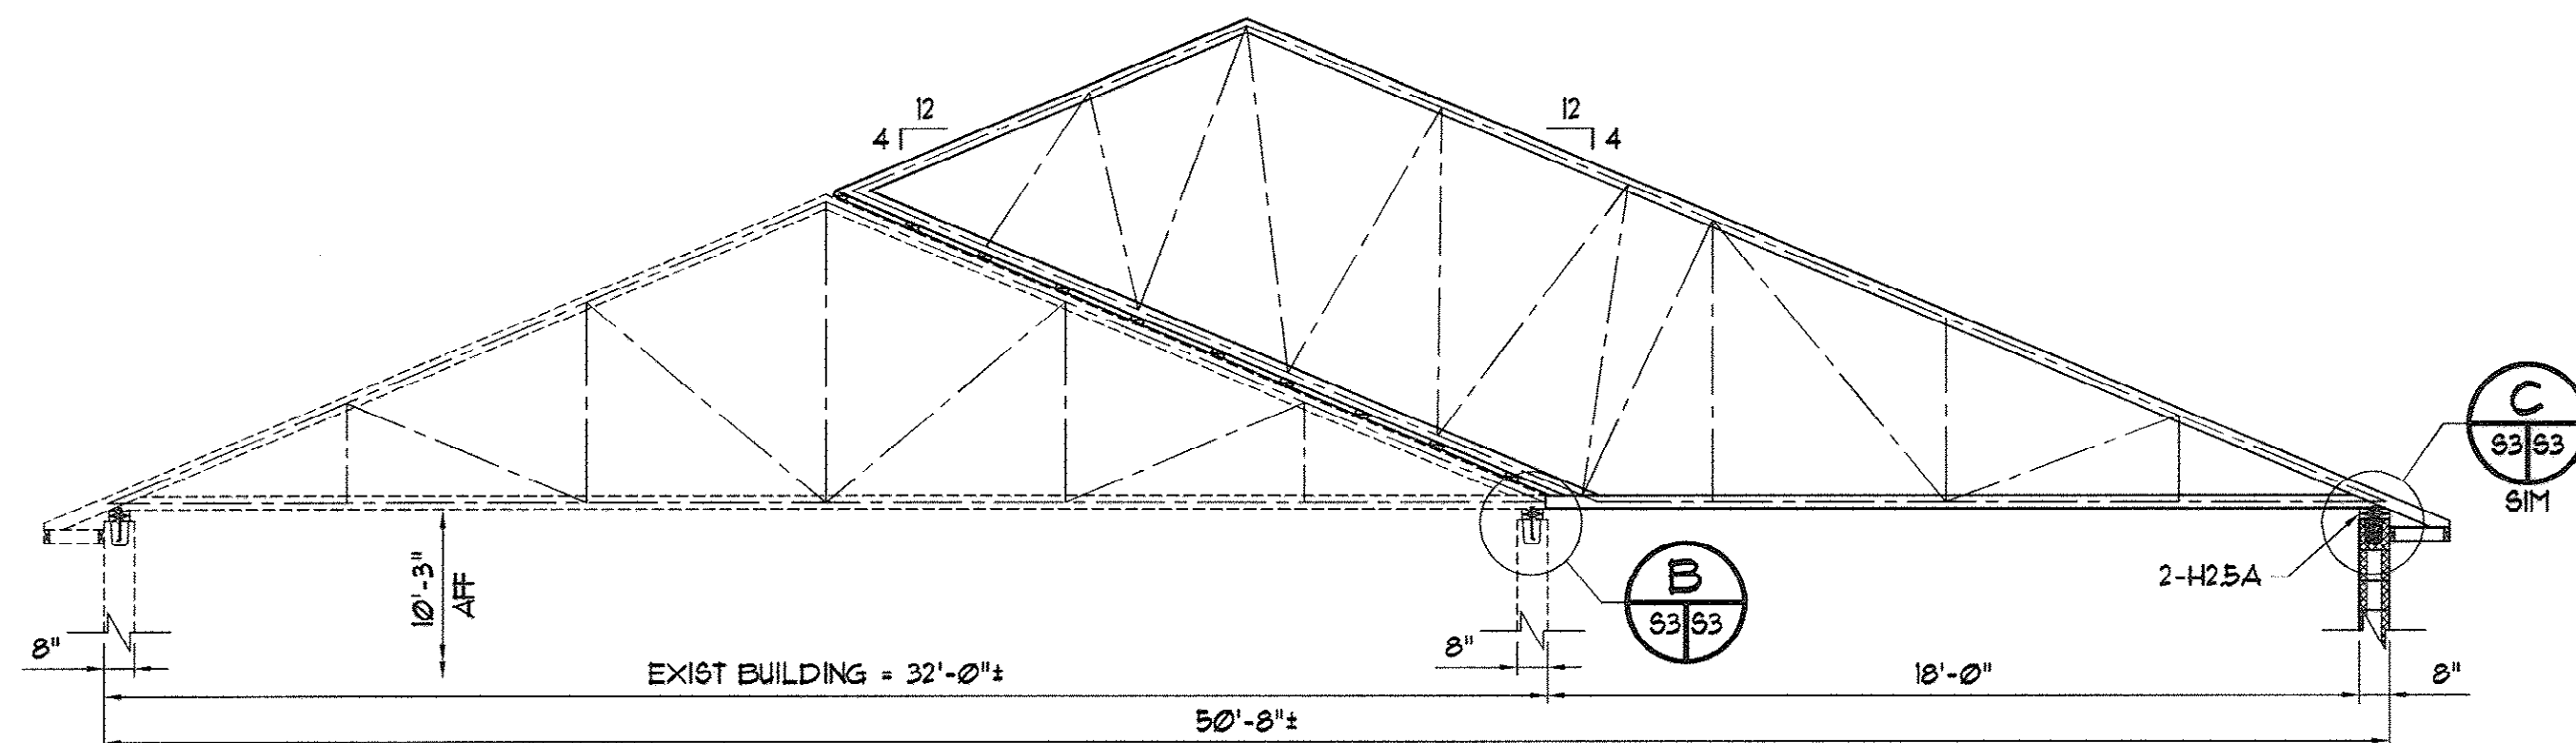

EXIST TRUSS

TRUSS T3

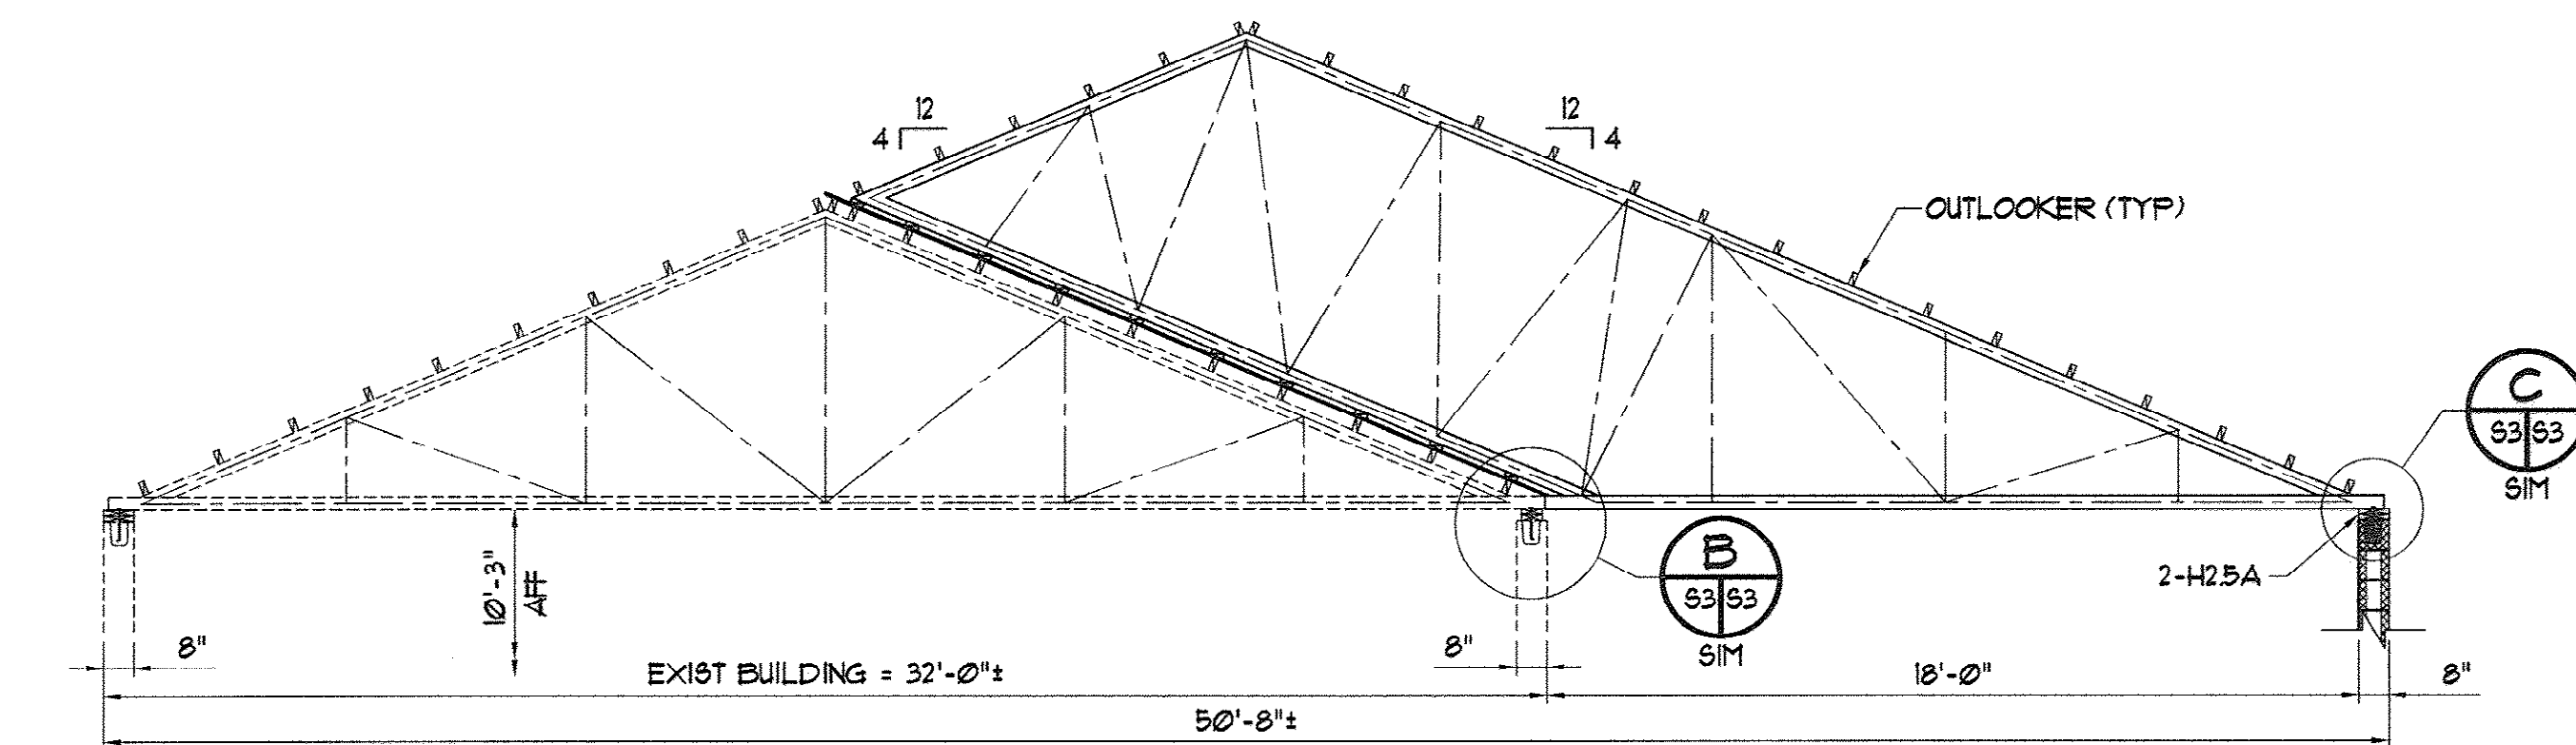


EXIST TRUSS


TRUSS T4

WOOD TRUSS DESIGN NOTES


- LUMBER IN TRUSSES SHALL BE GRADE MARKED AS FOLLOWS:
CHORD MEMBERS
WEB MEMBERS
 - MAXIMUM TRUSS SPACING = 2'-0" ON CENTER.
 - CENTROIDAL LINES OF MEMBERS SHALL INTERSECT AT A POINT, UCN.
 - ENDS OF ALL COMPRESSION MEMBERS SHALL BE CUT TO FIT INTERSECTING MEMBERS FOR POSITIVE END BEARING.
 - TRUSS DESIGN LOADS
WIND ASCE 7-02, 125 MPH, WIND IMPORTANCE FACTOR = 1.15, EXPOSURE C
GCH = 40.55, DESIGN TRUSSES FOR COMPONENT LOADING
TOP CHORD DEAD LOAD 10 PSF (6 PSF FOR UPLIFT)
BOTTOM CHORD DEAD LOAD 15 PSF (8 PSF FOR UPLIFT)
TOP CHORD LIVE LOAD 20 PSF
- TRUSSES SHALL BE DESIGNED BY A REGISTERED SOUTH CAROLINA PROFESSIONAL ENGINEER EMPLOYED BY THE TRUSS MANUFACTURER. SUBMIT SEALED CALCULATIONS FOR TRUSS MEMBER AND CONNECTION DESIGN WITH SHOP DRAWINGS.
- TRUSS JOINT CONNECTIONS SHALL BE MADE BY USING GALVANIZED TOOTHED CONNECTION PLATES.
 - TRUSS WEB MEMBERS SHOWN ARE SCHEMATIC ONLY. PROVIDE VERTICALS AND DIAGONALS AS REQUIRED BY TRUSS DESIGN. CONTRACTOR COORDINATE CLEARANCES REQUIRED FOR MECHANICAL SYSTEMS.

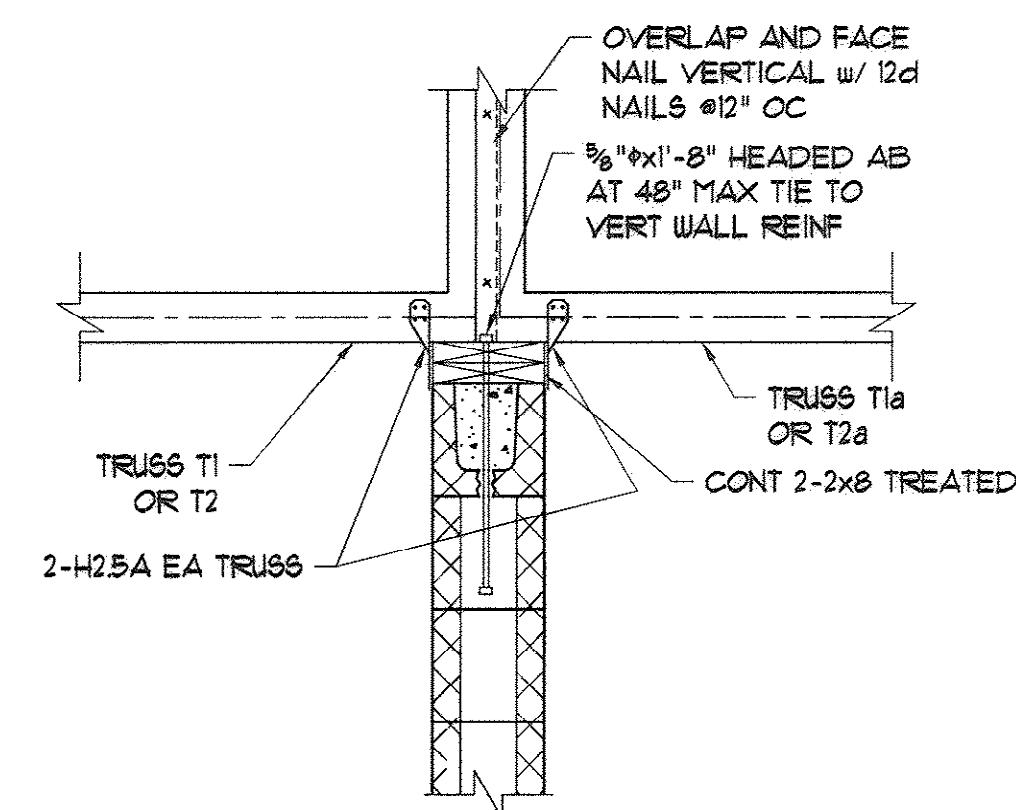



A TRUSS INTERIOR WALL BEARING
NO SCALE

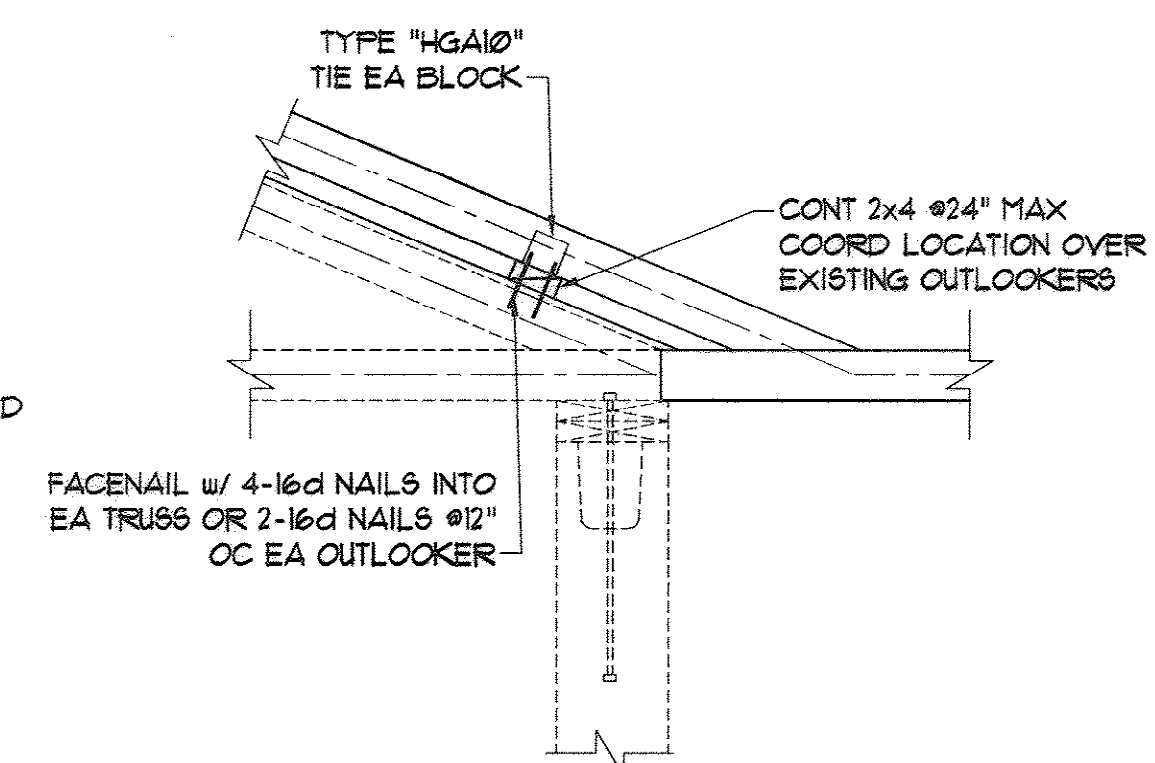

B TRUSS OVERFRAME DETAIL
NO SCALE

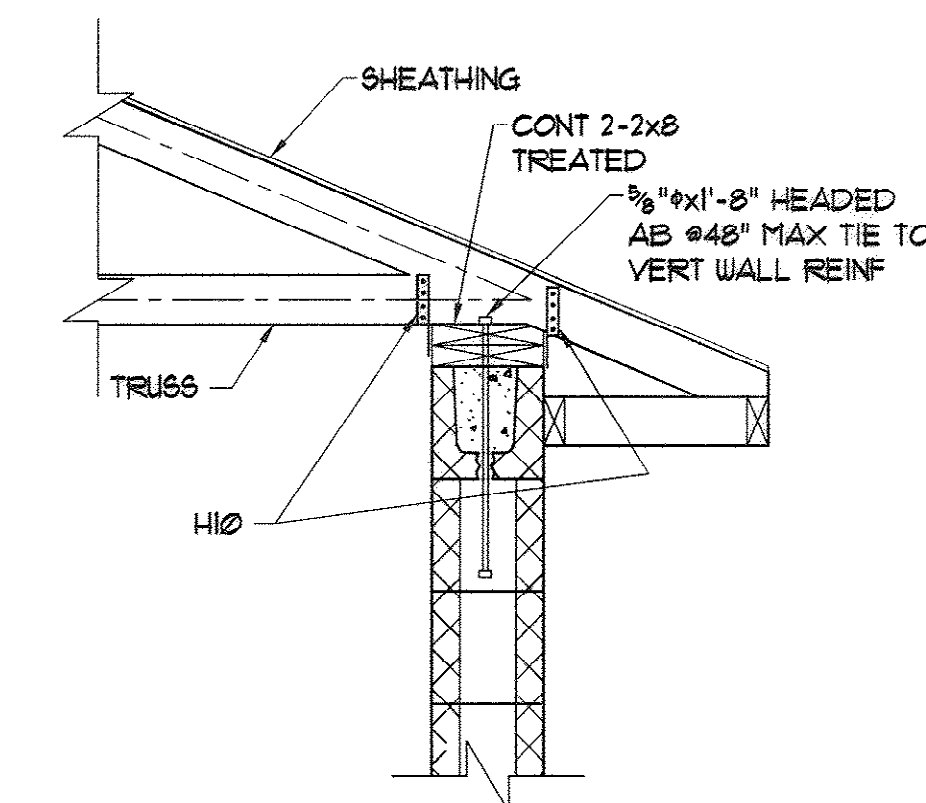

C TRUSS EAVE BEARING DETAIL
NO SCALE

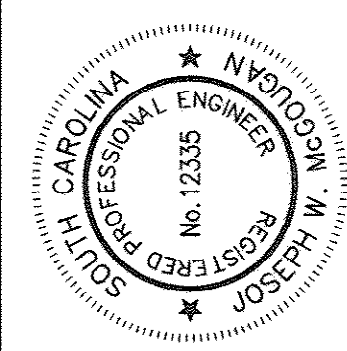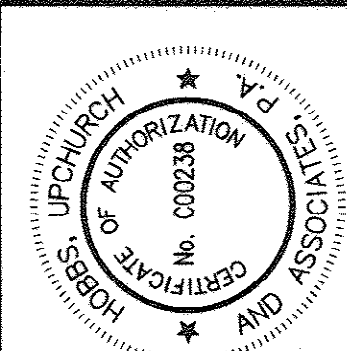

Hobbs, Upchurch & Associates, P.A.
Consulting Engineers
Myrtle Beach, South Carolina 29577
PHONE: (843) 628-1910 FAX: (843) 628-1745



TRUSS ELEVATIONS
AND DETAILS

PERRY ROAD
PUMP STATION
GRAND STRAND WATER &
SEWER AUTHORITY

DATE: 9-5-2008
DESIGNED: JWM
DRAWN: DWN
CHECKED: JWM
SCALE: AS SHOWN

SHEET NO.

S3

AS-BUILT 9-5-08

OF: 4 VERSION: 4

12-250-035/36 W

