



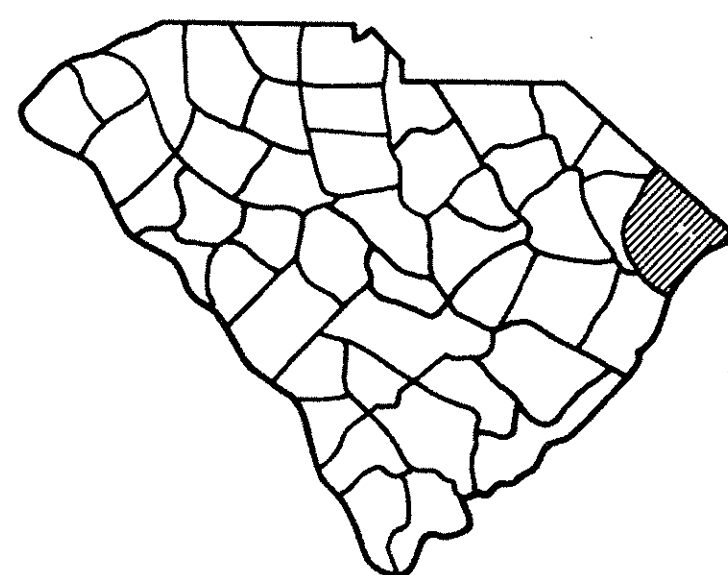

MAP SHOWING LOCATION OF
HORRY COUNTY IN SOUTH CAROLINA

VICINITY MAP

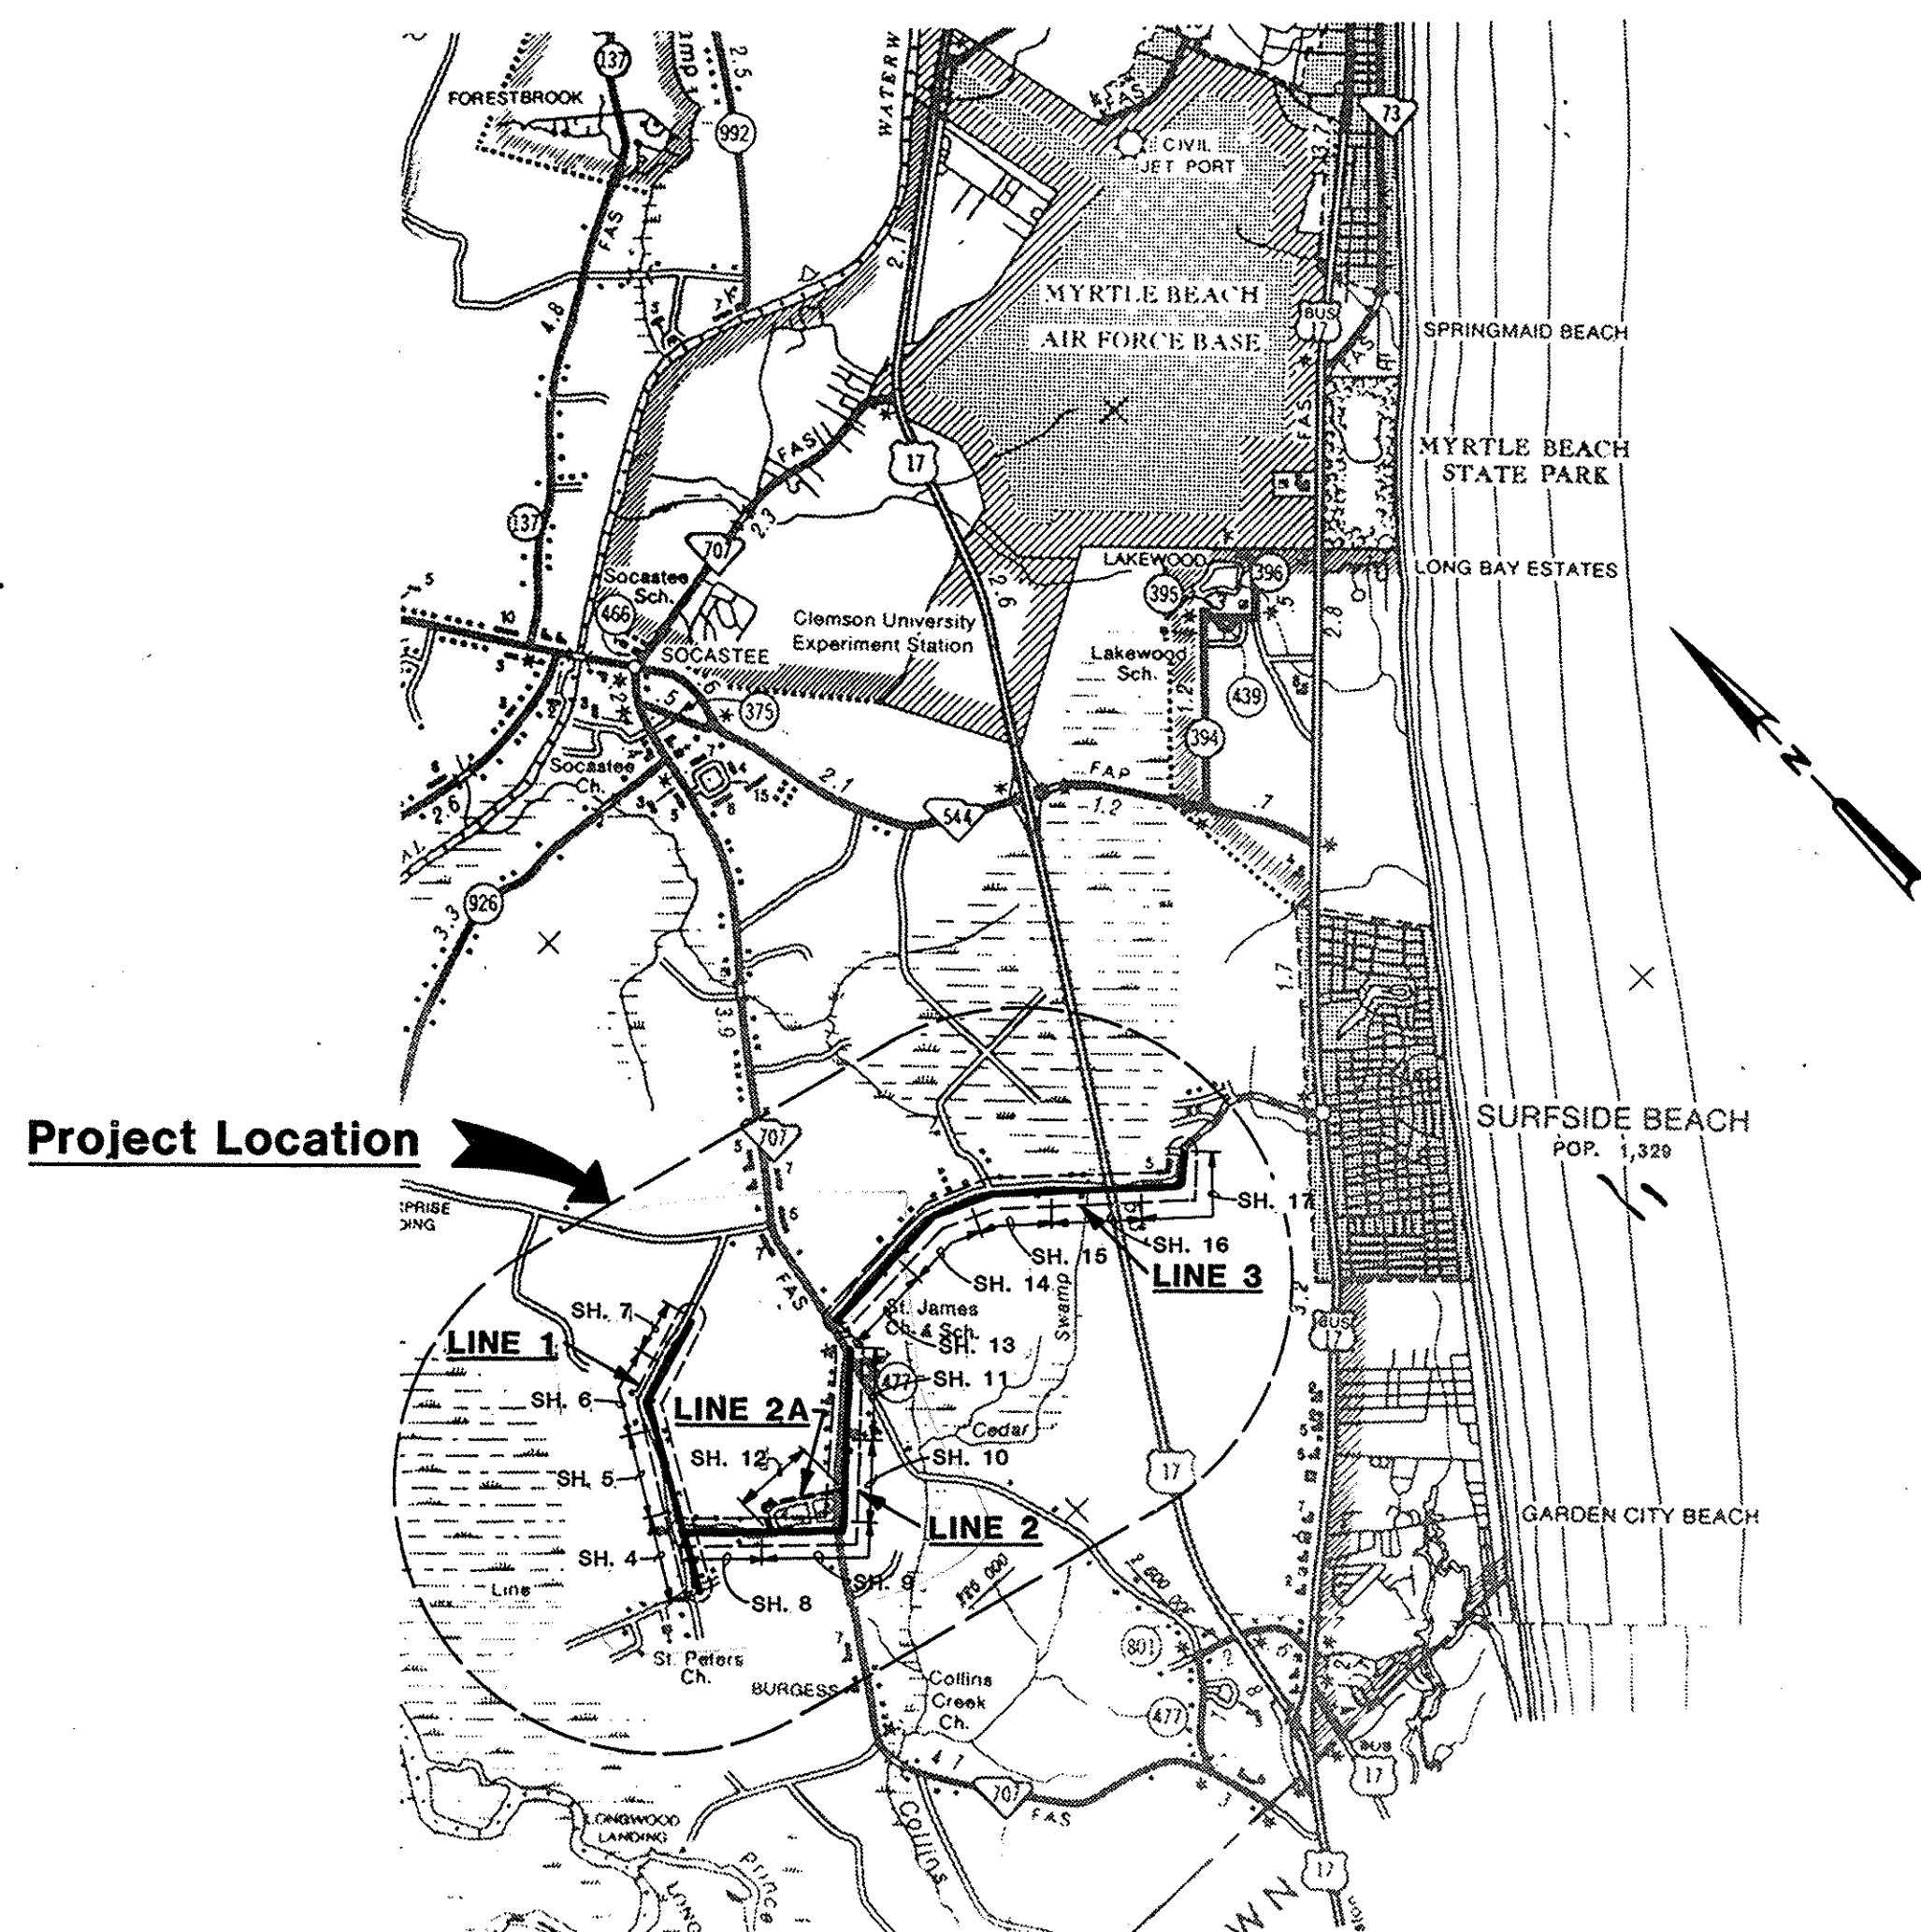

LOCATION MAP

LEGEND

EXISTING

- EDGE OF ROAD OR PAVEMENT
- EDGE OF ROAD UNDER CONSTRUCTION
- CENTER LINE
- UNDERGROUND TELEPHONE CABLE
- WATERLINE - SIZE INDICATED
- FORCE MAIN - SIZE INDICATED
- CULVERT - SIZE AND TYPE INDICATED
- CREEK
- GATE VALVE
- BUTTERFLY VALVE
- BLOWOFF
- POWER POLE
- TELEPHONE PEDESTAL
- TREE - SIZE AND TYPE INDICATED

NEW

- TRAVERSE WITH STATIONING (IN 100 S OF FEET)
- WATERLINE - SIZE INDICATED
- GATE VALVE
- BUTTERFLY VALVE
- PAVEMENT REPLACEMENT
- TRENCH BACKFILL CLASSIFICATION
- COUPLING - SIZE INDICATED
- ENCASED PIPE
- FIRE HYDRANT
- AIR RELEASE VALVE
- BLOWOFF VALVE
- PLUG

ABBREVIATIONS

- ARV AIR RELEASE VALVE ASSEMBLY
- AVE AVENUE
- BC BRASS CAP
- BFV BUTTERFLY VALVE
- BM BENCHMARK
- CLR CLEARANCE
- CMP CORRUGATED METAL PIPE
- CONC CONCRETE
- CPLG COUPLING
- DI DUCTILE IRON
- DR DRIVE
- EL ELEVATION
- GTV GATE VALVE
- HORIZ HORIZONTAL
- MIN MINIMUM
- NGS NATIONAL GEODETIC SURVEY
- PVC POLYVINYL CHLORIDE
- PVMT PAVEMENT
- RCP REINFORCED CONCRETE PIPE
- RDCR REDUCER
- SQ SQUARE
- STA STATION
- TELEPHONE
- TBM TEMPORARY BENCHMARK
- VERT VERTICAL
- W WATER

INDEX OF DRAWINGS

SHEET NO.	TITLE
1	LOCATION MAP, LEGEND, ABBREVIATIONS, AND INDEX OF DRAWINGS
2	STANDARD DETAILS
3	STANDARD DETAILS
4	LINE 1-PLAN AND PROFILE STA 0+00 TO STA 28+00
5	LINE 1-PLAN AND PROFILE STA 28+00 TO STA 56+00
6	LINE 1-PLAN AND PROFILE STA 56+00 TO STA 82+00
7	LINE 1-PLAN AND PROFILE STA 82+00 TO STA 109+55
8	LINE 2-PLAN AND PROFILE STA 0+00 TO STA 28+00
9	LINE 2-PLAN AND PROFILE STA 28+00 TO STA 56+00
10	LINE 2-PLAN AND PROFILE STA 56+00 TO STA 84+00
11	LINE 2-PLAN AND PROFILE STA 84+00 TO STA 106+64
12	LINE 2A-PLAN AND PROFILE STA 0+00 TO STA 25+95
13	LINE 3-PLAN AND PROFILE STA 0+00 TO STA 28+00
14	LINE 3-PLAN AND PROFILE STA 28+00 TO STA 56+00
15	LINE 3-PLAN AND PROFILE STA 56+00 TO STA 84+00
16	LINE 3-PLAN AND PROFILE STA 84+00 TO STA 112+00
17	LINE 3-PLAN AND PROFILE STA 112+00 TO 130+25

SECTION (LETTER) OR
DETAIL (NUMERAL)
DESIGNATION

ON DRAWING WHERE SECTION
OR DETAIL IS TAKEN:
SHEET NUMBER WHERE SHOWN

SHEET NUMBER
(REPLACED WITH A LINE
IF TAKEN AND SHOWN
ON SAME SHEET)

ON DRAWING WHERE SECTION
OR DETAIL IS SHOWN:
SHEET NUMBER(S) WHERE TAKEN

DETAIL AND SECTION DESIGNATION

14-11-001/17-W



CH2M HILL
DSGN T. SMALLWOOD
DR M. HALES
CHK R. CRANDALL
APVD R. HIRSEKORN

NO. DATE REVISION

BY APVD

REUSE OF DOCUMENTS
THIS DOCUMENT, AND THE IDEAS AND DESIGNS INCORPORATED HEREIN, AS AN INSTRUMENT OF PROFESSIONAL SERVICE, IS THE PROPERTY OF CH2M HILL AND IS NOT TO BE USED, IN WHOLE OR IN PART, FOR ANY OTHER PROJECT WITHOUT THE WRITTEN AUTHORIZATION OF CH2M HILL.


VERIFY SCALES
BAR IS ONE INCH ON ORIGINAL DRAWING.
0 1"
IF NOT ONE INCH ON THIS SHEET, ADJUST SCALES ACCORDINGLY.

WATER SYSTEM IMPROVEMENTS
BURGESS COMMUNITY
GRAND STRAND WATER & SEWER AUTHORITY

LOCATION MAP, LEGEND, ABBREVIATIONS,
AND INDEX OF DRAWINGS

SHEET 1
OF 17
DATE FEB 1985
PROJ NO. SA17940.A1



THRUST BLOCK DETAIL

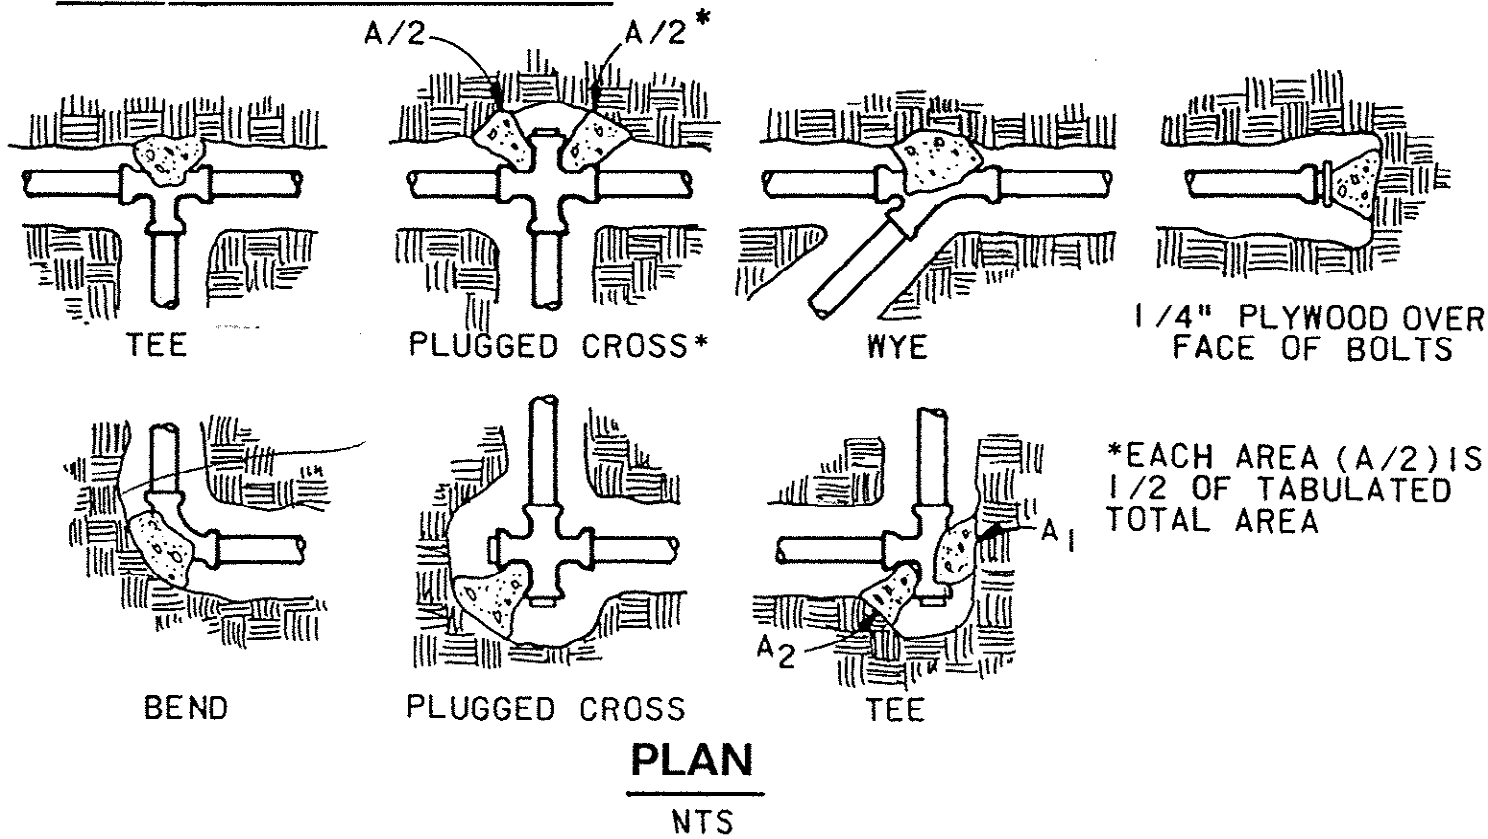

BEARING AREA OF THRUST BLOCKS IN SQ. FT. (HORIZONTAL BENDS)							
FITTING SIZE	TEE, WYE, PLUG OR CAP	90° BEND, PLUGGED CROSS	TEE PLUGGED ON RUN		BEND ANGLE		
			A1	A2	45°	22 1/2°	11 1/4°
4	1.0	1.4	1.0	1.4	1.0	-	-
6	2.1	3.0	2.1	3.0	1.6	1.0	-
8	3.8	5.3	3.8	5.4	2.9	1.5	1.0
10	5.9	8.4	5.9	8.4	4.6	2.4	1.2
12	8.5	12.0	8.5	12.0	6.6	3.4	1.7
14	11.5	16.3	11.5	16.3	8.9	4.6	2.3
16	15.0	21.3	15.0	21.3	11.6	6.0	3.0
18	19.0	27.0	19.0	27.0	14.6	7.6	3.8
20	23.5	33.3	23.5	33.3	18.1	9.4	4.7
24	34.0	48.0	34.0	48.0	26.2	13.6	6.8

VOLUME OF THRUST BLOCK IN CUBIC YARDS (VERTICAL BENDS)			
FITTING SIZE	BEND ANGLE		
	45°	22 1/2°	11 1/4°
4	1.1	0.4	0.2
6	2.7	1.0	0.4
8	4.0	1.5	0.6
10	6.0	2.3	0.9
12	8.5	3.2	1.3
14	11.5	4.3	1.8
16	14.8	5.6	2.3

FITTING SIZE	ROD SIZE	EMBEDMENT
12" AND LESS	# 6	30"
14" - 16"	# 8	36"

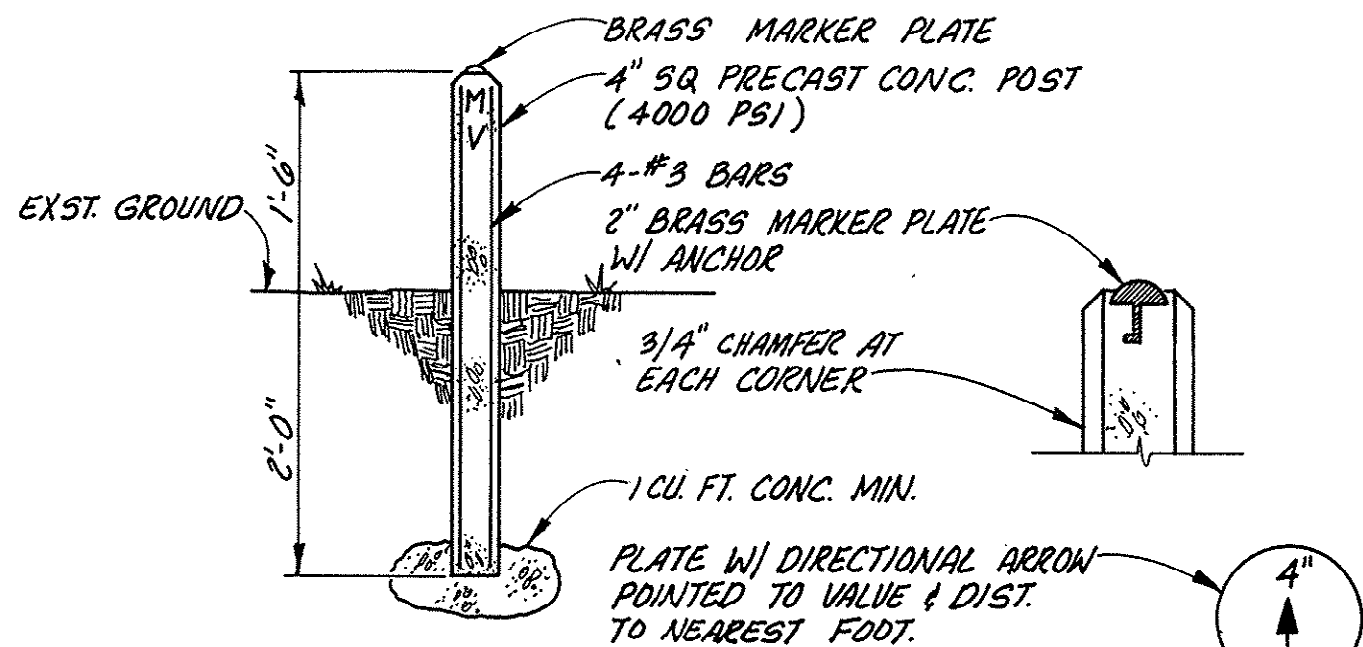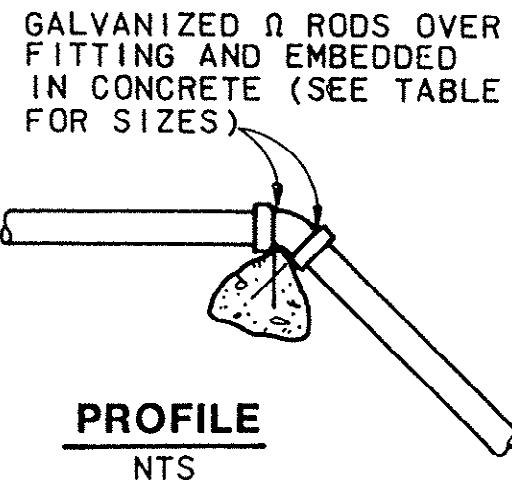

VALVE MARKER DETAIL

N.T.S.
NOTE: VALVE MARKERS TO BE PLACED AT ALL BURIED BUTTERFLY AND GATE VALVES

THRUST BLOCK NOTES AND DETAILS

THRUST BLOCK NOTES

- KEEP CONCRETE CLEAR OF JOINT AND JOINT ACCESSORIES.
- CONCRETE THRUST BLOCKING SHALL BE POURED AGAINST UNDISTURBED EARTH.
- REQUIRED VOLUMES OR BEARING AREAS AT FITTINGS SHALL BE AS INDICATED BELOW, ADJUSTED, IF NECESSARY, TO CONFORM TO THE TEST PRESSURE(S) AND ALLOWABLE SOIL BEARING STRESS(ES) STATED IN THE SPECIFICATIONS.
- THRUST BLOCK VOLUMES FOR VERTICAL BENDS HAVING UPWARD RESULTANT THRUSTS ARE BASED ON TEST PRESSURE OF 150 PSIG AND THE WEIGHT OF CONCRETE = 4050 LBS/CU YD. TO COMPUTE VOLUMES FOR DIFFERENT TEST PRESSURES, USE THE FOLLOWING EQUATION: VOLUME = (TEST PRESS./150) x (TABLE VALUE).
- BEARING AREAS FOR HORIZONTAL BEND THRUST BLOCKS ARE BASED ON TEST PRESSURE OF 150 PSIG AND AN ALLOWABLE SOIL BEARING STRESS OF 2000 LBS/SQ FT. TO COMPUTE BEARING AREAS FOR DIFFERENT TEST PRESSURES AND SOIL BEARING STRESSES, USE THE FOLLOWING EQUATION: BEARING AREA = (TEST PRESS./150) x (2000/SOIL BEARING STRESS) x (TABLE VALUE). SEE NOTE 10.
- THRUST BLOCKS FOR VERTICAL BENDS HAVING DOWNWARD RESULTANT THRUSTS SHALL BE THE SAME AS FOR HORIZONTAL BENDS.
- BEARING AREAS, VOLUMES, AND SPECIAL BLOCKING DETAILS SHOWN ON PLANS TAKE PRECEDENCE OVER THIS STANDARD.
- BEARING AREA OF THRUST BLOCK SHALL NOT BE LESS THAN 1.0 SQ.FT.
- VERTICAL BENDS THAT REQUIRE A THRUST BLOCK VOLUME EXCEEDING 5 CUBIC YARDS REQUIRE SPECIAL BLOCKING DETAILS. SEE PLANS.
- THE ALLOWABLE SOIL BEARING STRESS SHALL BE 1000 LBS./SQ. FT. MULTIPLY TABULATED BEARING AREAS FOR HORIZONTAL BENDS AND FOR VERTICAL BENDS BY TWO (2).

NOTES:

- THIS DETAIL TO BE USED IN CONJUNCTION WITH METER BOX DETAIL. LONG SIDE SERVICE CONNECTION TUBING TO BE BORED UNDER EXISTING PAVEMENT.
- LIMITS OF SERVICE CONNECTION PAY ITEM INCLUDES TAP, CORPORATION STOP, GATE VALVE AND BOX, POLYETHYLENE TUBING, AND METER BOX (SEE METER BOX DETAIL). PAY ITEM SHALL BE BASED ON INSTALLED LENGTHS OF POLYETHYLENE TUBE SHOWN IN TABLE 1.


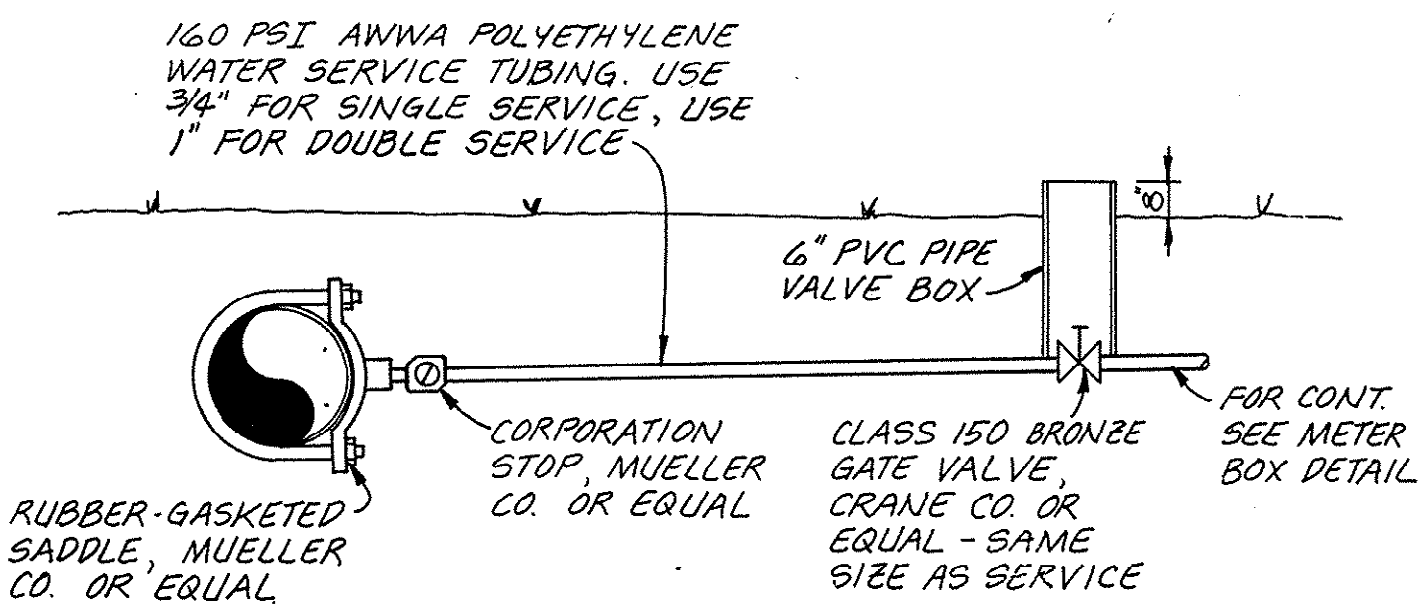



TABLE 1 POLYETHYLENE TUBING				
INSTALLED LENGTH (FT)	SHORT SIDE		LONG SIDE	
	SINGLE	DOUBLE	SINGLE	DOUBLE
3/4"	10	50	40	50
1"	—	10	—	40

WATER SERVICE DETAIL

N.T.S.

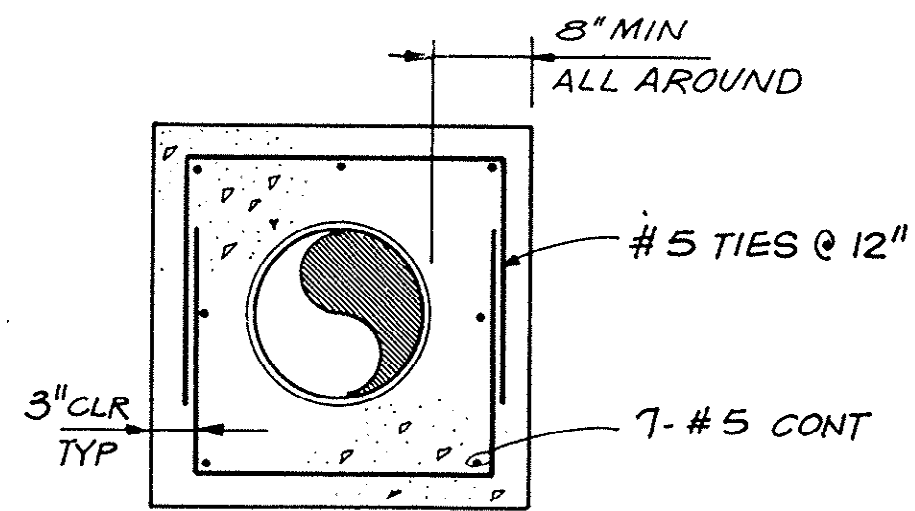


PIPE ENCASEMENT
N.T.S.

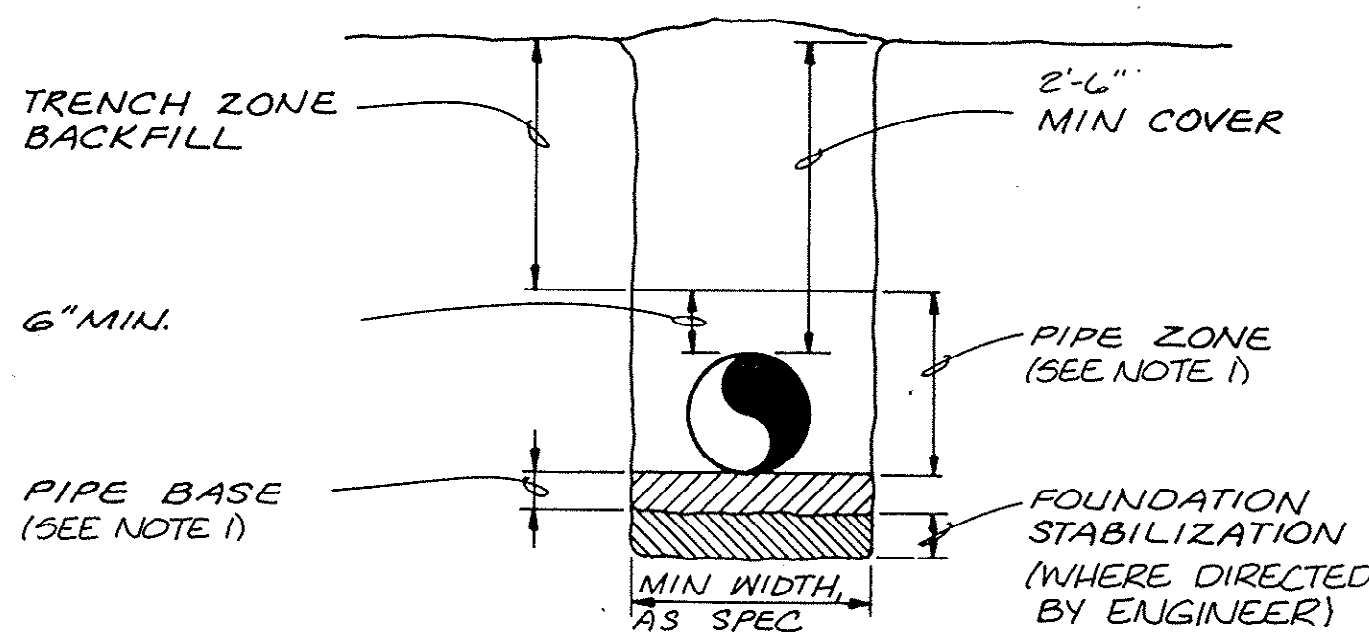

NOTES:
1. SELECT TRENCH EXCAVATED MATERIAL UNLESS OTHERWISE DIRECTED BY ENGINEER. PLACE AND COMPACT AS SPECIFIED



TYPICAL TRENCH
N.T.S.

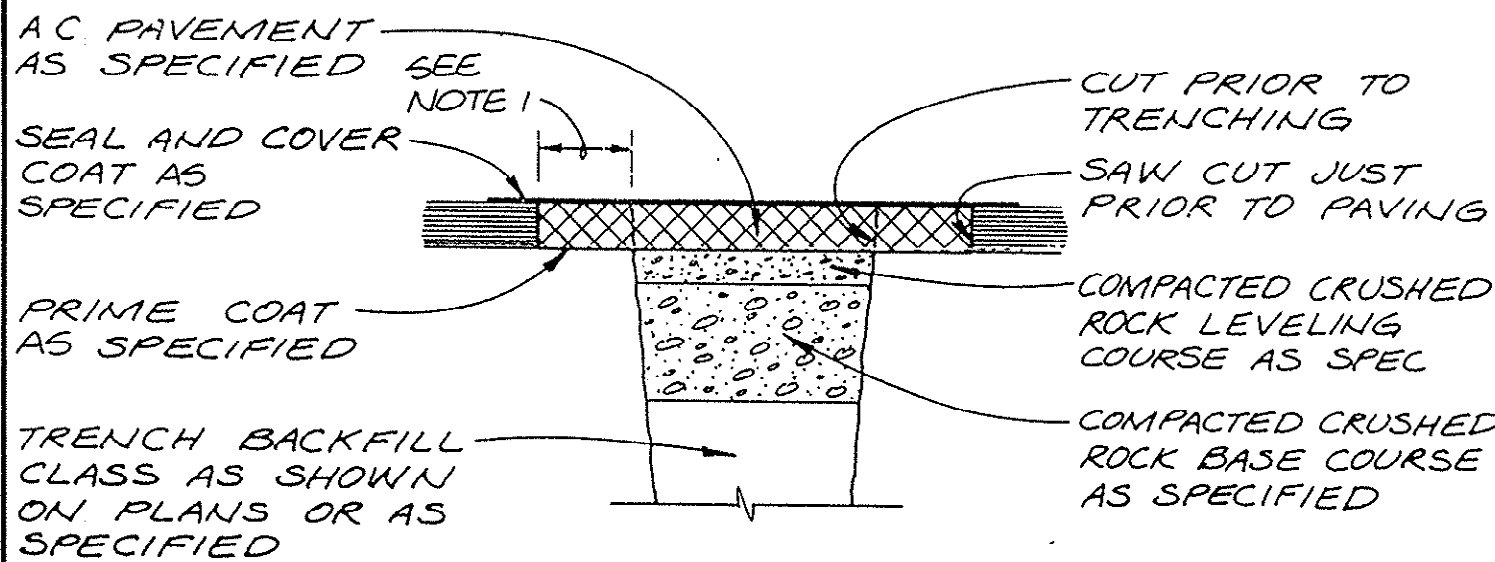


ASPHALT CONCRETE

- NOTES:
1. RESTORED PAVEMENT SHALL EXTEND MINIMUM 12" ON BOTH SIDES OF TRENCH, OR GREATER THAN 12" AS REQUIRED BY SOUTH CAROLINA STATE HIGHWAY DEPARTMENT STANDARD SPECIFICATIONS FOR HIGHWAY CONSTRUCTION.

SURFACE RESTORATION
N.T.S.

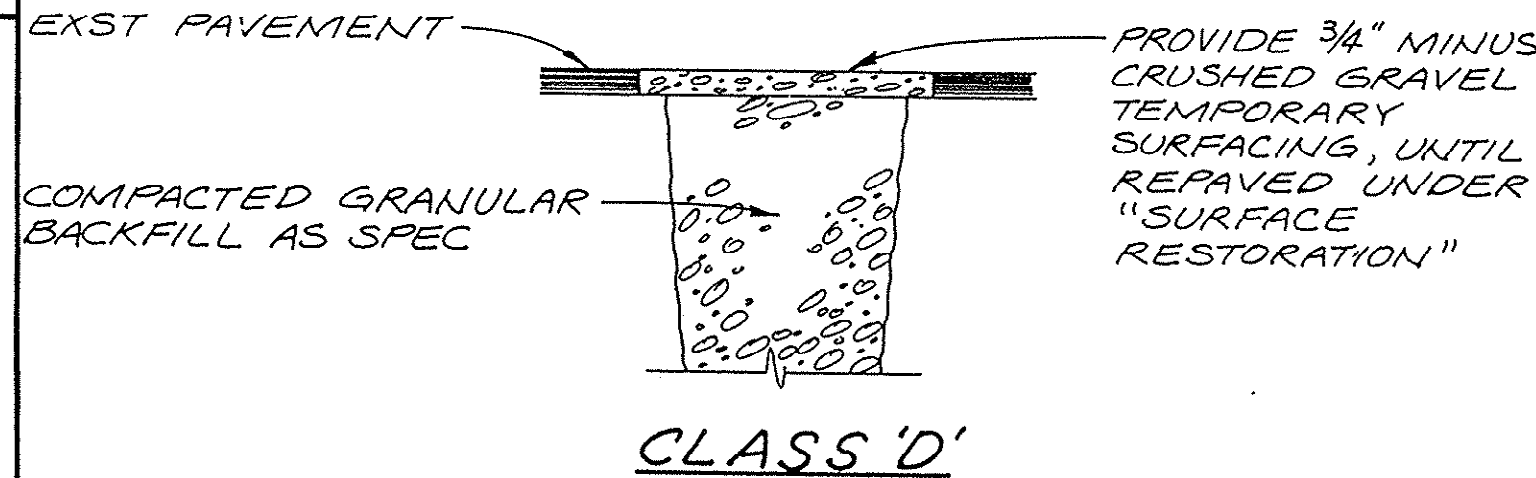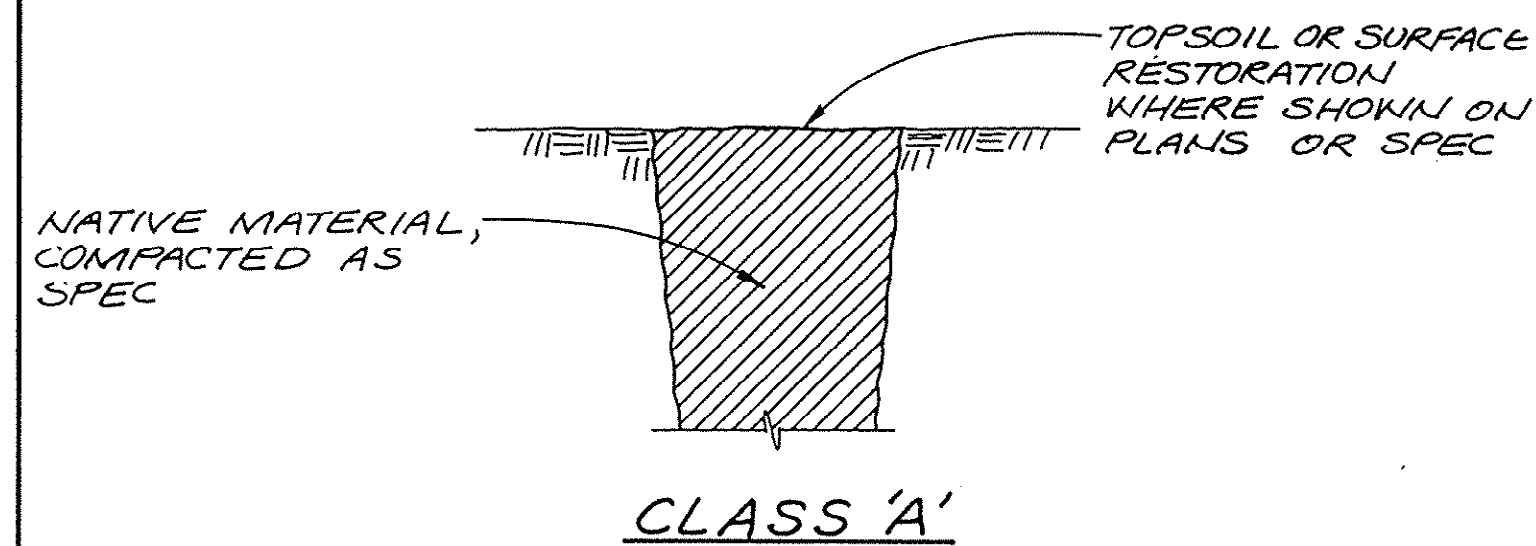

TRENCH BACKFILL
ABOVE THE PIPE ZONE
N.T.S.

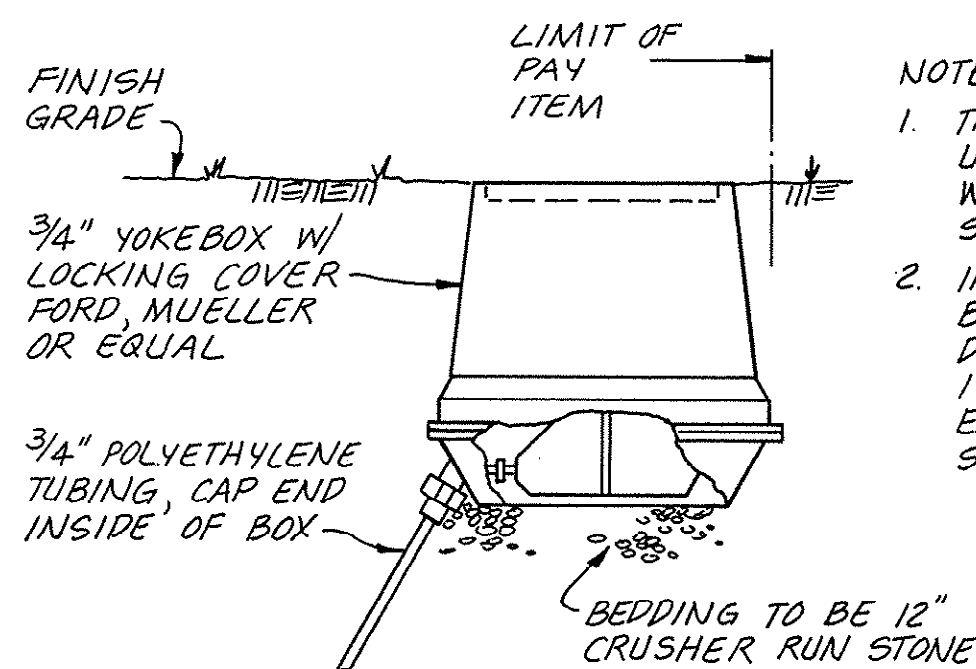

METER BOX DETAIL
N.T.S.

- NOTES:
1. THIS DETAIL TO BE USED IN CONJUNCTION WITH WATER SERVICE DETAIL
2. INSTALL 2 METER BOXES FOR EACH DOUBLE SERVICE, 1 METER BOX FOR EACH SINGLE SERVICE.

14-II-002/17-W



CH2M HILL	DSGN T. SMALLWOOD
	DR M. HALES
	CHK C. CRANDALL
APVD R. HIRSEKORN	

NO.	DATE	REVISION	BY	APVD


REUSE OF DOCUMENTS
THIS DOCUMENT, AND THE IDEAS AND DESIGNS INCORPORATED HEREIN, AS AN INSTRUMENT OF PROFESSIONAL SERVICE, IS THE PROPERTY OF CH2M HILL AND IS NOT TO BE USED, IN WHOLE OR IN PART, FOR ANY OTHER PROJECT WITHOUT THE WRITTEN AUTHORIZATION OF CH2M HILL.

VERIFY SCALES
BAR IS ONE INCH ON ORIGINAL DRAWING.
IF NOT ONE INCH ON THIS SHEET, ADJUST SCALES ACCORDINGLY.


WATER SYSTEM IMPROVEMENTS
BURGESS COMMUNITY
GRAND STRAND WATER & SEWER AUTHORITY

STANDARD DETAILS


SHEET	2
OF	17
DATE	FEB 1985
PROJ NO.	SA17940.A1

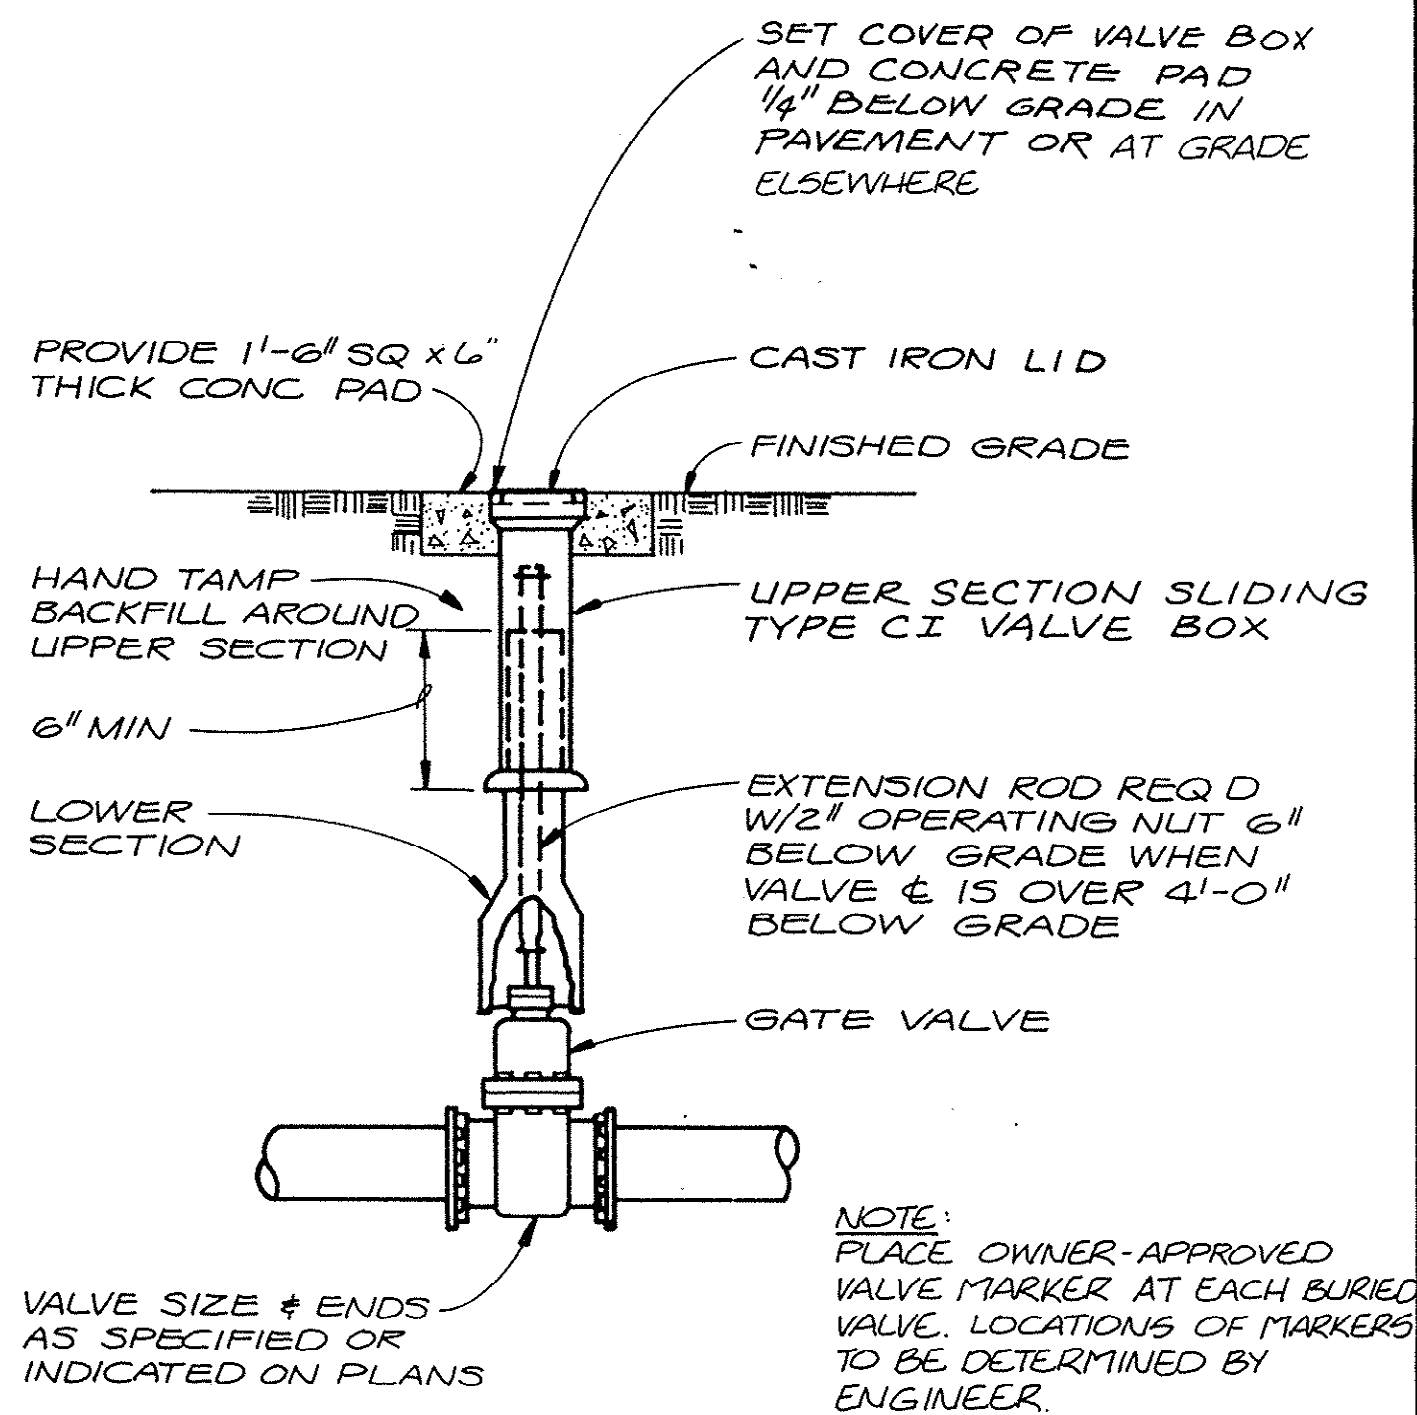


BURIED GATE VALVE BOX SETTING
NTS

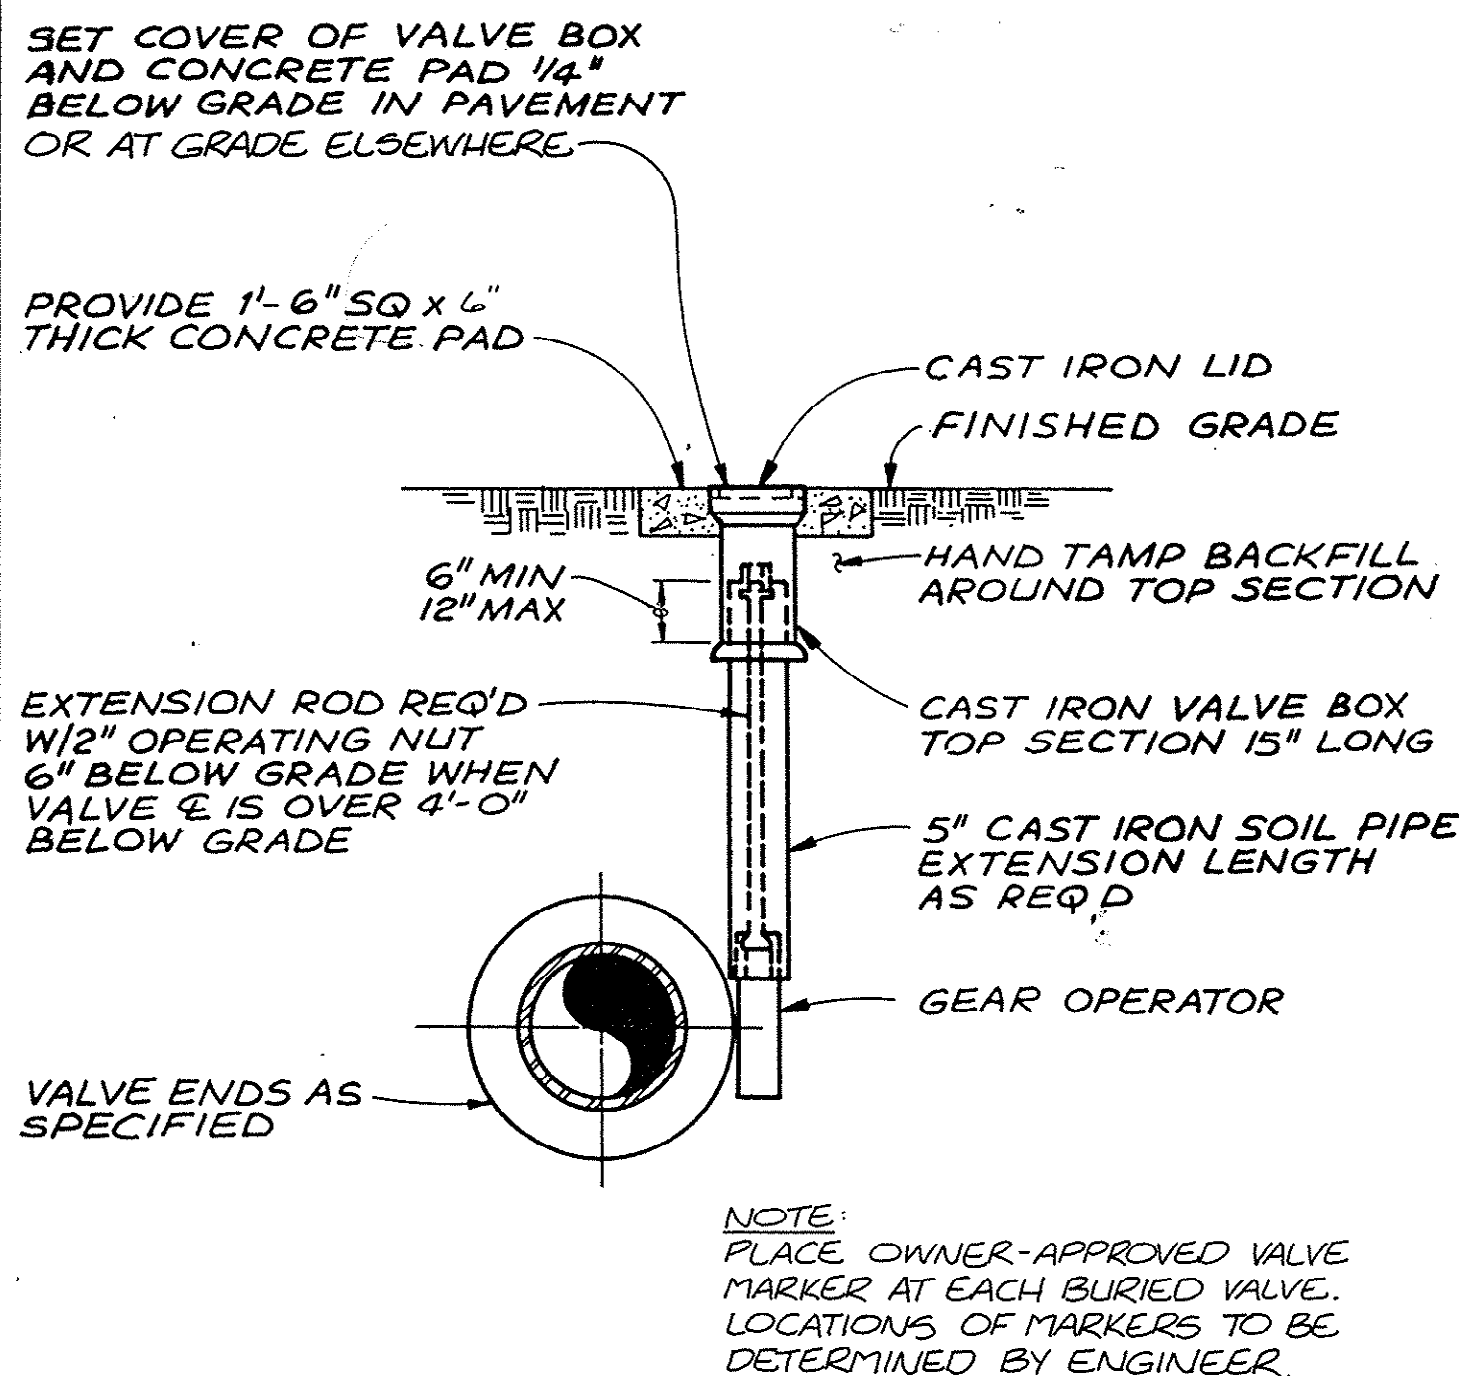


BURIED BUTTERFLY VALVE BOX SETTING
NTS

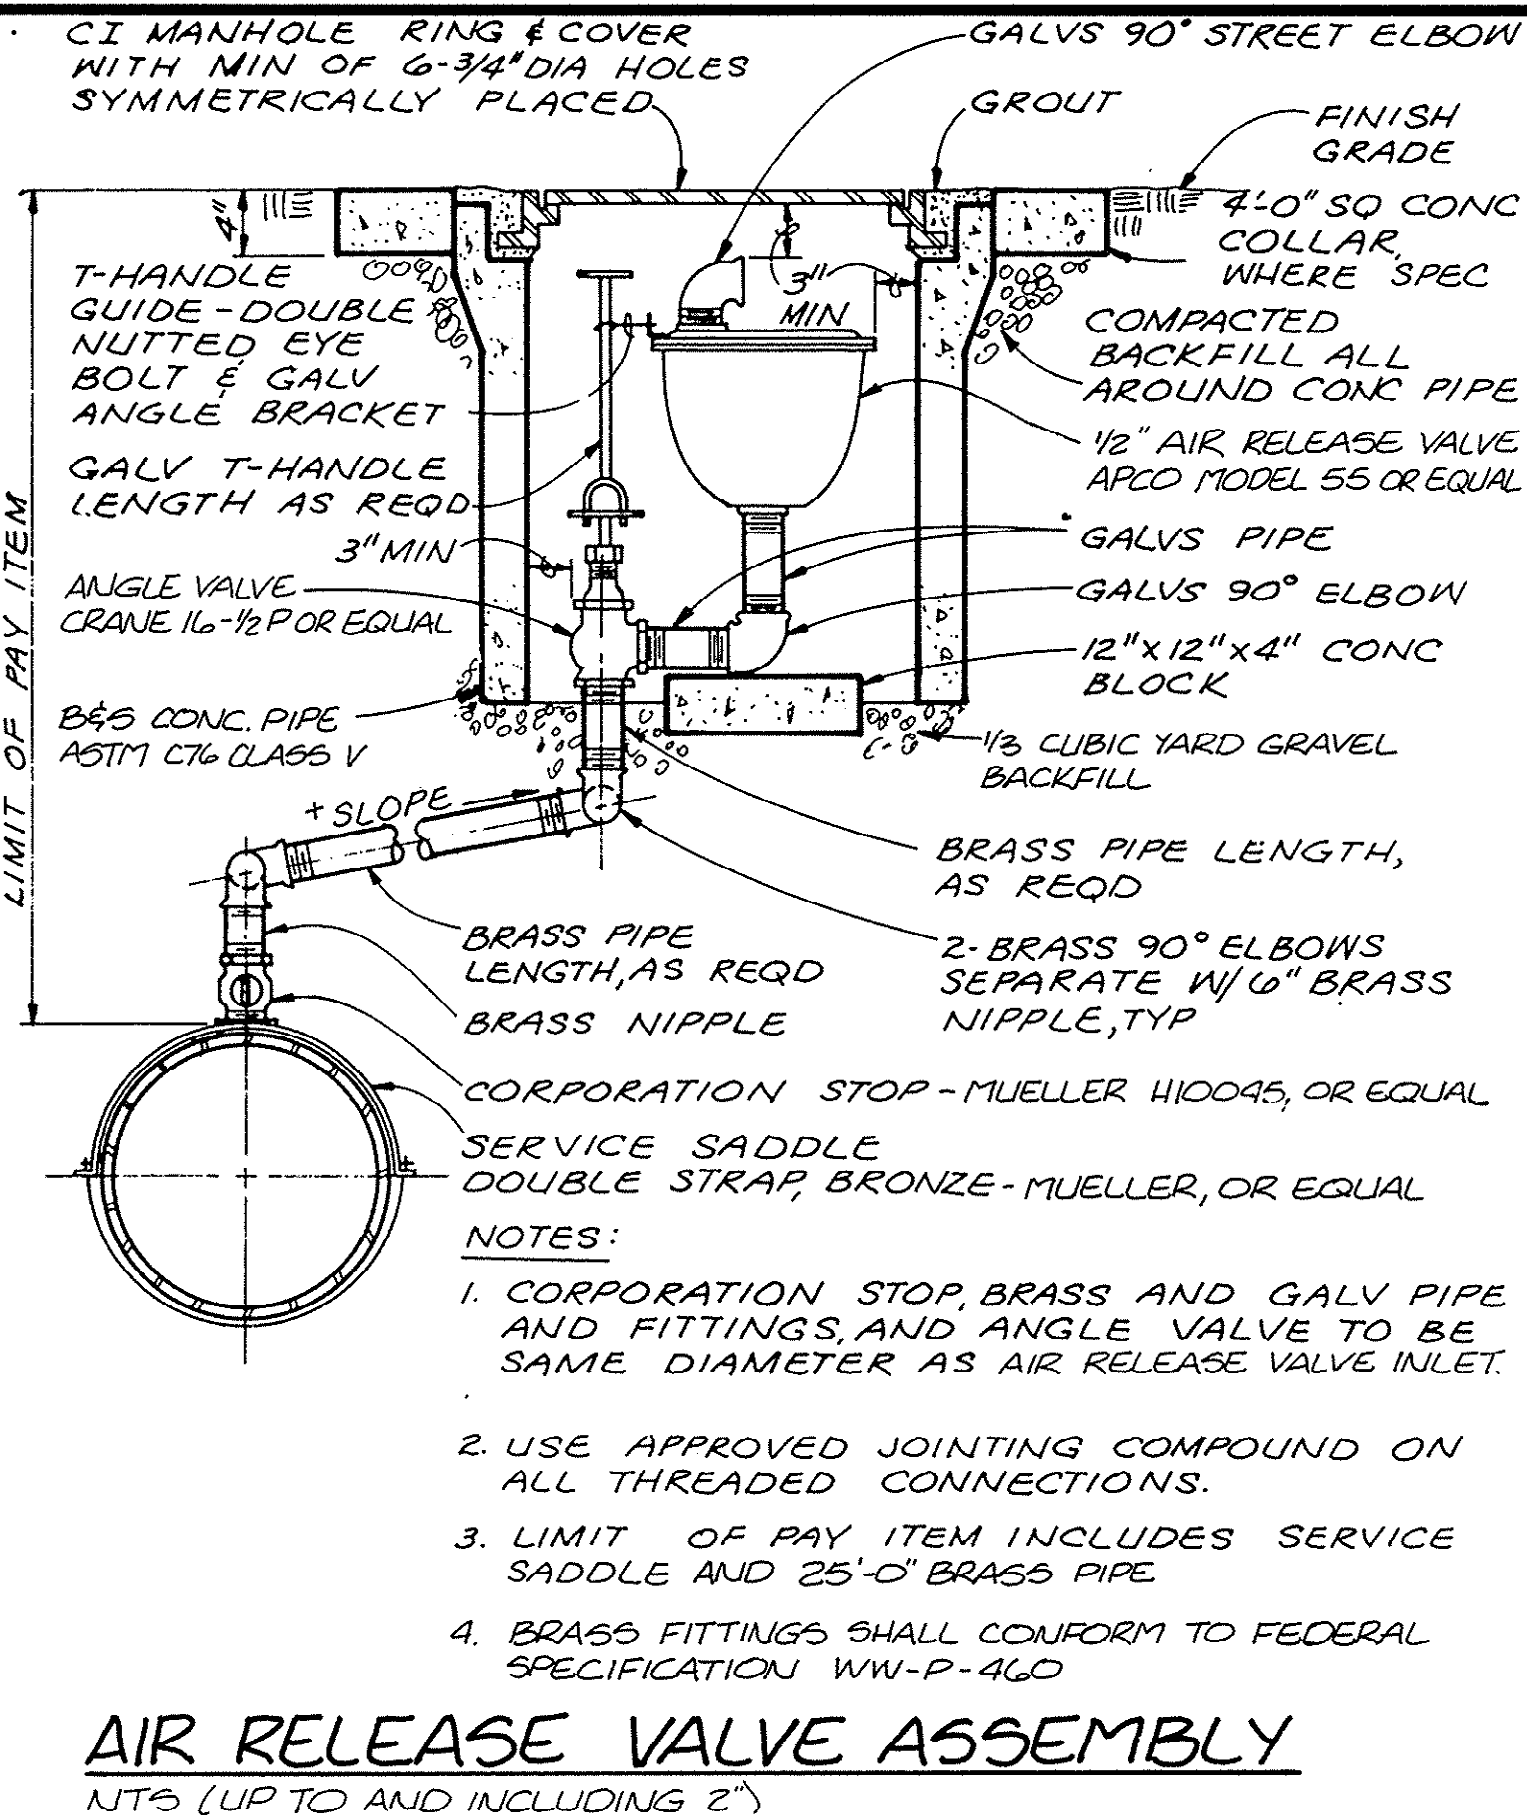


AIR RELEASE VALVE ASSEMBLY
NTS (UP TO AND INCLUDING 2")

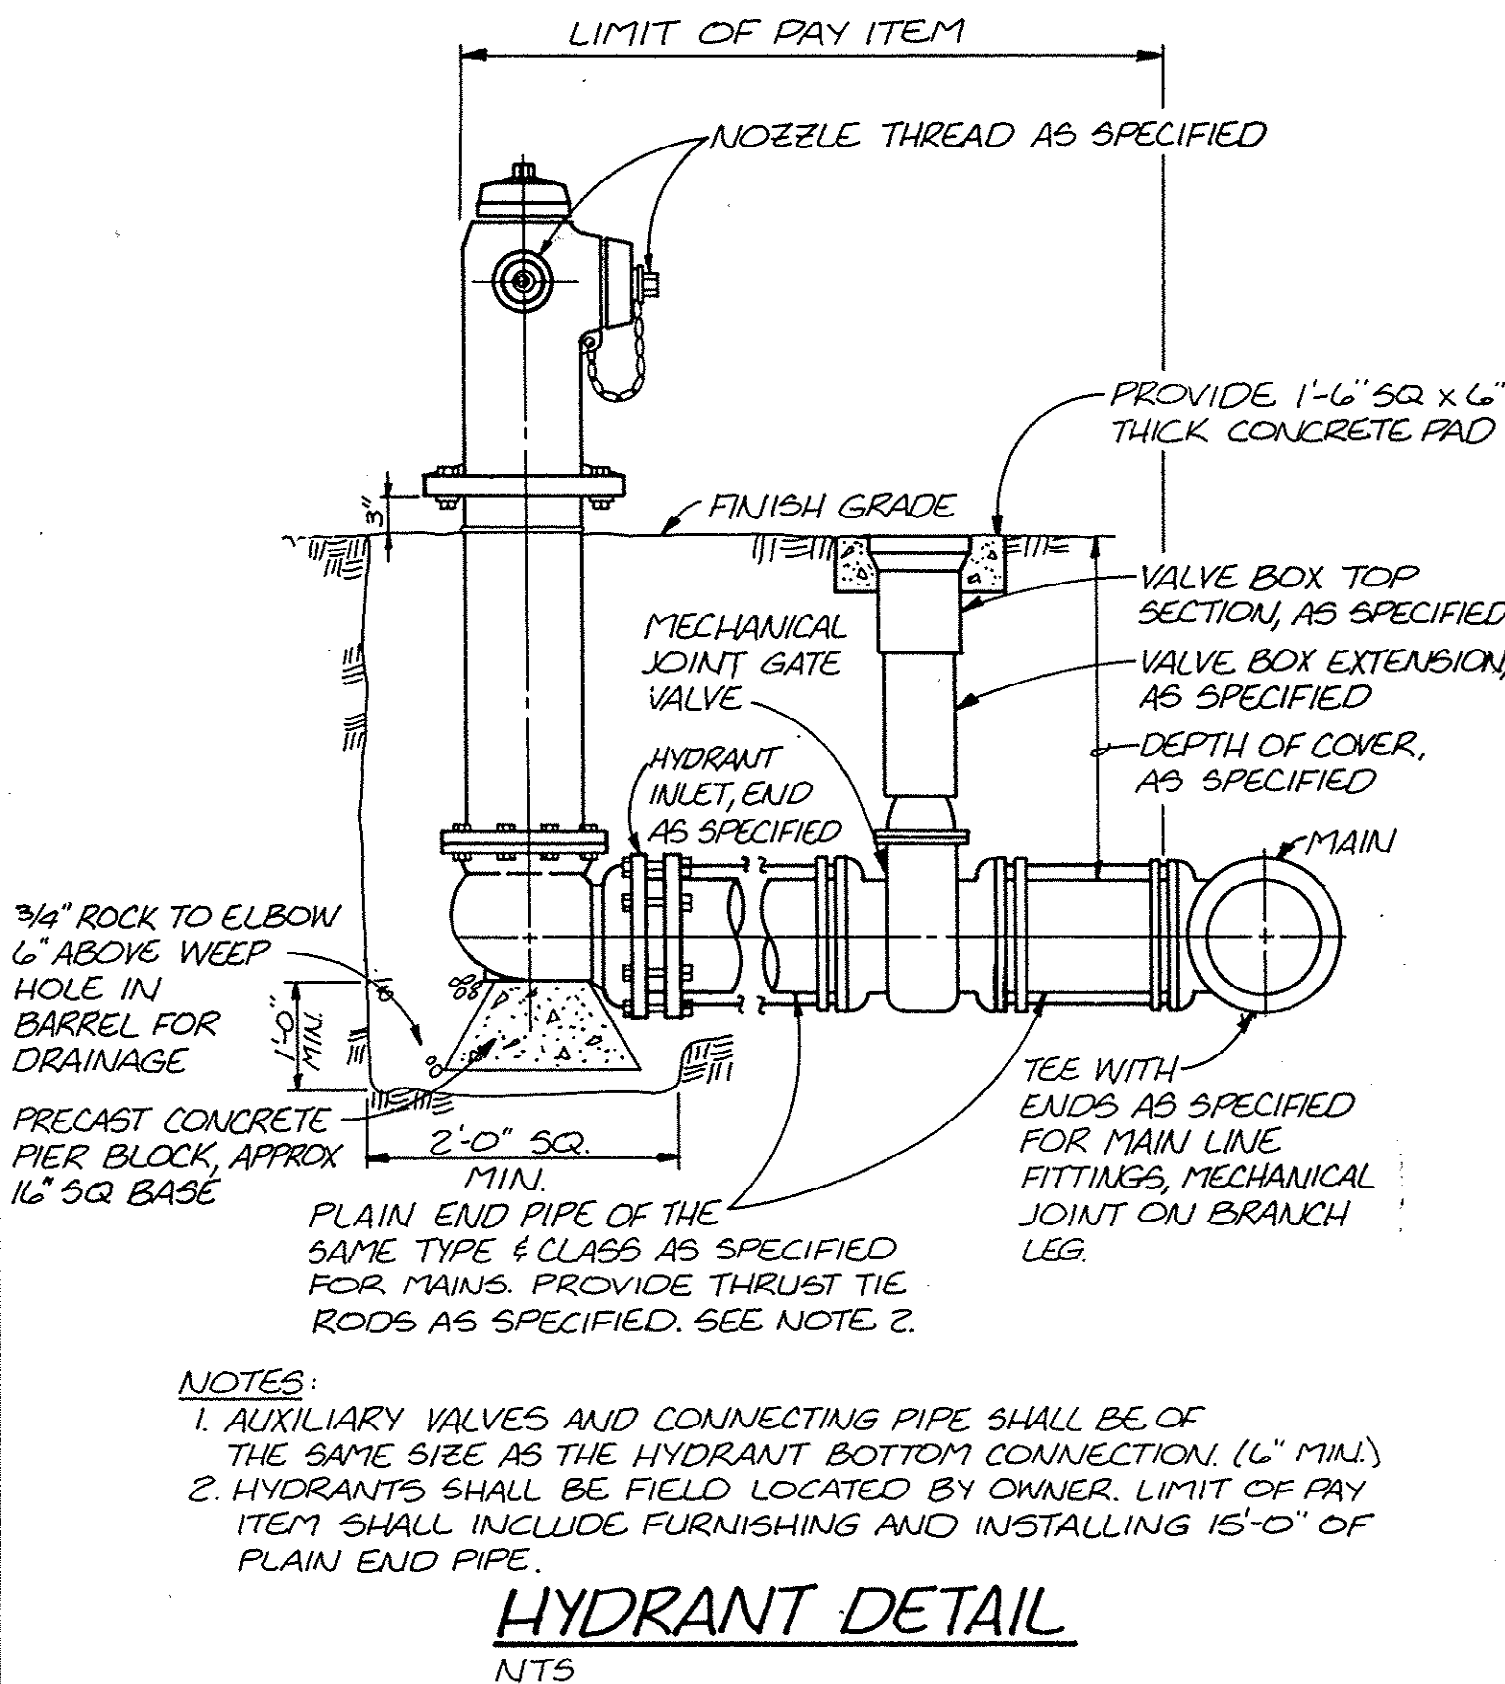

HYDRANT DETAIL
NTS

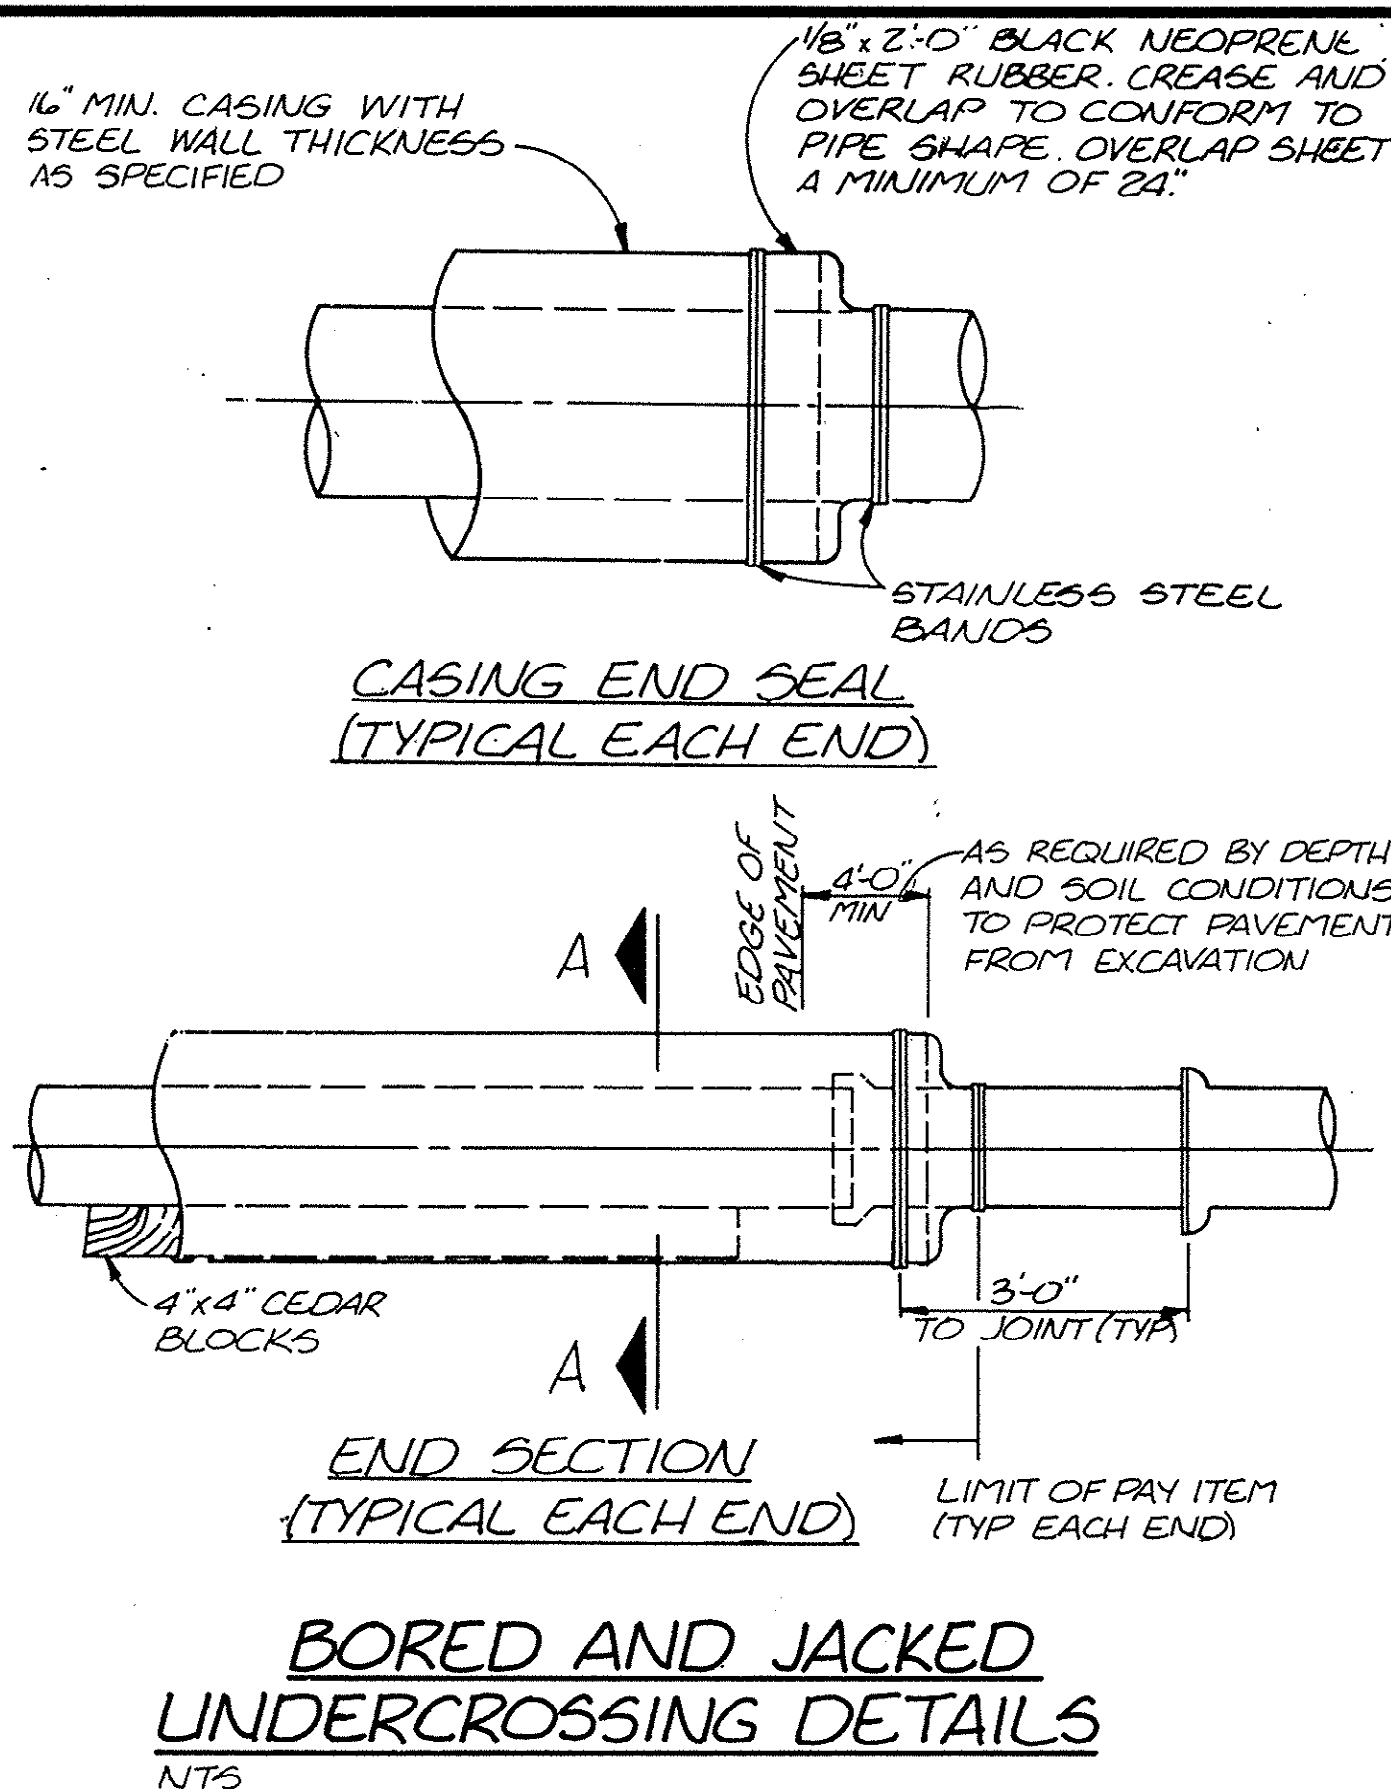

BORED AND JACKED UNDERCROSSING DETAILS
NTS

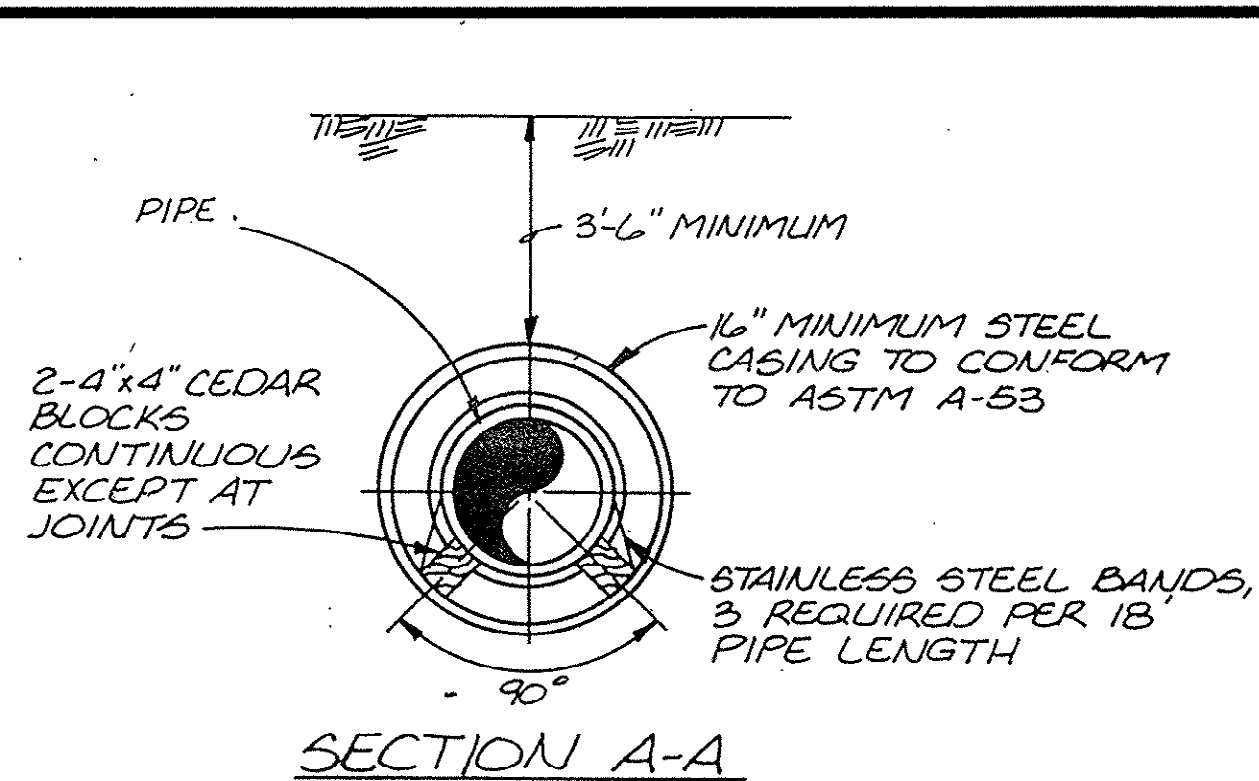

WATERLINE LOCATION SCHEDULE

LINE 2

STA	N.E.P.	S.E.P.	NEW
1	7	29	0
2	8	27	0
3	8	27	0
4	8	28	0
5	10	29	2
6	10	30	2
7	11	31	3
8	12	32	4
9	12	32	4
10	13	33	4
11	14	34	5
12	14	34	5
13	15	35	5
14	15	35	6
15	15	35	6
16	25	46	18
17	7	29	0
18	7	29	0
19	16	32	8
20	21	3	27
21	22	1	28
22	23	2	29
23	25	4	31
24	31	10	38
25	32	15	43
26	14	7	21
27	3	19	9
28	1	22	7
29	0	22	7
30	0	22	7
31	0	21	7
32	0	21	7
33	0	21	7
34	0	21	7
35	0	21	7
36	0	21	7
37	0	21	7
38	0	21	7
39	1	22	7
40	2	23	6
41	3	23	5
42	3	23	5
43	3	23	5
44	3	23	5
45	3	23	5
46	3	23	5
47	3	23	5
48	3	23	5
49	2	22	5
50	1	22	5
51	1	22	5
52	0	21	5
53	0	21	5
54	0	21	5
55	14	37	6
56	4	27	3
57	2	20	10
58	6	17	12
59	7	17	14
60	6	18	13
61	3	20	11
62	3	20	11
63	3	20	11
64	4	19	13
65	4	19	13
66	3	20	13
67	3	20	13
68	2	20	12
69	2	21	11
70	2	21	11
71	2	21	11
72	2	21	11
73	2	21	11
74	0	22	7
75	0	22	7
76	0	22	7
77	0	22	7
78	0	22	7
79	0	22	7
80	0	22	7
81	0	22	7
82	0	22	7
83	0	22	7
84	1	22	7
85	1	22	7
86	1	22	7
87	1	22	7
88	0	22	7
89	0	22	7
90	0	22	7
91	1	22	7
92	1	22	7
93	0	22	7
94	3	19	10
95	5	18	11
96	6	16	12

LINE 2A

STA	N.E.P.	S.E.P.	NEW
1	5	35	1
2	3	31	2
3	0	27	5
4	1	23	7
5	20	59	10
6	9	22	8
7	0	22	8
8	0	22	8
9	0	22	8
10	0	22	8
11	0	22	8
12	1	21	9
13	1	21	9
14	2	21	9
15	2	21	9
16	9	33	2
17	16	41	9
18	0	21	7
19	3	25	10
20	3	25	10
21	3	25	10
22	1	25	9
23	2	25	8
24	2	25	7
25	1	25	7

LINE 3

STA	N.E.P.	S.E.P.	NEW
1	3	17	4
2	2	16	6
3	0	15	7
4	1	14	9
5	3	13	10
6	5	12	12
7	7	10	14
8	9	9	15
9	11	8	18
10	13	5	20
11	16	4	22
12	18	2	24
13	21	0	27
14	23	2	29
15	25	3	32
16	27	4	33
17	29	6	35
18	30	7	37
19	30	7	38
20	30	6	37
21	29	4	36
22	26	3	34
23	24	2	32
24	22	1	30
25	20	0	28
26	18	2	25
27	16	4	23
28	14	5	22
29	12	7	21
30	10	8	20
31	8	10	19
32	6	12	18
33	4	14	17
34	2	16	16
35	0	18	15
36	0	20	14
37	0	22	13
38	0	24	12
39	0	26	11
40	0	28	10
41	0	30	9
42	0	32	8
43	0	34	7
44	0	36	6
45	0	38	5
46	0	40	4
47	0	42	3
48	0	44	2
49	0	46	1
50	0	48	0
51	0	50	0
52	0	52	0
96	0	140	0



DSGN	T. SMALLWOOD
DR	M. HALES
CHK	C. CRANDALL
APVD	R. HIRSEKORN

NO.	DATE	REVISION	BY	APVD





REUSE OF DOCUMENTS
THIS DOCUMENT, AND THE IDEAS AND DESIGNS INCORPORATED HEREIN, AS AN INSTRUMENT OF PROFESSIONAL SERVICE, IS THE PROPERTY OF CH2M HILL AND IS NOT TO BE USED, IN WHOLE OR IN PART, FOR ANY OTHER PROJECT WITHOUT THE WRITTEN AUTHORIZATION OF CH2M HILL.

VERIFY SCALES
BAR IS ONE INCH ON ORIGINAL DRAWING.
IF NOT ONE INCH ON THIS SHEET, ADJUST SCALES ACCORDINGLY.

WATER SYSTEM IMPROVEMENTS
BURGESS COMMUNITY
GRAND STRAND WATER & SEWER AUTHORITY

STANDARD DETAILS

SHEET	3
OF	17
DATE	FEB 1985
PROJ NO.	SA17940.A1

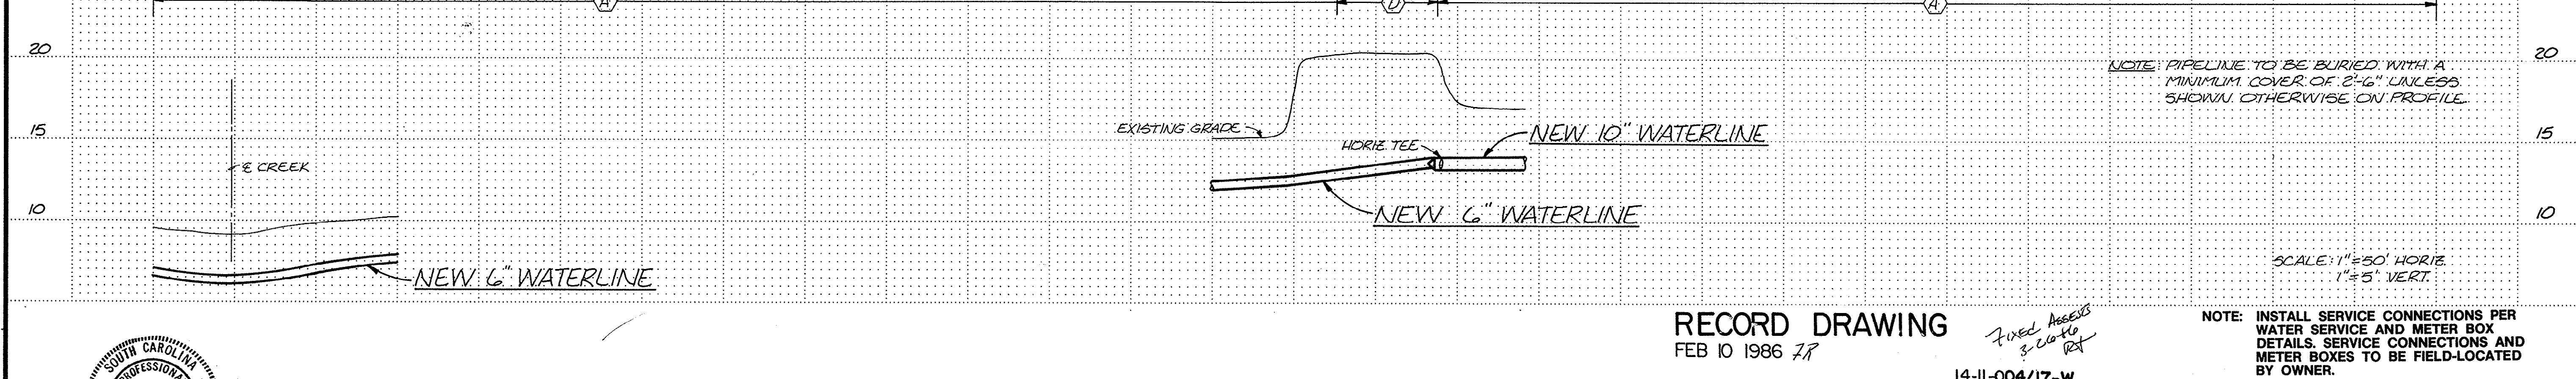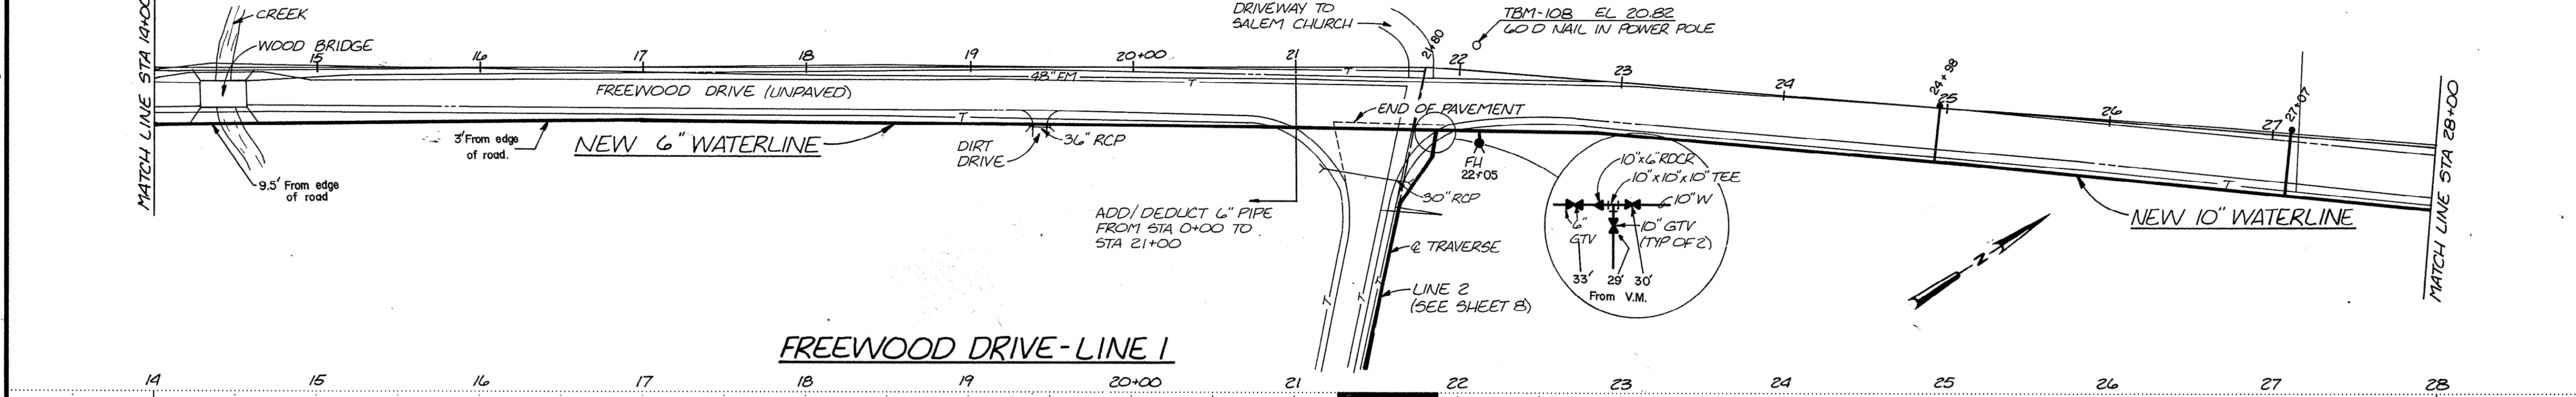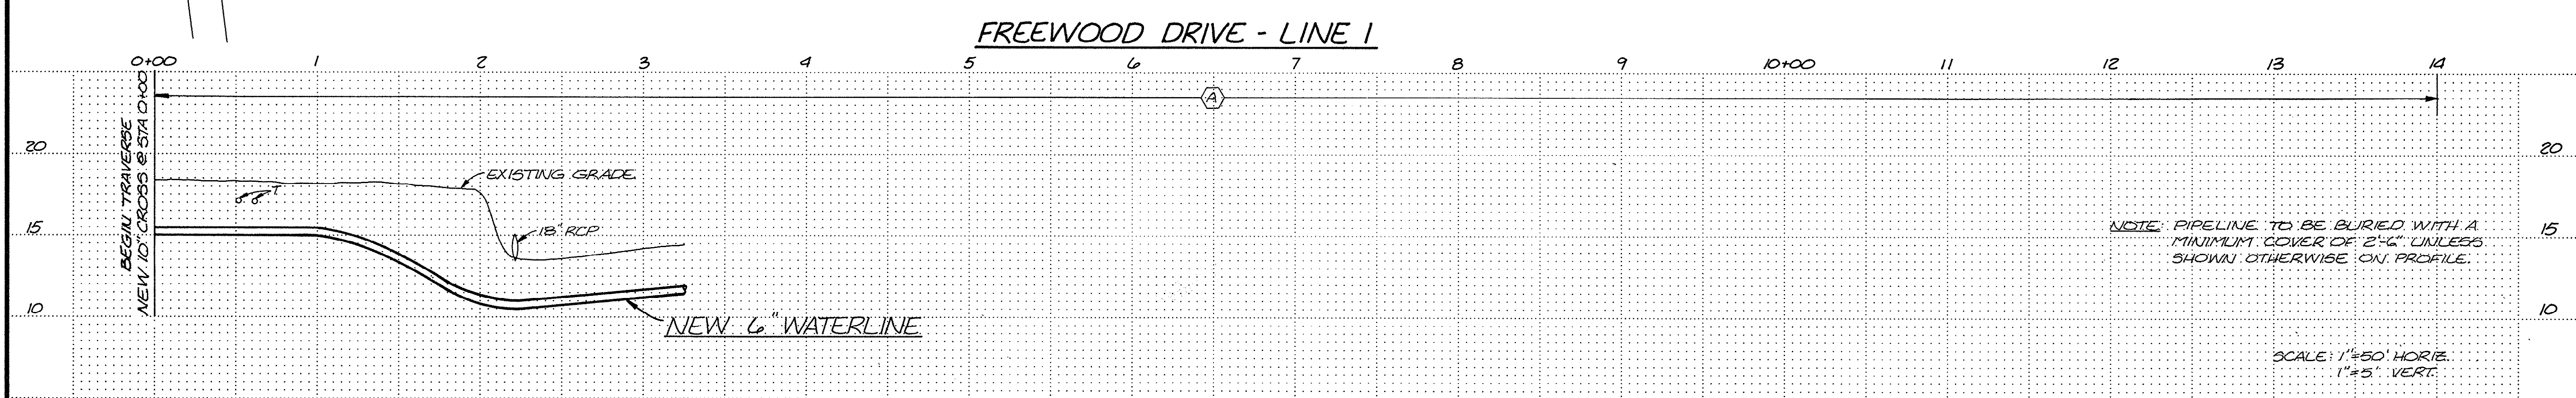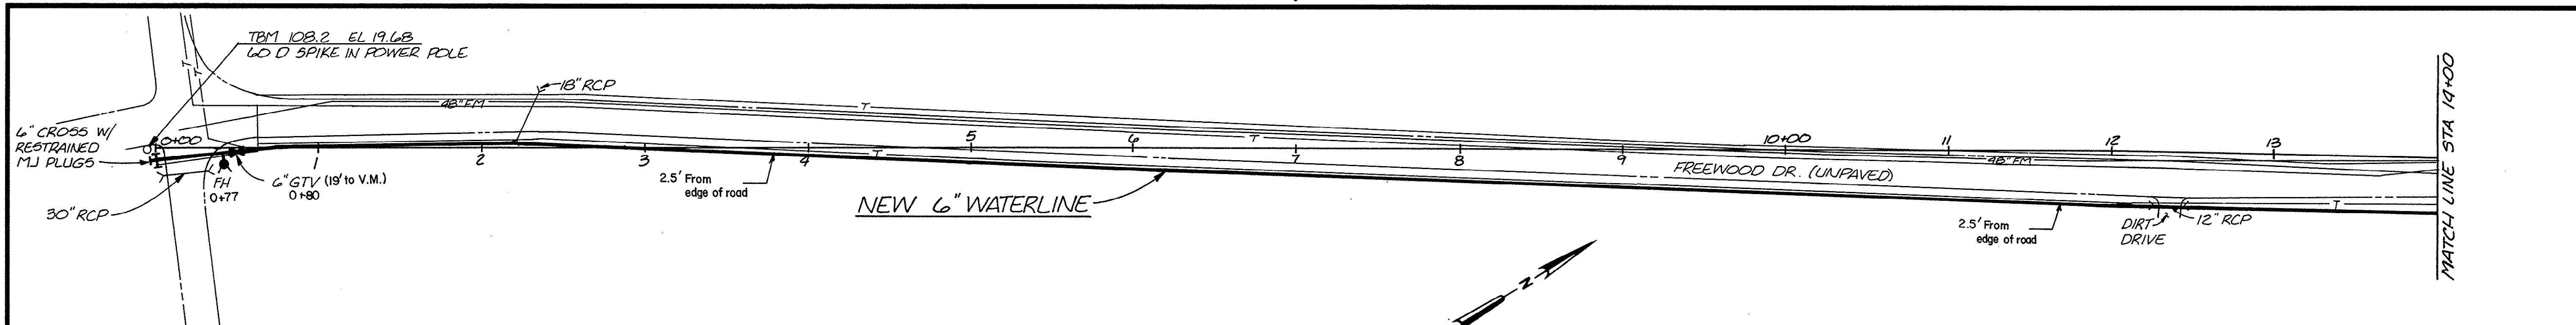

RECORD DRAWING
FEB 10 1986 JR

Fixed Assets
3/2/86
RT

NOTE: INSTALL SERVICE CONNECTIONS PER WATER SERVICE AND METER BOX DETAILS. SERVICE CONNECTIONS AND METER BOXES TO BE FIELD-LOCATED BY OWNER.



CH2M HILL	DSGN	T. SMALLWOOD	NO.	DATE	REVISION	BY	APVD
	DR	M. HALES					
	CHK	C. CRANDALL					
	APVD	R. HIRSEKORN					


REUSE OF DOCUMENTS
THIS DOCUMENT, AND THE IDEAS AND DESIGNS INCORPORATED HEREIN, AS AN INSTRUMENT OF PROFESSIONAL SERVICE, IS THE PROPERTY OF CH2M HILL AND IS NOT TO BE USED, IN WHOLE OR IN PART, FOR ANY OTHER PROJECT WITHOUT THE WRITTEN AUTHORIZATION OF CH2M HILL.

VERIFY SCALES
BAR IS ONE INCH ON ORIGINAL DRAWING.
IF NOT ONE INCH ON THIS SHEET, ADJUST SCALES ACCORDINGLY.



WATER SYSTEM IMPROVEMENTS
BURGESS COMMUNITY
GRAND STRAND WATER & SEWER AUTHORITY

LINE 1 - PLAN AND PROFILE
10" WATERLINE
STA 0+00 TO STA 28+00



SHEET	4
OF	17
DATE	FEB 1985
PROJ. NO.	SA17940.A1

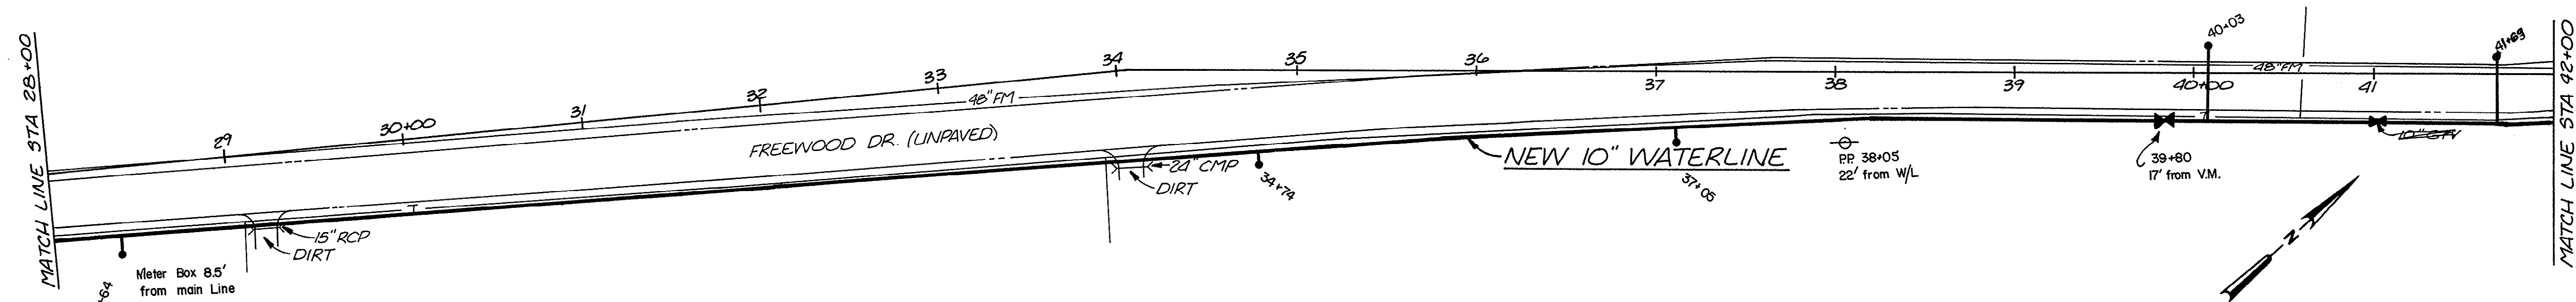

FREWOOD DRIVE - LINE 1

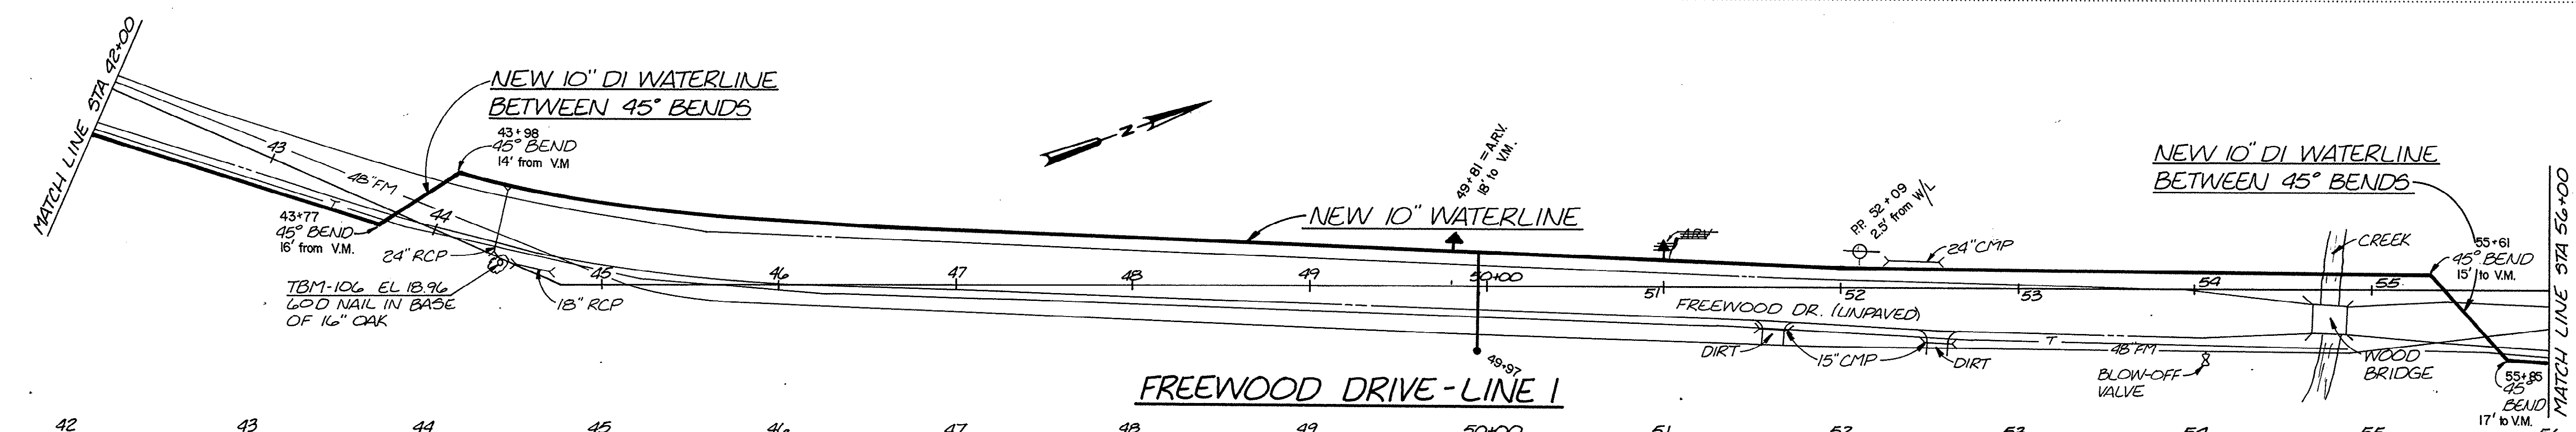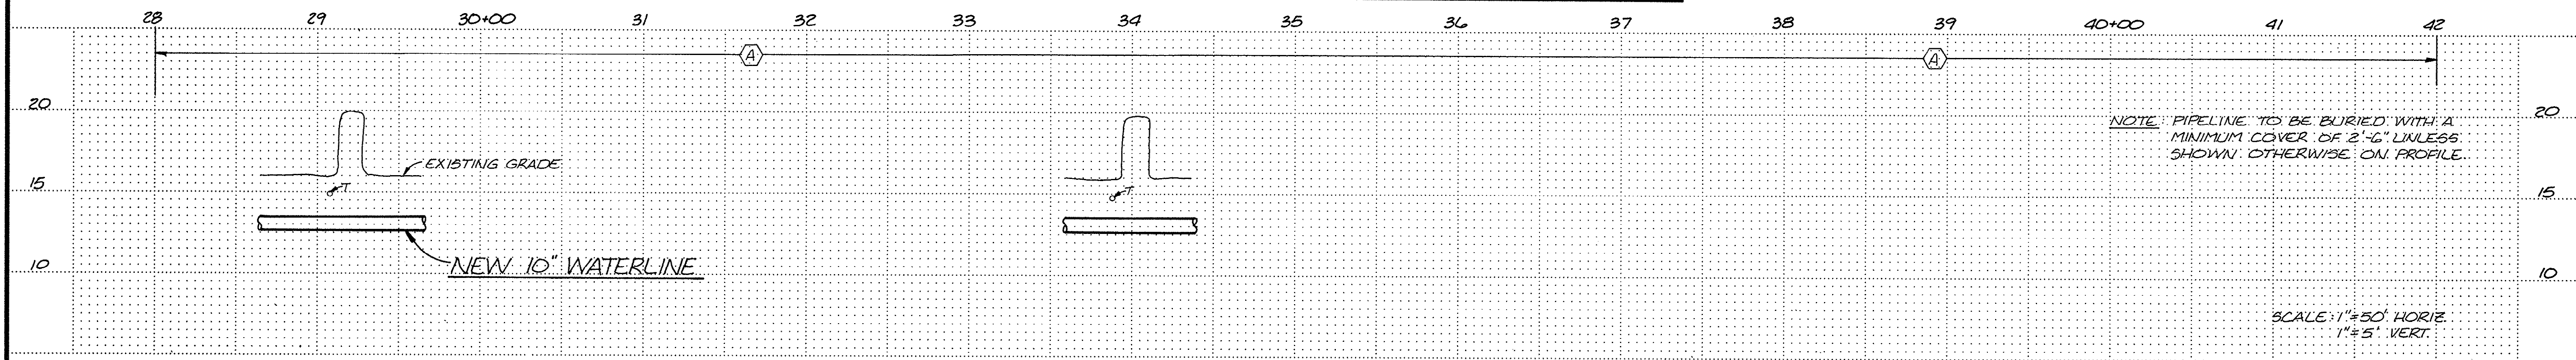

FREWOOD DRIVE - LINE 1

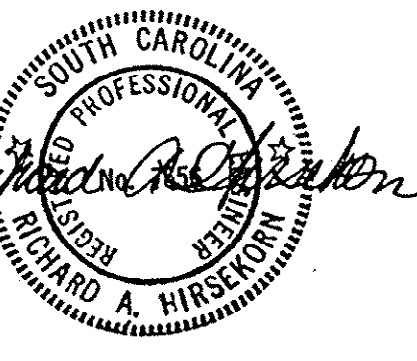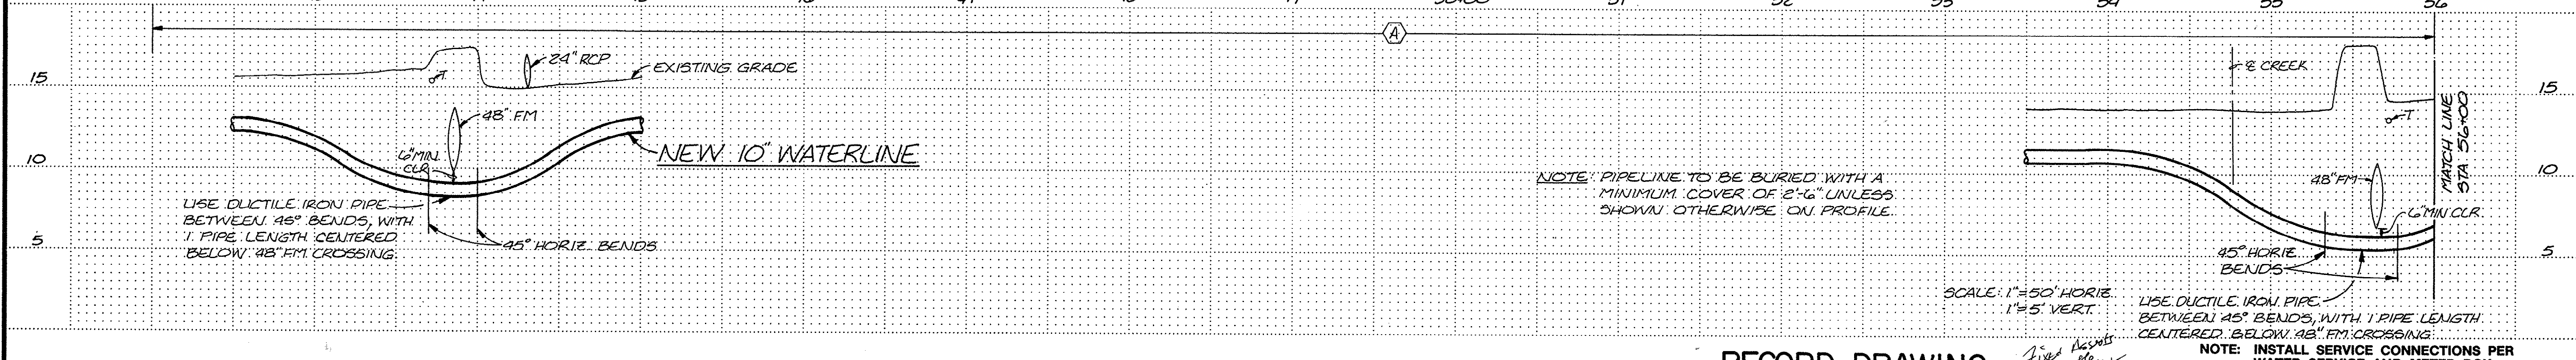

CH2M HILL	DESIGN	T. SMALLWOOD
	DR	M. HALES
	CHK	C. CRANDALL
	APVD	R. HIRSEKORN

NO.	DATE	REVISION	BY	APVD

REUSE OF DOCUMENTS
THIS DOCUMENT, AND THE IDEAS AND DESIGNS INCORPORATED HEREIN, AS AN INSTRUMENT OF PROFESSIONAL SERVICE, IS THE PROPERTY OF CH2M HILL AND IS NOT TO BE USED, IN WHOLE OR IN PART, FOR ANY OTHER PROJECT WITHOUT THE WRITTEN AUTHORIZATION OF CH2M HILL.

VERIFY SCALES
BAR IS ONE INCH ON ORIGINAL DRAWING.
IF NOT ONE INCH ON THIS SHEET, ADJUST SCALES ACCORDINGLY.

WATER SYSTEM IMPROVEMENTS
BURGESS COMMUNITY
GRAND STRAND WATER & SEWER AUTHORITY


RECORD DRAWING
FEB 10 1986 *AR*
14-11-005/17-W

NOTE: INSTALL SERVICE CONNECTIONS PER WATER SERVICE AND METER BOX DETAILS. SERVICE CONNECTIONS AND METER BOXES TO BE FIELD-LOCATED BY OWNER.

LINE 1 - PLAN AND PROFILE
10" WATERLINE
STA 28+00 TO STA 56+00

SHEET	5
OF	17
DATE	FEB 1986
PROJ	SA17940.A1

UNOFFICIAL
OVERLAY
SCREEN
CONTRACT

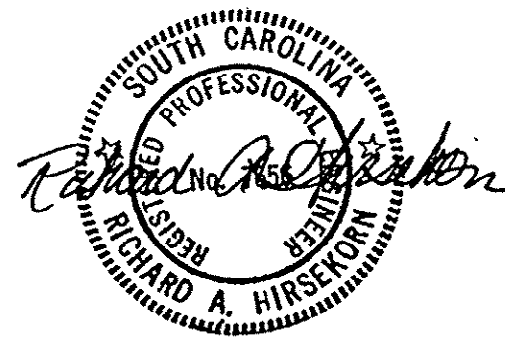

CH2M HILL
DESIGN: T. SMALLWOOD
DRAWN: M. HALES
CHECKED: C. CRANDALL
APPROVED: R. HIRSEKORN

NO. DATE REVISION

BY APVD


REUSE OF DOCUMENTS
THIS DOCUMENT, AND THE IDEAS AND DESIGNS INCORPORATED HEREIN, AS AN INSTRUMENT OF PROFESSIONAL SERVICE, IS THE PROPERTY OF CH2M HILL AND IS NOT TO BE USED, IN WHOLE OR IN PART, FOR ANY OTHER PROJECT WITHOUT THE WRITTEN AUTHORIZATION OF CH2M HILL.


VERIFY SCALES
BAR IS ONE INCH ON ORIGINAL DRAWING.
IF NOT ONE INCH ON THIS SHEET, ADJUST SCALES ACCORDINGLY.

WATER SYSTEM IMPROVEMENTS
BURGESS COMMUNITY
GRAND STRAND WATER & SEWER AUTHORITY


LINE 1 - PLAN AND PROFILE
10" WATERLINE
STA 56+00 TO STA 82+00

SHEET **6**
OF 17
DATE **FEB 1985**
PROJ. NO. **SA17940A1**

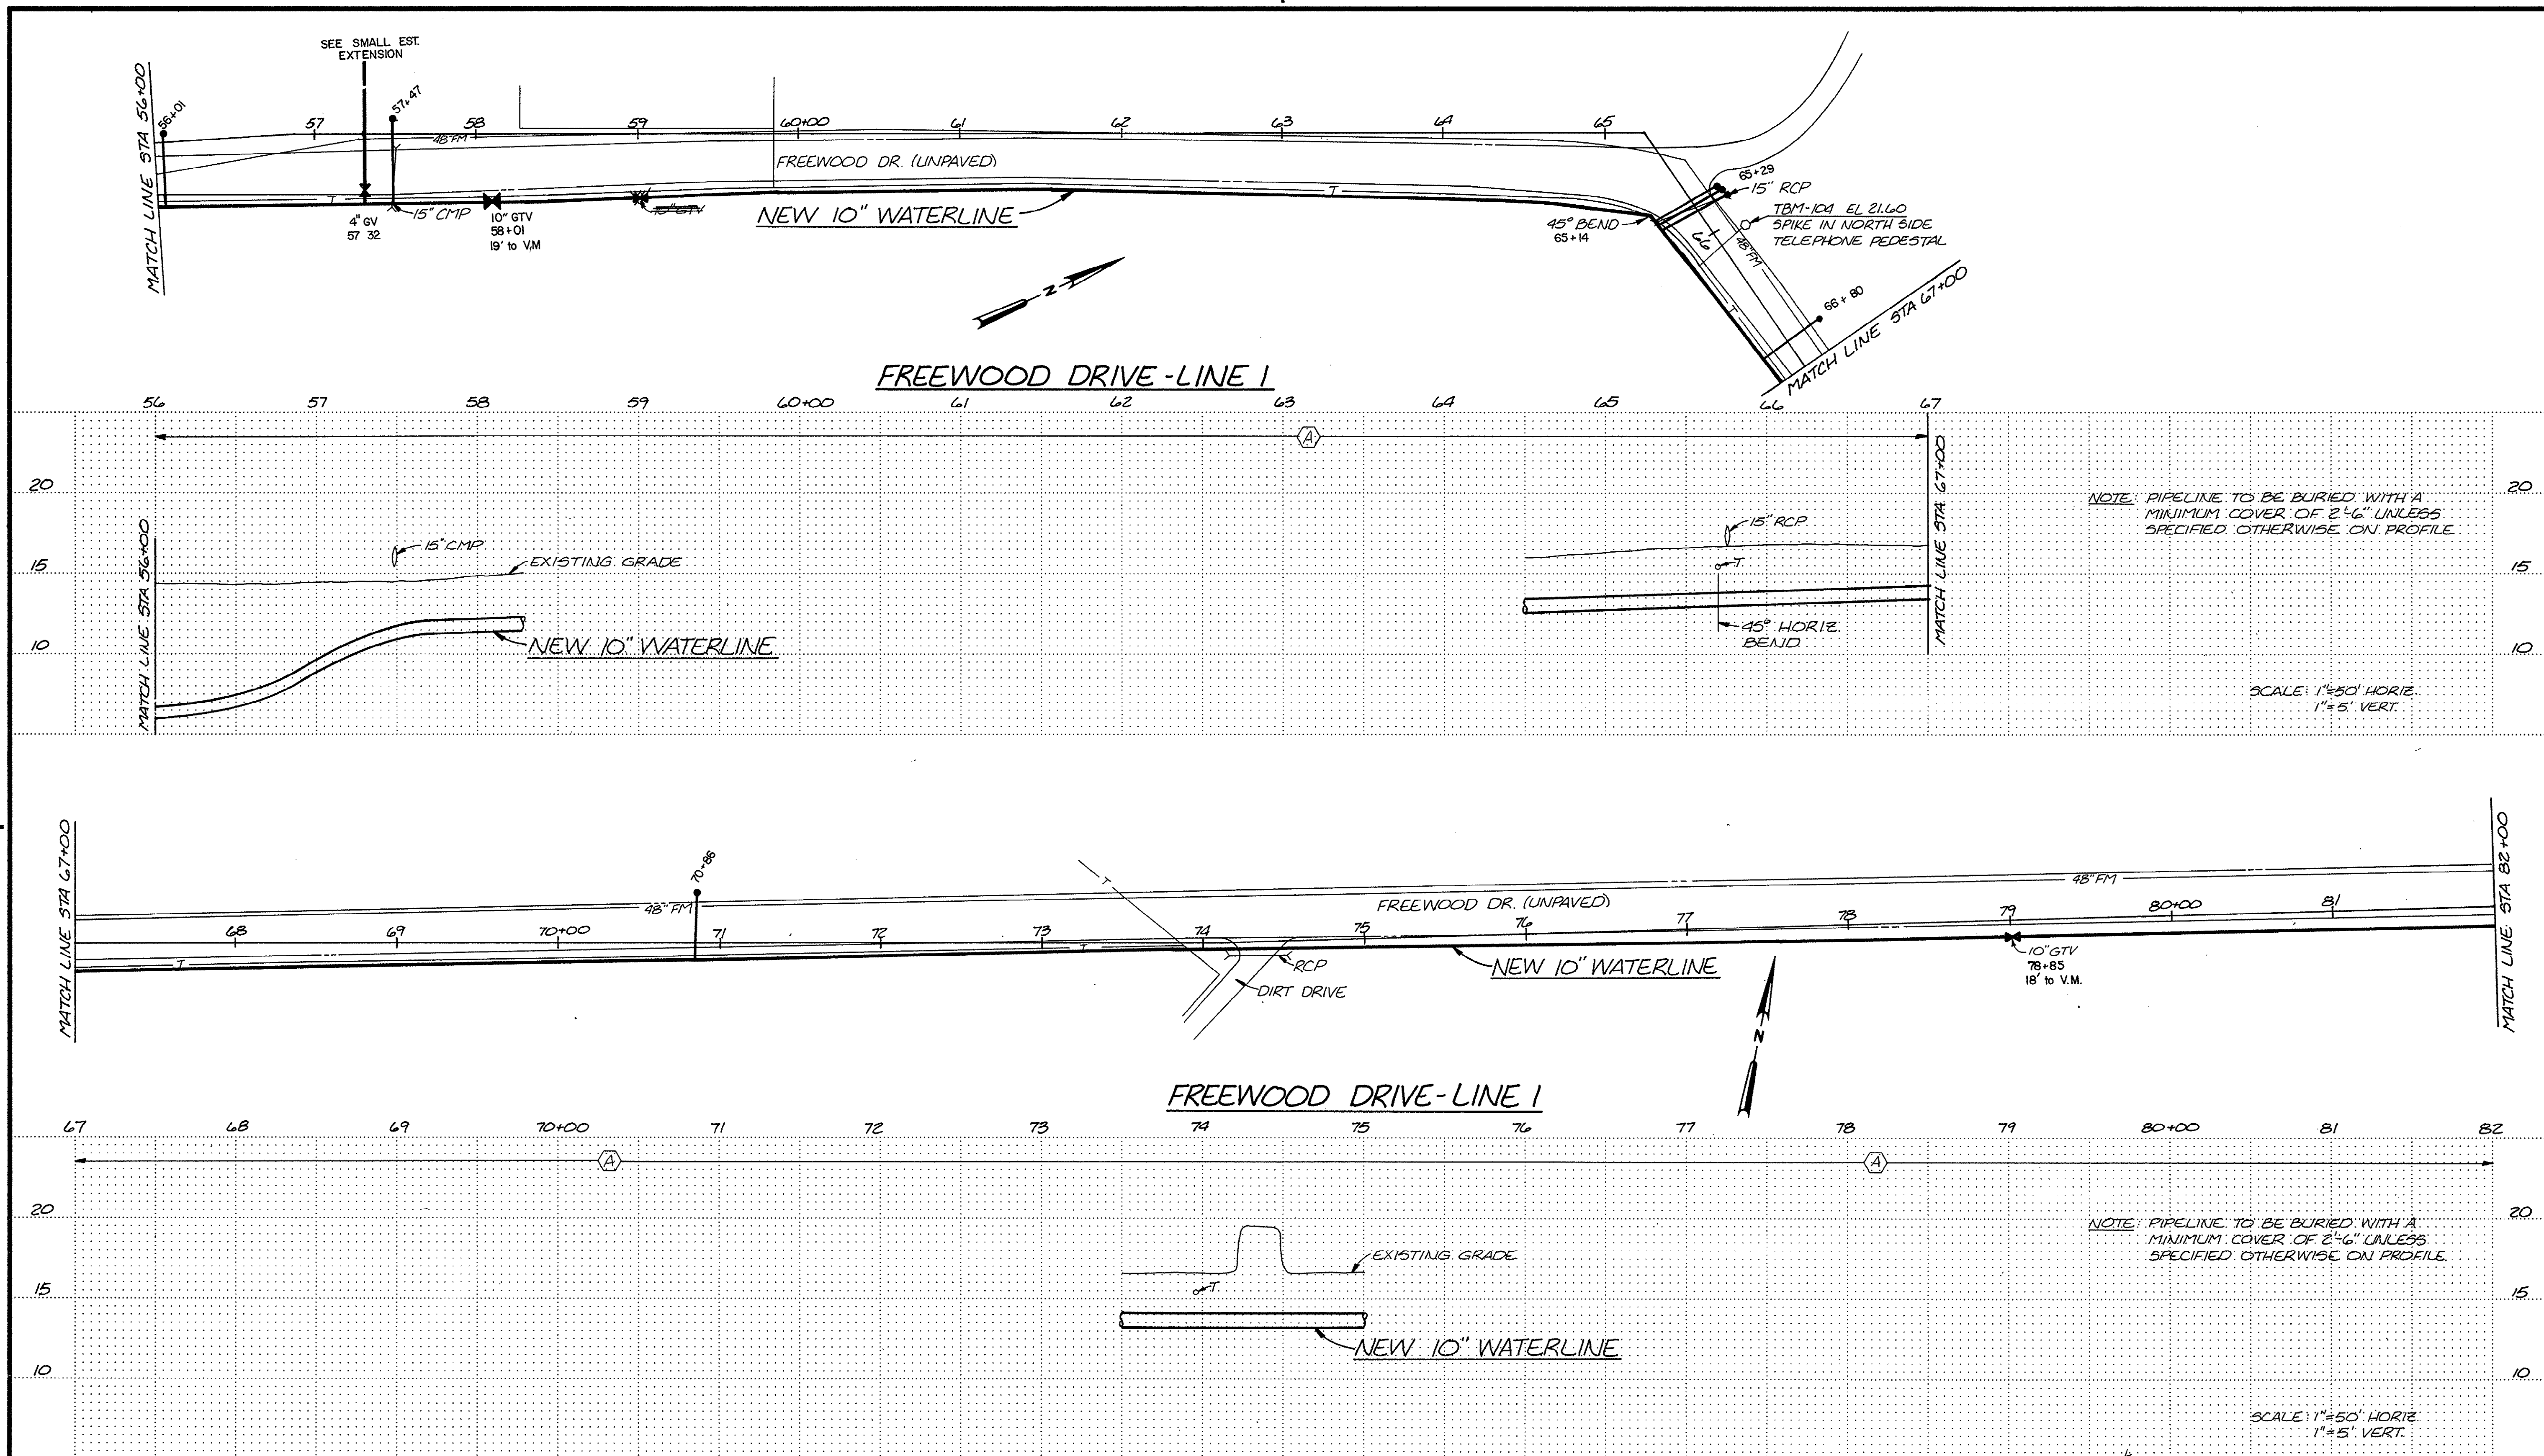

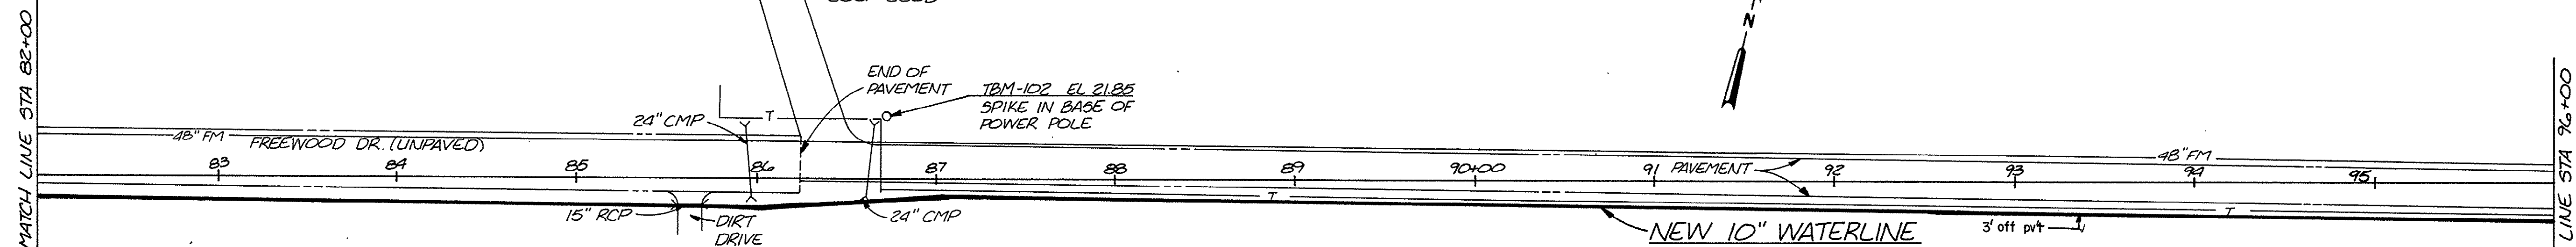


FREWOOD DRIVE - LINE 1

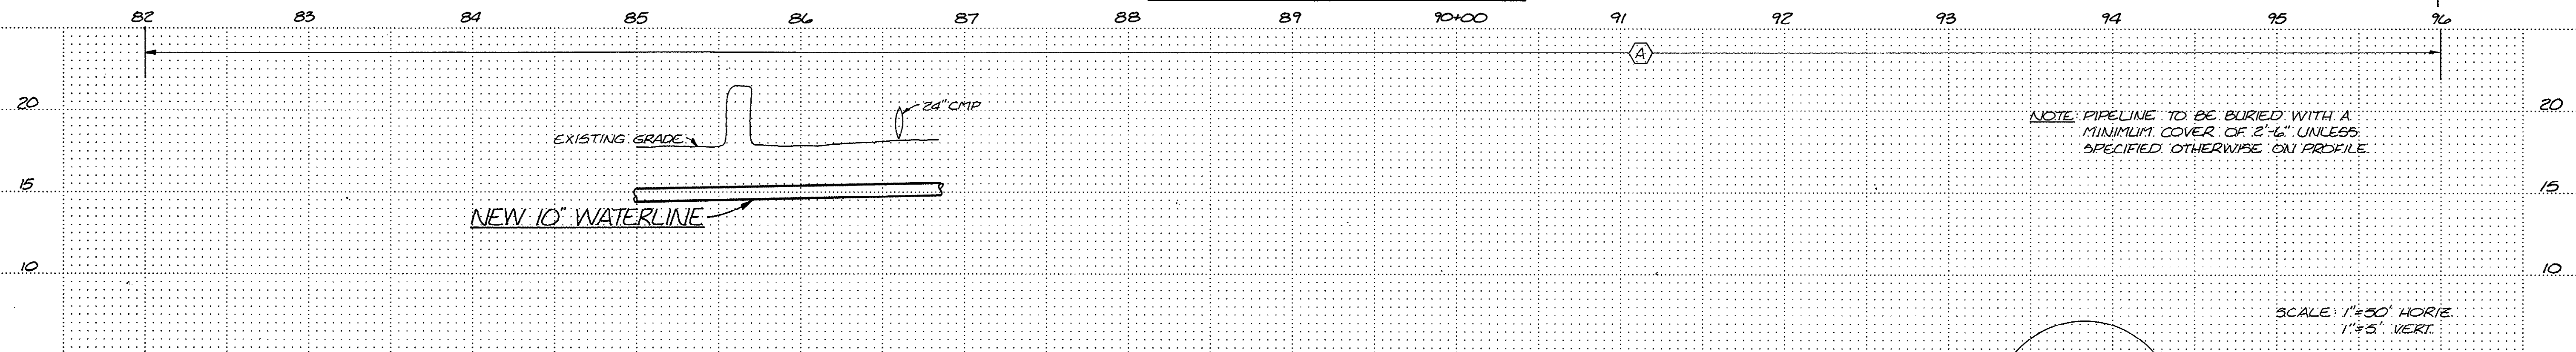


NOTE: PIPELINE TO BE BURIED WITH A MINIMUM COVER OF 2'-6\"/>

SCALE: 1\"/>

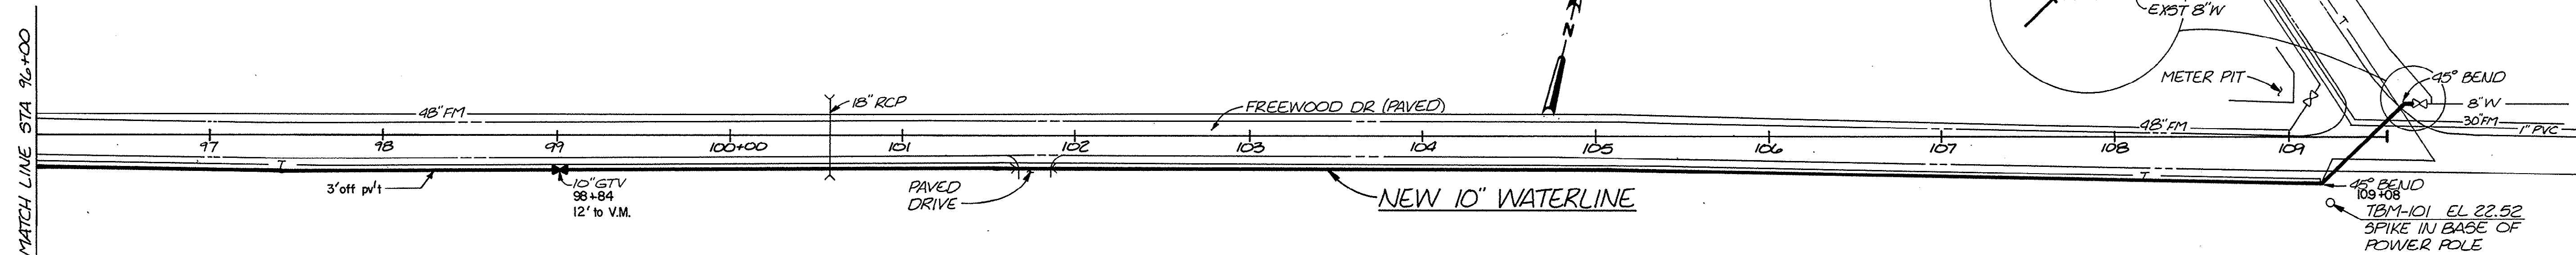


FREWOOD DRIVE - LINE 1

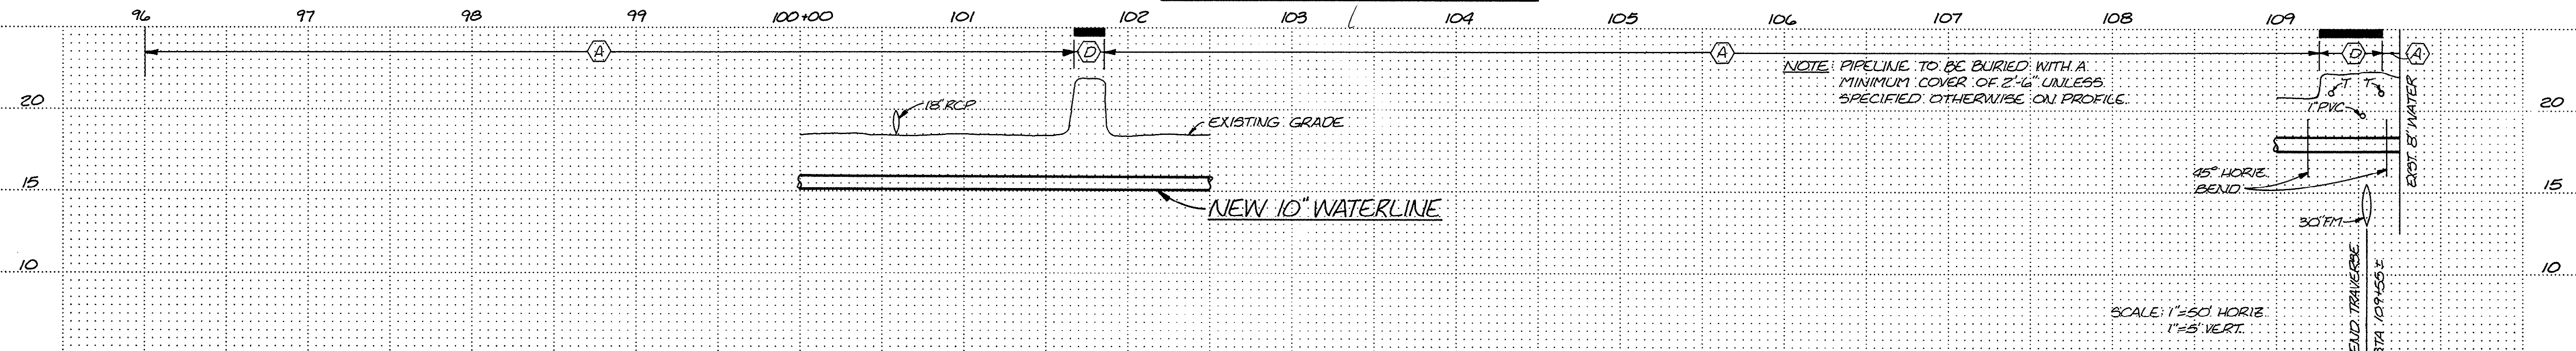

RECORD DRAWING
FEB 10 1986 *FK*

Fixed Assets
3-26-86 *DK*
14-11-007/17-W

NOTE: INSTALL SERVICE CONNECTIONS PER WATER SERVICE AND METER BOX DETAILS. SERVICE CONNECTIONS AND METER BOXES TO BE FIELD-LOCATED BY OWNER.

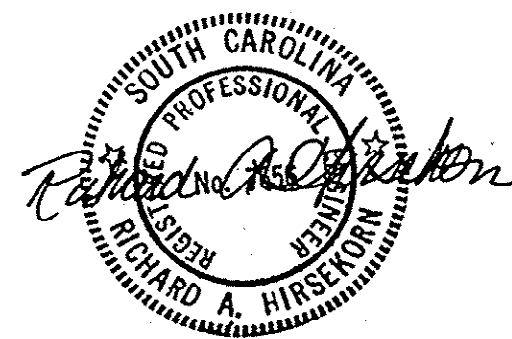

CH2M HILL	DESIGN	T. SMALLWOOD	NO.	DATE	REVISION	BY	APVD
	DR.	M. HALES					
	CHK.	C. CRANDALL					
	APVD	R. HIRSEKORN					





REUSE OF DOCUMENTS
THIS DOCUMENT, AND THE IDEAS AND DESIGNS INCORPORATED HEREIN, AS AN INSTRUMENT OF PROFESSIONAL SERVICE, IS THE PROPERTY OF CH2M HILL AND IS NOT TO BE USED, IN WHOLE OR IN PART, FOR ANY OTHER PROJECT WITHOUT THE WRITTEN AUTHORIZATION OF CH2M HILL.

VERIFY SCALES
BAR IS ONE INCH ON ORIGINAL DRAWING.
0 1"
IF NOT ONE INCH ON THIS SHEET, ADJUST SCALES ACCORDINGLY.

WATER SYSTEM IMPROVEMENTS
BURGESS COMMUNITY
GRAND STRAND WATER & SEWER AUTHORITY

LINE 1 - PLAN AND PROFILE
10\"/>

SHEET	7
OF	17
DATE	FEB 1986
PROJ. NO.	SA17940.A1

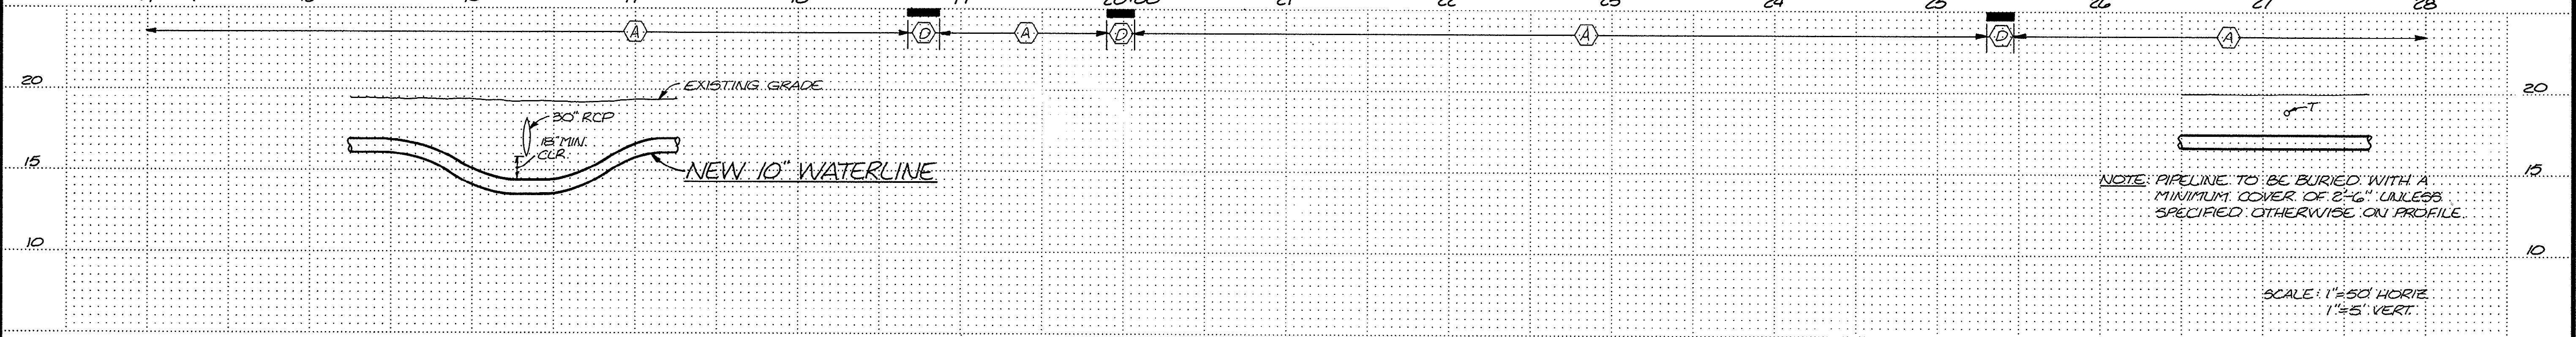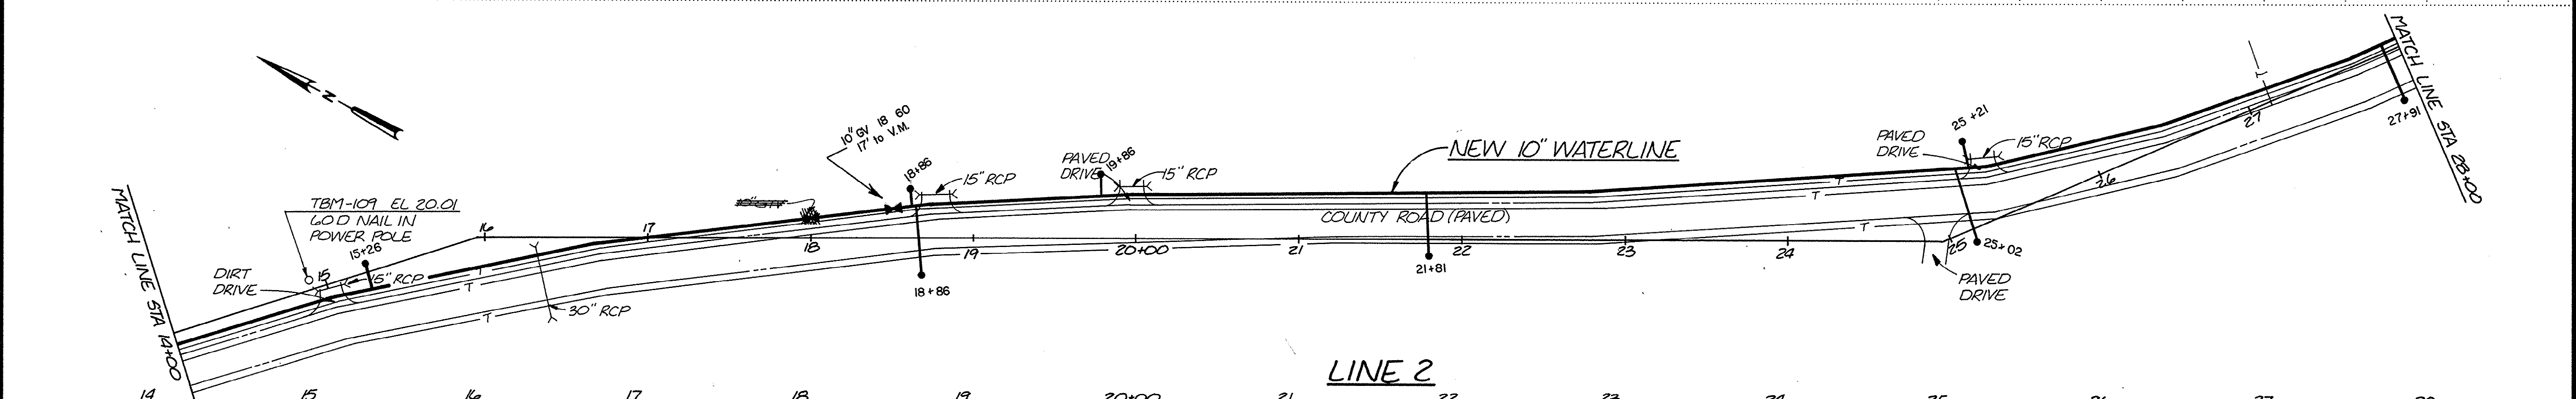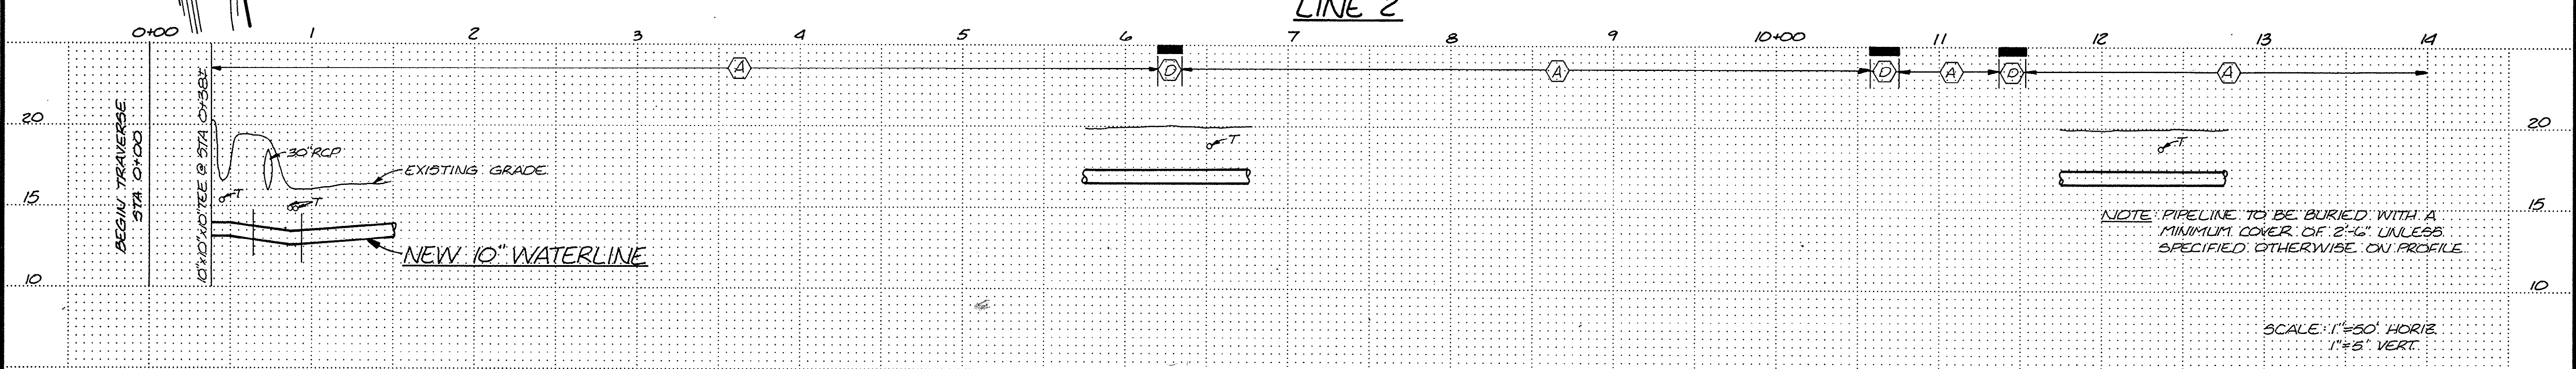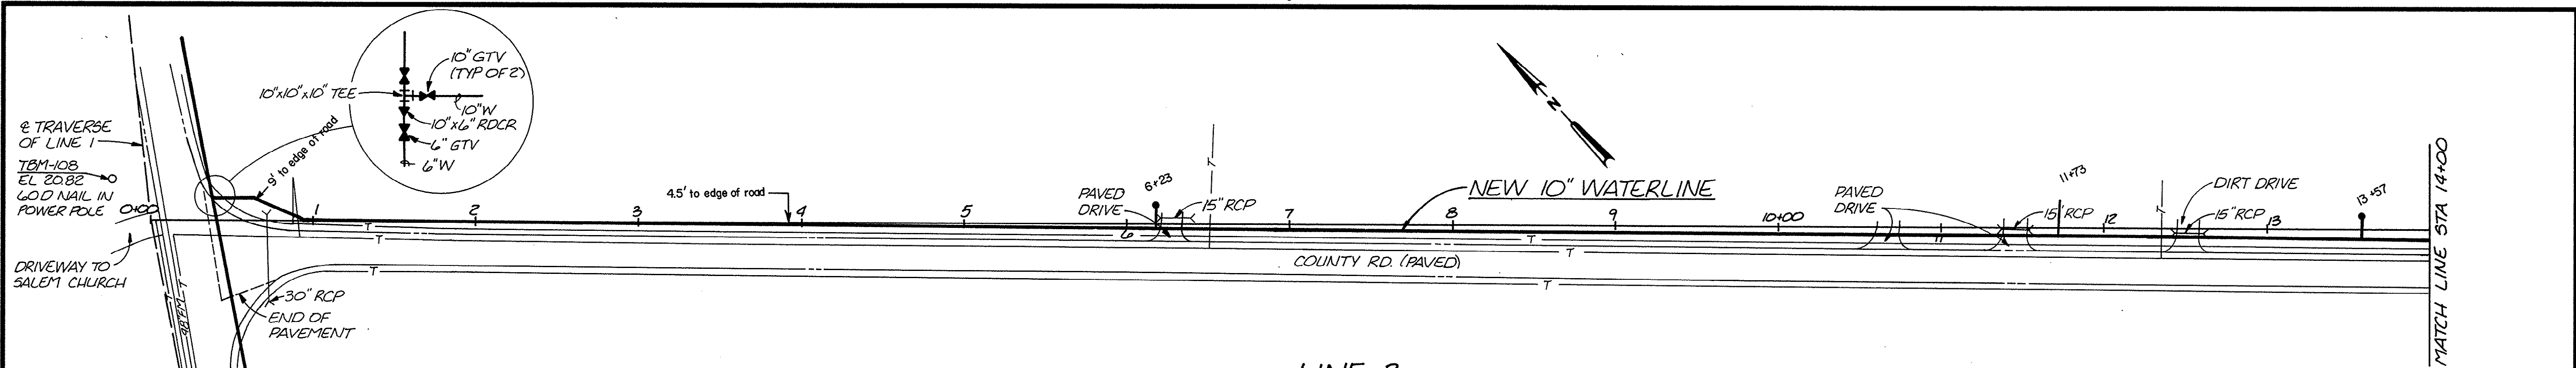

CH2M HILL

DESIGN: T. SMALLWOOD
 DR: M. HALES
 CHK: C. CRANDALL
 APVD: R. HIRSEKORN

NO.	DATE	REVISION	BY	APVD

REUSE OF DOCUMENTS

THIS DOCUMENT, AND THE IDEAS AND DESIGNS INCORPORATED HEREIN, AS AN INSTRUMENT OF PROFESSIONAL SERVICE, IS THE PROPERTY OF CH2M HILL AND IS NOT TO BE USED, IN WHOLE OR IN PART, FOR ANY OTHER PROJECT WITHOUT THE WRITTEN AUTHORIZATION OF CH2M HILL.

CH2M HILL, INC.

VERIFY SCALES

BAR IS ONE INCH ON ORIGINAL DRAWING.

IF NOT ONE INCH ON THIS SHEET, ADJUST SCALES ACCORDINGLY.

WATER SYSTEM IMPROVEMENTS

BURGESS COMMUNITY

GRAND STRAND WATER & SEWER AUTHORITY

fixed assets
 3-20-1985

14-11-008/17-W

NOTE: INSTALL SERVICE CONNECTIONS PER WATER SERVICE AND METER BOX DETAILS. SERVICE CONNECTIONS AND METER BOXES TO BE FIELD-LOCATED BY OWNER.

LINE 2 - PLAN AND PROFILE

10" WATERLINE

STA 0+00 TO STA 28+00

SHEET 8

OF 17

DATE FEB 1985

PROJ. NO. SA17940.41

OVERLAY IDENTIFICATION | COMPOSITE | OVERLAY | SCREEN | CONTRACT



DSGN T. SMALLWOOD
DR M. HALES
CHK C. CRANDALL
APVD R. HIRSEKORN

NO. DATE

REVISION

BY APVD

REUSE OF DOCUMENTS

THIS DOCUMENT, AND THE IDEAS AND DESIGNS INCORPORATED HEREIN, AS AN INSTRUMENT OF PROFESSIONAL SERVICE, IS THE PROPERTY OF CH2M HILL AND IS NOT TO BE USED, IN WHOLE OR IN PART, FOR ANY OTHER PROJECT WITHOUT THE WRITTEN AUTHORIZATION OF CH2M HILL.

©CH2M HILL, INC.

VERIFY SCALES


BAR IS ONE INCH ON ORIGINAL DRAWING.
0 1"
IF NOT ONE INCH ON THIS SHEET, ADJUST SCALES ACCORDINGLY.

WATER SYSTEM IMPROVEMENTS

BURGESS COMMUNITY
GRAND STRAND WATER & SEWER AUTHORITY

LINE 2 - PLAN AND PROFILE
10" WATERLINE
STA 28+00 TO STA 56+00

SHEET 9
OF 17
DATE FEB 1986
PROJ NO. SA17940A1

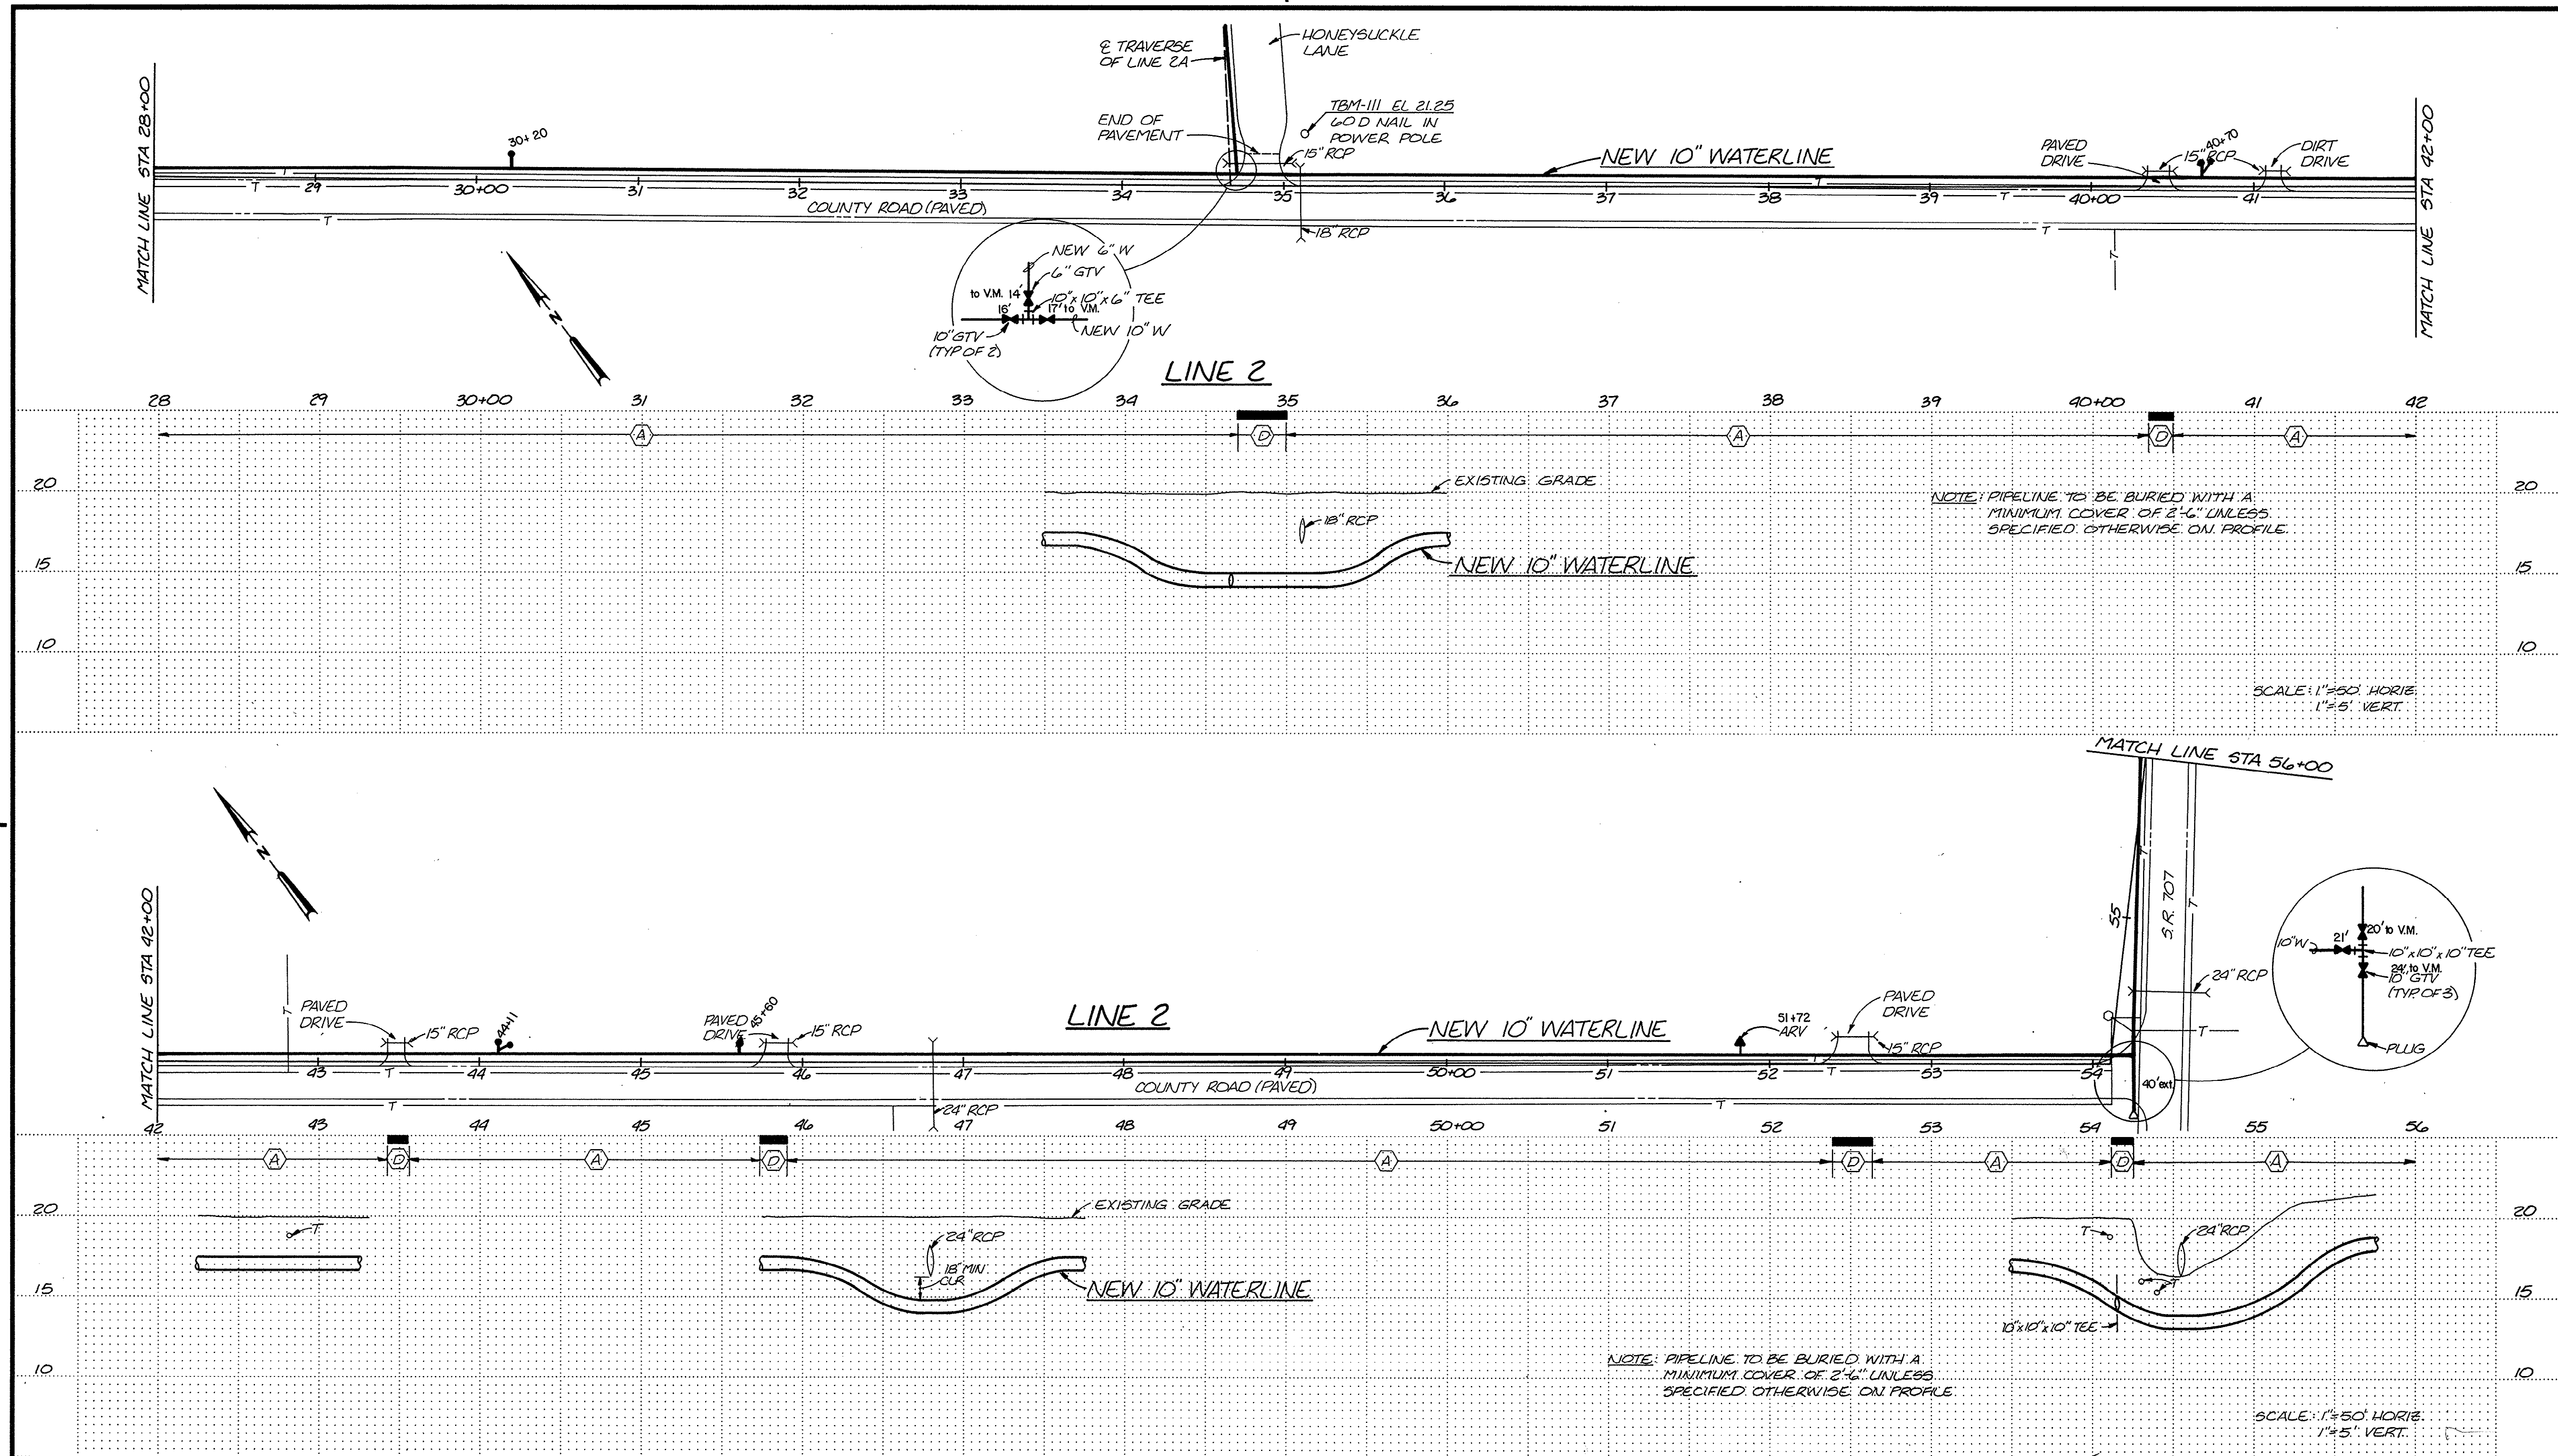


RECORD DRAWING
FEB 10 1986

Fixed Access
3-28-86 RCH

14-10-009/17-W

COMPOSITE
OVERLAY
SCREEN
CONTRACT

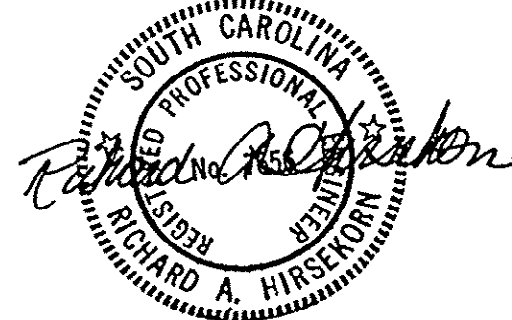

CH2M HILL
DSGN T. SMALLWOOD
DR M. HALES
CHK C. CRANDALL
APVD R. HIRSEKORN

NO. DATE REVISION

BY APVD


REUSE OF DOCUMENTS
THIS DOCUMENT, AND THE IDEAS AND DESIGNS INCORPORATED HEREIN, AS AN INSTRUMENT OF PROFESSIONAL SERVICE, IS THE PROPERTY OF CH2M HILL AND IS NOT TO BE USED, IN WHOLE OR IN PART, FOR ANY OTHER PROJECT WITHOUT THE WRITTEN AUTHORIZATION OF CH2M HILL.

VERIFY SCALES
BAR IS ONE INCH ON ORIGINAL DRAWING.
IF NOT ONE INCH ON THIS SHEET, ADJUST SCALES ACCORDINGLY.

WATER SYSTEM IMPROVEMENTS
BURGESS COMMUNITY
GRAND STRAND WATER & SEWER AUTHORITY

LINE 2 - PLAN AND PROFILE
10" WATERLINE
STA 56+00 TO STA 84+00


SHEET 10
OF 17
DATE FEB 1985
PROJ. NO. SA17940A1

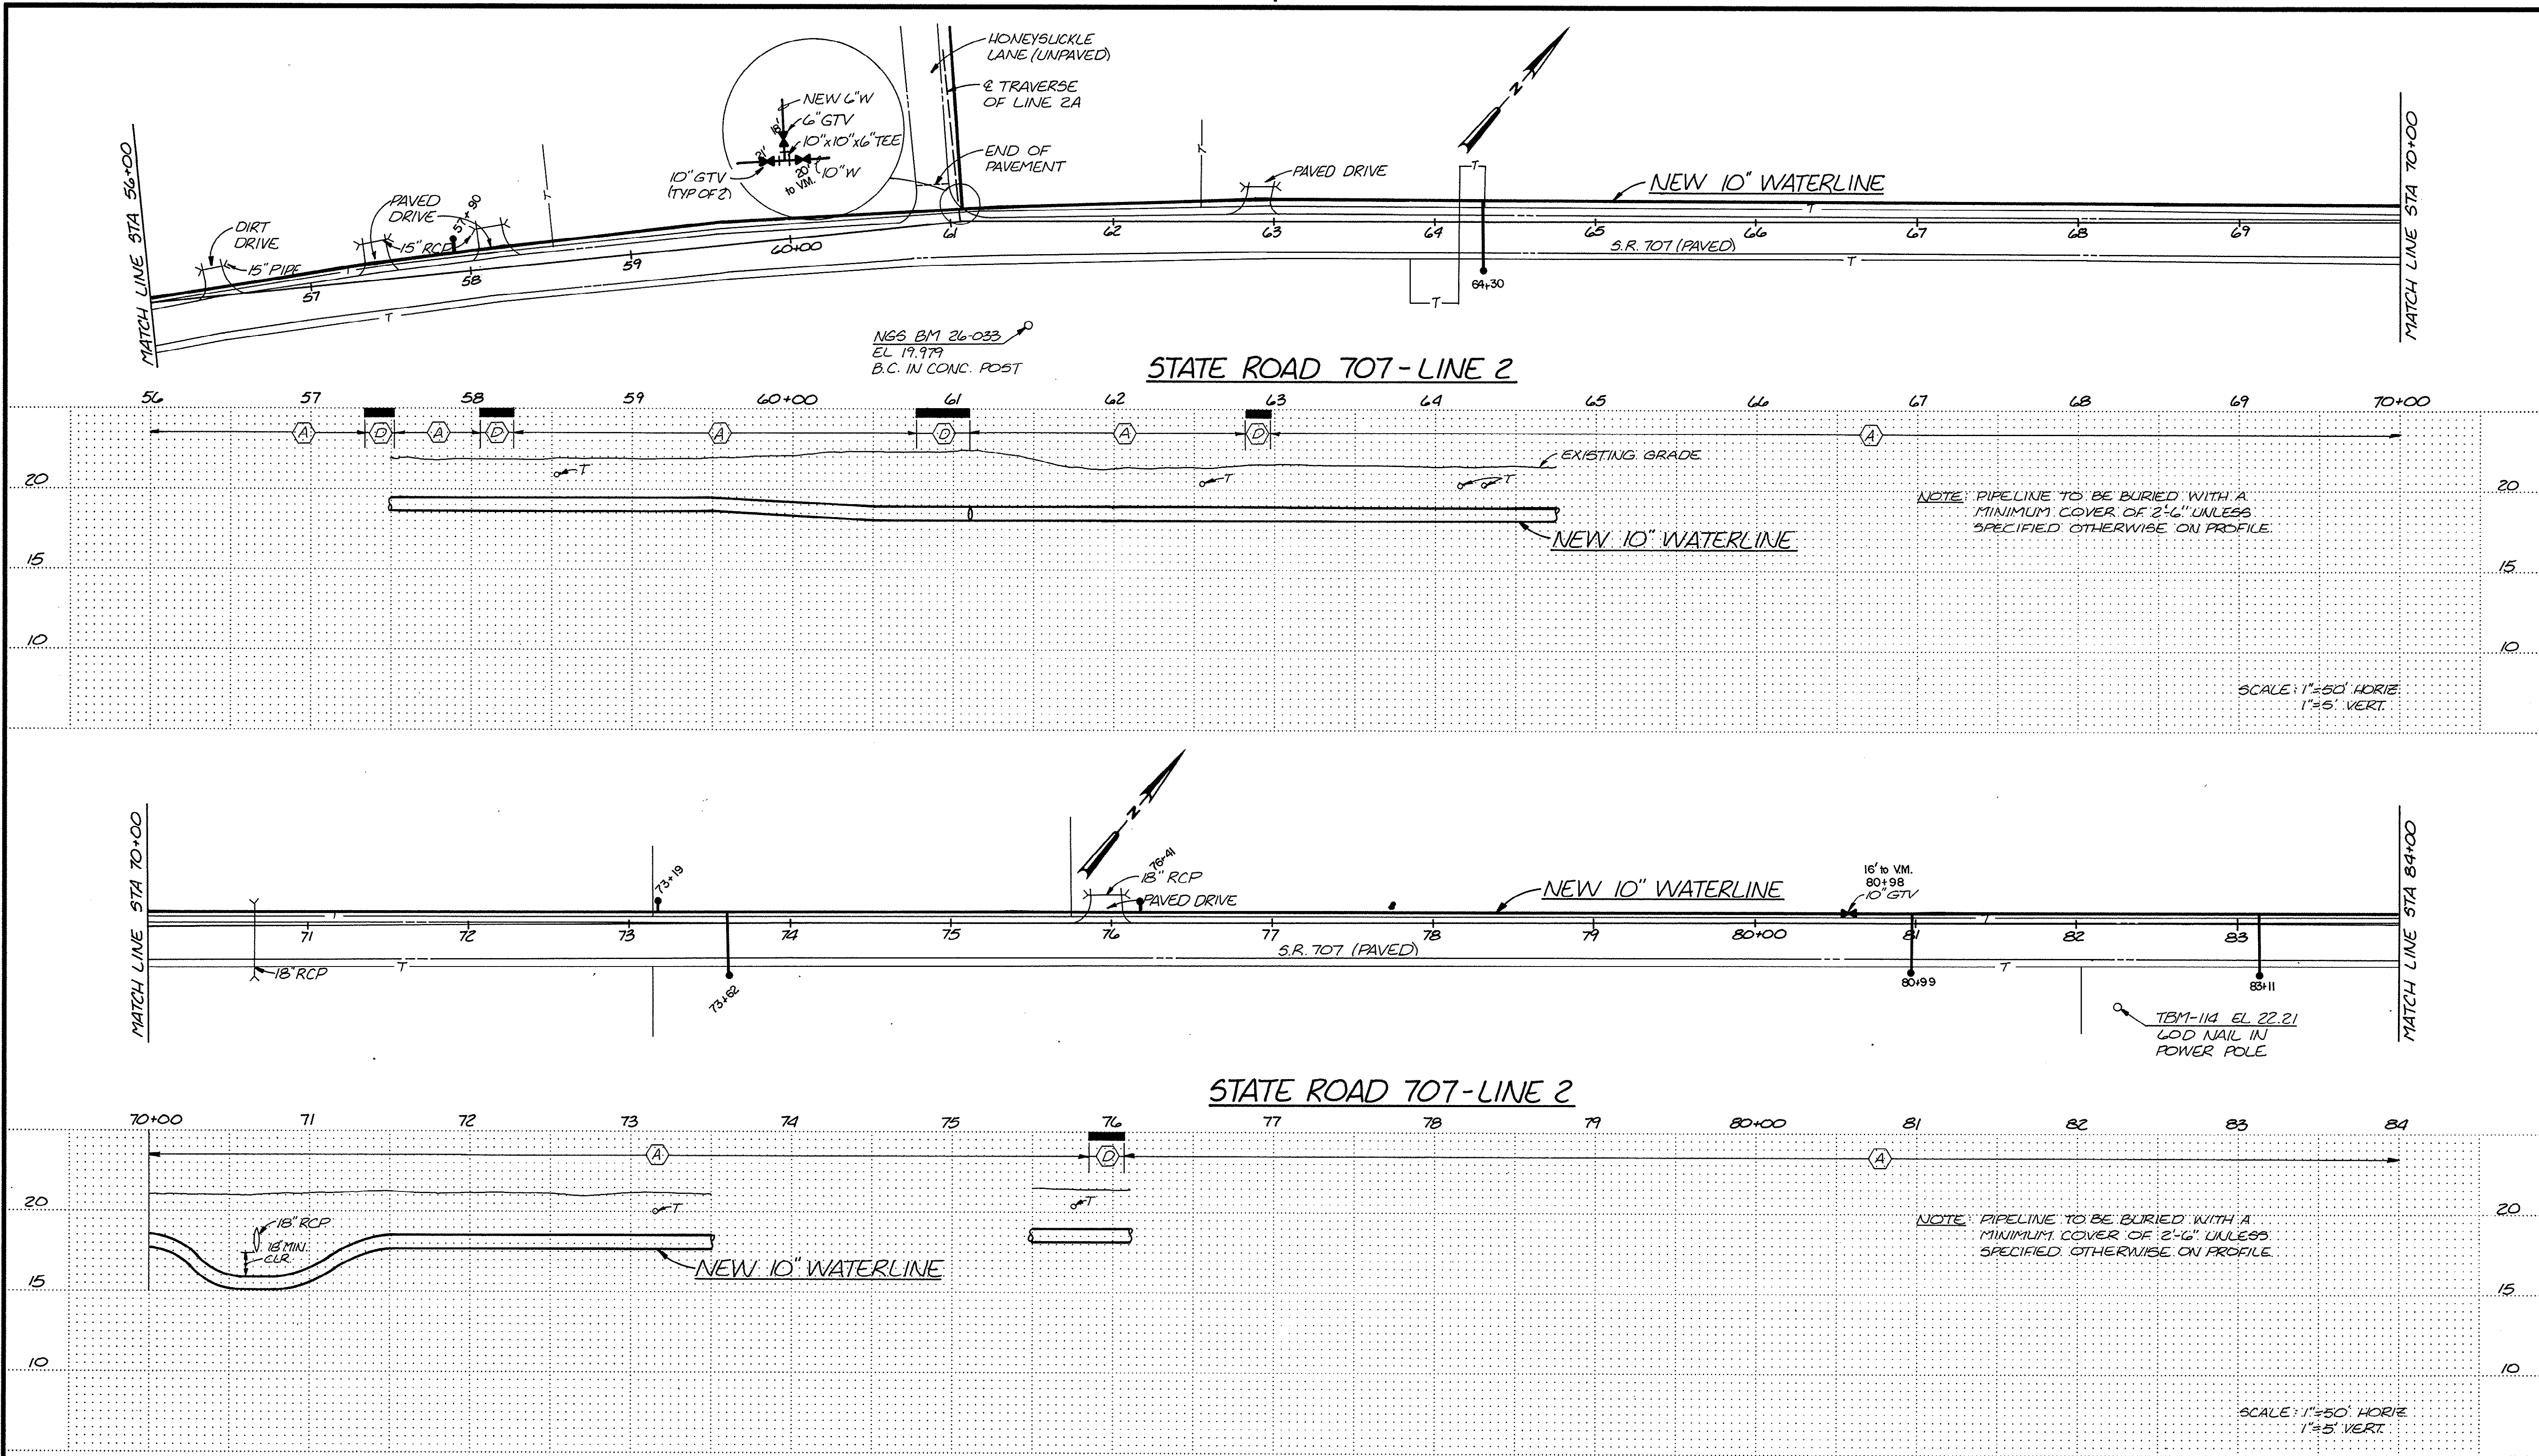



RECORD DRAWING
FEB 10 1986 FR

Fixed Assesd
3 10-17-85
14-11-010/17-W


NOTE: INSTALL SERVICE CONNECTIONS PER WATER SERVICE AND METER BOX DETAILS. SERVICE CONNECTIONS AND METER BOXES TO BE FIELD-LOCATED BY OWNER.

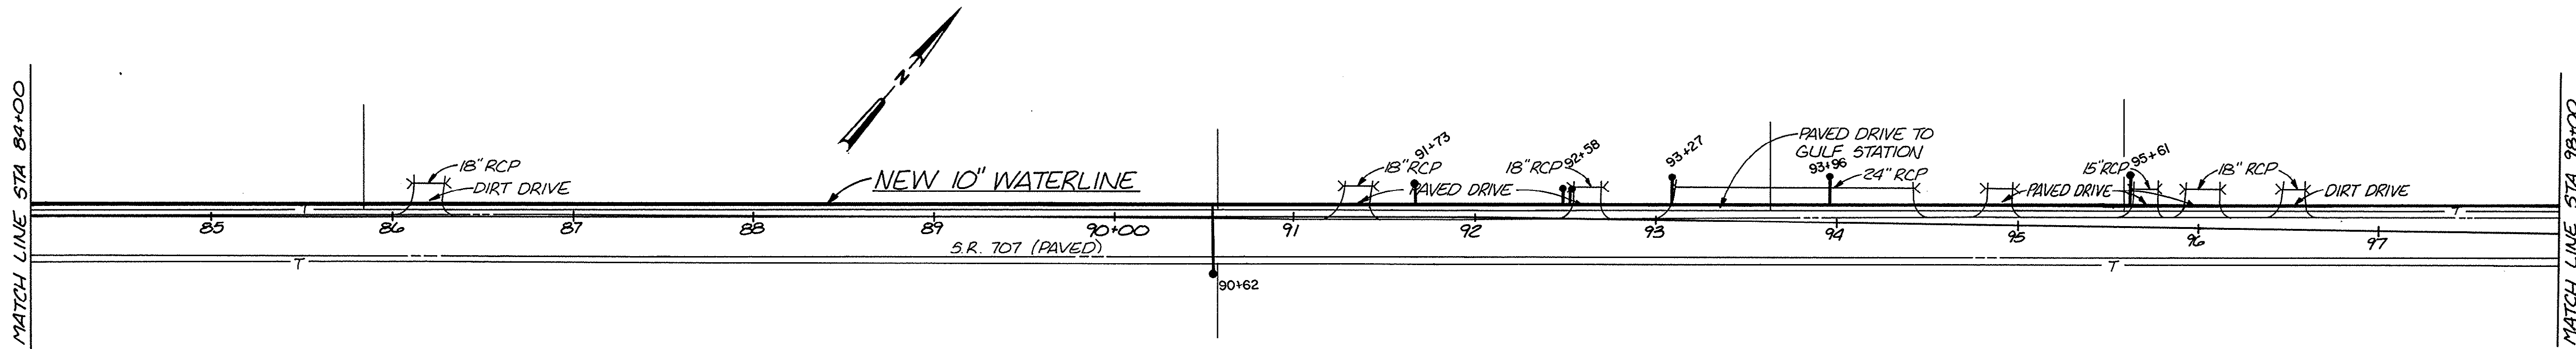

STATE ROAD 707-LINE 2

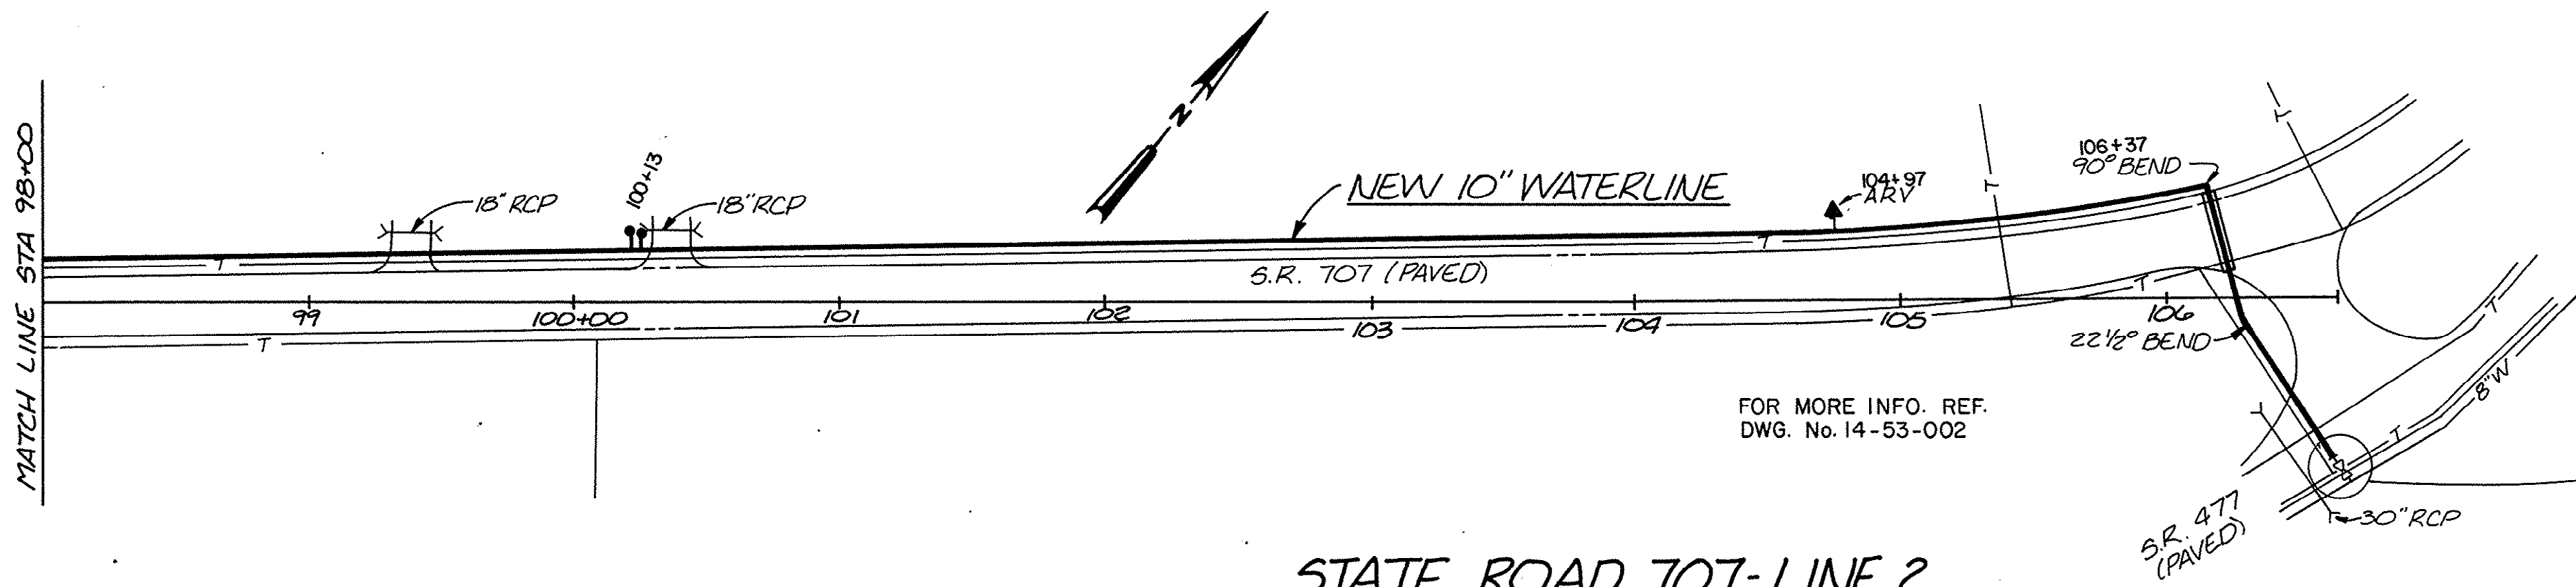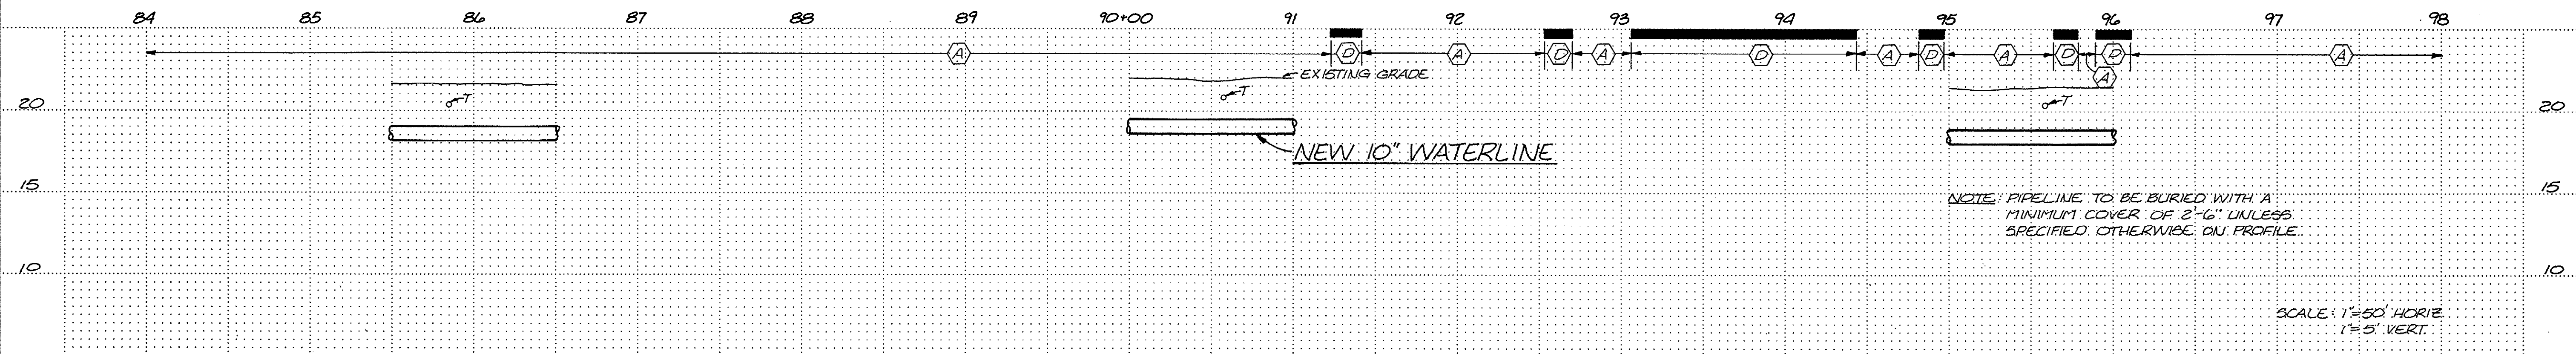

STATE ROAD 707-LINE 2

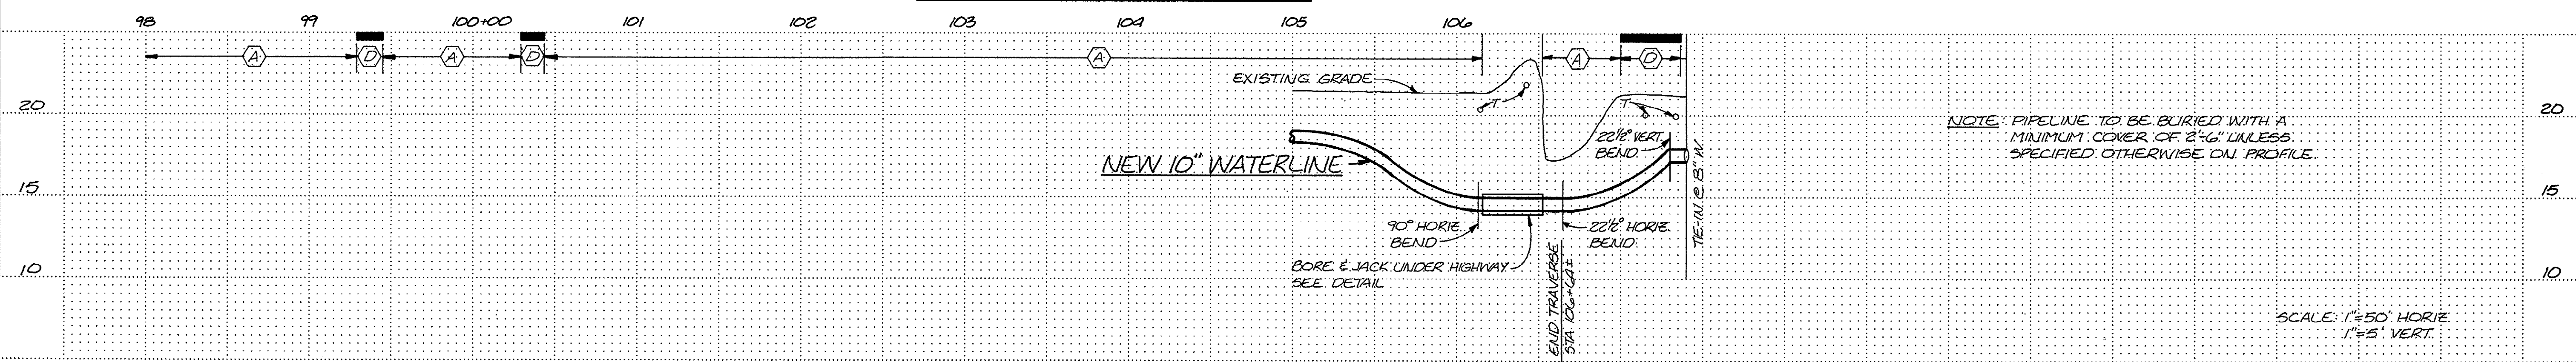

RECORD DRAWING
FEB 10 1986

FILED ASSESSED
3-25-86
14-11-011/17-W

NOTE: INSTALL SERVICE CONNECTIONS PER WATER SERVICE AND METER BOX DETAILS. SERVICE CONNECTIONS AND METER BOXES TO BE FIELD-LOCATED BY OWNER.



CH2M HILL	DSGN	I. SMALLWOOD	NO.	DATE	REVISION	BY	APVD
	DR	M. HALES					
	CHK	C. CRANDALL					
	APVD	R. HIRSEKORN					


REUSE OF DOCUMENTS
THIS DOCUMENT, AND THE IDEAS AND DESIGNS INCORPORATED HEREIN, AS AN INSTRUMENT OF PROFESSIONAL SERVICE, IS THE PROPERTY OF CH2M HILL AND IS NOT TO BE USED, IN WHOLE OR IN PART, FOR ANY OTHER PROJECT WITHOUT THE WRITTEN AUTHORIZATION OF CH2M HILL.

VERIFY SCALES
BAR IS ONE INCH ON ORIGINAL DRAWING.
IF NOT ONE INCH ON THIS SHEET, ADJUST SCALES ACCORDINGLY.



WATER SYSTEM IMPROVEMENTS
BURGESS COMMUNITY
GRAND STRAND WATER & SEWER AUTHORITY

LINE 2 - PLAN AND PROFILE
10" WATERLINE
STA 84+00 TO STA 106+64



SHEET	11
OF	17
DATE	FEB 1985
PROJ. NO.	SA17940A1

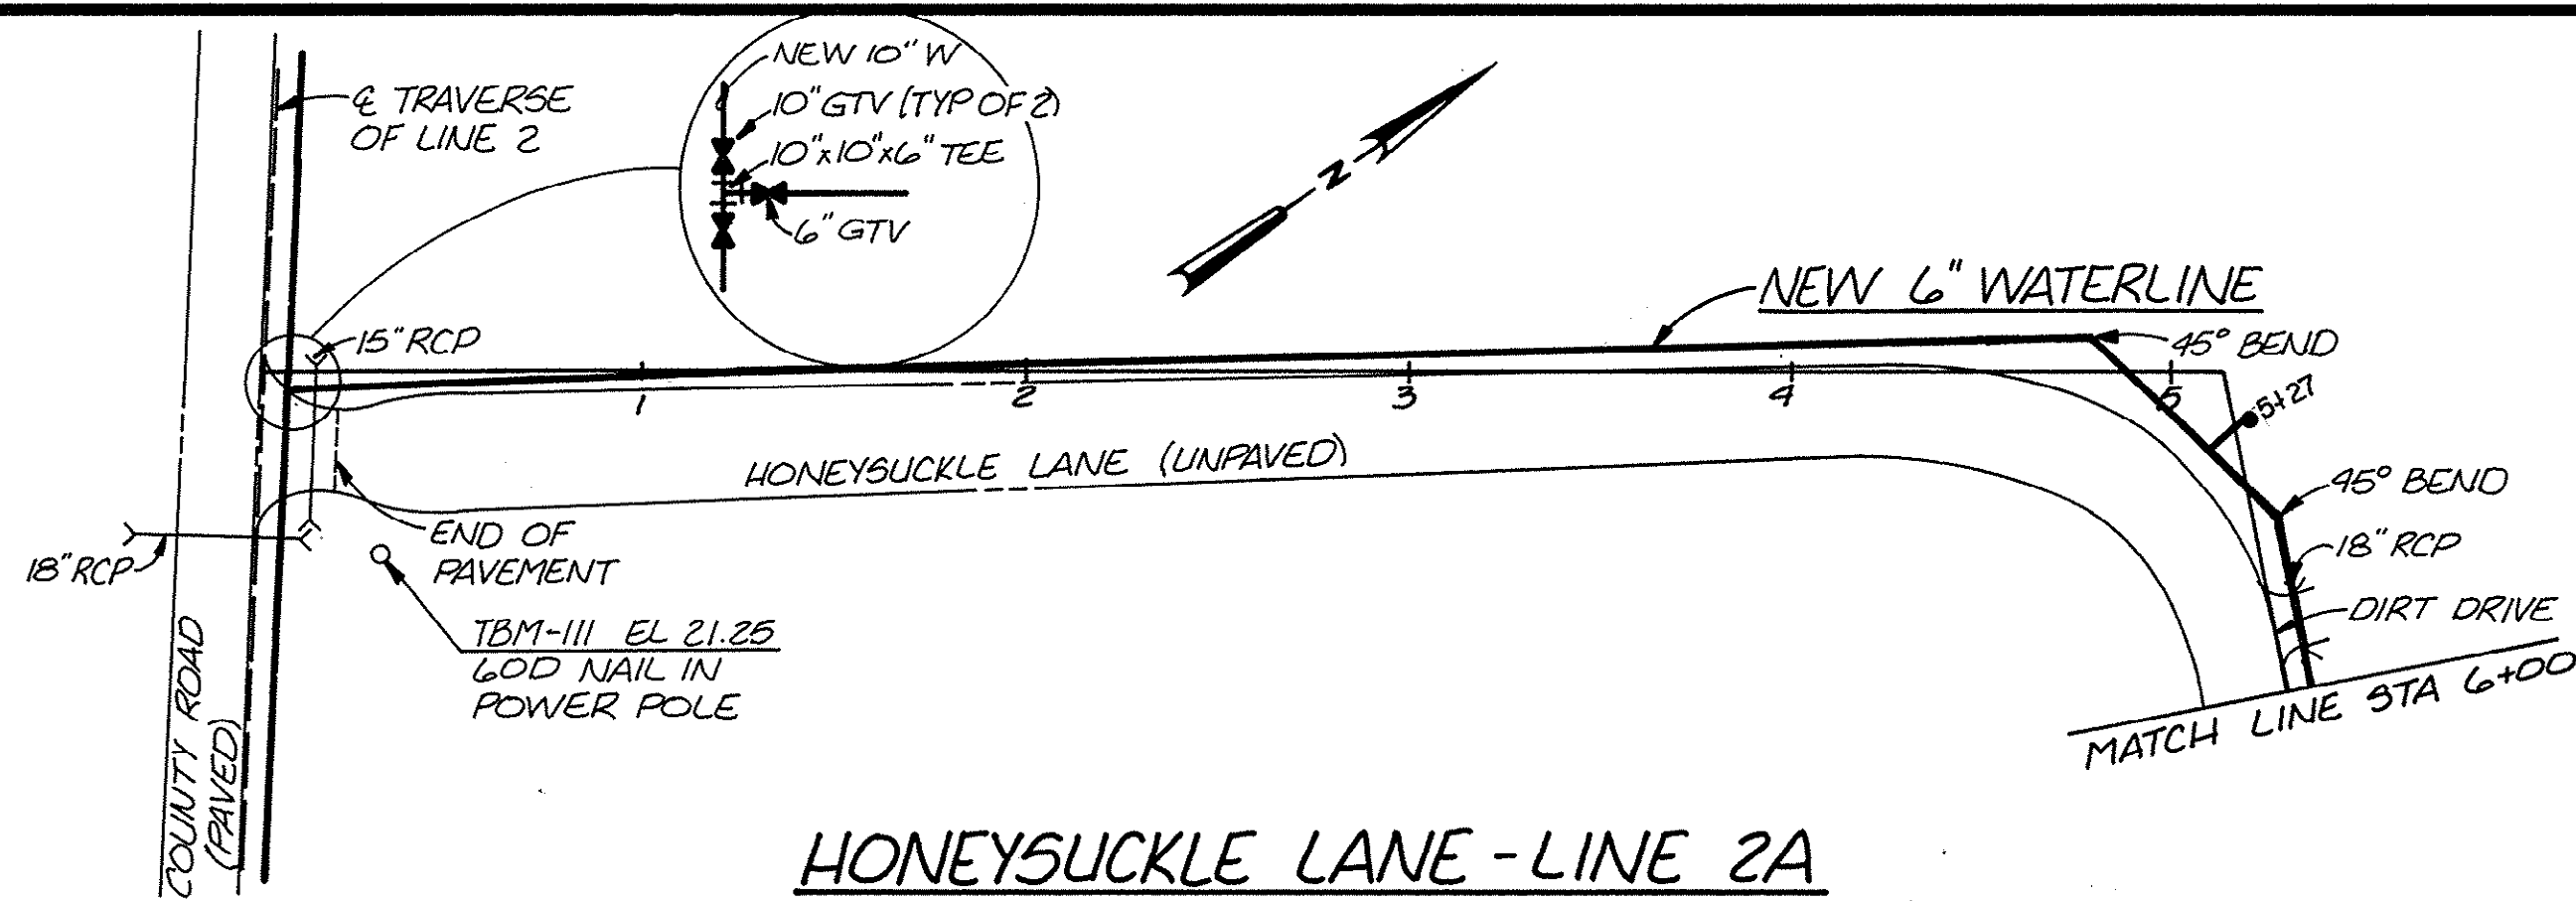


HONEYSUCKLE LANE - LINE 2A

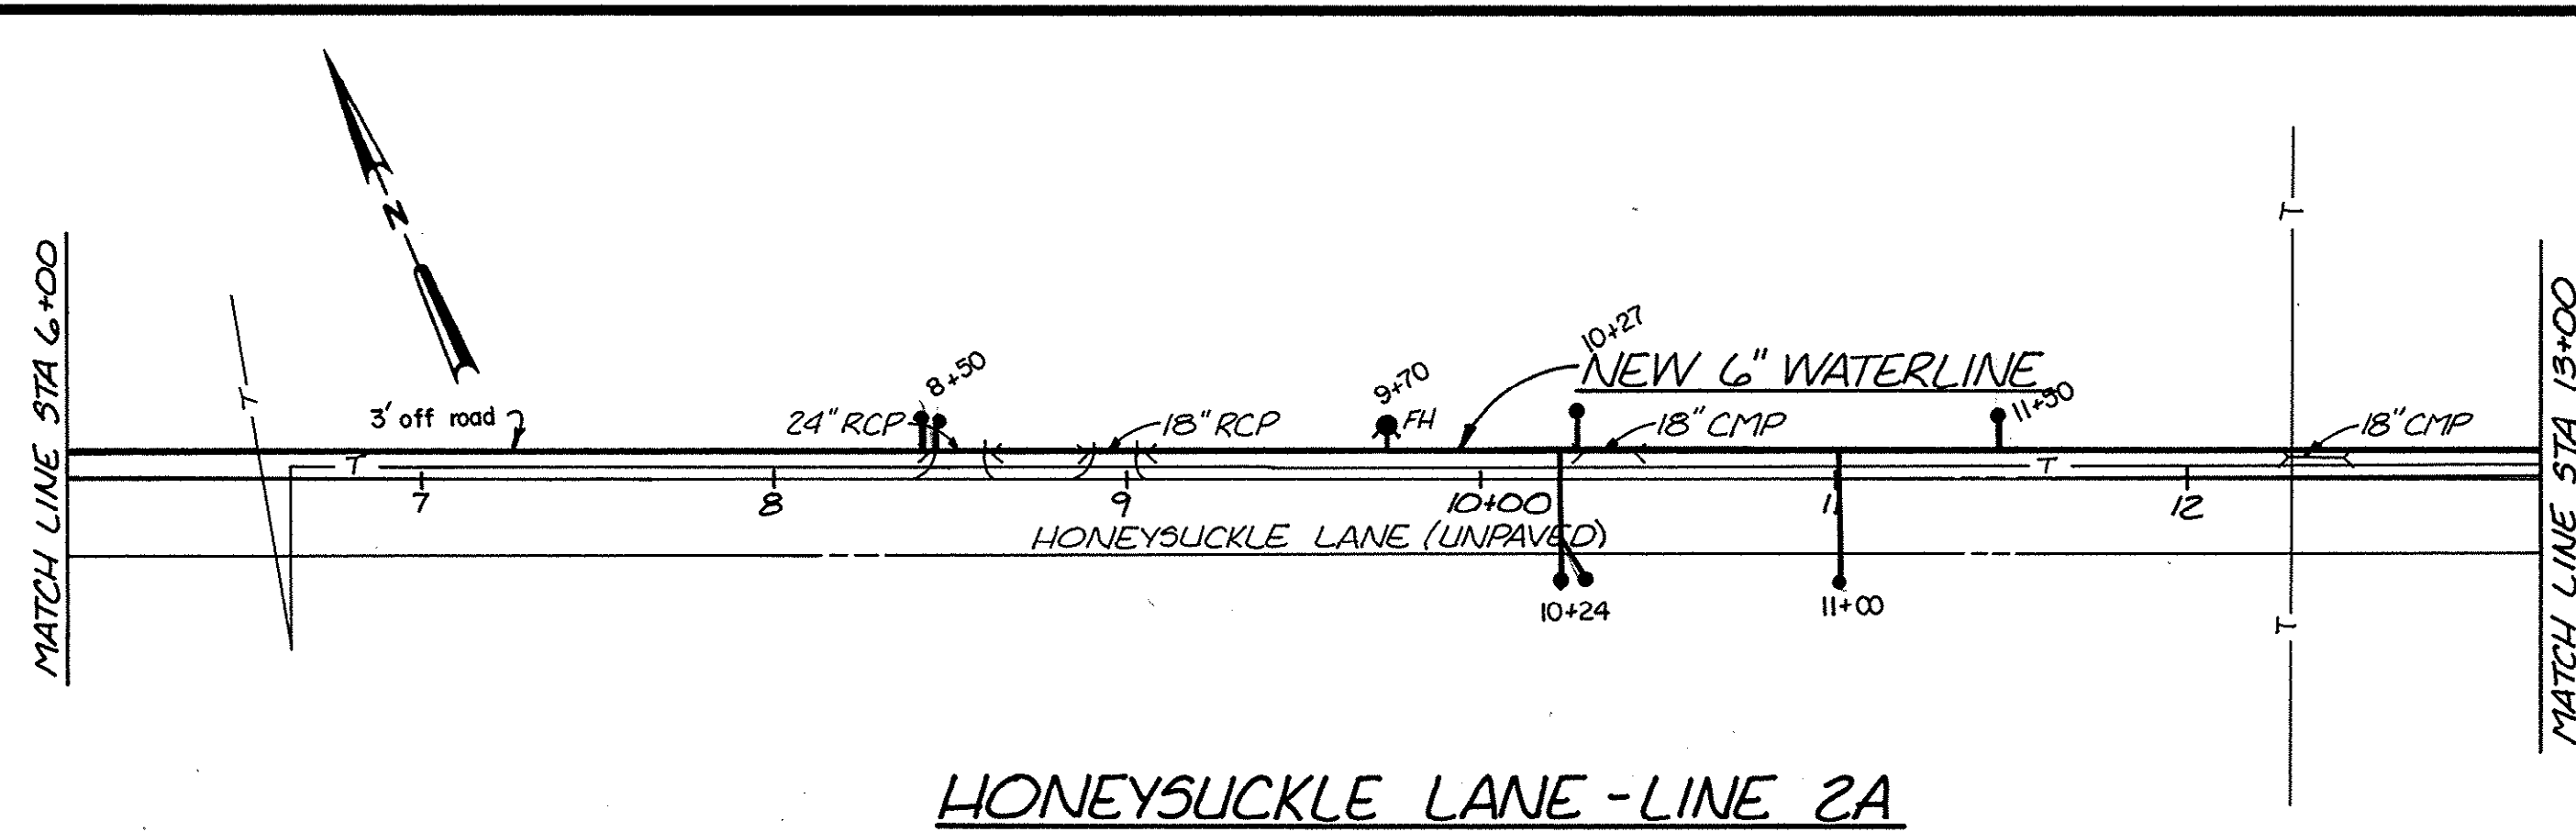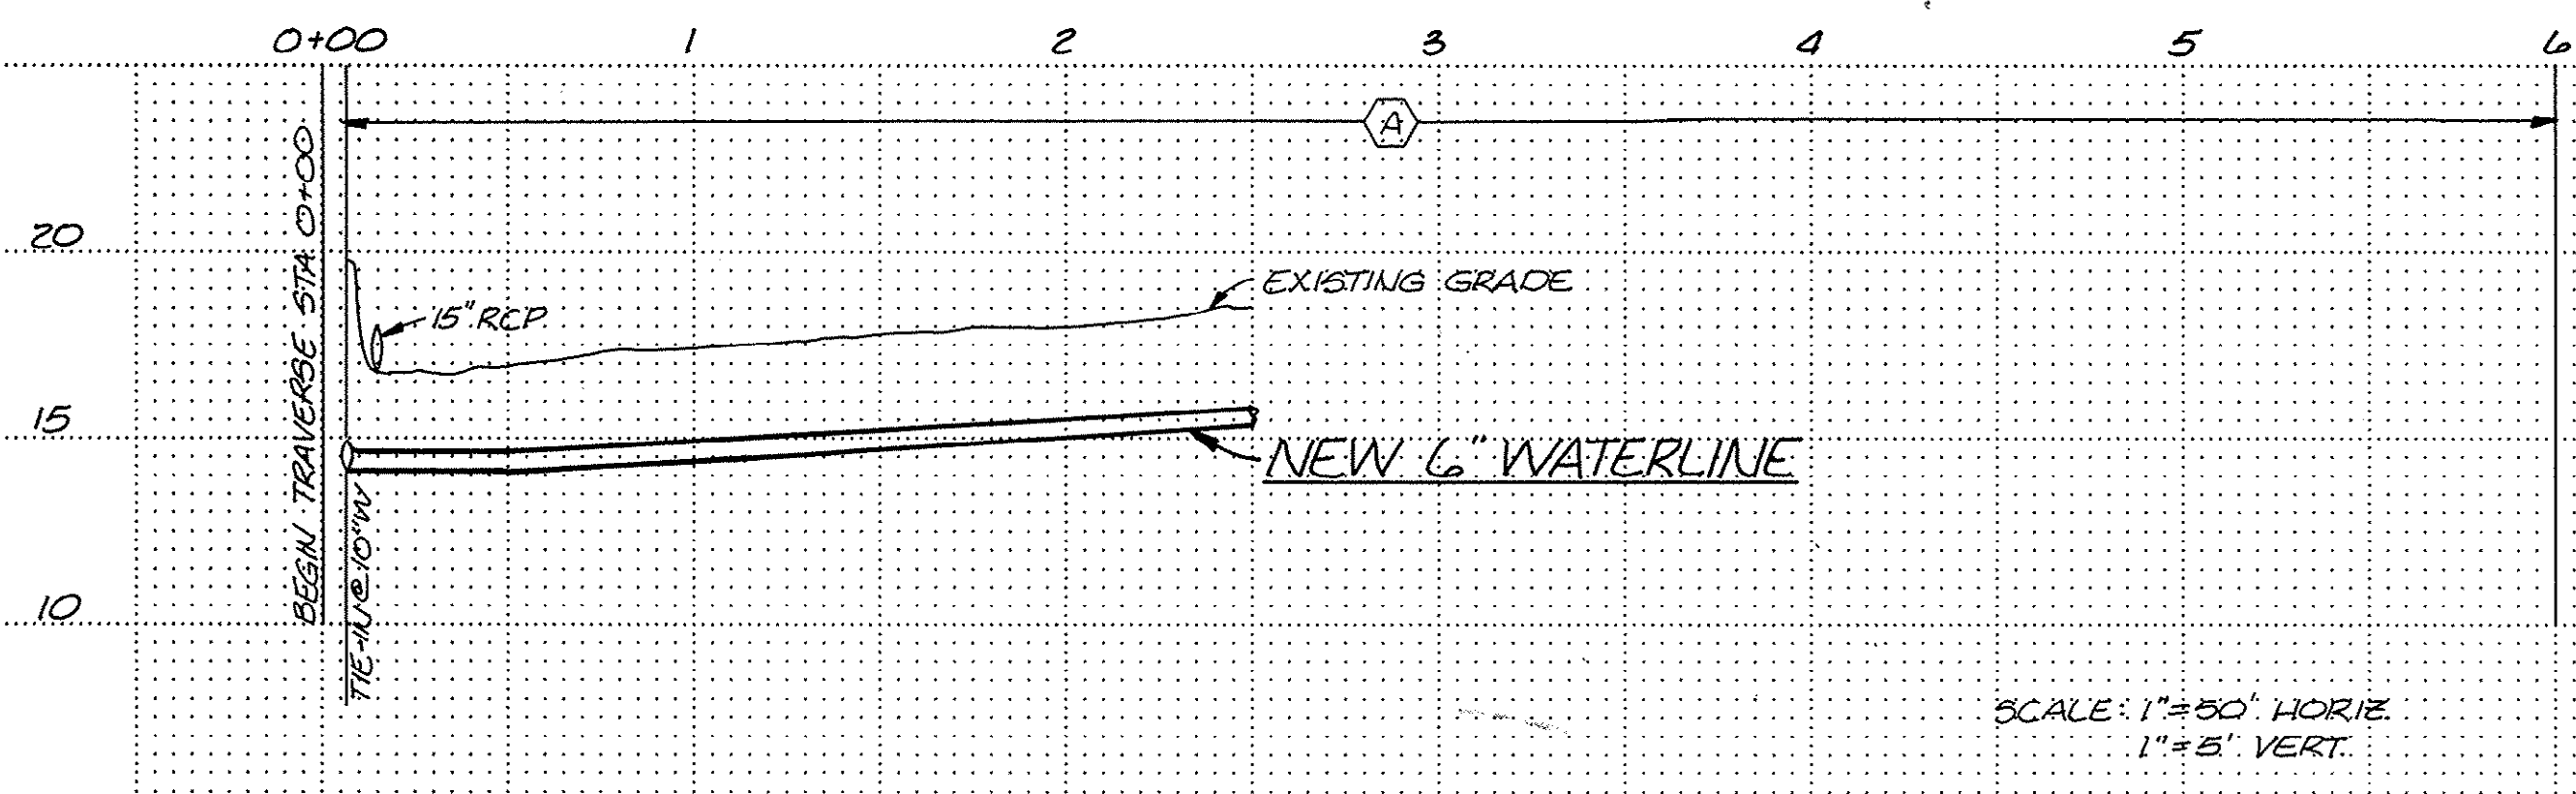

HONEYSUCKLE LANE - LINE 2A

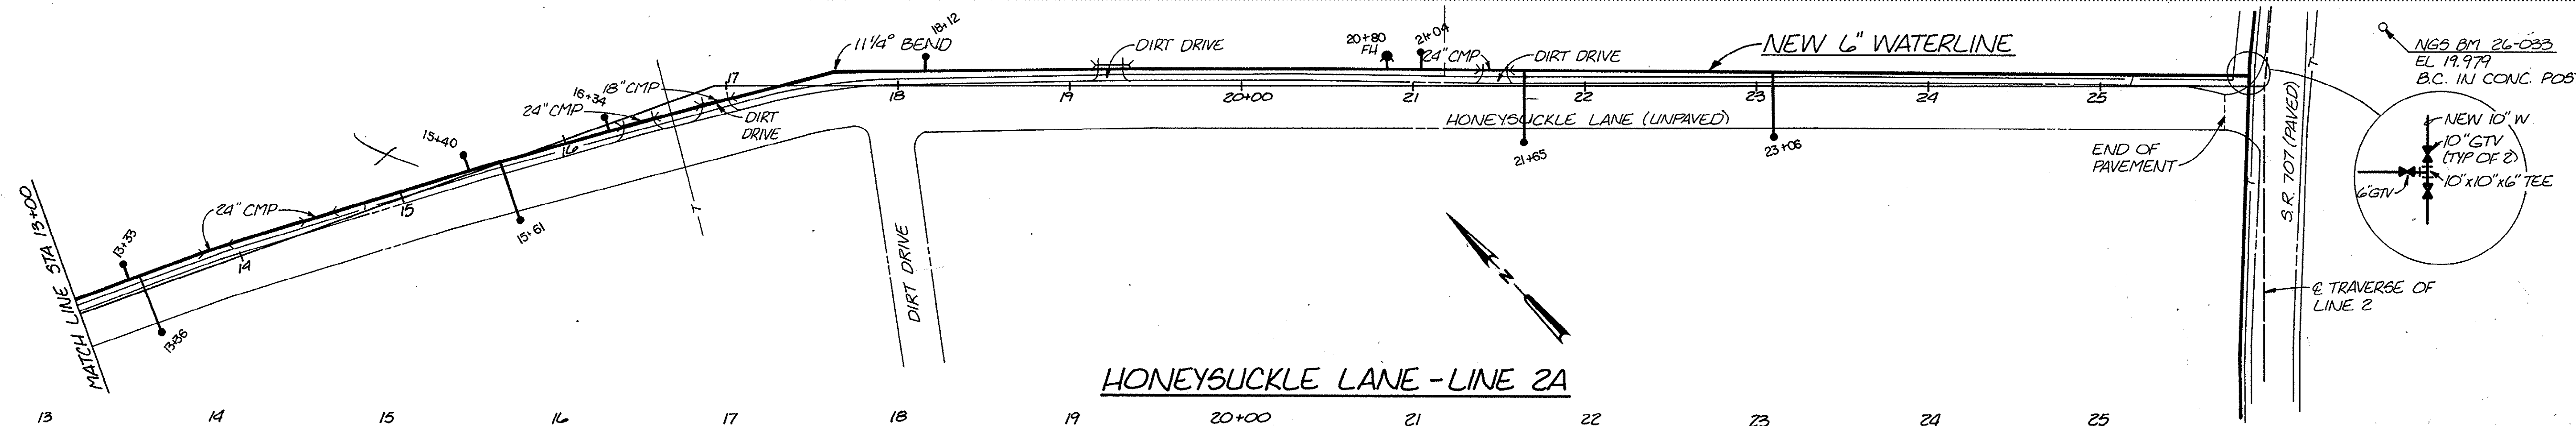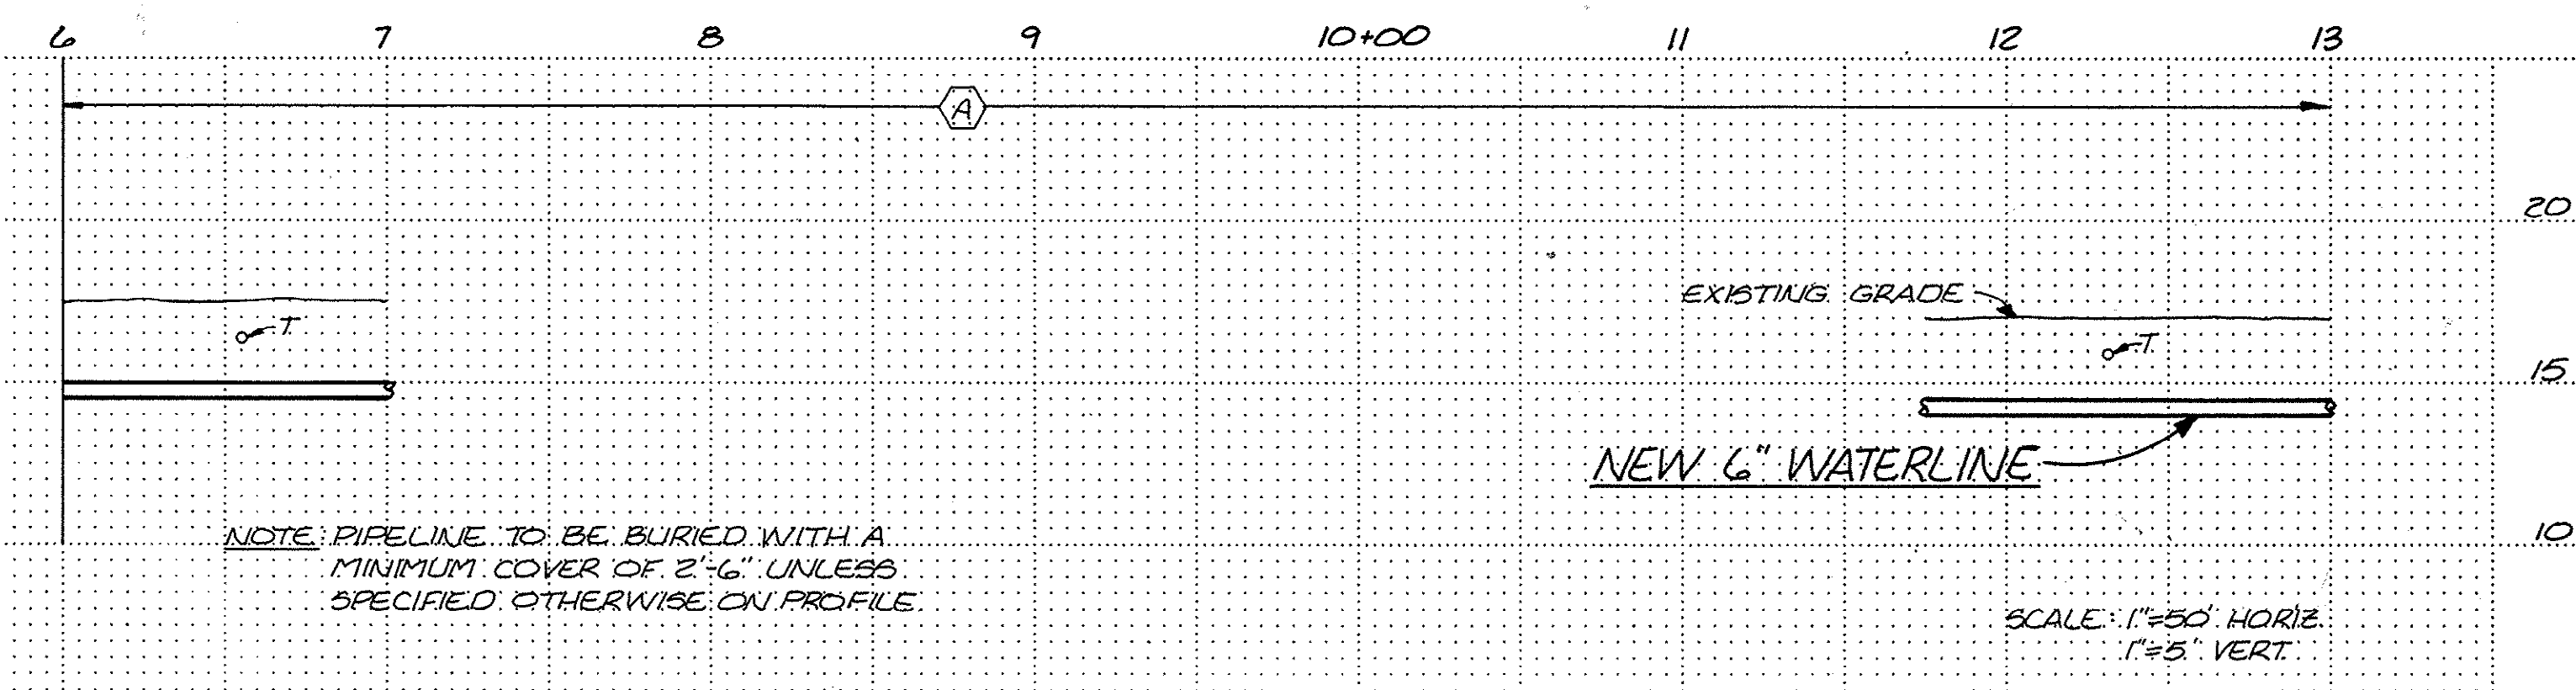

HONEYSUCKLE LANE - LINE 2A

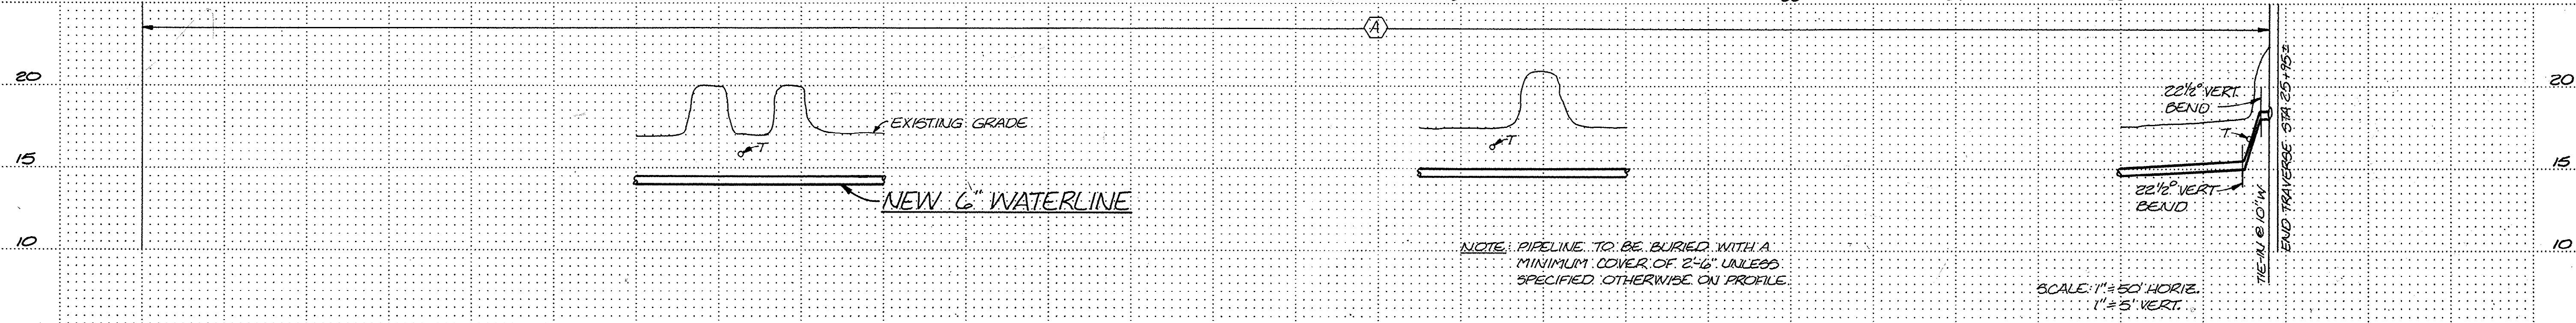

RECORD DRAWING
FEB 10 1986 FR

Fixed Assets
3-20-86
14-11-012/17-W

NOTE: INSTALL SERVICE CONNECTIONS PER WATER SERVICE AND METER BOX DETAILS. SERVICE CONNECTIONS AND METER BOXES TO BE FIELD-LOCATED BY OWNER.



CH2M HILL	DSGN T. SMALLWOOD
	DR M. HALES
	CHK C. CRANDALL
	APVD R. HIRSEKORN

NO.	DATE	REVISION	BY	APVD

REUSE OF DOCUMENTS
THIS DOCUMENT, AND THE IDEAS AND DESIGNS INCORPORATED HEREIN, AS AN INSTRUMENT OF PROFESSIONAL SERVICE, IS THE PROPERTY OF CH2M HILL AND IS NOT TO BE USED, IN WHOLE OR IN PART, FOR ANY OTHER PROJECT WITHOUT THE WRITTEN AUTHORIZATION OF CH2M HILL.



VERIFY SCALES
BAR IS ONE INCH ON ORIGINAL DRAWING.
IF NOT ONE INCH ON THIS SHEET, ADJUST SCALES ACCORDINGLY.

WATER SYSTEM IMPROVEMENTS
BURGESS COMMUNITY
GRAND STRAND WATER & SEWER AUTHORITY

LINE 2A - PLAN AND PROFILE
6" WATERLINE
STA 0+00 TO STA 25+95

SHEET	12
OF	17
DATE	FEB 1986
PROJ NO.	SA17940.A1

COMPOSITE
OVERLAY
SCREEN
PROJ. NO.
CONTRACT

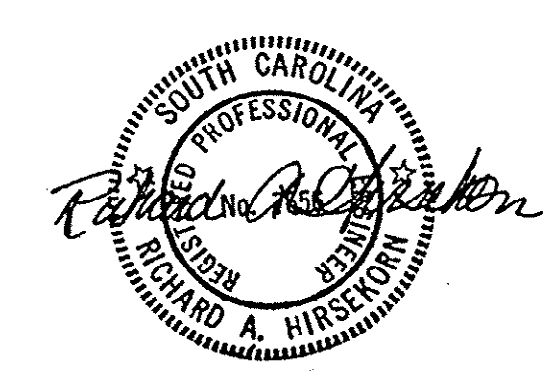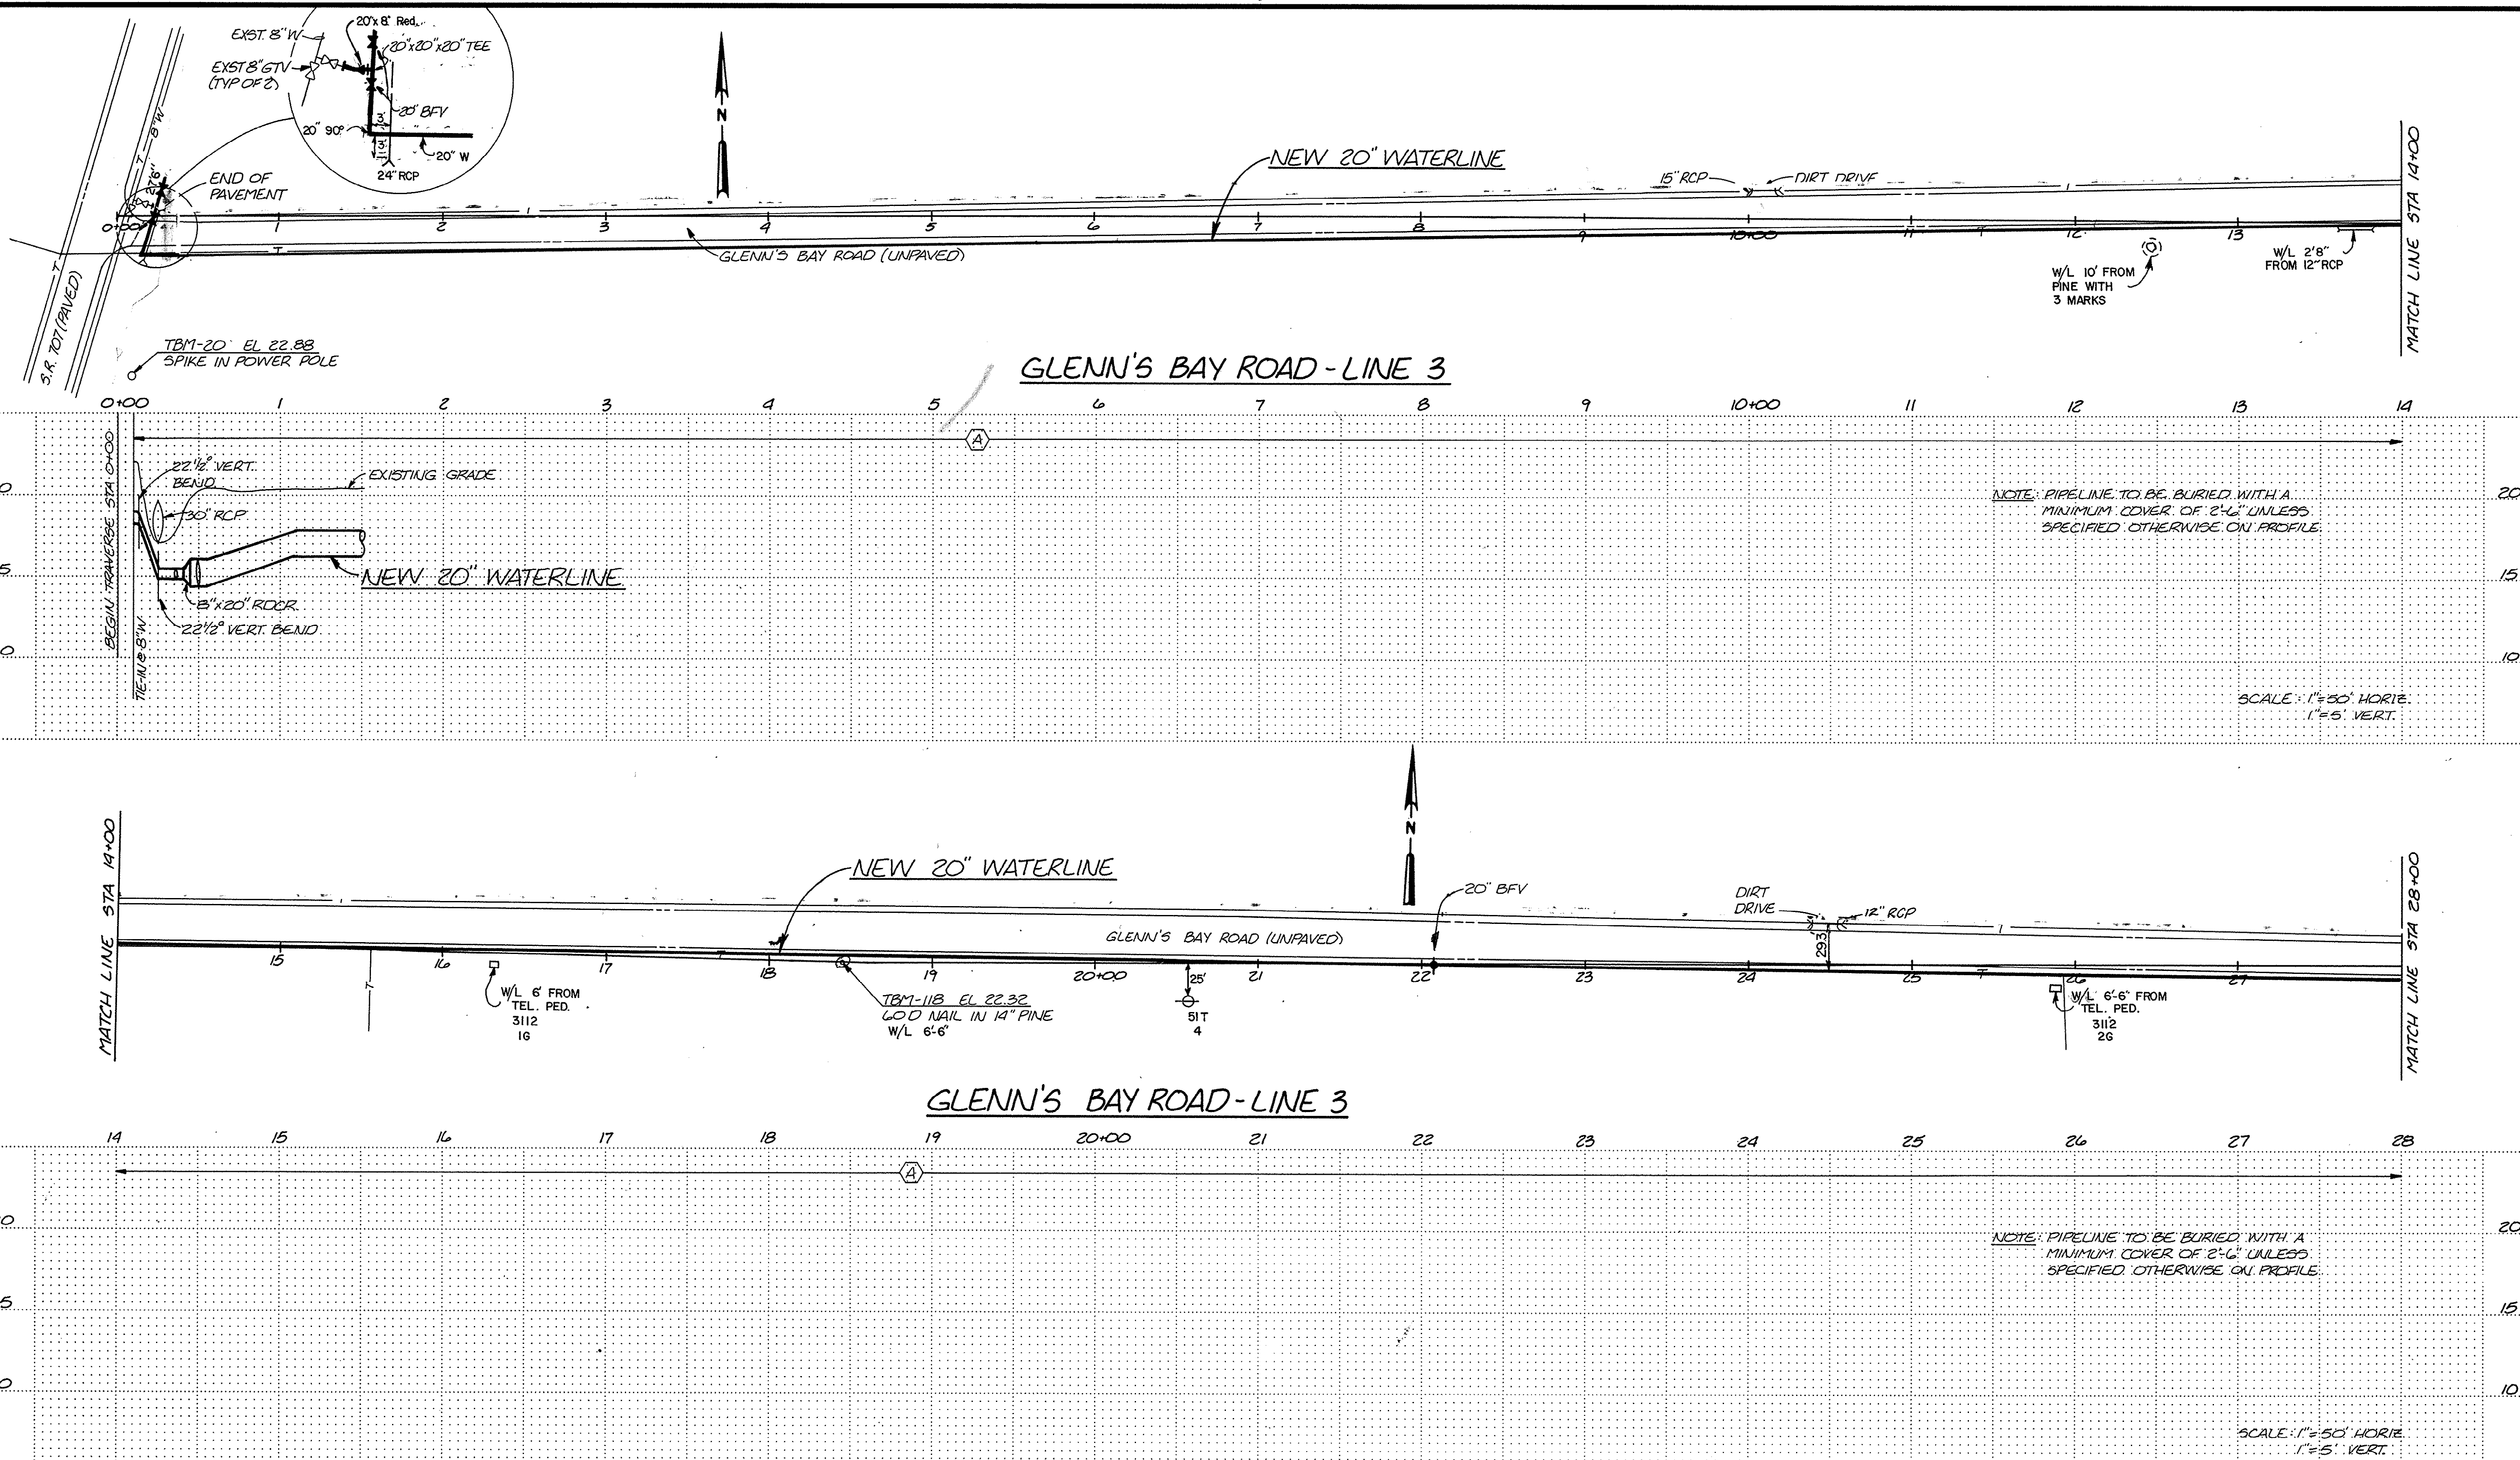

CH2M HILL	DSGN	T. SMALLWOOD	NO.	DATE	REVISION	BY	APVD
	DR	M. HALES					
	CHK	C. CRAUDALL					
	APVD	R. HIRSEKORN					

REUSE OF DOCUMENTS
THIS DOCUMENT, AND THE IDEAS AND DESIGNS INCORPORATED HEREIN, AS AN INSTRUMENT OF PROFESSIONAL SERVICE, IS THE PROPERTY OF CH2M HILL AND IS NOT TO BE USED, IN WHOLE OR IN PART, FOR ANY OTHER PROJECT WITHOUT THE WRITTEN AUTHORIZATION OF CH2M HILL.

VERIFY SCALES
BAR IS ONE INCH ON ORIGINAL DRAWING.
IF NOT ONE INCH ON THIS SHEET, ADJUST SCALES ACCORDINGLY.


WATER SYSTEM IMPROVEMENTS
BURGESS COMMUNITY
GRAND STRAND WATER & SEWER AUTHORITY

Fixed Assets
3-26-86 RA
14-IL-013/17-W



NOTE: INSTALL SERVICE CONNECTIONS PER WATER SERVICE AND METER BOX DETAILS. SERVICE CONNECTIONS AND METER BOXES TO BE FIELD-LOCATED BY OWNER.

LINE 3 - PLAN AND PROFILE
20" WATERLINE
STA 0+00 TO STA 28+00


SHEET	13
OF 17	
DATE	FEB 1985
PROJ.	SA17940.A1
NO.	

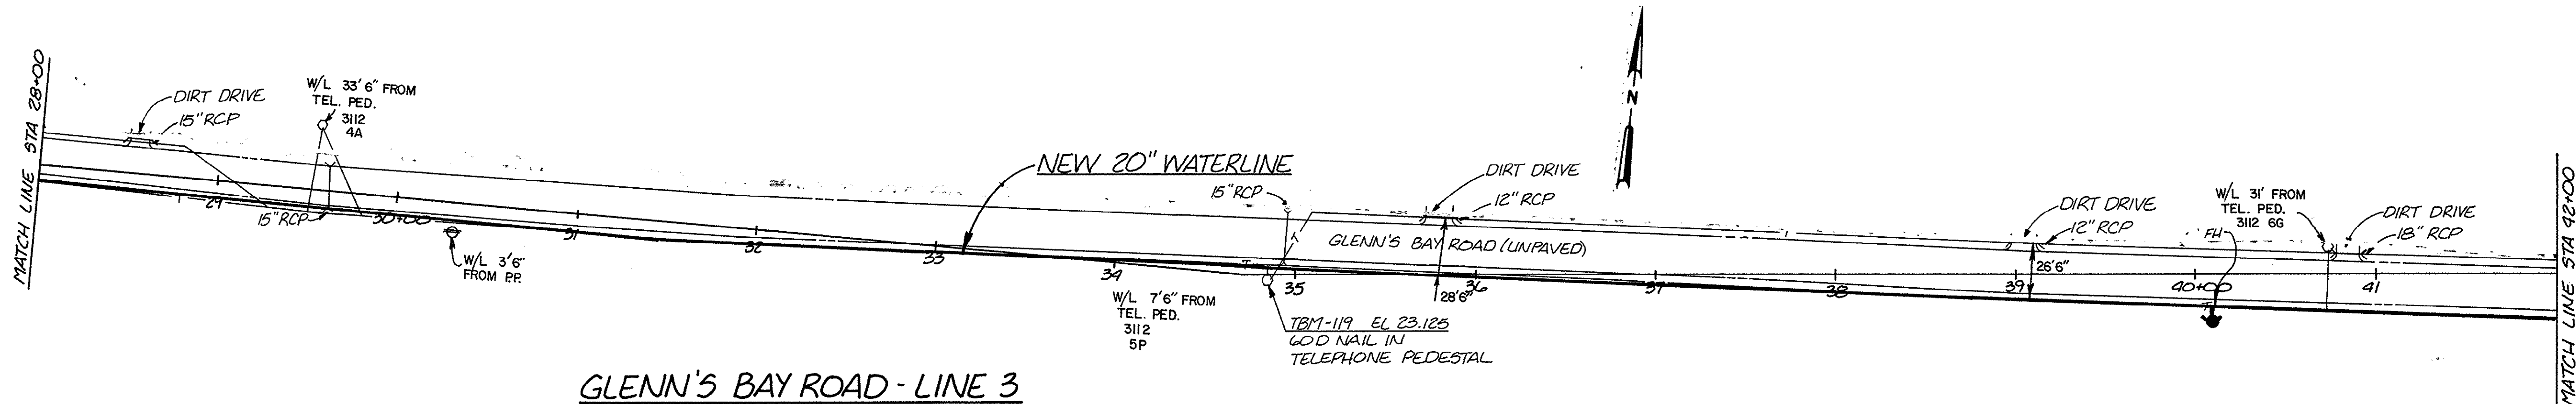

GLENN'S BAY ROAD - LINE 3

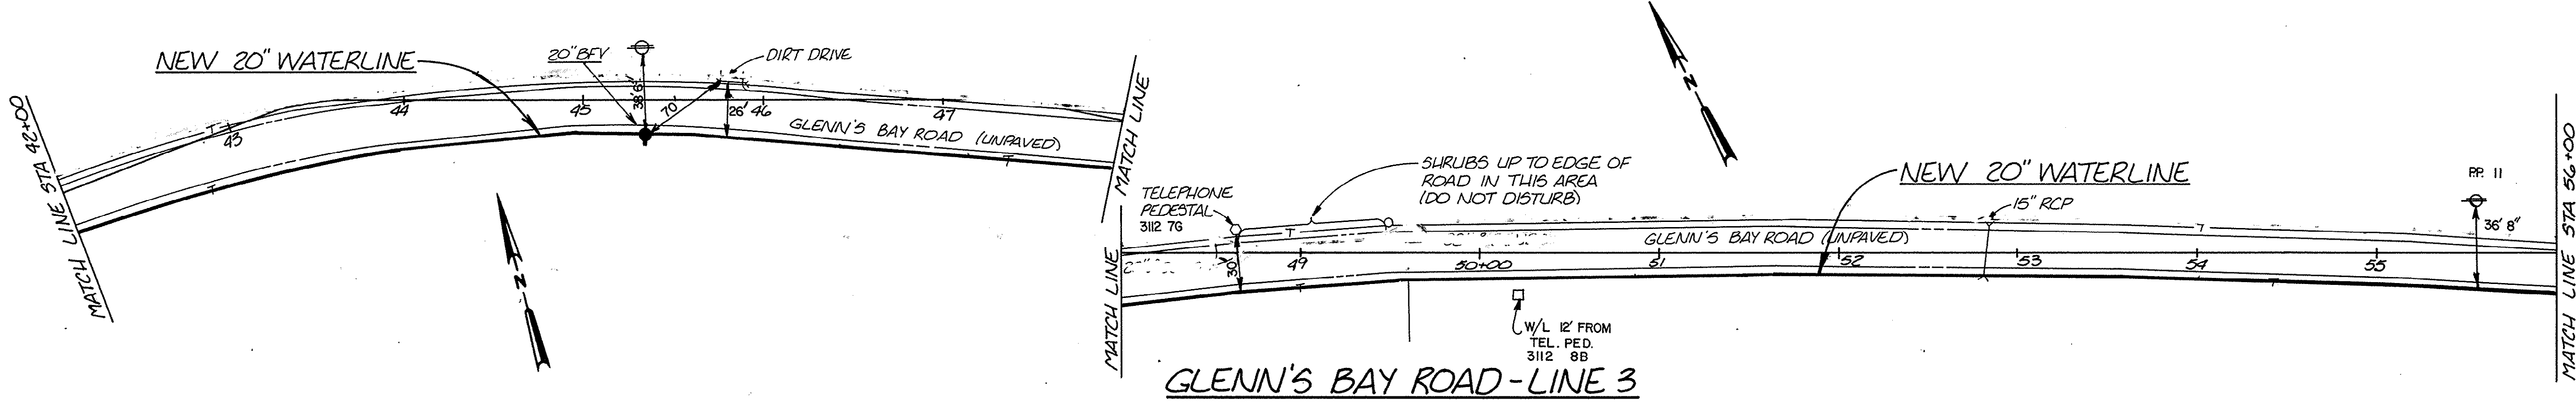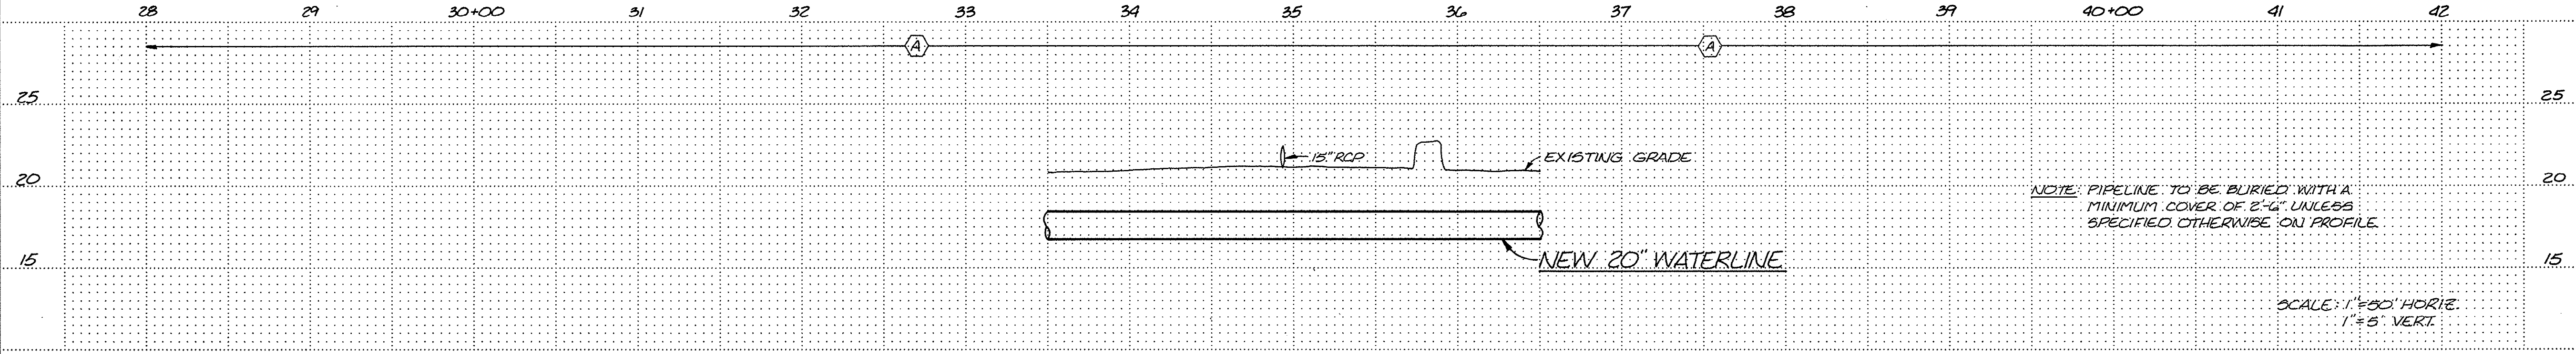

GLENN'S BAY ROAD - LINE 3

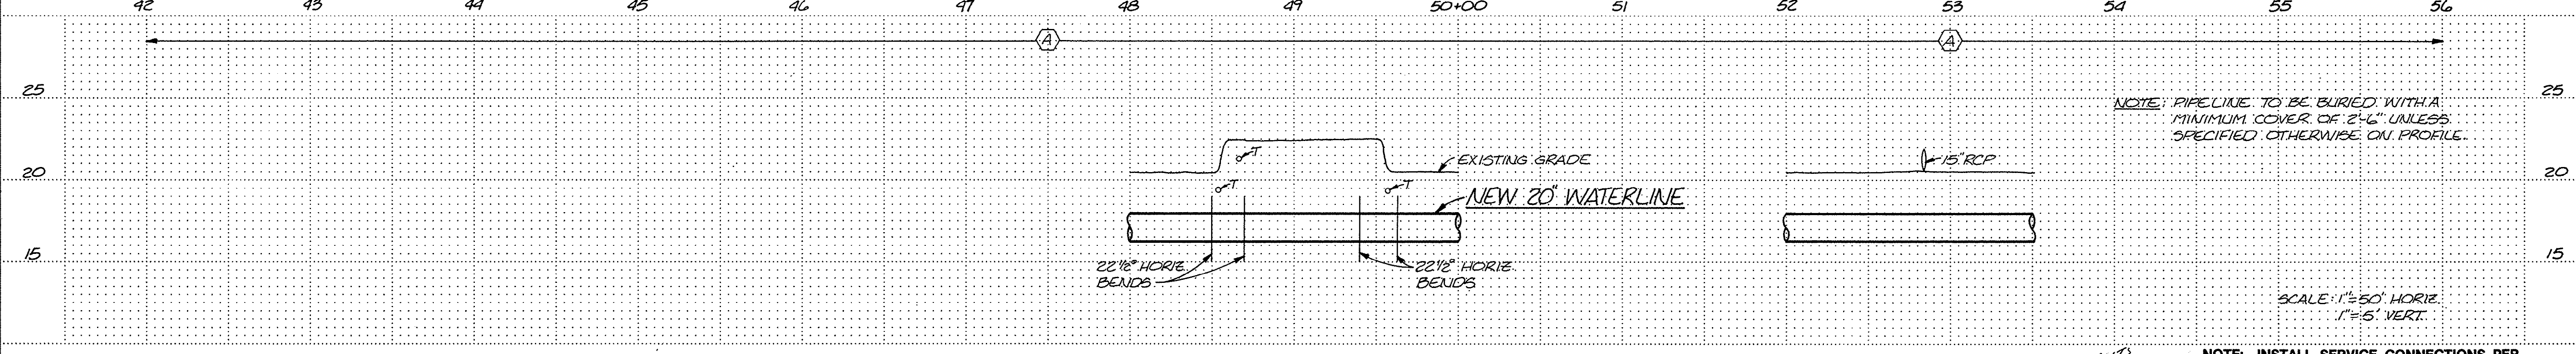

RECORD DRAWING
FEB 10 1986

NOTE: INSTALL SERVICE CONNECTIONS PER WATER SERVICE AND METER BOX DETAILS. SERVICE CONNECTIONS AND METER BOXES TO BE FIELD-LOCATED BY OWNER.



CH2M HILL	DSGN	T. SMALLWOOD							
	DR	M. HALES							
	CHK	C. CRANDALL							
	APVD	R. HIRSEKORU							
	NO.	DATE	REVISION	BY	APVD				

REUSE OF DOCUMENTS
THIS DOCUMENT, AND THE IDEAS AND DESIGNS INCORPORATED HEREIN, AS AN INSTRUMENT OF PROFESSIONAL SERVICE, IS THE PROPERTY OF CH2M HILL AND IS NOT TO BE USED, IN WHOLE OR IN PART, FOR ANY OTHER PROJECT WITHOUT THE WRITTEN AUTHORIZATION OF CH2M HILL.



VERIFY SCALES
BAR IS ONE INCH ON ORIGINAL DRAWING.
IF NOT ONE INCH ON THIS SHEET, ADJUST SCALES ACCORDINGLY.

WATER SYSTEM IMPROVEMENTS
BURGESS COMMUNITY
GRAND STRAND WATER & SEWER AUTHORITY

LINE 3 - PLAN AND PROFILE
20" WATERLINE
STA 28+00 TO STA 56+00

SHEET	14
OF	17
DATE	FEB 1985
PROJ. NO.	SA17940.A1

OVERLAY
CONTRACT

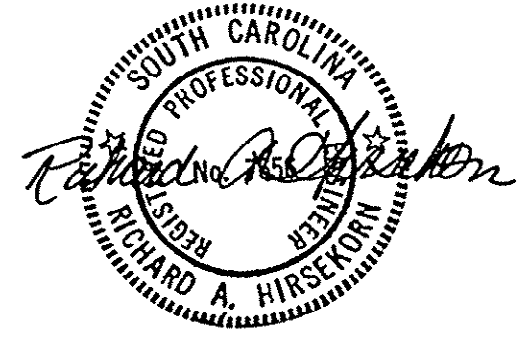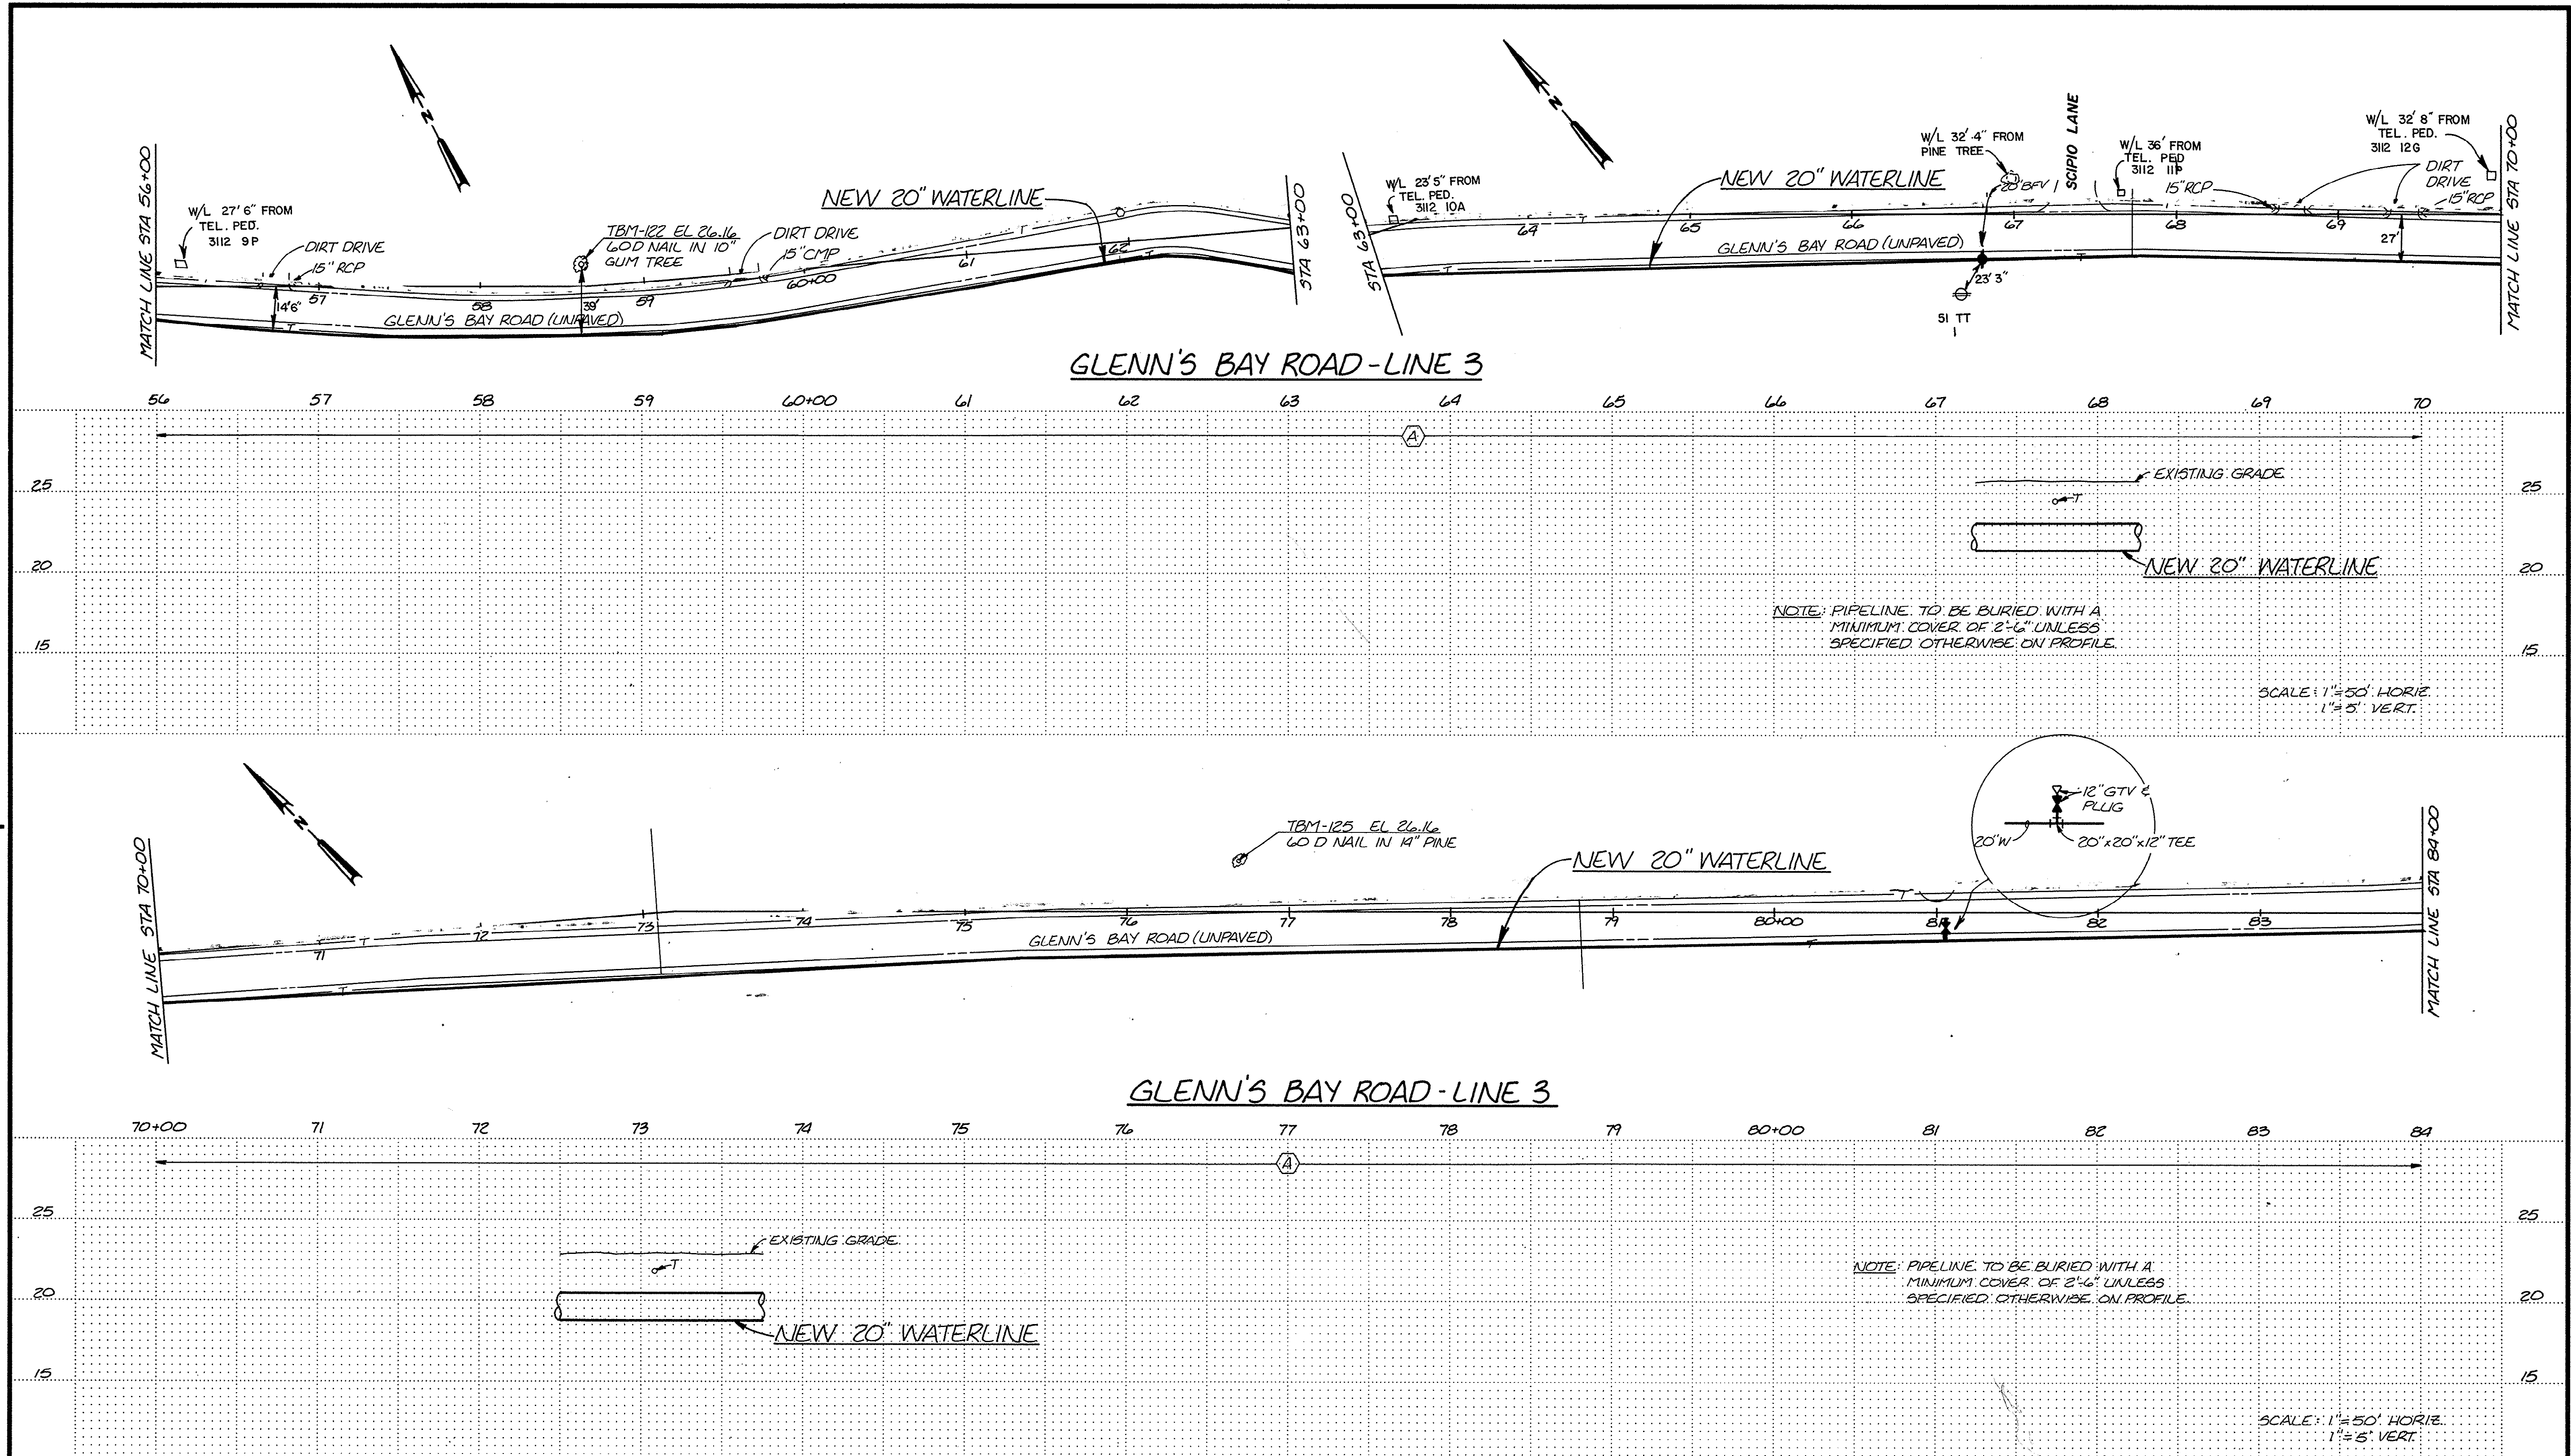

CH2M HILL	DSGN	T. SMALLWOOD			NO.	DATE	REVISION	BY	APVD
	DR	M. HALES							
	CHK	C. CRANDALL							
	APVD	R. HIRSEKORNI							

REUSE OF DOCUMENTS
THIS DOCUMENT, AND THE IDEAS AND DESIGNS INCORPORATED HEREIN, AS AN INSTRUMENT OF PROFESSIONAL SERVICE, IS THE PROPERTY OF CH2M HILL AND IS NOT TO BE USED, IN WHOLE OR IN PART, FOR ANY OTHER PROJECT WITHOUT THE WRITTEN AUTHORIZATION OF CH2M HILL.

VERIFY SCALES
BAR IS ONE INCH ON ORIGINAL DRAWING.
IF NOT ONE INCH ON THIS SHEET, ADJUST SCALES ACCORDINGLY.

WATER SYSTEM IMPROVEMENTS
BURGESS COMMUNITY
GRAND STRAND WATER & SEWER AUTHORITY

LINE 3 - PLAN AND PROFILE
20\" WATERLINE
STA 56+00 TO STA 84+00

SHEET 15
OF 17
DATE FEB 1986
PROJ. NO. SA17940.A1


RECORD DRAWING
FEB 10 1986 *FR*
14-11-0154Z-W

NOTE: INSTALL SERVICE CONNECTIONS PER WATER SERVICE AND METER BOX DETAILS. SERVICE CONNECTIONS AND METER BOXES TO BE FIELD-LOCATED BY OWNER.

ENTERPRISE ROAD WATERLINE EXTENSION

GRAND STRAND WATER & SEWER AUTHORITY

NOVEMBER 1985

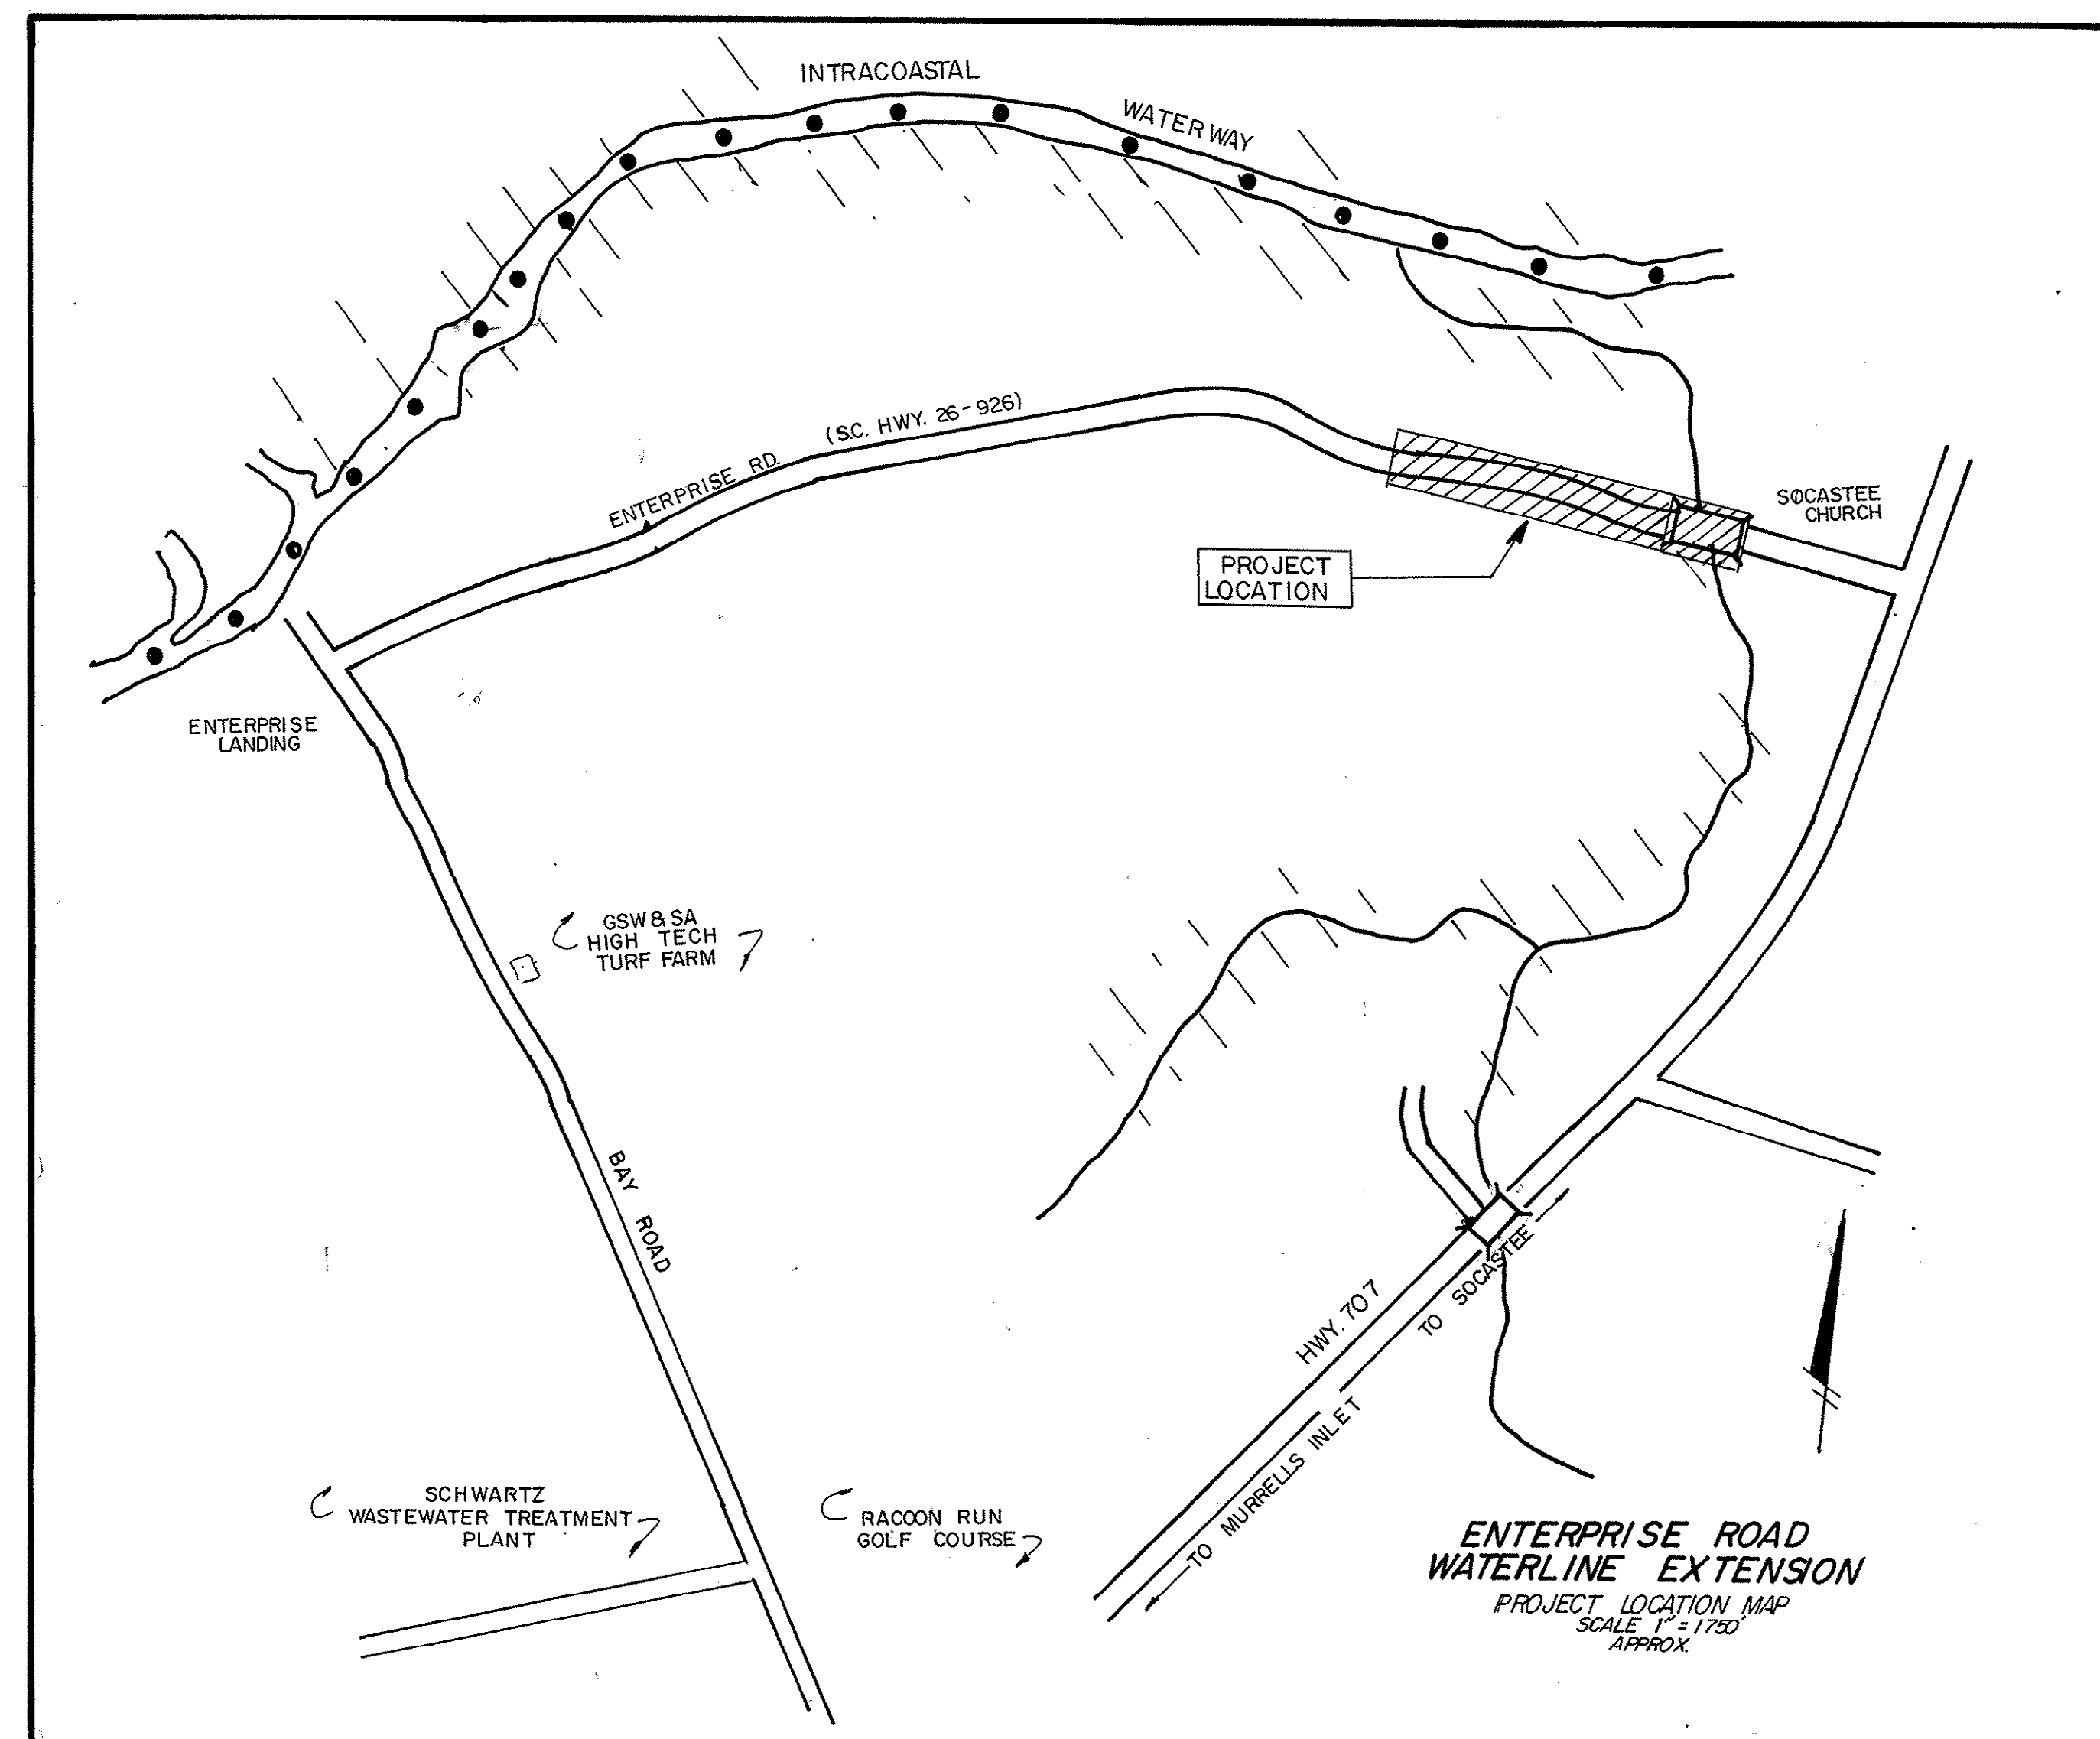

APPROVED
By *C.C. Hahn* Date *3/4/87*