

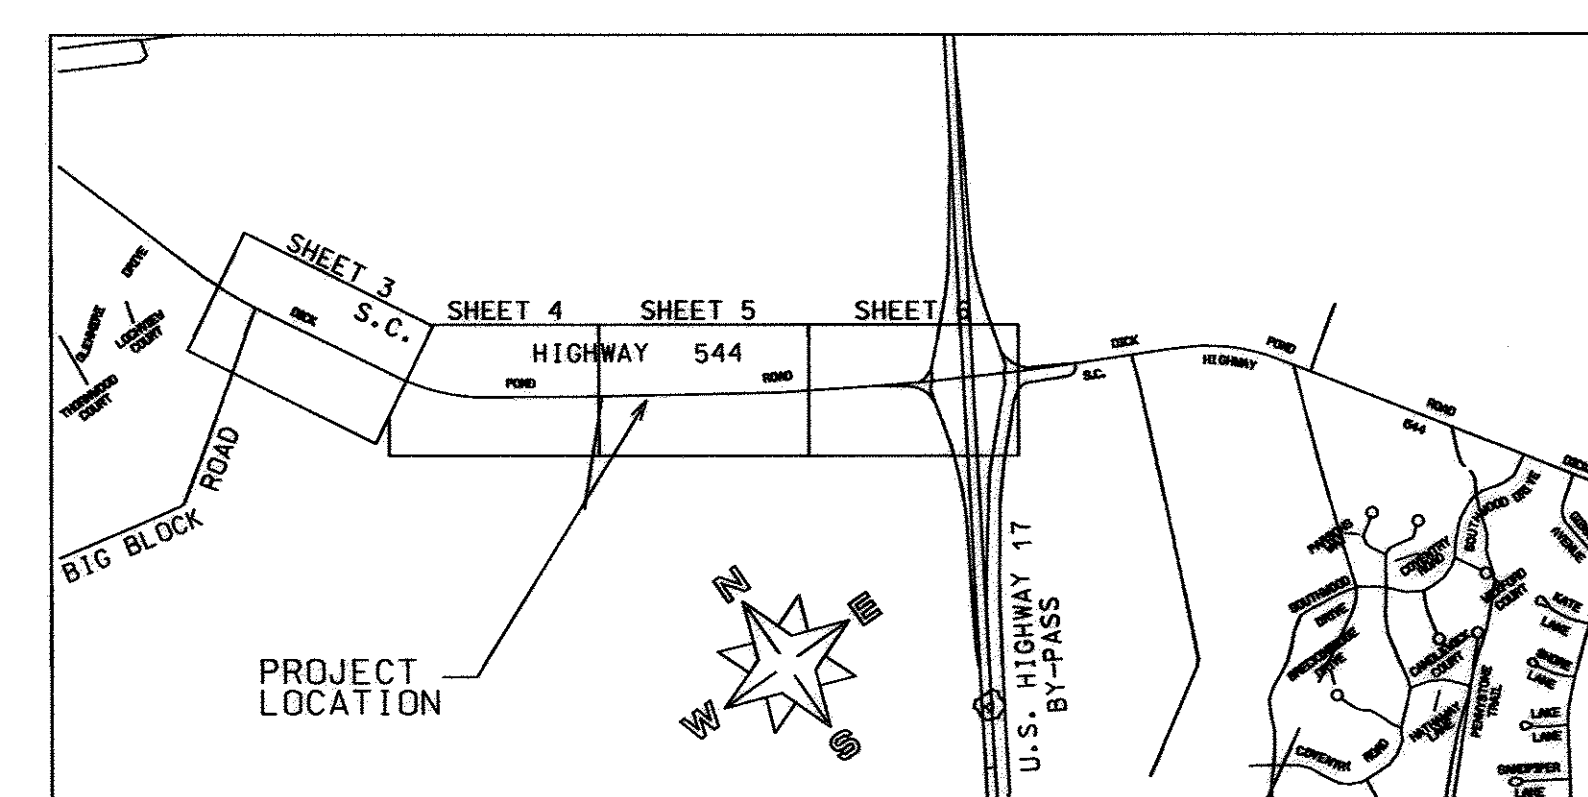


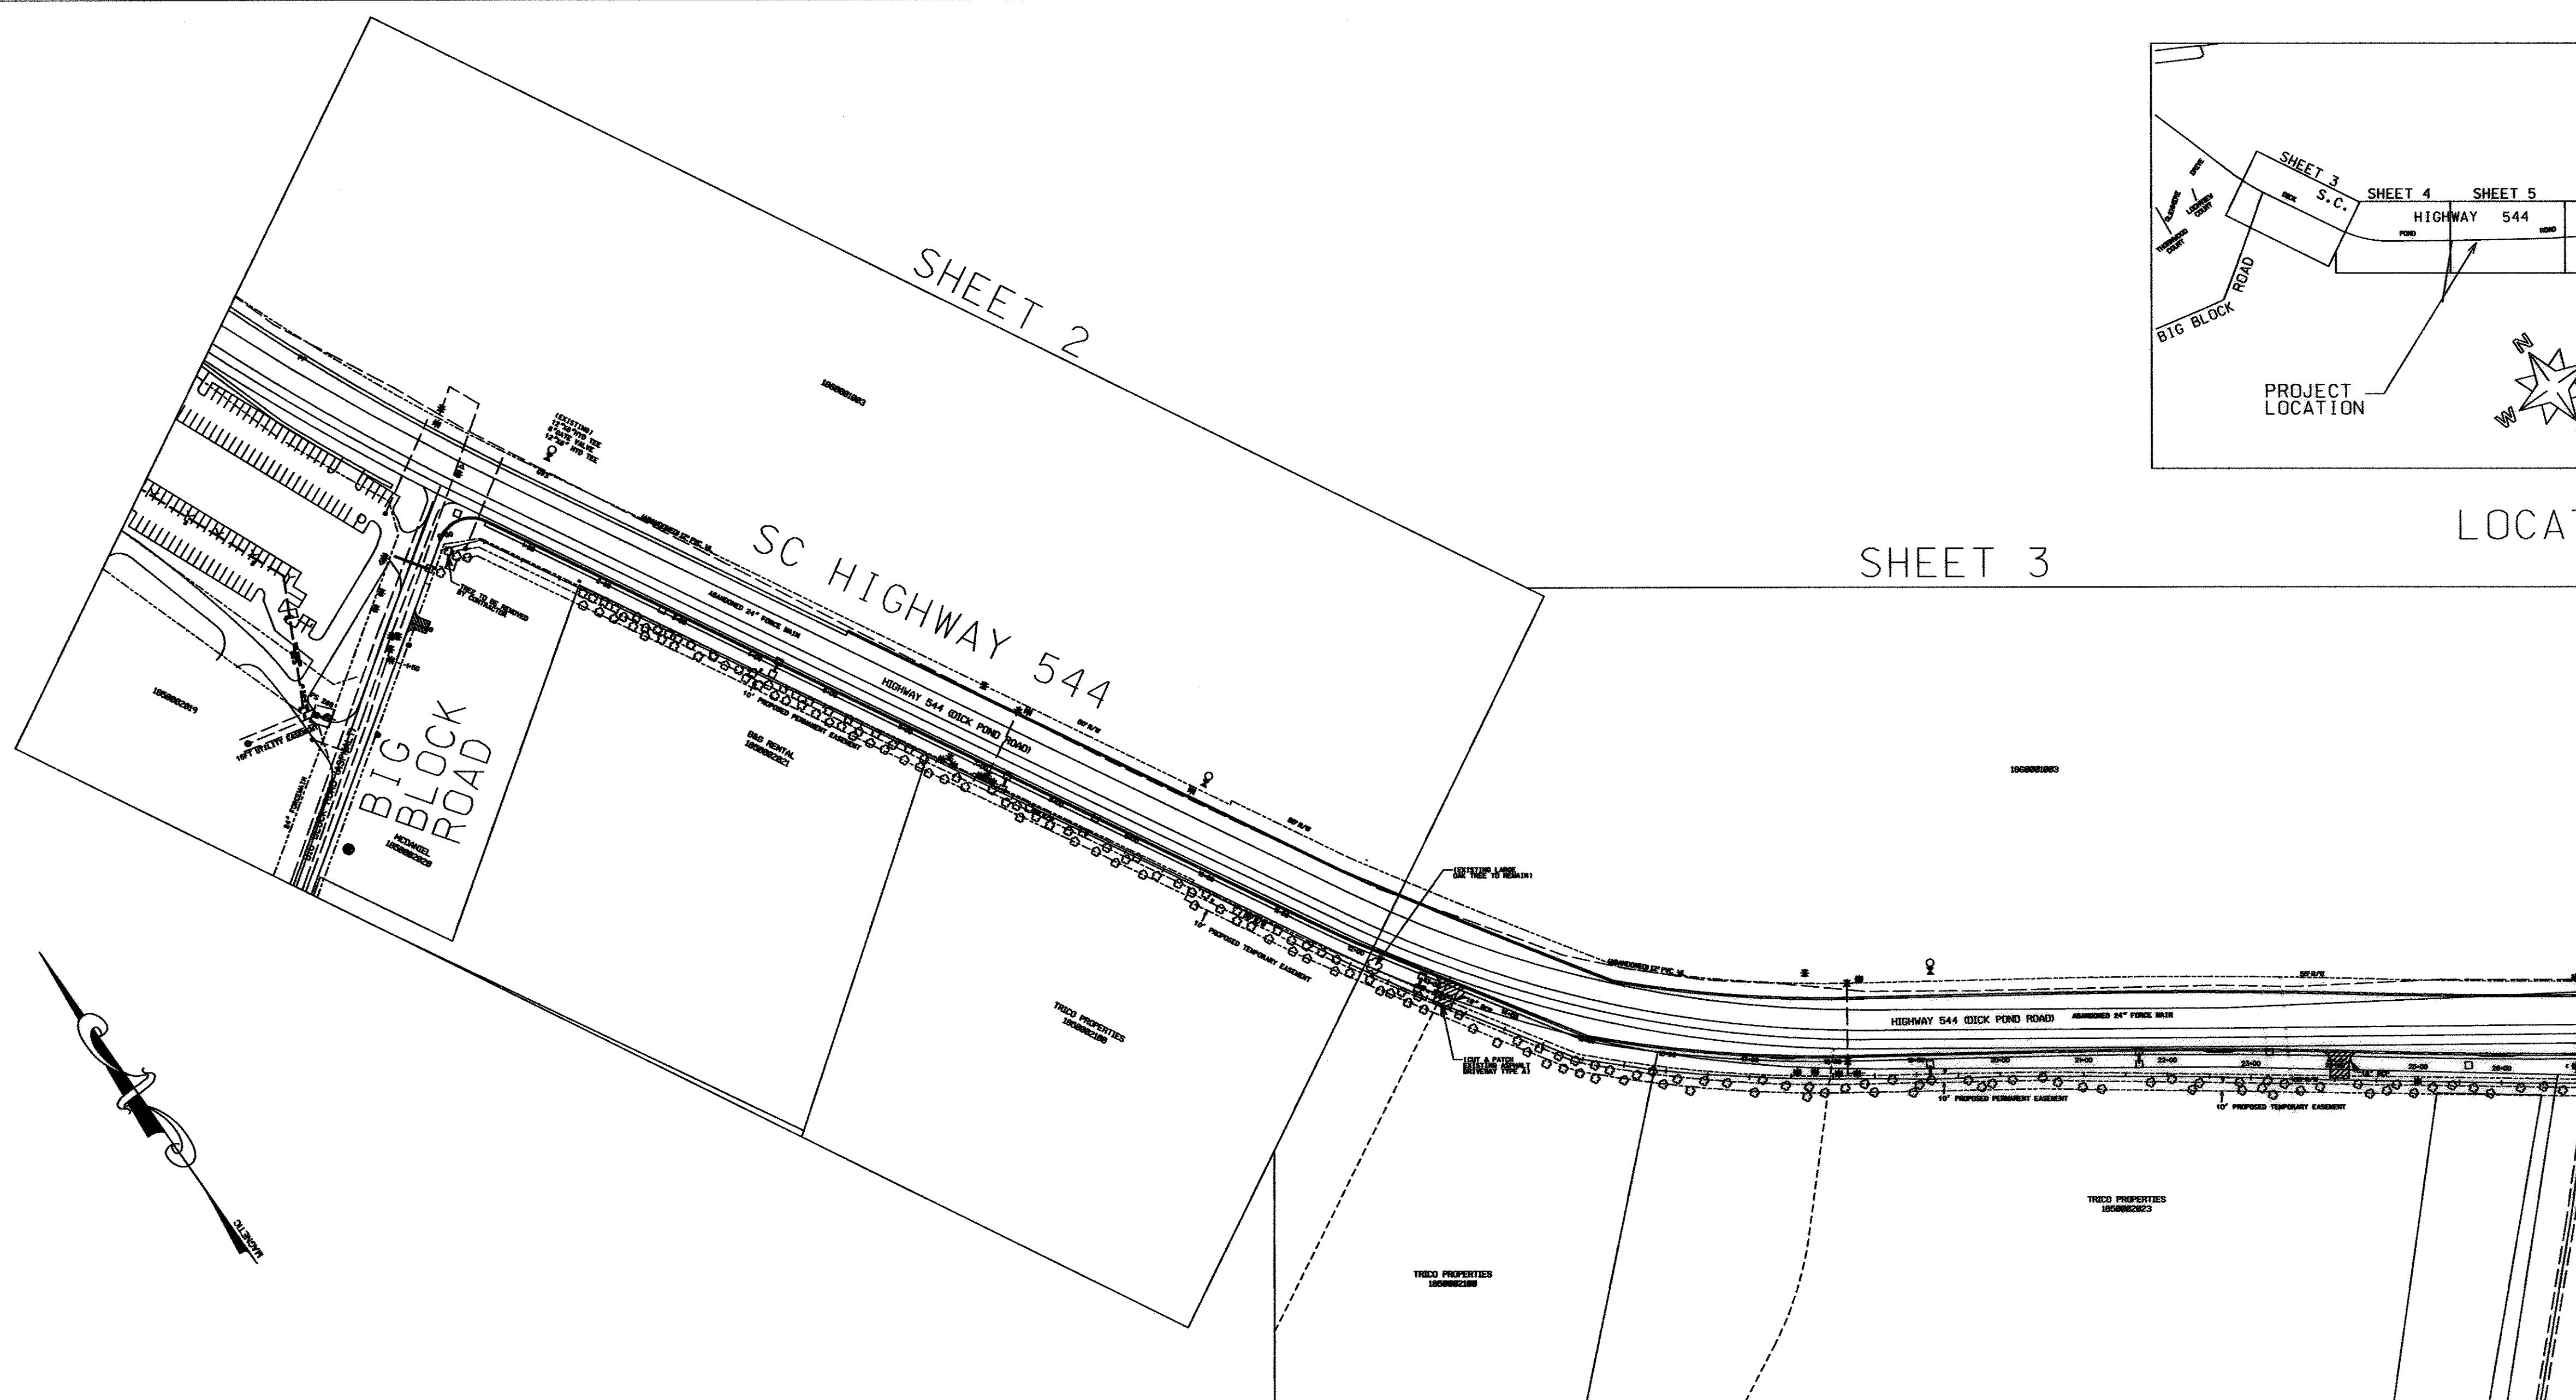

LOCATION MAP

SHEET 4

SHEET 5

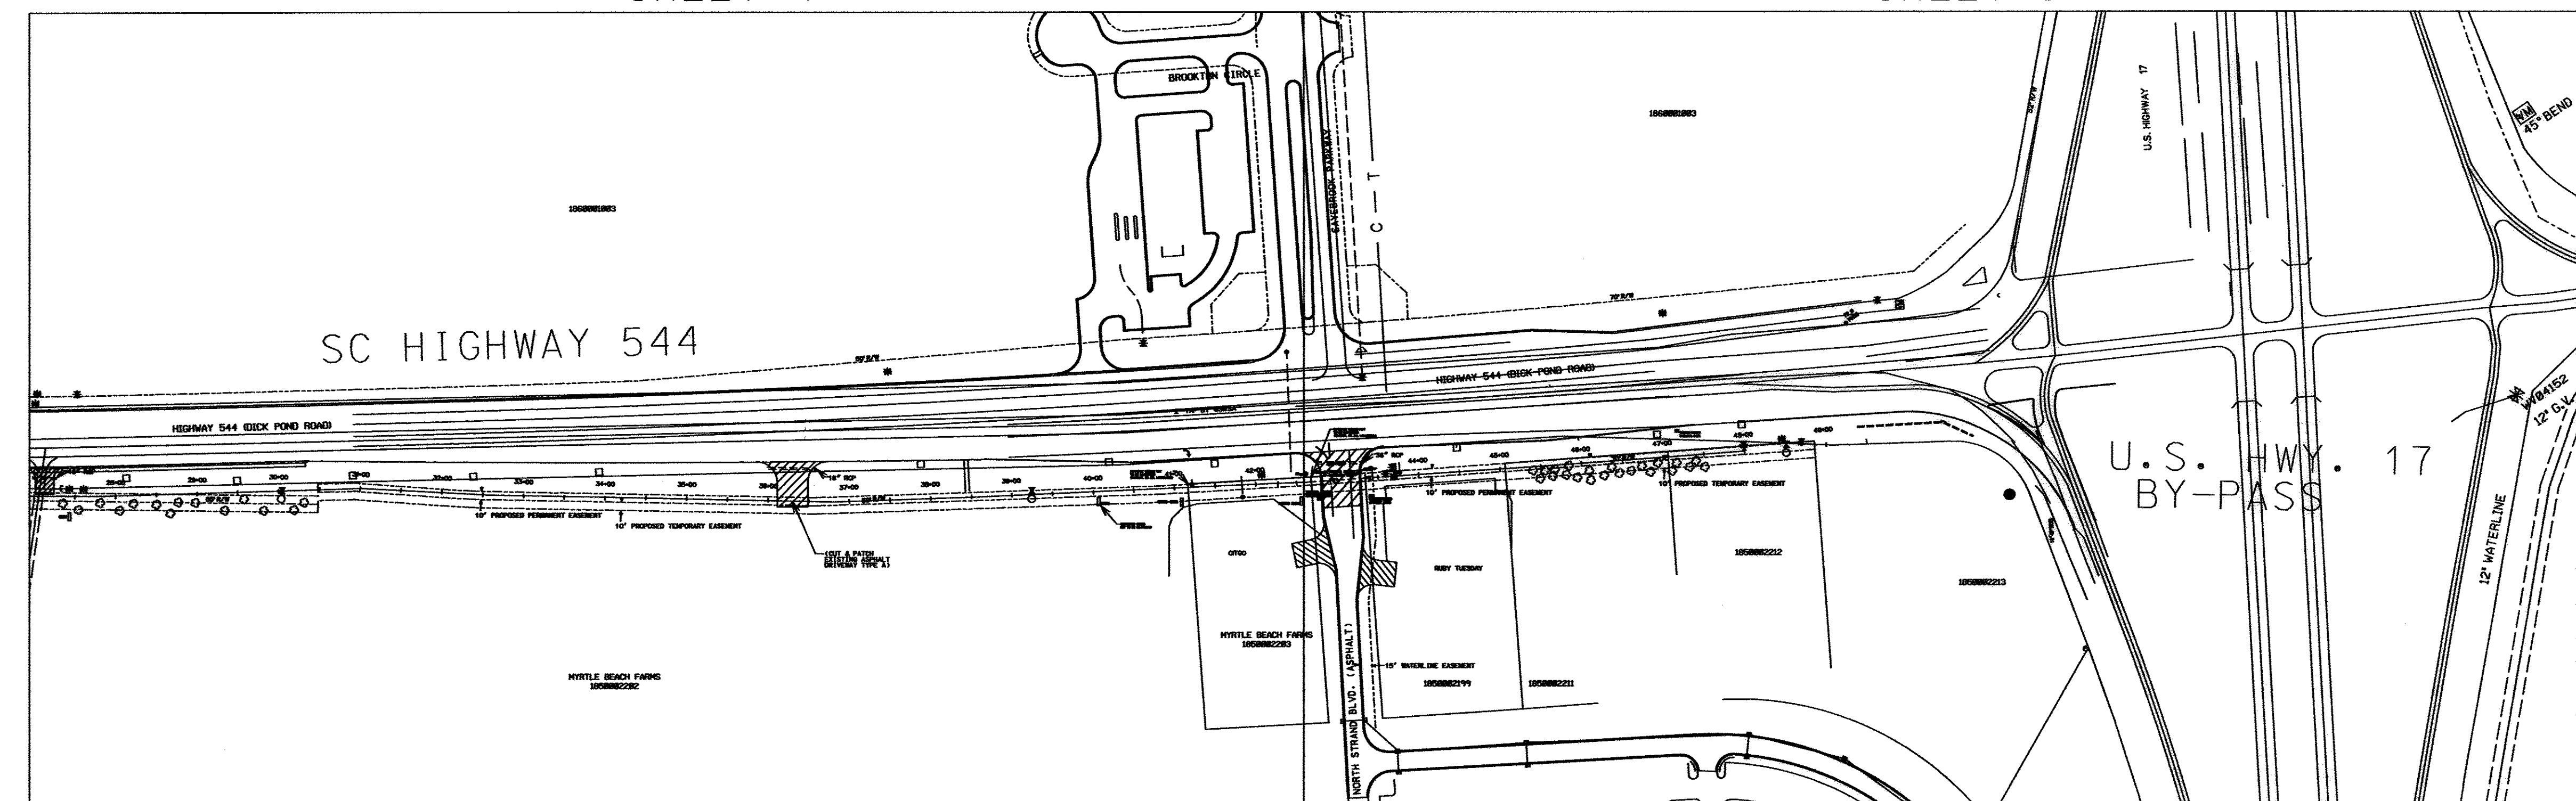

THESE DRAWINGS REFLECT AS-BUILT CONDITIONS	
REVIEWED BY: <i>Ronald W. Keen</i>	DATE: <i>6/8/07</i>
INSPECTIONS	
REVIEWED BY: <i>Jim Hembree</i>	DATE: <i>6/11/07</i>
ENGINEERING	
GRAND STRAND WATER AND SEWER AUTHORITY	

EAST WATERLINE TRANSMISSION EXT.

REVISION	DATE
BY	REP
AS BUILT	MAY 2007

GRAND STRAND WATER & SEWER AUTHORITY	
170 JACKSON BLUFF RD. CONWAY, SC 29525-2988 (843) 347-4641 FAX (843) 347-4642 E-MAIL: GSWA@GSA.COM	


EAST WATERLINE TRANSMISSION EXT.	
(LOCATED ALONG HWY 544)	
PROJ. #475-01/CONT. #W	

SOUTH CAROLINA REGISTERED PROFESSIONAL ENGINEER	
NO. 9853	
FRED R. RICHARDSON	

DATE:	JULY 2002
SCALE:	(NTS)
FILENAME:	sheet2.dgn
DRAWN BY:	CHANDUS PORTER
CHECKED BY:	JIM HEMBREE
APPROVED BY:	
FRED R. RICHARDSON	PE #9853
SHEET 1 OF 5	
DWG # 17-153-001005-W	

1860001003


HWY 544 RELOC.
REF.# 17-098-006

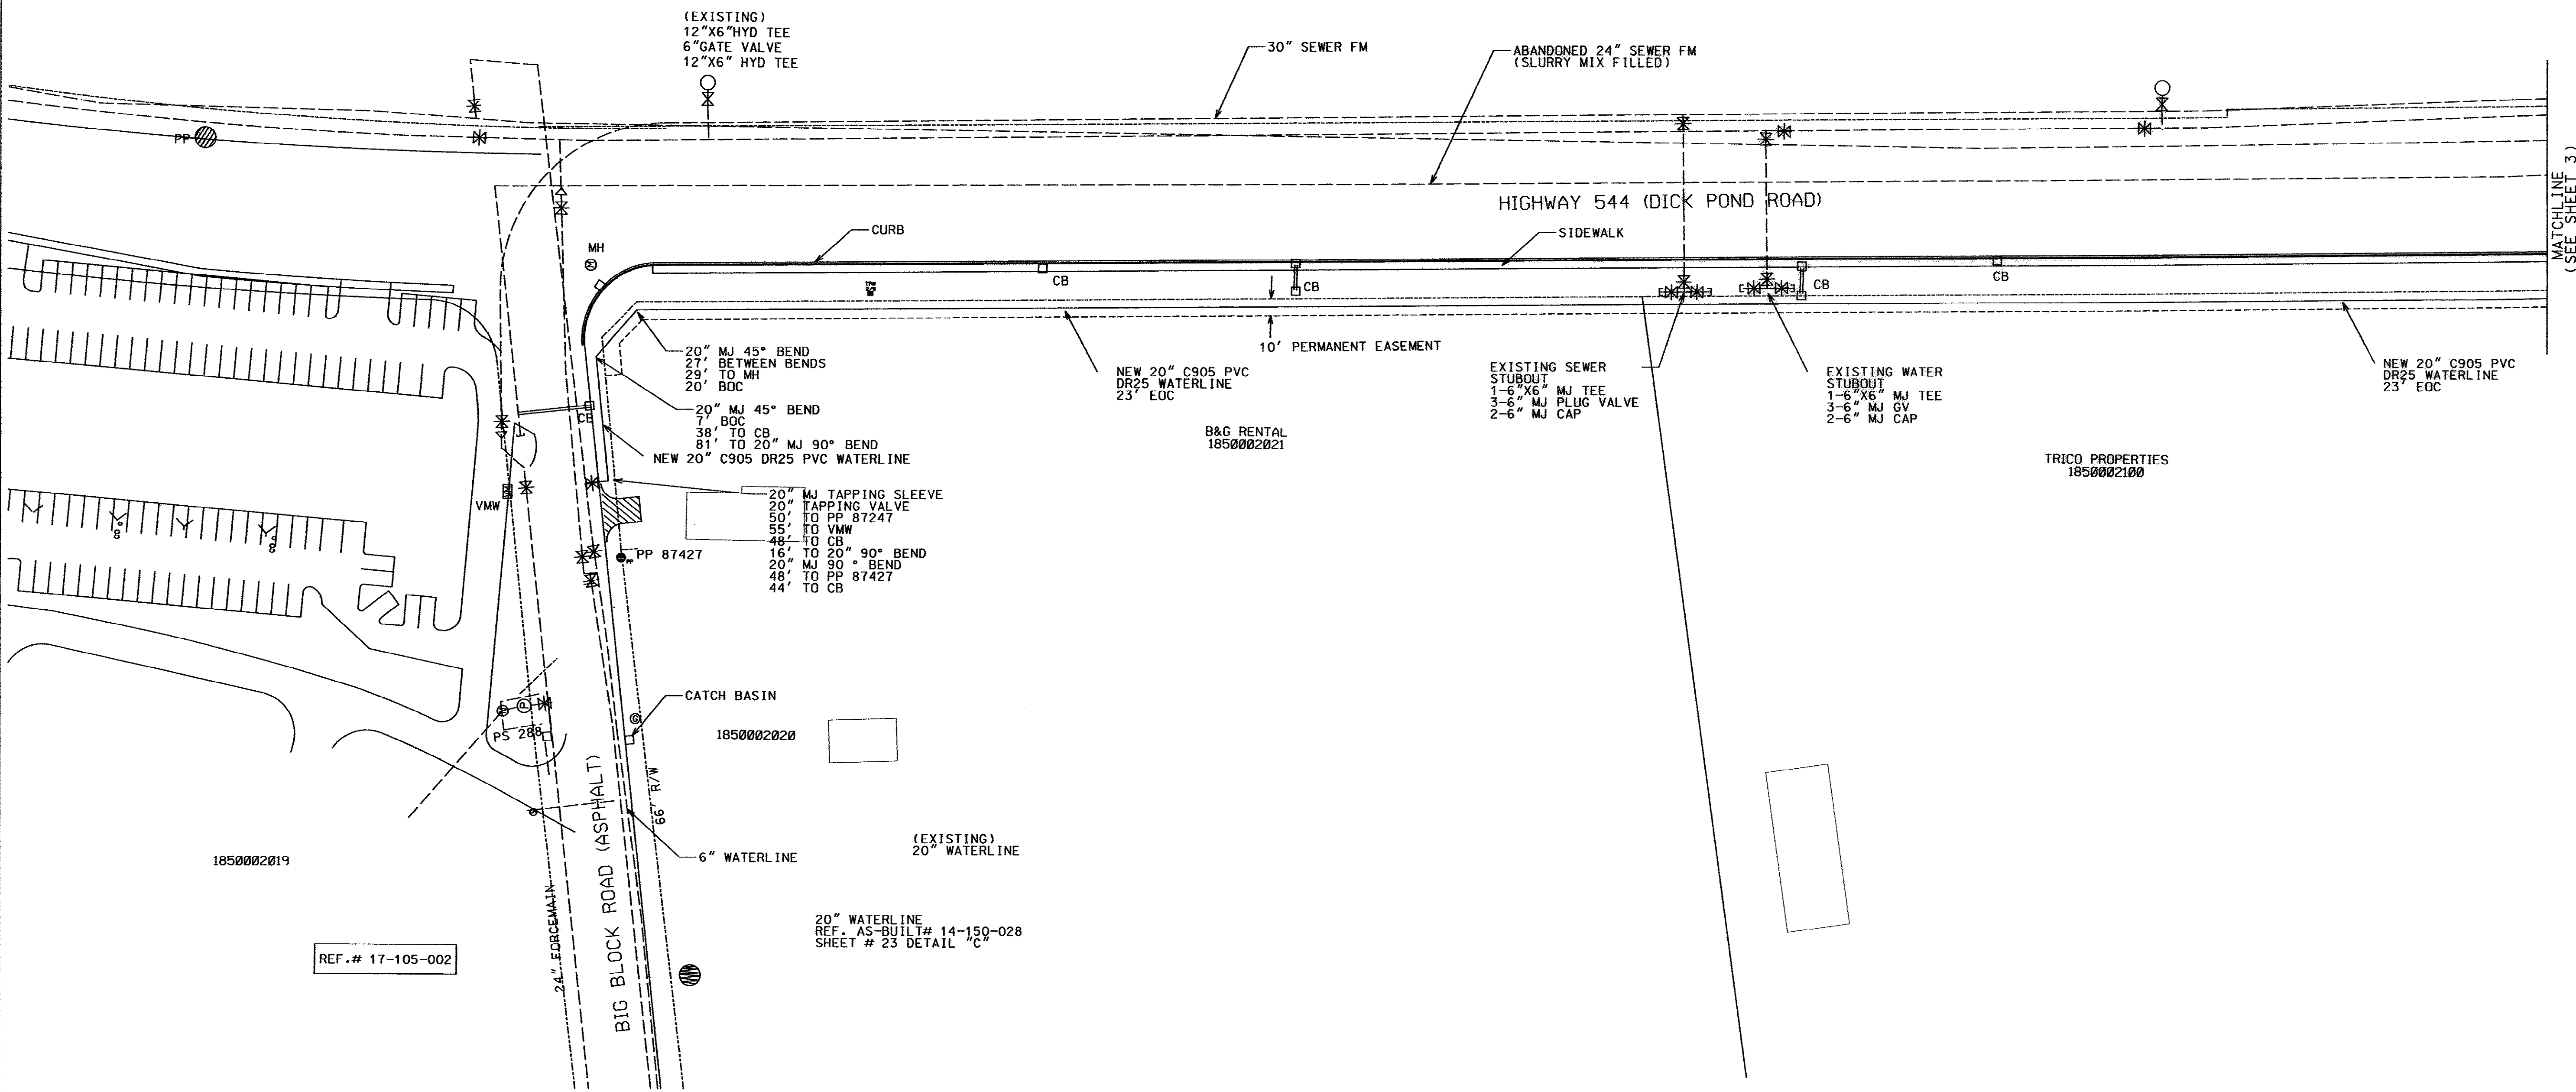

1850002019

REF.# 17-105-002

LEGEND (APPLIES TYPICALLY THROUGHOUT PLAN SHEETS)	
DIRT/GRASS DRIVEWAY	FIRE HYDRANT & GV
CONCRETE DRIVEWAY	POST HYDRANT & GV
CONCRETE DRIVEWAY	GATE VALVE
ASPHALT DRIVEWAY	WATER SERVICE
REINFORCED CONCRETE PIPE (RCP)	REDUCER
TELEPHONE PEDESTAL	RESIDENCE TO RECEIVE WATER SERVICE
	ELECTRIC POWER POLE

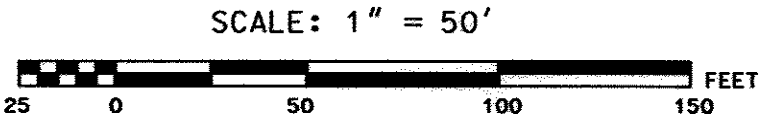

THESE DRAWINGS REFLECT
AS-BUILT
CONDITIONS

REVIEWED BY: *Paradise W. Farn* 6/8/07
INSPECTIONS DATE

REVIEWED BY: *James Post* 6/11/07
ENGINEERING DATE

APPROVED BY: _____
GRAND STRAND WATER AND SEWER AUTHORITY

REVISION	DATE
BY	REF
ASBUILT	MAY 2007

GRAND STRAND
WATER & SEWER
AUTHORITY


170 JACOBSON BLUFF RD.
CONWAY, SC 29528-2388
(843) 347-4641 OR 448-688
FAX: (843) 347-4642
E-MAIL: GSWA@GSA.COM

**EAST WATERLINE TRANSMISSION
EXT.**
(LOCATED ALONG HWY 544)
PROJ. #475-01/CONT. #W

SOUTH CAROLINA
REGISTERED PROFESSIONAL ENGINEER
NO. 9853
F. RICHARDSON

DATE:	JULY 2002
SCALE:	1" = 50'
FILENAME:	sheet.dgn
DRAWN BY:	CHANDUS PORTER
CHECKED BY:	JIM HEMBREE
APPROVED BY:	
FRED R. RICHARDSON	PE #9853
SHEET 2 OF 5	
DWG # 17-153-0025-W	

EAST WATERLINE TRANSMISSION EXT.

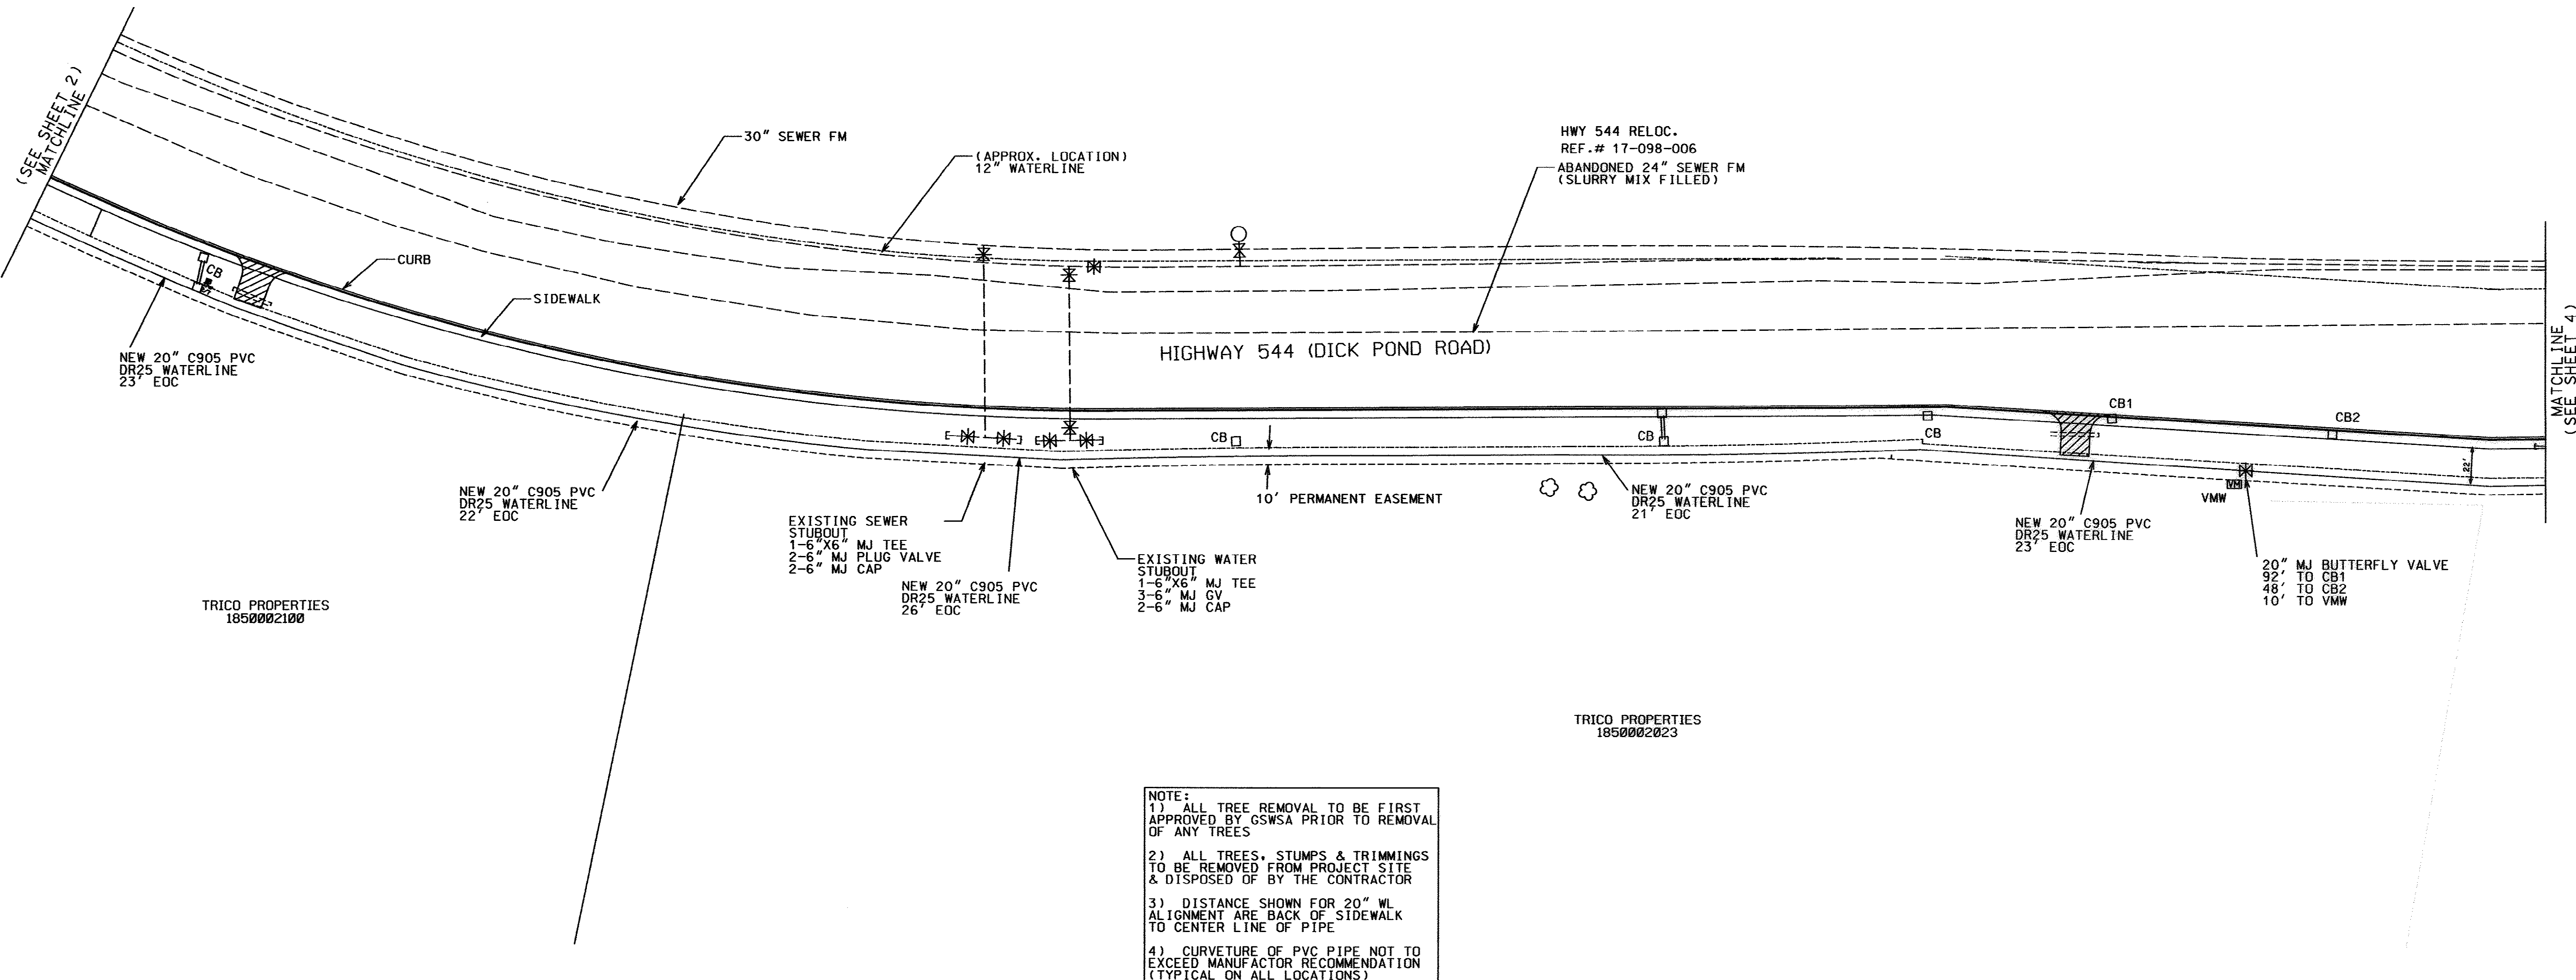

1860001003

TRICO PROPERTIES
1850002100

TRICO PROPERTIES
1850002023

NOTE:
1) ALL TREE REMOVAL TO BE FIRST APPROVED BY GSWA PRIOR TO REMOVAL OF ANY TREES
2) ALL TREES, STUMPS & TRIMMINGS TO BE REMOVED FROM PROJECT SITE & DISPOSED OF BY THE CONTRACTOR
3) DISTANCE SHOWN FOR 20" WL ALIGNMENT ARE BACK OF SIDEWALK TO CENTER LINE OF PIPE
4) CURVATURE OF PVC PIPE NOT TO EXCEED MANUFACTURER RECOMMENDATION (TYPICAL ON ALL LOCATIONS)

LEGEND (APPLIES TYPICALLY THROUGHOUT PLAN SHEETS)		
DIRT/GRASS DRIVEWAY	FIRE HYDRANT & GV.	
CONCRETE DRIVEWAY	POST HYDRANT & GV.	
ASPHALT DRIVEWAY	GATE VALVE	
REINFORCED CONCRETE PIPE (RCP)	WATER SERVICE	
TELEPHONE PEDESTAL	REDUCER	
	RESIDENCE TO RECEIVE WATER SERVICE	
	ELECTRIC POWER POLE	


SCALE: 1" = 50'
25 0 50 100 150 FEET

THESE DRAWINGS REFLECT
AS-BUILT
CONDITIONS
REVIEWED BY: *Donald W. Lee* 6/10/07
DISSECTIONS
REVIEWED BY: *Jason Port* 6/14/07
ENGINEERING
GRAND STRAND WATER AND SEWER AUTHORITY

REVISION	DATE
BY	REF
ASBUILT	MAY 2007

GRAND STRAND
WATER & SEWER
AUTHORITY
170 JACKSON BLUFF RD.
PO BOX 2398
CONWAY, SC 29524
(843) 347-4684 OR 445-1886
(843) 347-4685 (FAX)
E-MAIL: GSWA@GSA.COM

**EAST WATERLINE TRANSMISSION
EXT.**
(LOCATED ALONG HWY 544)
PROJ. #475-01/CONT. #W

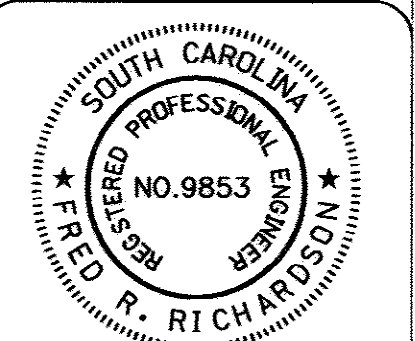


DATE:	JULY 2002
SCALE:	1" = 50'
FILENAME:	sheet2.dgn
DRAWN BY:	CHANDUS PORTER
CHECKED BY:	JIM HEMBREE
APPROVED BY:	
FRED R. RICHARDSON	PE #9853
SHEET 3 OF 5	
DWG # 17-153-0035-W	


EAST WATERLINE TRANSMISSION EXT.

1860001003

HWY 544 RELOC.
REF.# 17-098-006

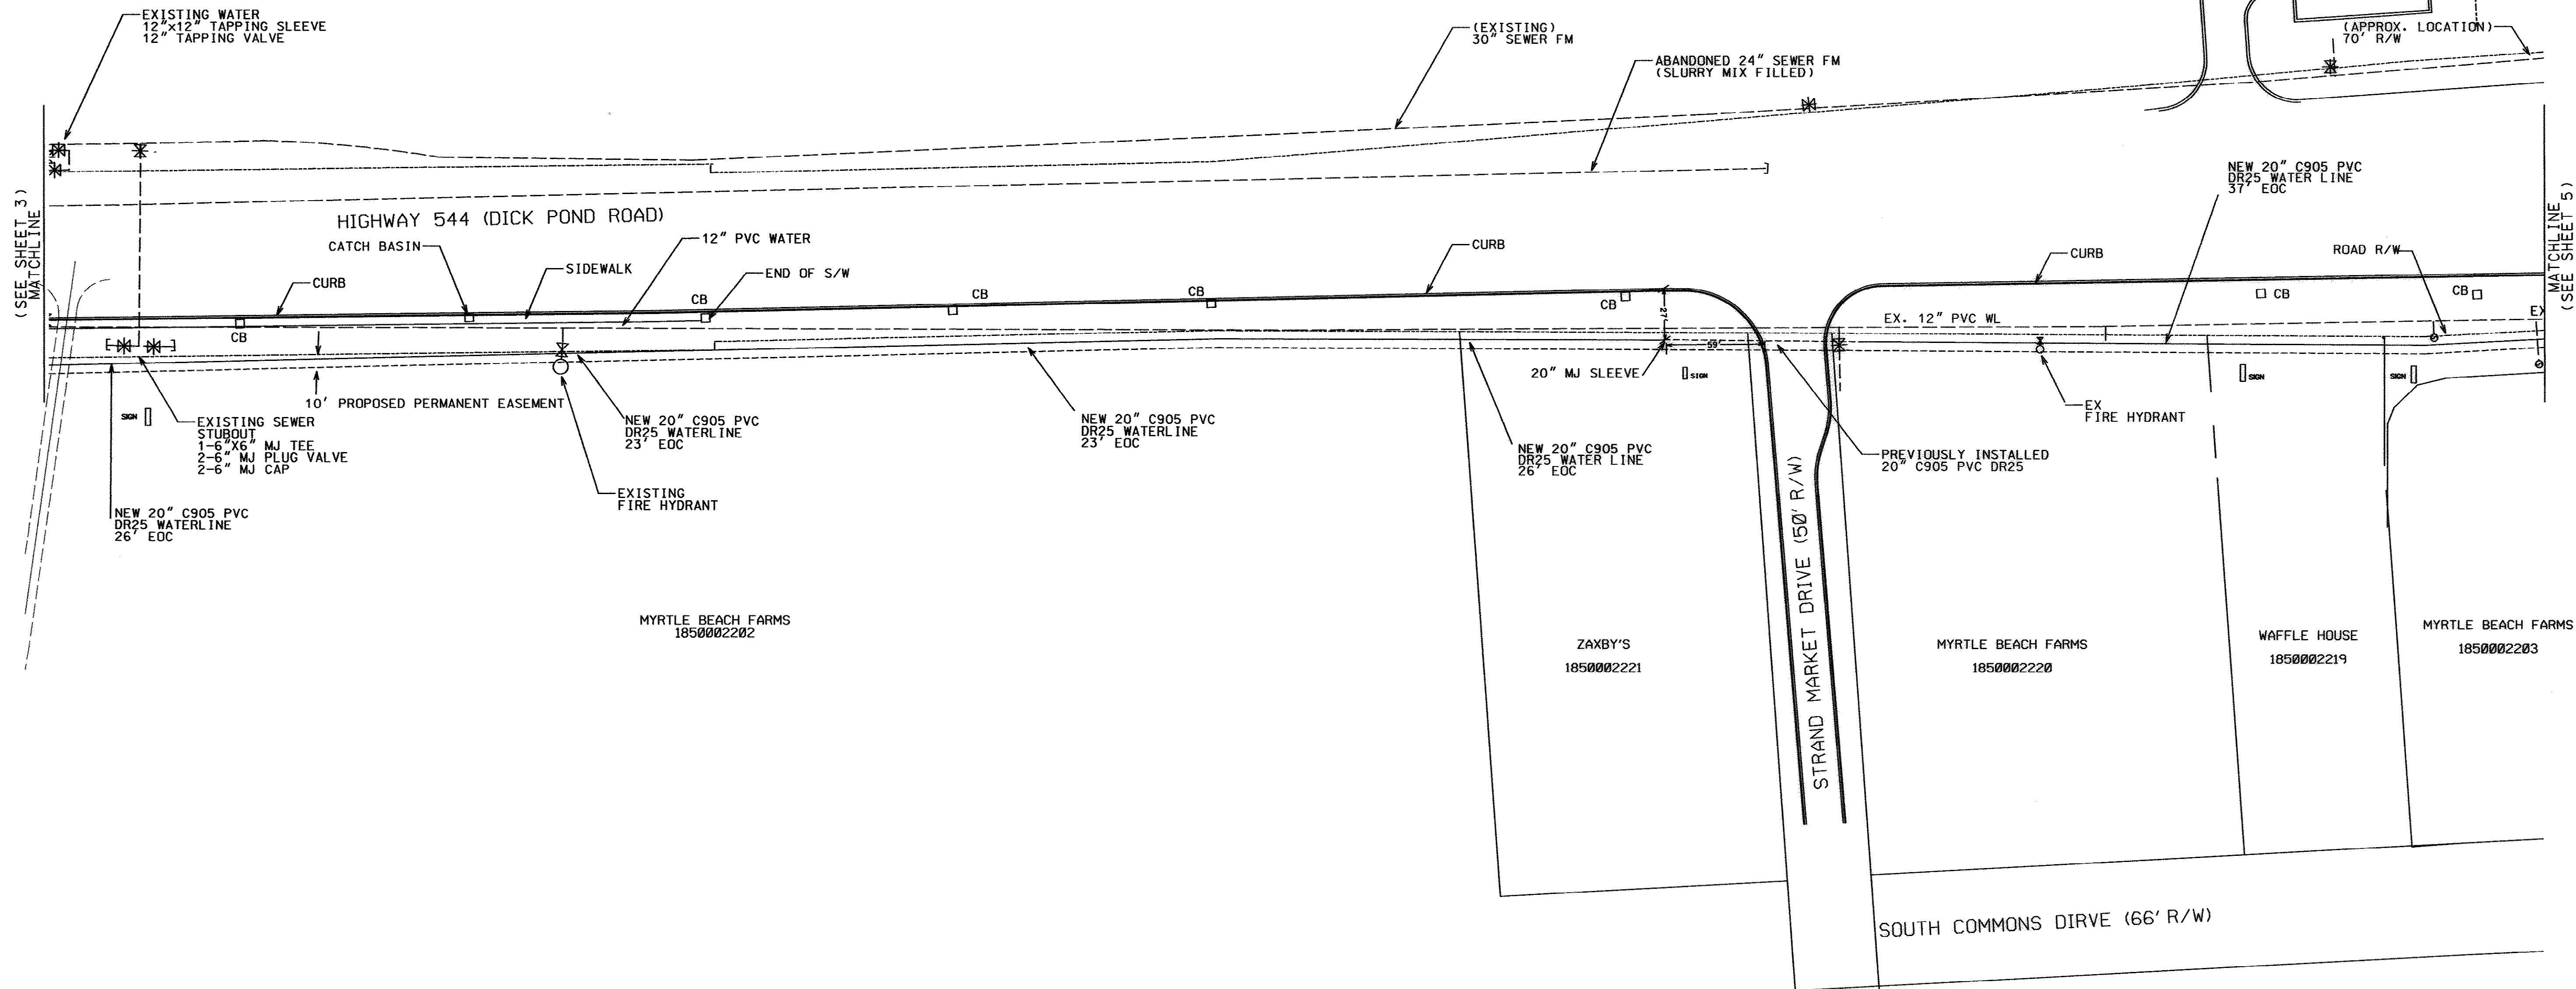

LEGEND (APPLIES TYPICALLY THROUGHOUT PLAN SHEETS)			
DIRT/GRASS DRIVEWAY		FIRE HYDRANT & GV.	
CONCRETE DRIVEWAY		POST HYDRANT & GV.	
ASPHALT DRIVEWAY		GATE VALVE	
REINFORCED CONCRETE PIPE (RCP)		WATER SERVICE	
TELEPHONE PEDESTAL		REORDER	
		RESIDENCE TO RECEIVE WATER SERVICE	
		ELECTRIC POWER POLE	

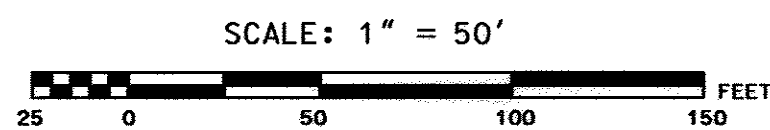

THESE DRAWINGS REFLECT
AS-BUILT
CONDITIONS

REVIEWED BY: *Donald W. Fleenor* 6/16/17
INSPECTIONS DATE

REVIEWED BY: *Jim Hembree* 6/16/17
ENGINEERING DATE

APPROVED BY: _____
GRAND STRAND WATER AND SEWER AUTHORITY

EAST WATERLINE TRANSMISSION EXT.

REVISION	DATE
BY	REP
ASBUILT	MAY 2007

GRAND STRAND WATER & SEWER AUTHORITY

170 JACKSON BLUFF RD.
CONWAY, SC 29525-2368
(843) 347-4641 OR 448-1666
FAX: (843) 347-4640
E-MAIL: GSWA@GSA.COM

EAST WATERLINE TRANSMISSION EXT.
(LOCATED ALONG HWY 544)
PROJ. #475-01/CONT. #W

SOUTH CAROLINA REGISTERED PROFESSIONAL ENGINEER
NO. 9853
FRED R. RICHARDSON

DATE: JULY 2002
SCALE: 1" = 50'
FILENAME: sheet3.dgn

DRAWN BY: CHANDUS PORTER
CHECKED BY: JIM HEMBREE
APPROVED BY: _____

FRED R. RICHARDSON PE #9853
SHEET 4 OF 5
DWG # 17-153-0045-W

