




REVISION	BY	DATE
MODIFIED FITTINGS AT S.C. HWY. 544 BORE AND JACK TO MEET CONDITIONS	REP	2/2/2007
ARV ADDITIONS AND CONSTRUCTION NOTES	REP	2/2/2007
TIE IN CONDITIONS FOR 20" WL CONTINUATION	REP	6/19/2007
AS-BUILT	REP	JUNE 2008

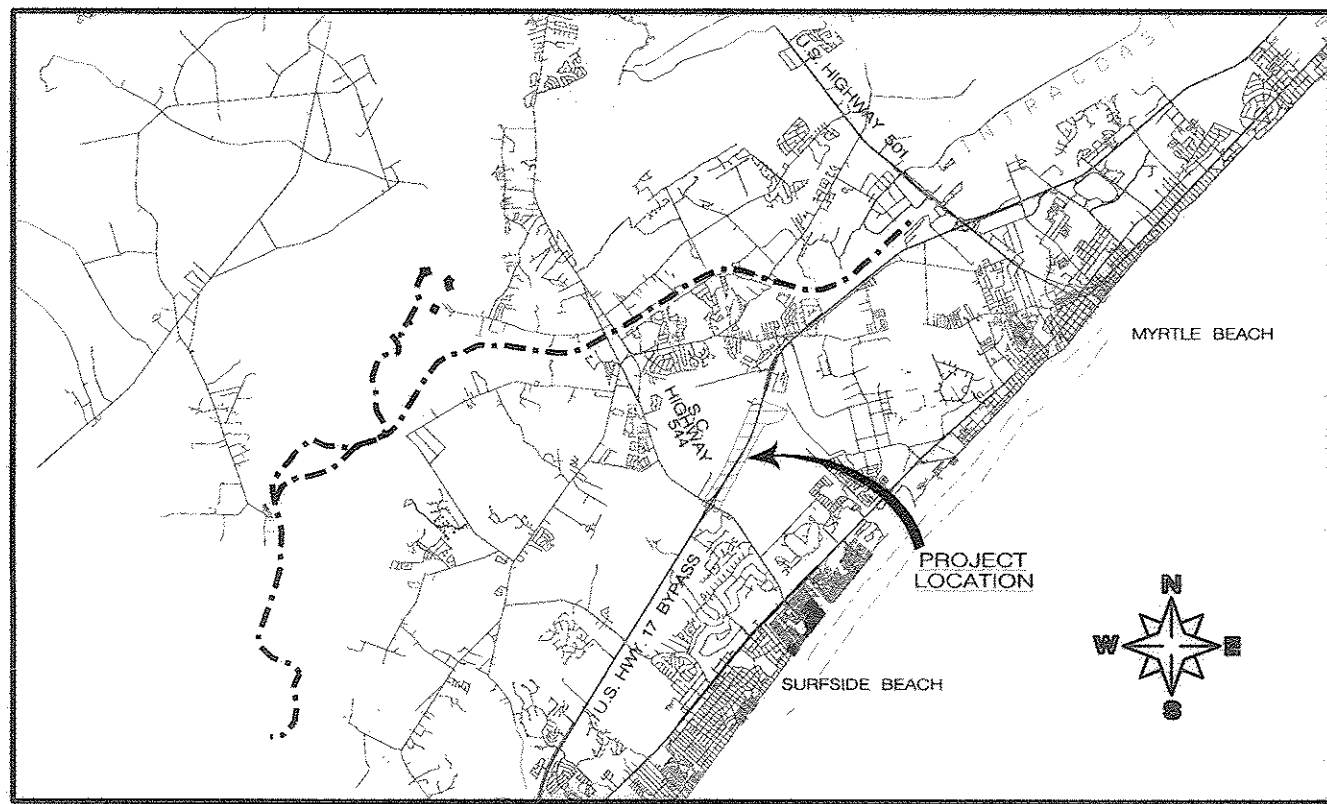

GRAND STRAND
WATER & SEWER
AUTHORITY

170 JACKSON BLUFF RD.
CONWAY, SC 29528-2968
(843) 347-4041 OR 448-1686

S.C. HIGHWAY 544 TO
TPI ELEVATED TANK
20" WATER MAIN
(ALONG U.S. HIGHWAY 17 BY-PASS)
PROJ. # 526-01

PROJ. # 526-01

DATE: FEBRUARY 2007

SCALE: 1" = 100 FEET

FILENAME: SC 544 to TPI ELEVATED TANK

DRAWN BY	ROBERT PERKINS
CHECKED BY	JASON POSTON

CHRISTINA S. EVERETT PE #2125

SHEET 1 OF 3

DWG # 20-226-0013-W





THESE DRAWINGS REFLECT
AS-BUILT
CONDITIONS

REVIEWED BY: Bob White 7-2-08
INSPECTIONS DATE

REVIEWED BY: James B. [Signature] 7-8-08
ENGINEERING DATE

GRAND STRAND WATER AND SEWER AUTHORITY

S.C. HIGHWAY 544 TO TPI ELEVATED TANK – 20" WATER MAIN

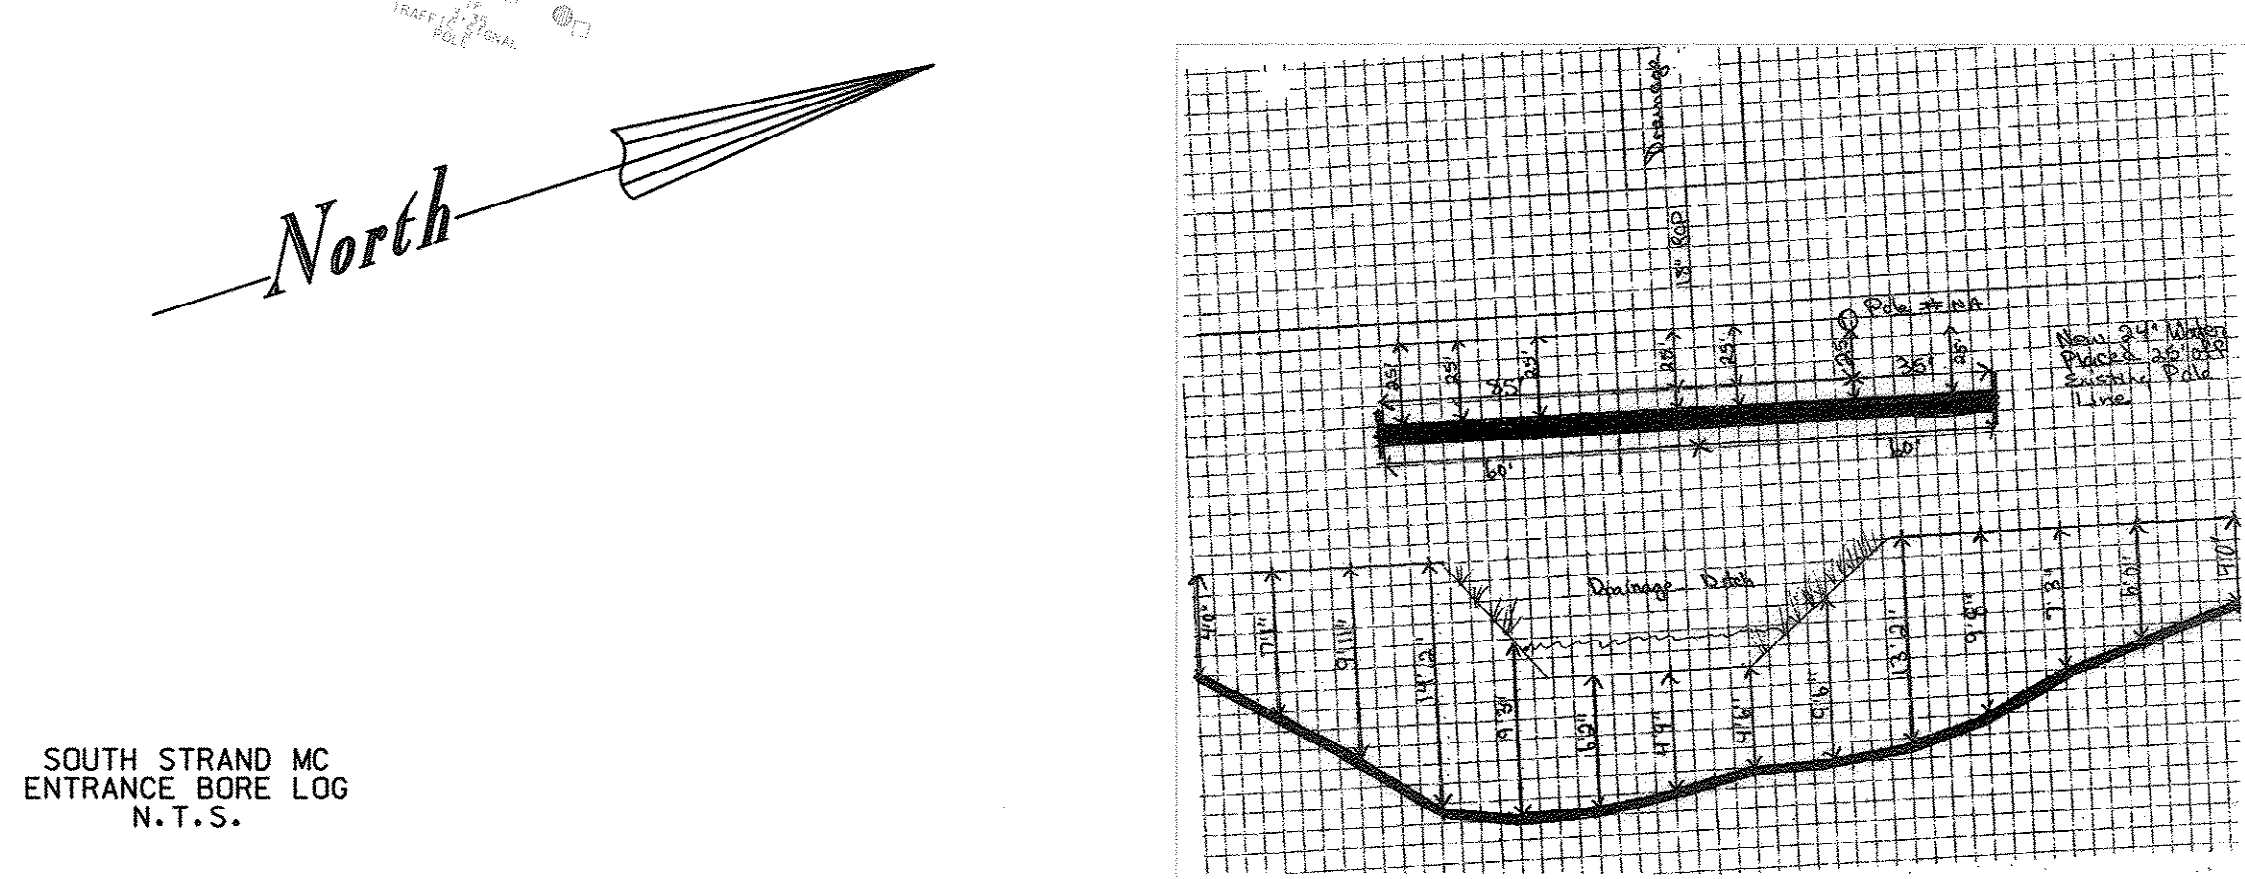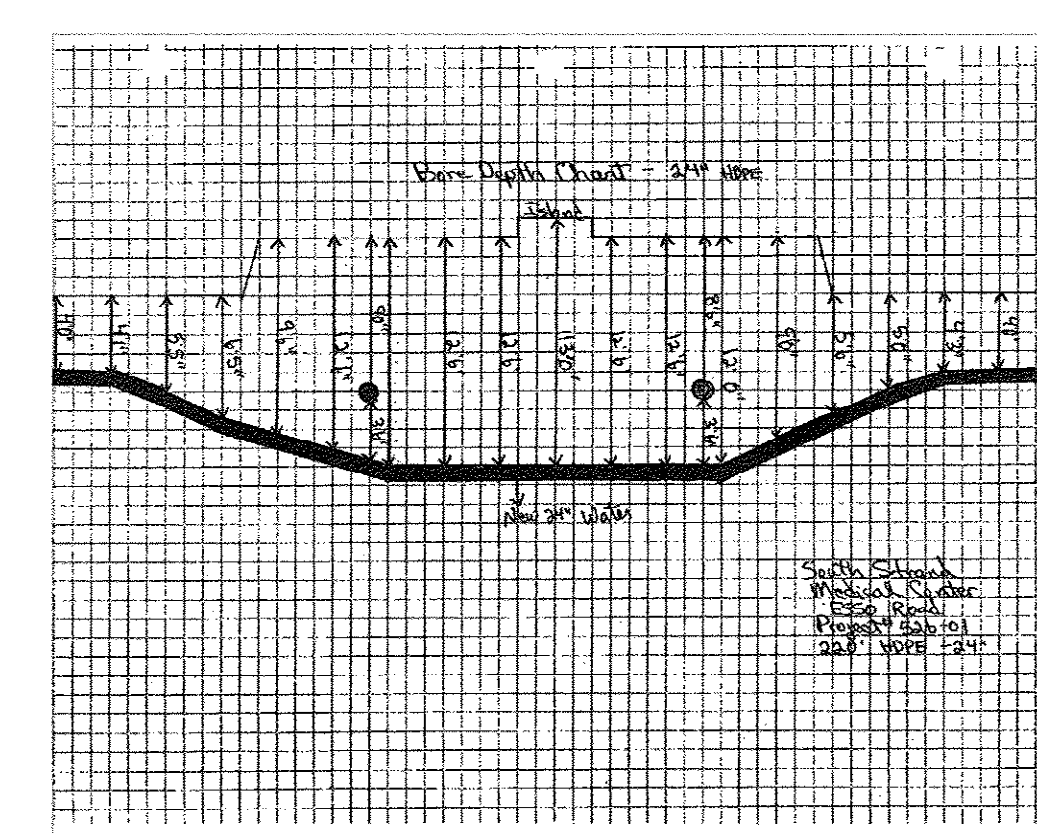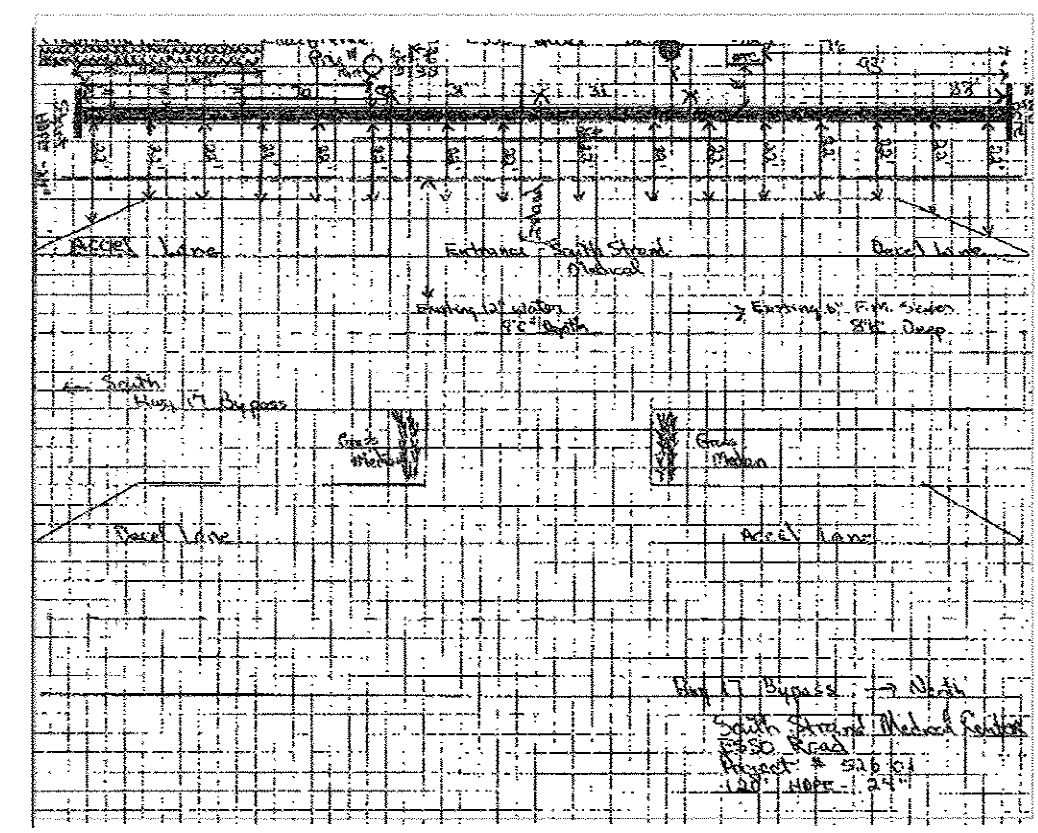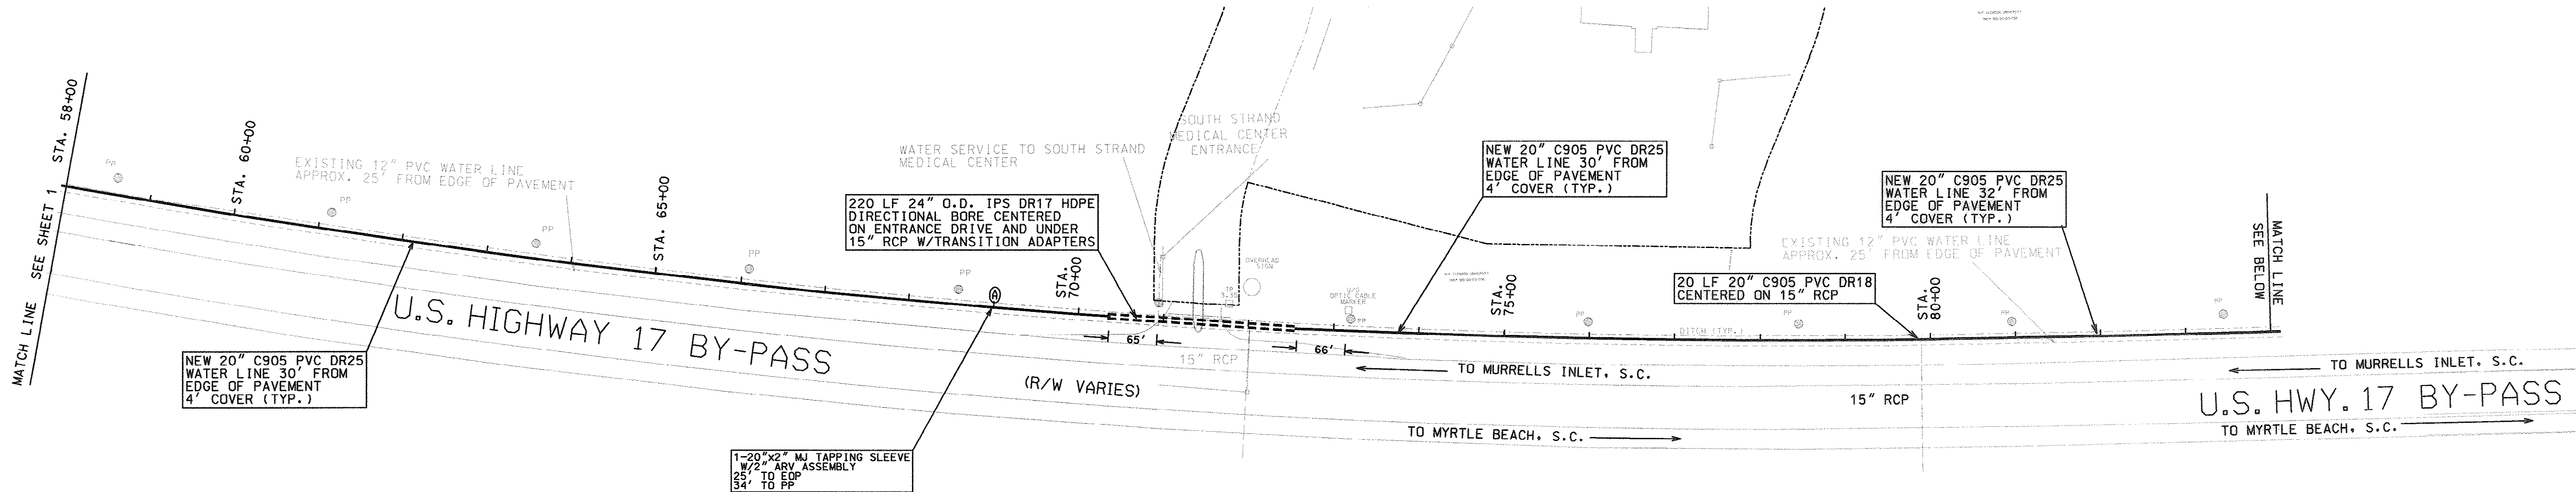

THESE DRAWINGS REFLECT
AS-BUILT
CONDITIONS





REVIEWED BY *Belknap* 7-2-08
INSPECTIONS DATE

REVIEWED BY *Jason Post* 7-8-08
ENGINEERING DATE

GRAND STRAND WATER AND SEWER AUTHORITY

SCALE: 1" = 100'

50 0 100 200 300 FEET

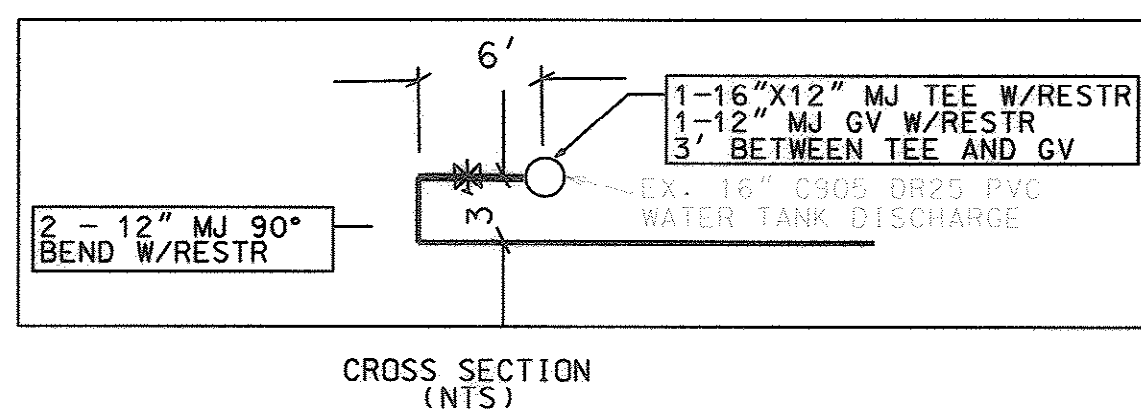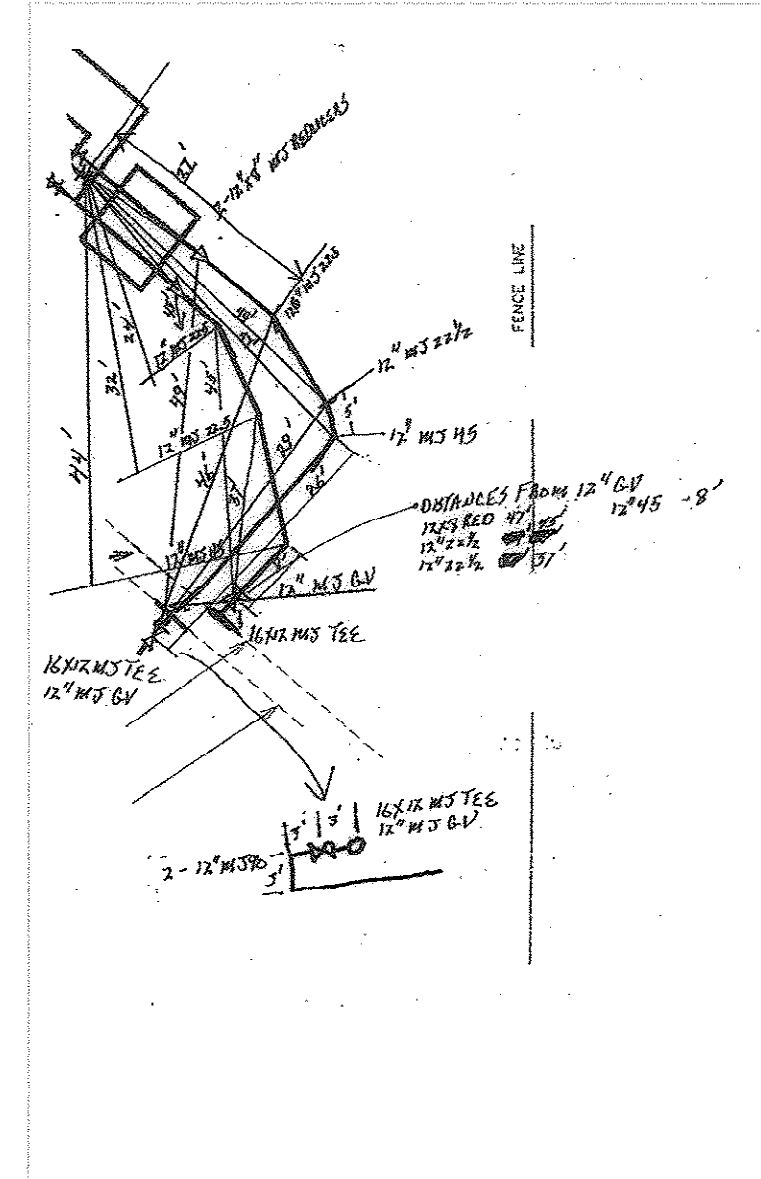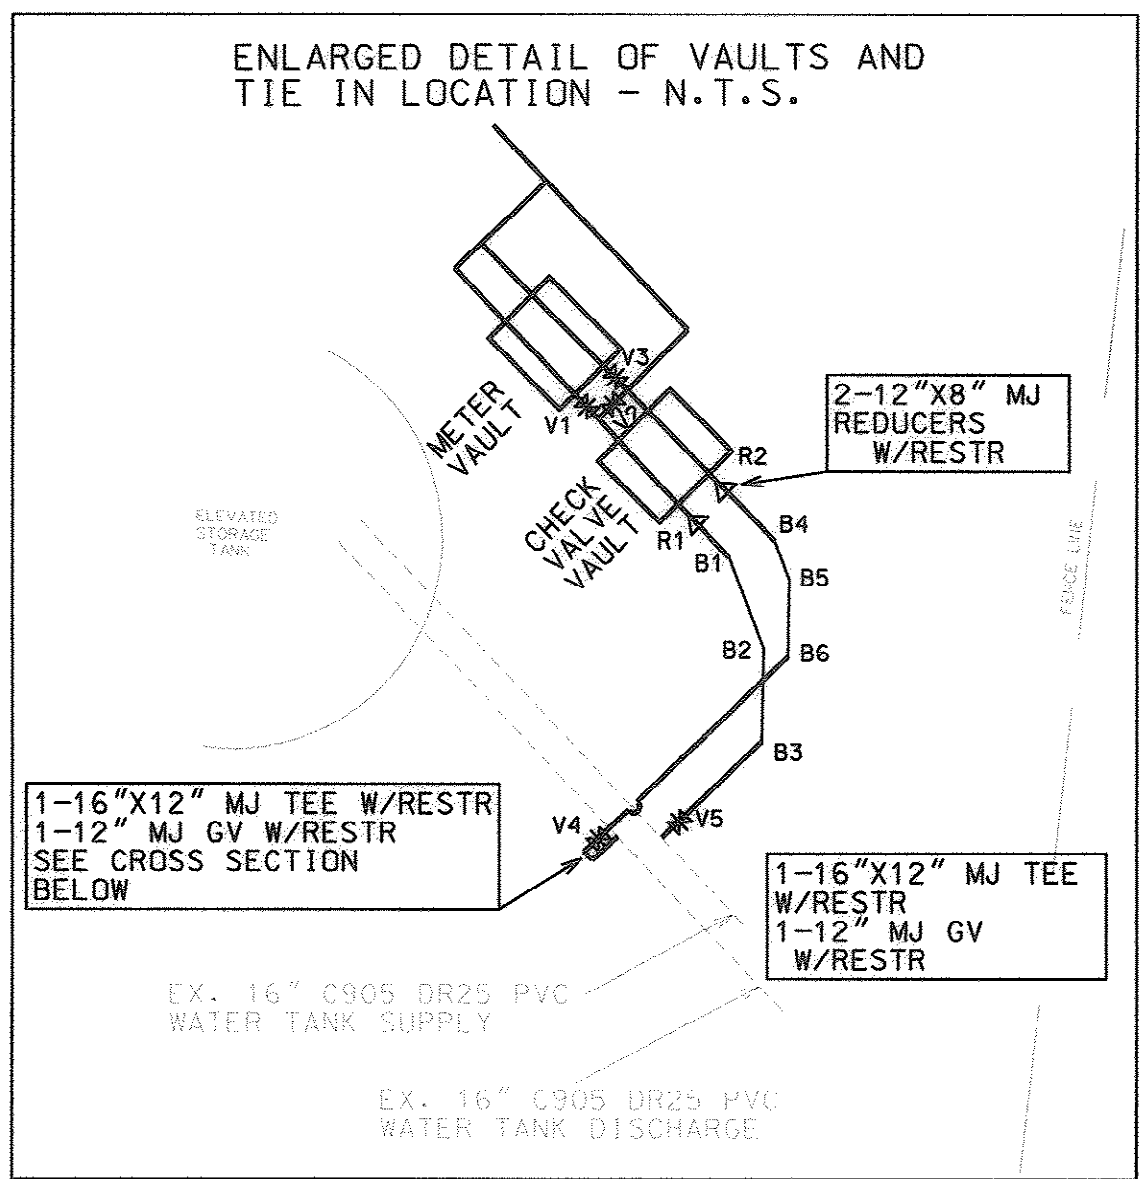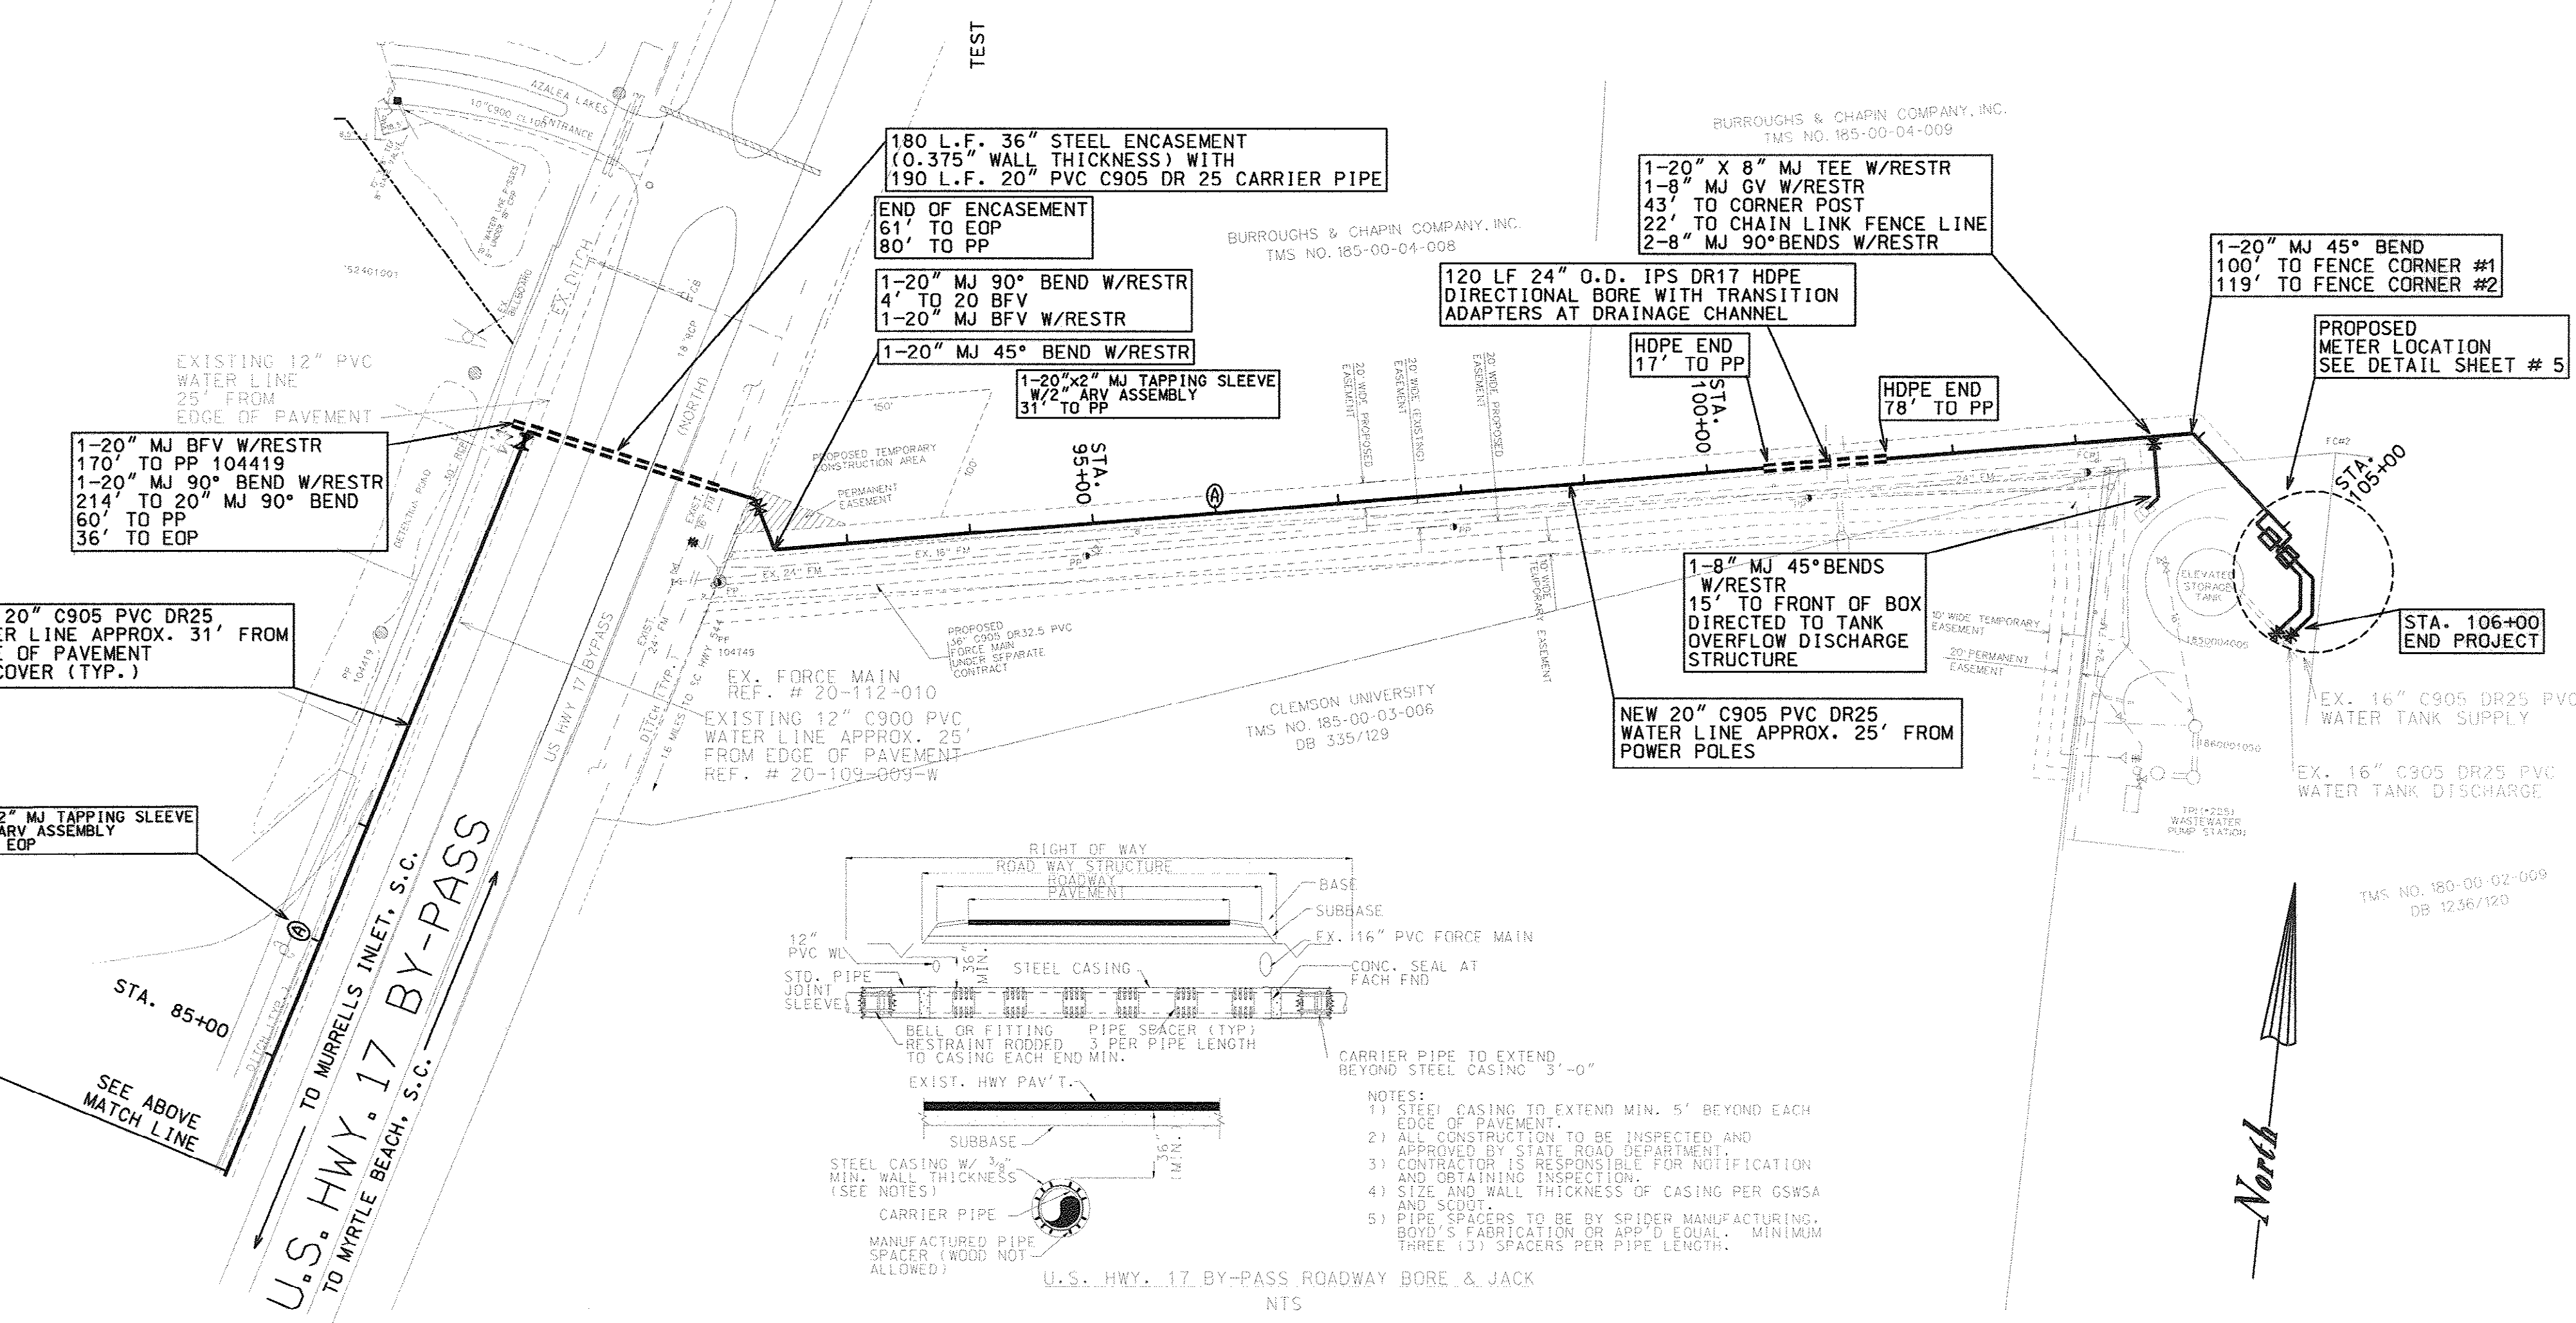

SCALE: 1" = 100'

50 0 100 200 300 FEET

REVISION	DATE	BY	APP'D
1	FEB 2007	REP	
2	JUNE 2007	REP	
3	AUG 2007	REP	
4	JAN 2008	REP	

ANY ADDITIONAL REVISIONS TO THESE DRAWINGS AT CONNECTION AND DISSEMINATION OF HOPE DITCH CROSSING METER VALVE CHANGE AT ELEV. TANK 8" COMPOUND METER CHANGES ASUILT

GRAND STRAND WATER & SEWER AUTHORITY

170 JACKSON BLUFF RD
P.O. BOX 2268
CONWAY, SC 29524
(843) 347-4641 OR 448-1886
FAX: (843) 347-4685 (FAX)
CIVIL@GSAWSA.COM

S.C. HIGHWAY 544 TO TPI ELEVATED TANK 20" WATER MAIN (ALONG U.S. HIGHWAY 17 BY-PASS)

PROJ. # 526-01

DATE: FEBRUARY 2007
SCALE: 1" = 100 FEET
FILENAME: SC 544 TO TPI ELEVATED TANK

DRAWN BY: ROBERT PERKINS
CHECKED BY: JASON POSTON
APPROVED BY: CHRISTINA S. EVERETT PE #21255

SHEET 2 OF 3
DWG # 20-226-0023-W



DATE: FEBRUARY 2007	
SCALE: AS NOTED	
FILENAME: DETAILS	
DRAWN BY	ROBERT E. PERKINS
CHECKED BY	JASON POSTON
APPROVED BY	
CHRISTINA S. EVERETT	PE #21255
SHEET 3 OF 3	
DWG # 20-226-0033-W	



**GRAND STRAND
WATER & SEWER
AUTHORITY**

170 JACKSON BLUFF RD.
PO BOX 2908
CONWAY, SC 29528-2908

(843) 347-6641 FAX 448-1066
(843) 347-6850 (TDD)

REVISION	BY	DATE
8" COMPOUND METERS PER CITY OF MB	REP	AUG. 2007
ASBUILT	REP	JUNE 2008