

GRAND STRAND WATER & SEWER AUTHORITY

SURFACE WATER TREATMENT PROJECT

SURFSIDE TRANSMISSION LINE



GENERAL NOTES:

1. ALL EXISTING DITCHES TO BE RECONSTRUCTED AS NECESSARY TO ALLOW PROPER PIPELINE INSTALLATION, CLEARANCE, AND DEPTH OF COVER.
2. MINIMUM DEPTH OF COVER SHALL BE 36"
3. EXISTING LINES AND VALVES TO BE FIELD LOCATED BY CONTRACTOR.
4. CONTRACTOR TO VERIFY LOCATION OF ALL EXISTING UTILITIES BEFORE BEGINNING CONSTRUCTION. INFORMATION ON EXISTING UTILITIES SHOWN ON THE DRAWINGS IS FOR INFORMATIONAL PURPOSES ONLY, NO RESPONSIBILITY IS ASSUMED BY GSW&SA OR THE ENGINEER FOR THE ACCURACY OR COMPLETENESS OF THIS INFORMATION.
5. ALL MATERIAL, WORKMANSHIP, CONSTRUCTION AND TESTING SHALL CONFORM TO THE GSW&SA STANDARD PLANS AND SPECIFICATIONS.
6. DISTANCE BETWEEN MAIN LINE GATE VALVES ARE APPROXIMATE: LOCATION OF GATE VALVES TO BE DETERMINED BY GSW&SA.
7. THE GSW&SA WILL SECURE ALL NECESSARY ENCROACHMENT AND TRENCH PERMITS FROM APPLICABLE PUBLIC AGENCIES.
8. NO CONSTRUCTION SHALL COMMENCE WITHOUT PRIOR APPROVAL OF THE GSW&SA.


PREPARED BY:
GRAND STRAND WATER & SEWER AUTHORITY
PO BOX 1537 CONWAY, SC 29526

APPROVED BY:
Fred R. Richardson
FRED R. RICHARDSON P.E. #9853

28-01-003/003

MATCHLINE SEE SHEET NO. 1
STA. 28 + 63

MATCHLINE SEE THIS SHEET
STA. 42 + 22

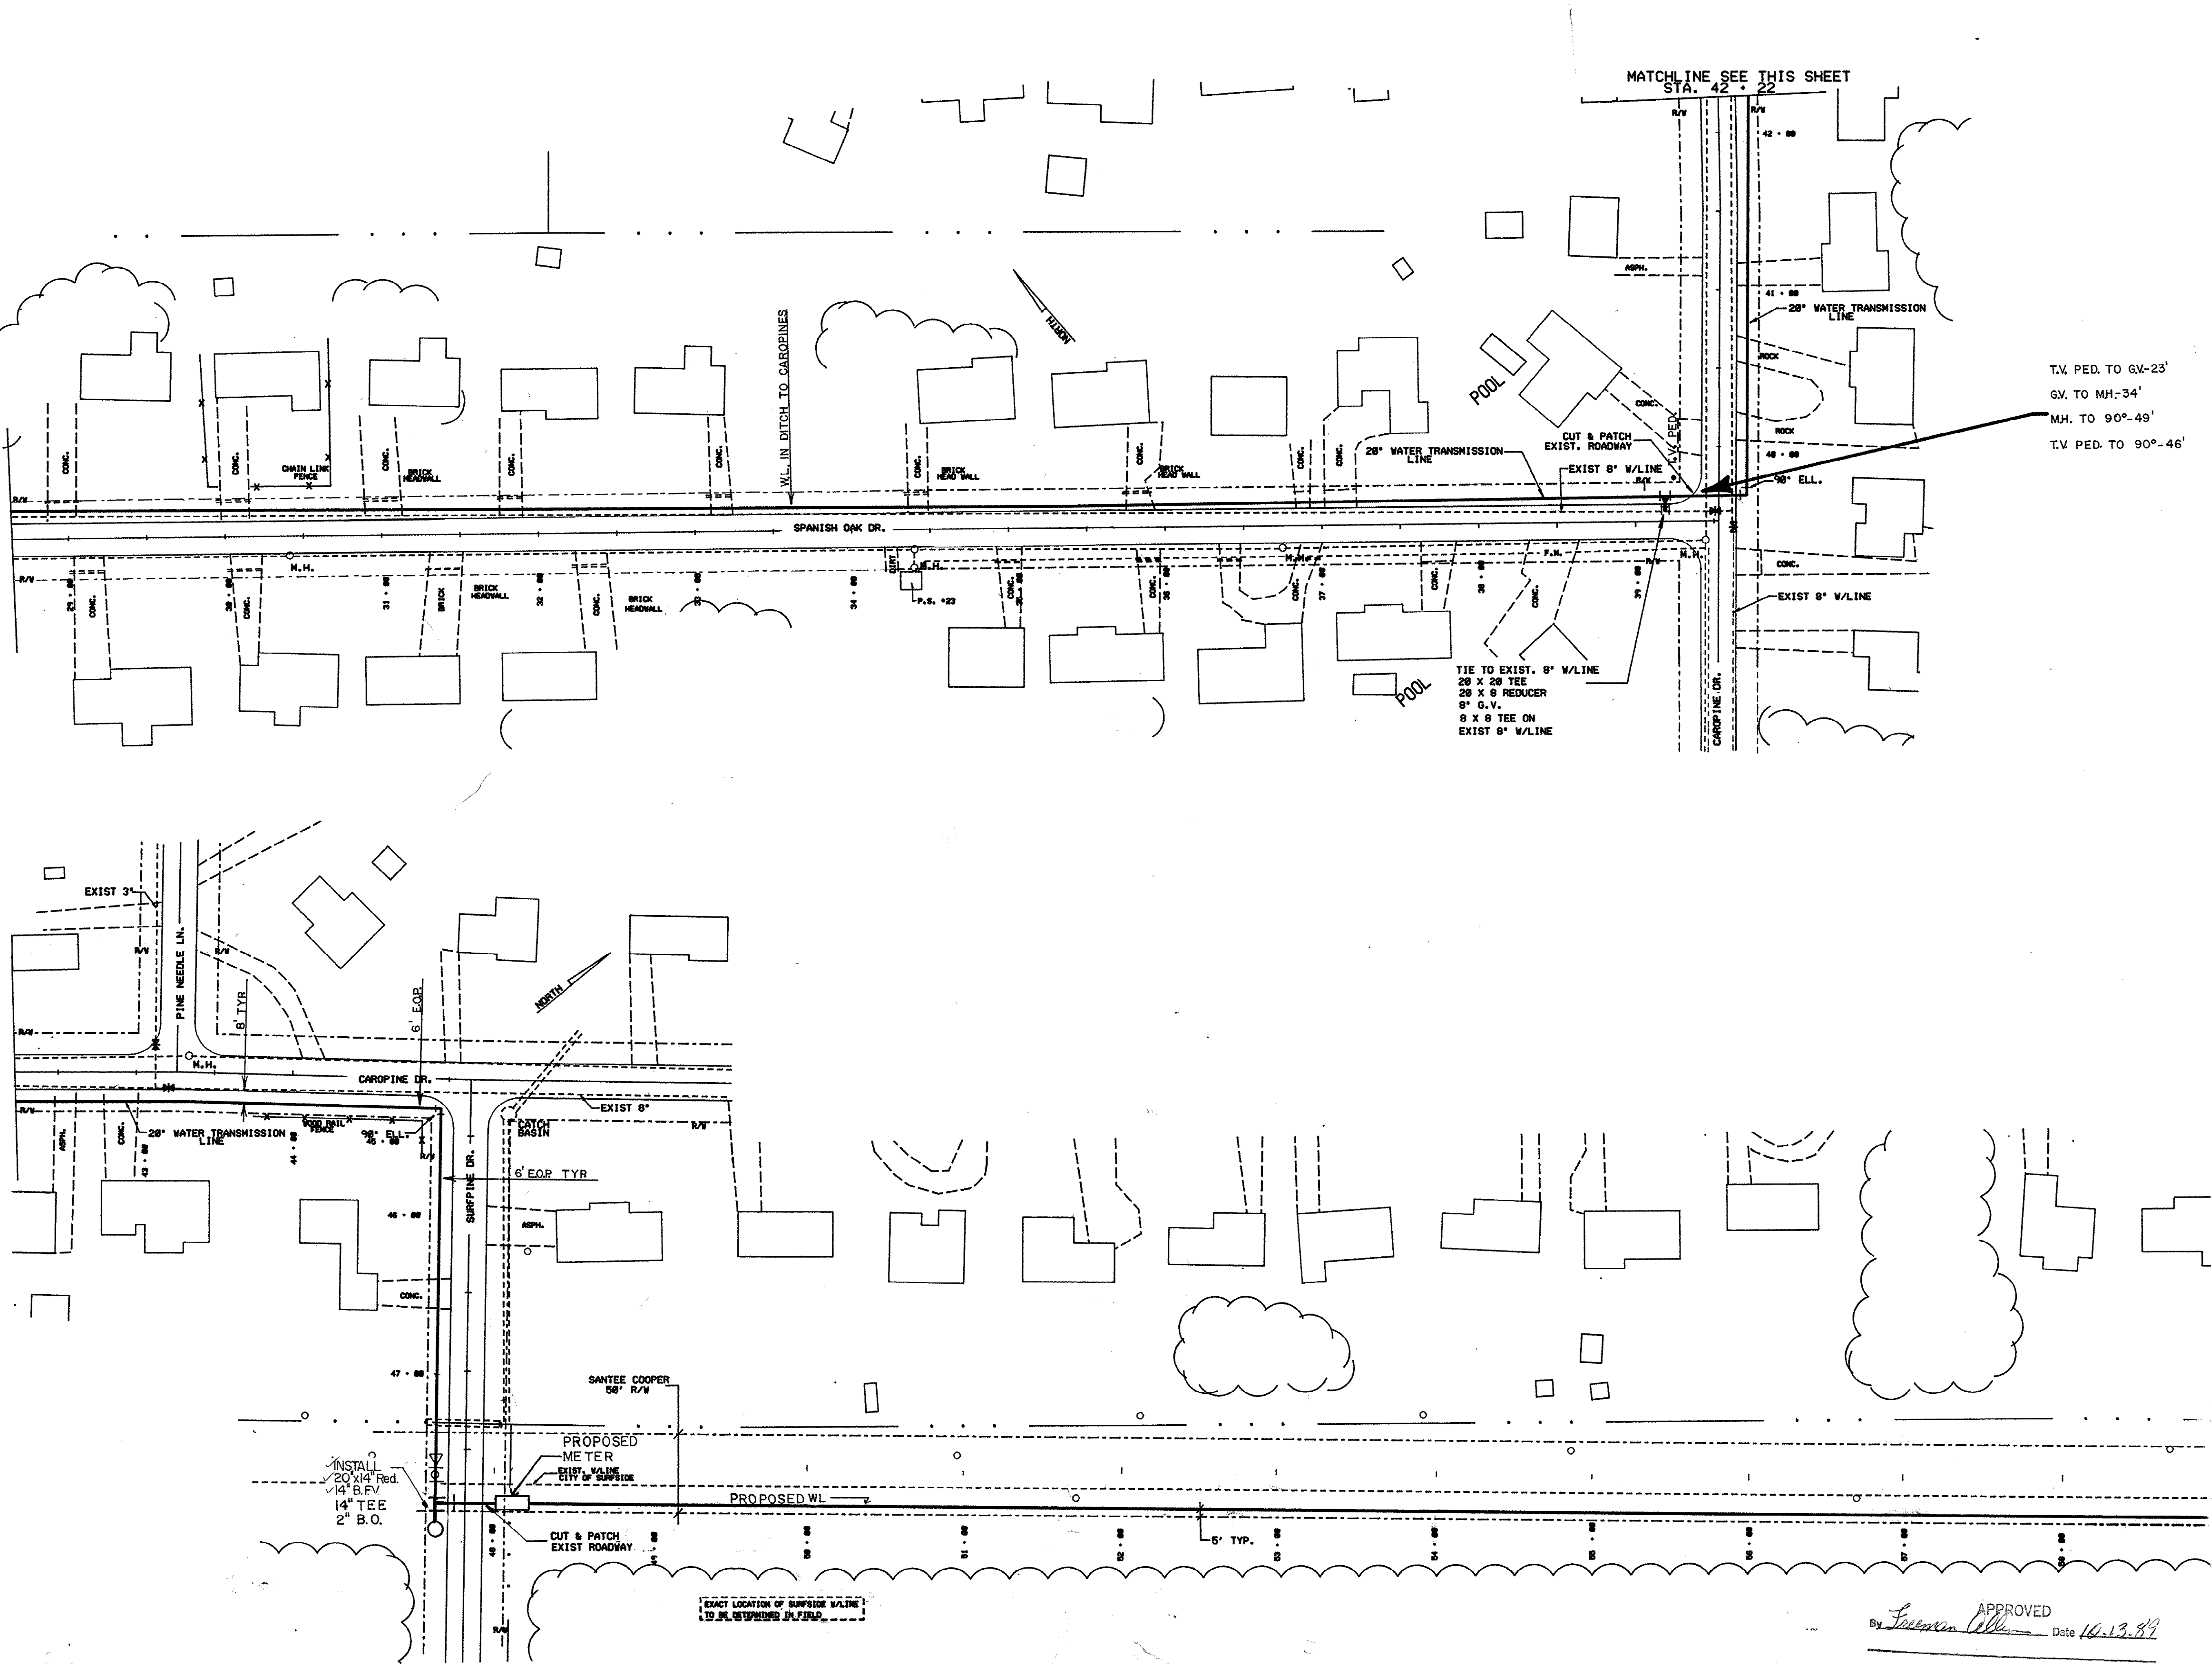

T.V. PED. TO 6W-23'
GV. TO MH-34'
MH. TO 90°-49'
T.V. PED. TO 90°-46'

APPROVED
By *Fred Richardson* Date *10-13-89*

28-01-003/003

REVISION	BY	DATE

SURFSIDE TRANSMISSION LINE

GRAND STRAND WATER & SEWER AUTHORITY

P.O. BOX 1537, CONWAY, S.C. 29526

TELEPHONE (803) 347-4541 OR 448-1686

DATE

FEB. 1989

SCALE

1" = 50'

DRAWN BY

P.W.

CHECKED BY

I.W.

CHECKED BY

J.H.

APPROVED BY

Fred Richardson

FRED RICHARDSON

P.E. NO. 9853

SHEET

2 OF 3

DRAWING NO.