


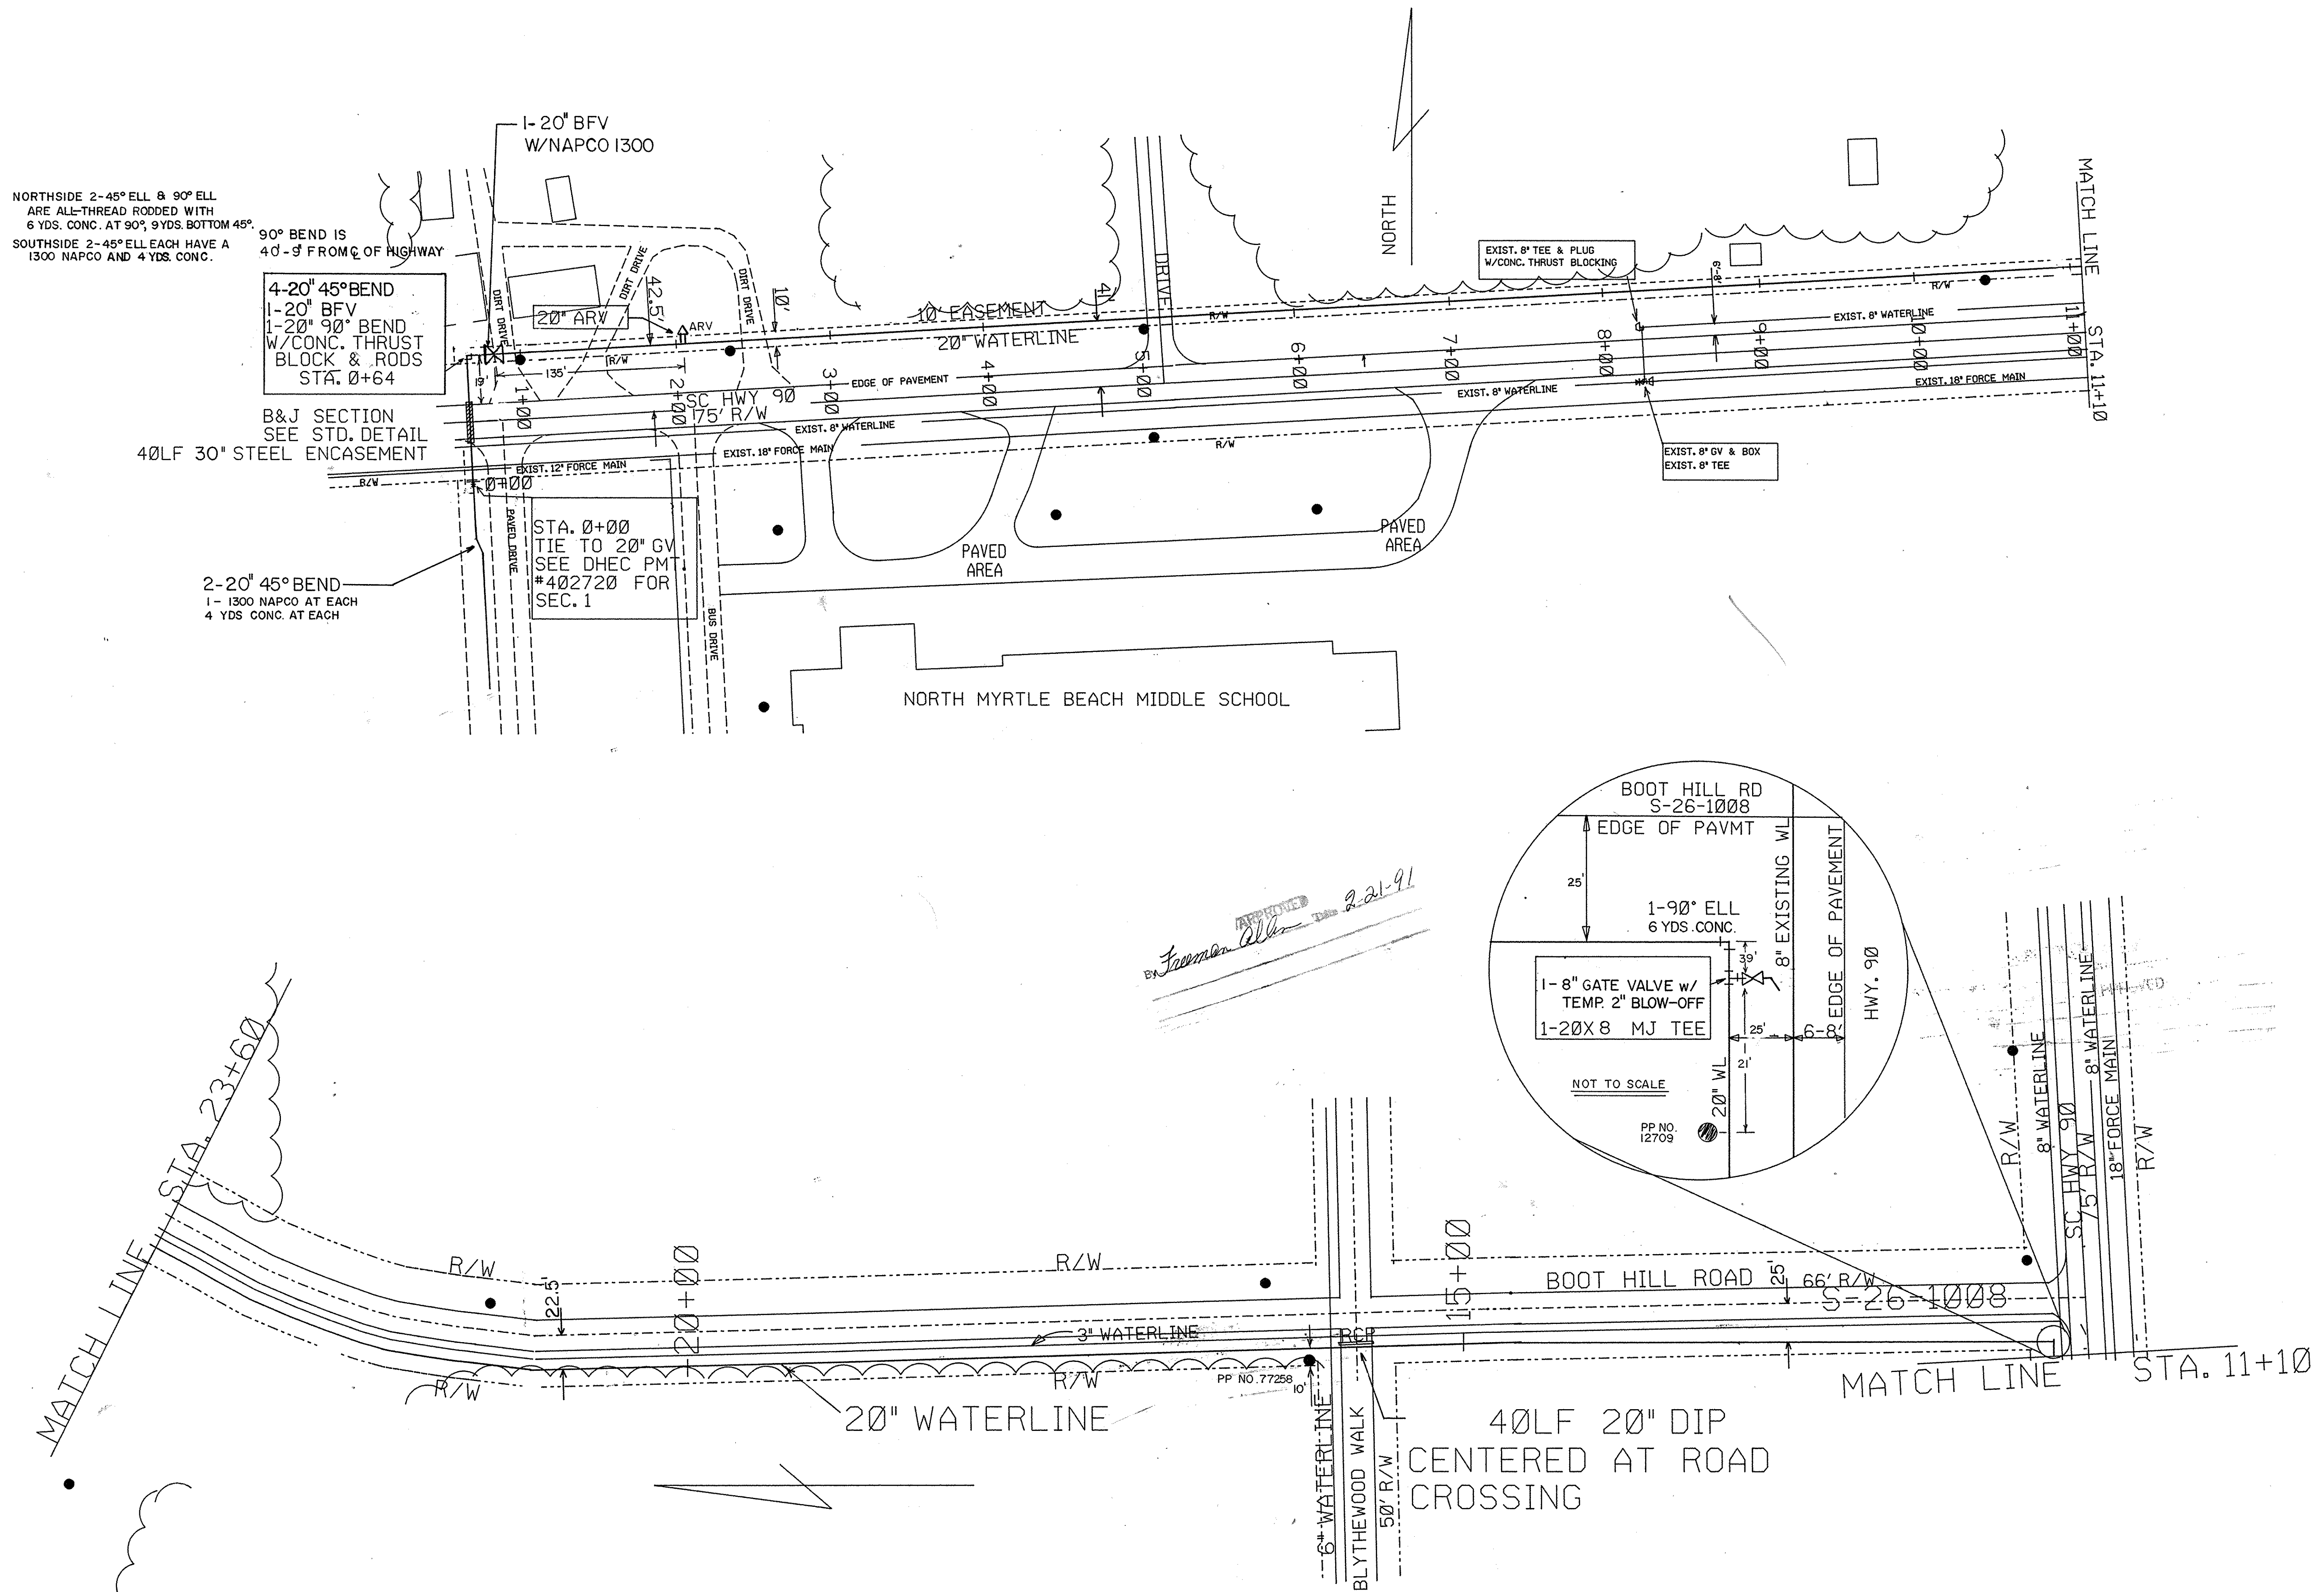

REVISION	BY	DATE
AS - BUILT	REP	12/20/90

SURFACE WATER TREATMENT PROJECT


LITTLE RIVER TRANS. LINE SECTION 2

GRAND STRAND WATER & SEWER AUTHORITY

P.O. BOX 1537, CONWAY, S. C. 29526

TELEPHONE (803) 347-4641 OR 448-1686

DATE	MAY 1990
SCALE	1" = 50'
DRAWN BY	ROBERT PERKINS
CHECKED BY	JIM HEMBREE
APPROVED BY	FRED RICHARDSON
SHEET 1 OF 4	
DRAWING NO. 28-05-004-W	

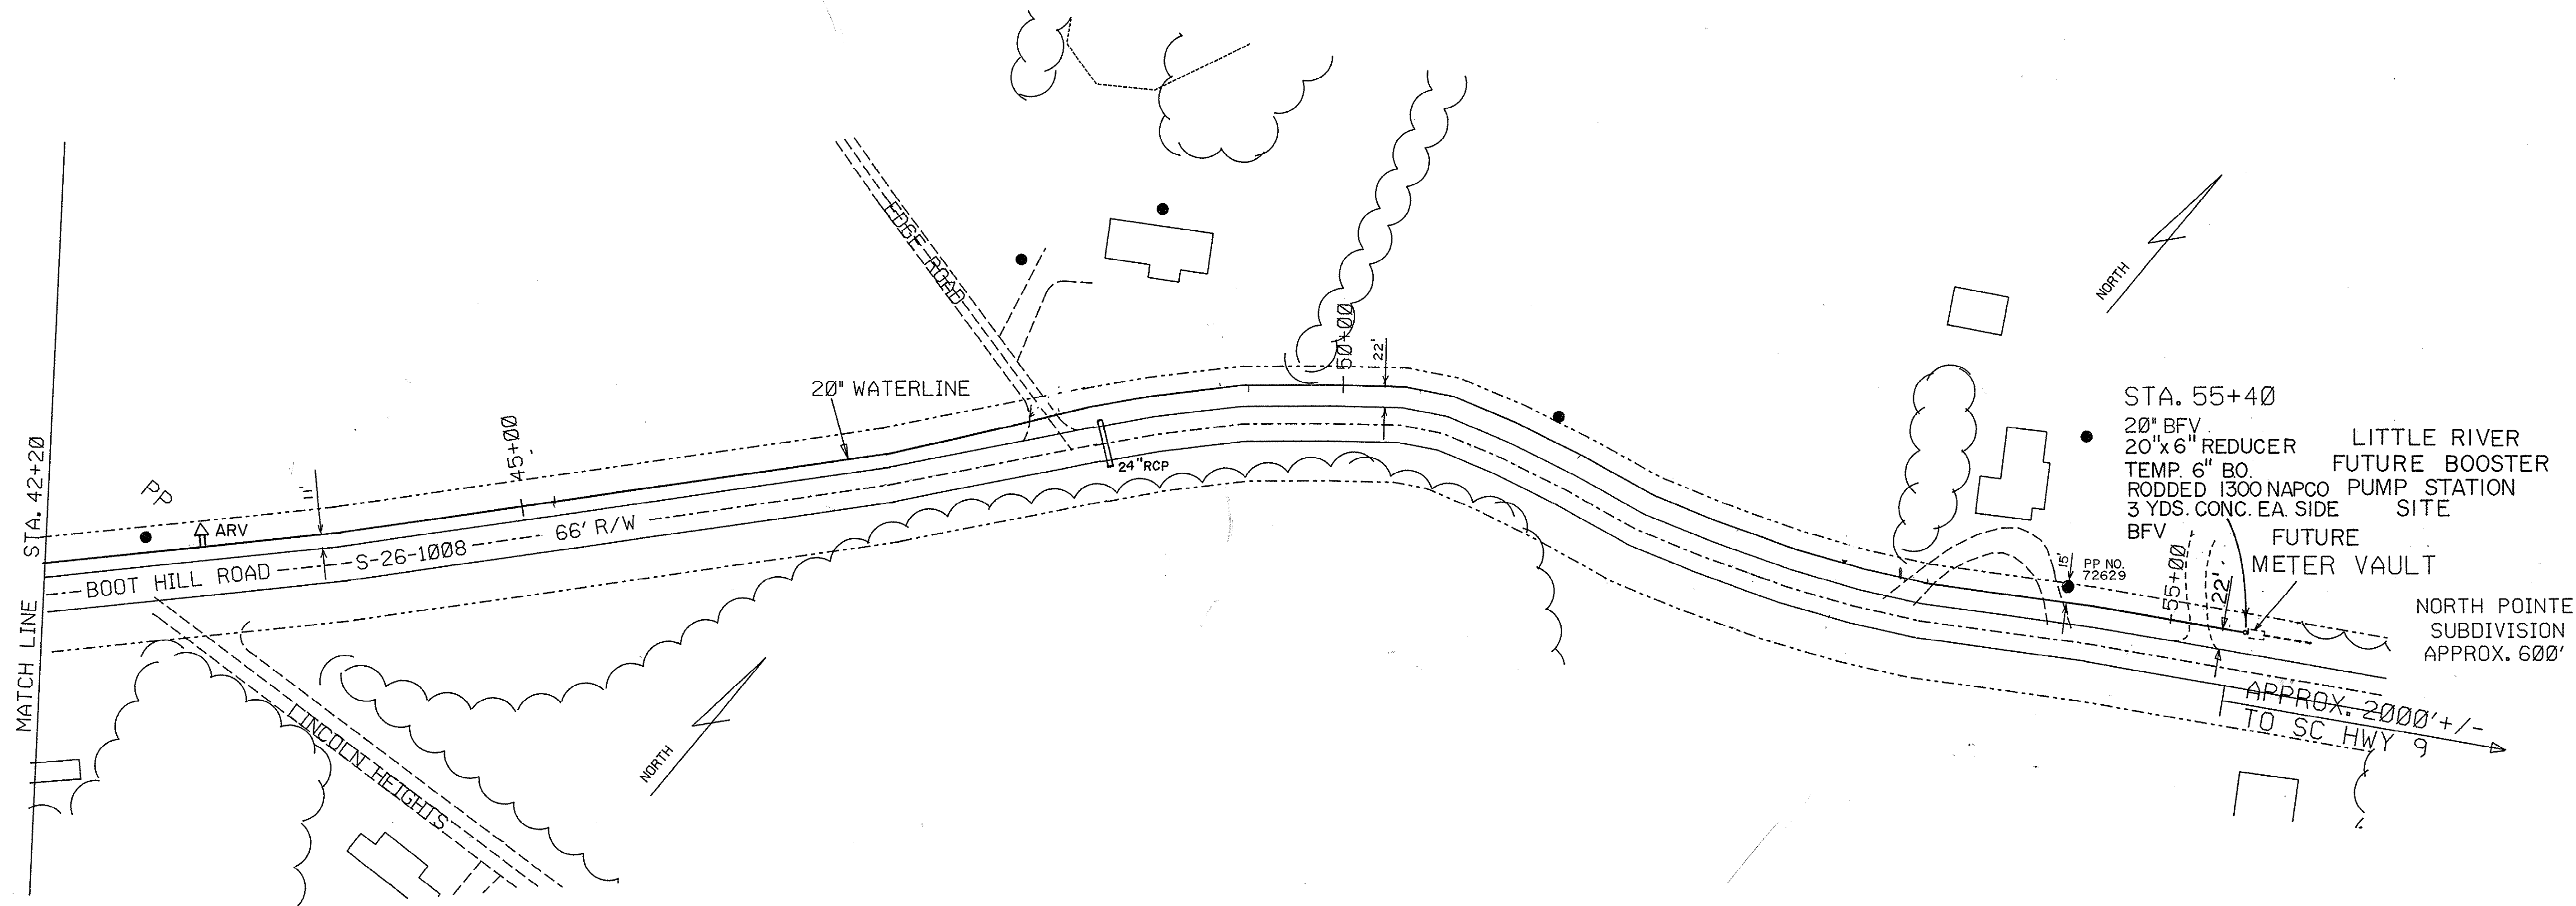

APPROVED
By *Freeman* Date *2-21-91*

GRAND STRAND WATER AND SEWER AUTHORITY AS-BUILT MATERIALS REPORT					
PROJECT: Boot Hill Road Start with end of project					
FITTING	SIZE	TYPE MATERIAL	LOCATION STA. NO.	MANUFACTURER	REMARKS
BFV	20"	D.I. M.J.	55 + 32	M & H	
Tapping Saddle	2" x 20"	---	41 + 86	Romac	for ARV
ARV	2"	---	41 + 86	Apco	
45° bend	20"	D.I. M.J.	39 + 00	Tyler	
Tapping Saddle	2" x 20"	---	30 + 89	Romac	for ARV
ARV	20"	---	30 + 89	Apco	
BFV	20"	D.I. M.J.	29 + 25	M & H	
90° bend	20"	D.I. M.J.	11 + 71	Tyler	
Tee	20" x 8"	D.I. M.J.	11 + 20	Tyler	Temp. B.O.
Tapping Saddle	2" x 20"	---	2 + 00	Romac	for ARV
ARV	20"	---	2 + 00	Apco	
BFV	20"	D.I. M.J.	01 + 70	M & H	
90° bend	20"	D.I. M.J.	01 + 62	Tyler	
45° bend	20"	D.I. M.J.	01 + 32	Tyler	
45° bend	20"	D.I. M.J.	01 + 07	Tyler	
45° bend	20"	D.I. M.J.	00 + 25	Tyler	
45° bend	20"	D.I. M.J.	00 + 00	Tyler	
45° bend	20"	D.I. M.J.	-00 + 75	Tyler	
45° bend	20"	D.I. M.J.	-01 + 00	Tyler	

REVISION	BY	DATE
AS-BUILT	REP	12/20/90

SURFACE WATER TREATMENT PROJECT
LITTLE RIVER TRANS. LINE SECTION 2

GRAND STRAND WATER & SEWER AUTHORITY

P.O. BOX 1537, CONWAY, S. C. 29526
TELEPHONE (803) 347-4641 OR 448-1686

DATE	MAY 1990
SCALE	1" = 50'
DRAWN BY	ROBERT PERKINS
CHECKED BY	JIM HEMBREE
APPROVED BY	<i>Fred Richardson</i>
FRED RICHARDSON	P.E. NO. 9853
SHEET	3 OF 4
DRAWING NO.	28-05-003-W