


THESE DRAWINGS REFLECT  
**AS-BUILT**  
CONDITIONS

REVIEWED BY: \_\_\_\_\_ DATE: \_\_\_\_\_  
INSPECTIONS

REVIEWED BY: *Jason Poston* DATE: *2/19/10*  
ENGINEERING - JASON POSTON

GRAND STRAND WATER AND SEWER AUTHORITY

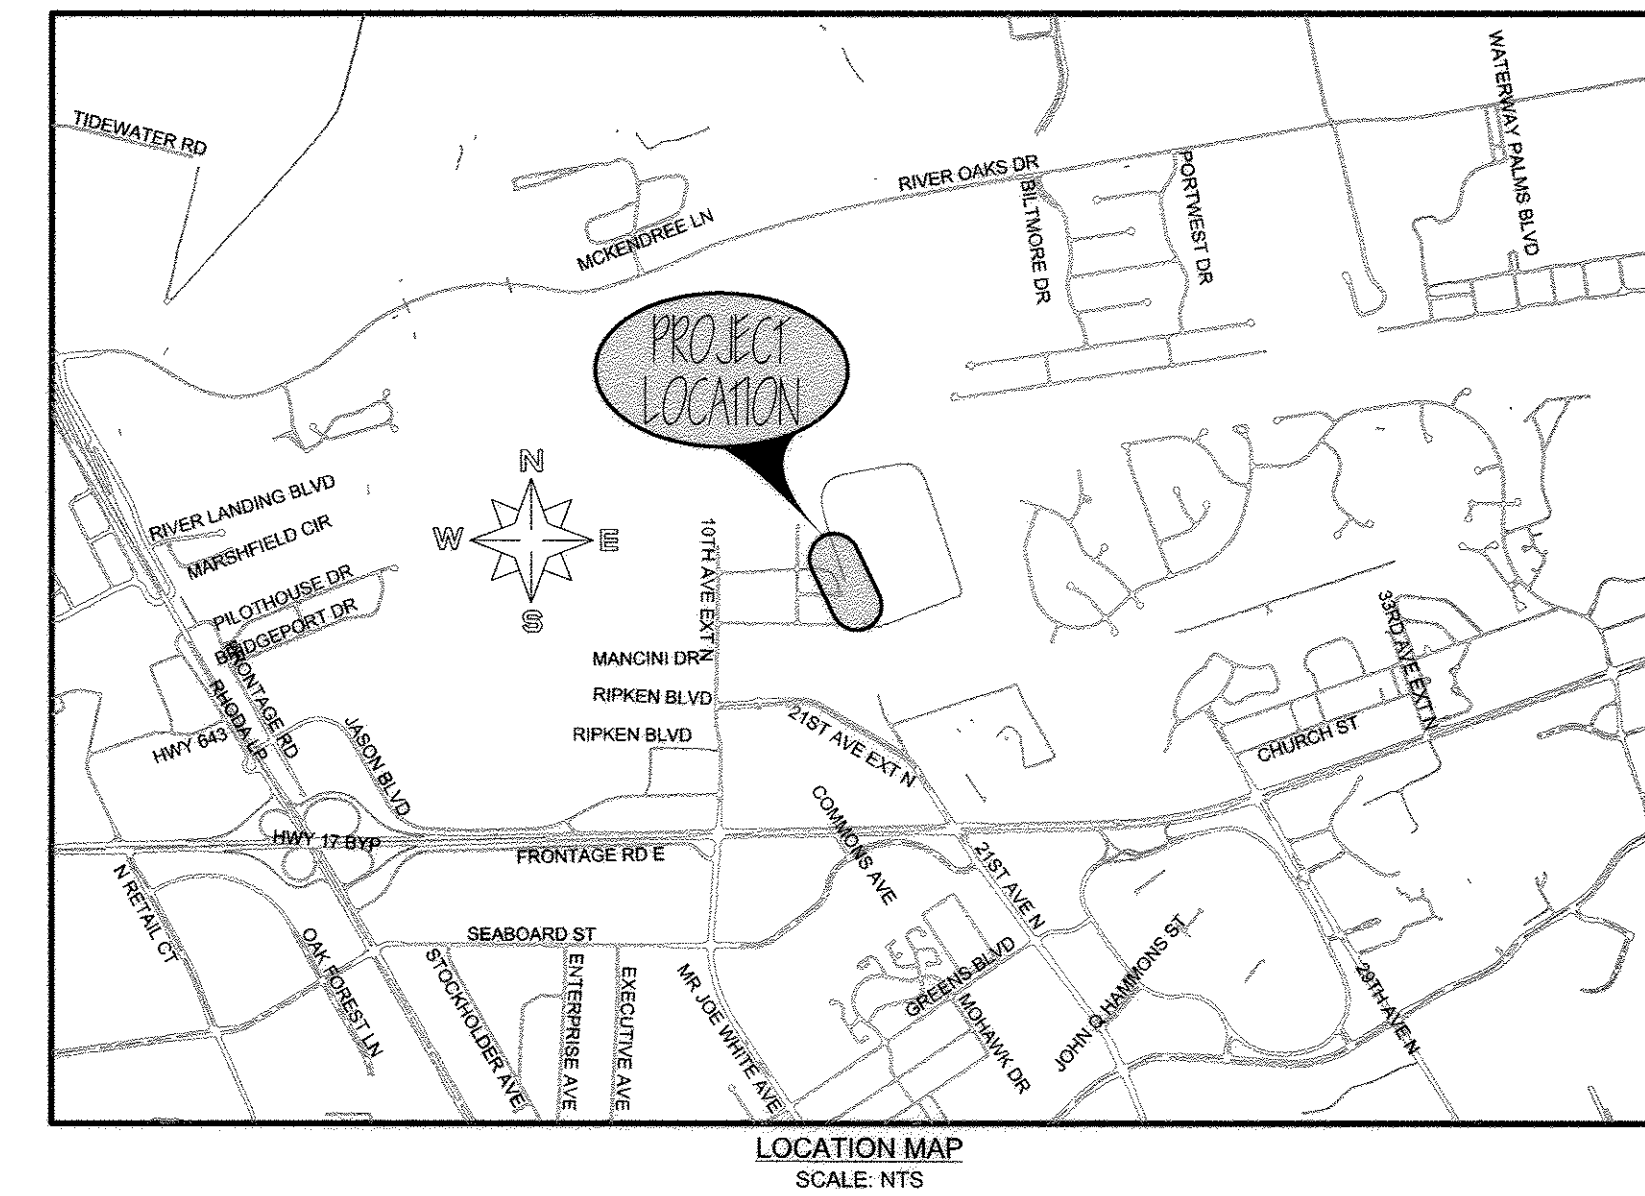

| REVISION   | DATE     | BY  |
|------------|----------|-----|
| 11 ASBUILT | 02/19/10 | JAD |

**GRAND STRAND WATER & SEWER AUTHORITY**

170 JACKSON BLUFF RD.  
P.O. BOX 2306  
CONWAY, SC 29528-2306  
(843) 397-4680 (FAX)  
(843) 397-4680 (TOLL FREE)  
E-MAIL: GSWA@GSA.COM

**MYRTLE BEACH WWTP SLUDGE LINE**

(LOCATED WITHIN THE MYRTLE BEACH WWTP FACILITY)

W.O. #570555 / PROJ. #901-01


SC DMEC CONSTR. PERMIT #  
ISSUED: \_\_\_\_\_  
DATE: 9/22/09  
SCALE: AS SHOWN  
FILENAME: MB\_Plant\_sludgeline.dgn

DESIGNED BY: \_\_\_\_\_  
GRAIG DUNN

CHECKED BY: \_\_\_\_\_  
JASON POSTON

APPROVED BY: \_\_\_\_\_  
CHRISTINA S. EVERETT PE #21255

SHEET 1 OF 1

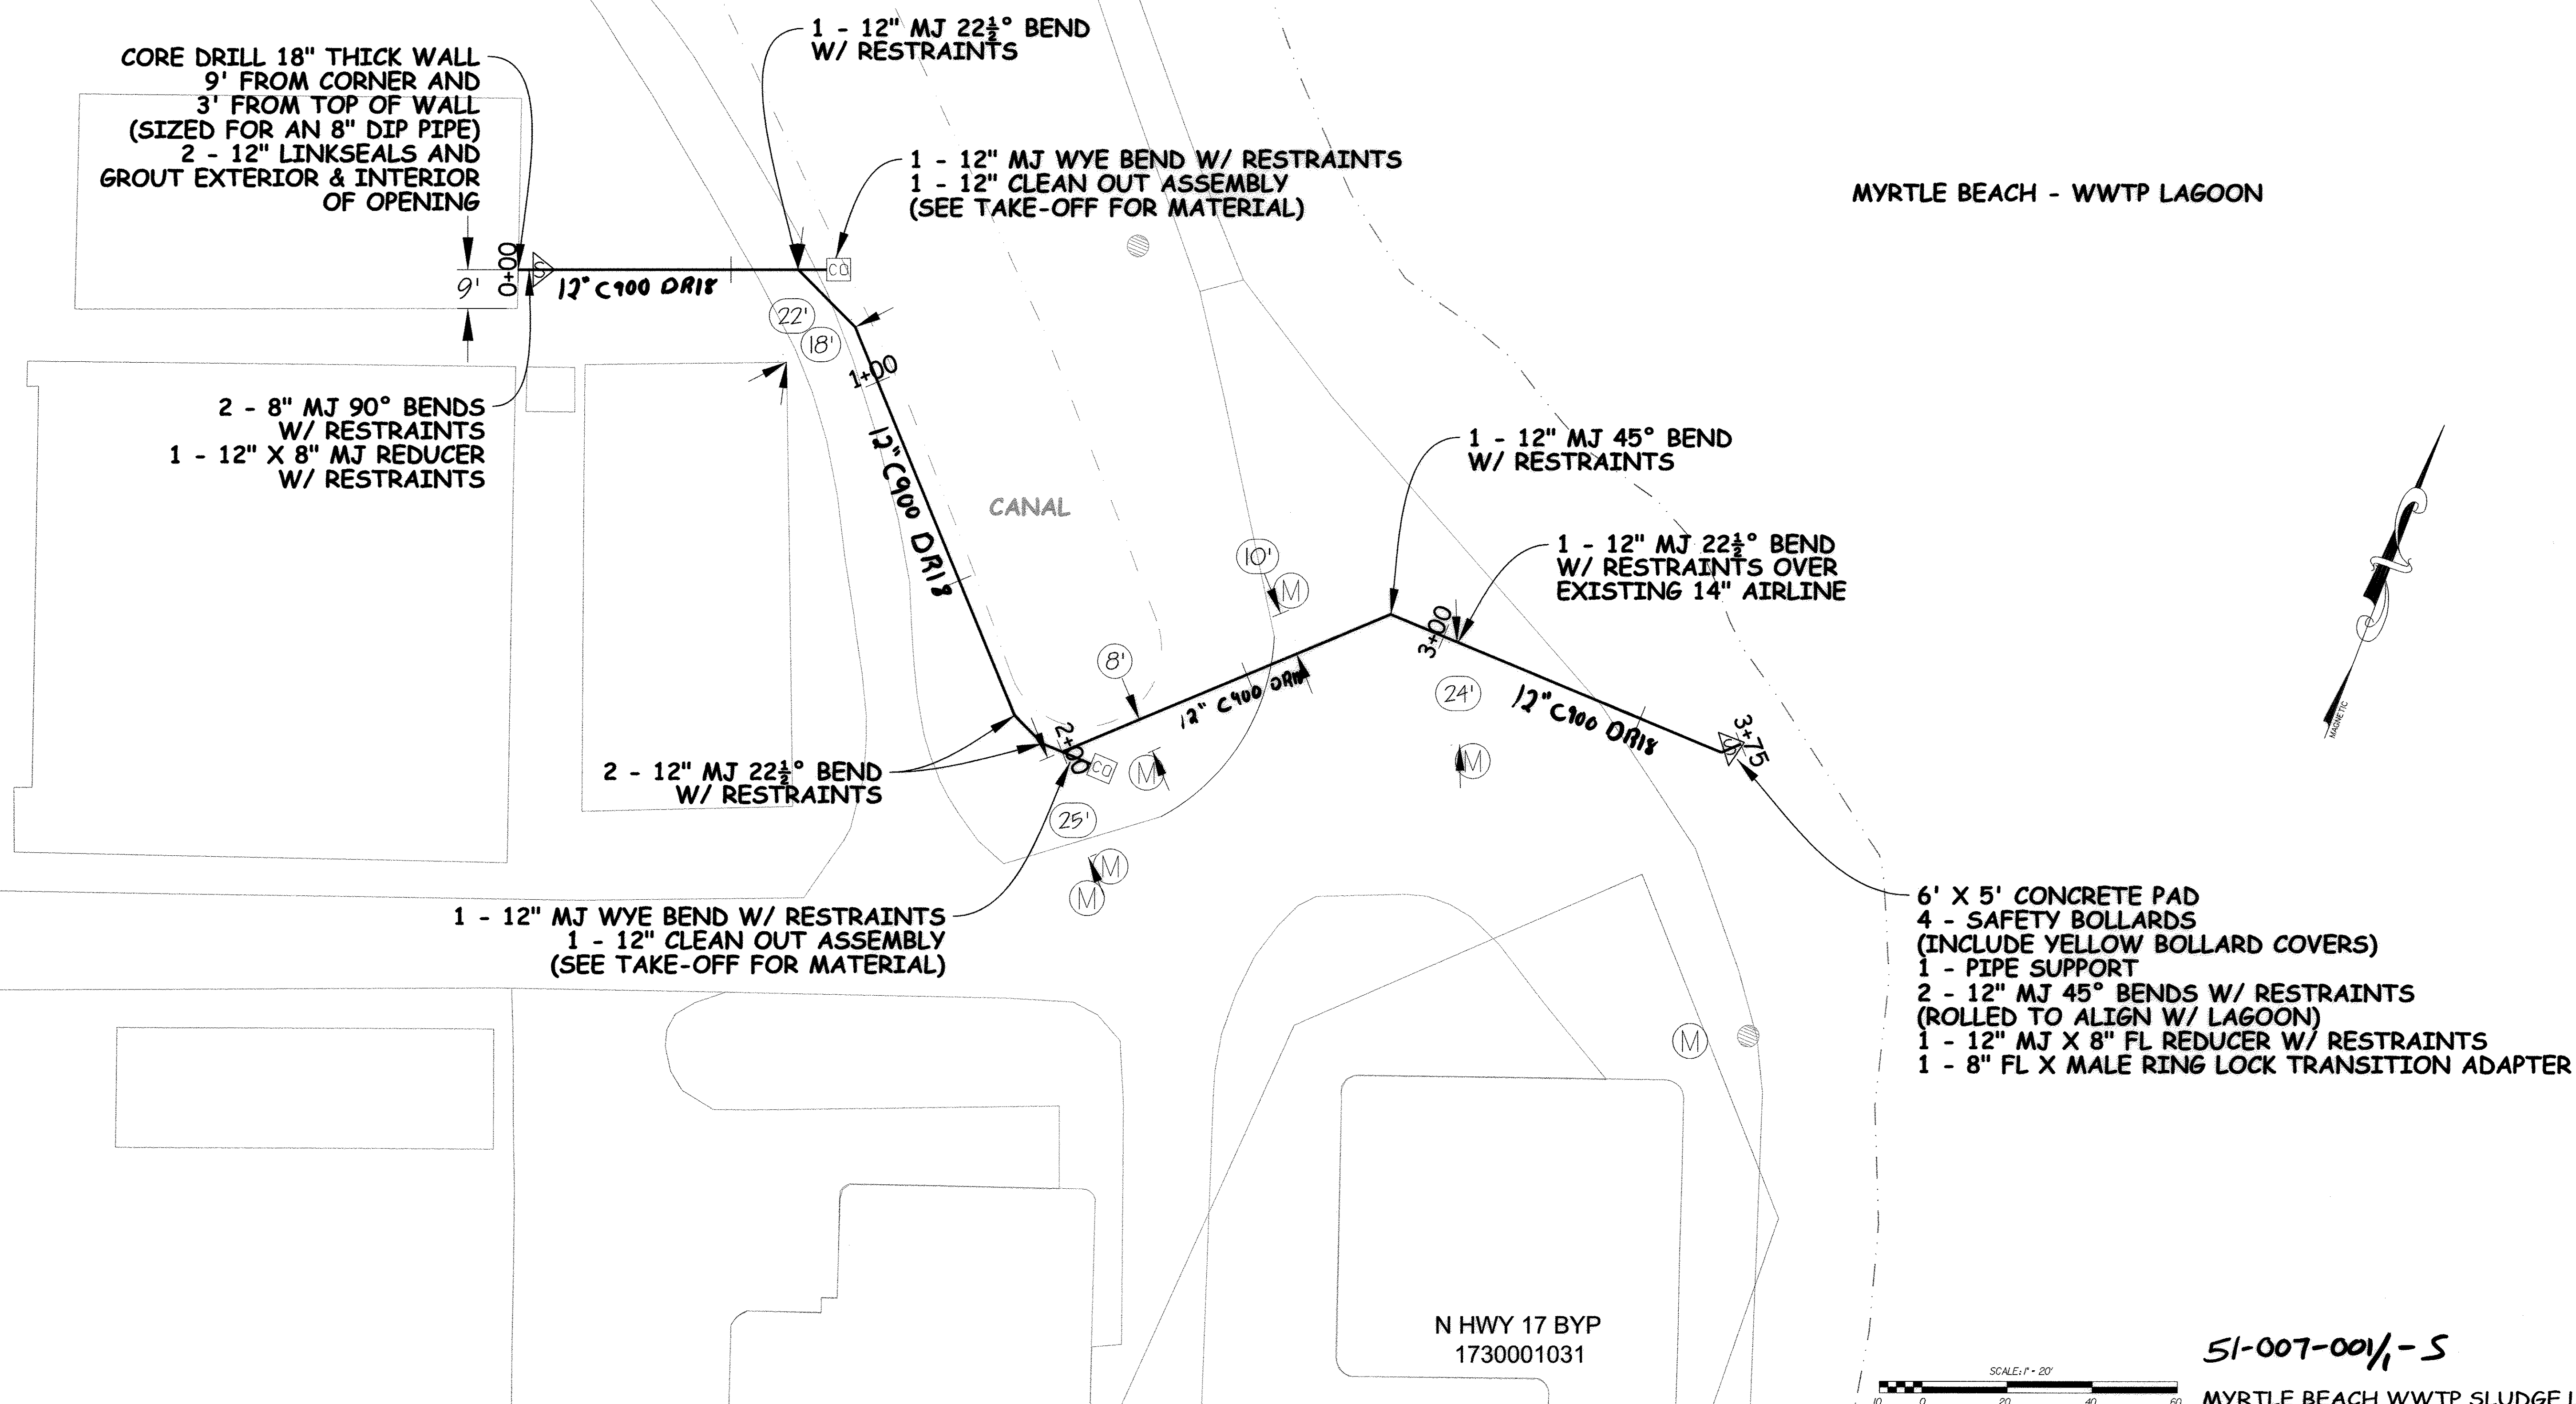

51-007-001/-S

MYRTLE BEACH WWTP SLUDGE LINE