


GRAND STRAND WATER AND SEWER AUTHORITY

LONGS-LITTLE RIVER 12" WATERLINE INTERCONNECT

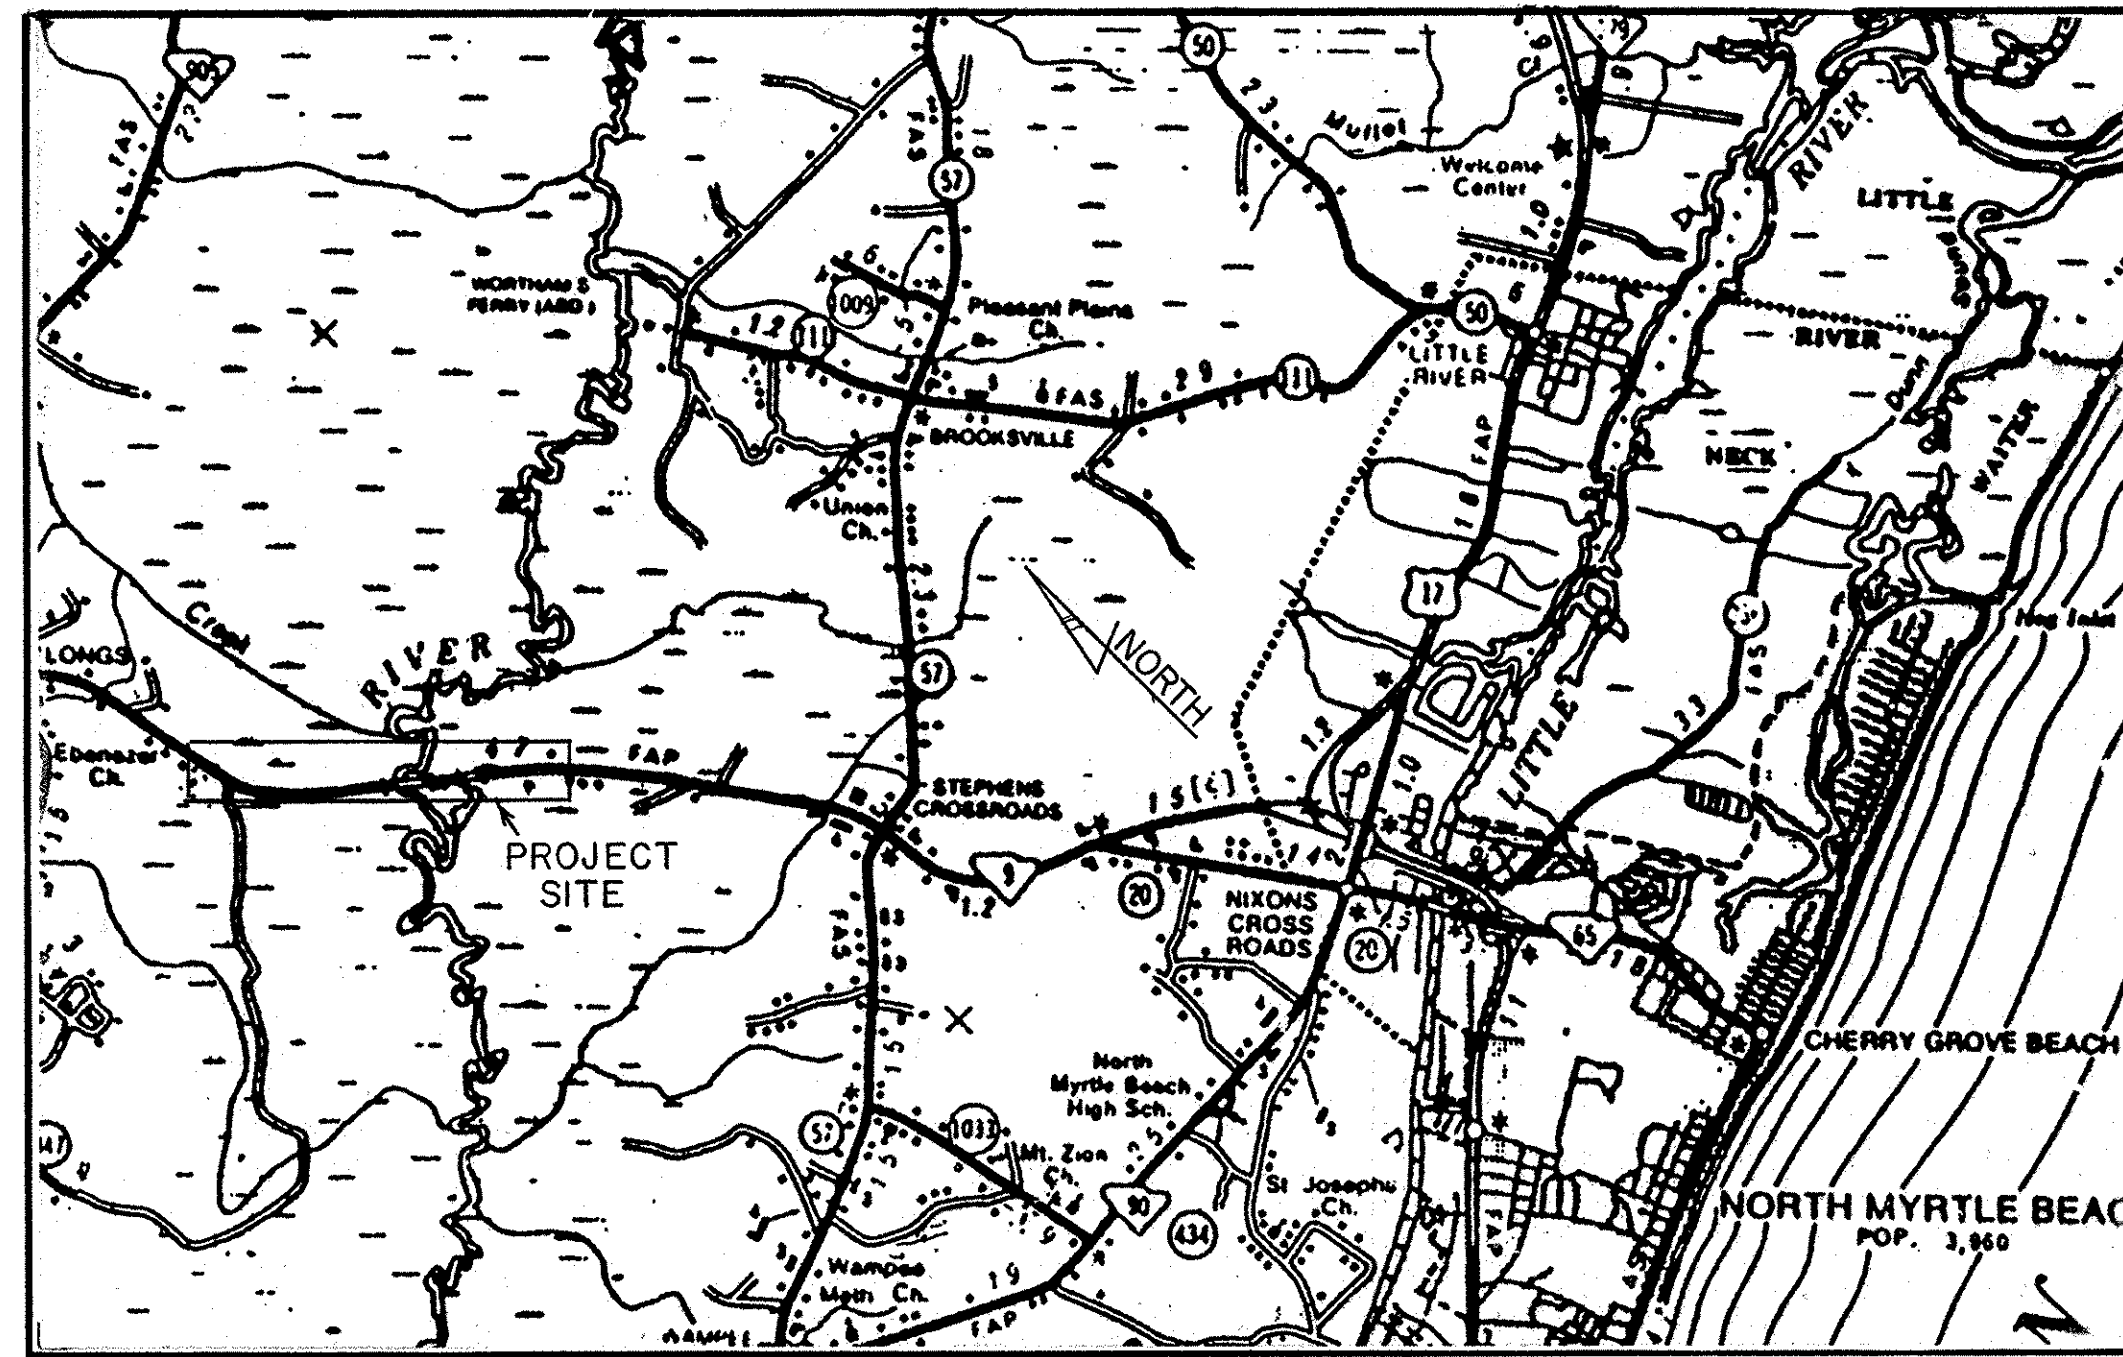

VICINITY MAP
NOT TO SCALE

GENERAL NOTES:


1. ALL EXISTING DITCHES TO BE RECONSTRUCTED AS NECESSARY TO ALLOW PROPER PIPELINE INSTALLATION, CLEARANCE, AND DEPTH OF COVER.
2. MINIMUM DEPTH OF COVER SHALL BE 36"
3. EXISTING LINES AND VALVES TO BE FIELD LOCATED BY CONTRACTOR.
4. CONTRACTOR TO VERIFY LOCATION OF ALL EXISTING UTILITIES BEFORE BEGINNING CONSTRUCTION. INFORMATION ON EXISTING UTILITIES SHOWN ON THE DRAWINGS IS FOR INFORMATIONAL PURPOSES ONLY, NO RESPONSIBILITY IS ASSUMED BY GSW&SA OR THE ENGINEER FOR THE ACCURACY OR COMPLETENESS OF THIS INFORMATION.
5. ALL MATERIAL, WORKMANSHIP, CONSTRUCTION AND TESTING SHALL CONFORM TO THE GSW&SA STANDARD PLANS AND SPECIFICATIONS.
6. DISTANCE BETWEEN MAIN LINE GATE VALVES ARE APPROXIMATE; LOCATION OF GATE VALVES TO BE DETERMINED BY GSW&SA.
7. THE GSW&SA WILL SECURE ALL NECESSARY ENCROACHMENT AND TRENCH PERMITS FROM APPLICABLE PUBLIC AGENCIES.
8. NO CONSTRUCTION SHALL COMMENCE WITHOUT PRIOR APPROVAL OF THE GSW&SA.

PREPARED BY:
GRAND STRAND WATER & SEWER AUTHORITY
PO BOX 1537 CONWAY, SC 29526

APPROVED BY:

Fred R. Richardson

FRED R. RICHARDSON P.E. # 9853

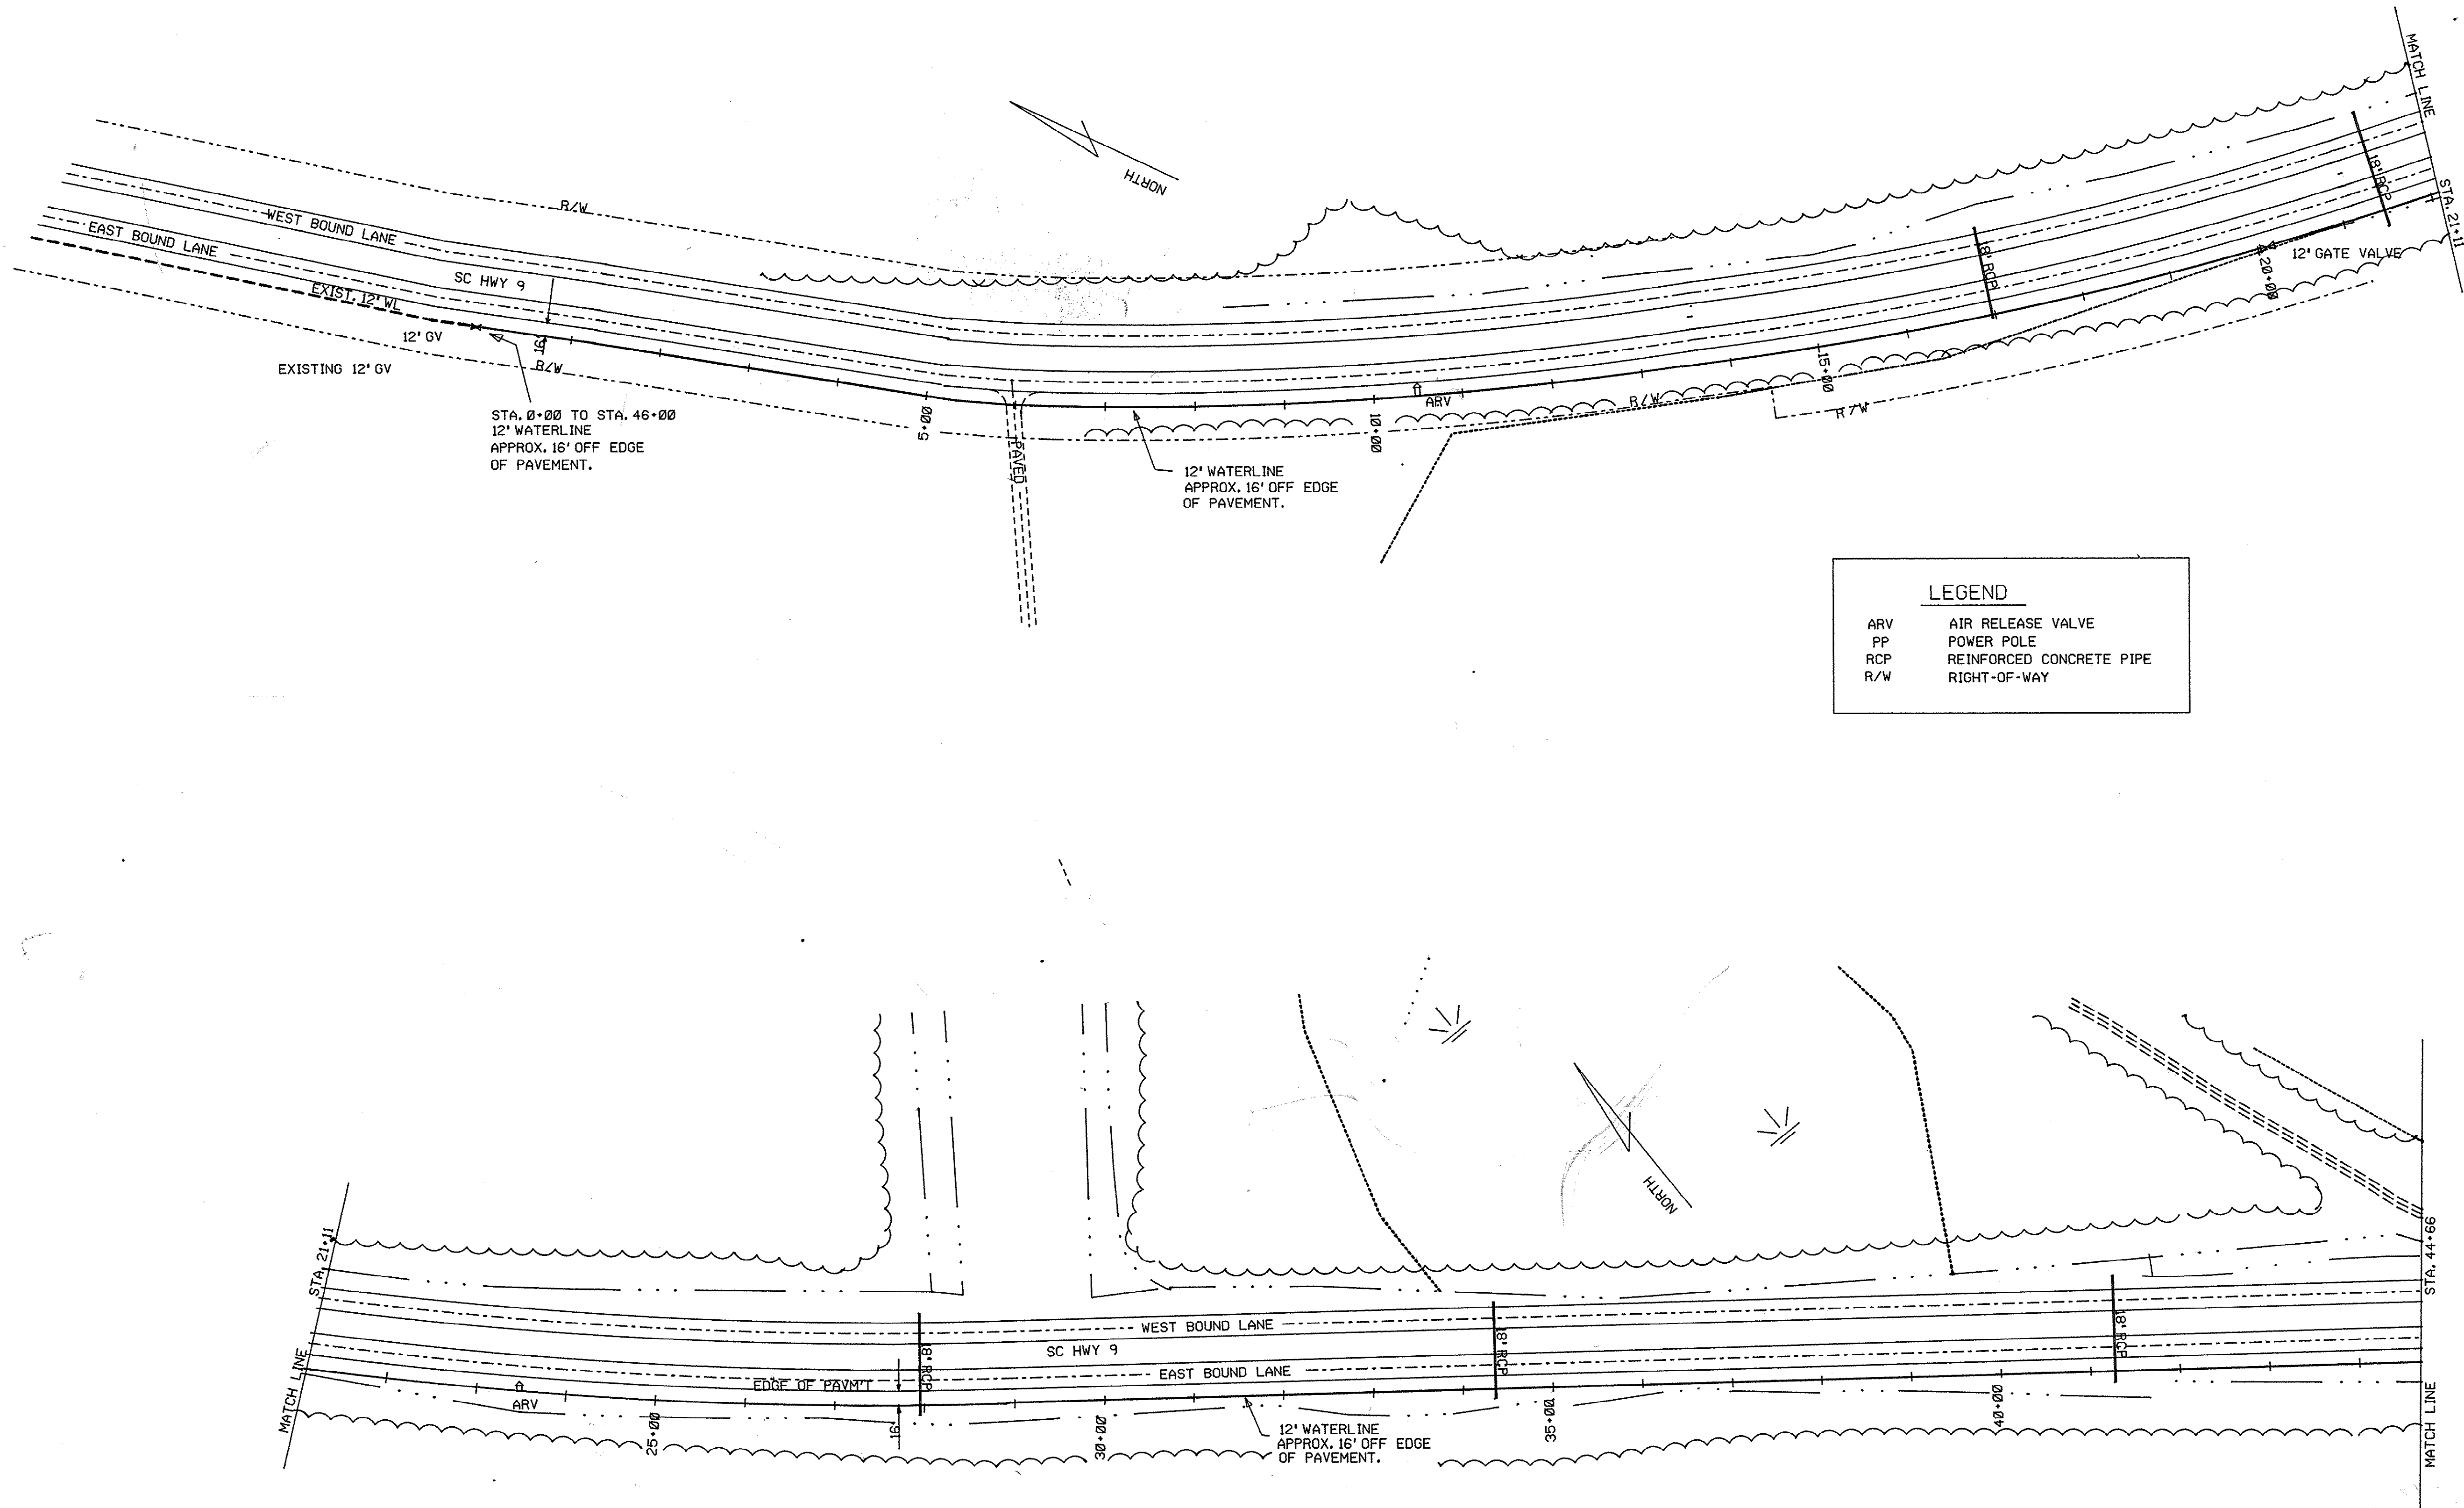


LEGEND	
ARV	AIR RELEASE VALVE
PP	POWER POLE
RCP	REINFORCED CONCRETE PIPE
R/W	RIGHT-OF-WAY

APPROVED
 Fred Richardson 7-2-91
 [Signature]

REVISION	BY	DATE
AS-BUILT	REP	7/2/91

LONGS-LITTLE RIVER 12" WATERLINE INTERCONNECT	
GRAND STRAND WATER & SEWER AUTHORITY	
P.O. BOX 1537, CONWAY, S.C. 29526 TELEPHONE (803) 347-4641 OR 448-1686	

DATE	AUGUST 1990
SCALE	1" = 100'
DRAWN BY	ROBERT PERKINS
CHECKED BY	BRUCE BAXLEY
APPROVED BY	FRED RICHARDSON RE NO 9853
SHEET	OF 3
DRAWING NO.	25-017-003-W

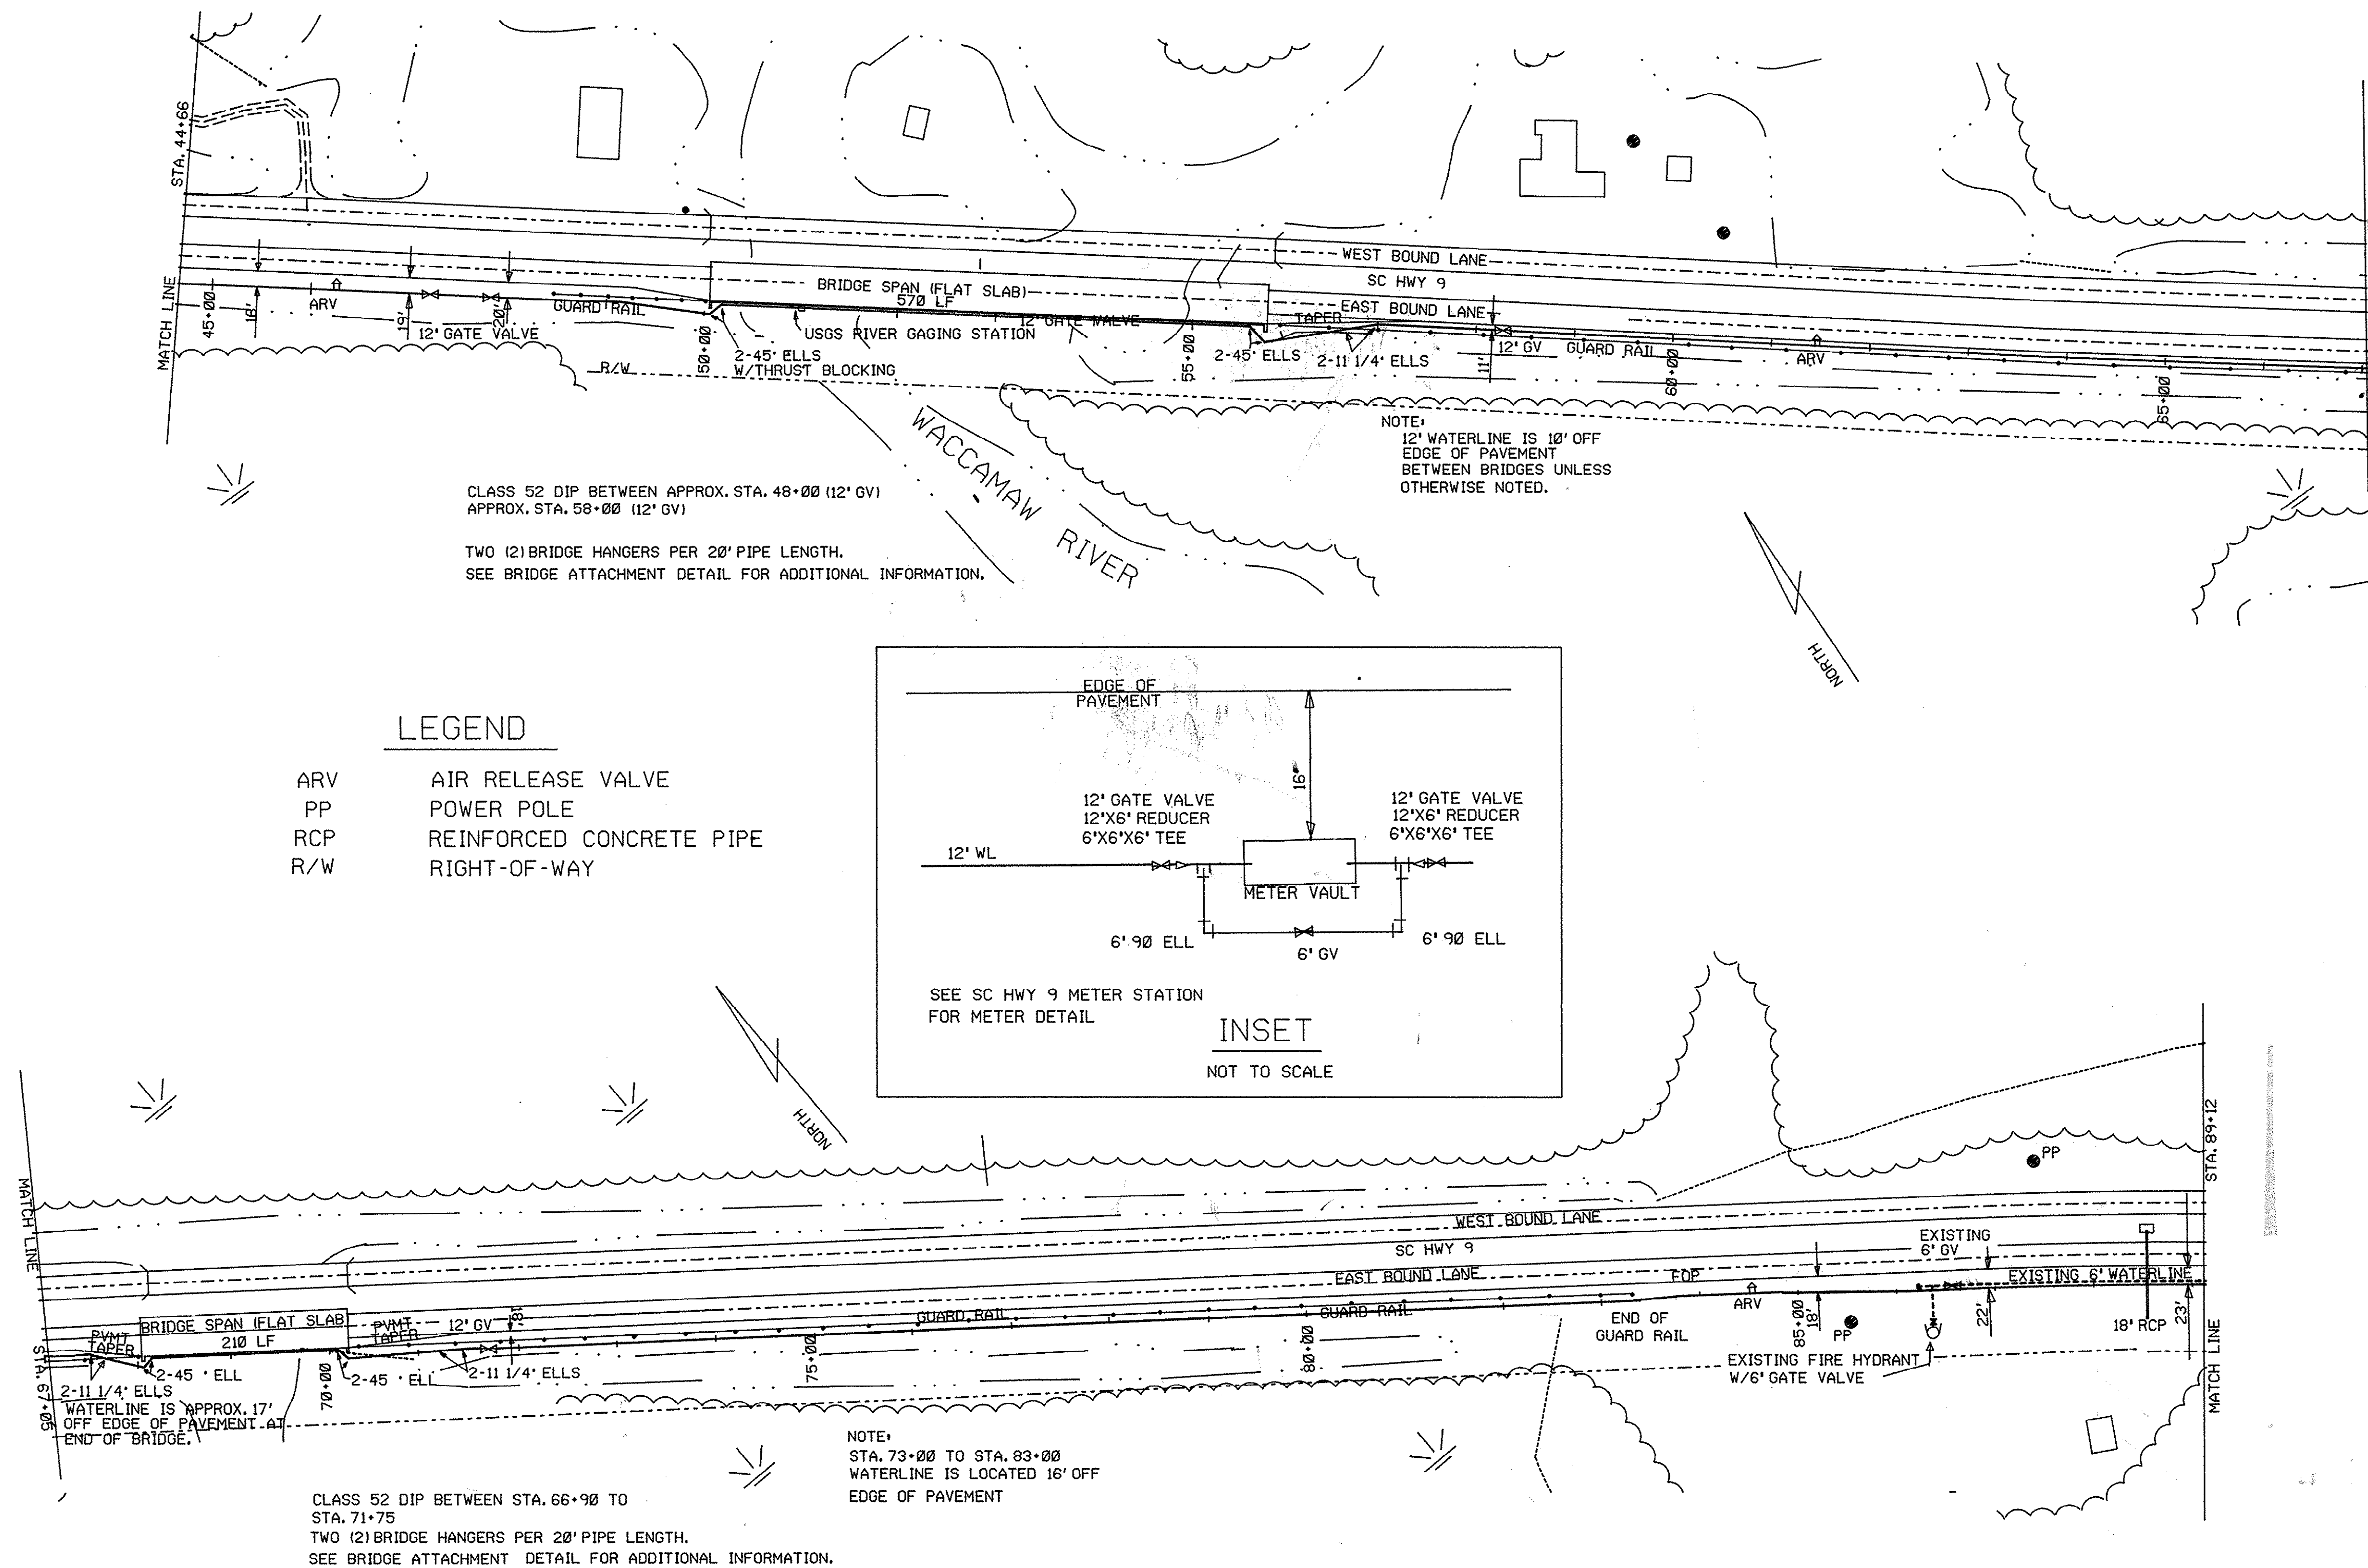

REVISION	BY	DATE
AS - BUILT	REP	7/2/91

LONGS-LITTLE RIVER 12" WATERLINE INTERCONNECT

GRAND STRAND WATER & SEWER AUTHORITY

P.O. BOX 1537, CONWAY, S. C. 29526
TELEPHONE (803) 347-4641 OR 448-1666

DATE AUGUST 1990

SCALE 1" = 100'

DRAWN BY ROBERT PERKINS


CHECKED BY B. BAXLEY

APPROVED BY Fred Richards

FRED RICHARDS OM3 PE NO 9853

SHEET 3 OF 3

DRAWING NO. 25-017-002/4

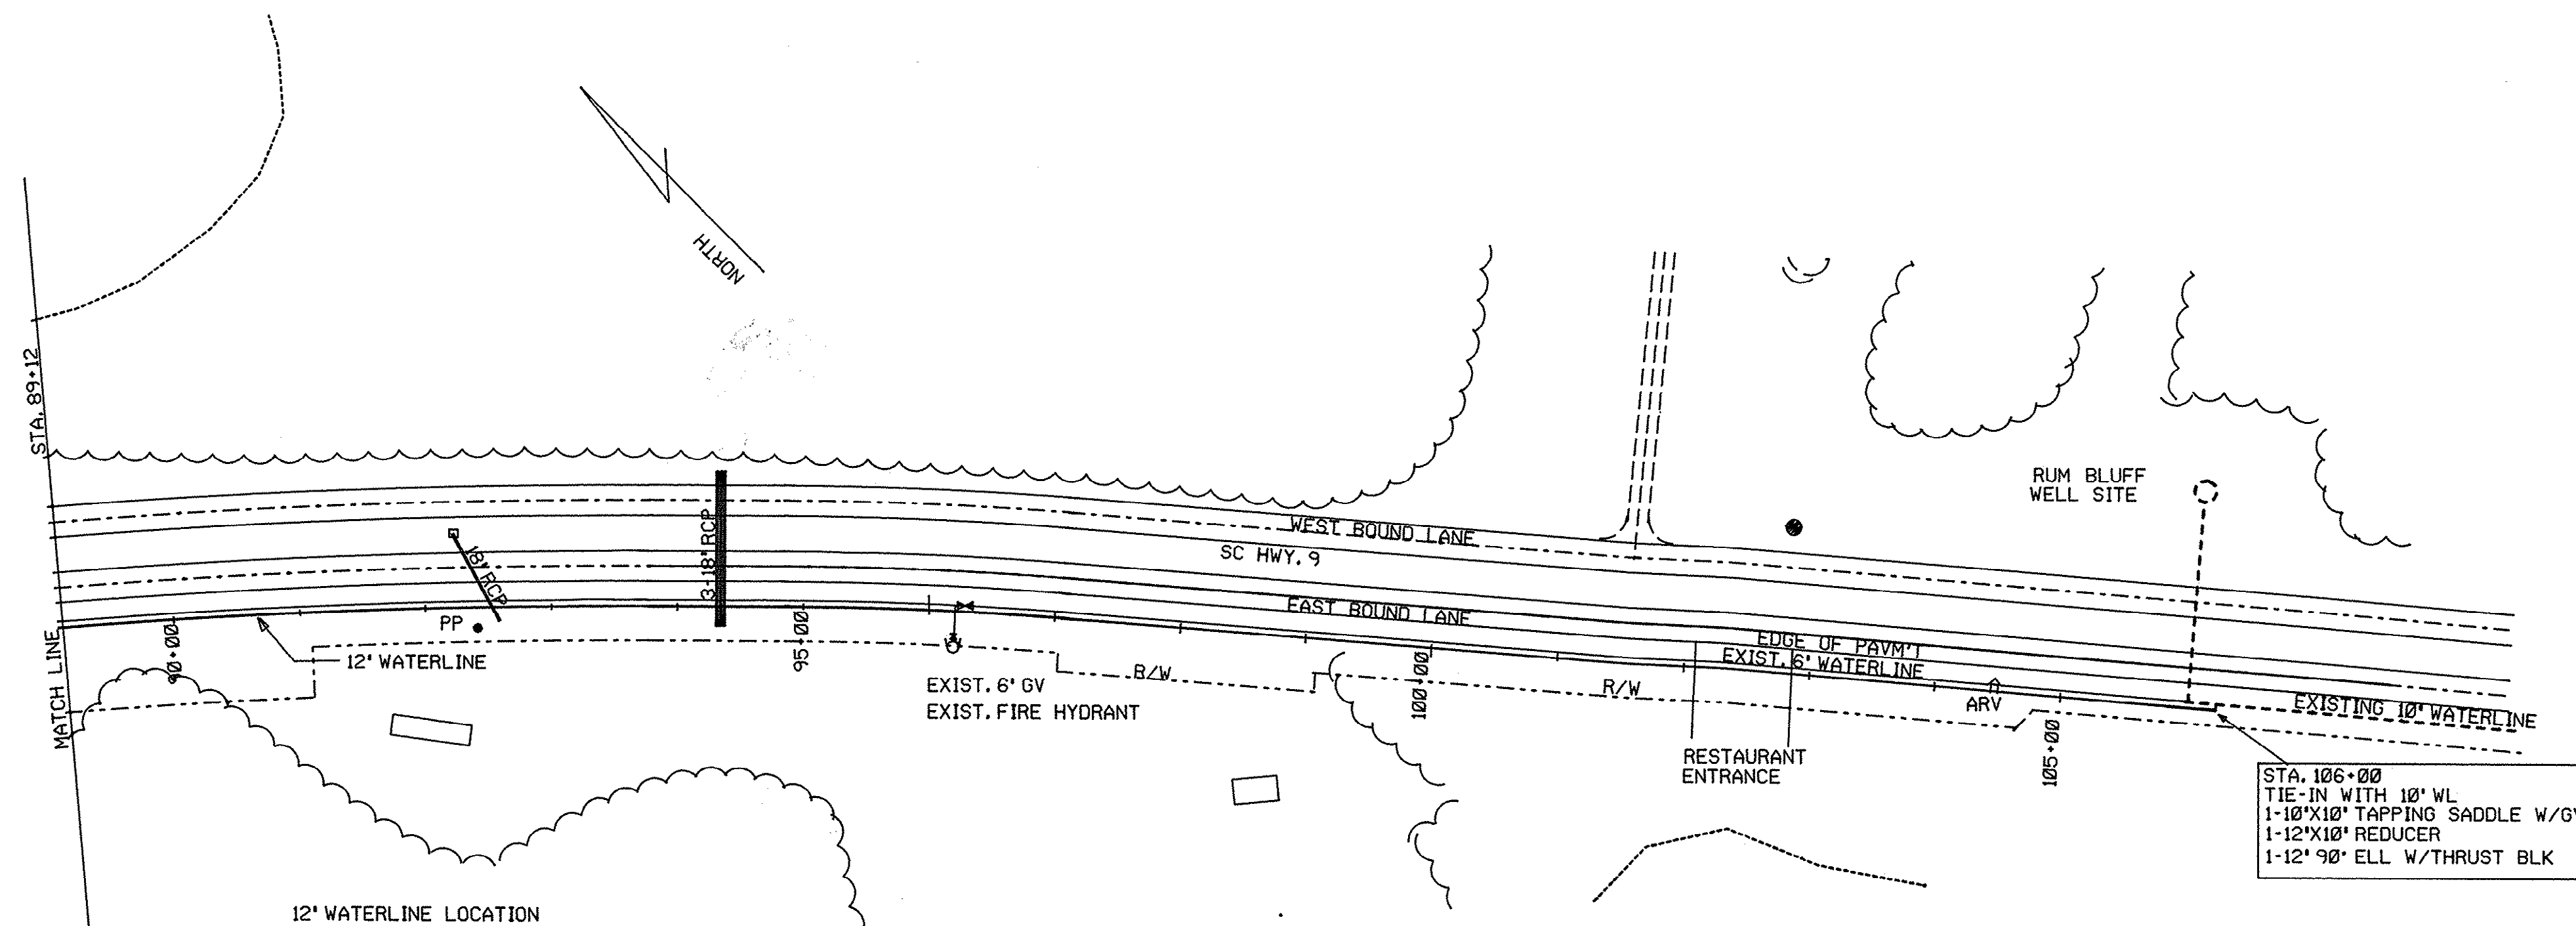

12" WATERLINE LOCATION

STATION	DIST. OFF PAVEMENT
90+00	25'
91+00	26'
92+00	26'
93+00	25'
94+00	23'
95+00	21'
96+00	20'
97+00	24'
98+00	25'
99+00	26'
100+00	26'
101+00 THRU 106+00	27'

LEGEND

ARV	AIR RELEASE VALVE
PP	POWER POLE
RCP	REINFORCED CONCRETE PIPE
R/W	RIGHT-OF-WAY

STA. 106+00
TIE-IN WITH 12" WL
1-10"x10" TAPPING SADDLE W/GV
1-12"x10" REDUCER
1-12" 90° ELL W/THRUST BLK

Fred Richardson 7-2-91

25-017-003/4


REVISION	BY	DATE
AS-BUILT	REP	7/2/91

LONGS-LITTLE RIVER 12" WATERLINE INTERCONNECT

GRAND STRAND WATER & SEWER AUTHORITY

P.O. BOX 1537, CONWAY, S.C. 29526
TELEPHONE (803) 347-4641 OR 448-1686

DATE	AUGUST 1990
SCALE	1" = 100'
DRAWN BY	ROBERT PERKINS
CHECKED BY	BRUCE BAXLEY
APPROVED BY	<i>Fred Richardson</i>
FRED RICHARDSON	P.E. NO. 9853
SHEET 3 OF 3	
DRAWING NO. 25-17-003-W	

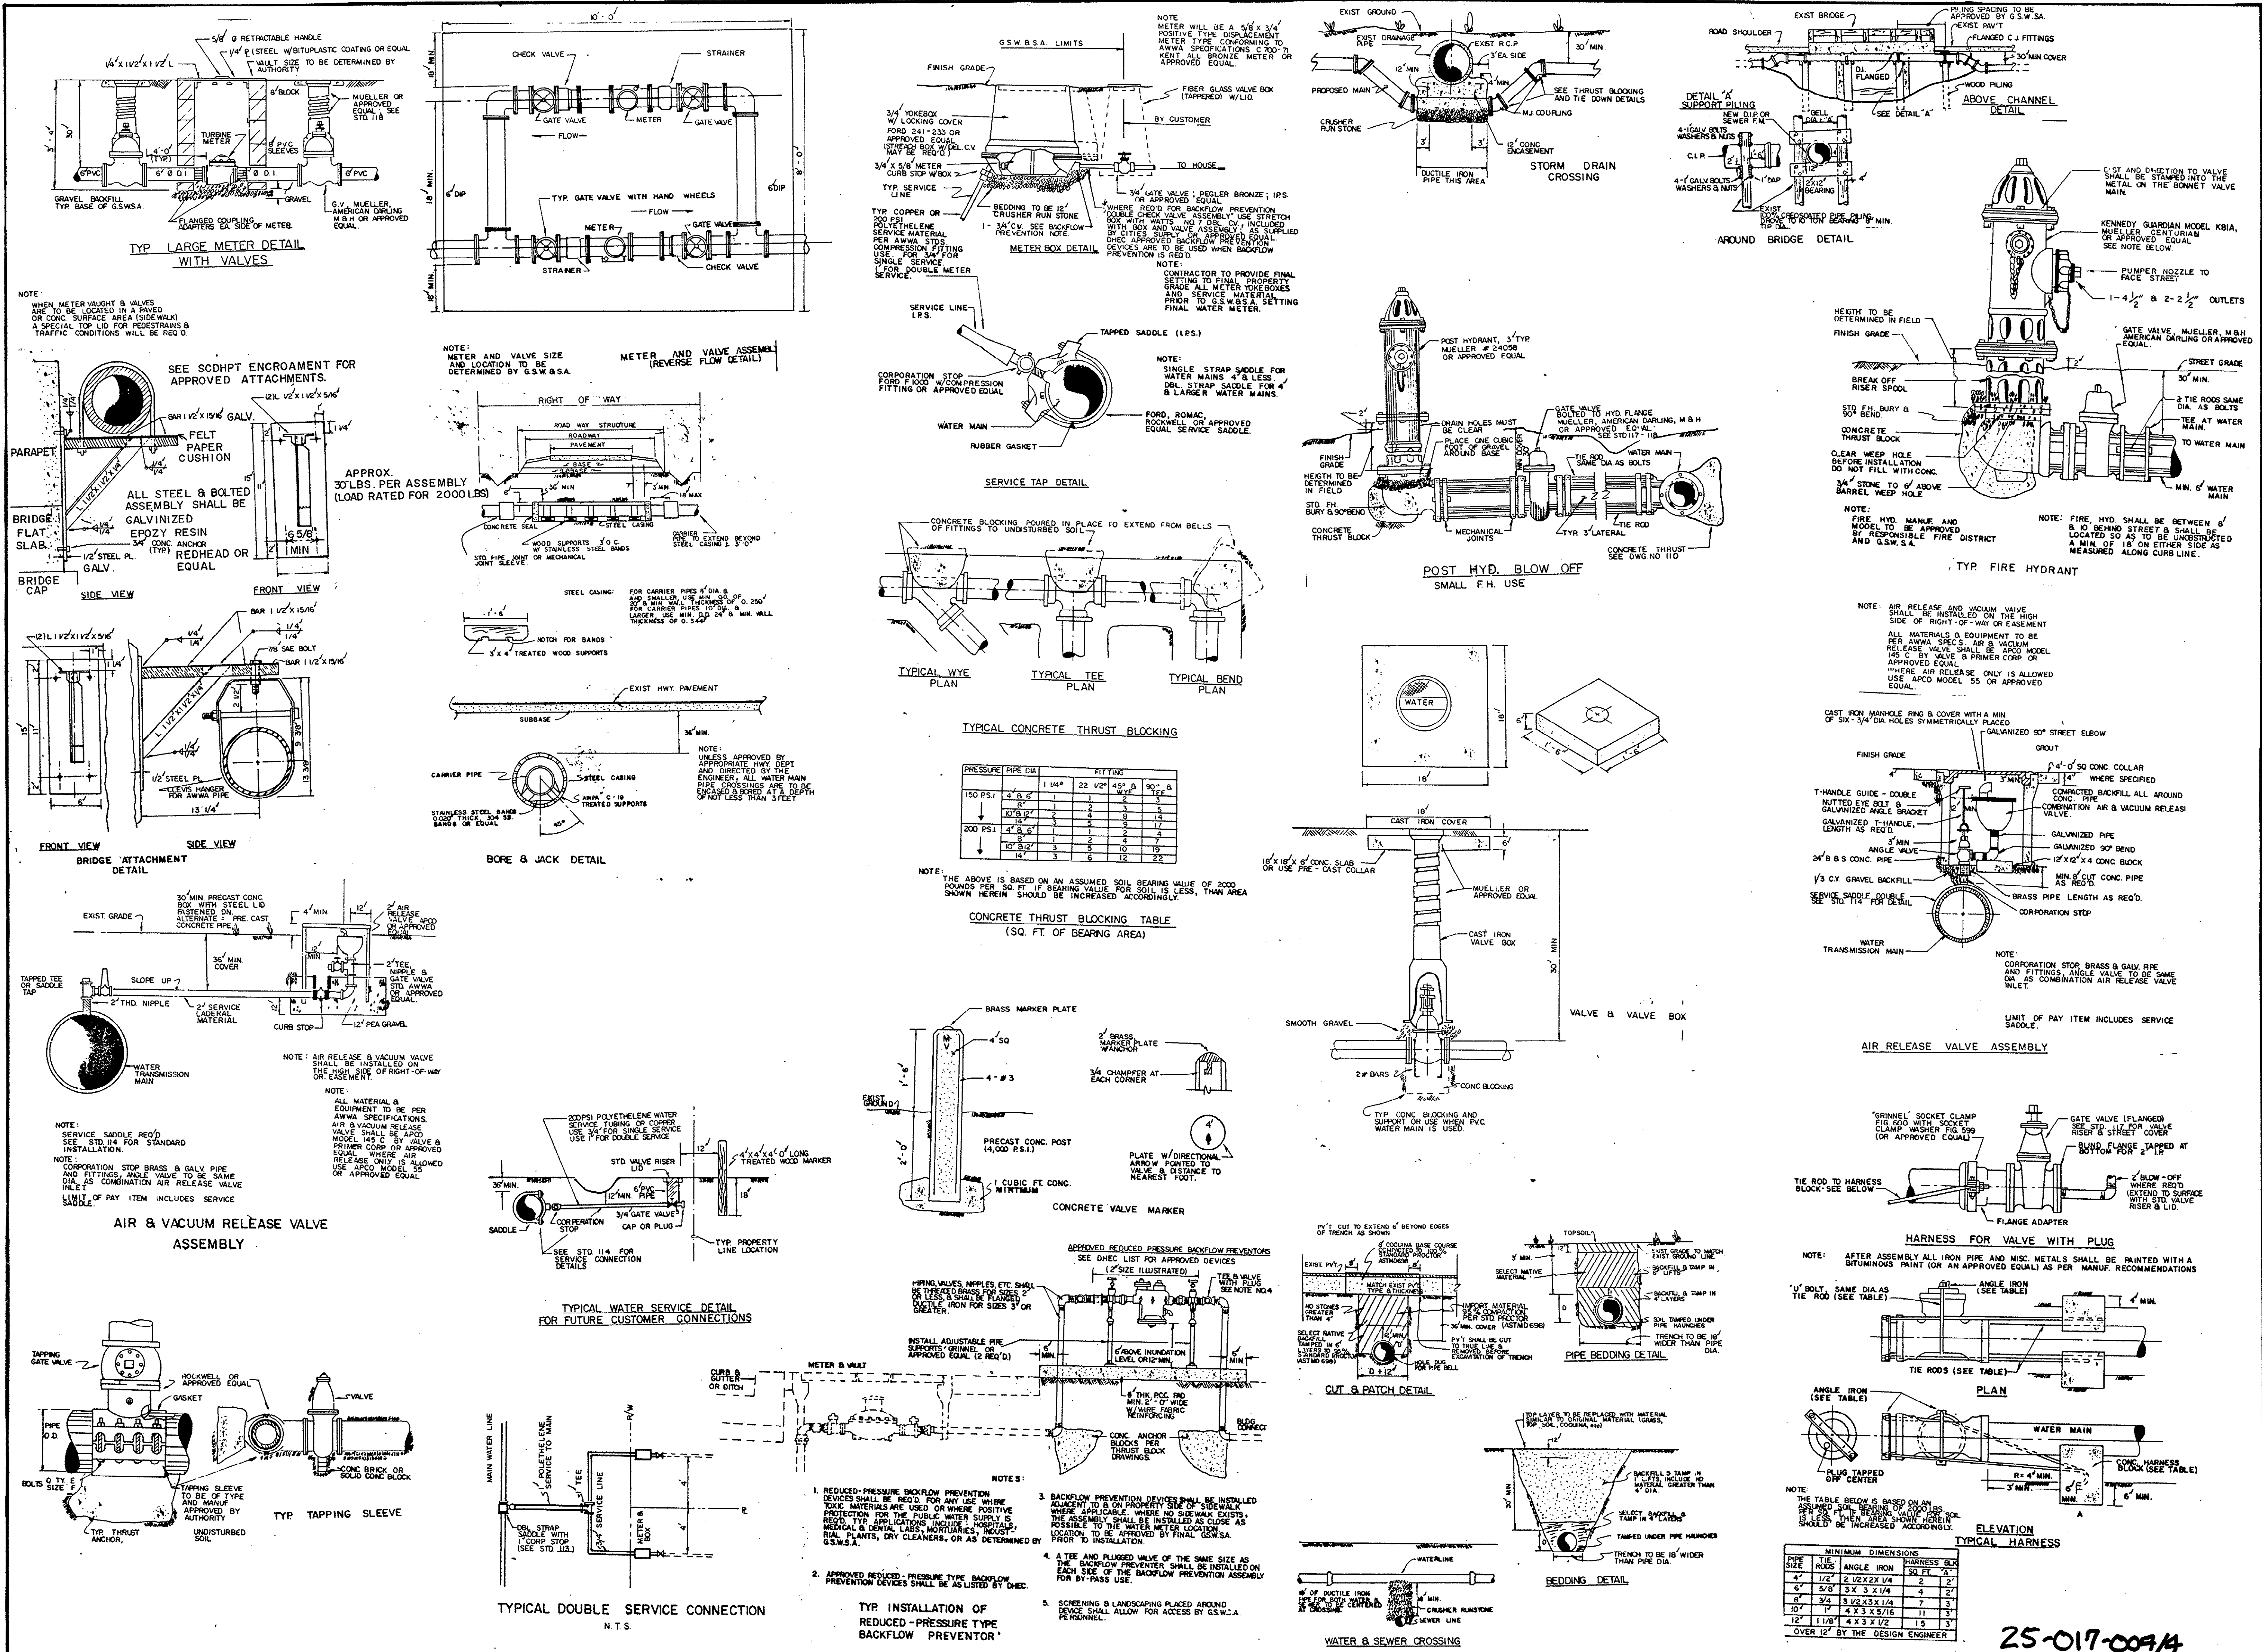

REVISION

BY

DATE

DATE

NOVEMBER 1985

SCALE

N.T.S.

DRAWN BY

P. JENERETTE

CHECKED BY

J. HEMBREE

APPROVED BY

F. RICHARDSON P.E. 9853/DATE

SHEET

4 OF 4

DRAWING No.

25-017-0014

SC HWY 905 - NORTH WATERLINE

GRAND STRAND WATER & SEWER AUTHORITY

TELEPHONE (803) 347-4641 or 448-1686

P.O. BOX 1537, CONWAY, S.C. 29826