

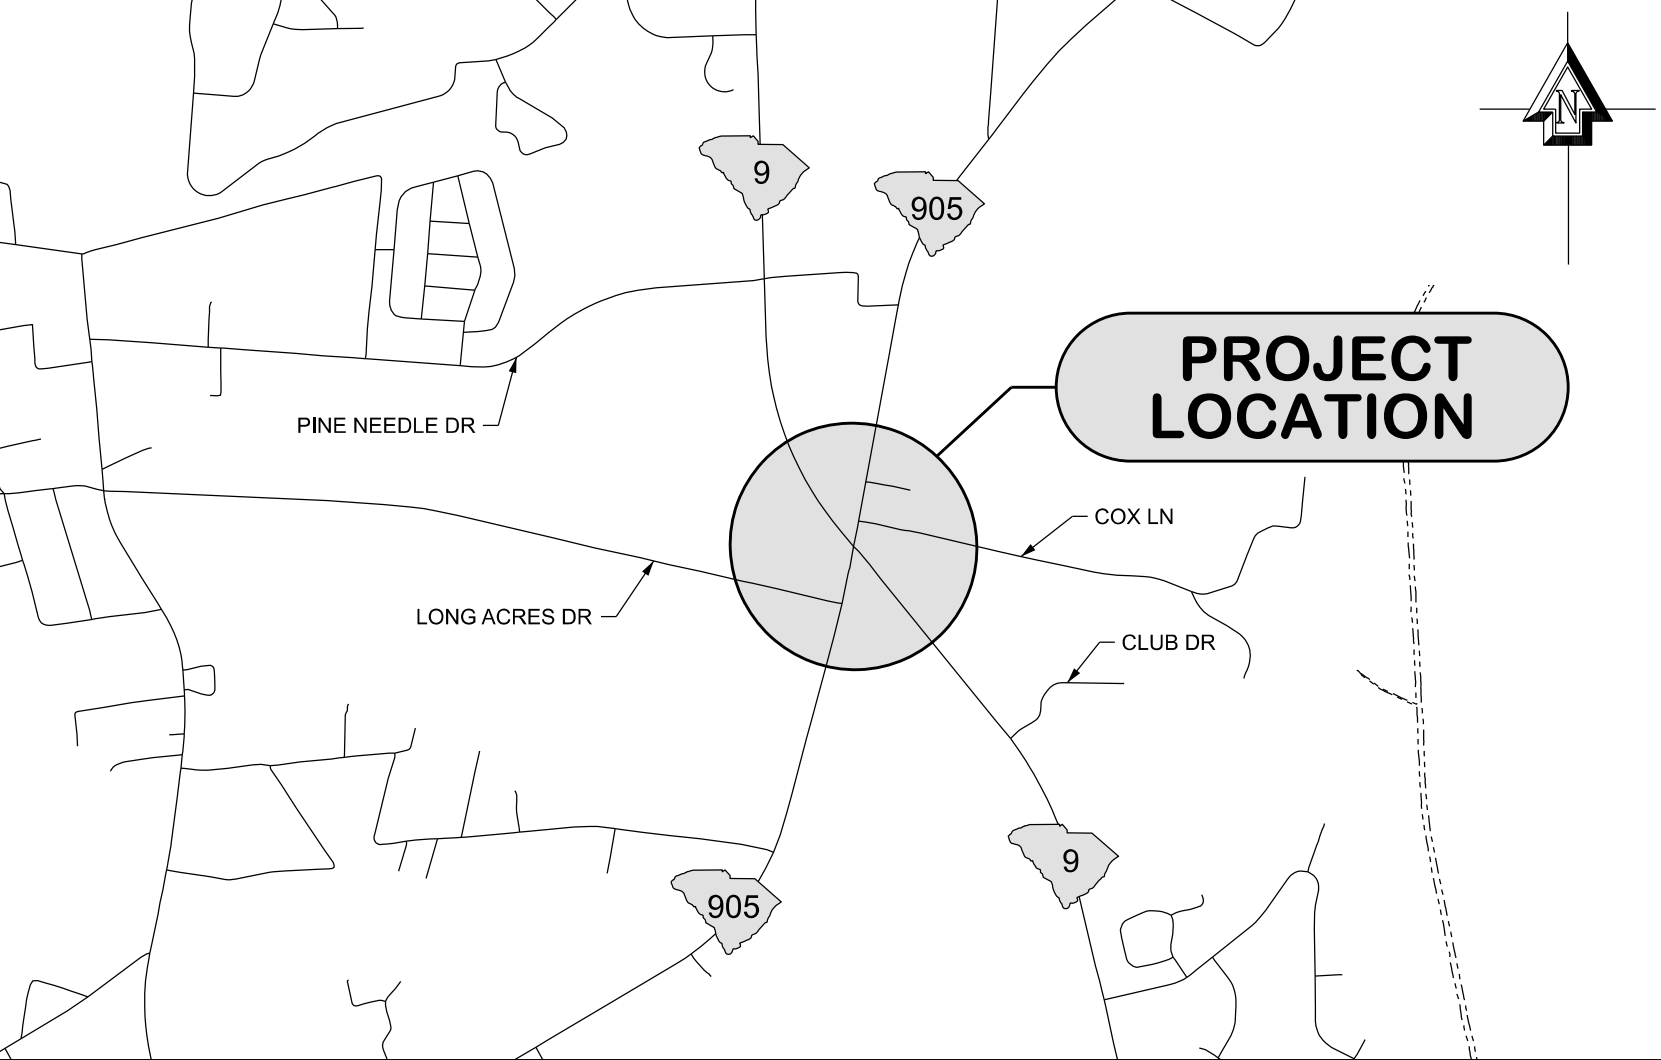
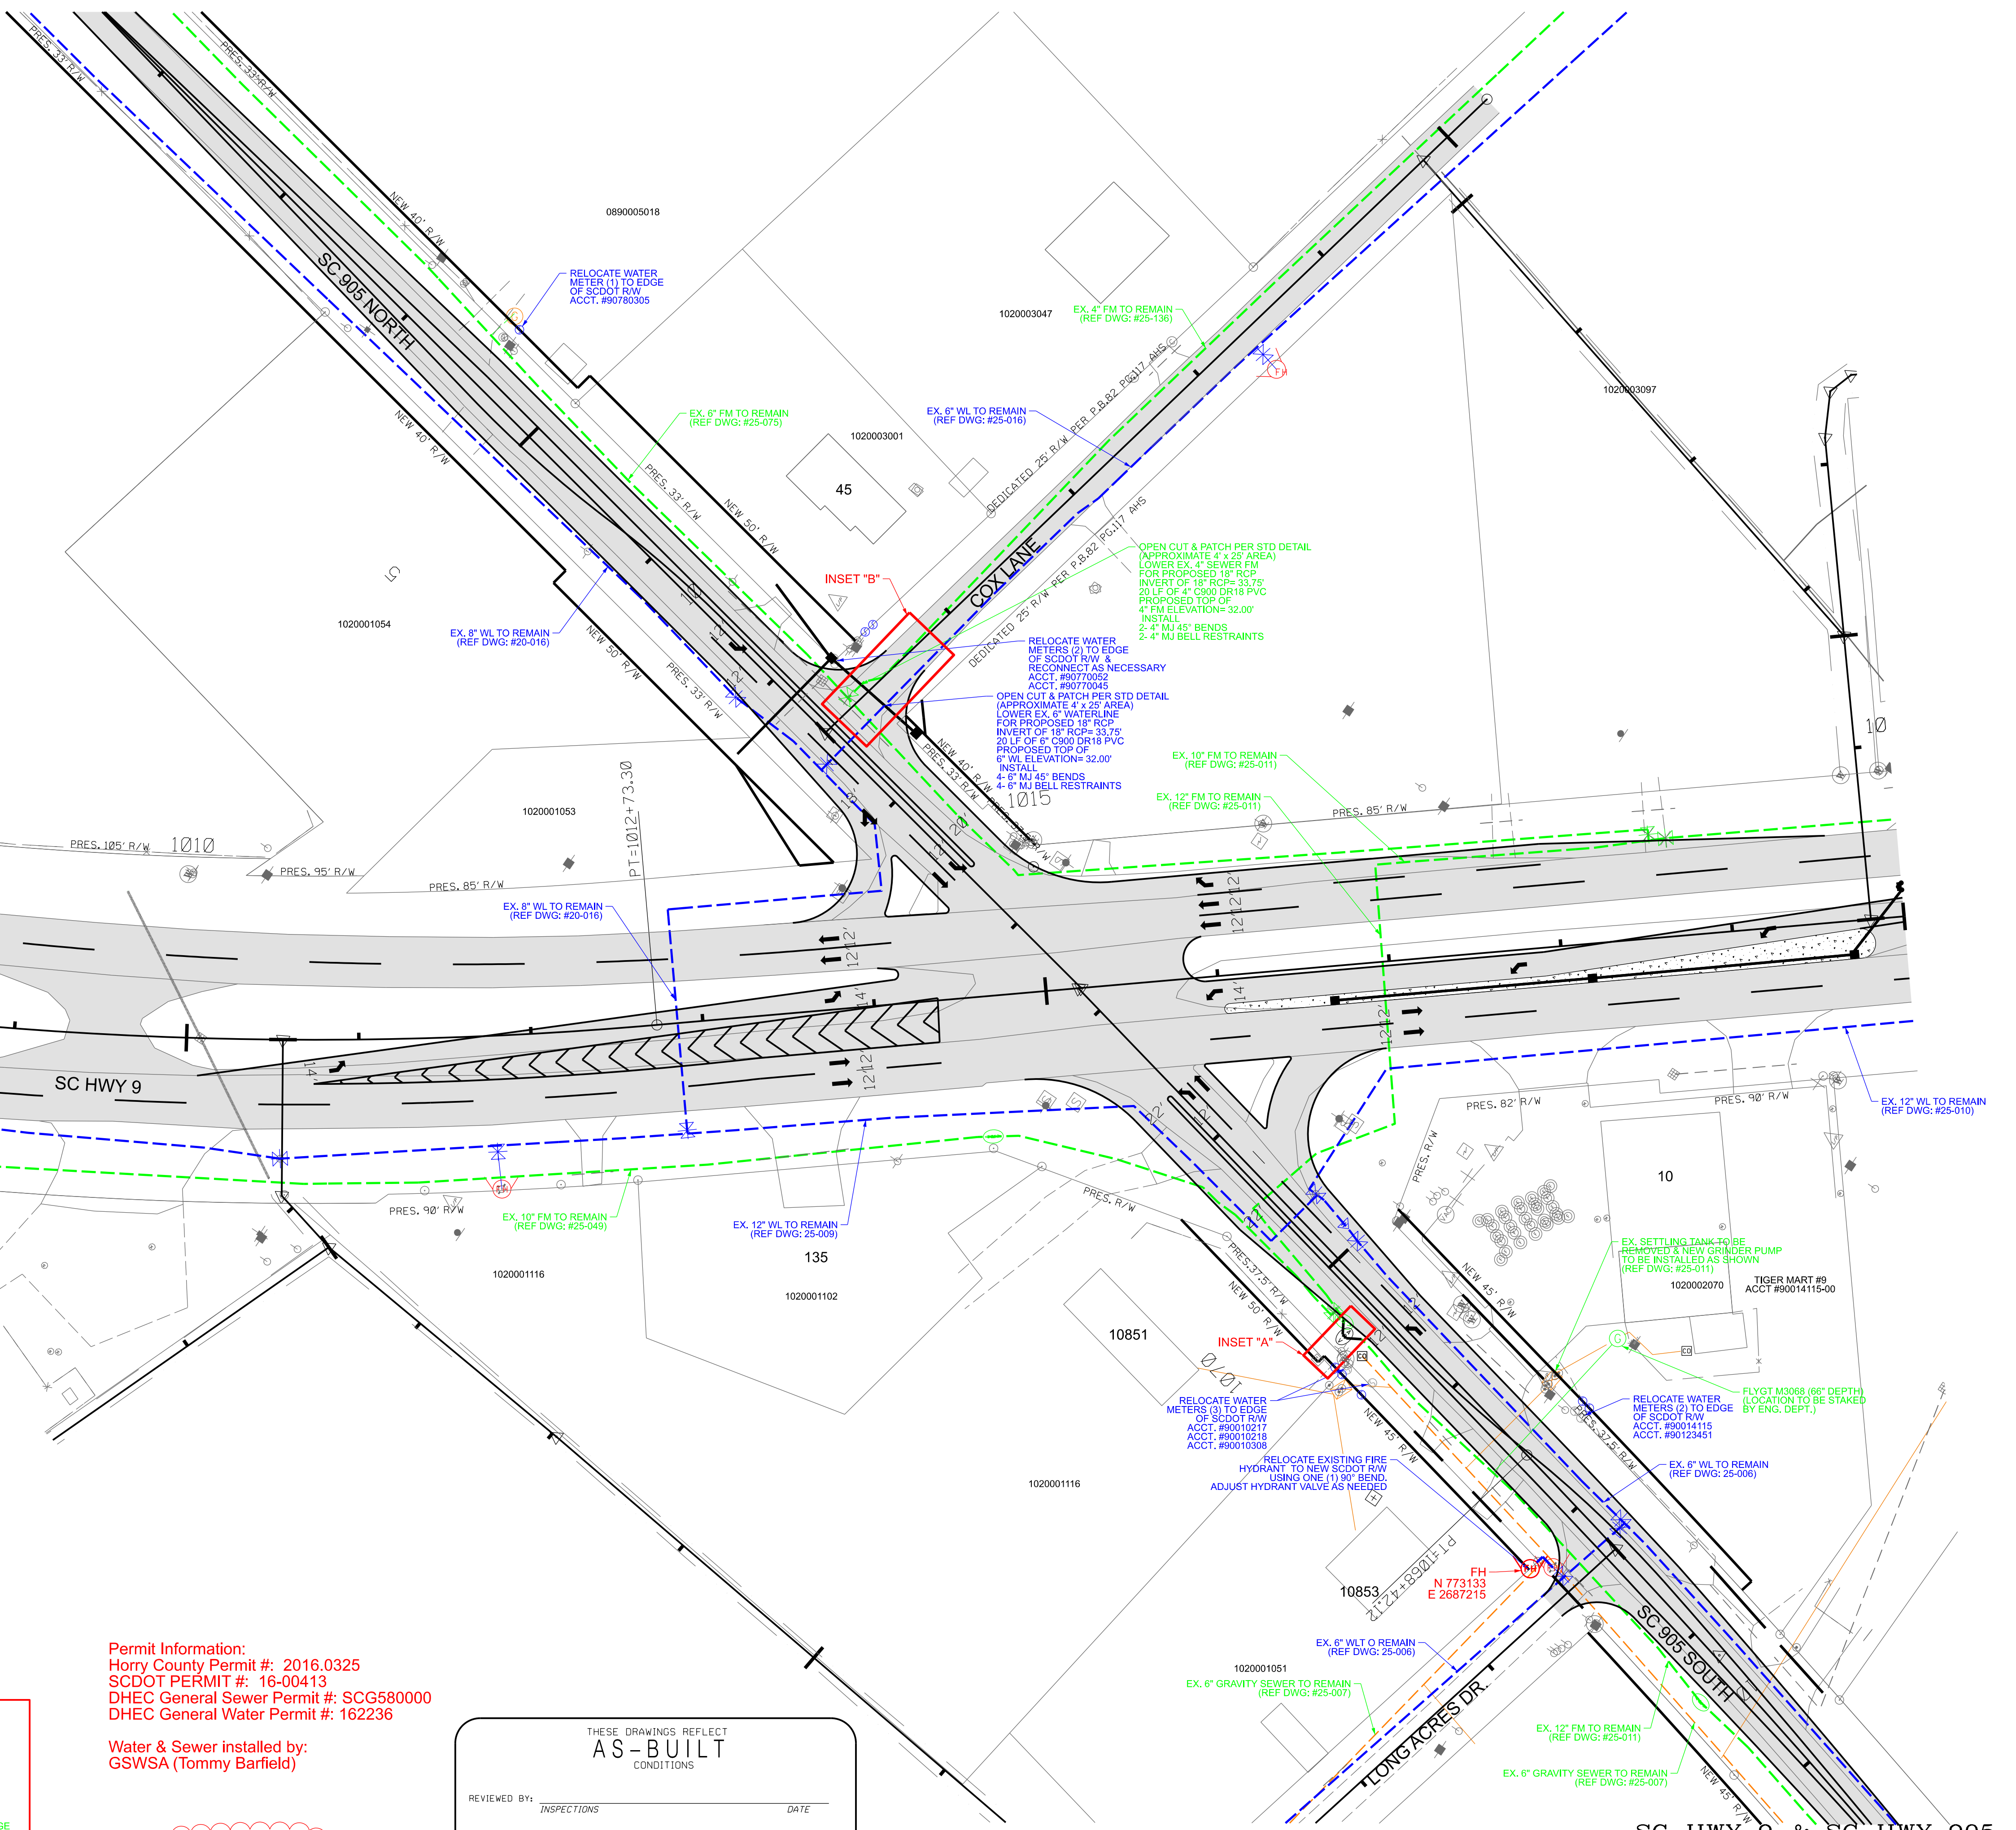
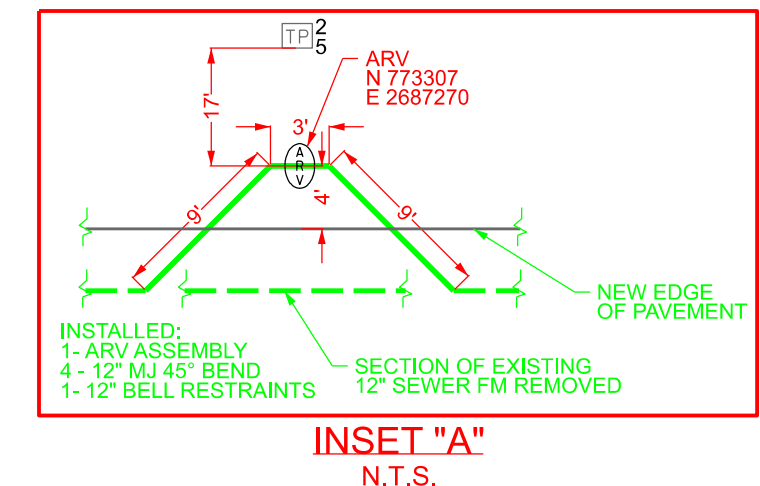
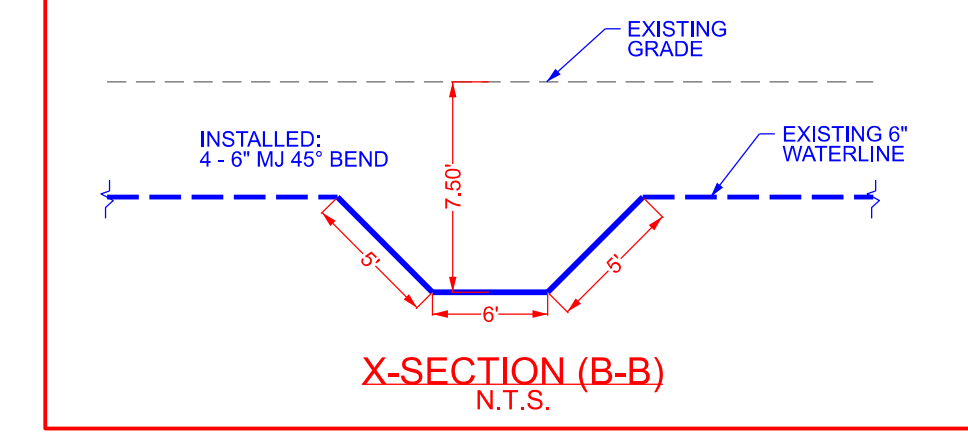


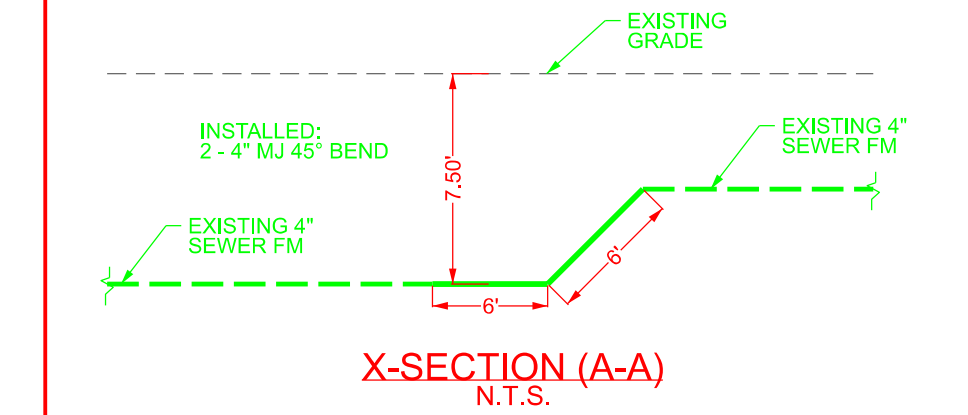

LOCATION MAP
SCALE: N.T.S.

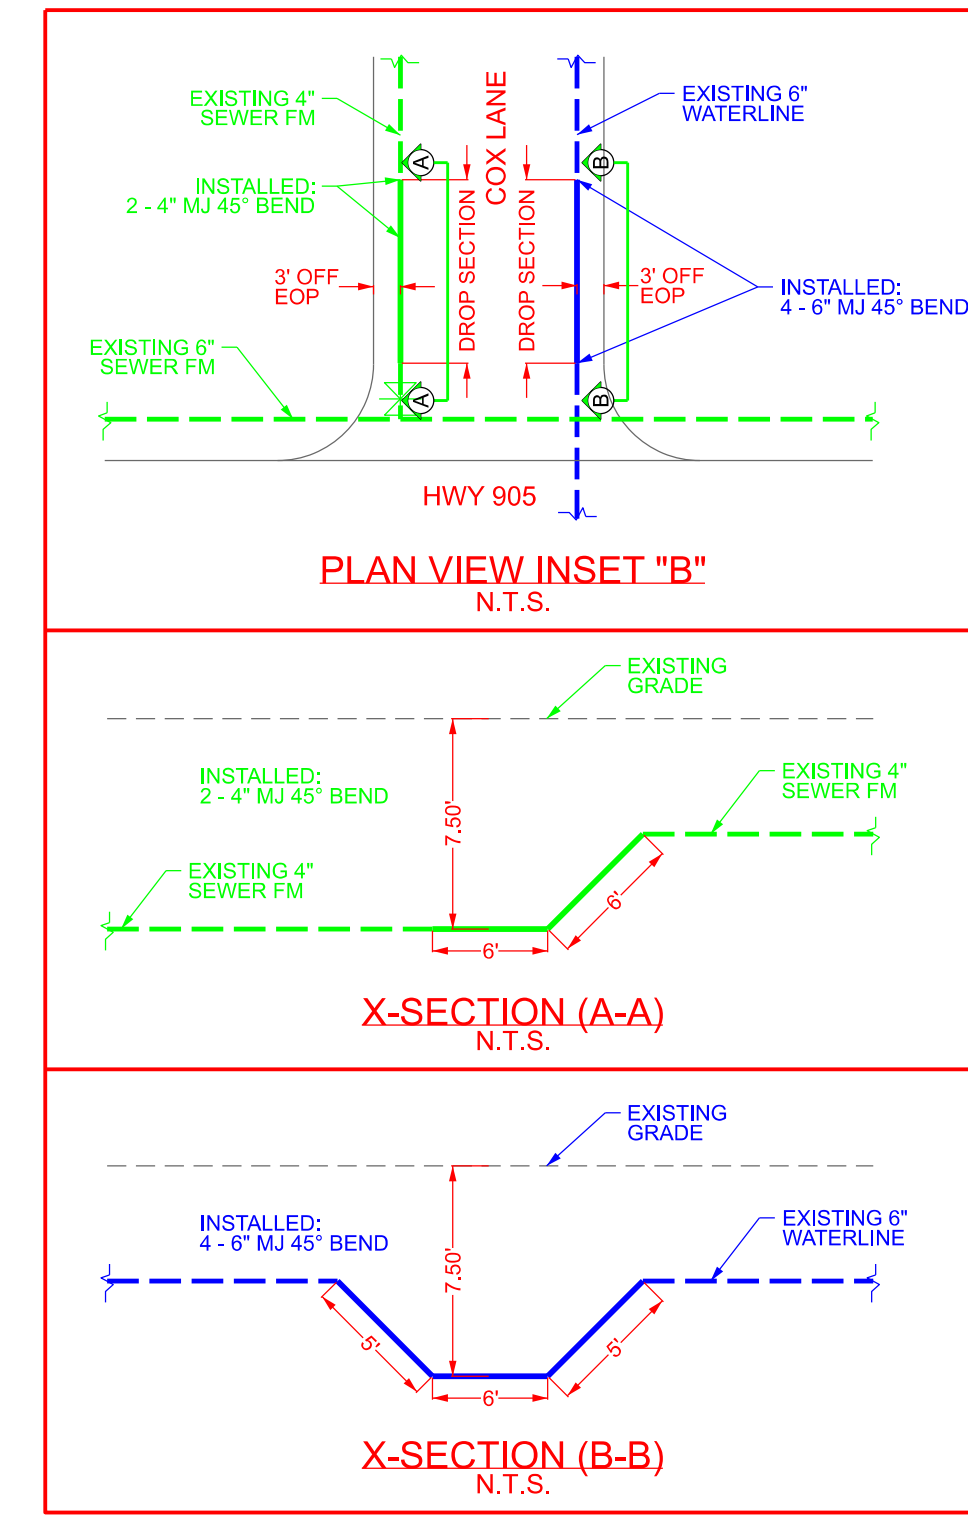

Permit Information:
Horry County Permit #: 2016.0325
SCDOT PERMIT #: 16-00413
DHEC General Sewer Permit #: SCG580000
DHEC General Water Permit #: 162236

Water & Sewer installed by:
GSWSA (Tommy Barfield)

THESE DRAWINGS REFLECT
AS-BUILT
CONDITIONS

REVIEWED BY: _____ DATE: _____
INSPECTIONS

REVIEWED BY: _____ DATE: 12/19/17
ENGINEERING

GRAND STRAND WATER AND SEWER AUTHORITY

AS-BUILT MEASUREMENTS
INDICATED BY
20'

SC HWY 9 & SC HWY 905
INTERSECTION IMPROVEMENT
SCALE: 1" = 50'

25-270-001/1-W/S

REVISION	BY	DATE
1.	T.M.	12-19-17

GRAND STRAND WATER & SEWER AUTHORITY
166 JACKSON BLUFF RD.
CONWAY, SC 29525-2568
(803) 353-5000
(803) 353-5000
E-MAIL: GSWSA.COM

**SC 9 & SC 905
INTERSECTION IMPROVEMENT**
(LOCATED AT THE INTERSECTION OF SC HWY 9 & SC HWY 905)
PROJ. # 605-13 & 960-11

DATE: July 2016
SCALE: as shown
FILENAME: Base Proposed.dgn
DESIGNED BY: Trapper Myers
CHECKED BY: Jason L. Poston
APPROVED BY: _____
CHRISTINA S. EVERETT, PE #21255

SHEET
1
OF 1