



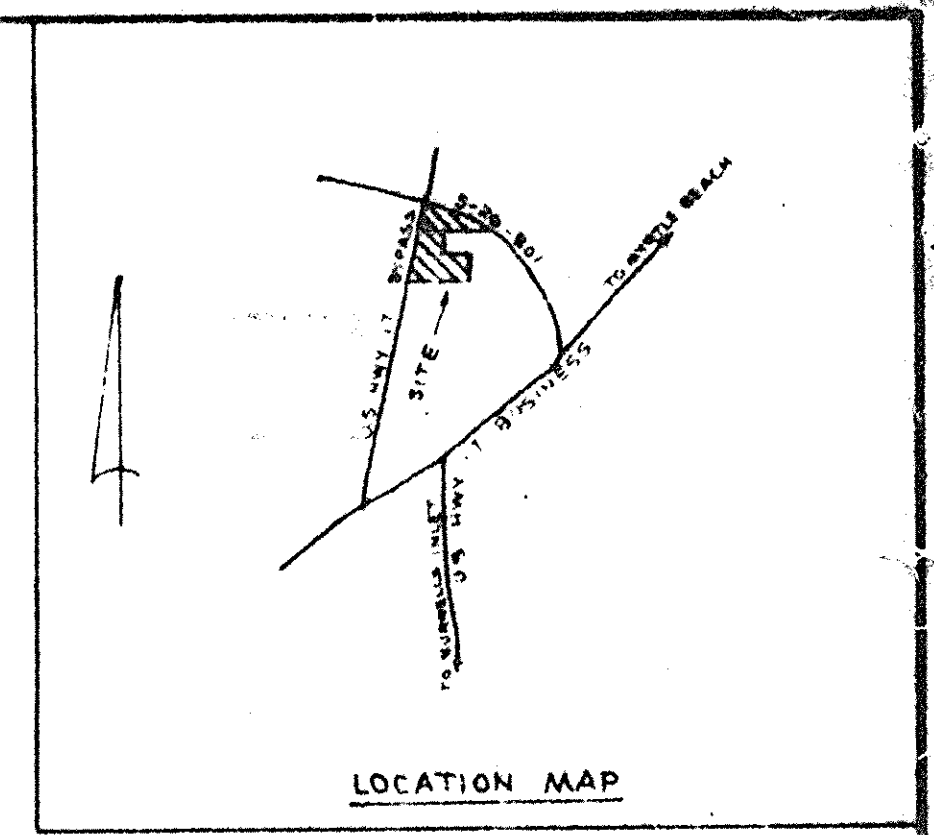

U.S. HIGHWAY #17 BYPASS

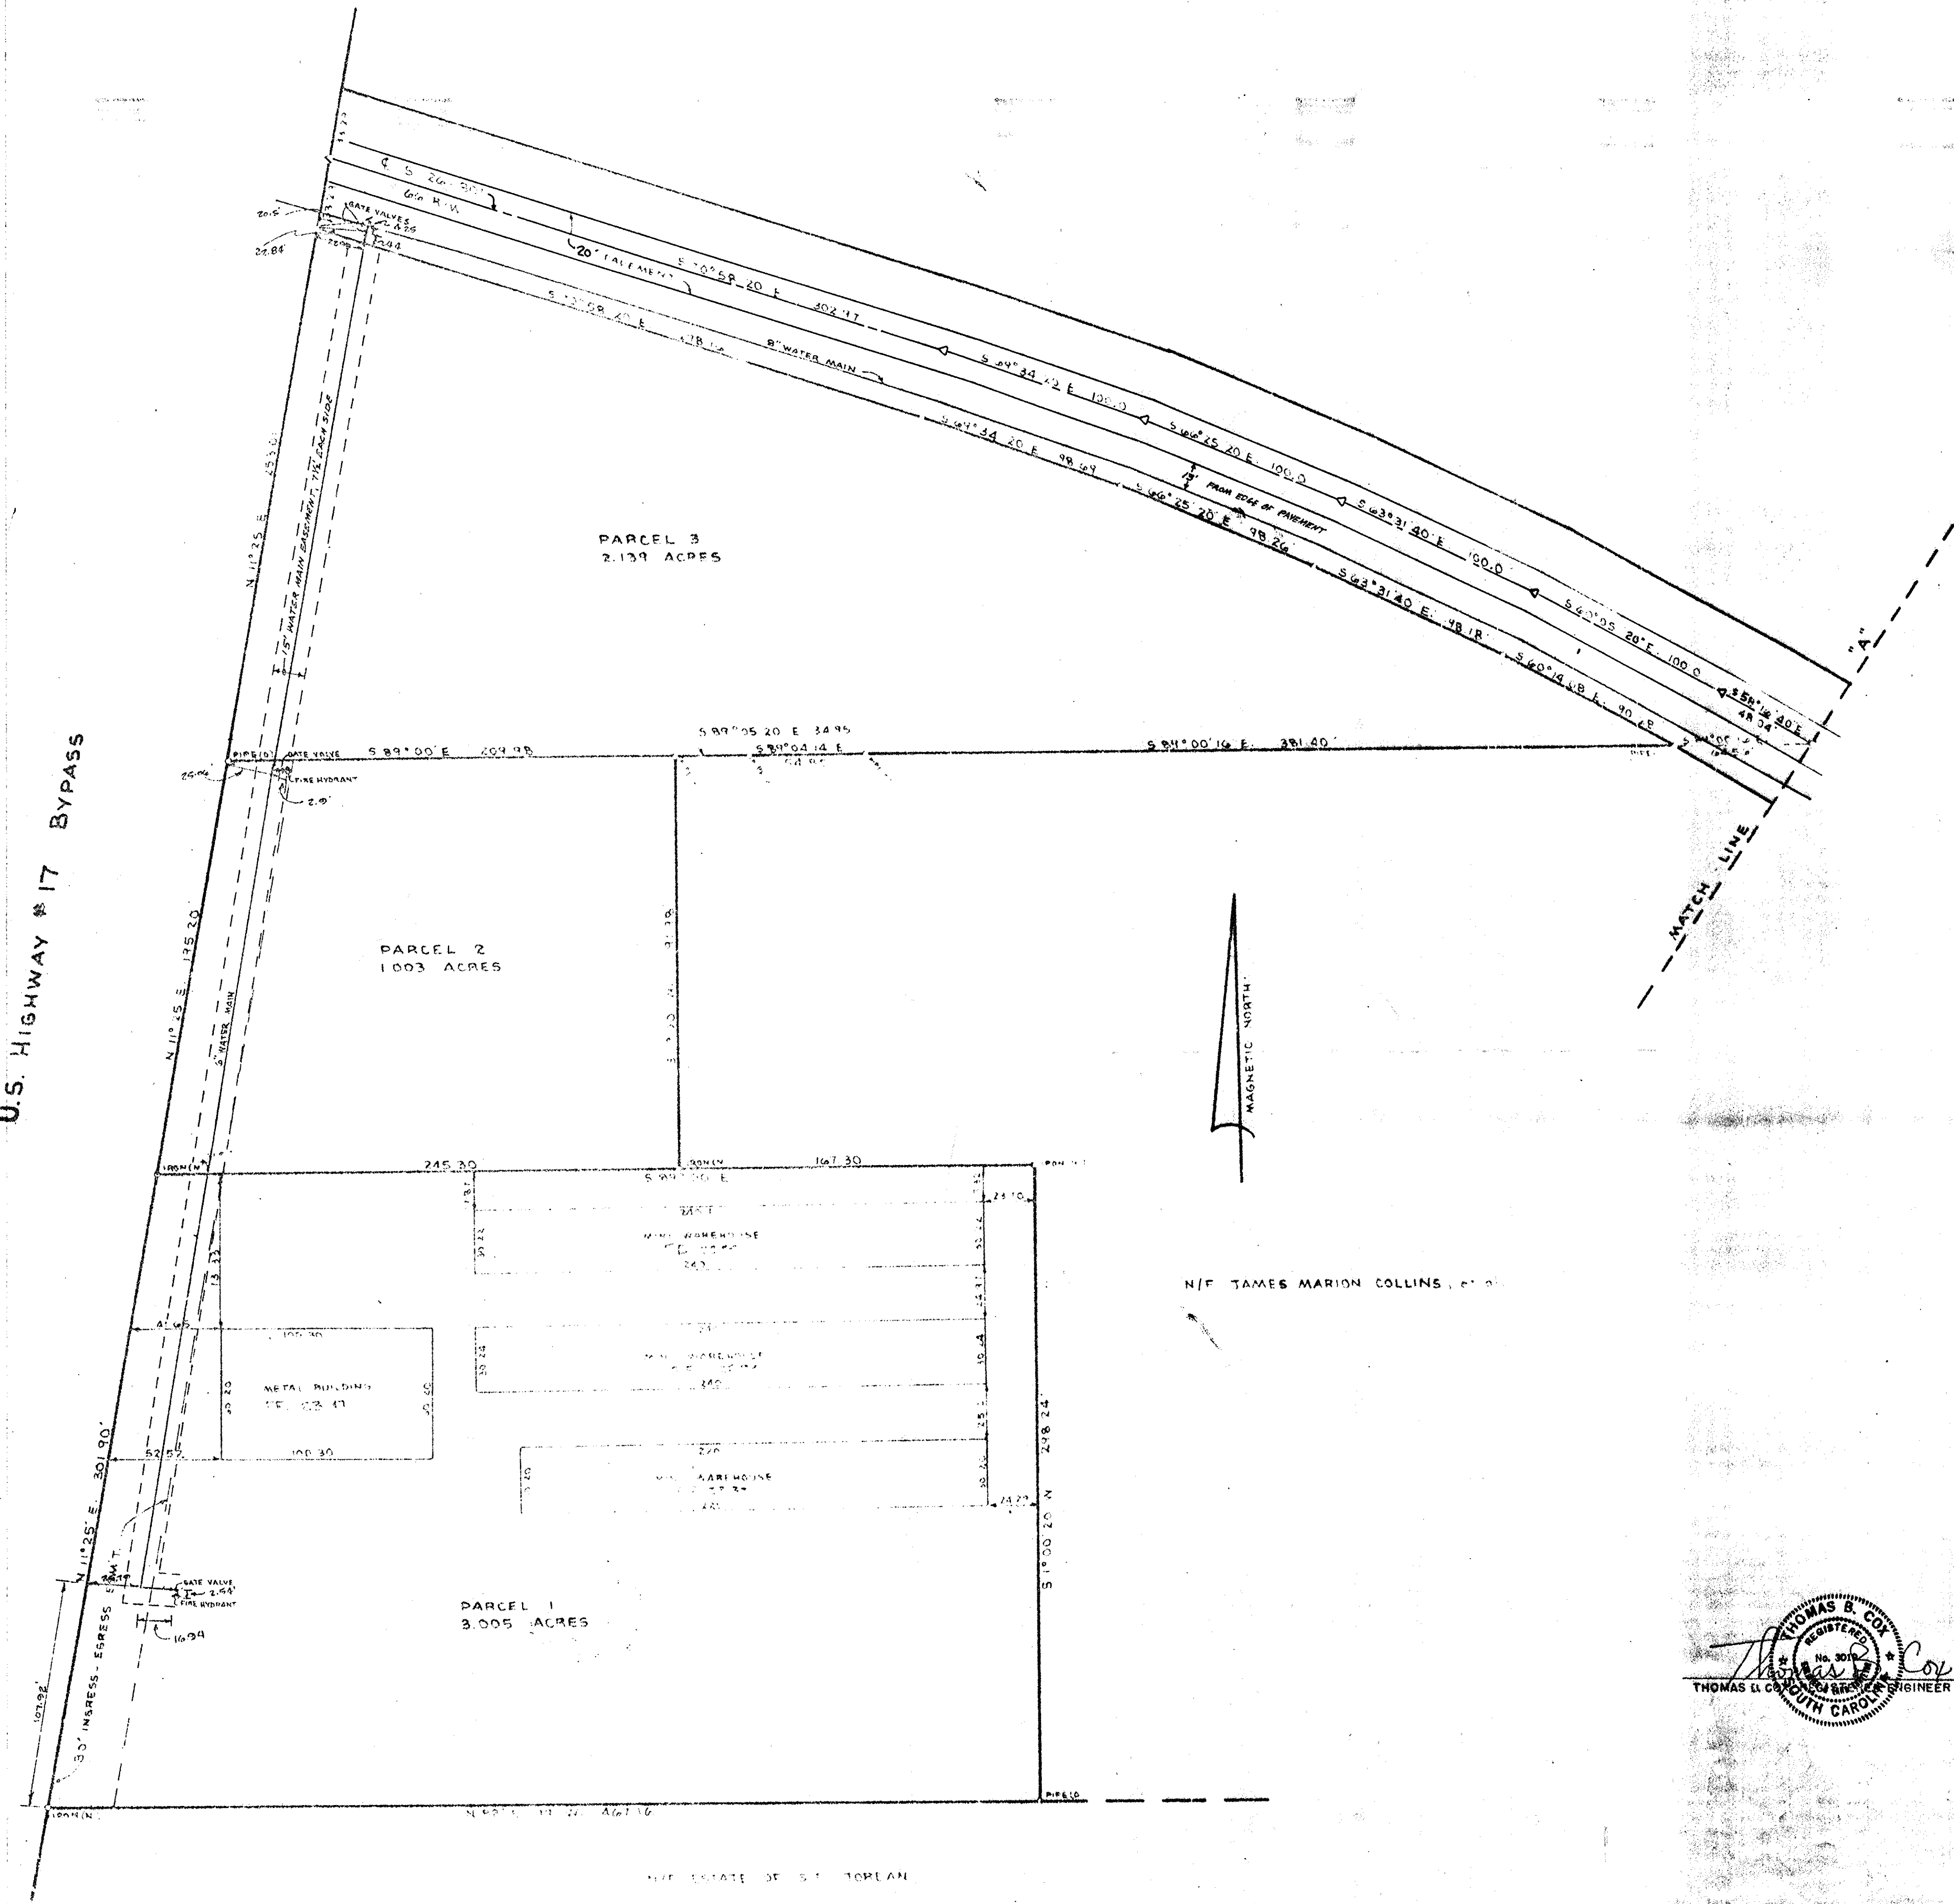

AS-BUILT WATER DISTRIBUTION PLAN OF
3 PARCELS OF LAND CONTAINING 6.147 ACRES AND ALSO
SHOWING THE R/W FOR STATE ROAD 5-26-801 BETWEEN
U.S. HIGHWAY 17 BYPASS AND U.S. HIGHWAY 17 BUSINESS
SOCASTEE TWP - HORRY CO. S.C.
SURVEYED FOR
A & H CONSTRUCTION CO., INC.

SCALE: 1"=40'
JUNE 3, 1985
CULLER LAND SURVEYING CO., INC. SURFSIDE BEACH, S.C.
REFERENCE: PLAT OF SEVERAL TRACTS OF LAND SURVEYED FOR JAMES MARION COLLINS, et al BY WENDELL C. POWERS DATED MARCH 27, 1977 AND REVISED MAY 26, 1979



RECEIVED
JUL 09 1985
ENGINEERING DEPT.


THE RATIO OF PRECISION OF THE FIELD SURVEY IS 1:10,000 AND THE AREA WAS DETERMINED BY THE DMD METHOD

Wm. H. Durbin
WILLIAM H. DURBIN R.L.S. #8099


Fixed Assets
7-23-86 R.F.

20-22-00/4-WS

SHEET 1 OF 2

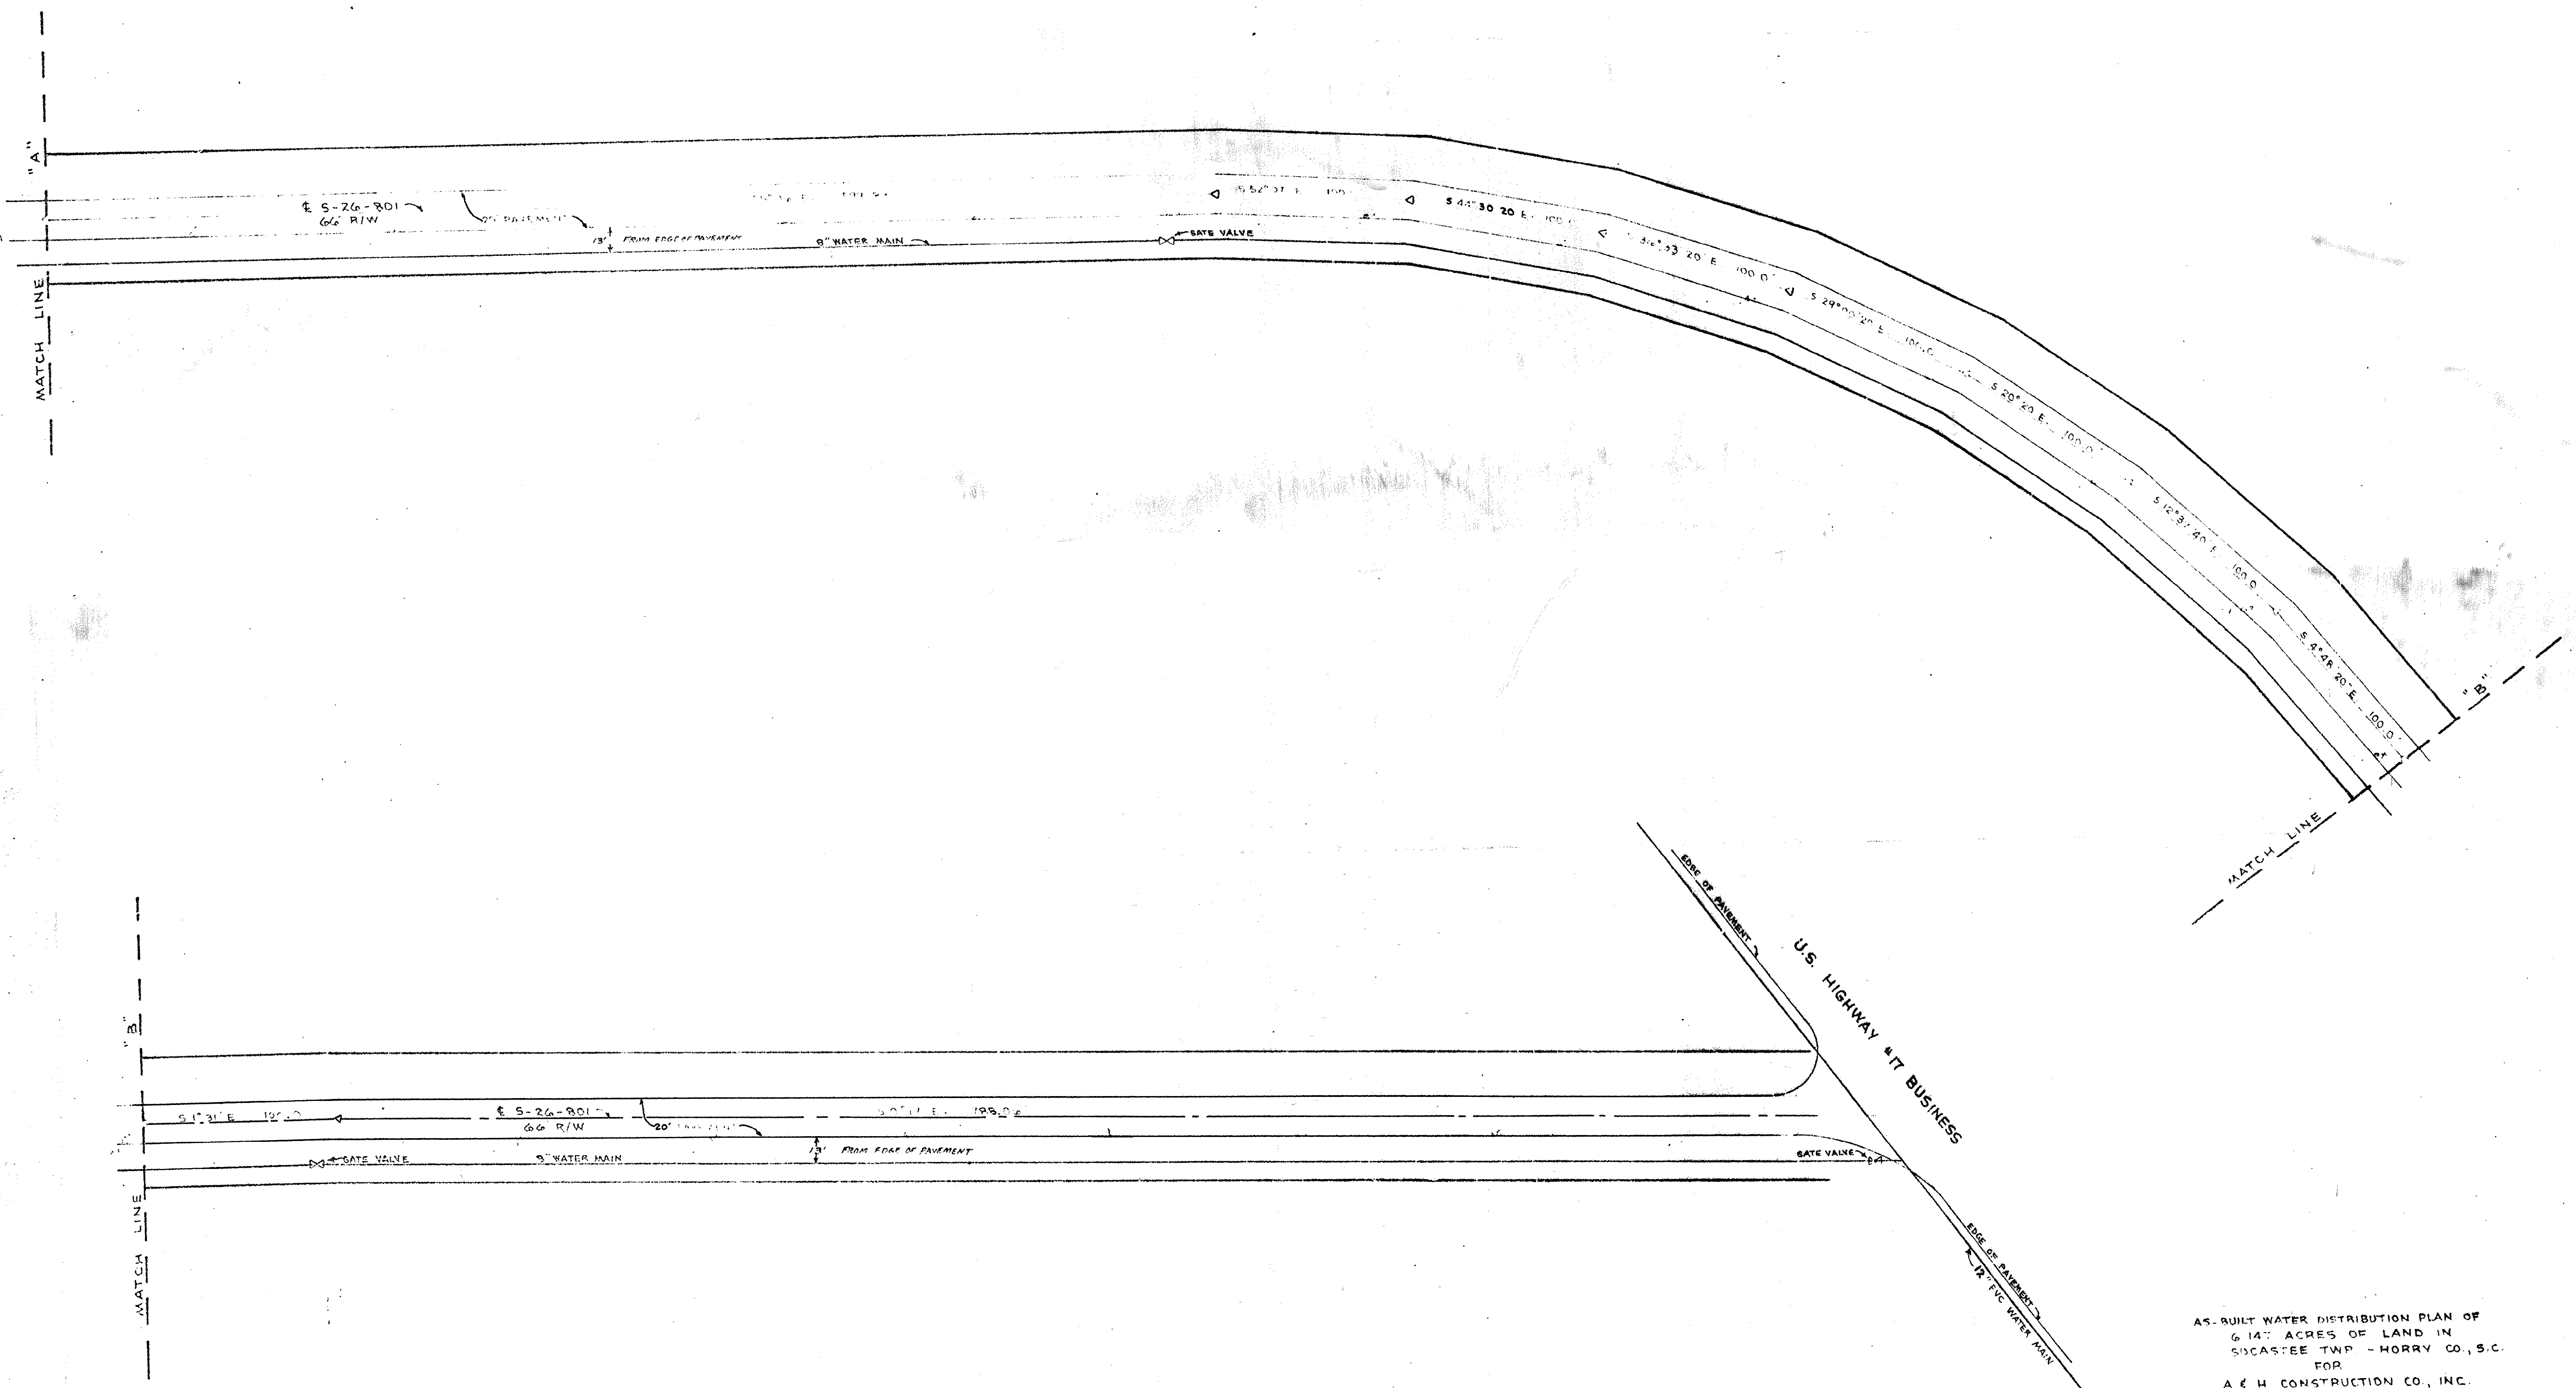


AS-BUILT WATER DISTRIBUTION PLAN OF
 6.147 ACRES OF LAND IN
 SIOCASTEE TWP - HORRY CO., S.C.
 FOR
 A & H CONSTRUCTION CO., INC.
 SCALE 1" = 40' JUNE 3, 1985
 CULLER LAND SURVEYING CO., INC.

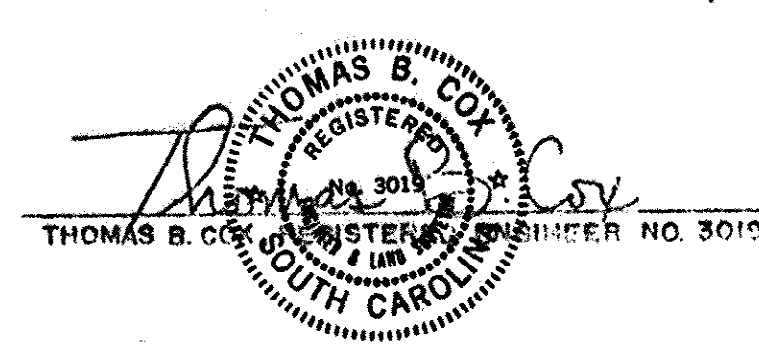


RECEIVED
 JUL 09 1985
 ENGINEERING DEPT.

FIXED ASSETS
 7-23-86 RF

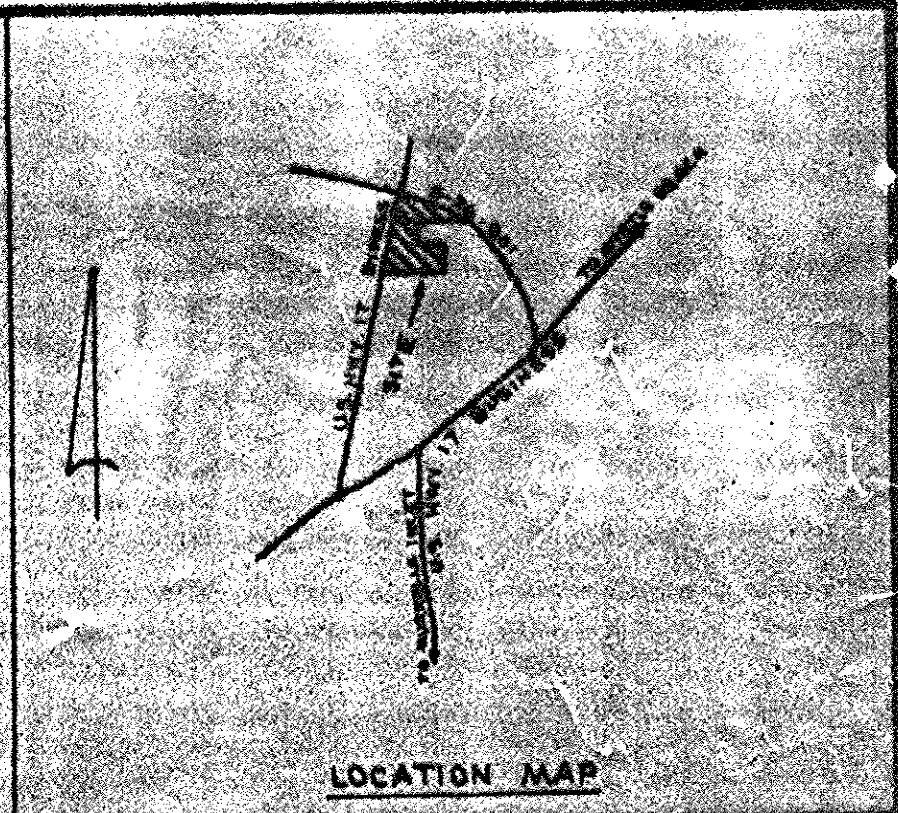

U.S. HIGHWAY #17 BYPASS

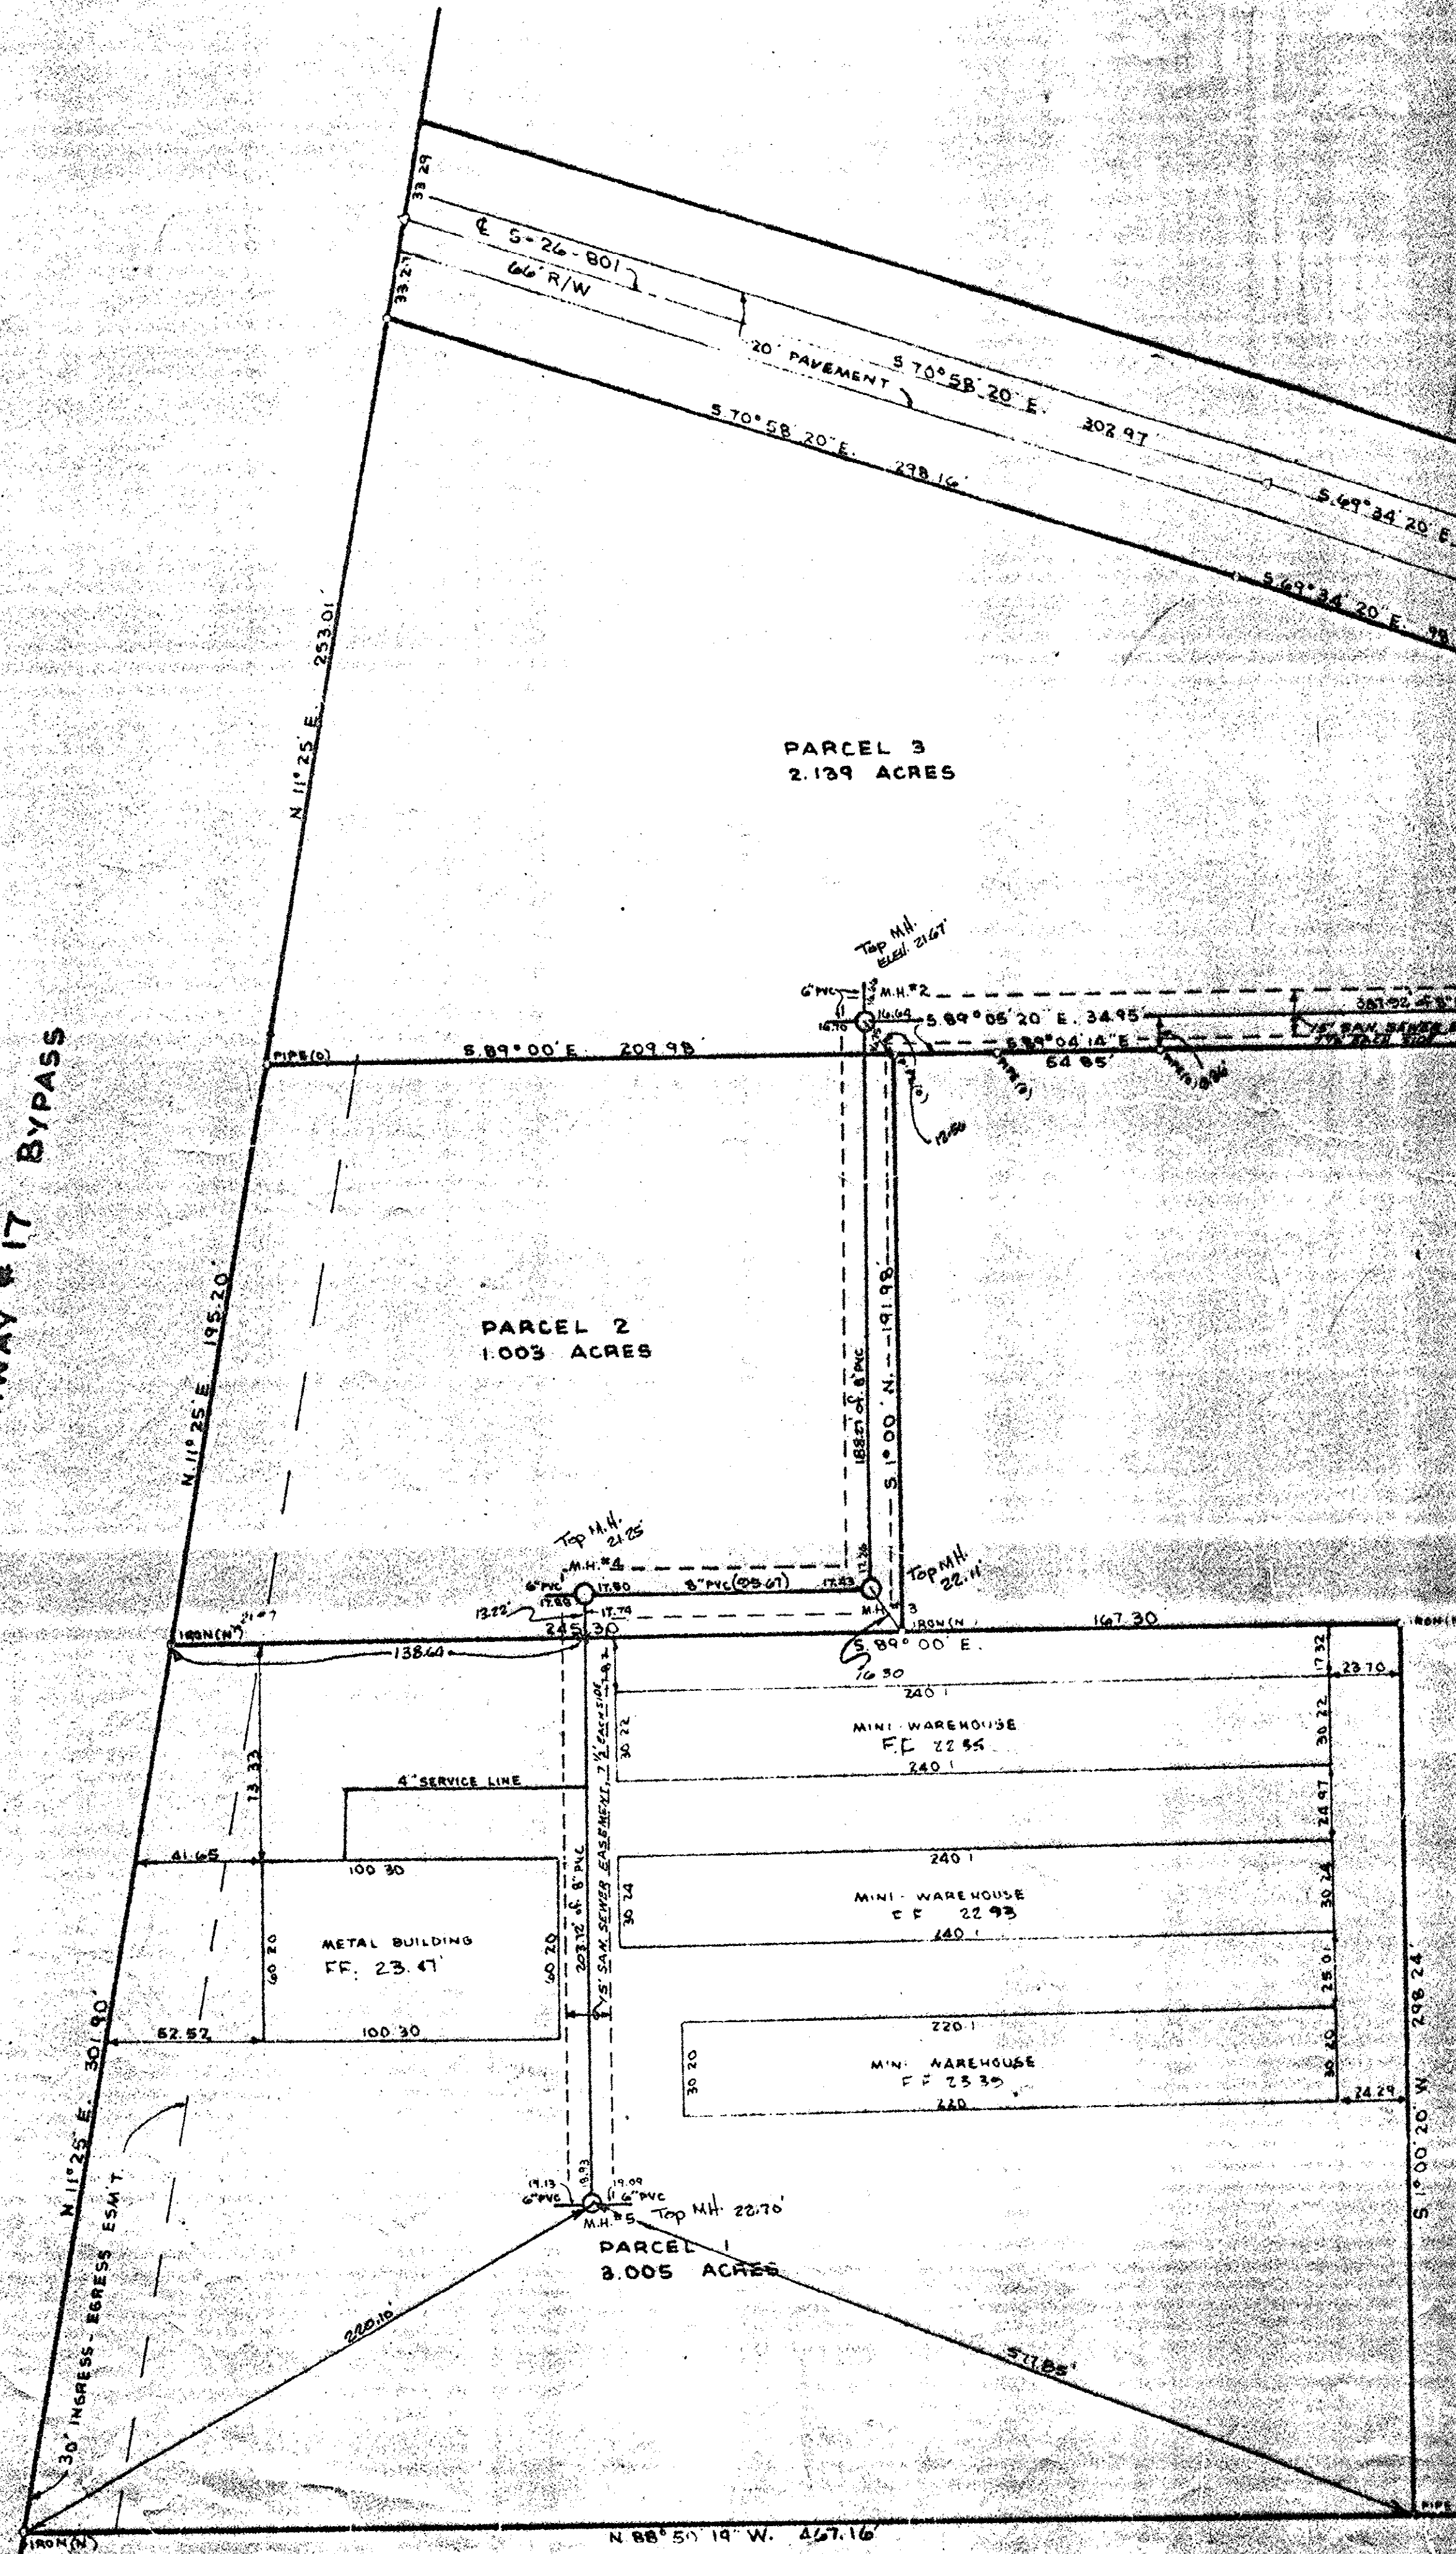


N/F JAMES MARION COLLINS, ET AL.


N/F ESTATE OF ST. JORDAN



AS-BUILT SANITARY SEWER PLANS OF
3 PARCELS OF LAND CONTAINING 6.127 ACRES AND ALSO
SHOWING THE R/W FOR STATE ROAD S-26-801 BETWEEN
U.S. HIGHWAY 17 BYPASS AND U.S. HIGHWAY 17 BUSINESS
SOCASTEE TWP - Horry Co., S.C.
SURVEYED FOR
A & H CONSTRUCTION CO., INC.

SCALE: 1"=40'
CULLER LAND SURVEYING CO., INC. SURFERS BEACH, S.C.
REFERENCE: PLAT OF SEVERAL TRACTS OF LAND SURVEYED FOR JAMES MARION
COLLINS, ET AL. BY MARGELL C. POWERS DATED MARCH 27, 1977 AND
REVISED MAY 26, 1978

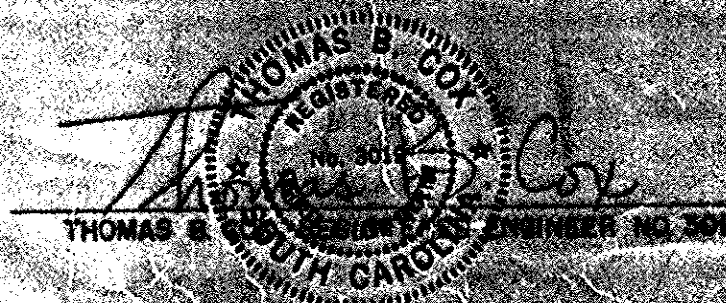

THE RATIO OF PRECISION OF THE FIELD SURVEY IS 1/10,000 AND THE AREA
WAS DETERMINED BY THE D.M.D. METHOD
William V. Durden
WILLIAM V. DURDEN R.E.S. #6094

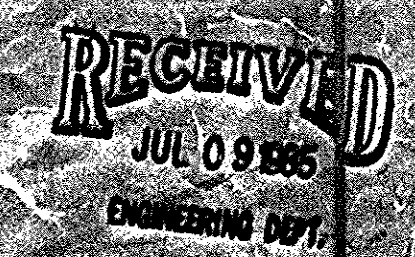

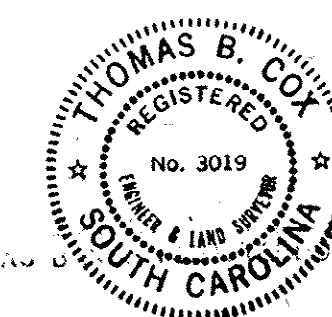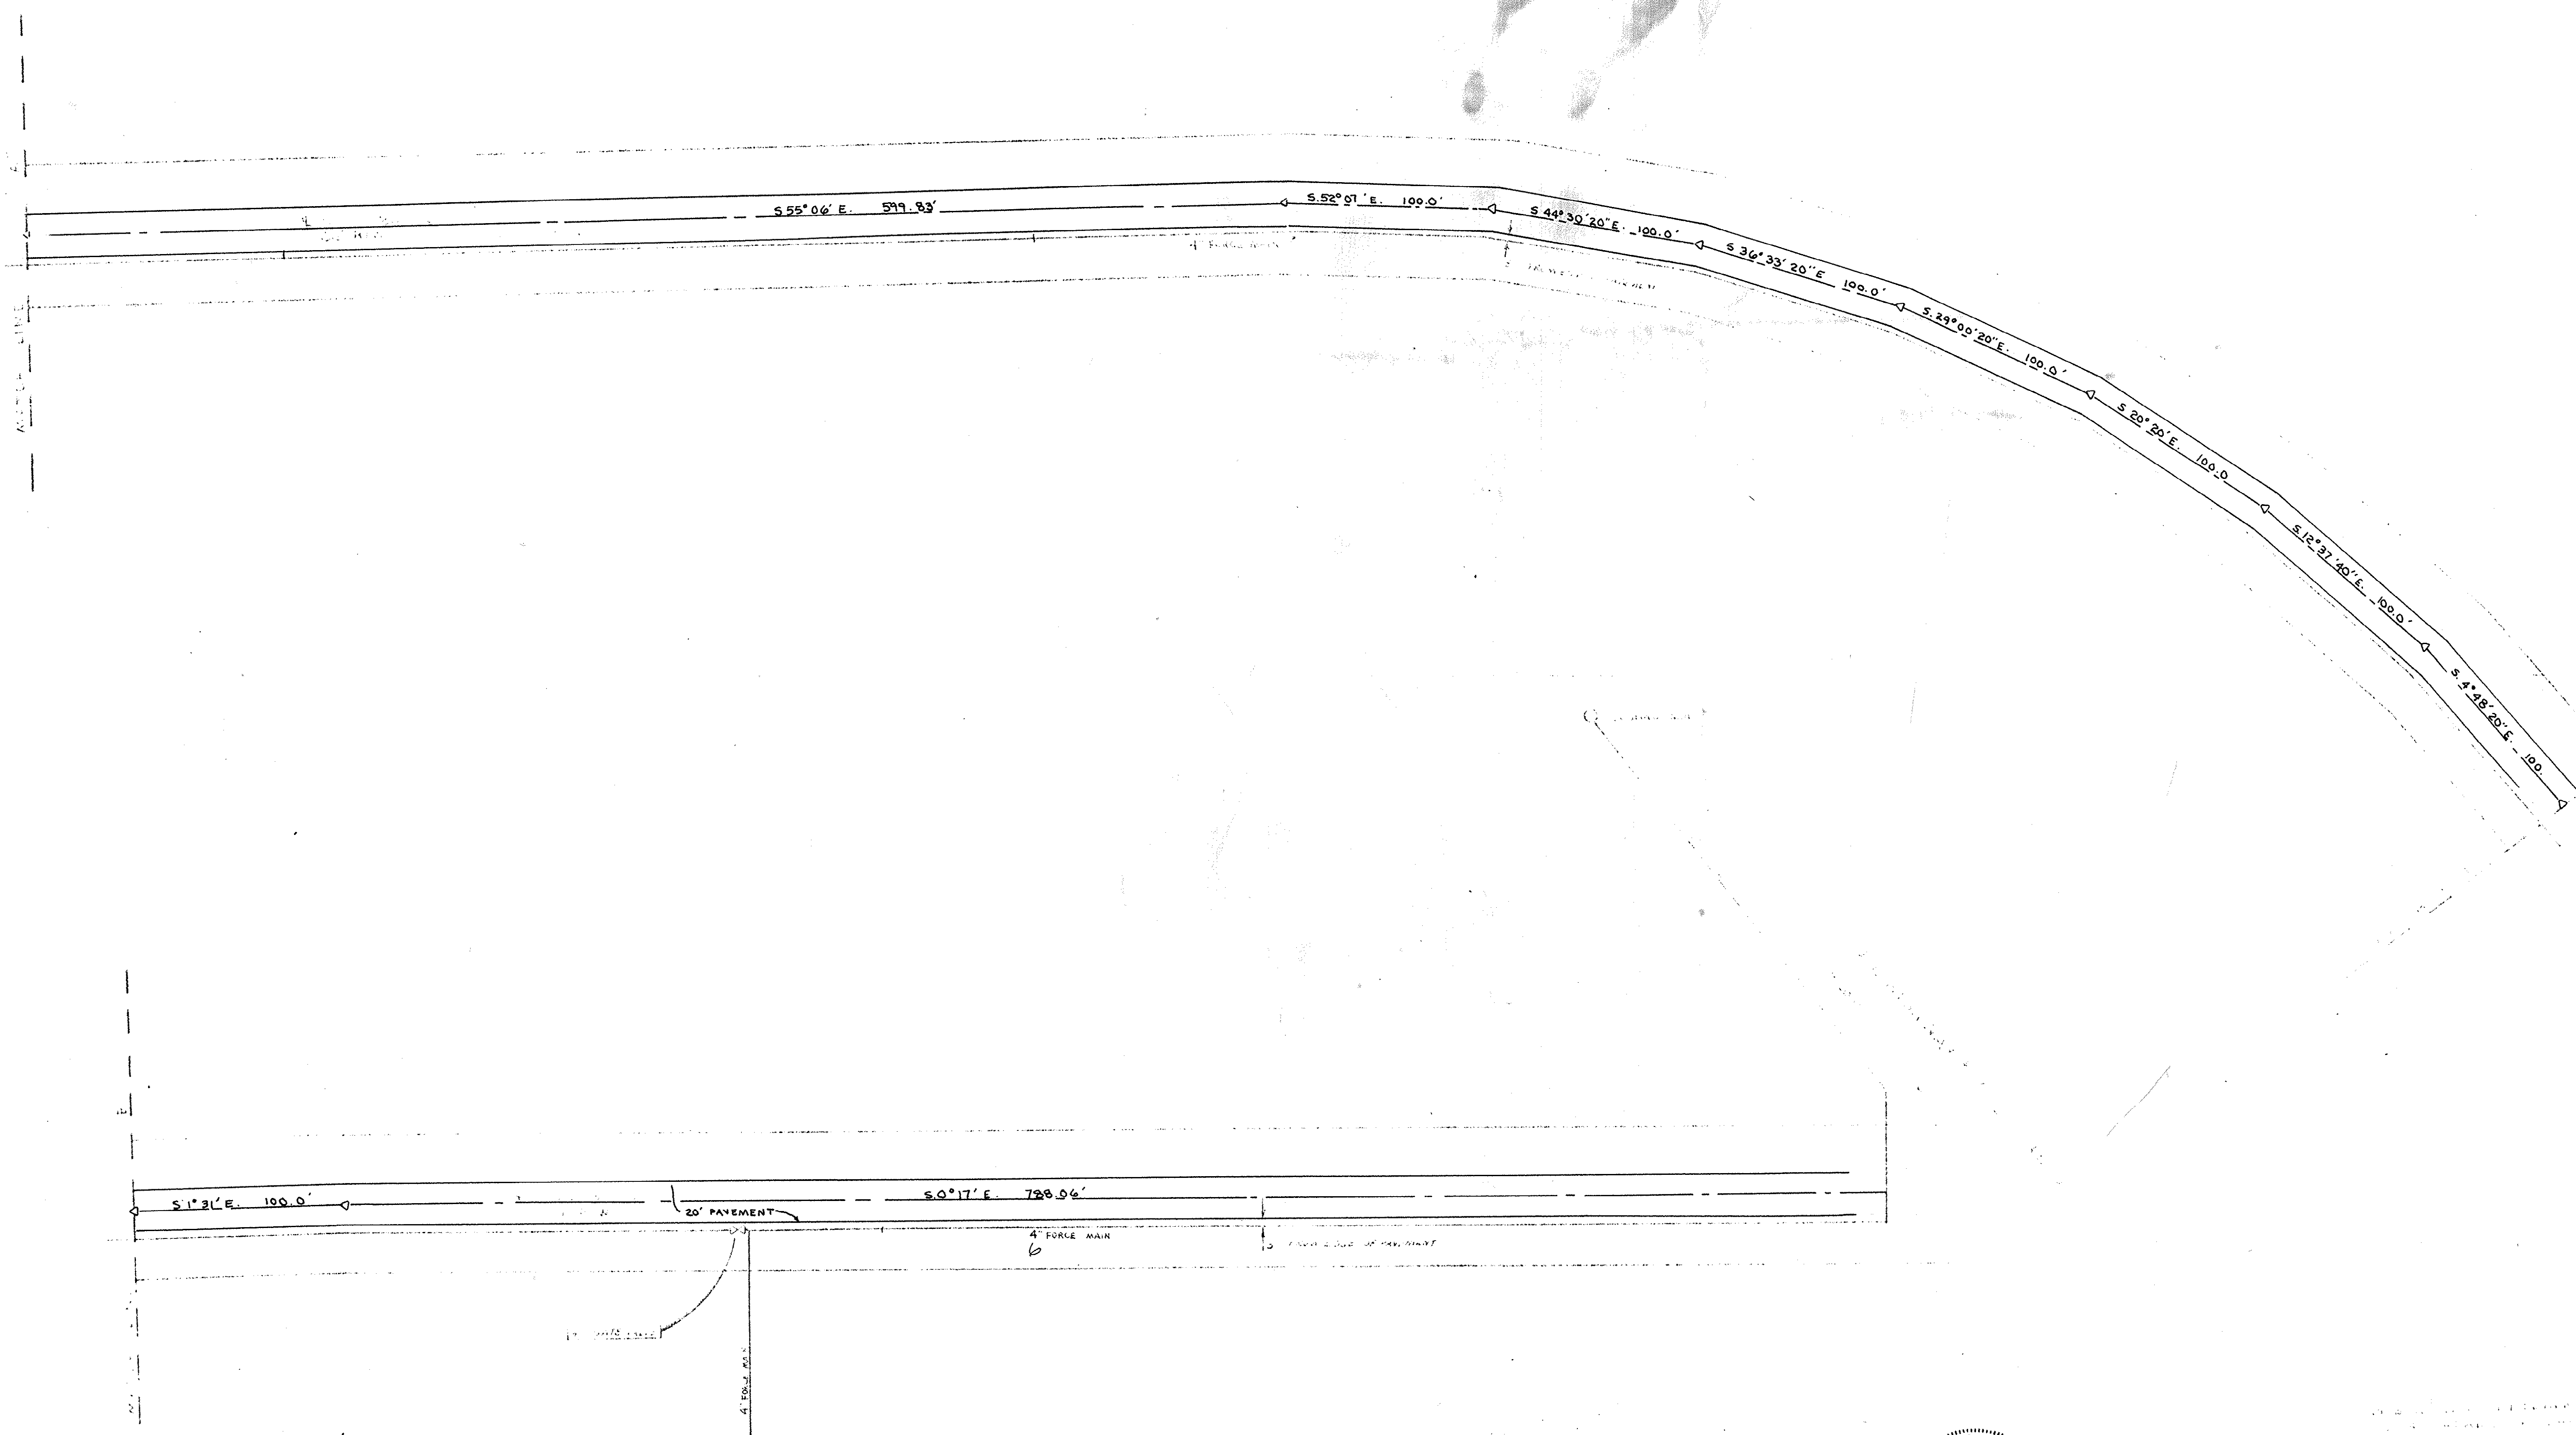

Fixed Asset
7-27-86 PM

RECEIVED
JUL 09 1986
ENGINEERING DEPT.