
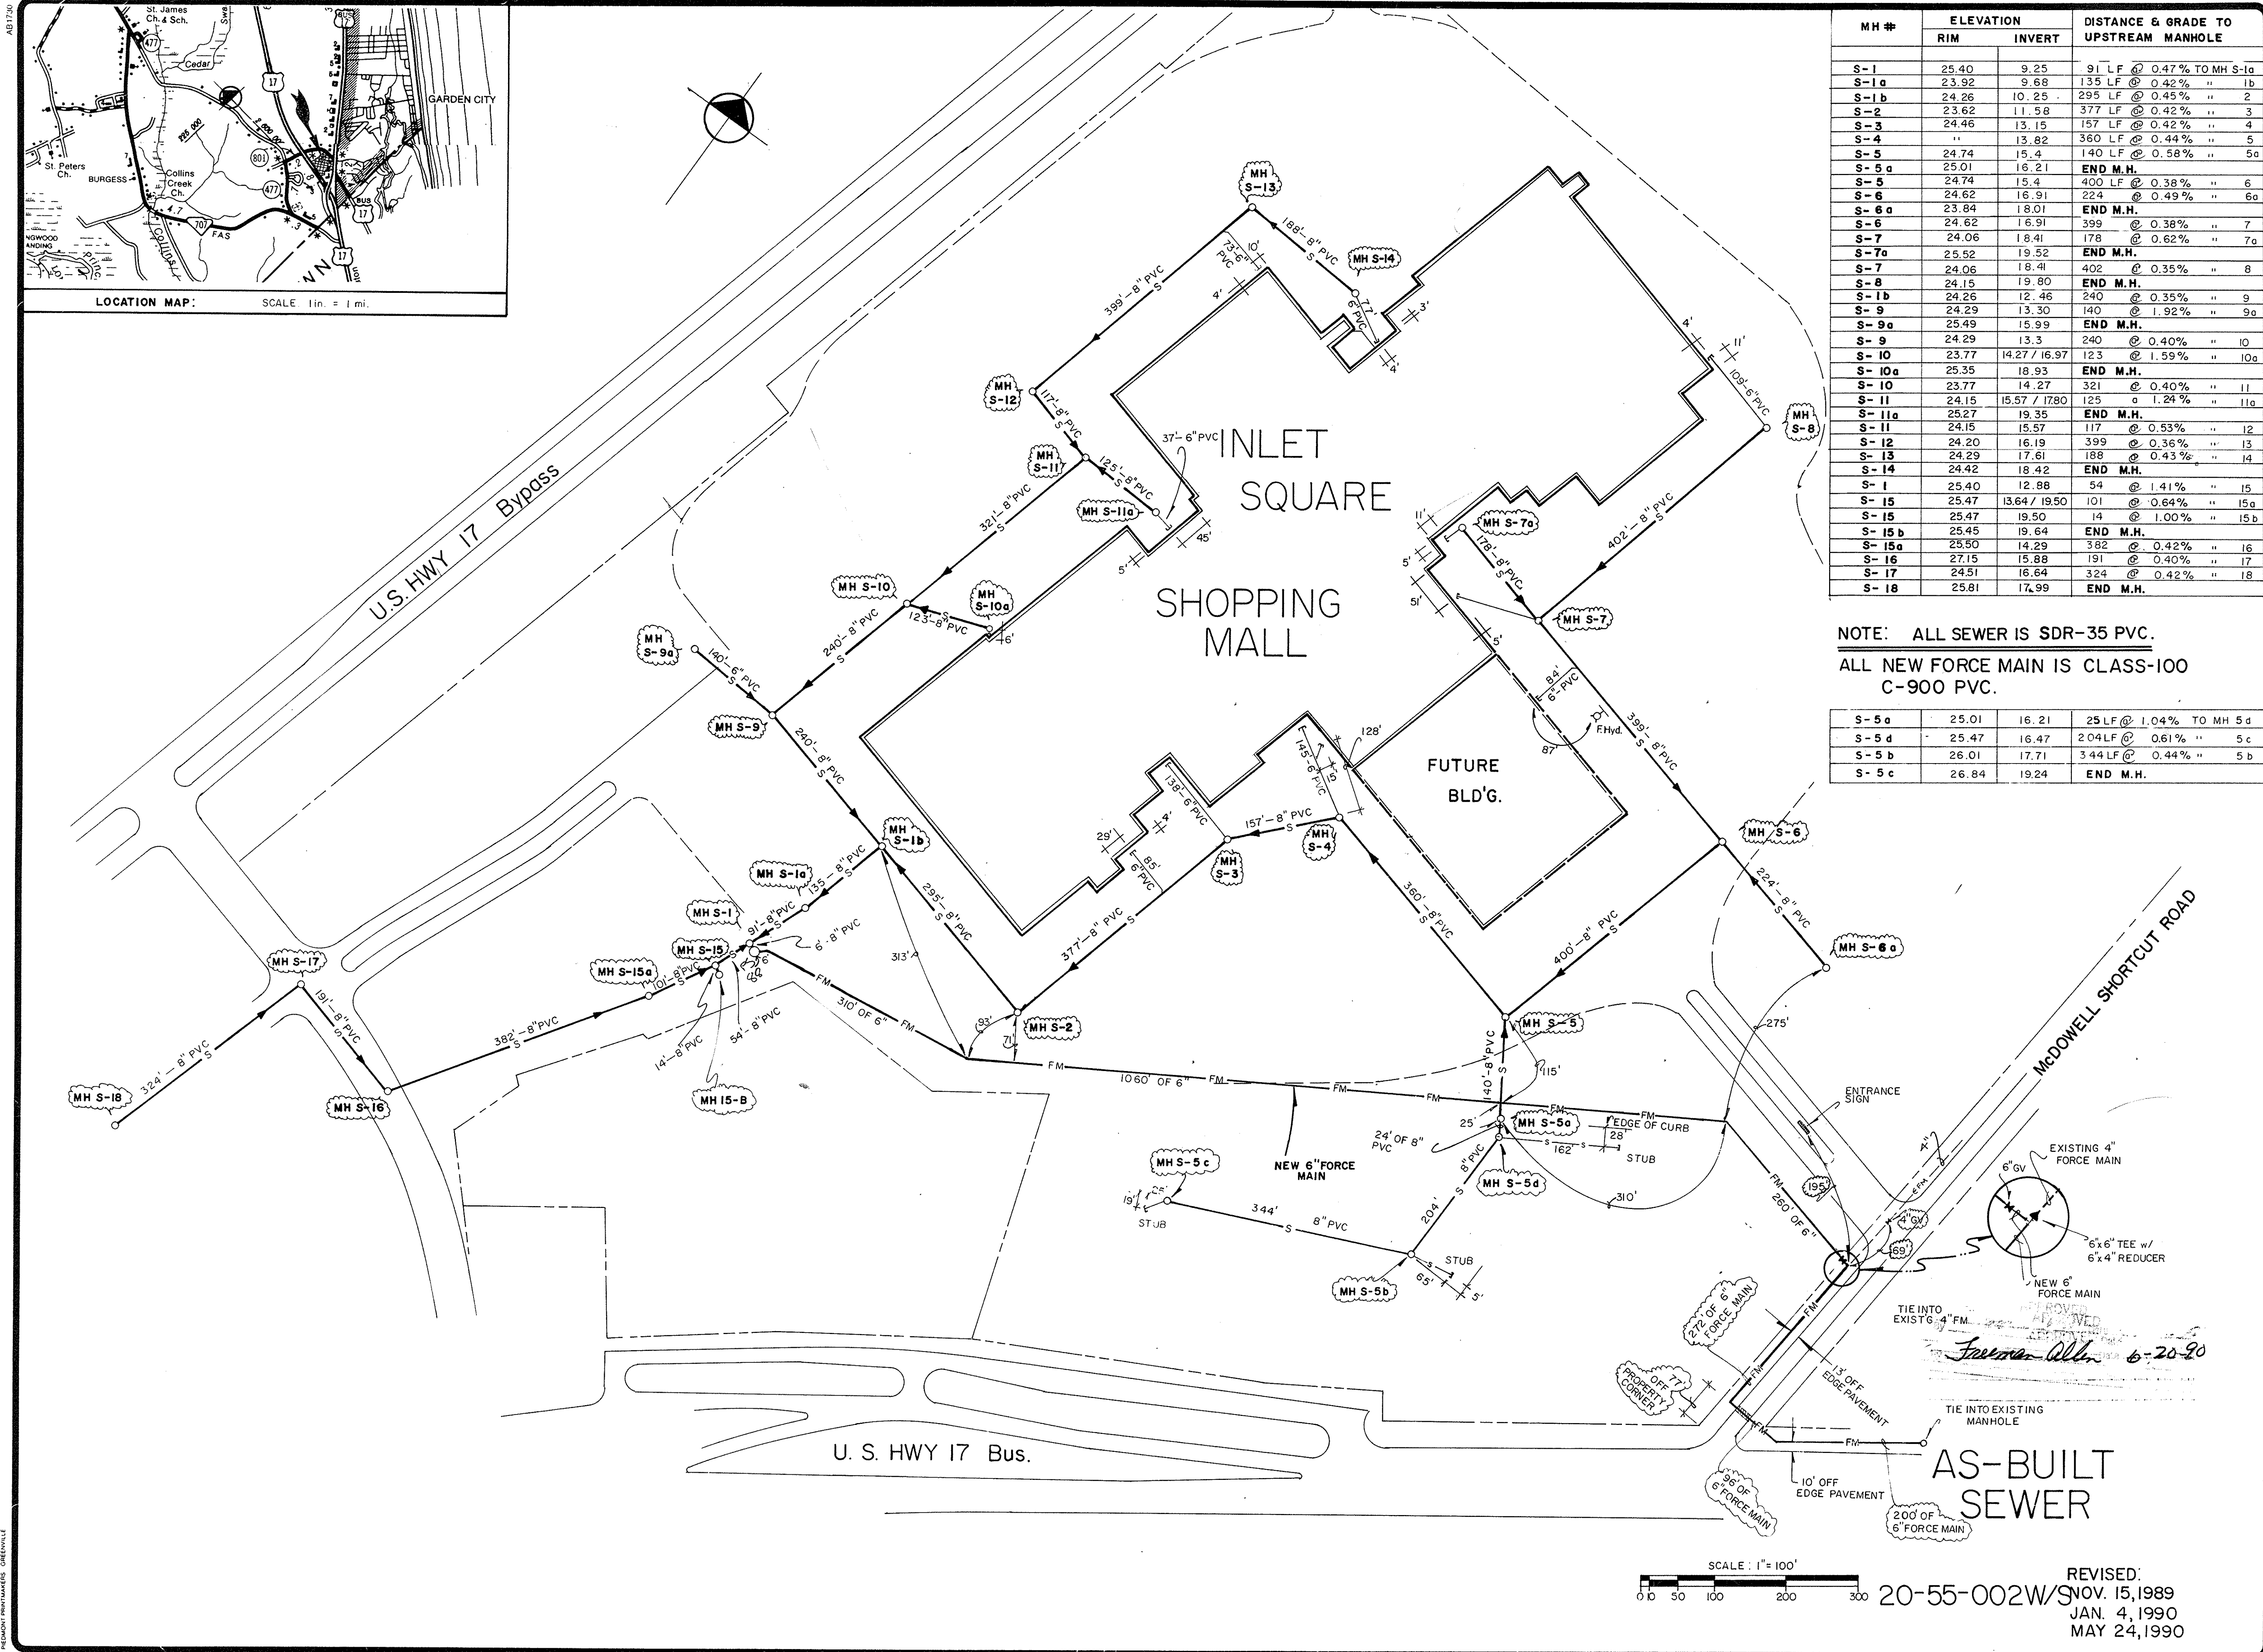



AB17-30

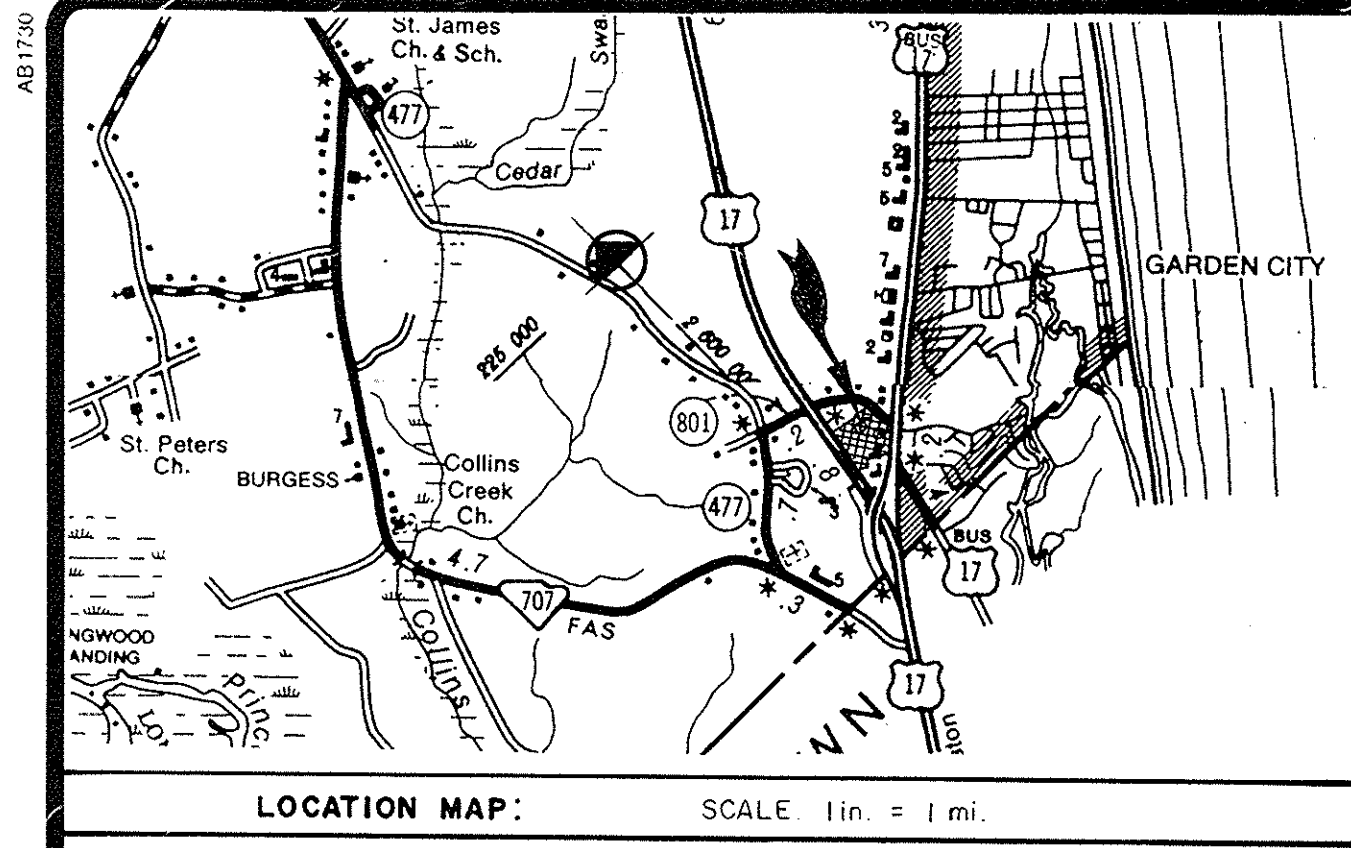

MH #	ELEVATION		DISTANCE & GRADE TO UPSTREAM MANHOLE
	RIM	INVERT	
S-1	25.40	9.25	91 LF @ 0.47% TO MH S-1a
S-1a	23.92	9.68	135 LF @ 0.42% " 1b
S-1b	24.26	10.25	295 LF @ 0.45% " 2
S-2	23.62	11.58	377 LF @ 0.42% " 3
S-3	24.46	13.15	157 LF @ 0.42% " 4
S-4	"	13.82	360 LF @ 0.44% " 5
S-5	24.74	15.4	140 LF @ 0.58% " 5a
S-5a	25.01	16.21	END M.H.
S-5	24.74	15.4	400 LF @ 0.38% " 6
S-6	24.62	16.91	224 @ 0.49% " 6a
S-6a	23.84	18.01	END M.H.
S-6	24.62	16.91	399 @ 0.38% " 7
S-7	24.06	18.41	178 @ 0.62% " 7a
S-7a	25.52	19.52	END M.H.
S-7	24.06	18.41	402 @ 0.35% " 8
S-8	24.15	19.80	END M.H.
S-1b	24.26	12.46	240 @ 0.35% " 9
S-9	24.29	13.30	140 @ 1.92% " 9a
S-9a	25.49	15.99	END M.H.
S-9	24.29	13.3	240 @ 0.40% " 10
S-10	23.77	14.27 / 16.97	123 @ 1.59% " 10a
S-10a	25.35	18.93	END M.H.
S-10	23.77	14.27	321 @ 0.40% " 11
S-11	24.15	15.57 / 17.80	125 @ 1.24% " 11a
S-11a	25.27	19.35	END M.H.
S-11	24.15	15.57	117 @ 0.53% " 12
S-12	24.20	16.19	399 @ 0.36% " 13
S-13	24.29	17.61	188 @ 0.43% " 14
S-14	24.42	18.42	END M.H.
S-1	25.40	12.88	54 @ 1.41% " 15
S-15	25.47	13.64 / 19.50	101 @ 0.64% " 15a
S-15	25.47	19.50	14 @ 1.00% " 15b
S-15b	25.45	19.64	END M.H.
S-15a	25.50	14.29	382 @ 0.42% " 16
S-16	27.15	15.88	191 @ 0.40% " 17
S-17	24.51	16.64	324 @ 0.42% " 18
S-18	25.81	17.99	END M.H.

NOTE: ALL SEWER IS SDR-35 PVC.
ALL NEW FORCE MAIN IS CLASS-100
C-900 PVC.

S-5a	25.01	16.21	25 LF @ 1.04% TO MH S-d
S-5d	25.47	16.47	204 LF @ 0.61% " 5c
S-5b	26.01	17.71	344 LF @ 0.44% " 5b
S-5c	26.84	19.24	END M.H.

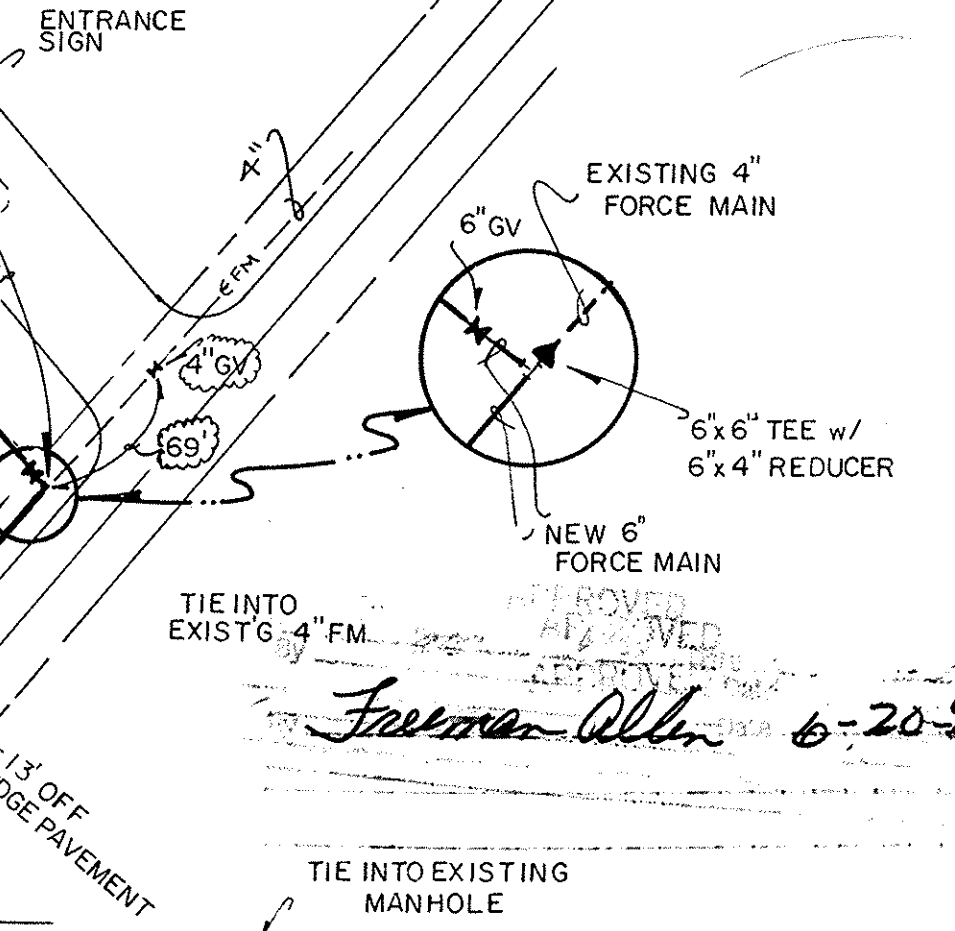

AS-BUILT
SEWER

REVISIONS:
NOV. 15, 1989
JAN. 4, 1990
MAY 24, 1990

CBL & ASSOCIATES
ONE PARK PLACE
6143 LEE HWY
CHATTANOOGA, TN 37421

INLET SQUARE SHOPPING
CENTER

AS-BUILT SEWER

MCDOWELL ENGINEERING
P. O. BOX 276
MURRELLS INLET, SOUTH CAROLINA



KENNETH MCDOWELL, P.E., R.L.S.

DRAWN
& LACY CANNON
CHECKED

DATE
AUG. 17, 1989
SCALE
AS SHOWN
JOB NO.
E-282-88
SHEET
1

OF 2 SHEETS


AB1730

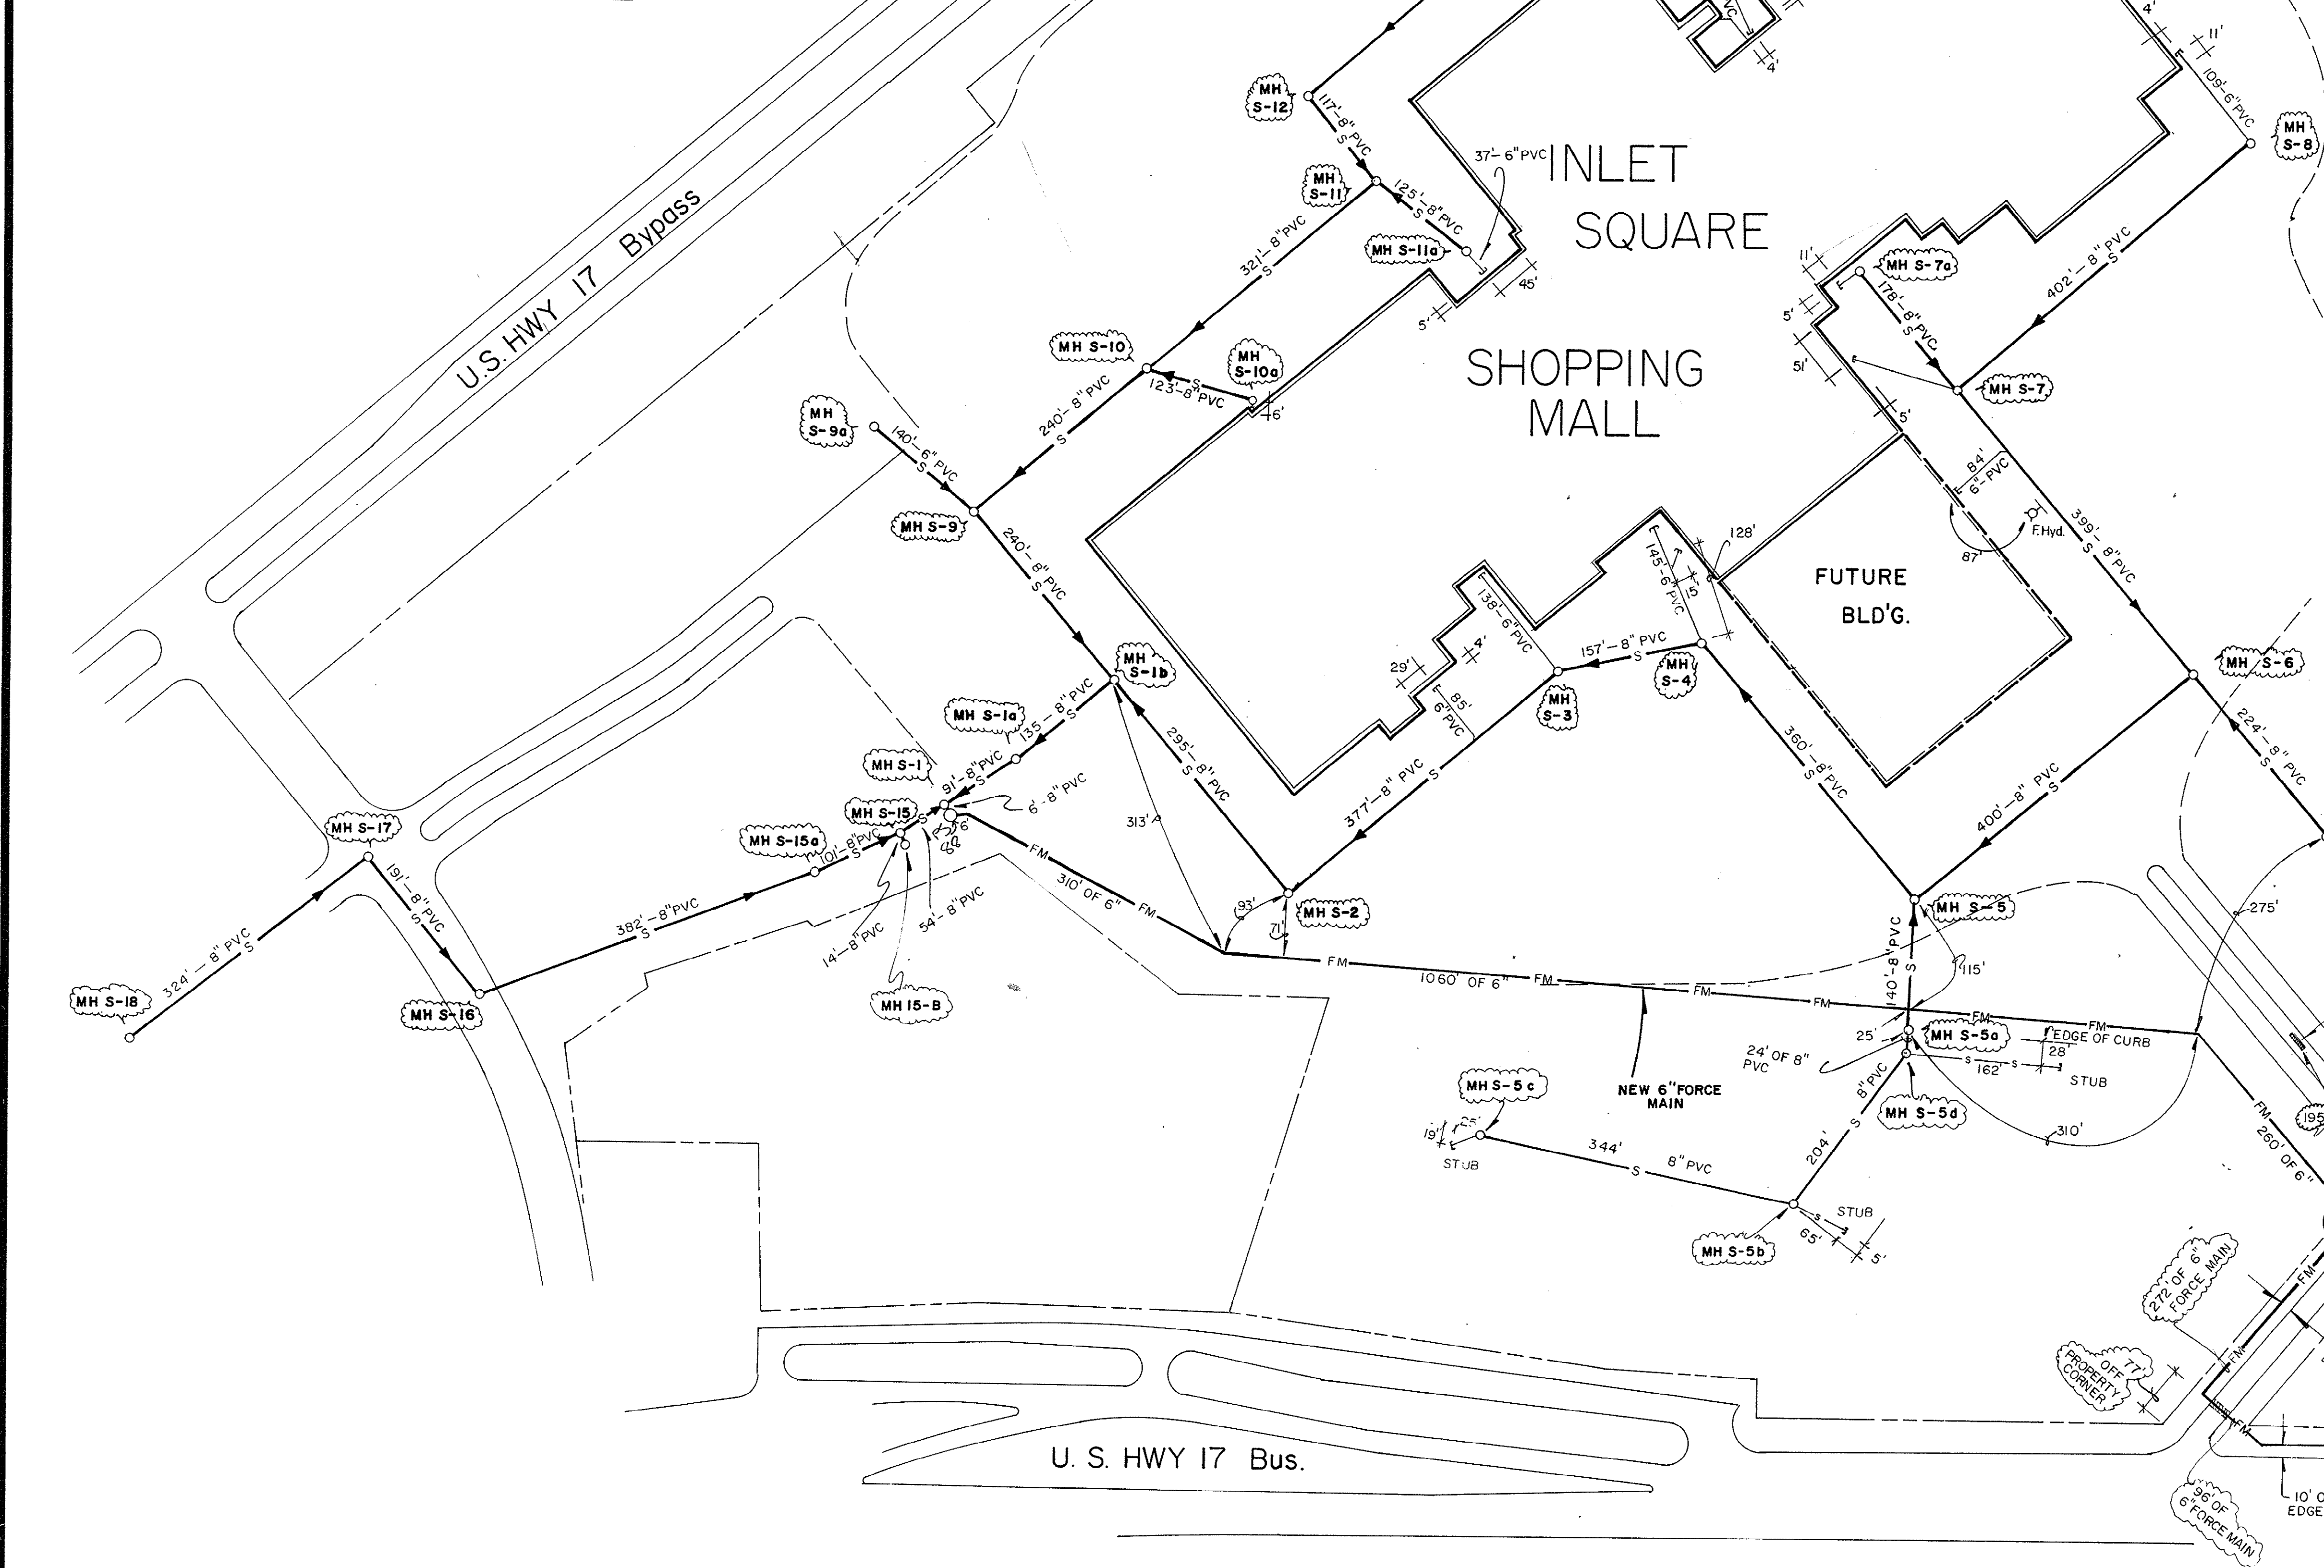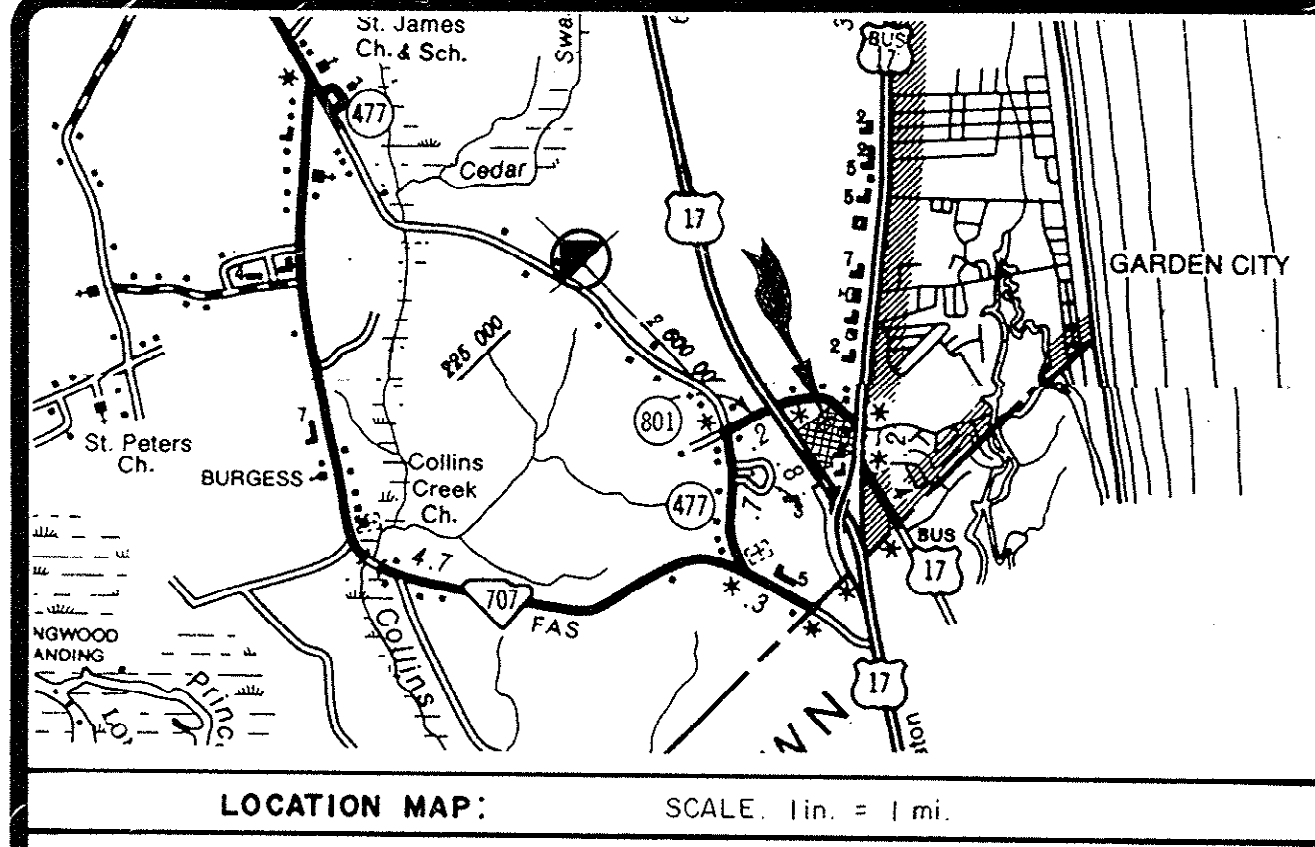

MH #	ELEVATION		DISTANCE & GRADE TO UPSTREAM MANHOLE
	RIM	INVERT	
S-1	25.40	9.25	91 LF @ 0.47% TO MH S-1a
S-1a	23.92	9.68	135 LF @ 0.42% " 1b
S-1b	24.26	10.25	295 LF @ 0.45% " 2
S-2	23.62	11.58	377 LF @ 0.42% " 3
S-3	24.46	13.15	157 LF @ 0.42% " 4
S-4	"	13.82	360 LF @ 0.44% " 5
S-5	24.74	15.4	140 LF @ 0.58% " 5a
S-5a	25.01	16.21	END M.H.
S-6	24.74	15.4	400 LF @ 0.38% " 6
S-6a	24.62	16.91	224 @ 0.49% " 6a
S-7	24.06	18.41	178 @ 0.62% " 7a
S-7a	25.52	19.52	END M.H.
S-8	24.06	18.41	402 @ 0.35% " 8
S-9	24.26	12.46	240 @ 0.35% " 9
S-9a	24.29	13.30	140 @ 1.92% " 9a
S-10	24.29	13.3	240 @ 0.40% " 10
S-10a	23.77	14.27 / 16.97	123 @ 1.59% " 10a
S-11	24.15	15.57 / 17.80	125 @ 1.24% " 11a
S-11a	25.27	19.35	END M.H.
S-12	24.20	16.19	399 @ 0.36% " 12
S-13	24.29	17.61	188 @ 0.43% " 13
S-14	24.42	18.42	END M.H.
S-15	25.40	12.88	54 @ 1.41% " 15
S-15a	25.47	13.64 / 19.50	101 @ 0.64% " 15a
S-16	25.47	19.50	14 @ 1.00% " 15b
S-17	25.45	19.64	END M.H.
S-18	25.50	14.29	382 @ 0.42% " 16
S-19	27.15	15.88	191 @ 0.40% " 17
S-20	24.51	16.64	324 @ 0.42% " 18
S-21	25.81	17.99	END M.H.

NOTE: ALL SEWER IS SDR-35 PVC.
ALL NEW FORCE MAIN IS CLASS-100
C-900 PVC.

S-5a	25.01	16.21	25 LF @ 1.04% TO MH S-5d
S-5b	25.47	16.47	204 LF @ 0.61% " 5c
S-5c	26.01	17.71	344 LF @ 0.44% " 5b
S-5d	26.84	19.24	END M.H.

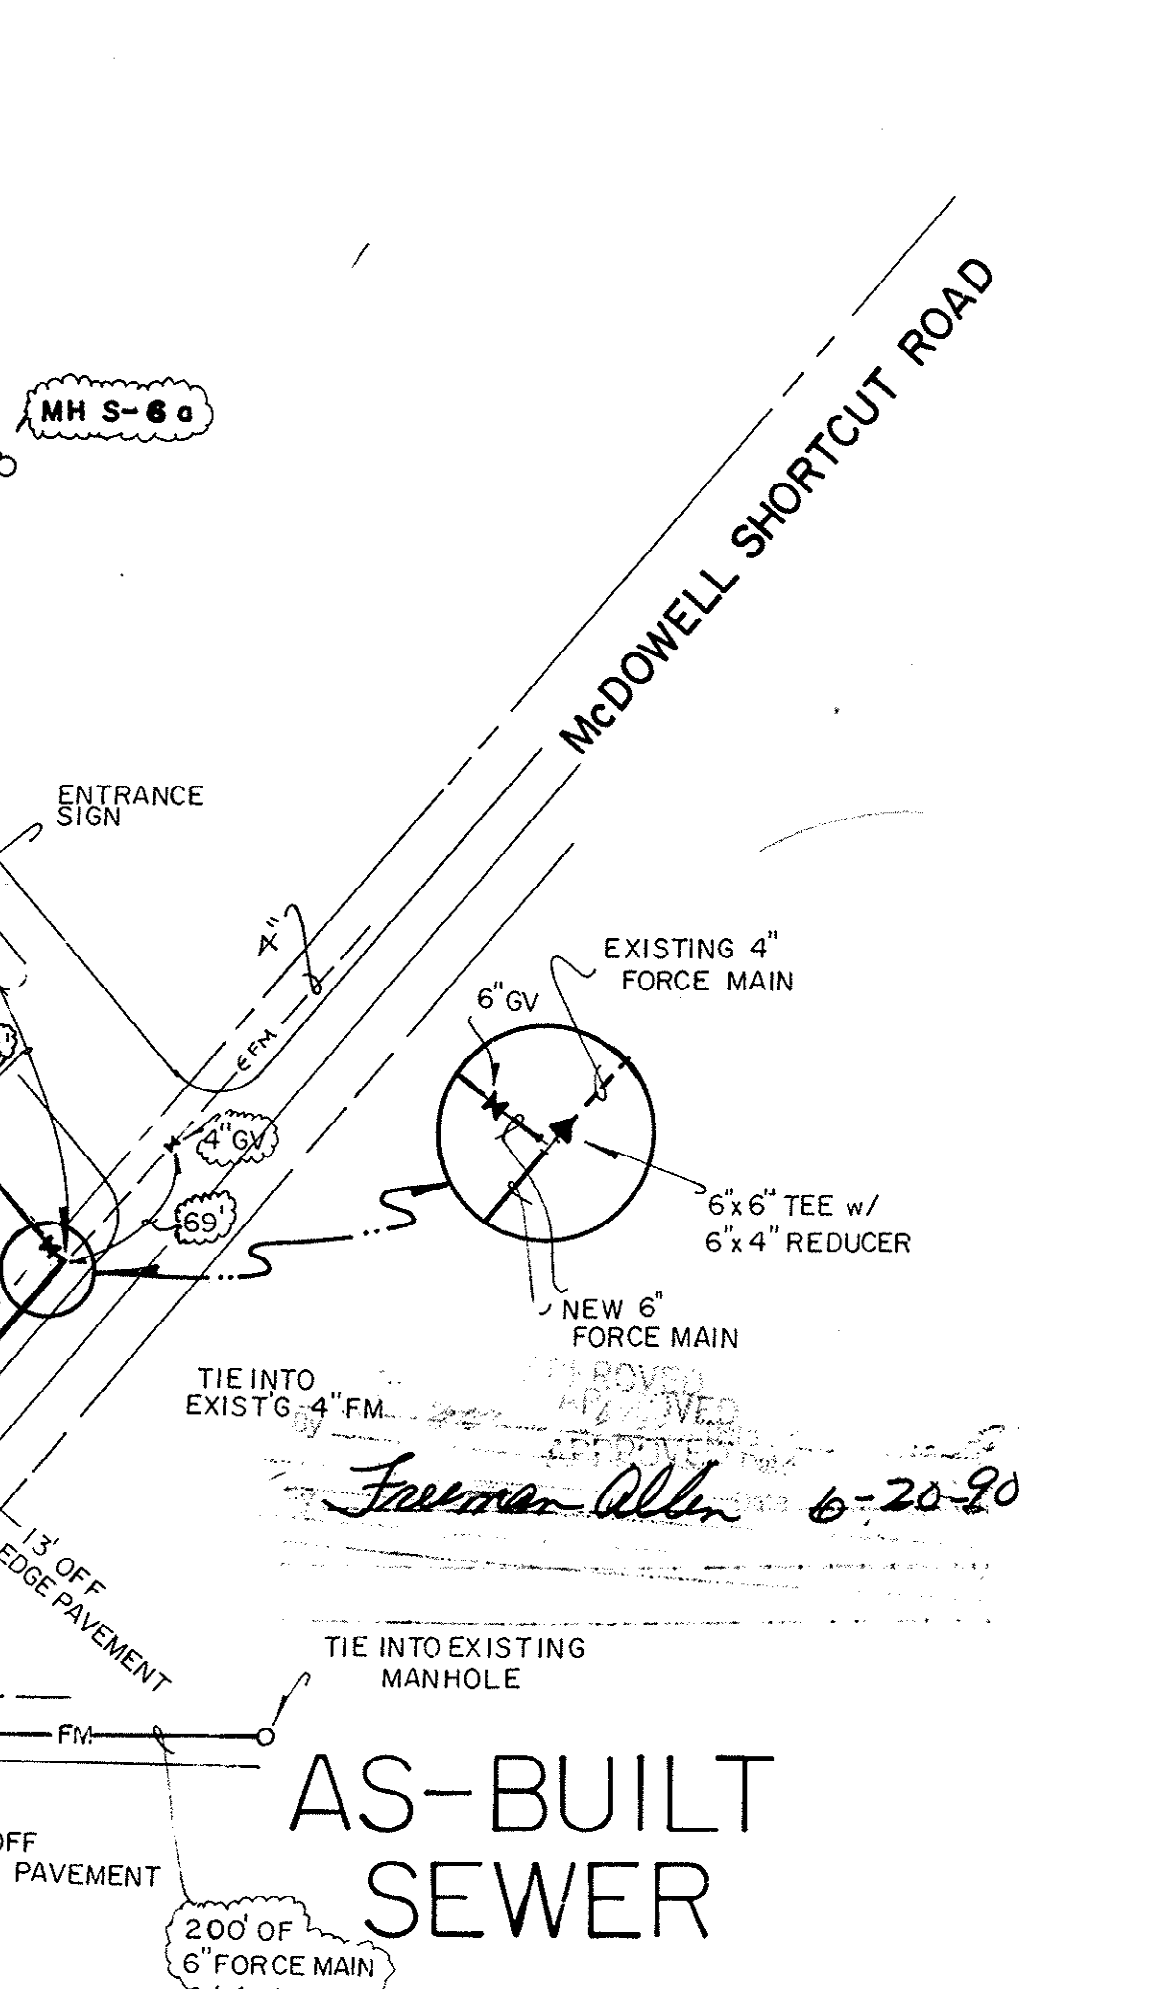

20-55-001 W/NOV. 15, 1989
JAN. 4, 1990
MAY 24, 1990

CBL & ASSOCIATES
ONE PARK PLACE
6143 LEE HWY
CHATTANOOGA, TN 37421

INLET SQUARE SHOPPING
CENTER

AS-BUILT SEWER

MCDOWELL ENGINEERING
P.O. BOX 276
MURRELLS INLET, SOUTH CAROLINA



KENNETH MCDOWELL, P.E., R.L.S.

DRAWN
& LACY CANNON
CHECKED

DATE
AUG. 17, 1989
SCALE
AS SHOWN
JOB NO.
E-282-88
SHEET
1

OF 2 SHEETS

AB1730
PILGRIM PHOTOGRAPHY, GREENVILLE

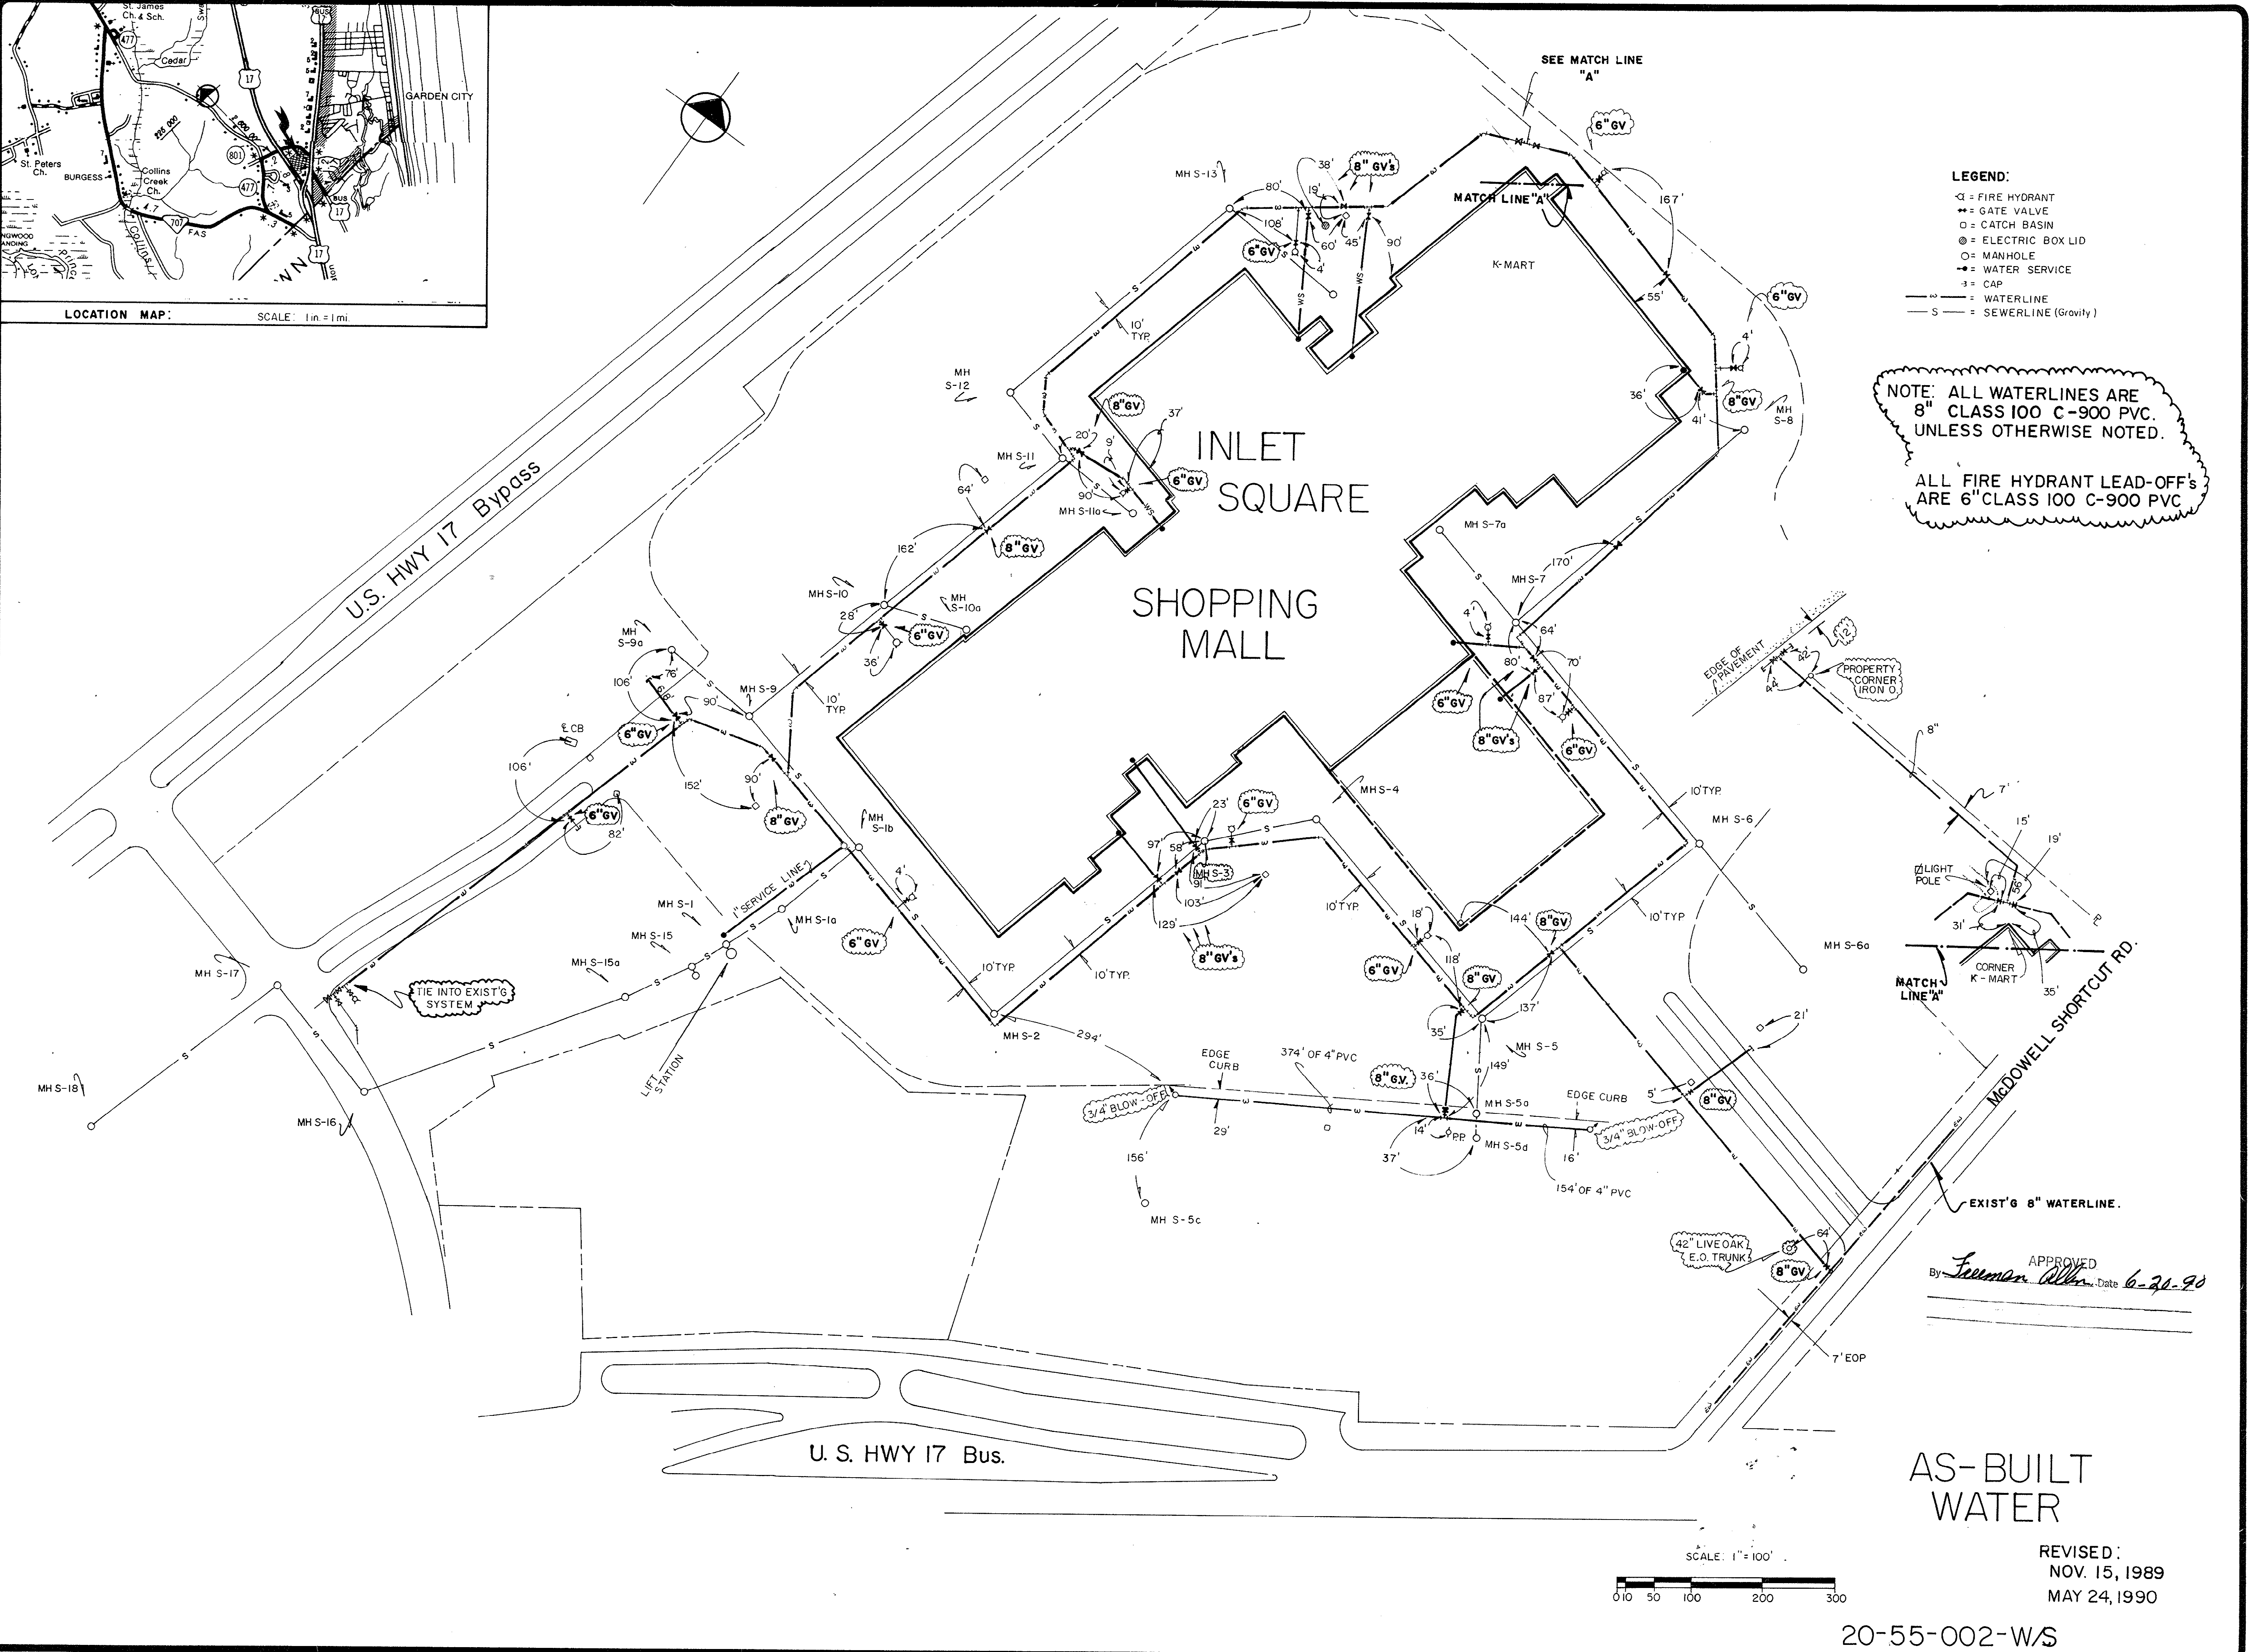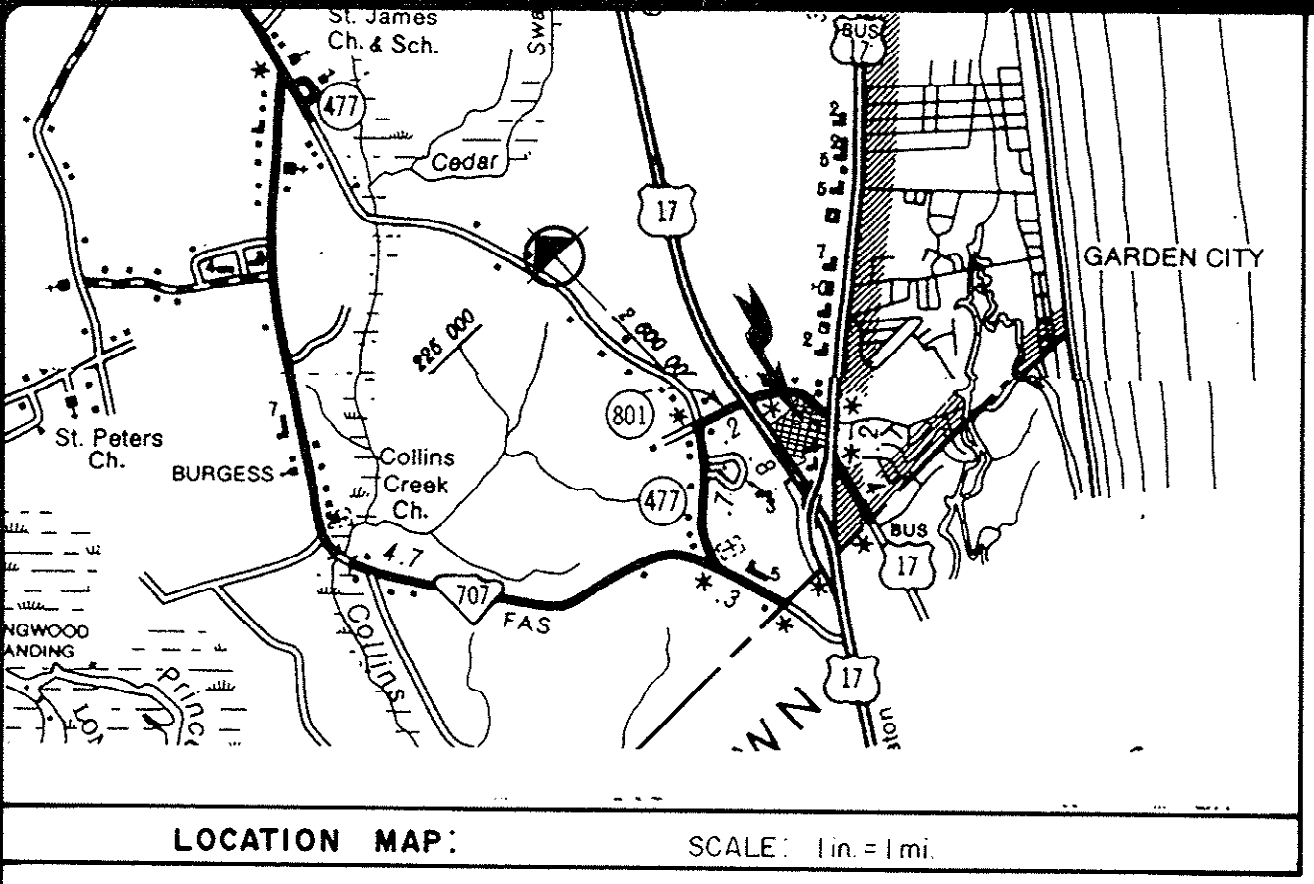

CBL & ASSOCIATES
ONE PARK PLACE
6143 LEE HWY
CHATTANOOGA, TN 37421

INLET SQUARE SHOPPING
CENTER

AS-BUILT WATER

MCDOWELL ENGINEERING
P. O. BOX 276
MURRELLS INLET, SOUTH CAROLINA



KENNETH MCDOWELL, P.E., R.L.S.

DRAWN
LACY CANNON
CHECKED

DATE
AUG. 17, 1989
SCALE
AS SHOWN
JOB NO.
E-282-88
SHEET
2

OF 2 SHEETS

20-55-002-W/S

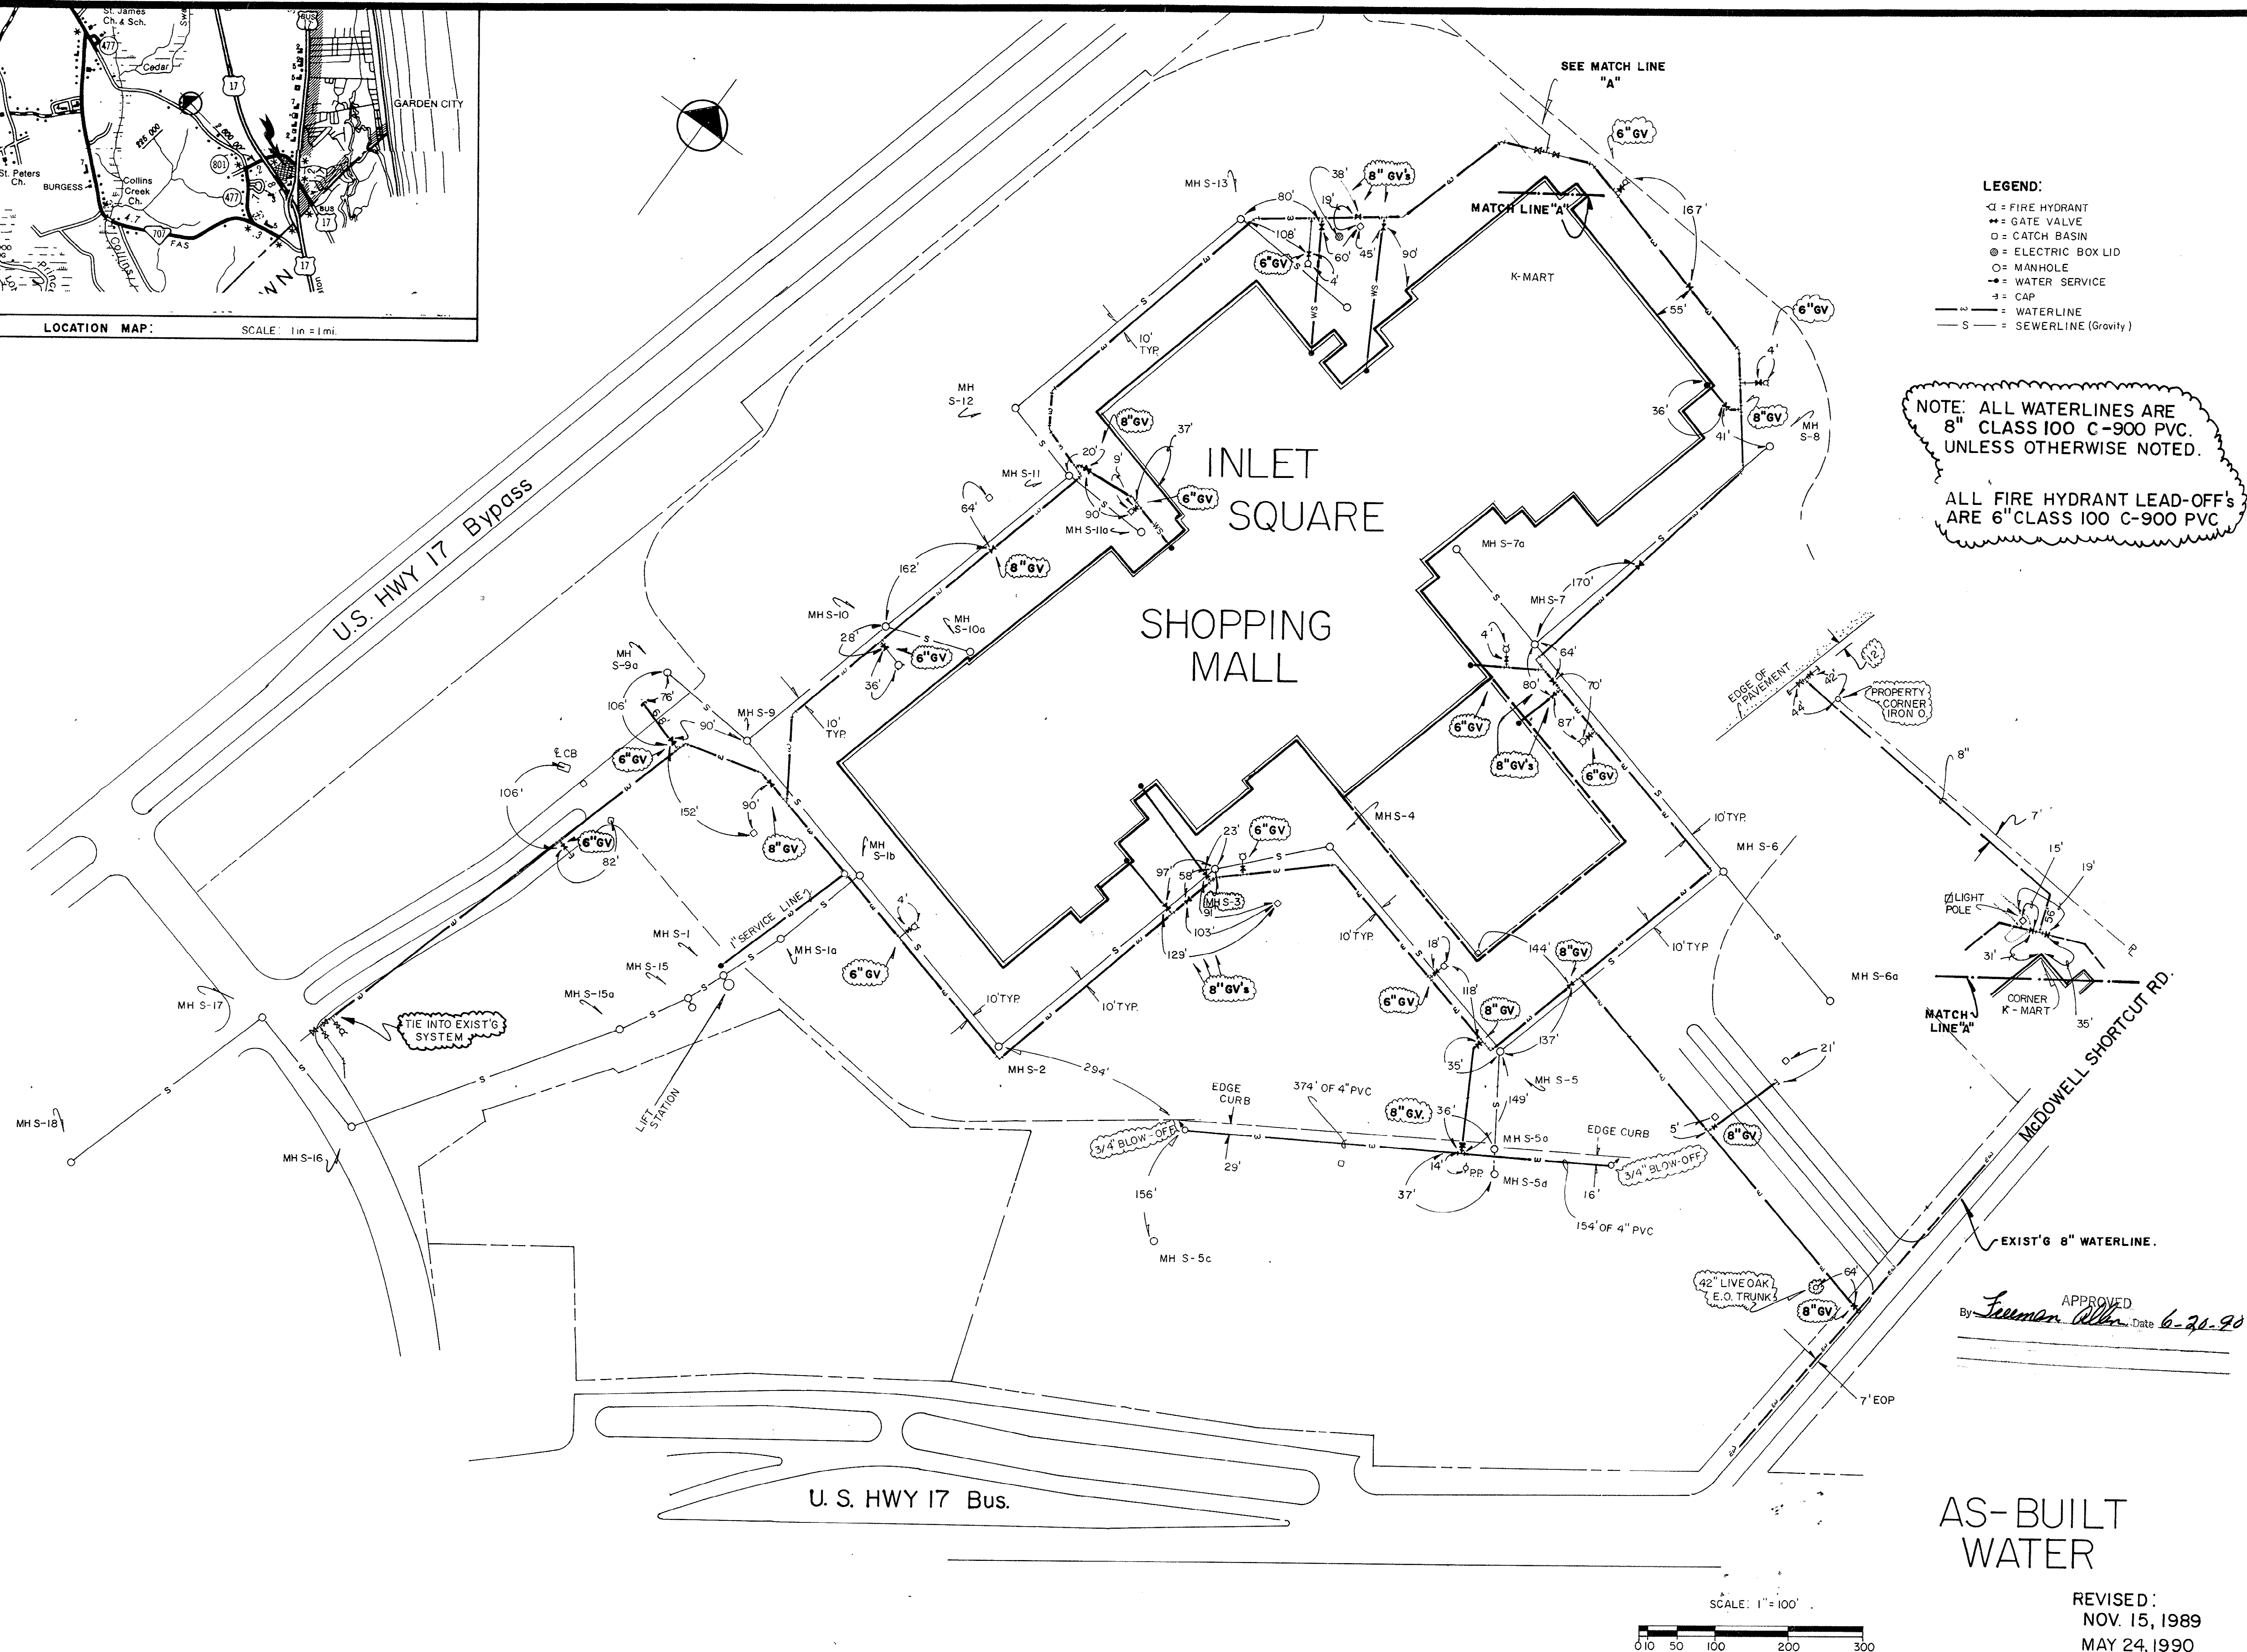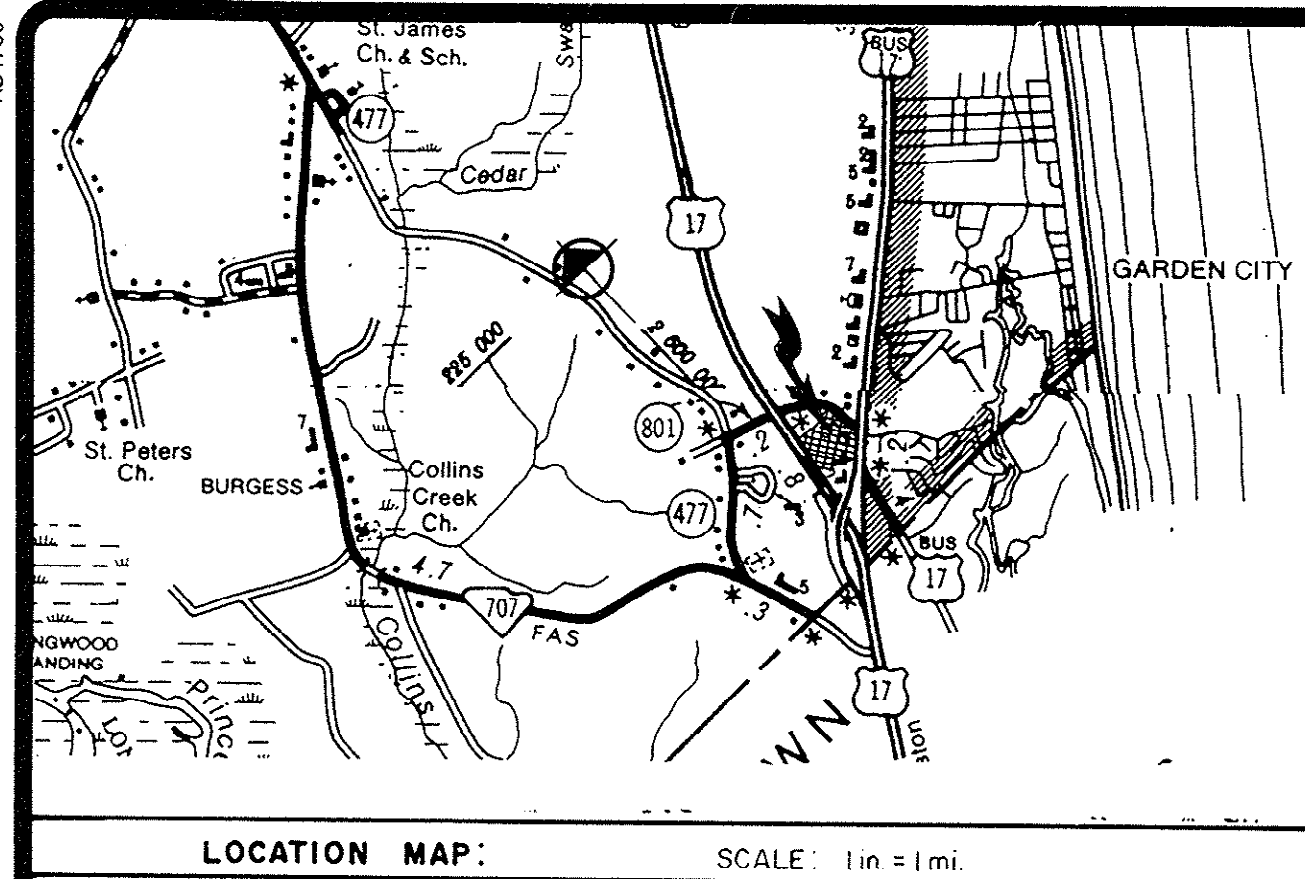

AS-BUILT
WATER

REVISED:
NOV. 15, 1989
MAY 24, 1990

20-55-002-W/S

CBL & ASSOCIATES
ONE PARK PLACE
6143 LEE HWY
CHATTANOOGA TN. 37424

INLET SQUARE SHOPPING
CENTER

AS-BUILT WATER

MCDOWELL ENGINEERING
P. O. BOX 276
MURRELLS INLET, SOUTH CAROLINA

KENNETH McDOWELL P E R I S

DRAWN
C LACY CANNON
CHECKED

DATE
AUG. 17, 1989

SCALE
AS SHOWN

JOB NO.
E-282- 88

2

OF 2 SHEETS