


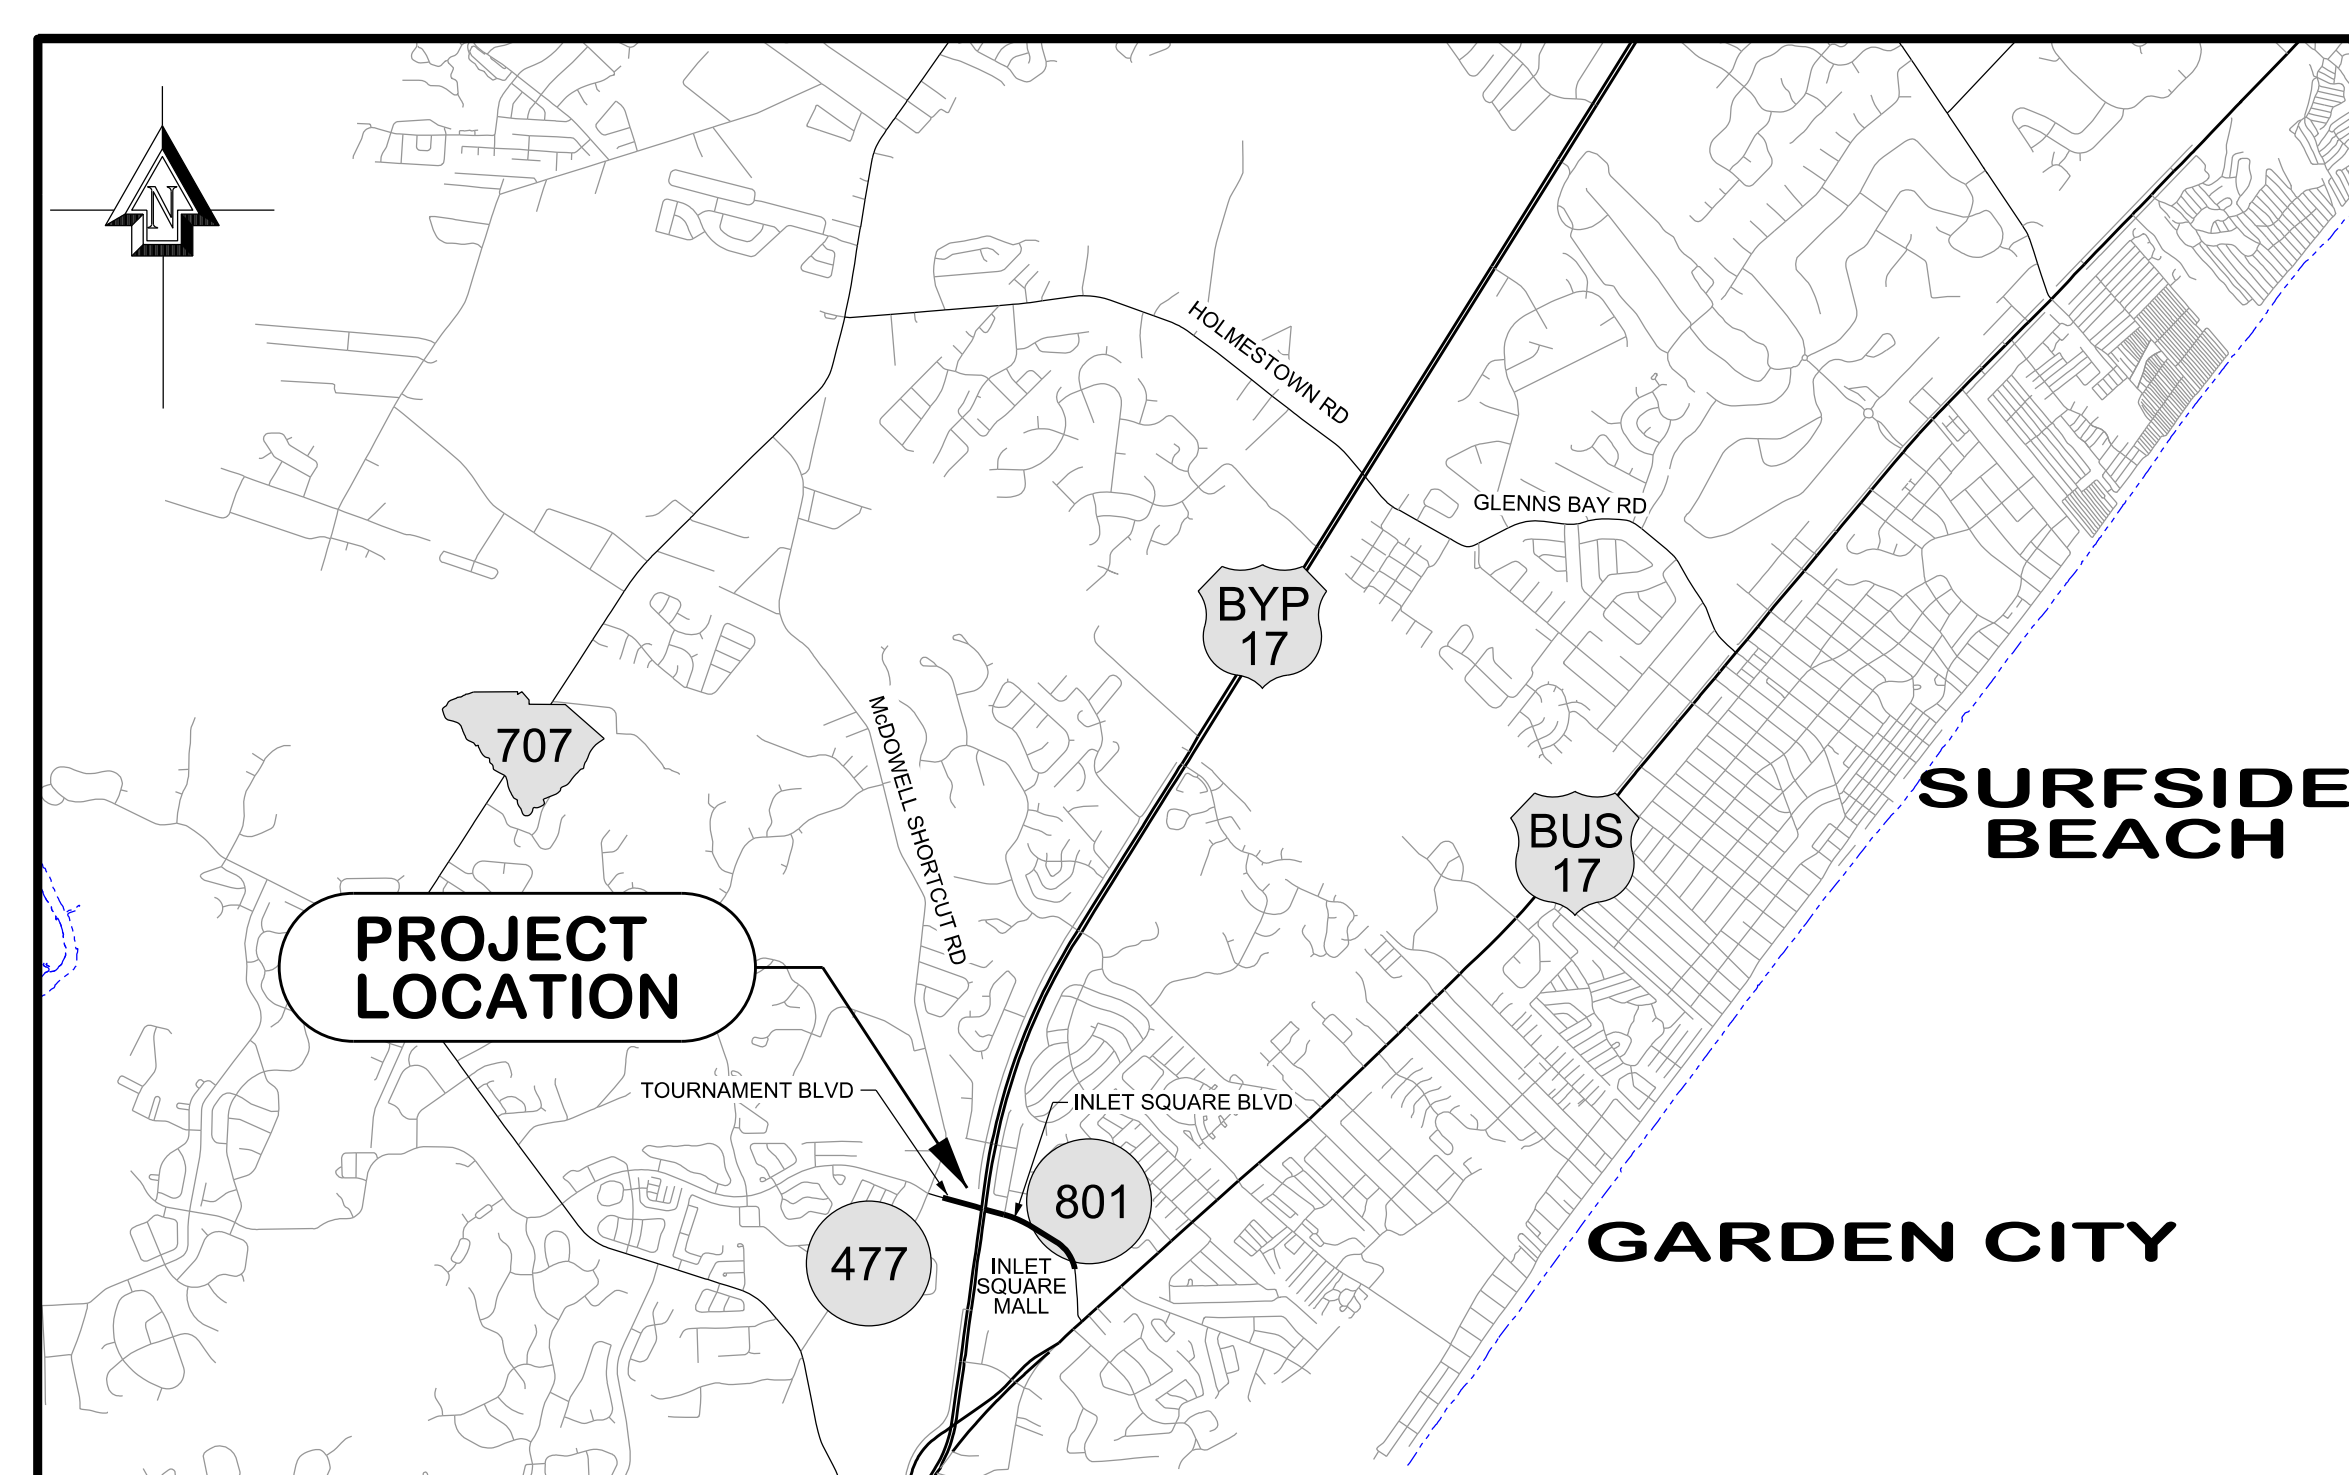




INLET SQUARE DR / TOURNAMENT BLVD (S-26-801) AT US HWY 17 BYPASS WATER & SEWER RELOCATIONS

SHEET INDEX:


- 1 TITLE W/ SHEET INDEX, NOTES, & OVERALL PLAN
- 1-3 PLAN SHEETS (AS-BUILTS)
- 3-4 BORE AS-BUILTS

LEGEND (APPLIES TYPICALLY THROUGHOUT PLAN SHEETS)

- SEWER FM AIR RELEASE VALVE
- SEWER FM PUMPER CONNECTION ASSEMBLY
- SEWER FM PLUG VALVE
- SEWER MANHOLE
- SEWER LIFT STATION
- SEWER S.T.E.P. TANK
- SEWER GRINDER PUMP STATION
- WATER FIRE HYDRANT
- WATER POST HYDRANT
- WATER GATE VALVE
- WATER/SEWER REDUCER
- WATER SERVICE METER

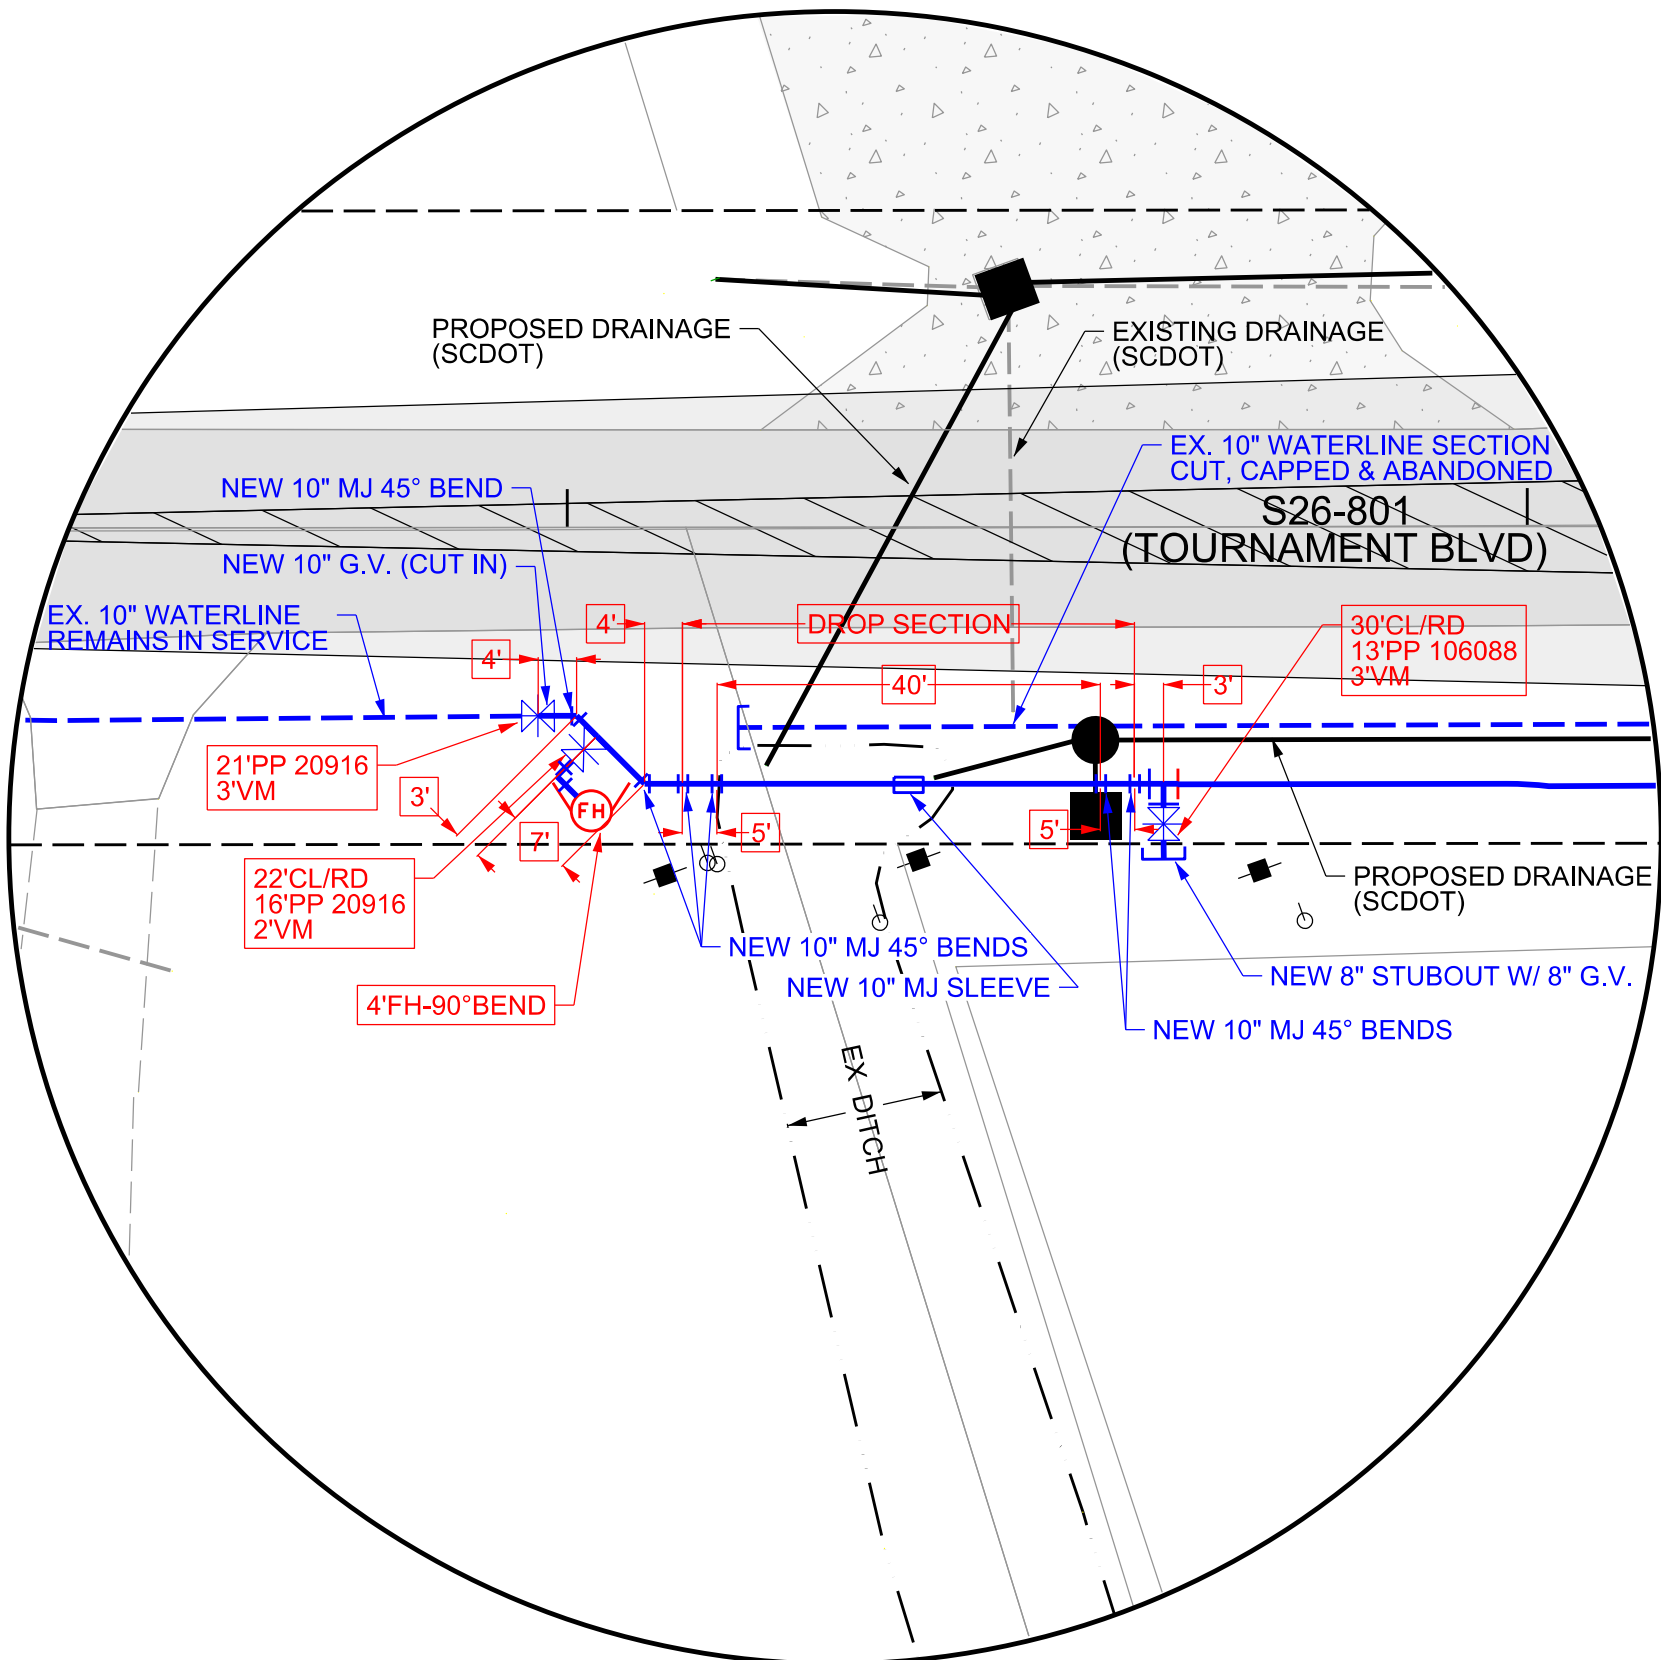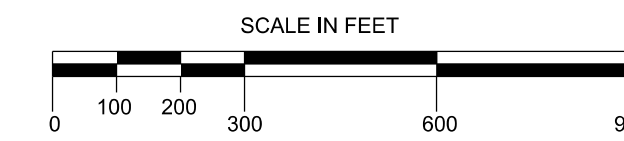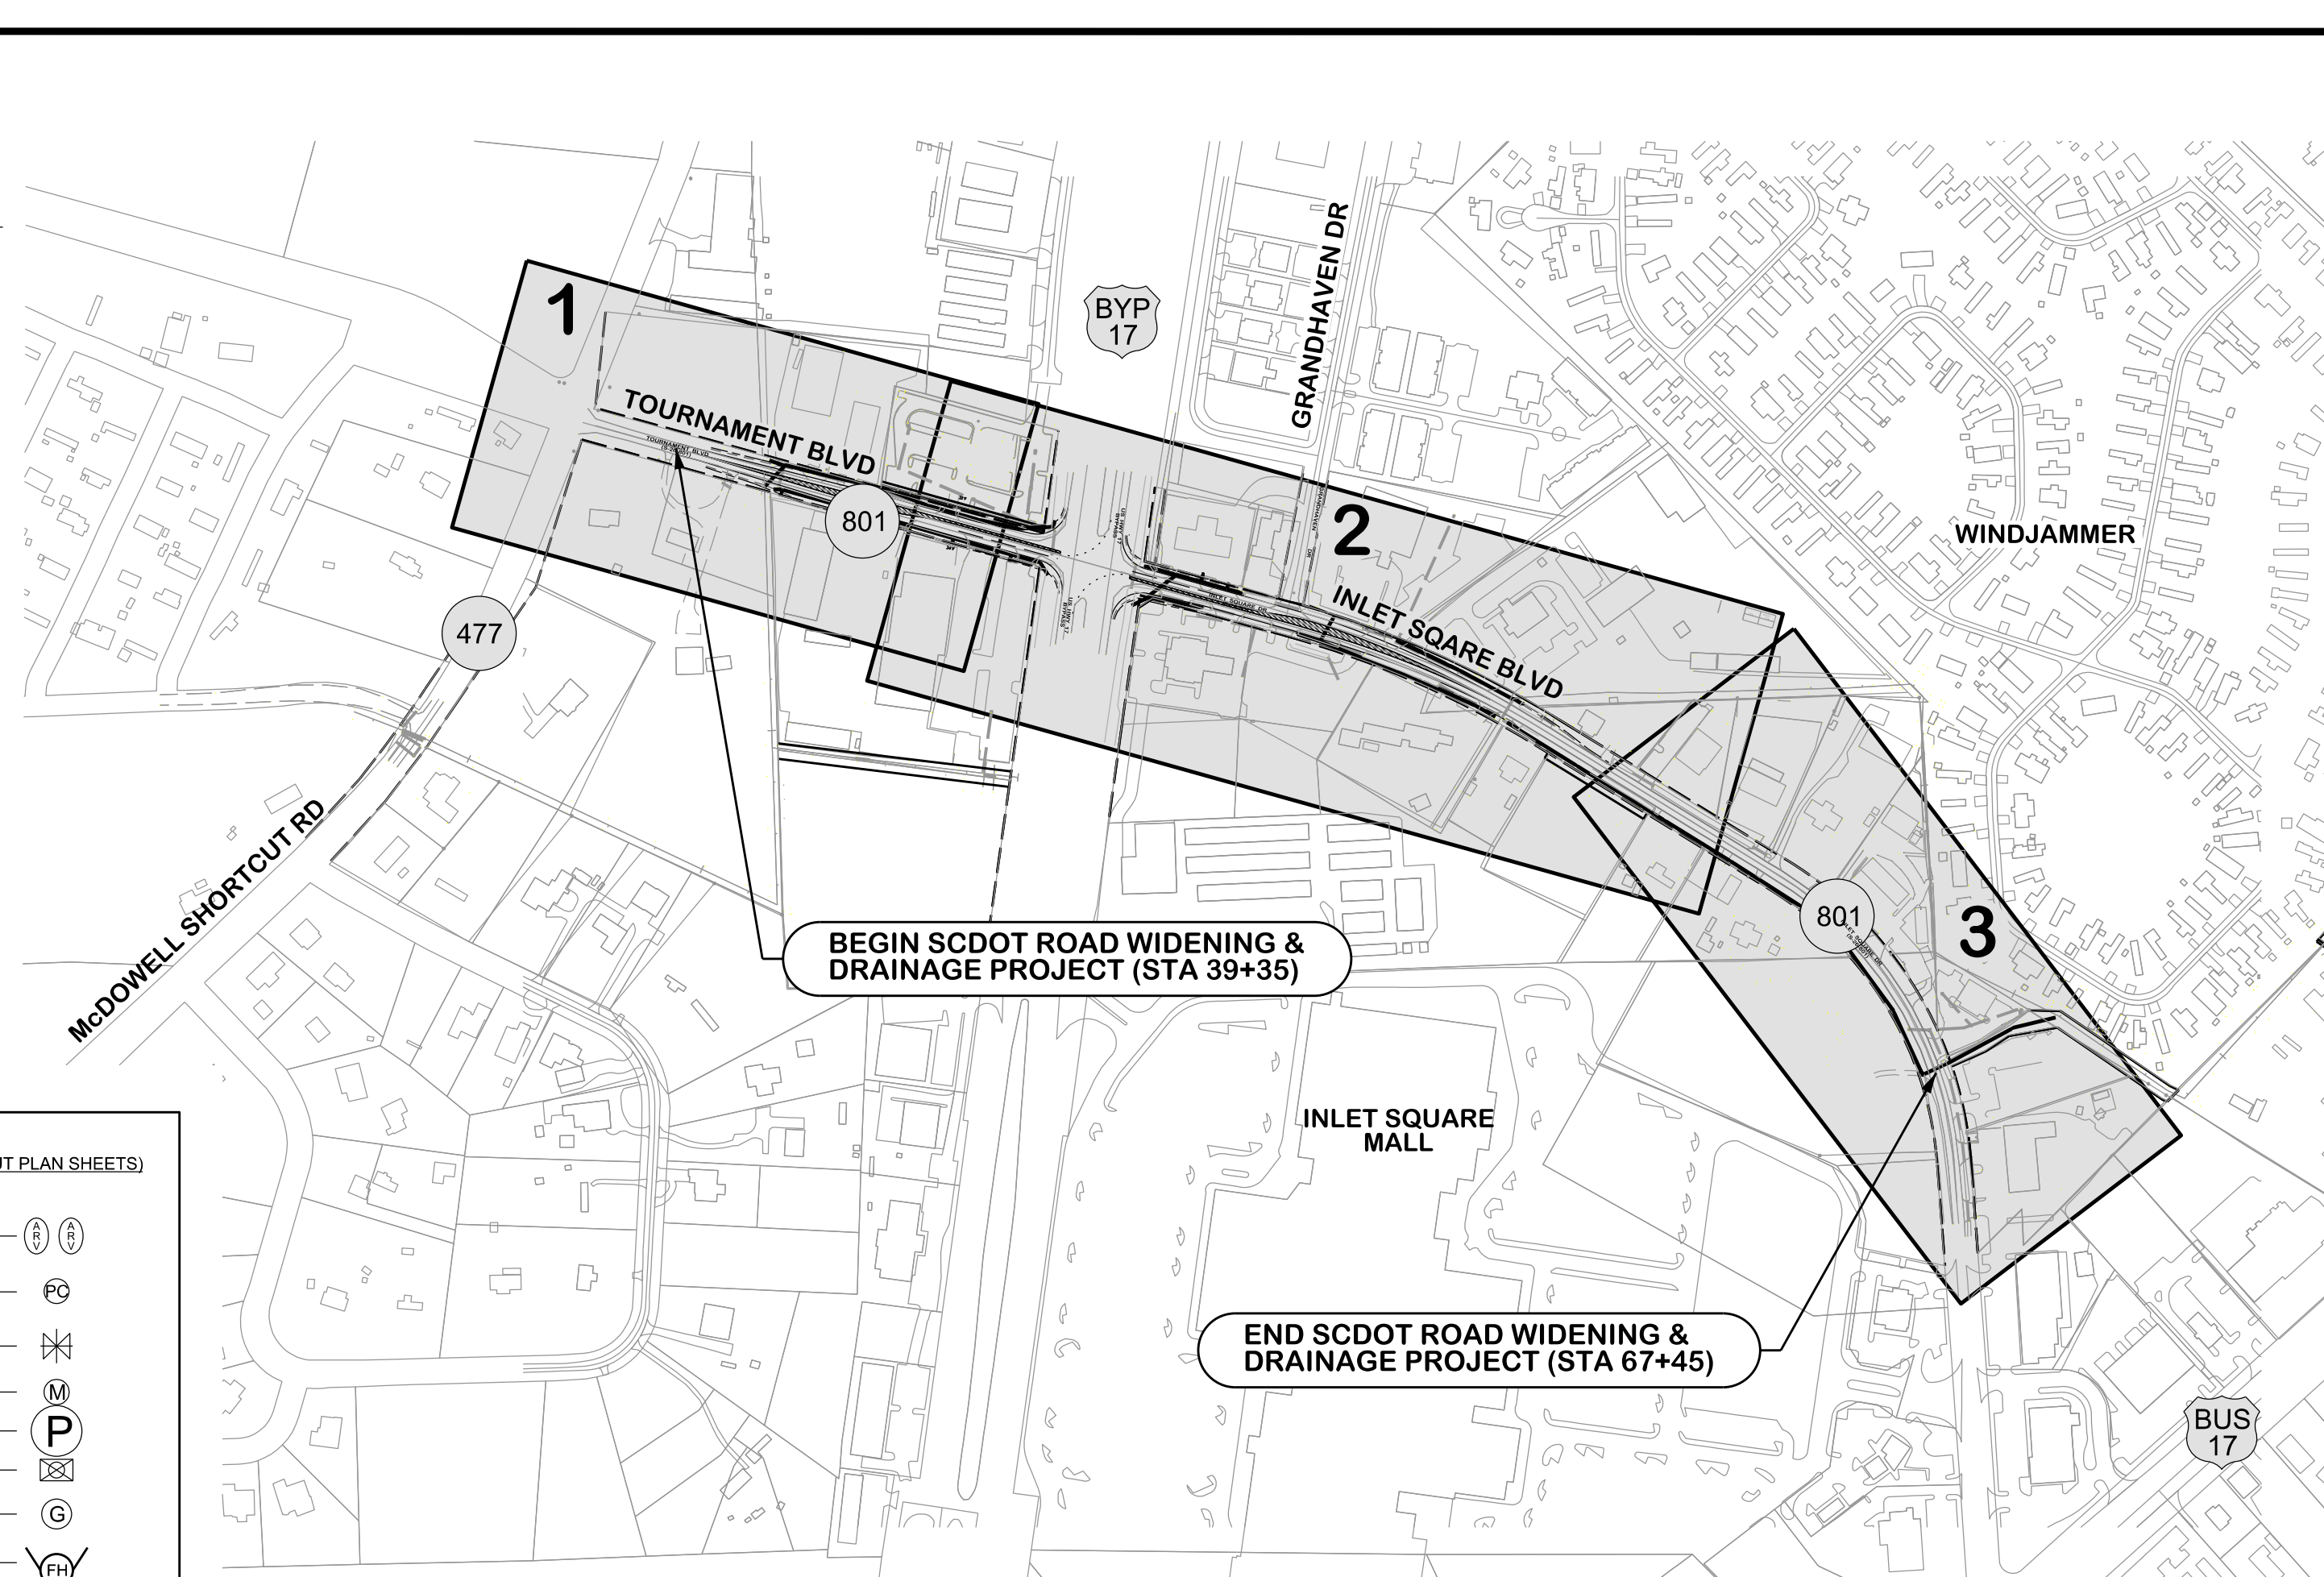

DETAIL 'A'

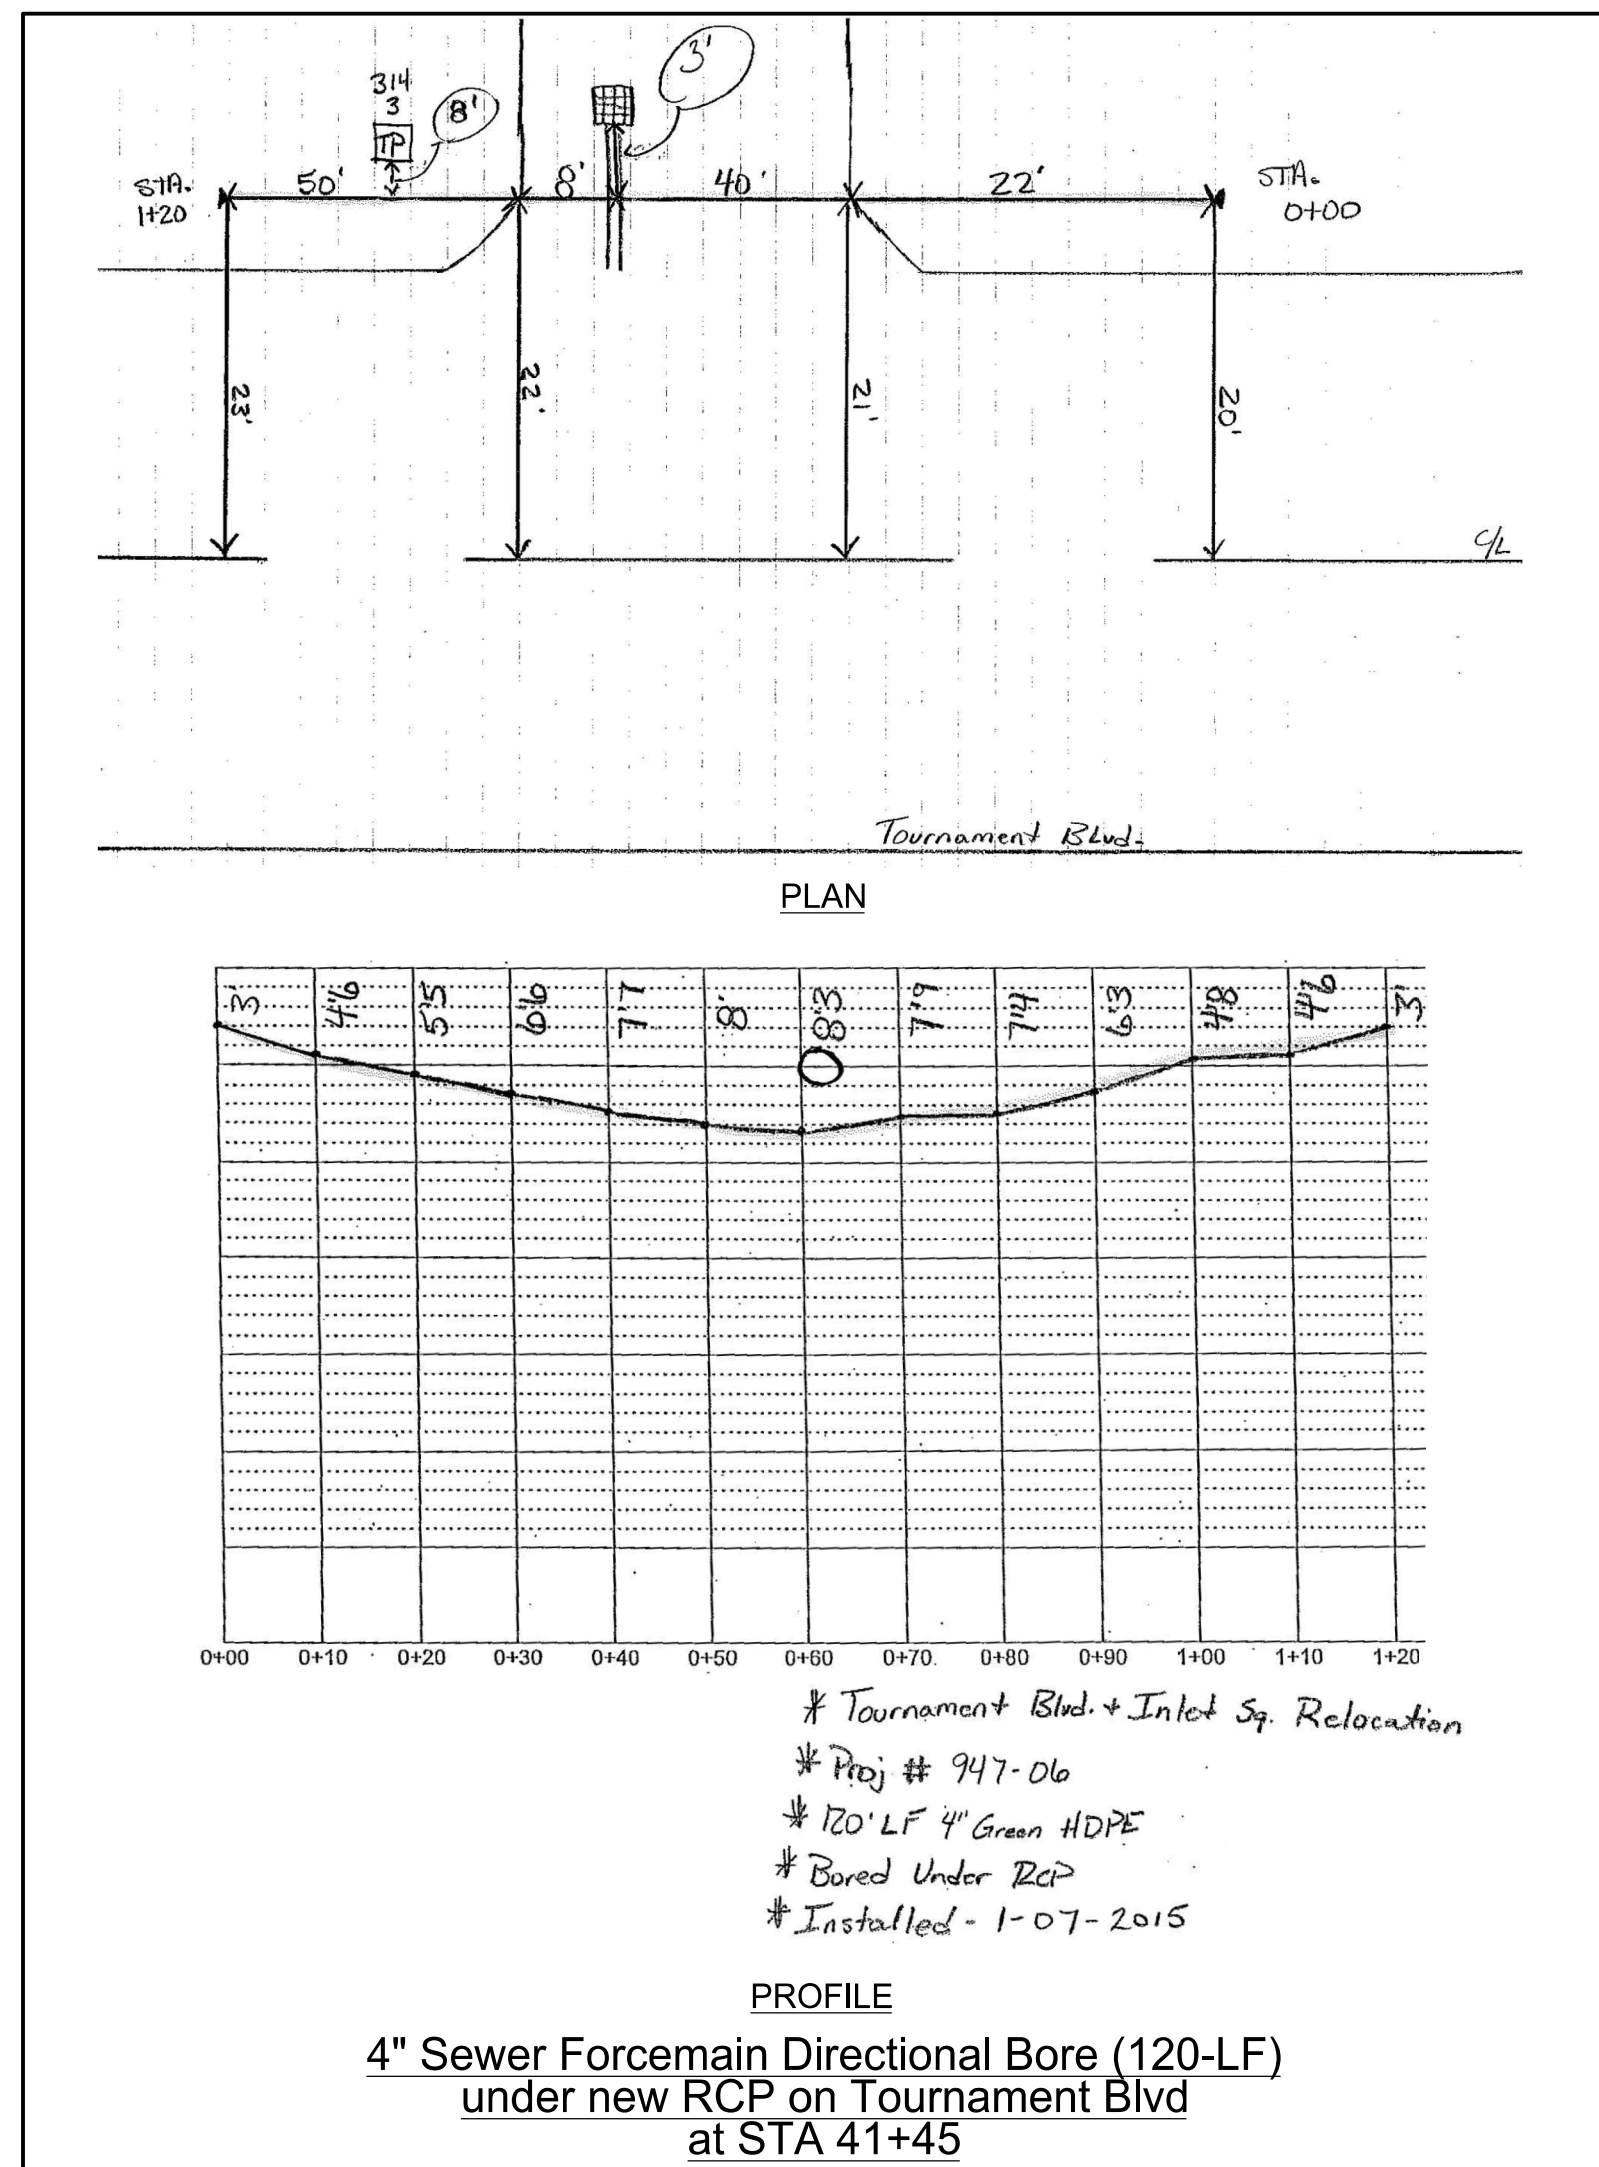

Permit Information:
SCDOT encroachment #14-00334
SCDOT Utility Agreement #13000

Water and Sewer installed by:
GSWSA (Rod Altman)

Directional bores installed by:
GSWSA (Tim Hucks)

AS-BUILT MEASUREMENTS
INDICATED BY


35'

THESE DRAWINGS REFLECT
AS-BUILT
CONDITIONS

REVIEWED BY: INSPECTIONS DATE: 8/13/15

REVIEWED BY: ENGINEERING

GRAND STRAND WATER AND SEWER AUTHORITY

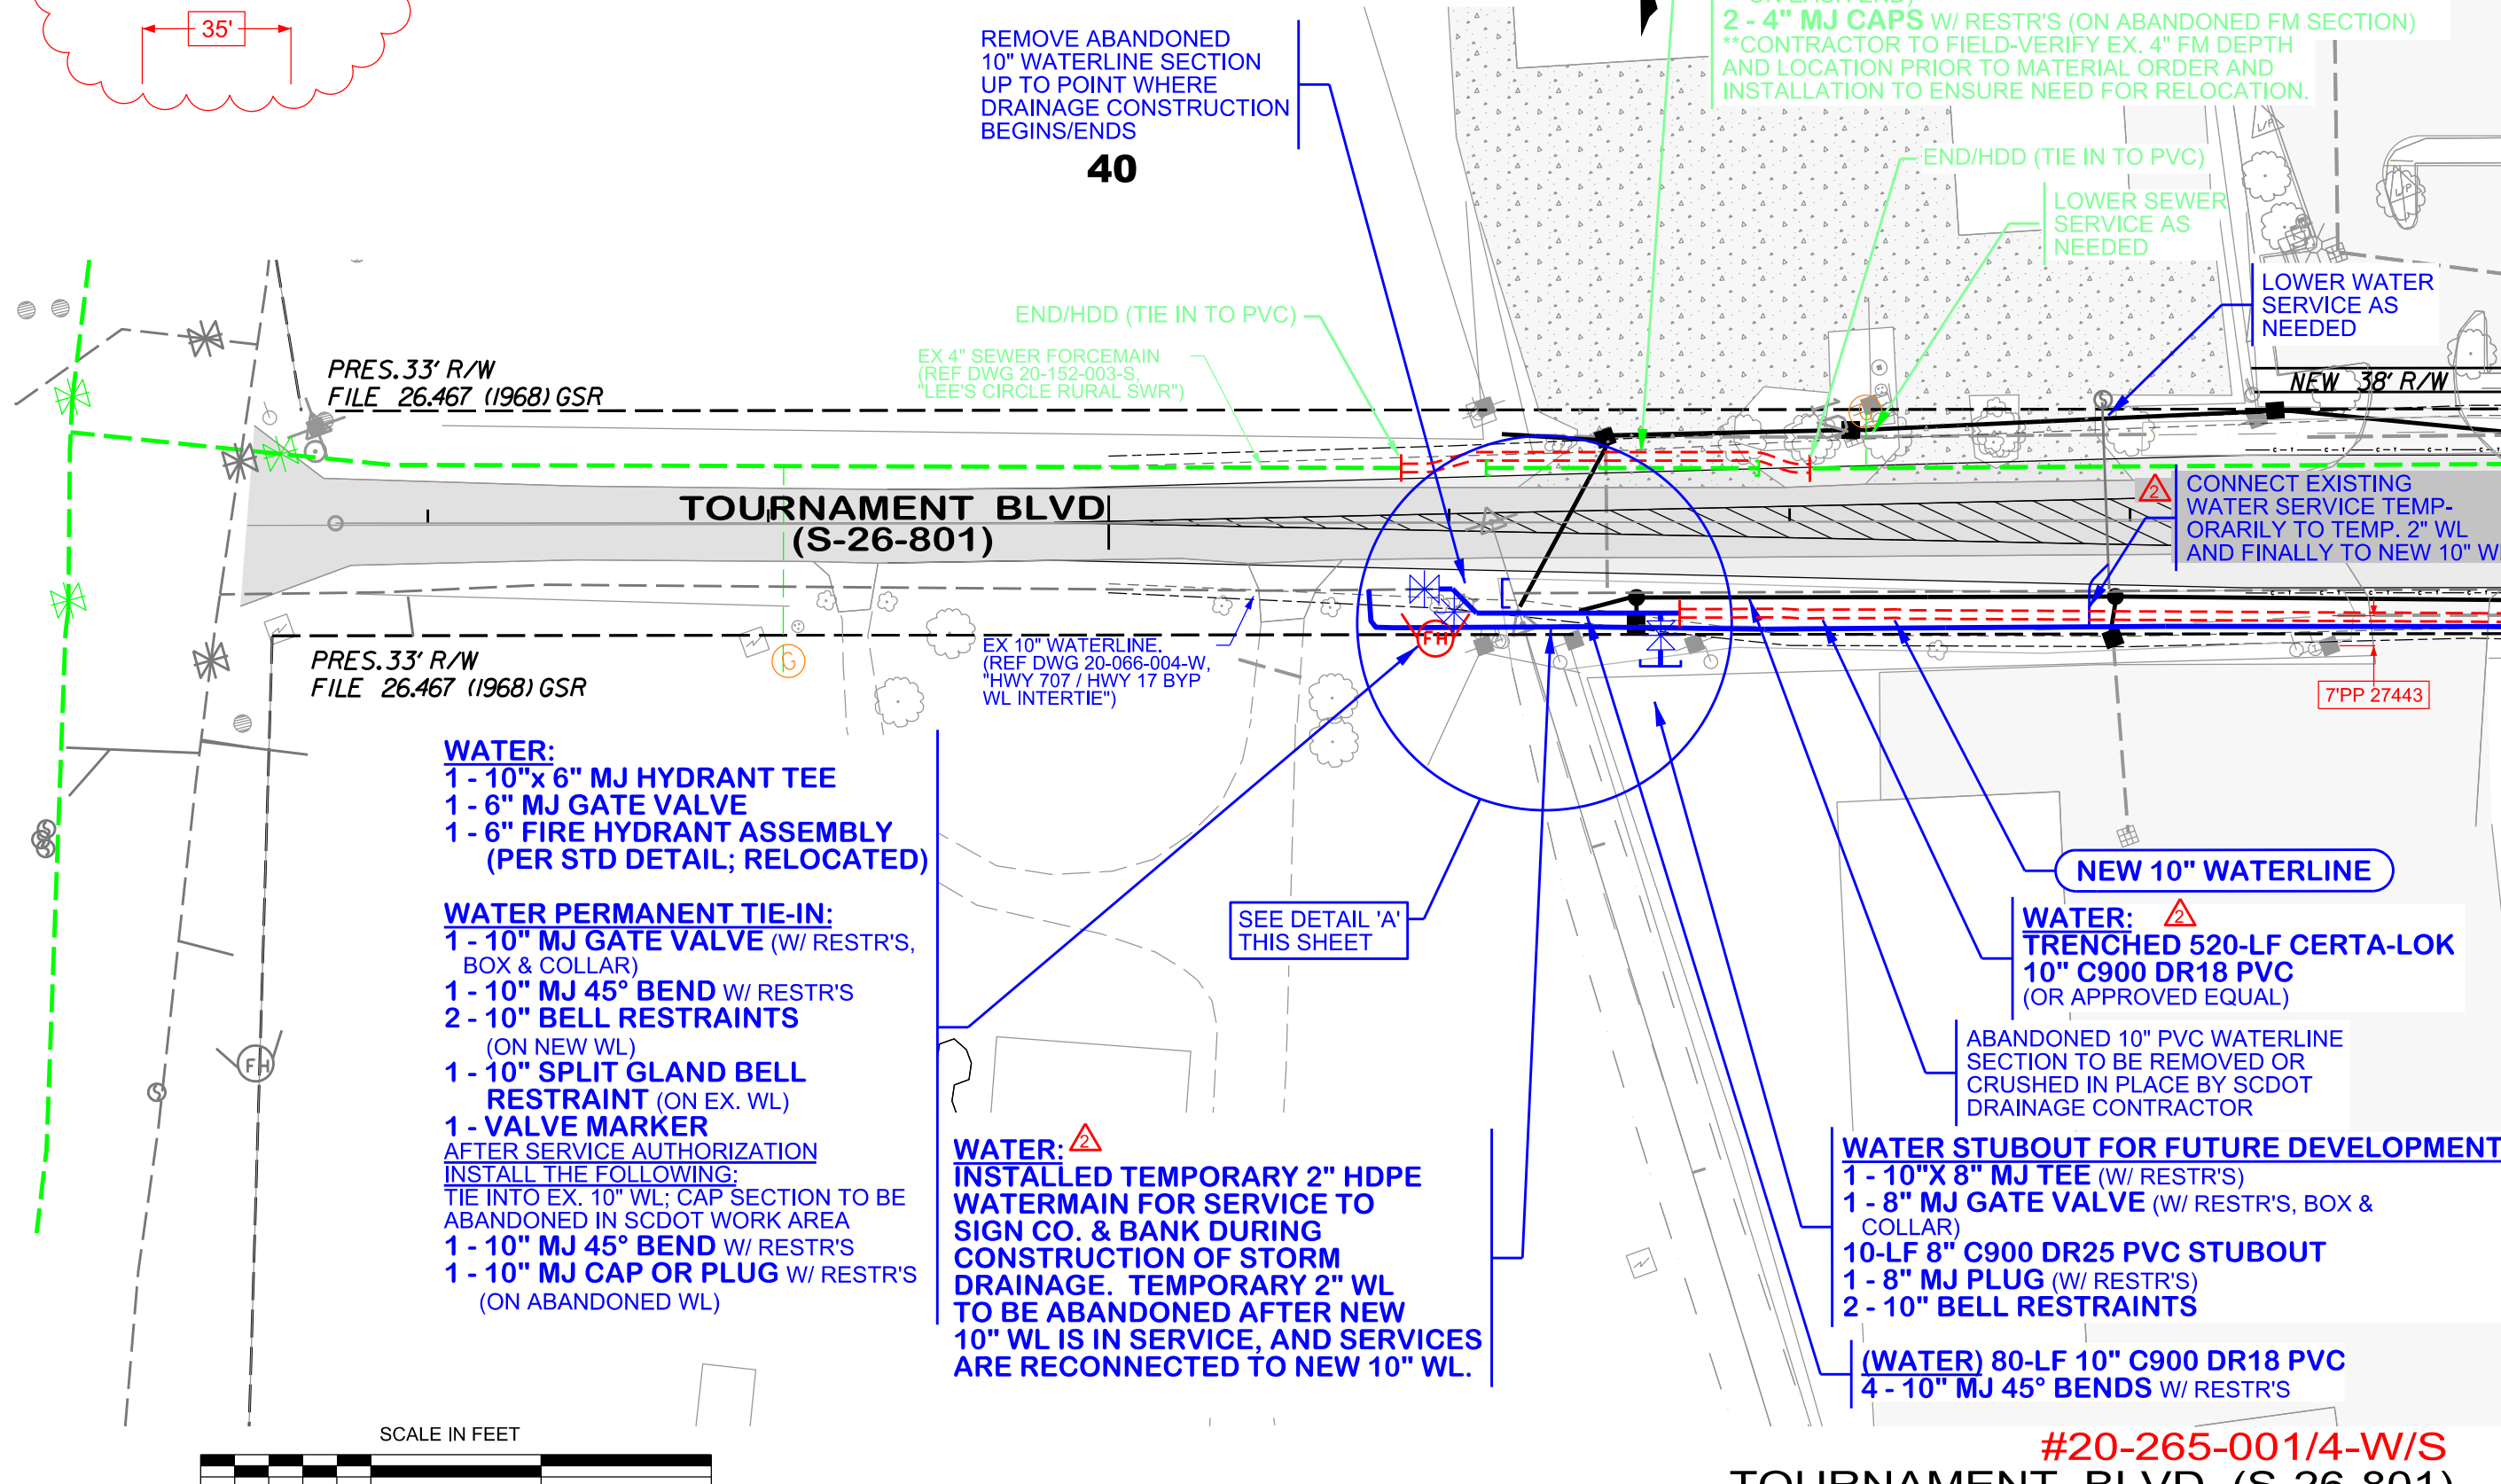

REVISION	BY	DATE
Δ PROPOSED 10" WL RELOCATION IN OAKMOUNT BLVD	DRT	2015-01-06
Δ ORIGINAL LOCATION IN SCOOT RW TO BE INSTALLED AFTER STREET DRAIN INSTALLATION. TEMP. SERVICE TO BANK AND SIGN CO.	DRT	2015-03-17
S-BUILT	DRT	2015-08-12

GRAND STRAND
WATER & SEWER
AUTHORITY

166 JACKSON BLUFF RD.
O.P.O. BOX 2368
CONWAY, SC 29525-2368

(843) 337-3434 FAX: 843-686-1686
E-MAIL: GSWSA@GSA.COM




INLET SQUARE DR / TOURNAMENT BLVD (S-26-801)
AT US HWY 17 BYPASS
WATER & SEWER RELOCATIONS
(Garden City area)
PROJ. #587-15 & #947-06

SCDHIC PROFESSIONAL ENGINEERING
No. 26566

SC DHIC GENERAL CONSTRUCTION PERMIT
DATE: June 2012 A.D.
SCALE: as shown
FILENAME: design (US Hwy 17 Bypass & S-26-801).dgn

DESIGNED BY: Ray Thompson
CHECKED BY: C. Ryan Hayes
APPROVED BY: JASON L. POSTON PE #26566

SHEET
1
OF 4

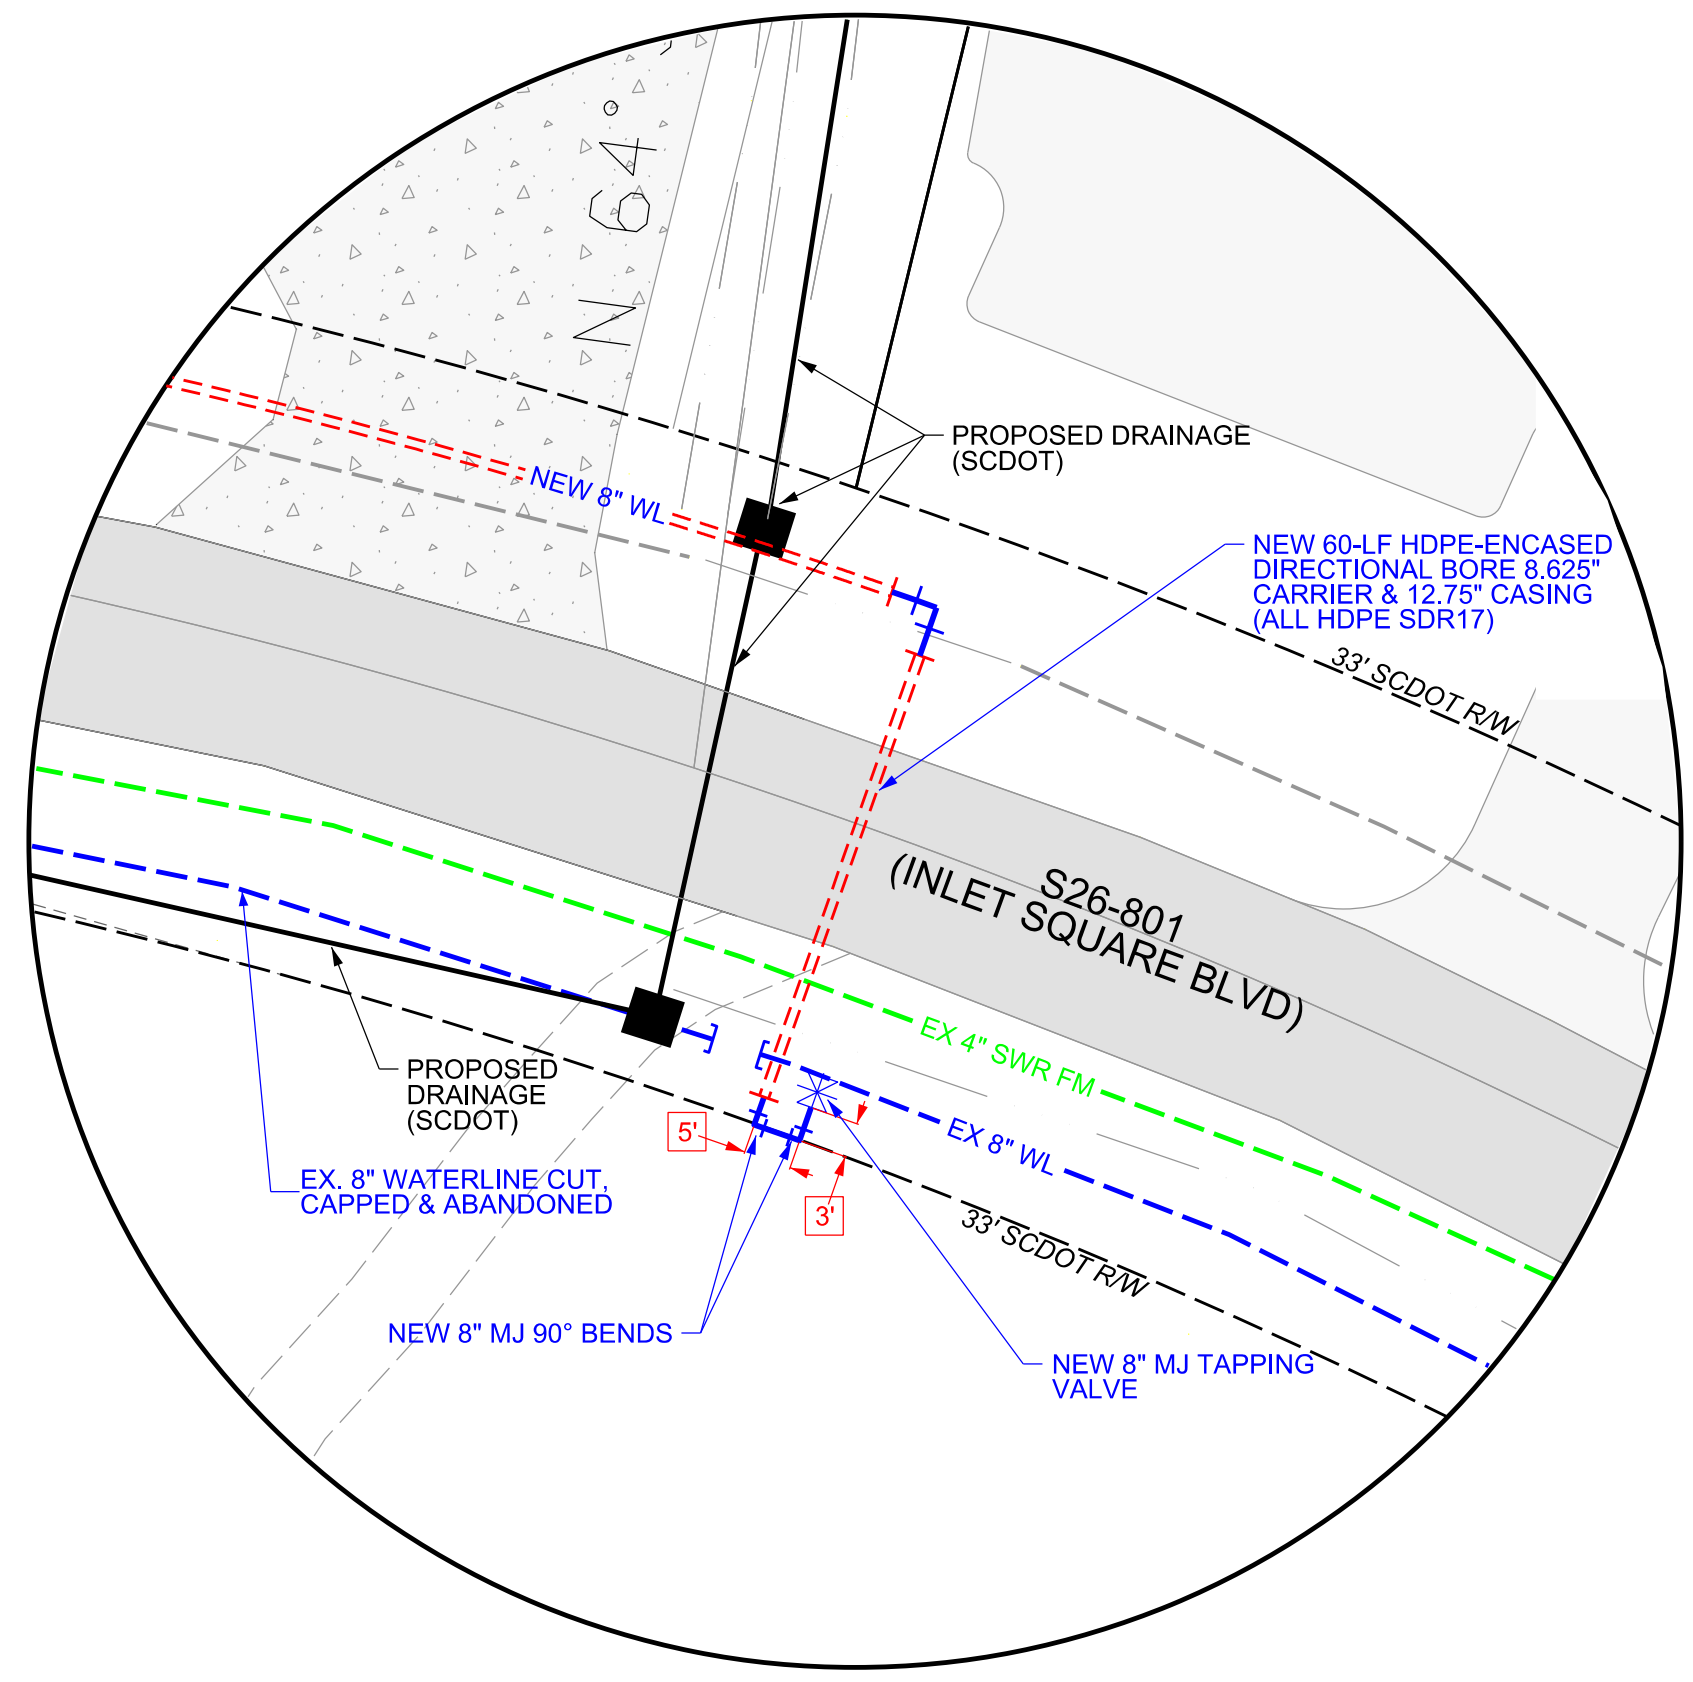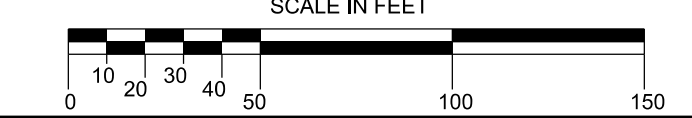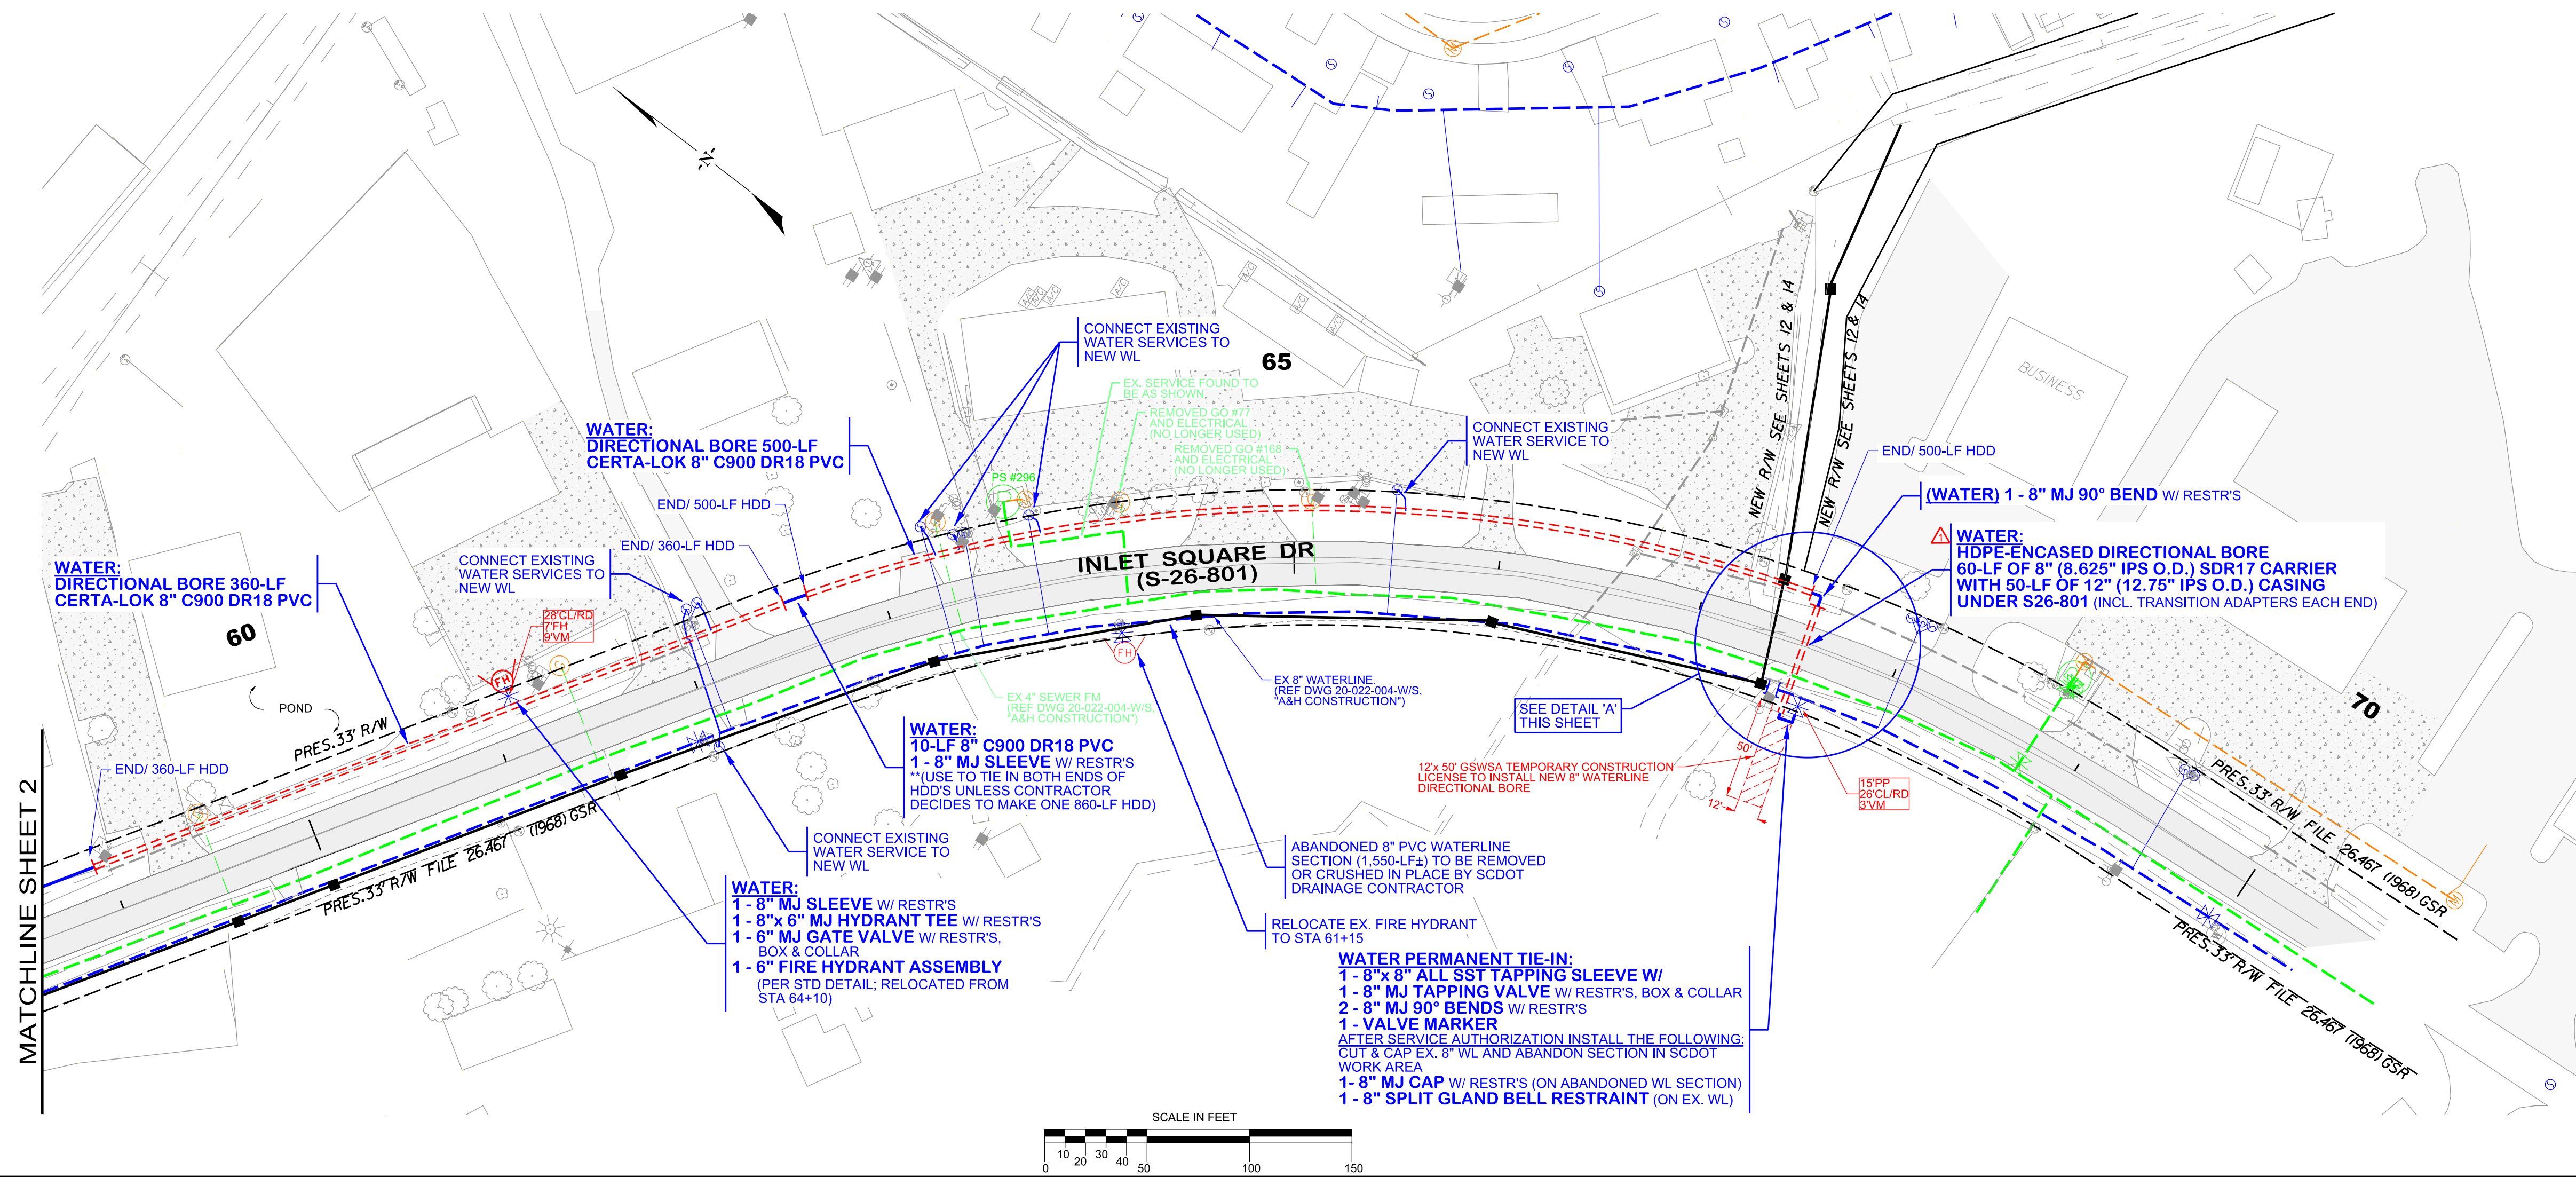

DETAIL 'A'

Permit Information:
SCDOT encroachment #14-00334
SCDOT Utility Agreement #13000

Water and Sewer installed by:
GSWSA (Rod Altman)

Directional bores installed by:
GSWSA (Tim Hucks)

AS-BUILT MEASUREMENTS
INDICATED BY
35'

THESE DRAWINGS REFLECT
AS-BUILT
CONDITIONS

REVIEWED BY: INSPECTIONS DATE: 8/13/15
REVIEWED BY: ENGINEERING DATE: 8/13/15
GRAND STRAND WATER AND SEWER AUTHORITY

REVISION	BY	DATE
REVISOR: DEPT. OF TRANSPORTATION APPROVAL: COVER BY SCDOT EMAIL	DRT	2015-02-19
AS-BUILT	DRT	2015-08-12

GRAND STRAND
WATER & SEWER
AUTHORITY

166 JACKSON BLUFF RD.
P.O. BOX 2368
CONWAY, SC 29525-2368
(843) 347-1541 FAX: (843) 347-1686
(843) 347-1686 TTY: (843) 347-1686
E-MAIL: GSWSA.COM





**INLET SQUARE DR / TOURNAMENT BLVD (S-26-801)
AT US HWY 17 BYPASS
WATER & SEWER RELOCATIONS**
(Garden City area)
PROJ. #587-15 & #947-06

SC DHEC GENERAL CONSTRUCTION
PERMIT

DATE: June 2012 A.D.
SCALE: as shown
FILENAME: design (US Hwy 17 Bypass
& S-26-801).dgn

DESIGNED BY: Ray Thompkins
CHECKED BY: C. Ryan Hayes
APPROVED BY: JASON L. POSTON PE #26566

SHEET
3
OF 4

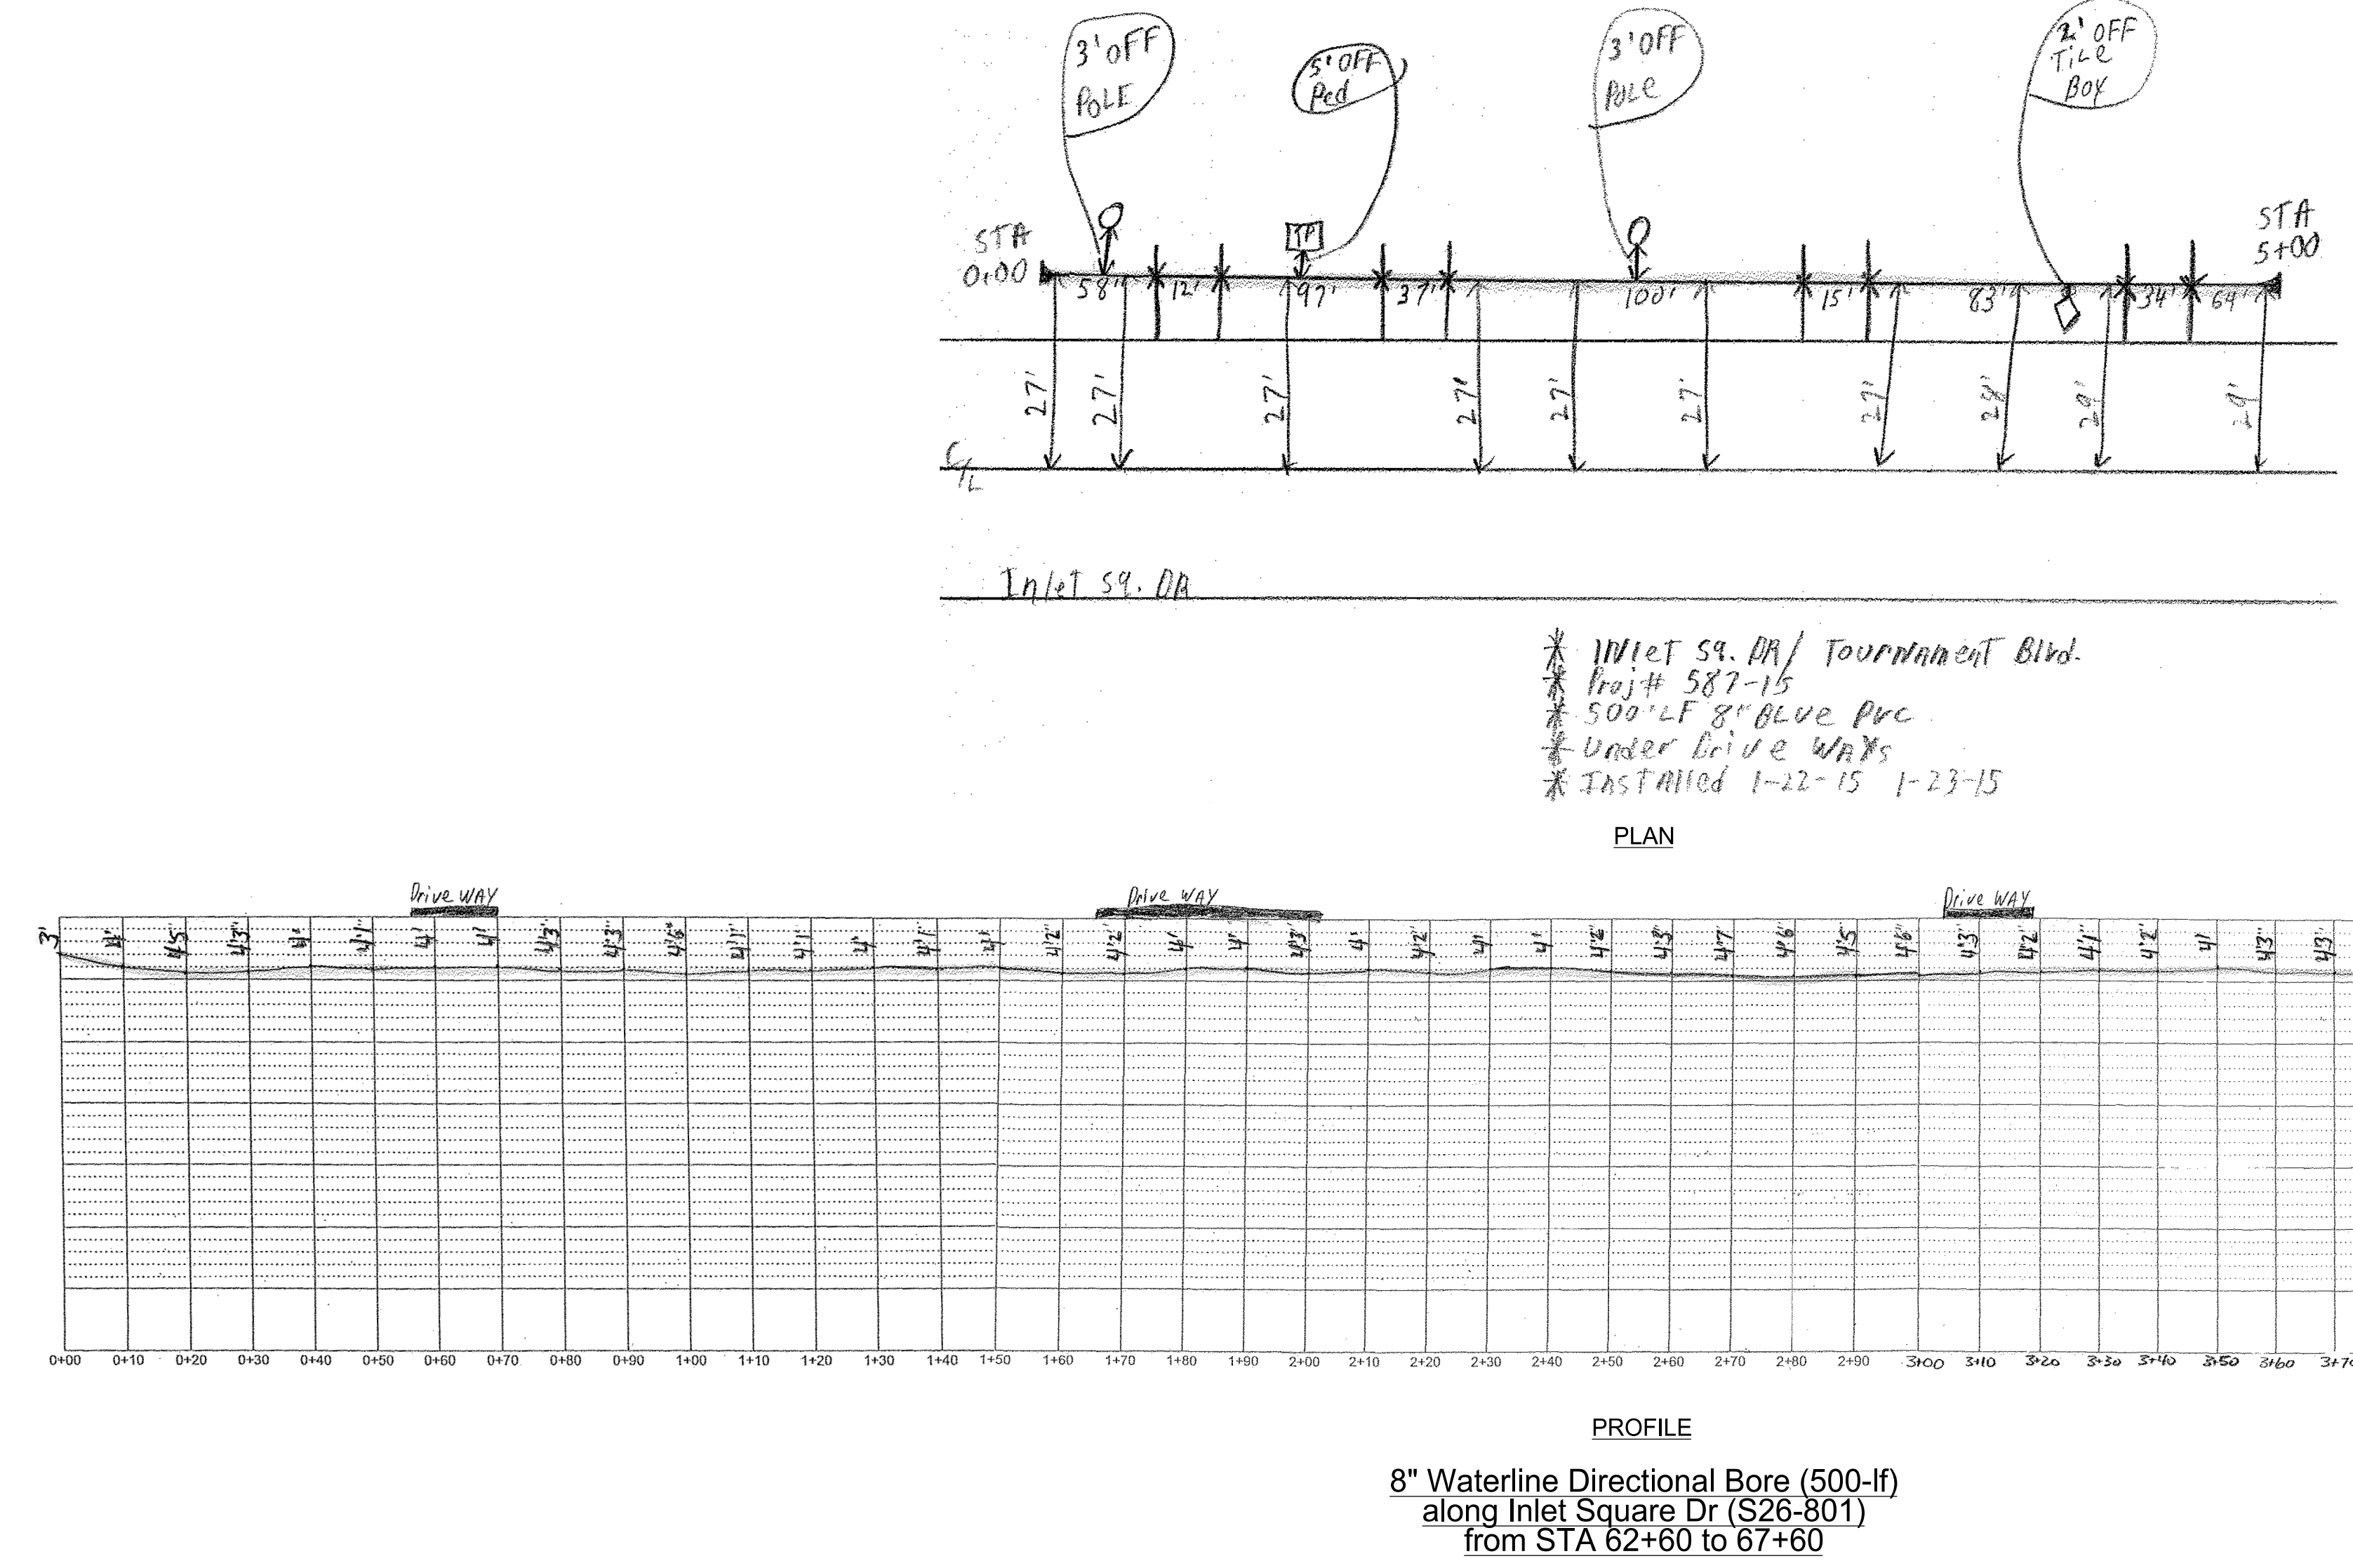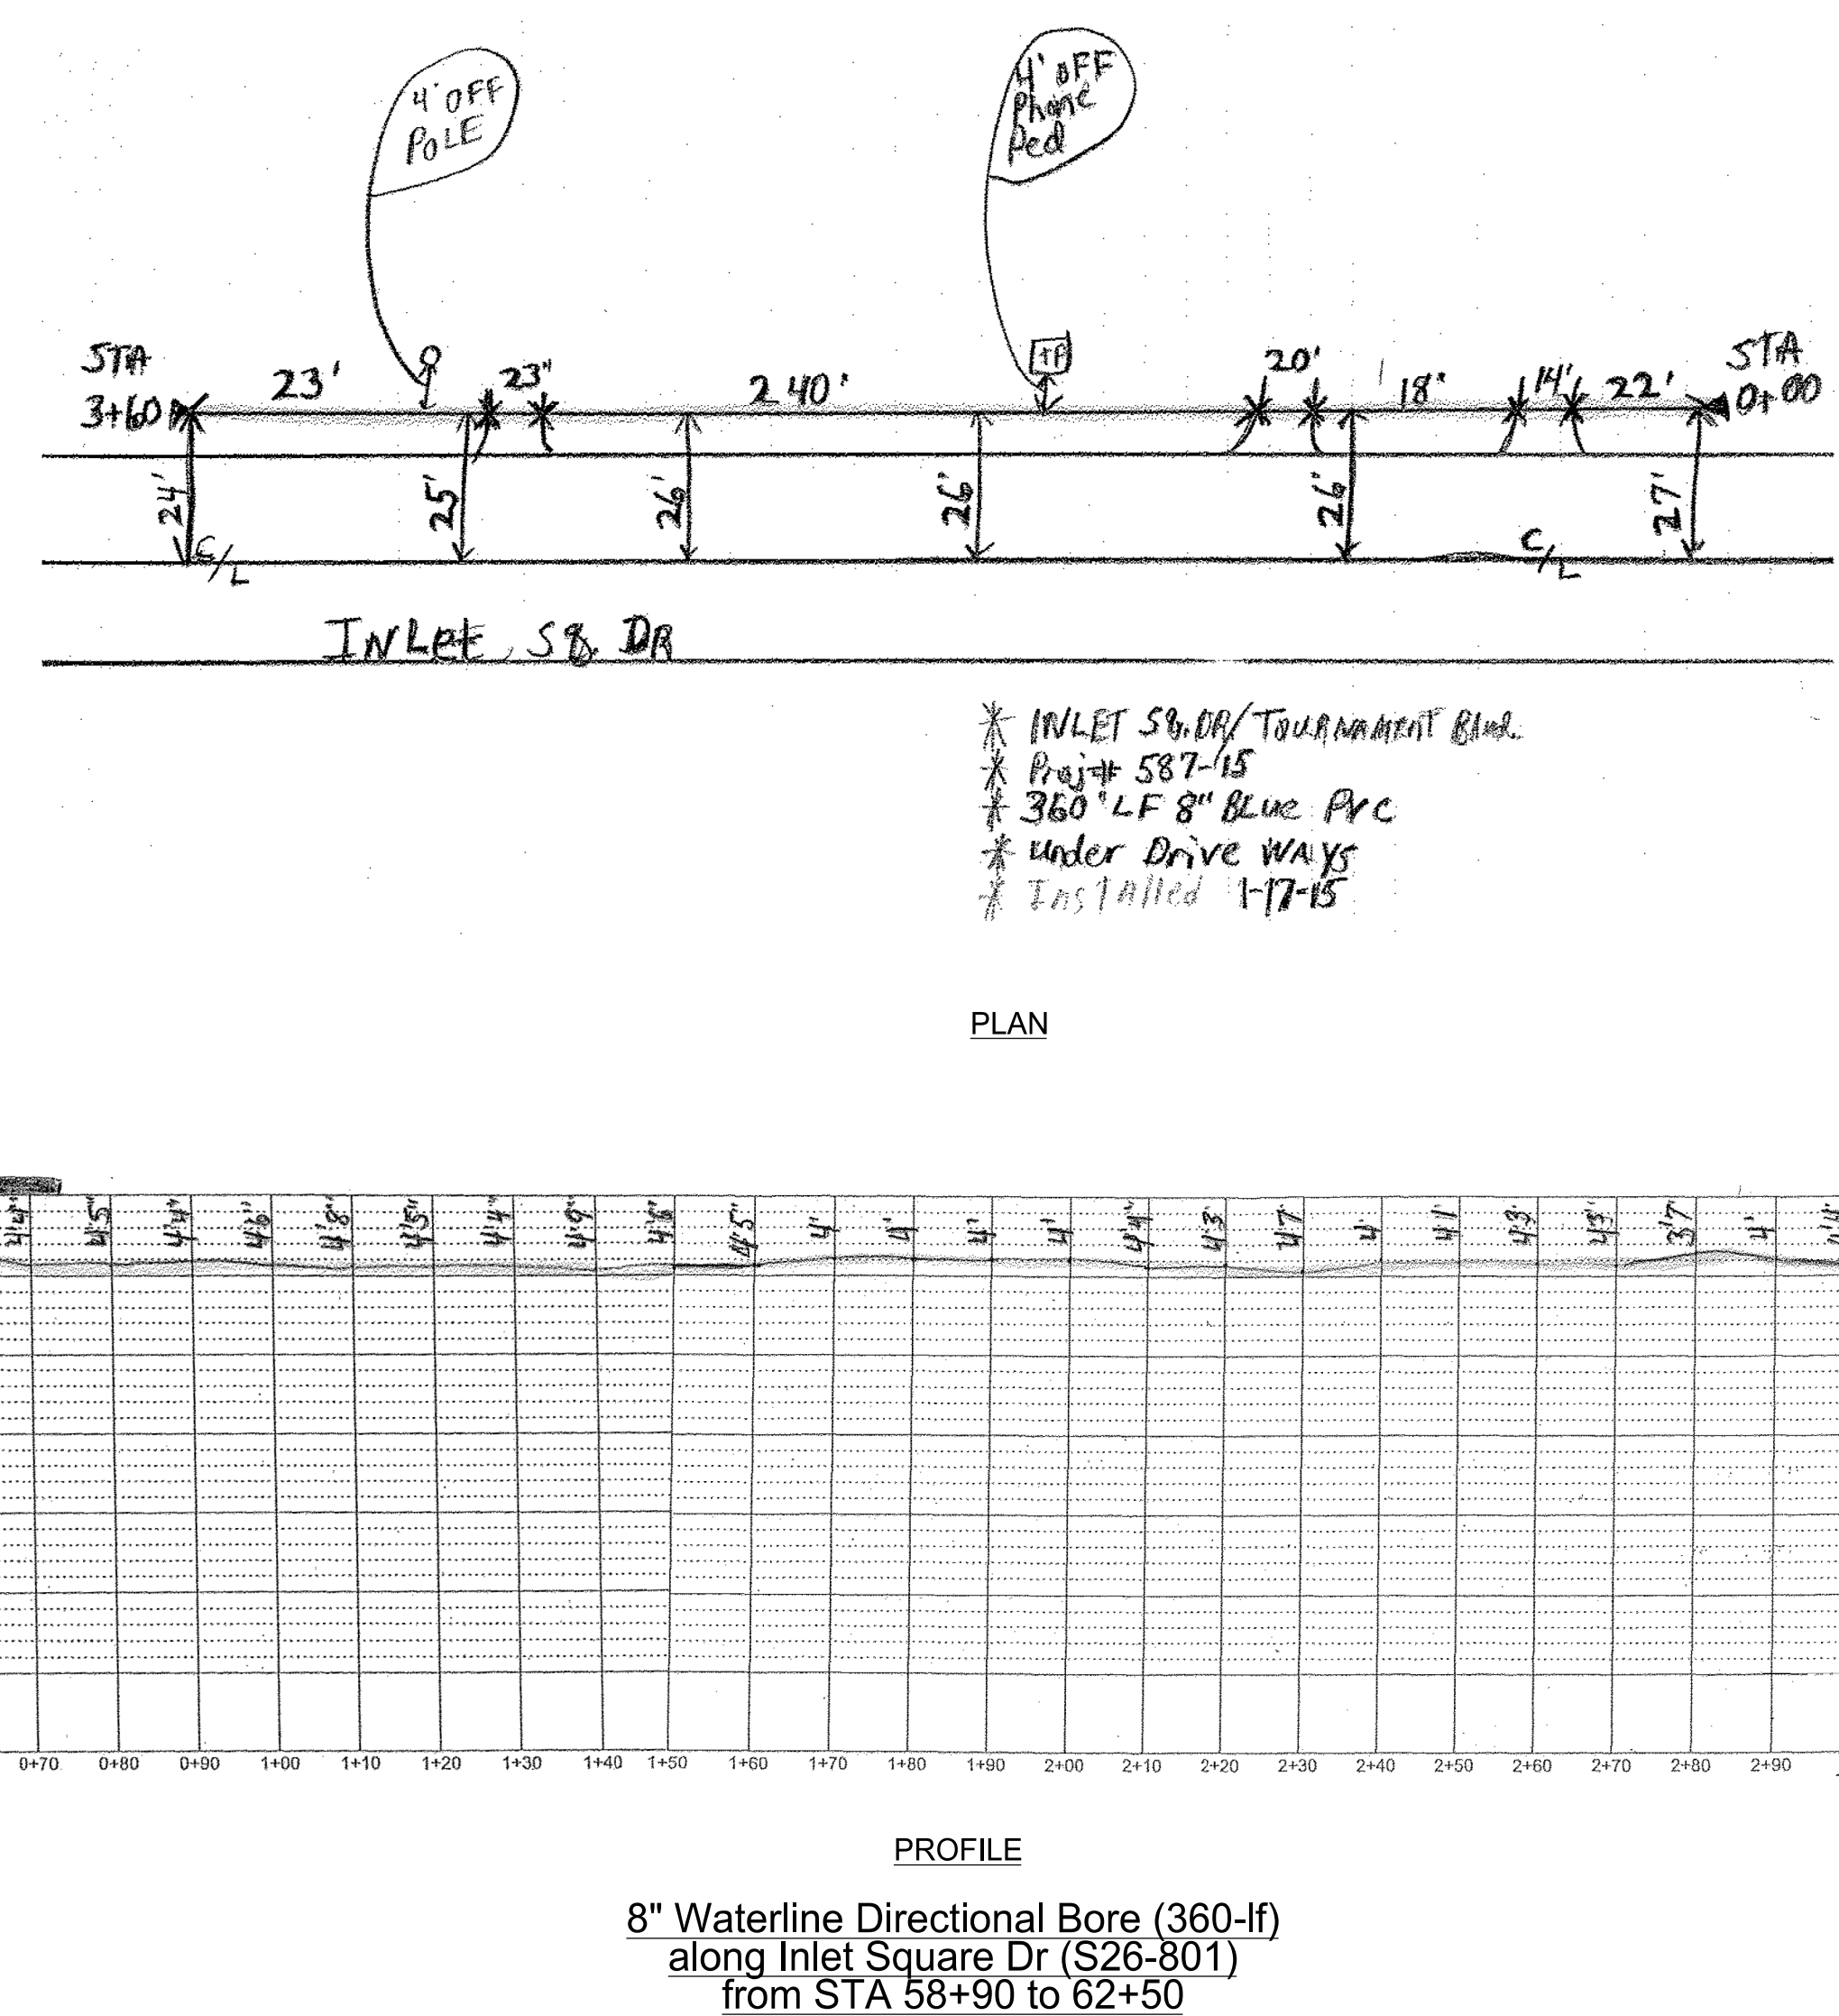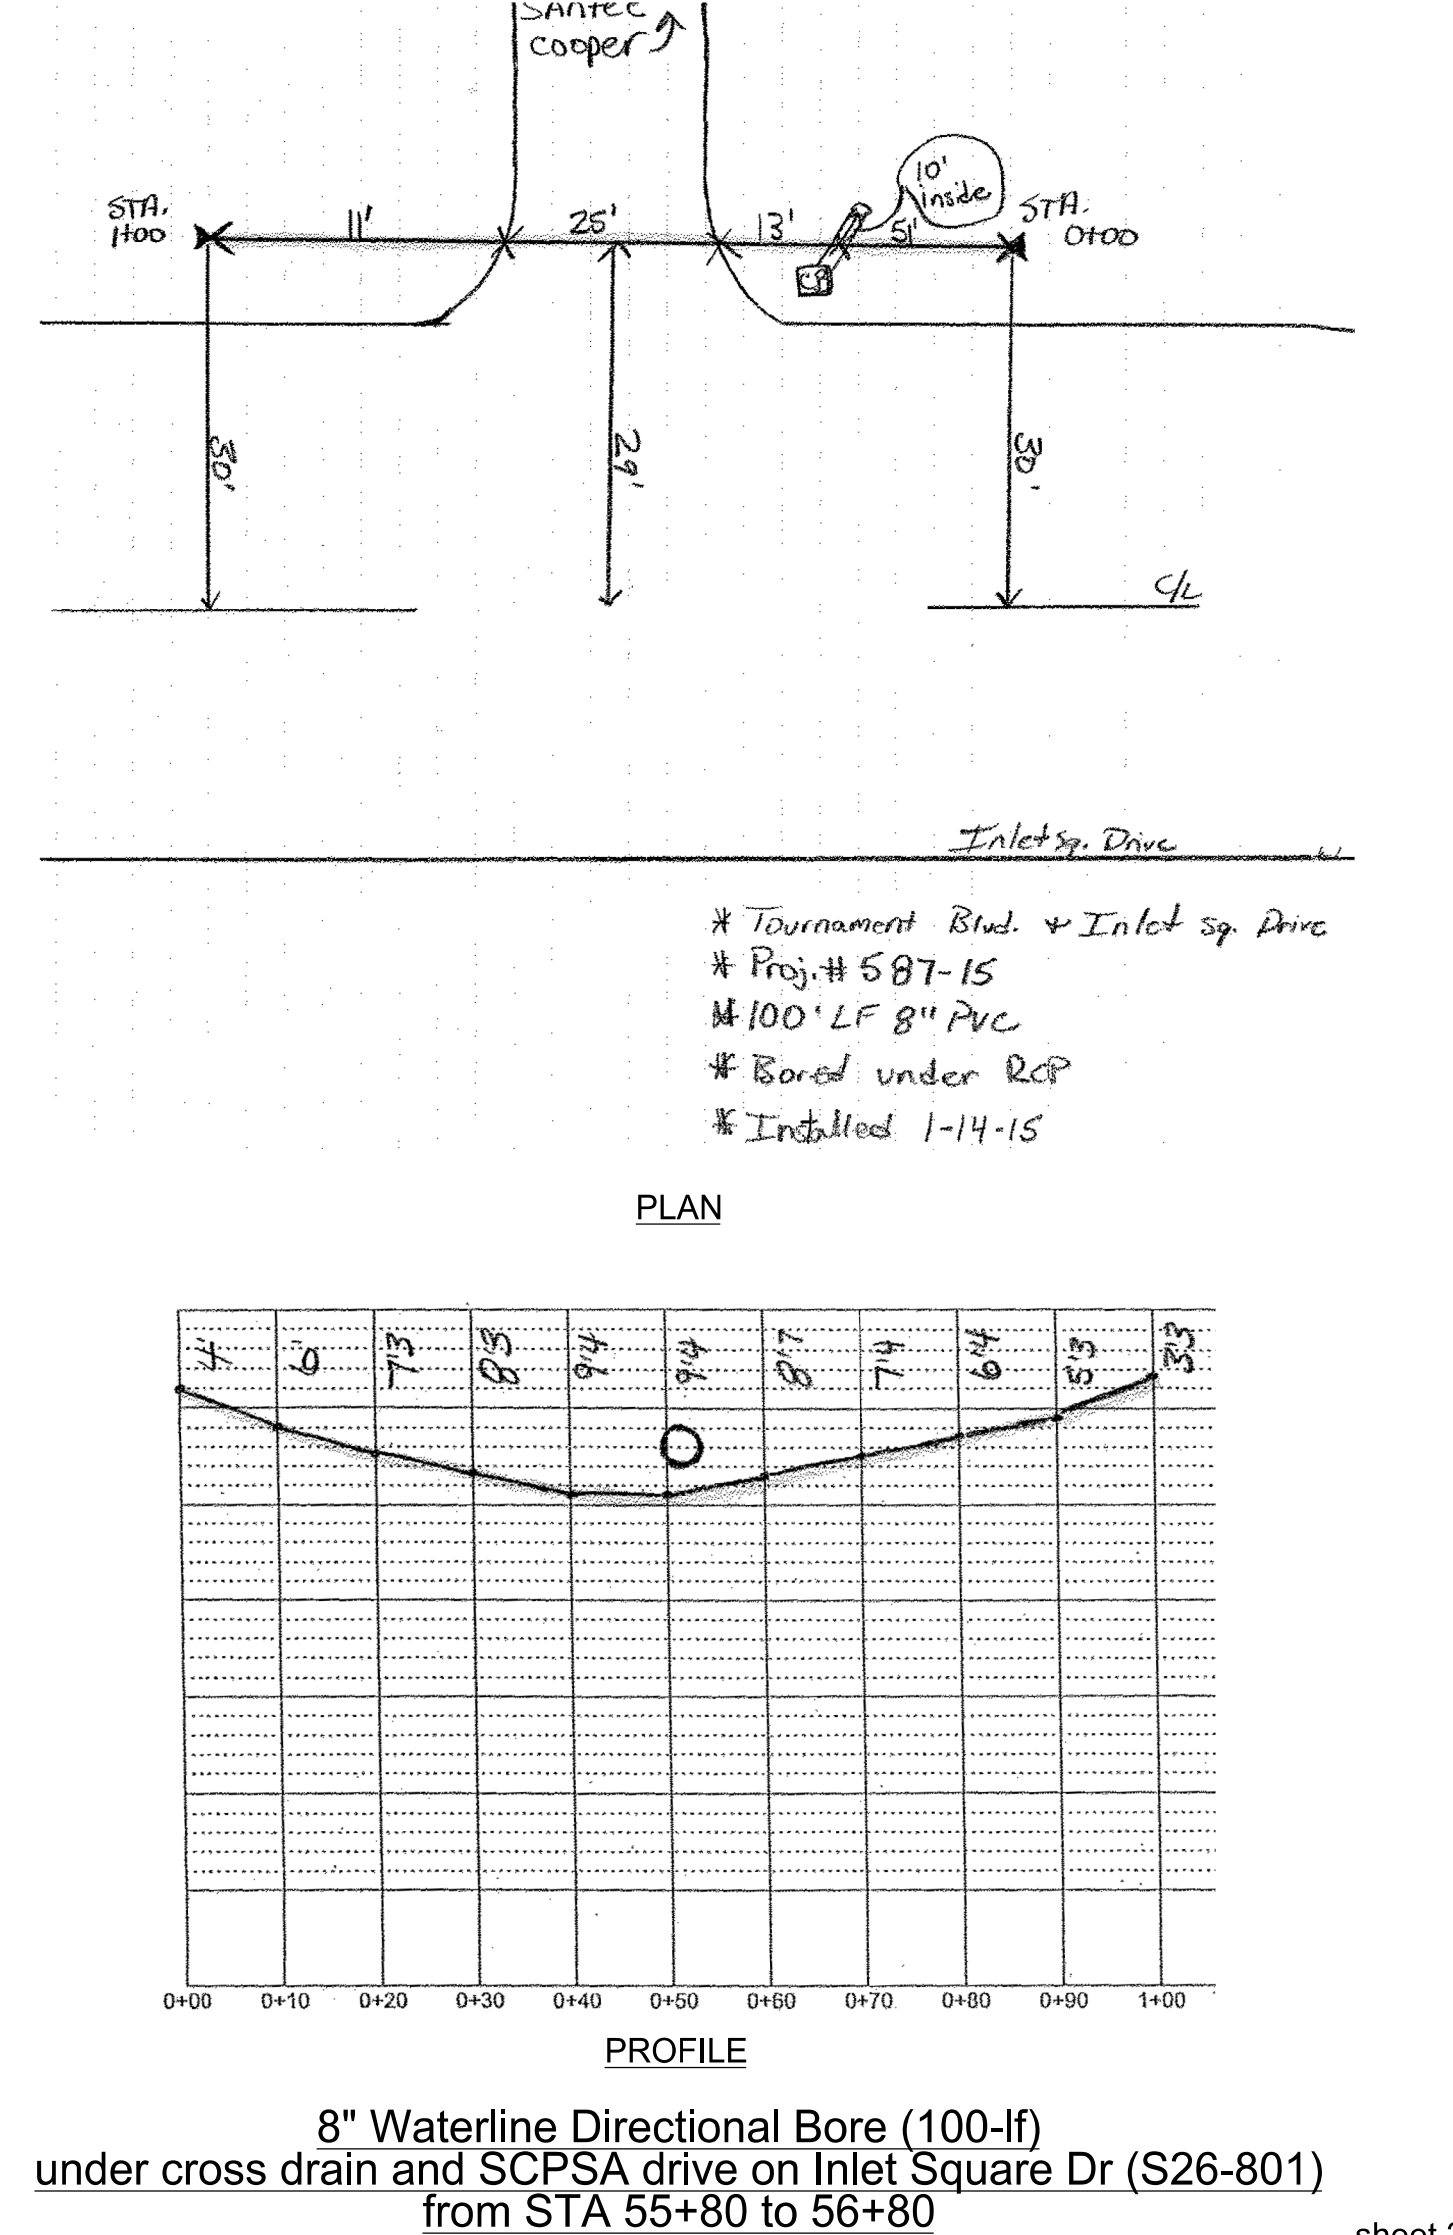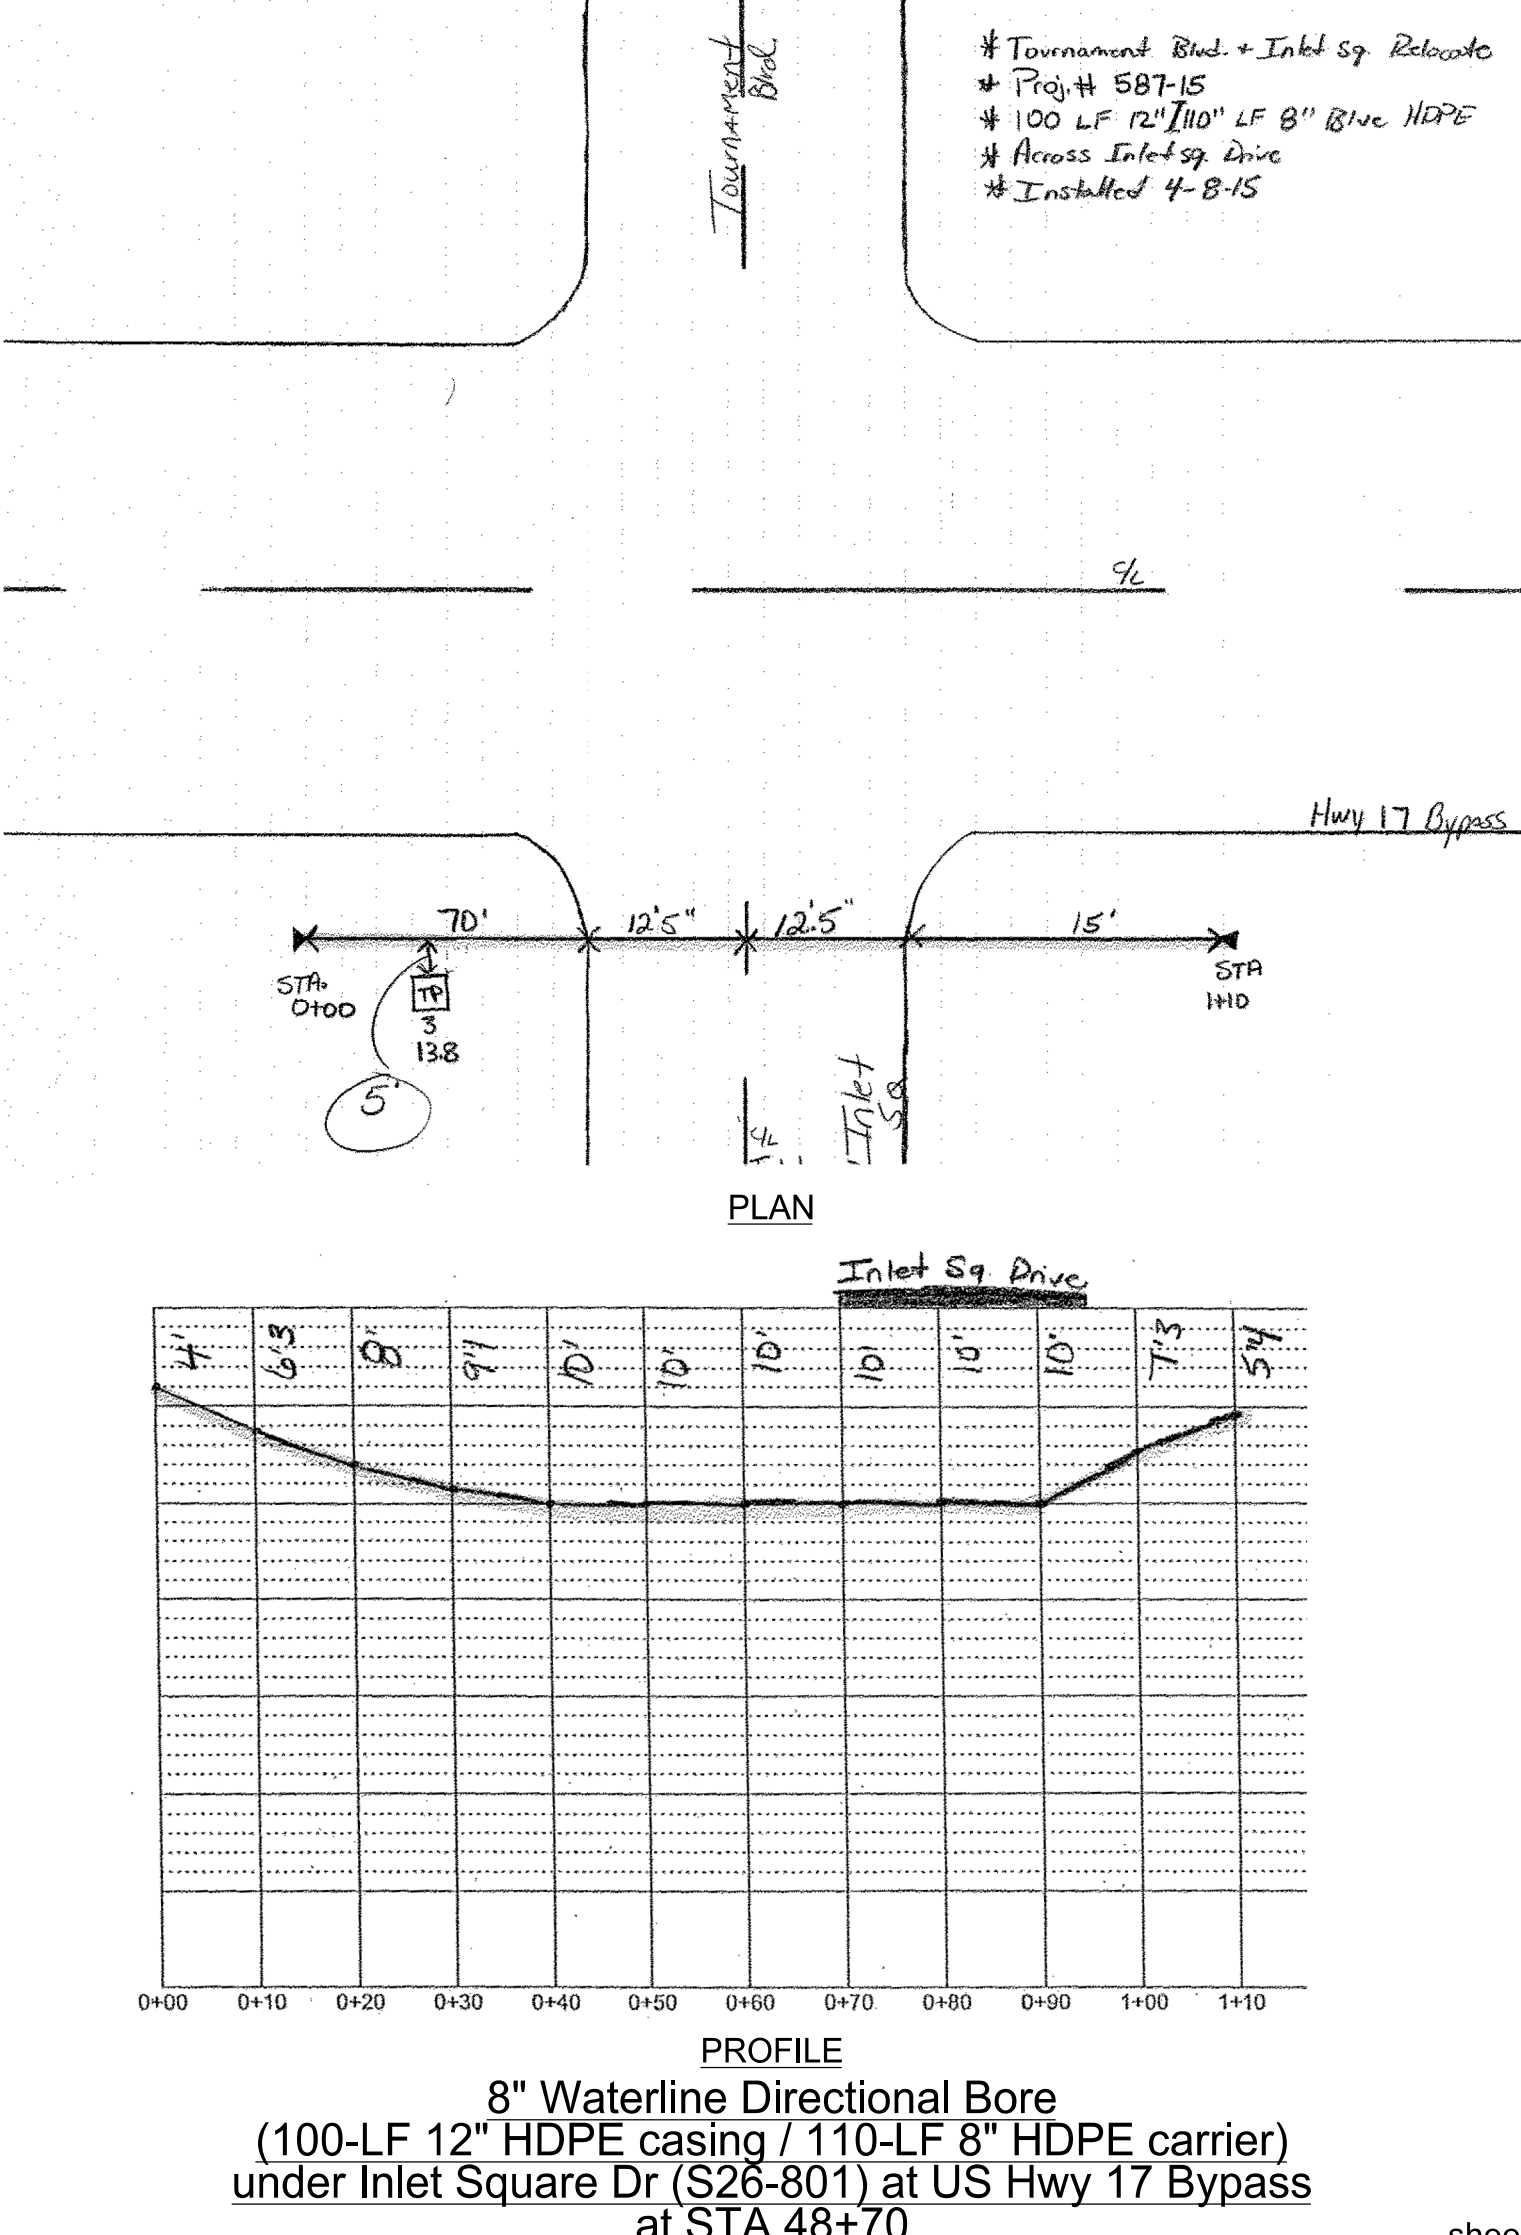

Permit Information:
SCDOT encroachment #14-00334
SCDOT Utility Agreement #13000

Water and Sewer installed by:
GSWSA (Rod Altman)

Directional bores installed by:
GSWSA (Tim Hucks)

AS-BUILT MEASUREMENTS
INDICATED BY

THESE DRAWINGS REFLECT
AS-BUILT
CONDITIONS

REVIEWED BY: INSPECTIONS DATE

REVIEWED BY: ENGINEERING DATE 8/13/15

GRAND STRAND WATER AND SEWER AUTHORITY

