

SCHWARTZ WASTEWATER TREATMENT PLANT

EFFLUENT DISPOSAL

FOR

PHASE I EXPANSION

HIGH TECH TURF FARMS

GRAND STRAND WATER & SEWER AUTHORITY

JANURARY 1986

REVISED

AUGUST 1986



INDEX TO DRAWINGS

SHT. 1 of 6	EFFLUENT LINE - W.W.T.P. TO HOLDING POND
SHT. 2 of 6	EFFLUENT LINE - AT W.W.T.P.
SHT. 3 of 6	TURF FARM PIPING & HEADWORKS PLAN
SHT. 4 of 6	STATIONARY IRRIGATION SYSTEM
SHT. 5 of 6	TURF FARM UTILITY SITE PLAN
SHT. 6 of 6	DETAIL SHEET

GENERAL NOTES

ALL MATERIAL, WORKMANSHIP, CONSTRUCTION AND TESTING SHALL CONFORM TO THE G.S.W.S.A. STANDARD PLANS AND SPECIFICATIONS.

DISTANCES BETWEEN MAIN LINE GATE VALVES ARE APPROXIMATE; LOCATIONS OF GATE VALVES TO BE DETERMINED BY G.S.W.S.A.

THE CONTRACTOR SHALL SECURE ALL NECESSARY ENCROACHMENT AND TRENCH PERMITS FROM APPLICABLE PUBLIC AGENCIES.

THE LOCATIONS OF EXISTING UNDERGROUND UTILITIES, AS SHOWN ON THESE PLANS ARE BASED ON THE BEST INFORMATION AVAILABLE TO G.S.W.S.A. AND ARE APPROXIMATE ONLY; G.S.W.S.A. ASSUMES NO RESPONSIBILITY FOR THE ACCURACY OF THE INFORMATION SHOWN, OR FOR INADVERTANT OMMISION OF ANY SUCH INFORMATION. THE CONTRACTOR SHALL COOPERATE WITH ALL UTILITY COMPANIES AND OTHER CONTRACTORS WITHIN THE AREA OF THIS PROJECT; G.S.W.S.A. ASSUMES NO RESPONSIBILITY FOR OBSTRUCTIONS WHICH MAY BE ENCOUNTERED.

NO CONSTRUCTION SHALL COMMENCE WITHOUT PRIOR APPROVAL OF THE G.S.W.S.A.

REVISION	BY	DATE

SCHWARTZ W.W.T.P. EFFLUENT DISPOSAL EFFLUENT LINE W.W.T.P. TO HOLDING POND GRAND STRAND WATER & SEWER AUTHORITY

P.O. BOX 1537 CONWAY, S.C. 29526
TELEPHONE (803) 347-4641 448-1686

DATE : DECEMBER 1985

SCALE : 1" = 300'

DRAWN BY P. JENERETTE

CHECKED BY J. HEMBREE

C. HUCKS


APPROVED BY


FRED RICHARDSON P.E. No. 9853

SHEET 1 of 6

DRAWING No.

7-03-001/5-S

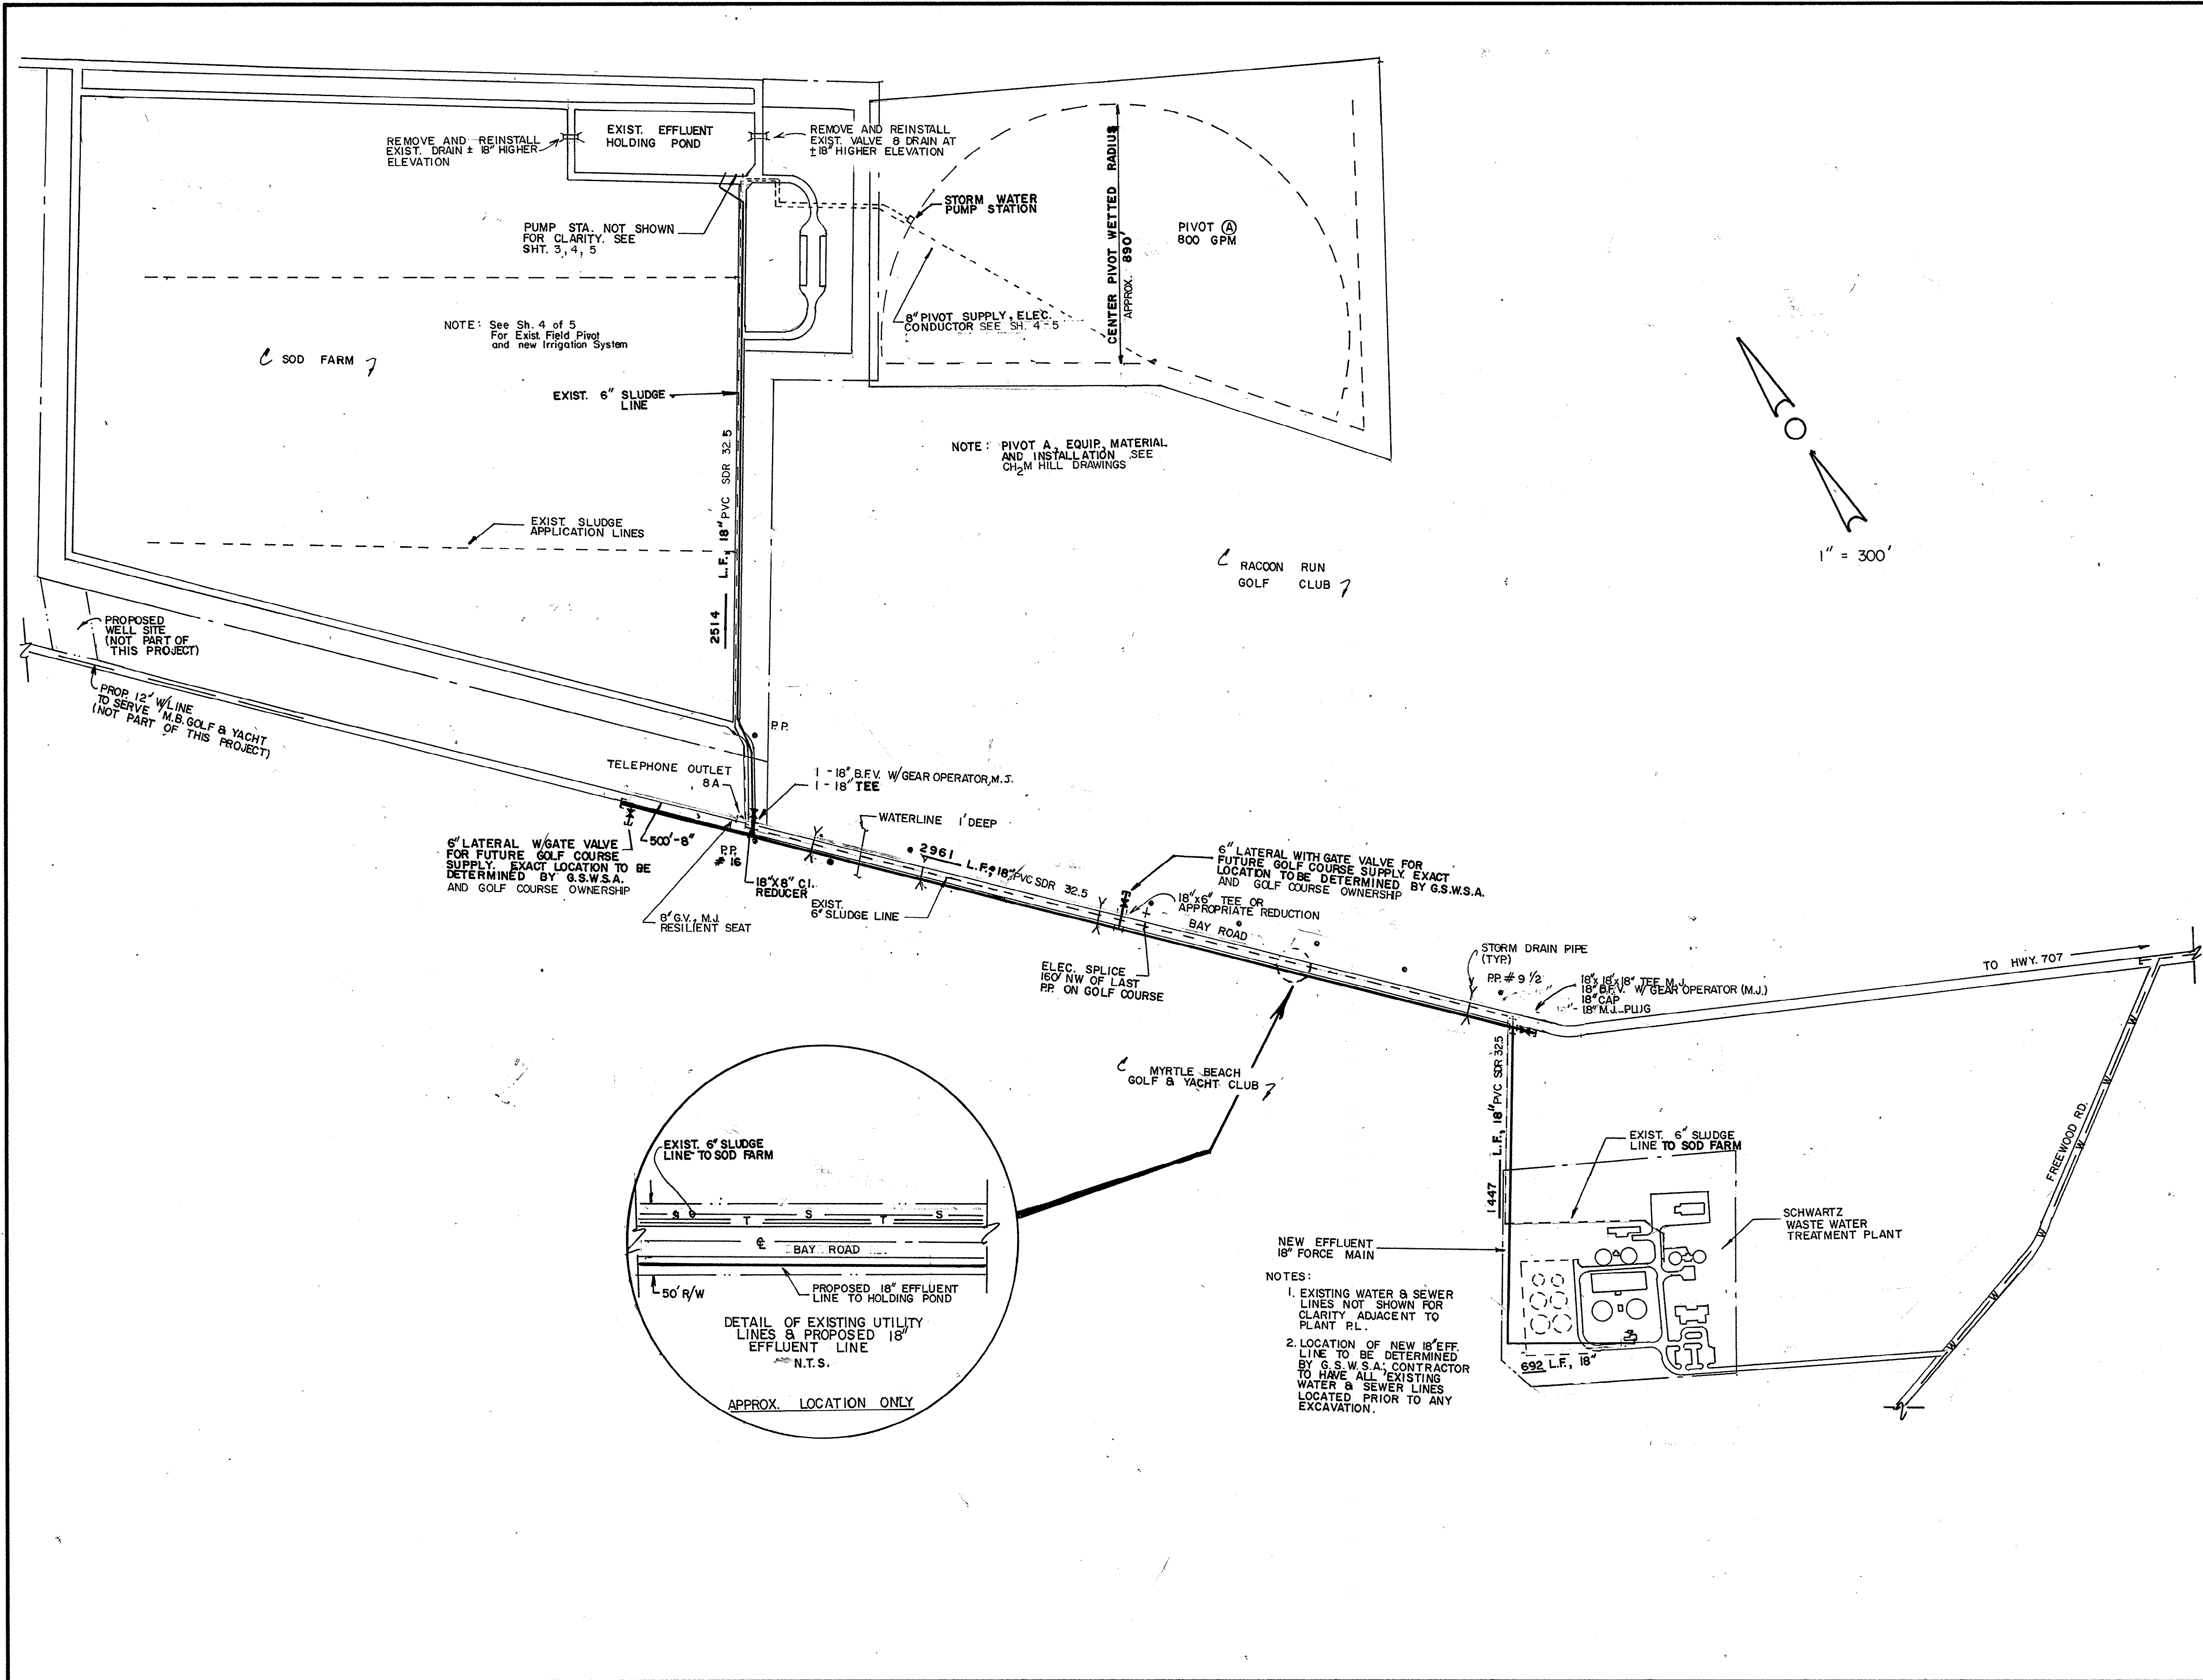


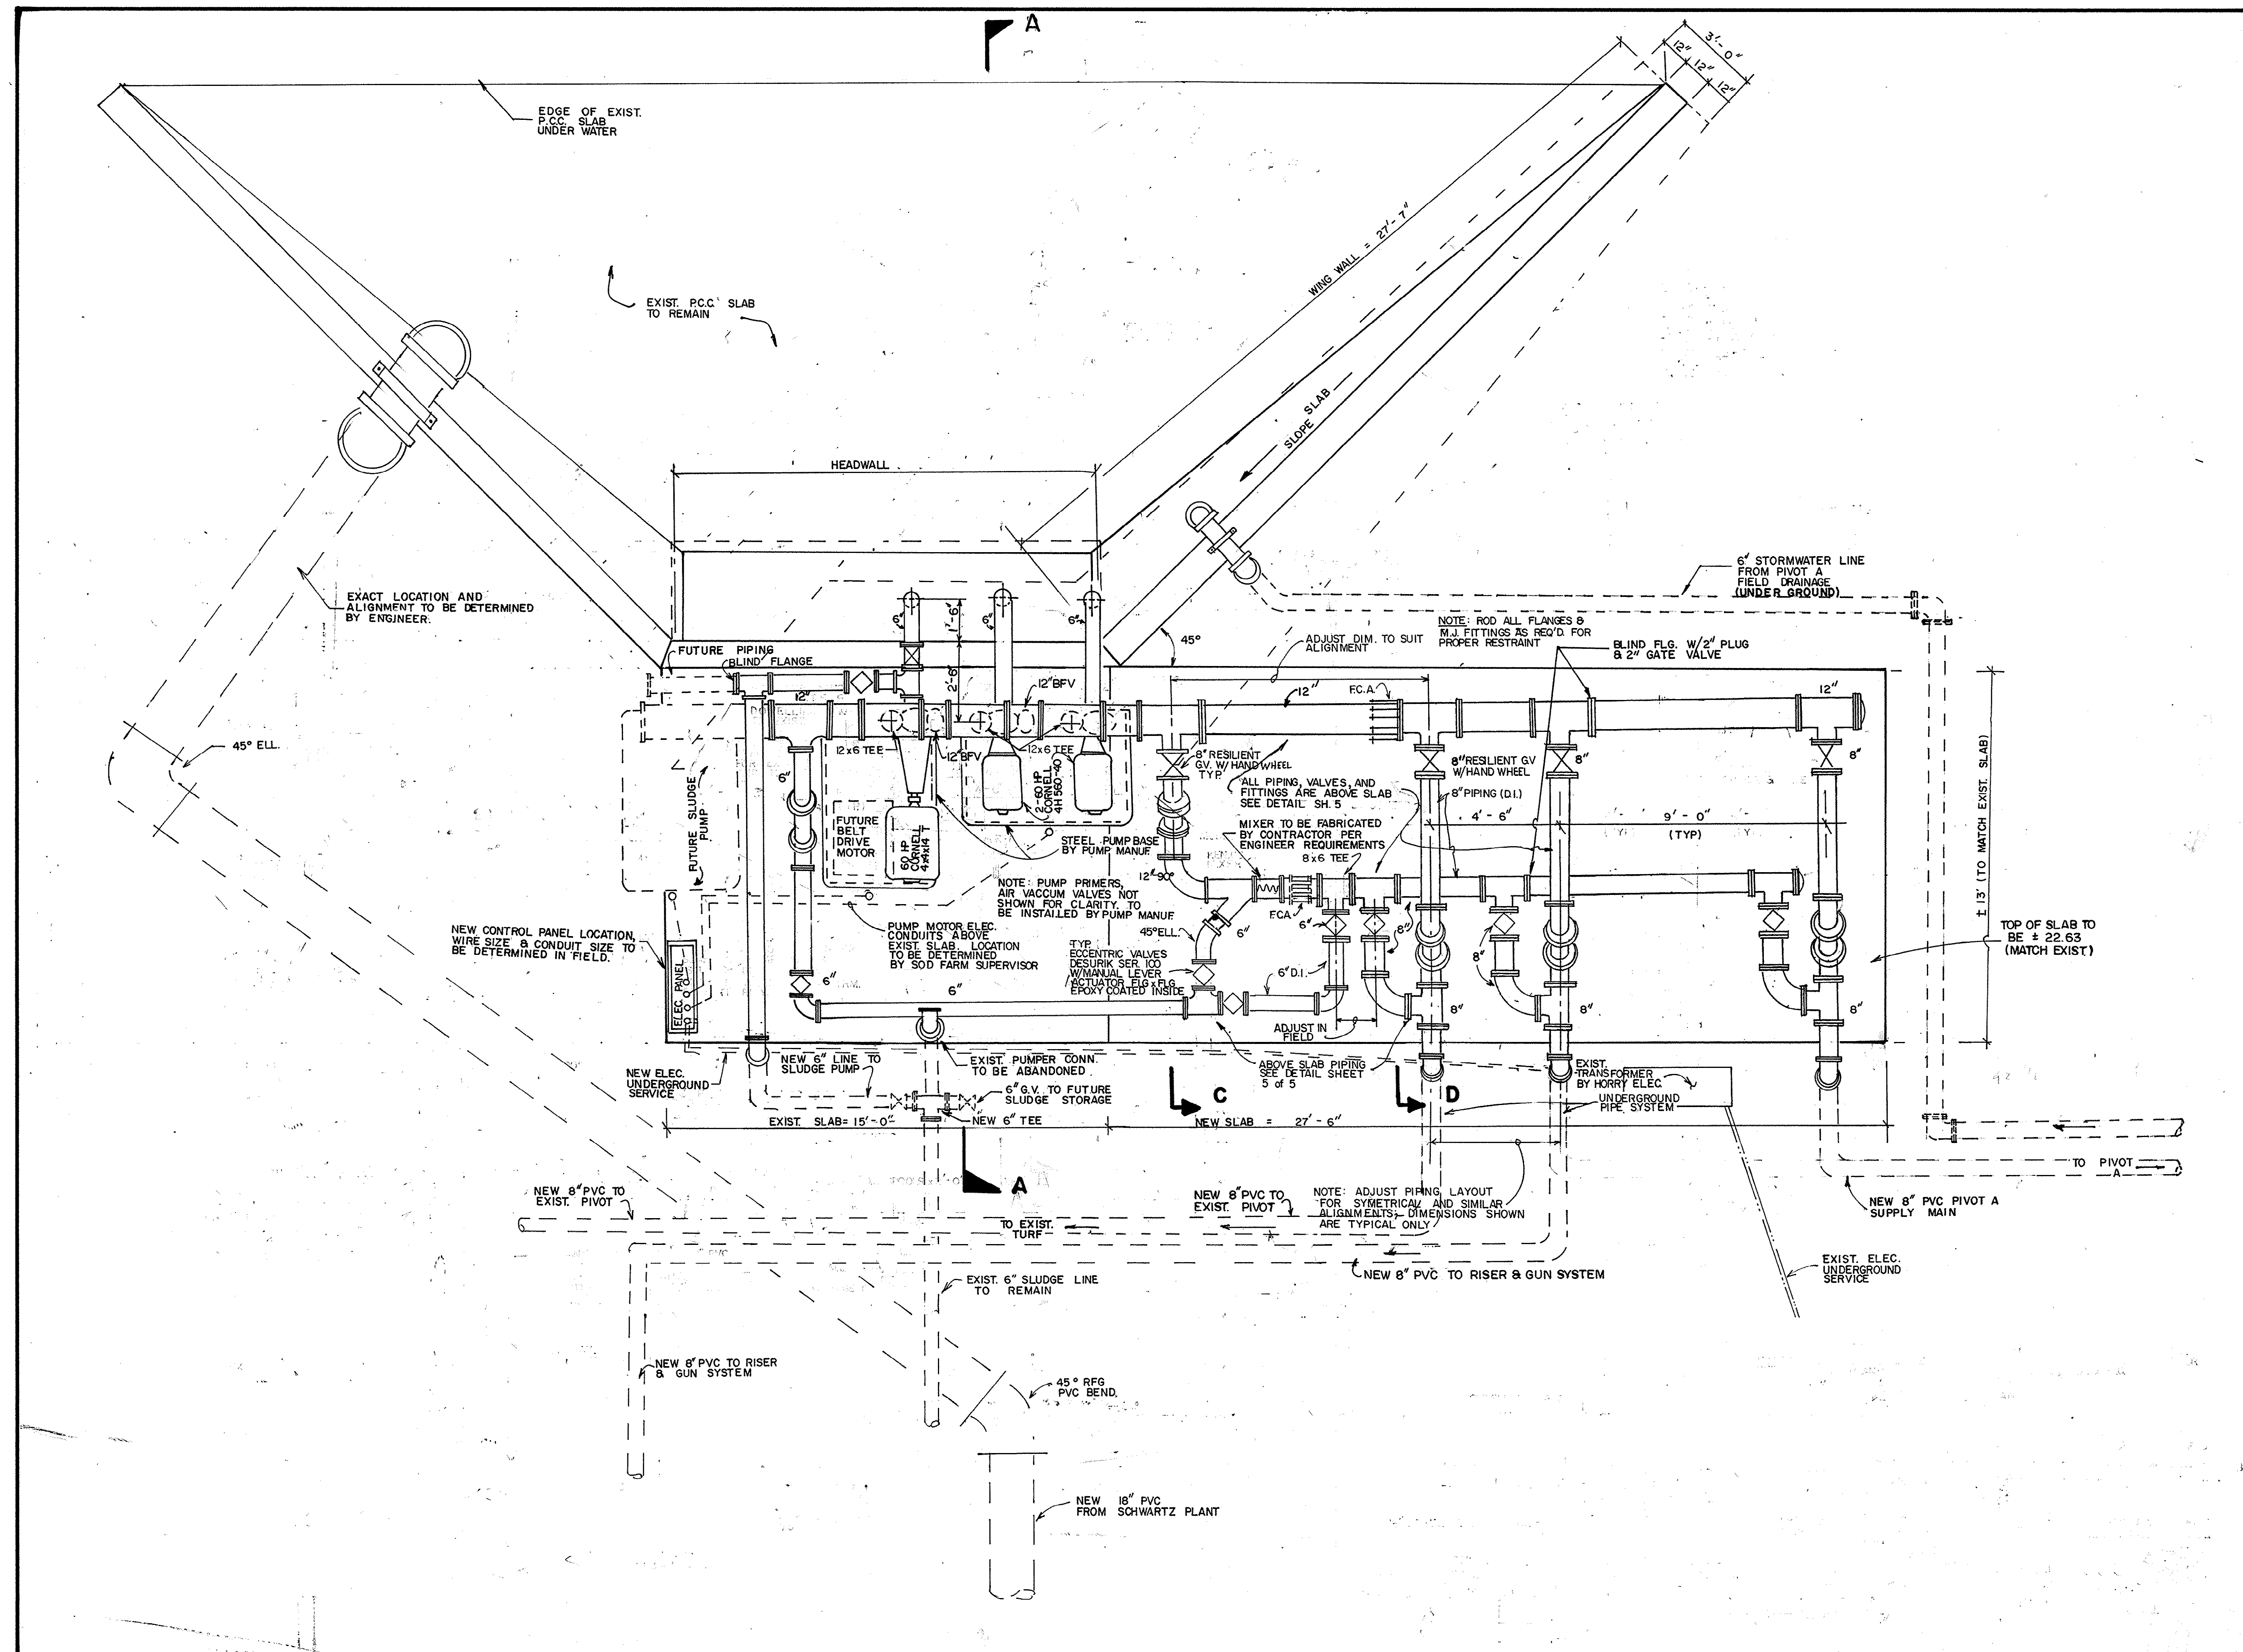


REVISION	BY	DATE

SCHWARTZ W.W.T.P. EFFLUENT DISPOSAL
TURF FARM PIPING & POND HEADWORKS PLAN
GRAND STRAND WATER & SEWER AUTHORITY

P.O. BOX 1537 CONWAY, S.C. 29526
 TELEPHONE (803) 347-4641 448-1686

DATE :	DECEMBER 1985
SCALE :	3/8" = 1' - 0"
DRAWN BY	P. JENERETTE
CHECKED BY	J. HEMBREE
APPROVED BY	C. HUCKS
FRED RICHARDSON P.E. No. 9853	
SHEET	3 of 6
DRAWING No.	7-03-003/6-S





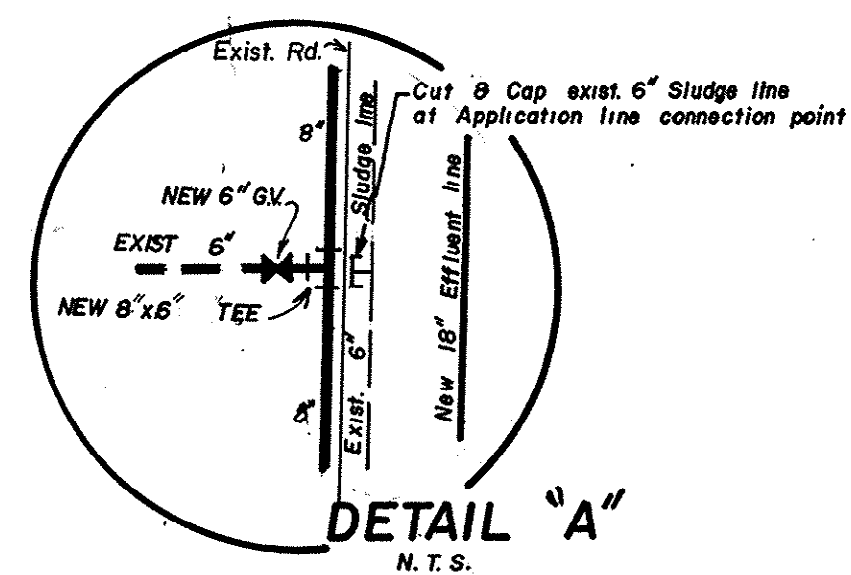
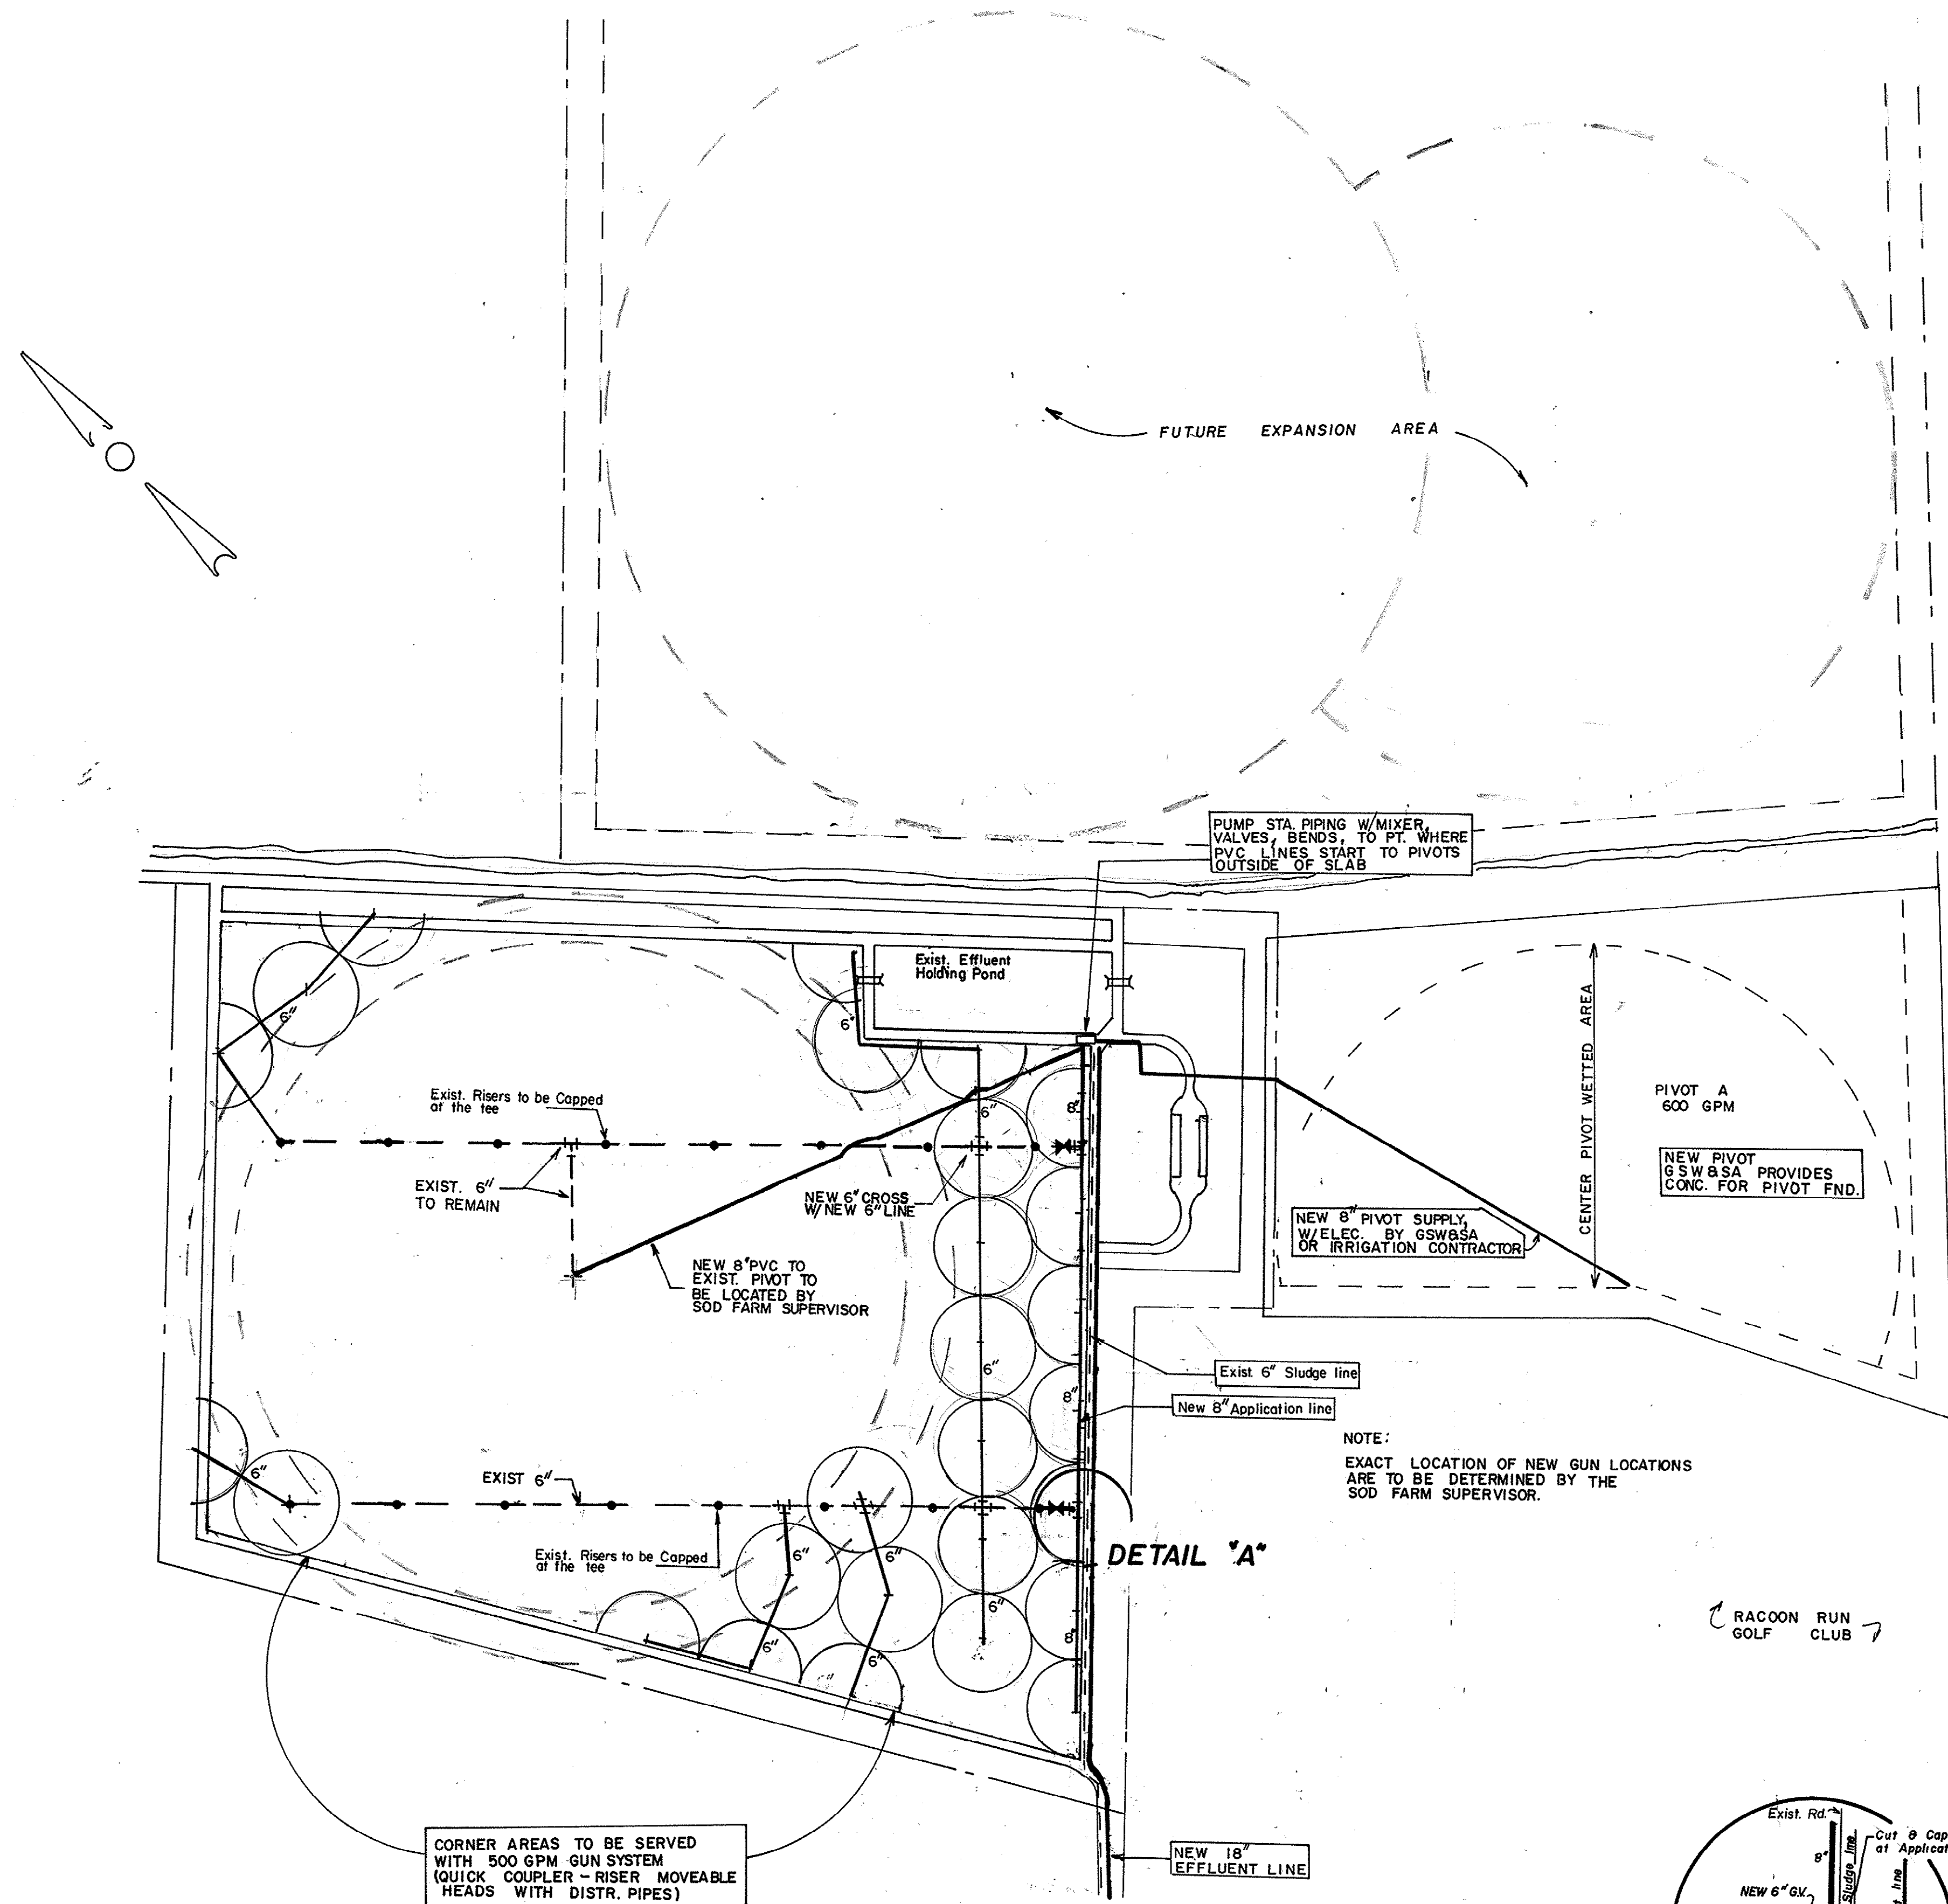


REVISION	BY	DATE

**SCHWARTZ W.W.T.P. EFFLUENT DISPOSAL
STATIONARY IRRIGATION SYSTEM
GRAND STRAND WATER & SEWER AUTHORITY**

P.D. BOX 1537 CONWAY S.C. 29526 (803) 347-4641 448-1886

DATE	11/86
SCALE	1" = 300'
DRAWN BY	P. JENERETTE
CHK'D BY	J. HEMBREE
APPROVED BY	
FRED RICHARDSON P.E. No. 9833	
SHEET 4 OF 6	
DWG. No. 7-03-004/6	

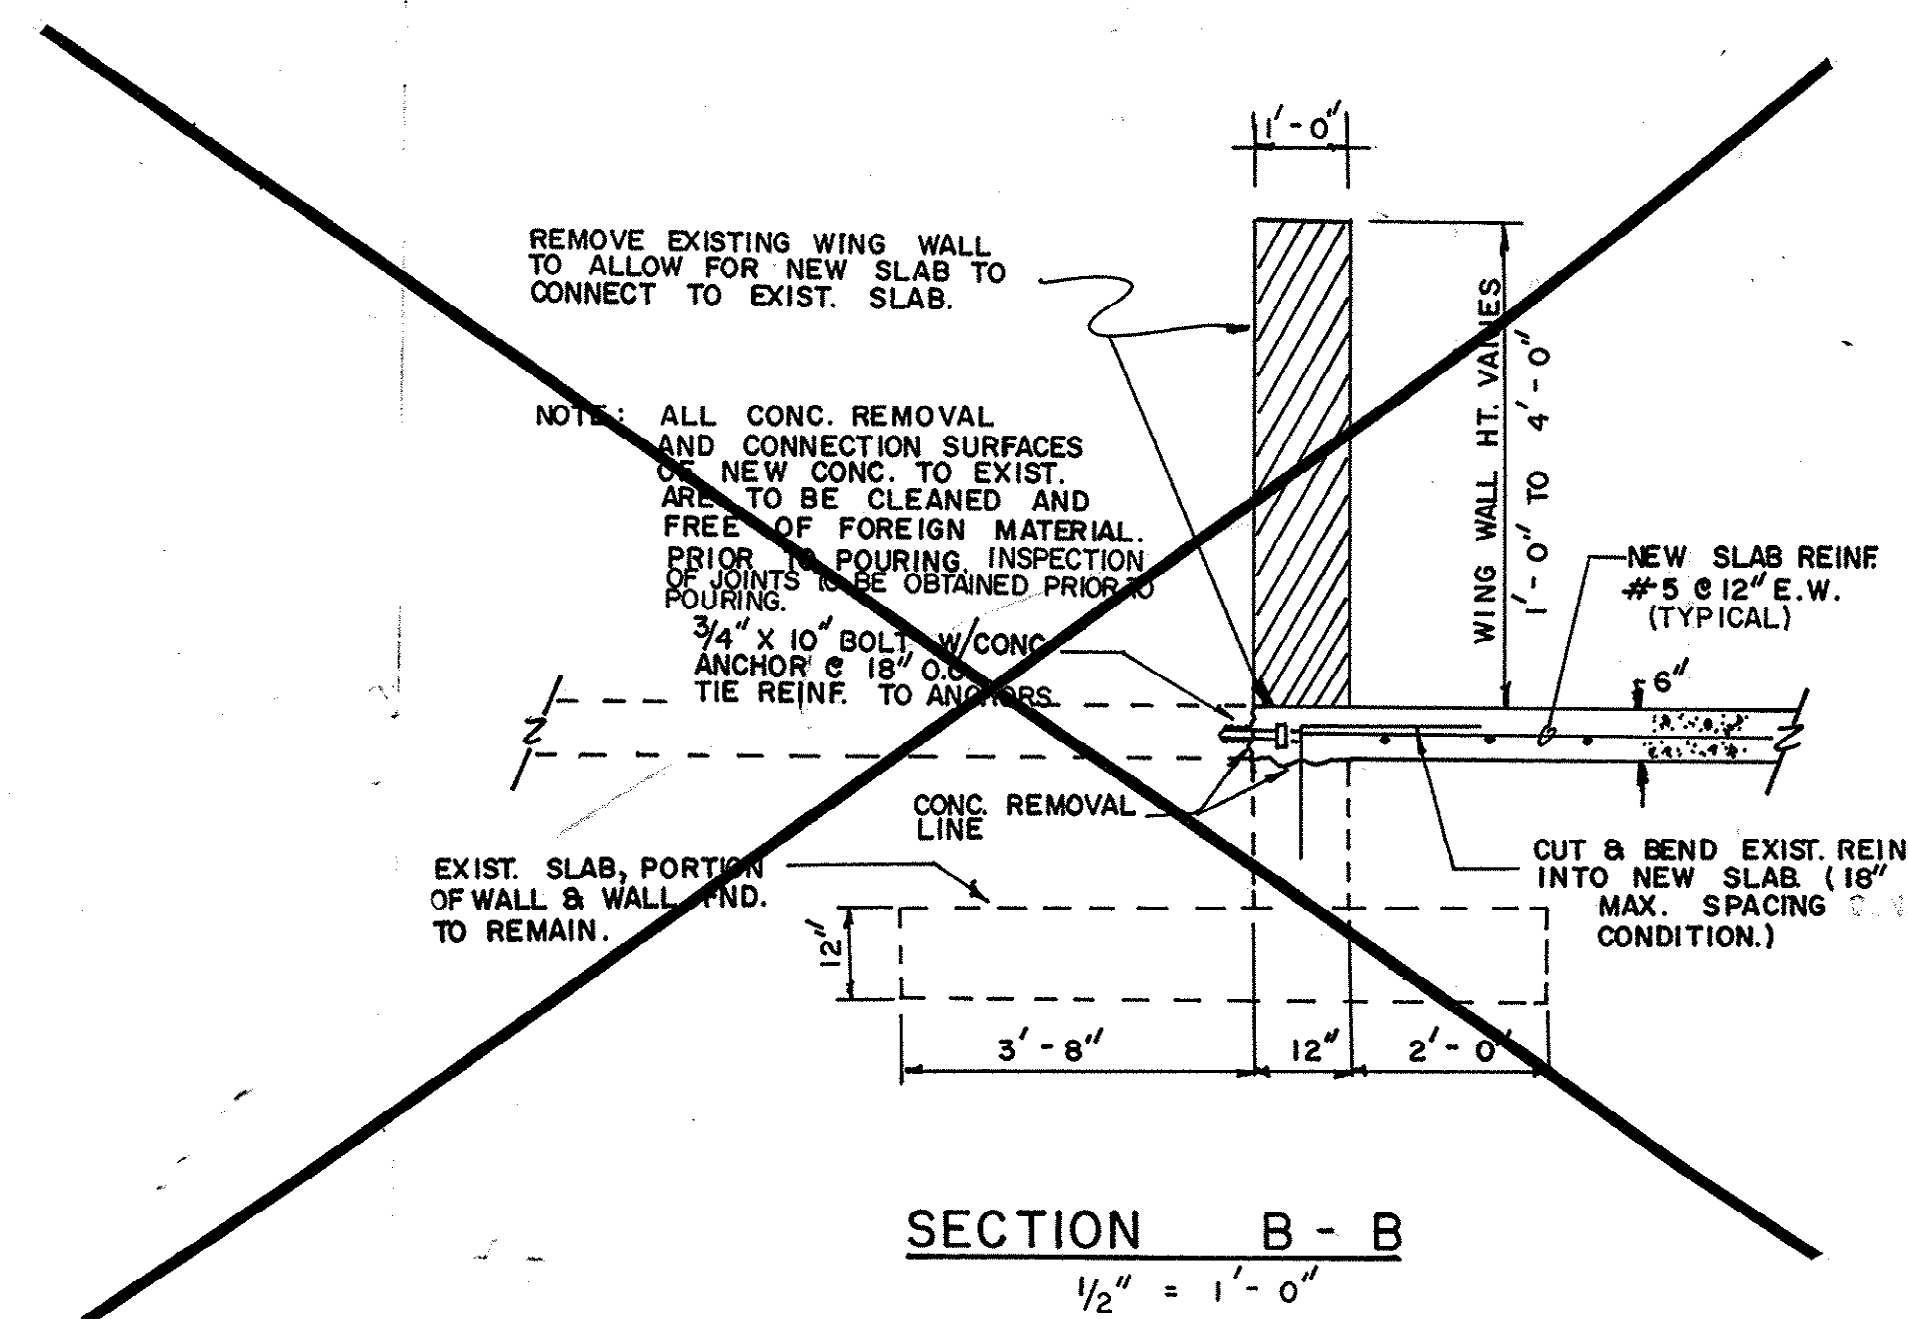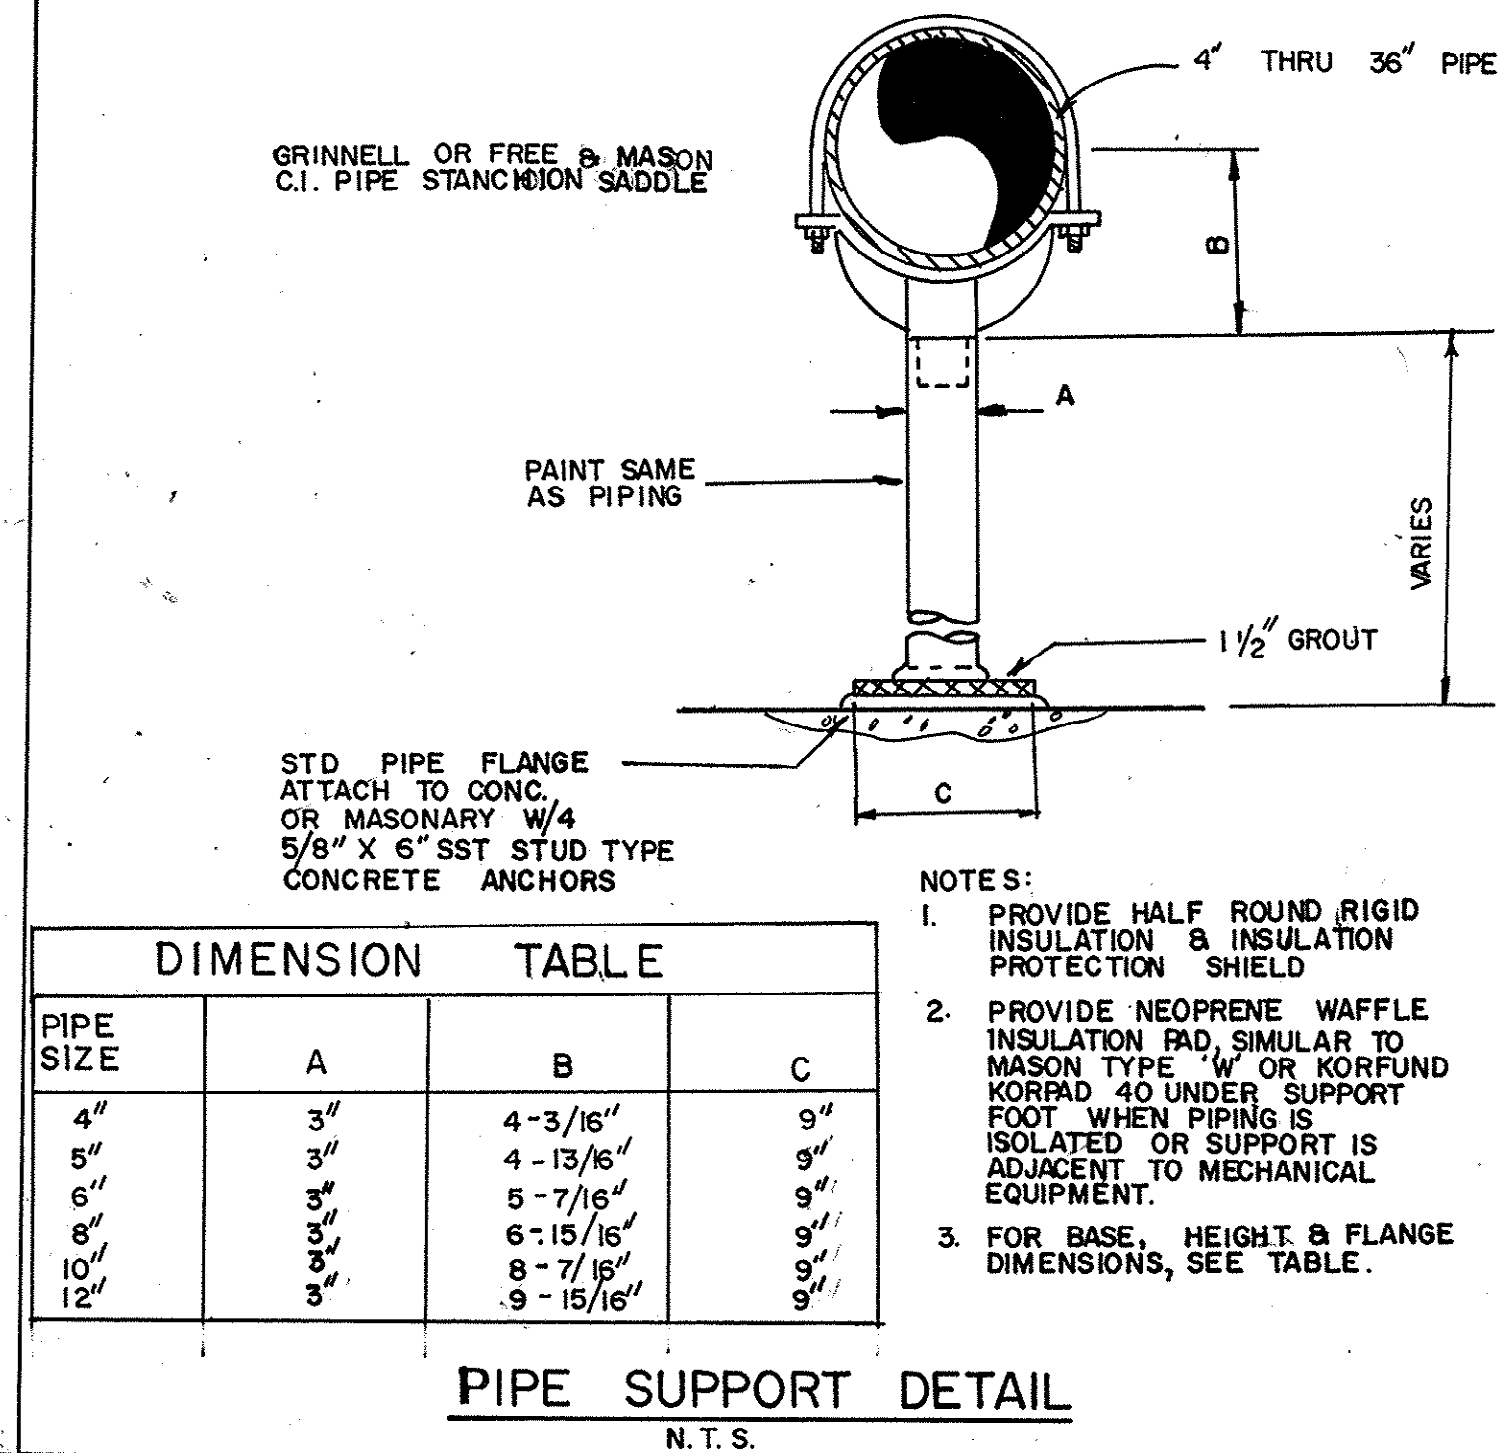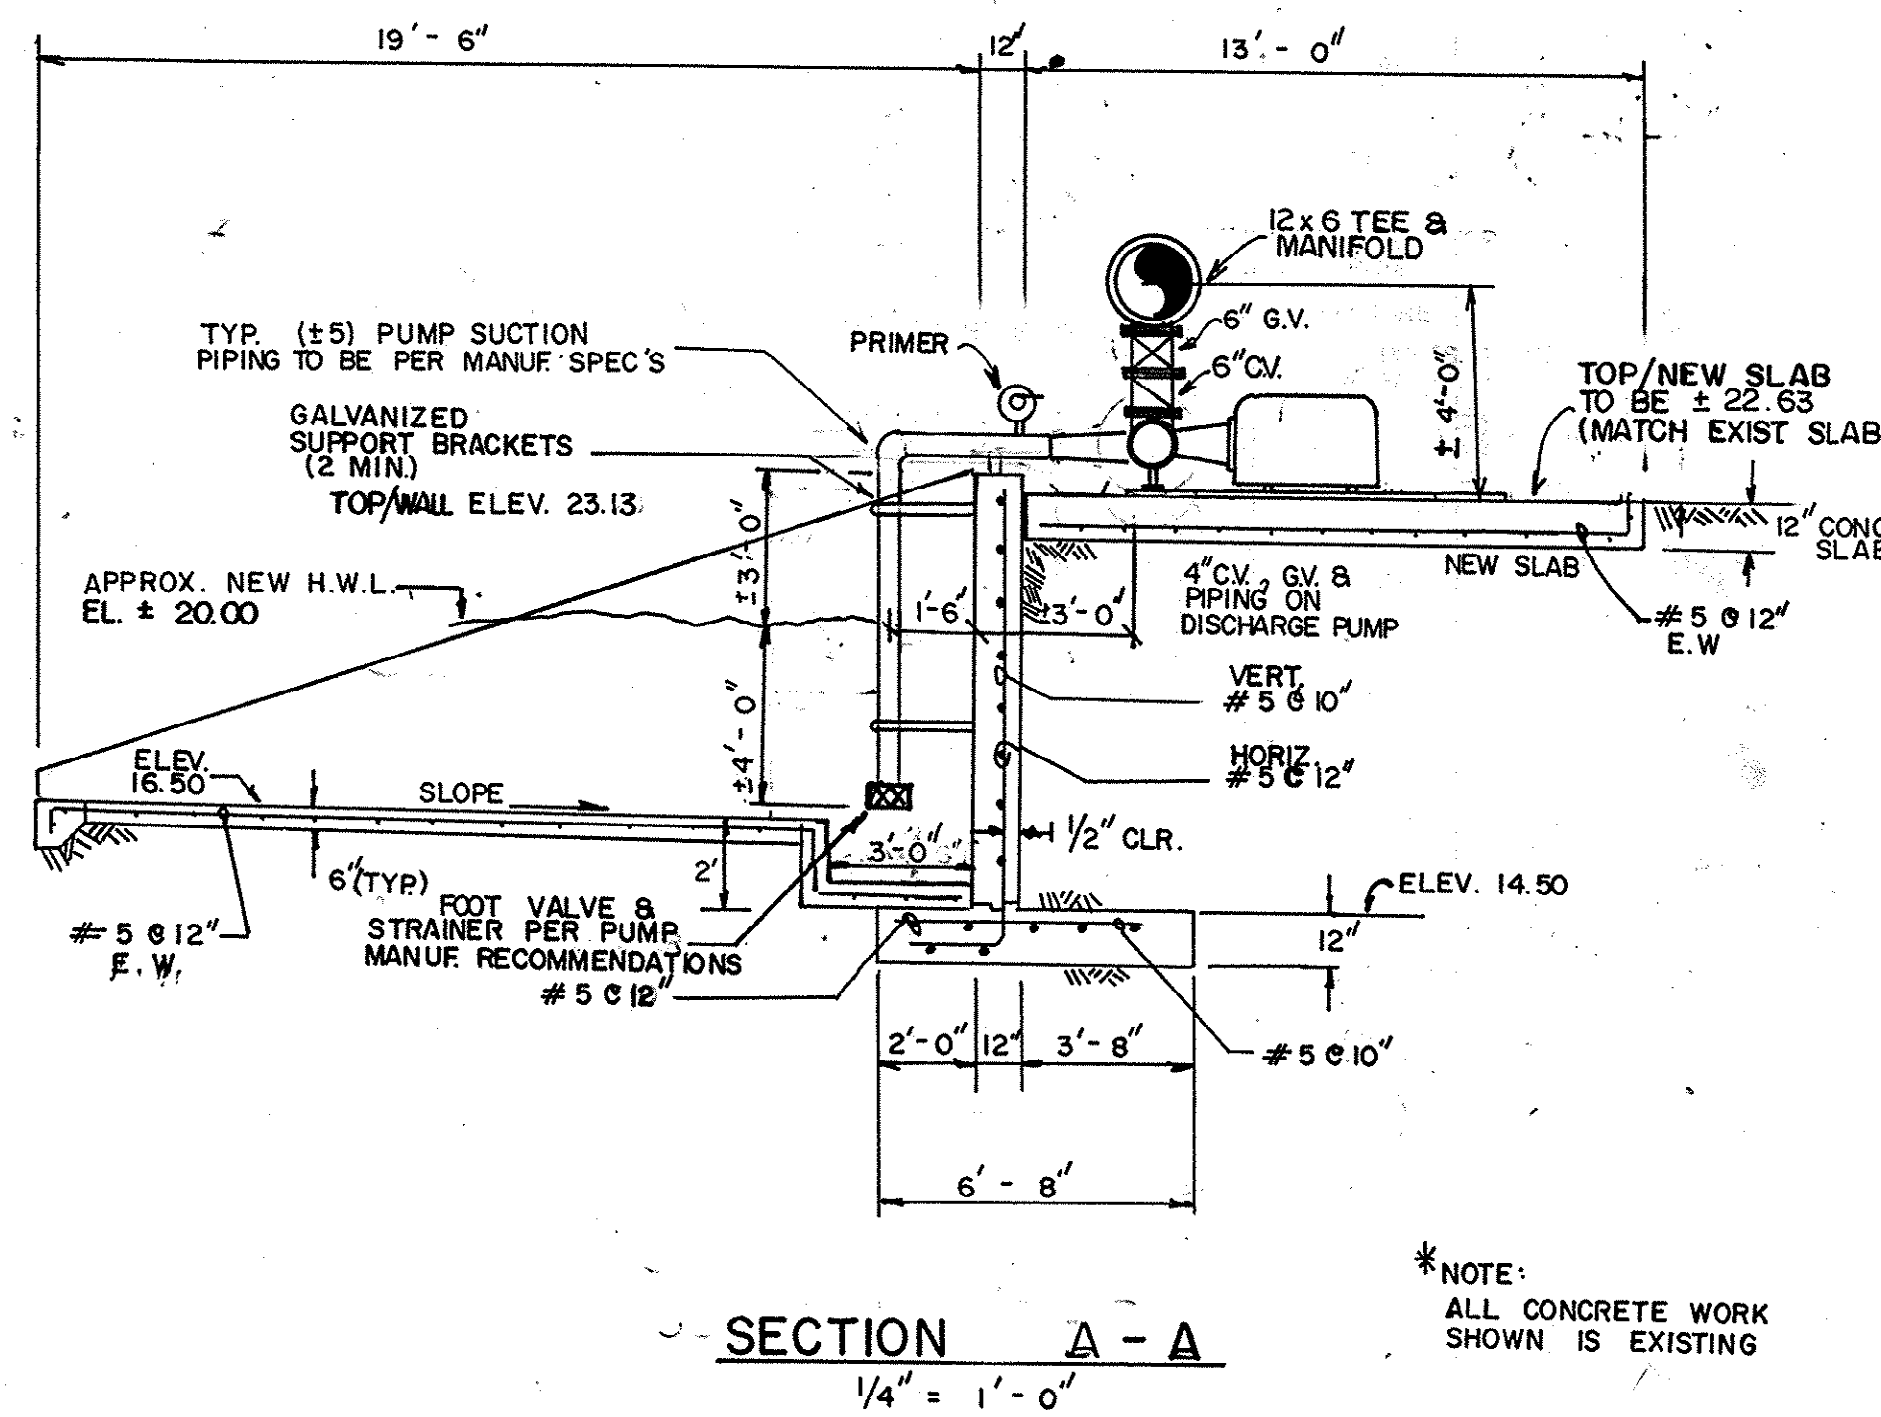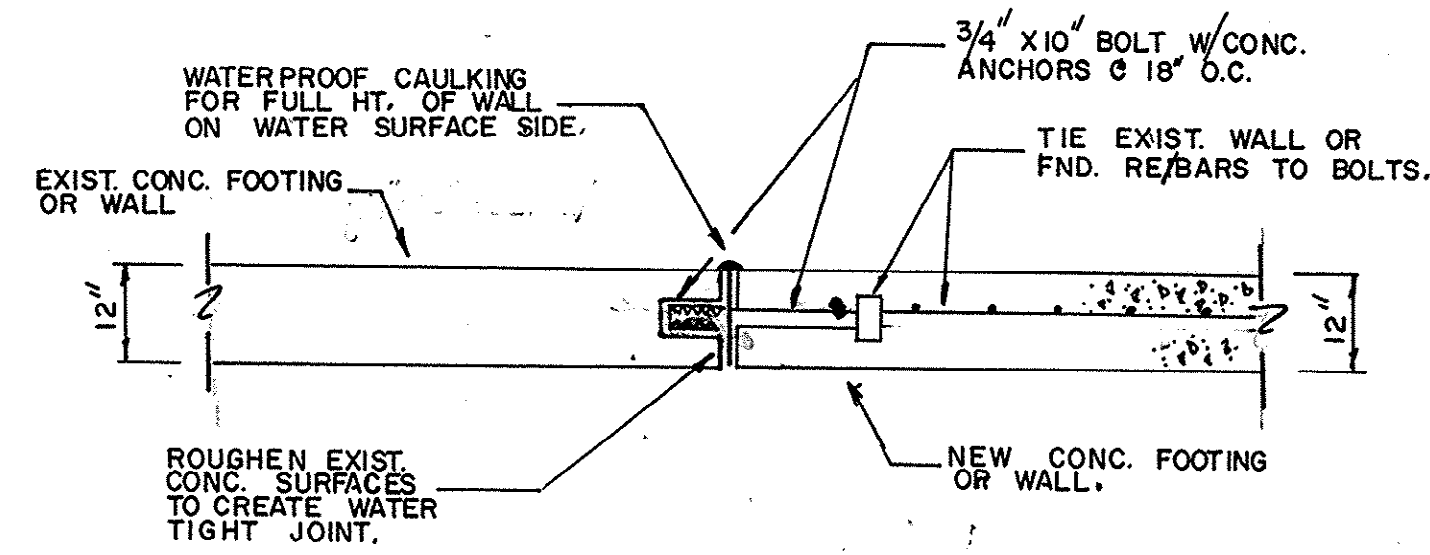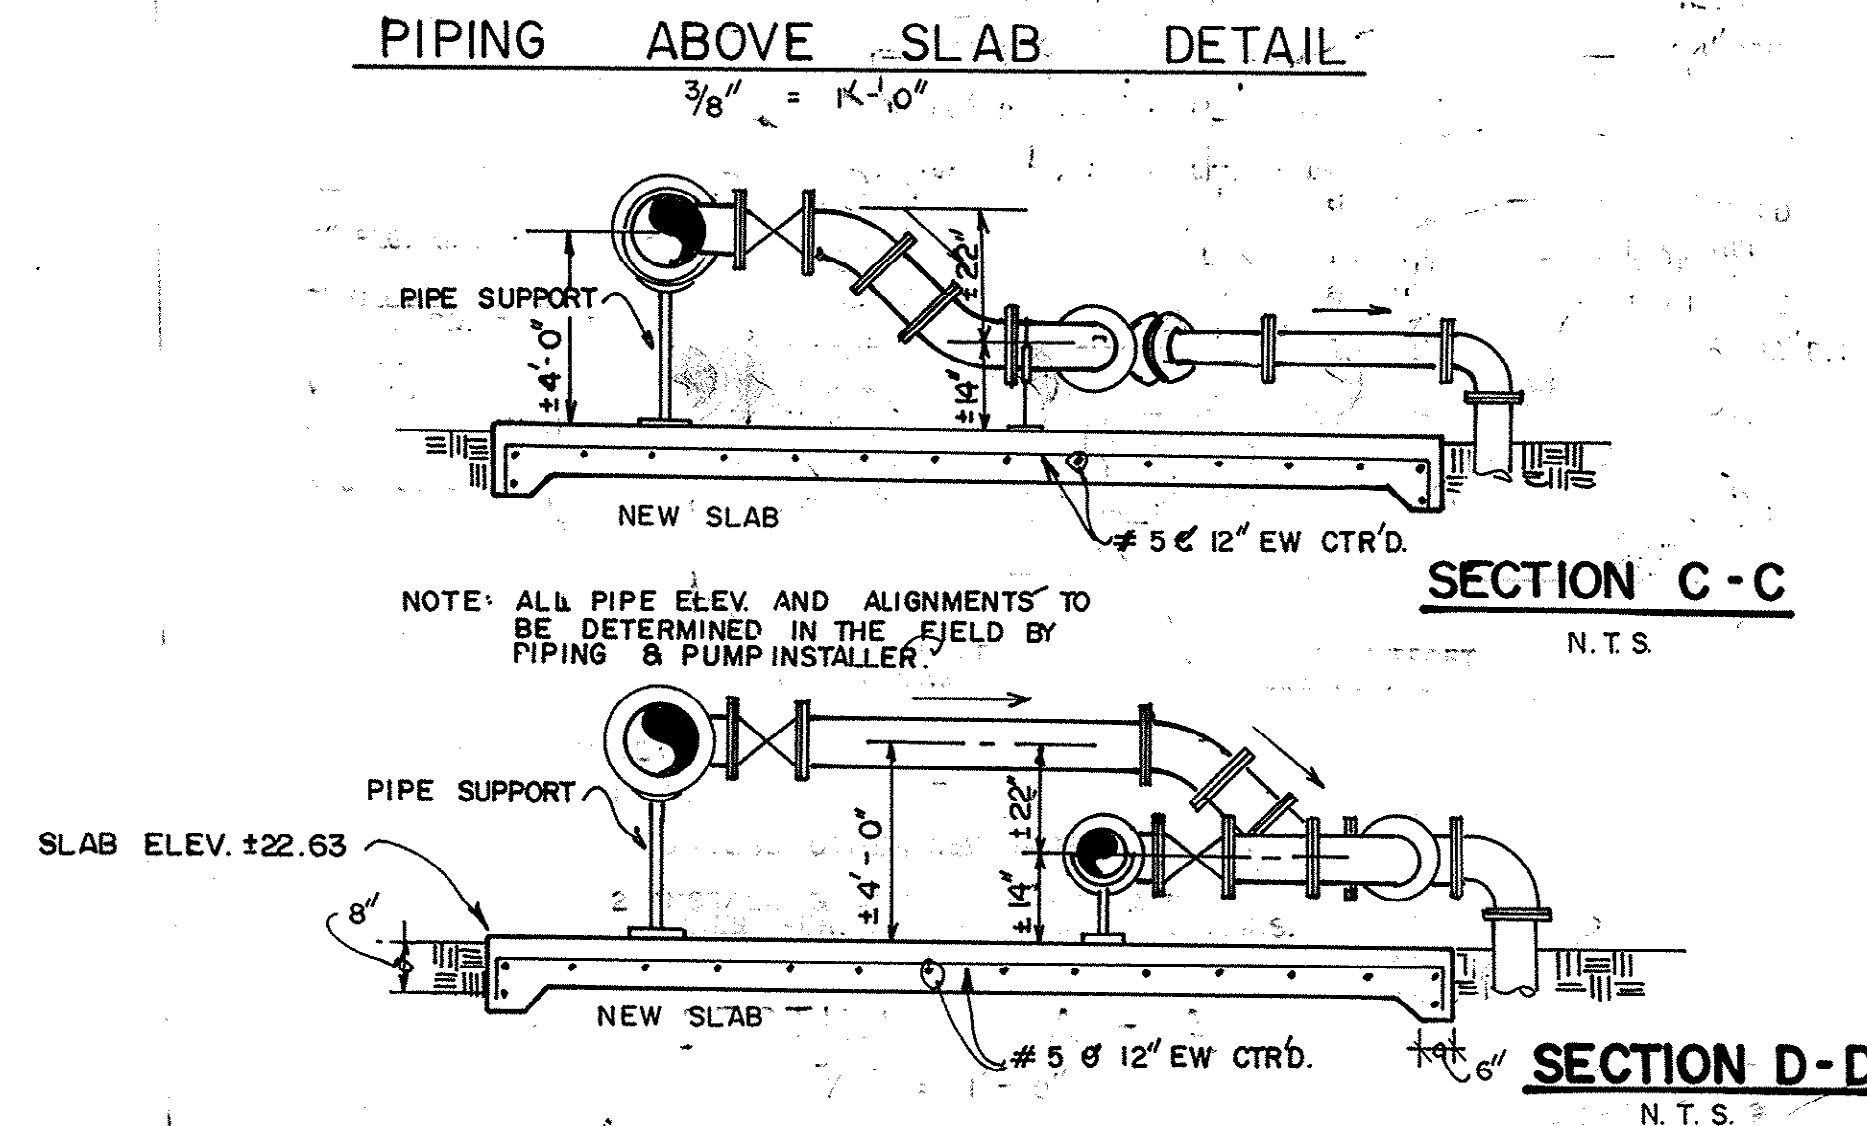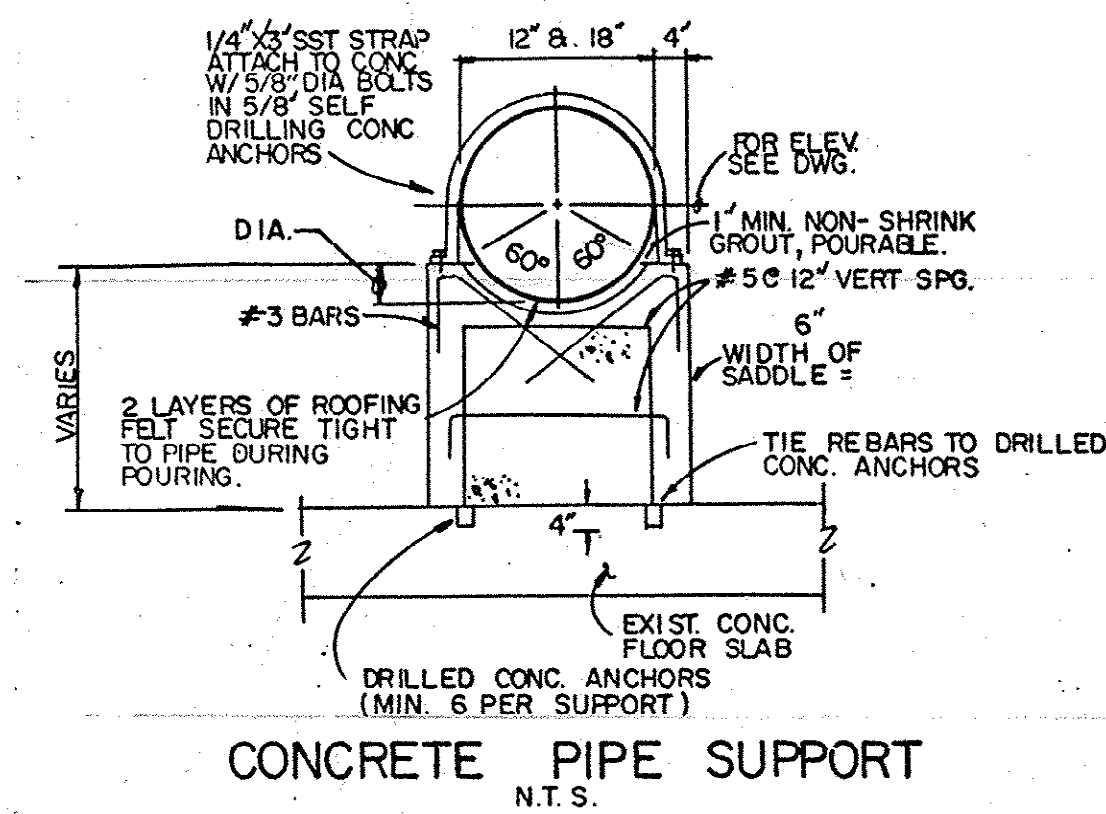

REVISION	BY	DATE

SCHWARTZ W.W.T.P. EFFLUENT DISPOSAL
DETAIL SHEET
GRAND STRAND WATER & SEWER AUTHORITY
P.O. BOX 1537 CONWAY, S.C. 29526
TELEPHONE (803) 347-4641 448-1886

DATE :	JANUARY 1986
SCALE :	AS SHOWN
DRAWN BY	P. JENERETTE
CHECKED BY	J. HEMBREE
APPROVED BY	C. HUCKS
FRED RICHARDSON P.E. No. 9853	
SHEET	6 of 6
DRAWING No.	7-03.005/SS