


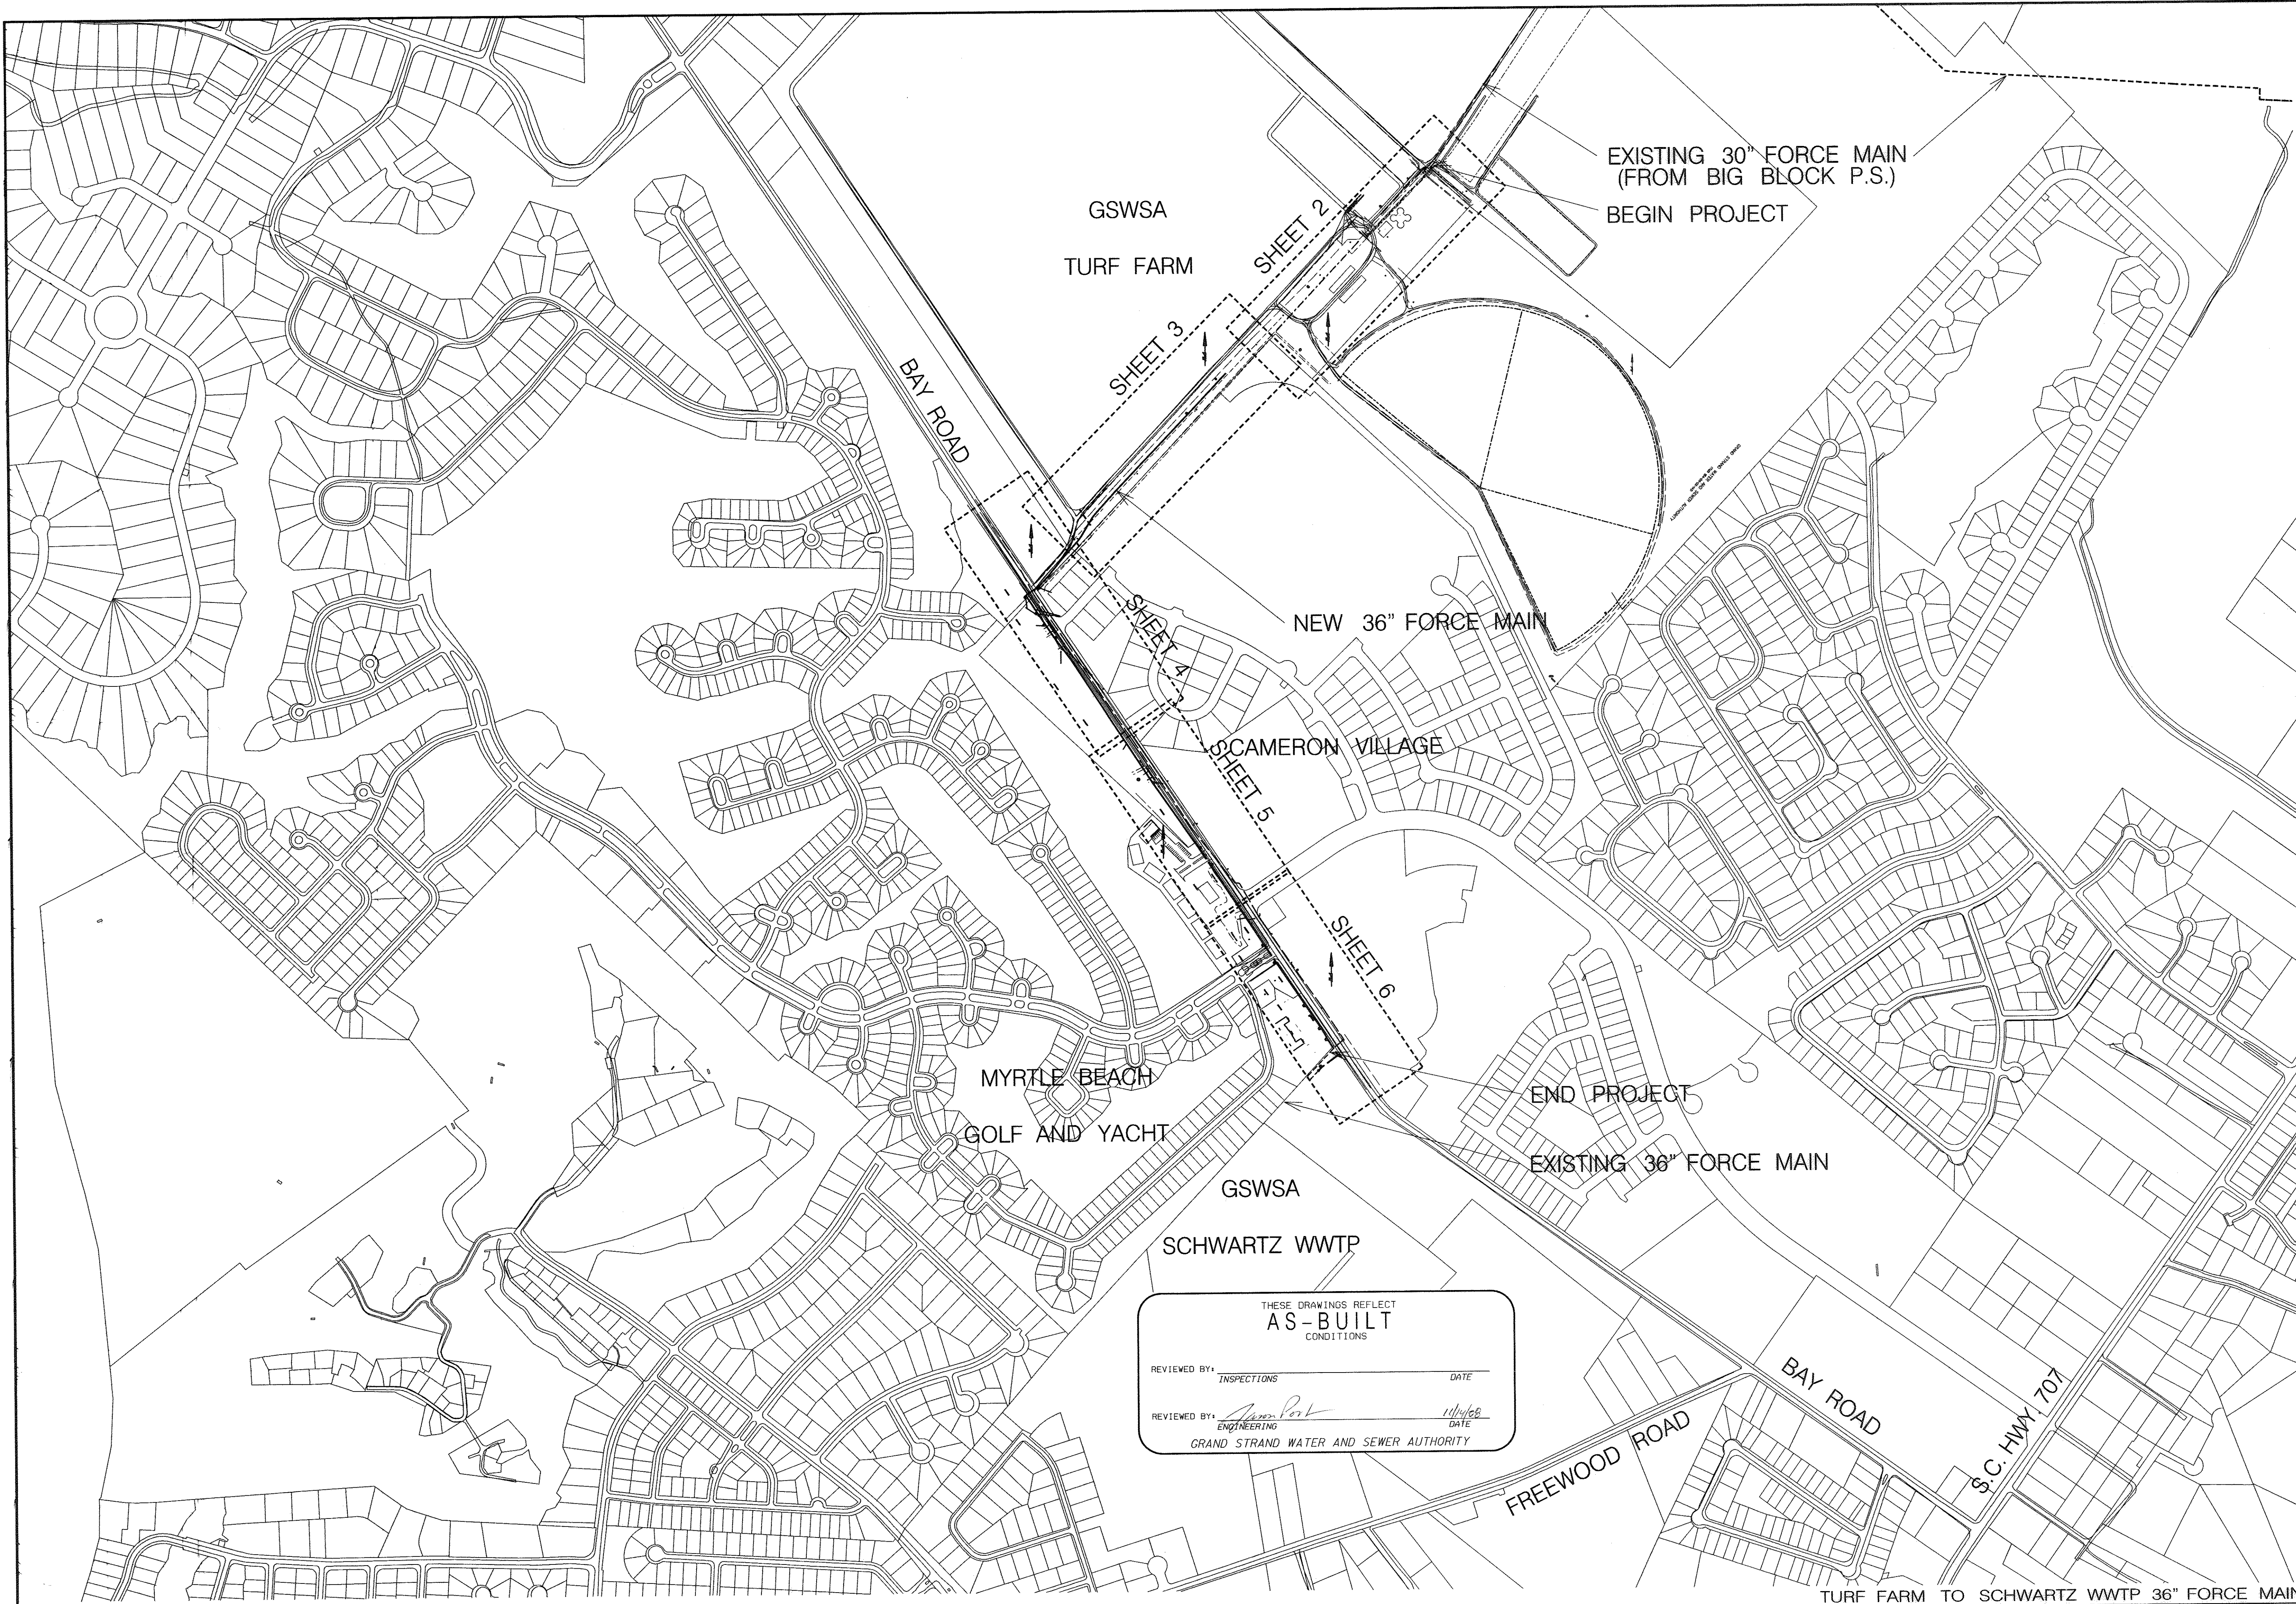

THESE DRAWINGS REFLECT
AS-BUILT
CONDITIONS

REVIEWED BY:	INSPECTIONS	DATE
REVIEWED BY:	<i>[Signature]</i>	11/14/08
	ENGINEERING	DATE
GRAND STRAND WATER AND SEWER AUTHORITY		

REVISION	DATE
BY	NOV 2008
REP	
ASBUILT	

GRAND STRAND
WATER & SEWER
AUTHORITY

170 JACKSON BLUFF RD.
P.O. BOX 33008
CONWAY, SC 29538-0008
(843) 347-4841 OR 448-1686
(843) 347-4850 (FAX)
CONWAY, SOUTH CAROLINA


**TURF FARM TO
SCHWARTZ WWTP
36" FORCE MAIN**

PROJ. #08-883-01


DATE: JUNE 2006
SCALE: 1" = 1500 FEET
FILENAME: LOCATION_MAP

DRAWN BY:	ROBERT PERKINS
CHECKED BY:	CHRISTINA EVERETT
APPROVED BY:	
CHRISTINA S. EVERETT	PE #21255

SHEET 1 OF 6
DWG # 07-020-0016-S

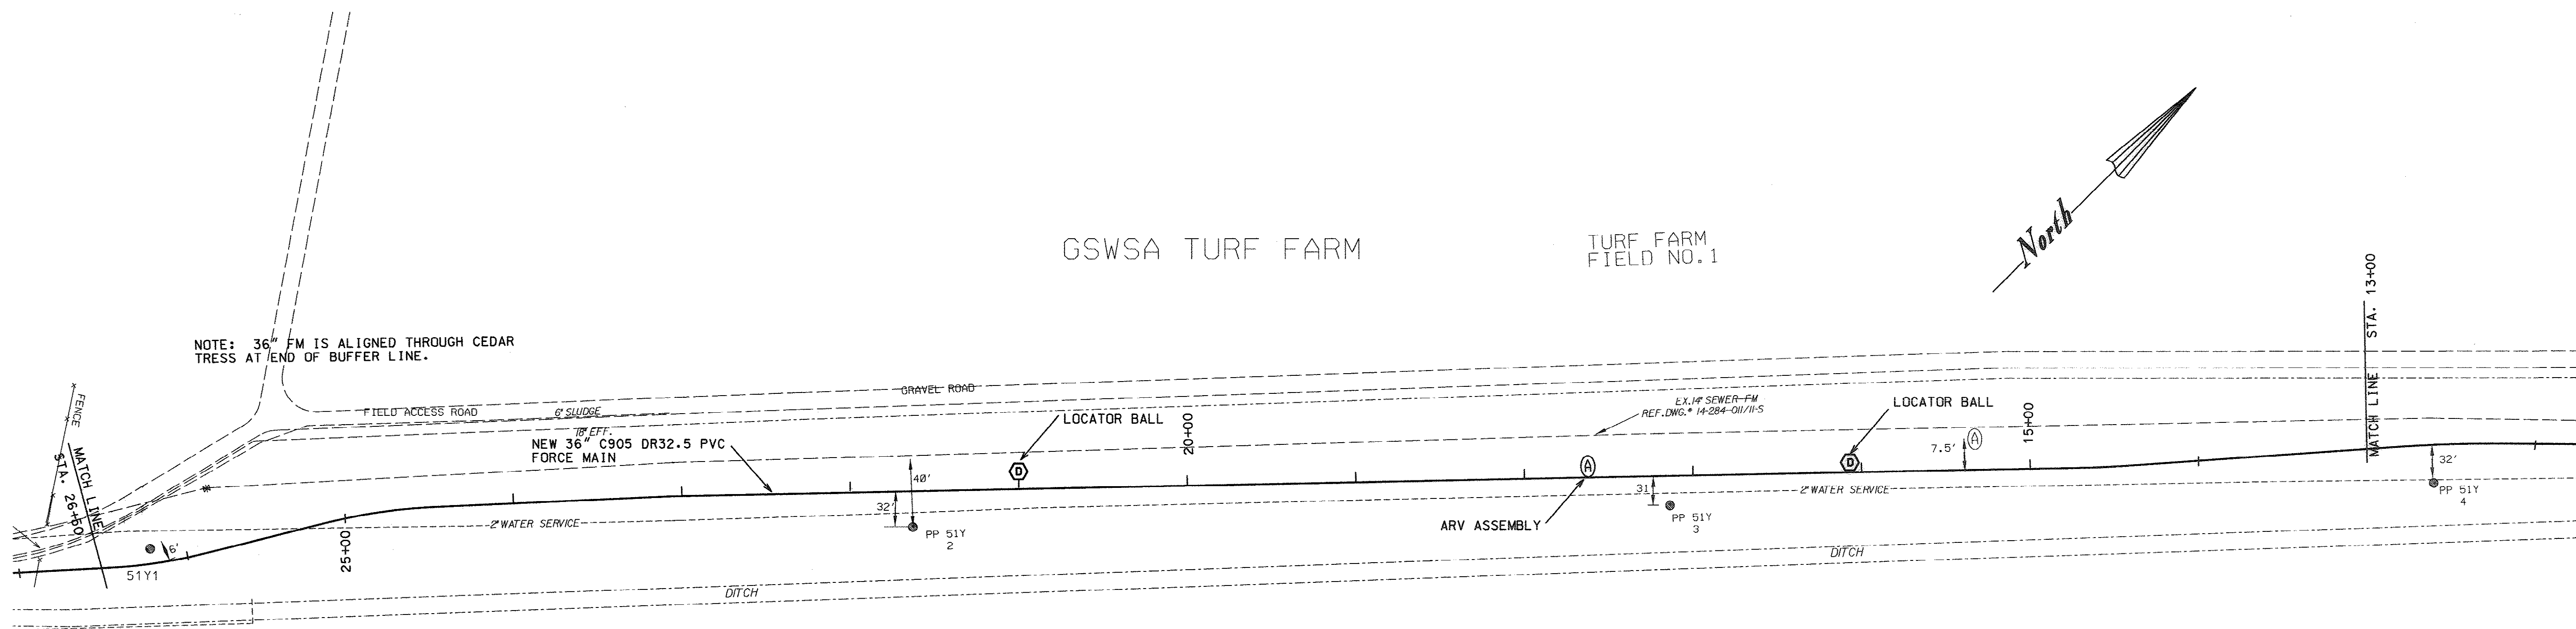

CAMERON VILLAGE

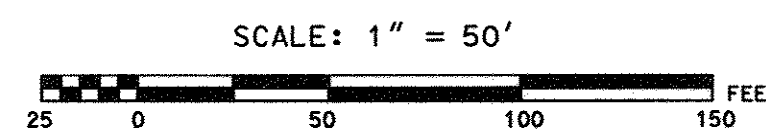


THESE DRAWINGS REFLECT
AS-BUILT
CONDITIONS

REVIEWED BY: _____ DATE: _____
INSPECTIONS

REVIEWED BY: _____ DATE: 11/14/08
ENGINEERING


GRAND STRAND WATER AND SEWER AUTHORITY

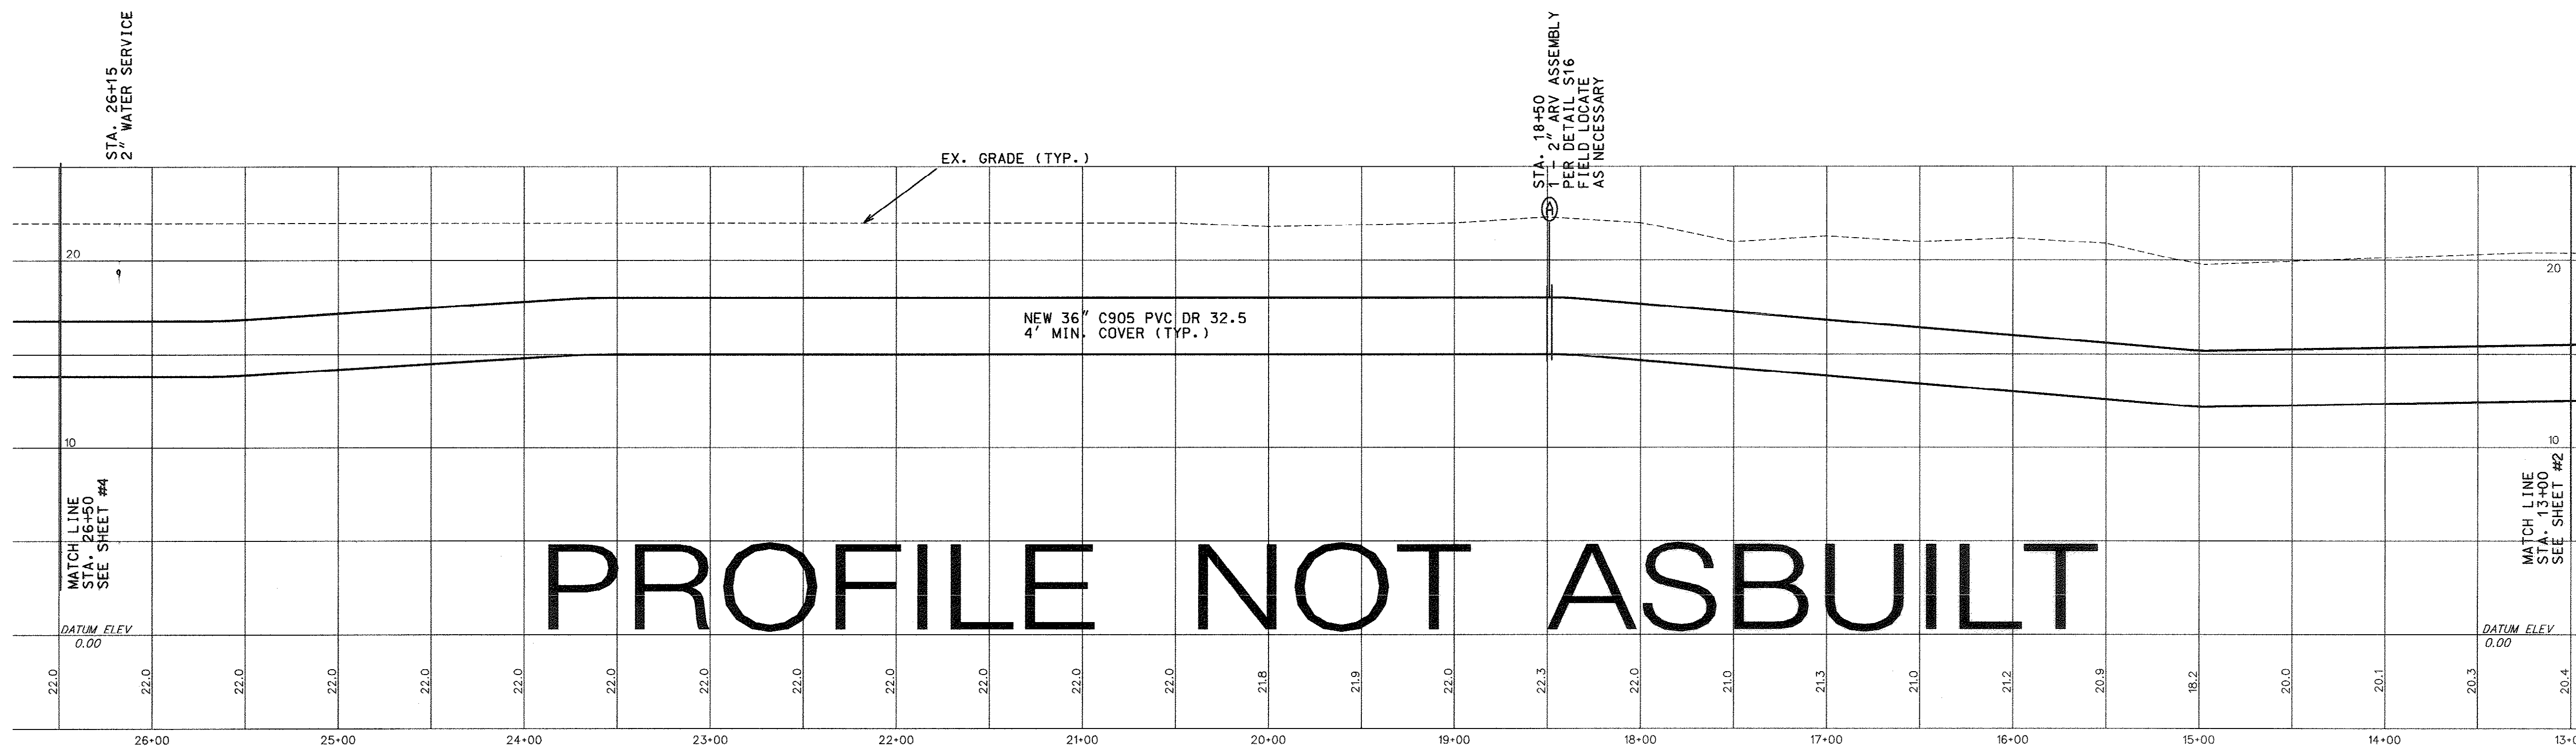

PROFILE SCALE: 1" = 50 FEET (HORIZONTAL)
1" = 5 FEET (VERTICAL)

TURF FARM TO SCHWARTZ WWTP 36" FORCE MAIN

REVISION	BY	DATE
ROUTE CHANGE	REP	OCT 2006
ALIGNMENT CHANGE	REP	NOV 2007
ASBUILT	REP	NOV 2008

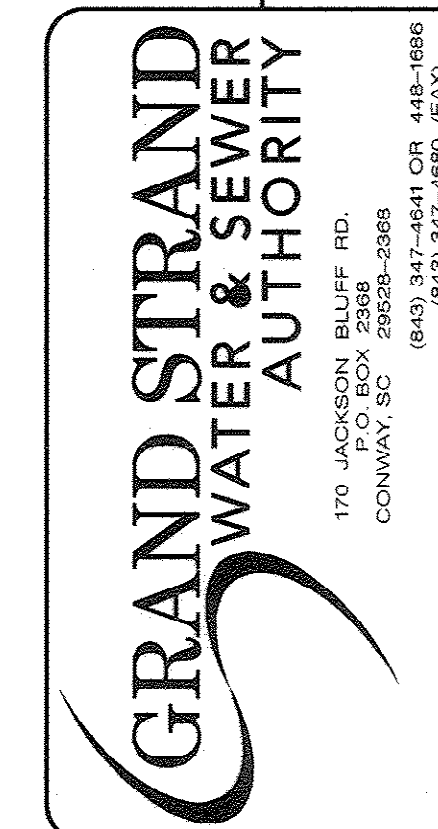

TURF FARM TO SCHWARTZ WWTP
36" FORCE MAIN

PROJ. # 883-01






DATE: JUNE 2006
SCALE: 1" = 50 FEET
FILENAME: TPI-SCHWARTZWWTP(2)

DRAWN BY: _____
ROBERT E. PETERSON

CHECKED BY: _____
JASON POSTON

APPROVED BY: _____
CHRISTINA S. EVERETT PE #21255

SHEET 3 OF 6
DWG # 07-020-0036-S

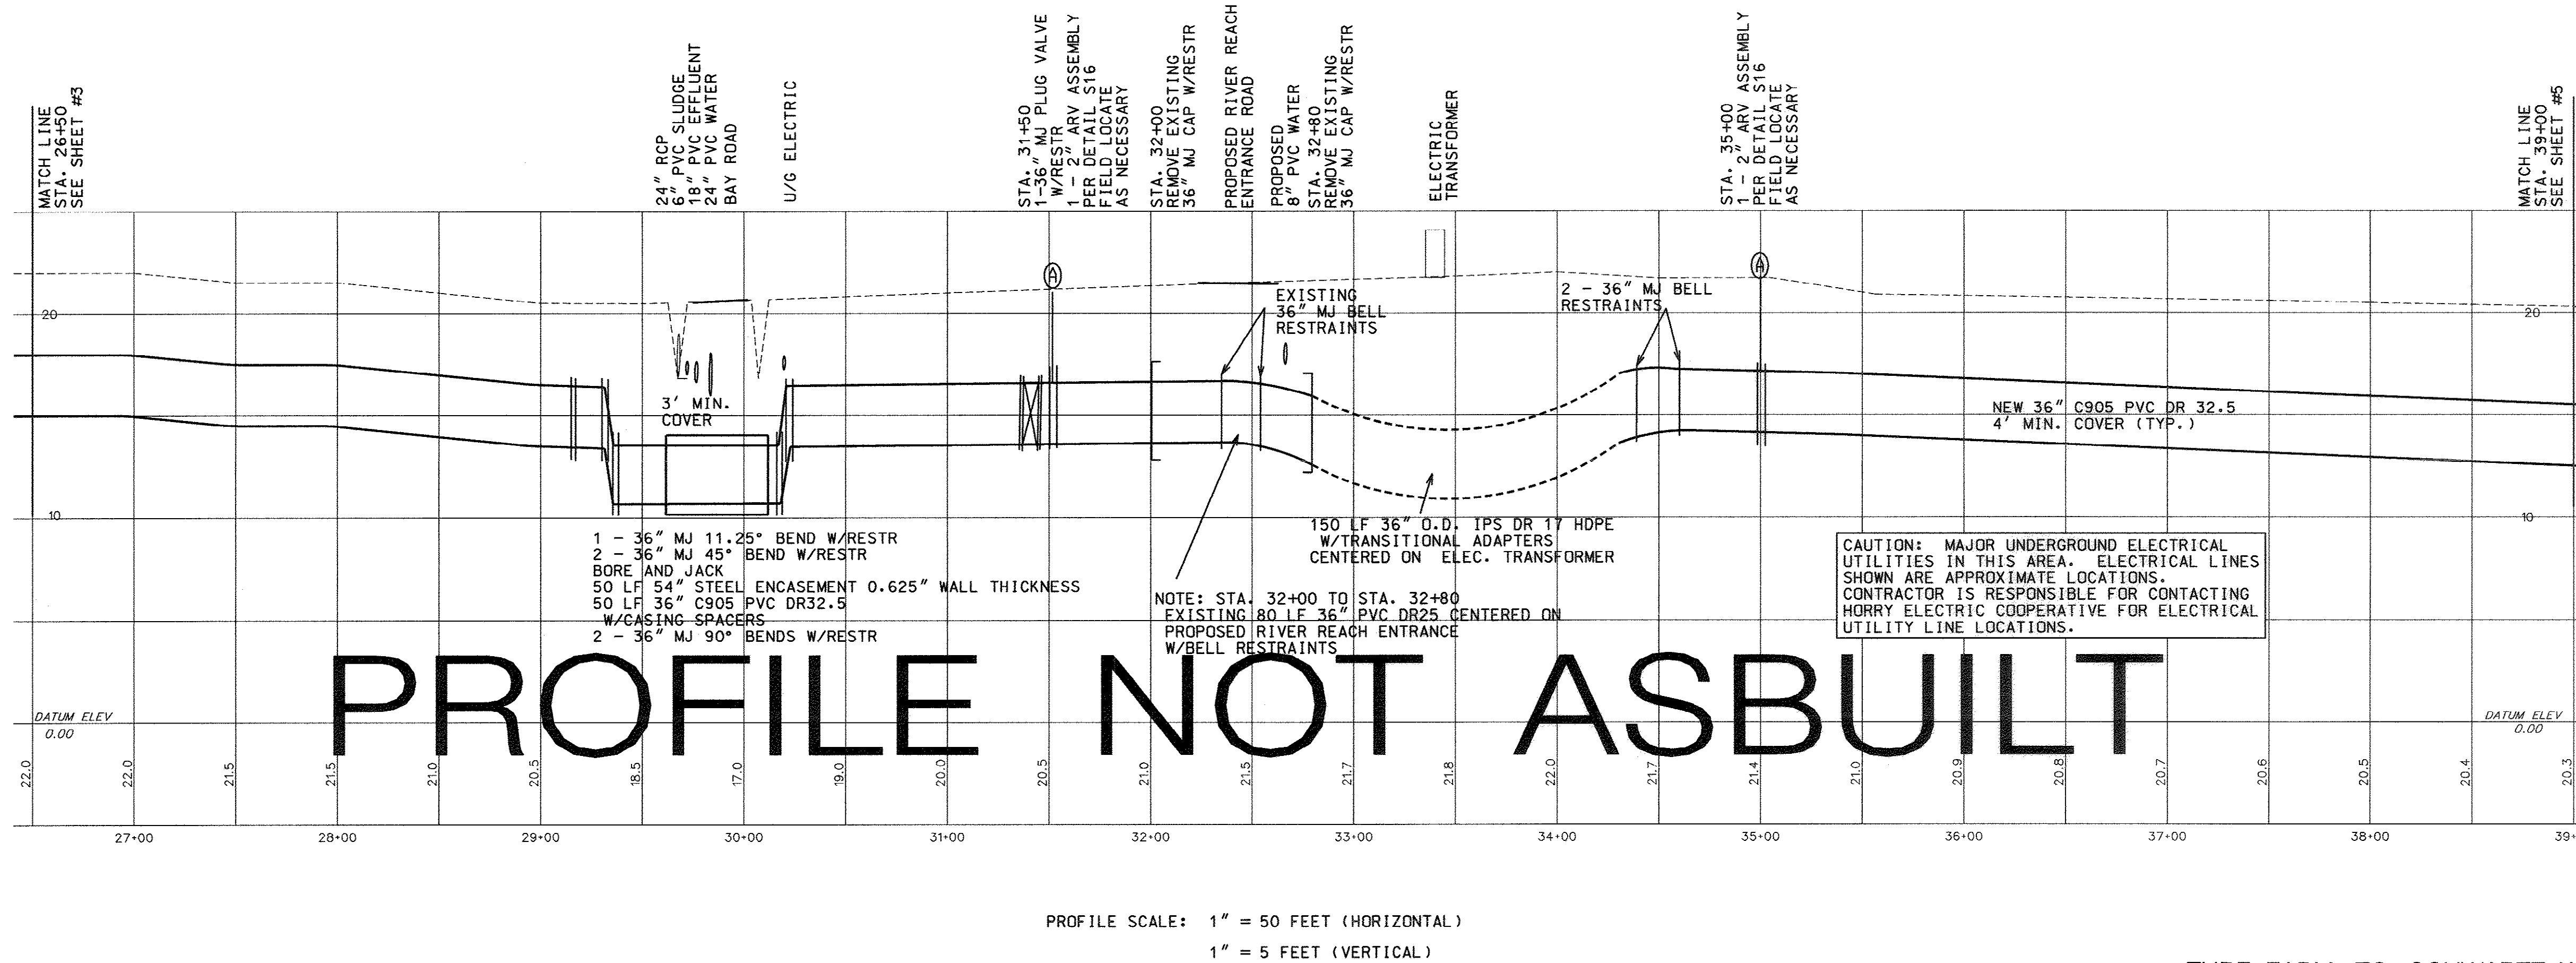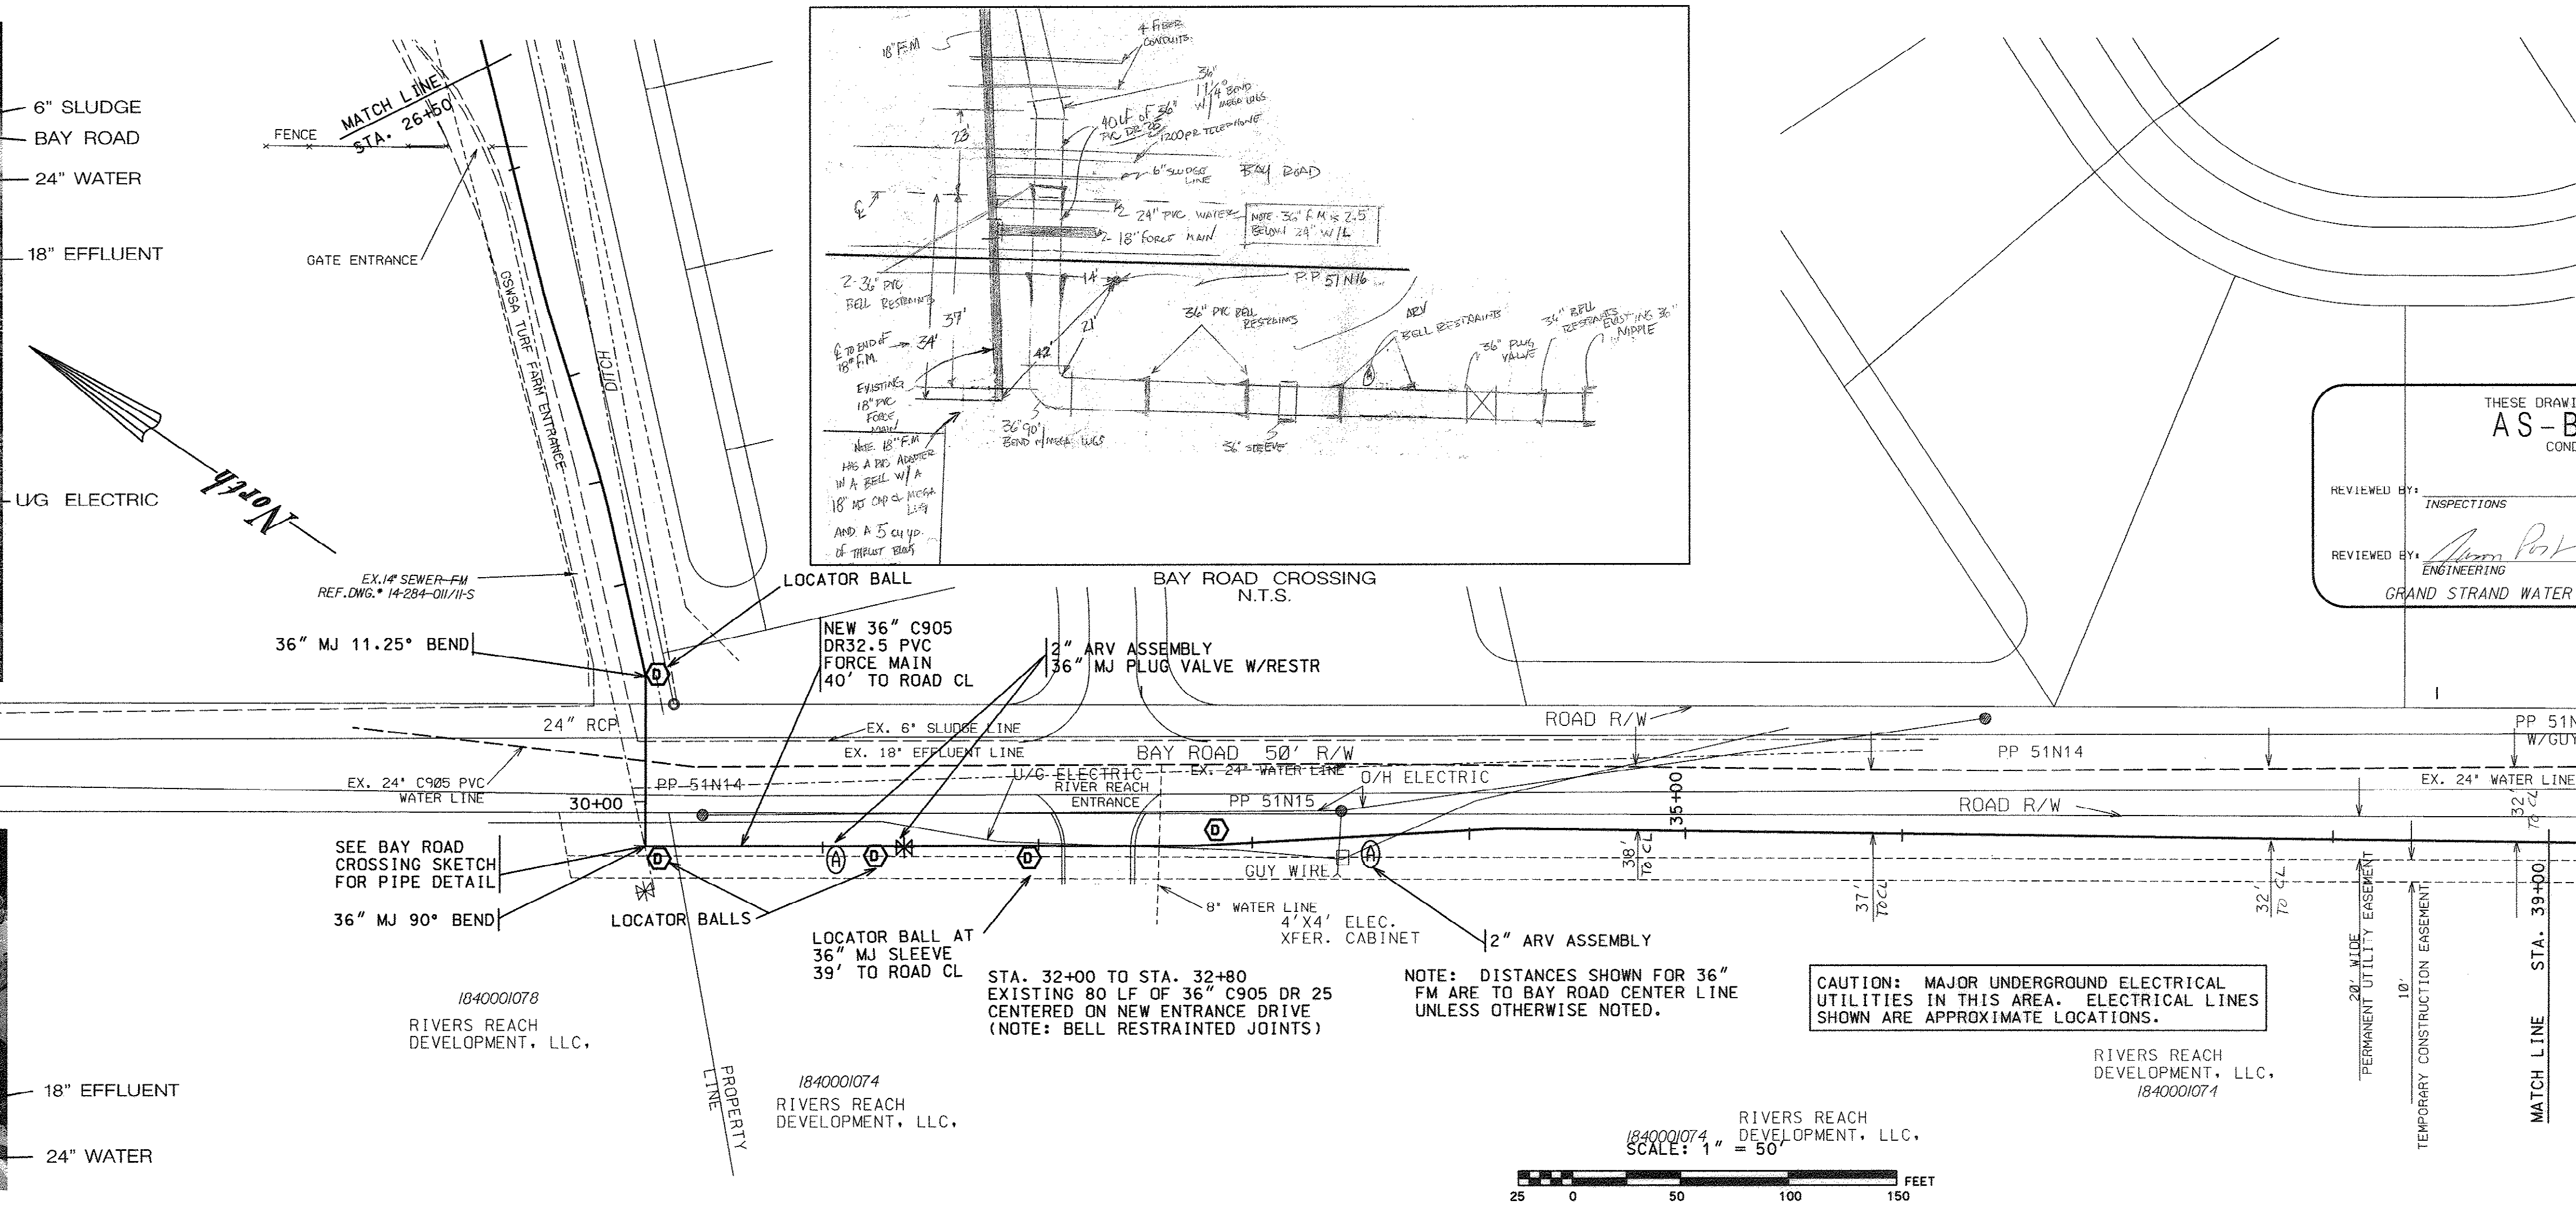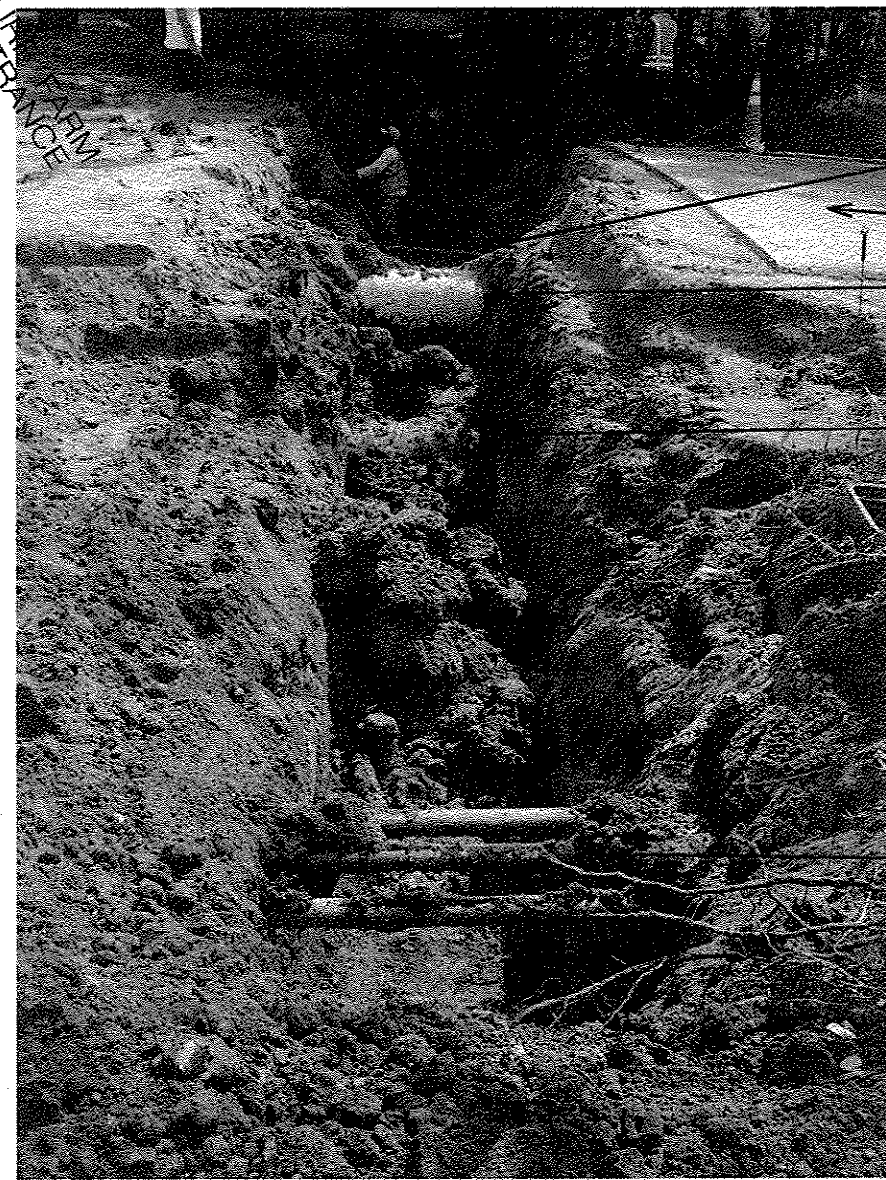

REVISION	DATE
PROPOSED EXISTENT ADJUSTMENT	09/22/06
ROUTE CHANGE	09/22/06
ROUTE CHANGE	NOV 2007
EARLY INSTALLATIONS AT RIVER REACH ENTRANCES	JAN 2008
STEEL ENCASUREMENT SIZE INCREASE	JAN 2008
ASBUILT	NOV 2008

GRAND STRAND WATER & SEWER AUTHORITY

170 JACKSON BLUFF RD.
CONWAY, SC 29526-2806
(843) 347-4641 OR 448-1646
FAX: (843) 347-4641

TURF FARM TO SCHWARTZ WWTP 36" FORCE MAIN


PROJ. # 883-01

PROFESSIONAL ENGINEER
No. 21255

DATE: JUNE 2006
SCALE: 1" = 50 FEET
FILENAME: TPI_SCHWARTZWWTPI2

DRAWN BY: ROBERT E. PERKINS
CHECKED BY: JASON POSTON
APPROVED BY:

CHRISTINA S. EVERETT PE #21255
SHEET 4 OF 6
DWG # 07-020-0046-S



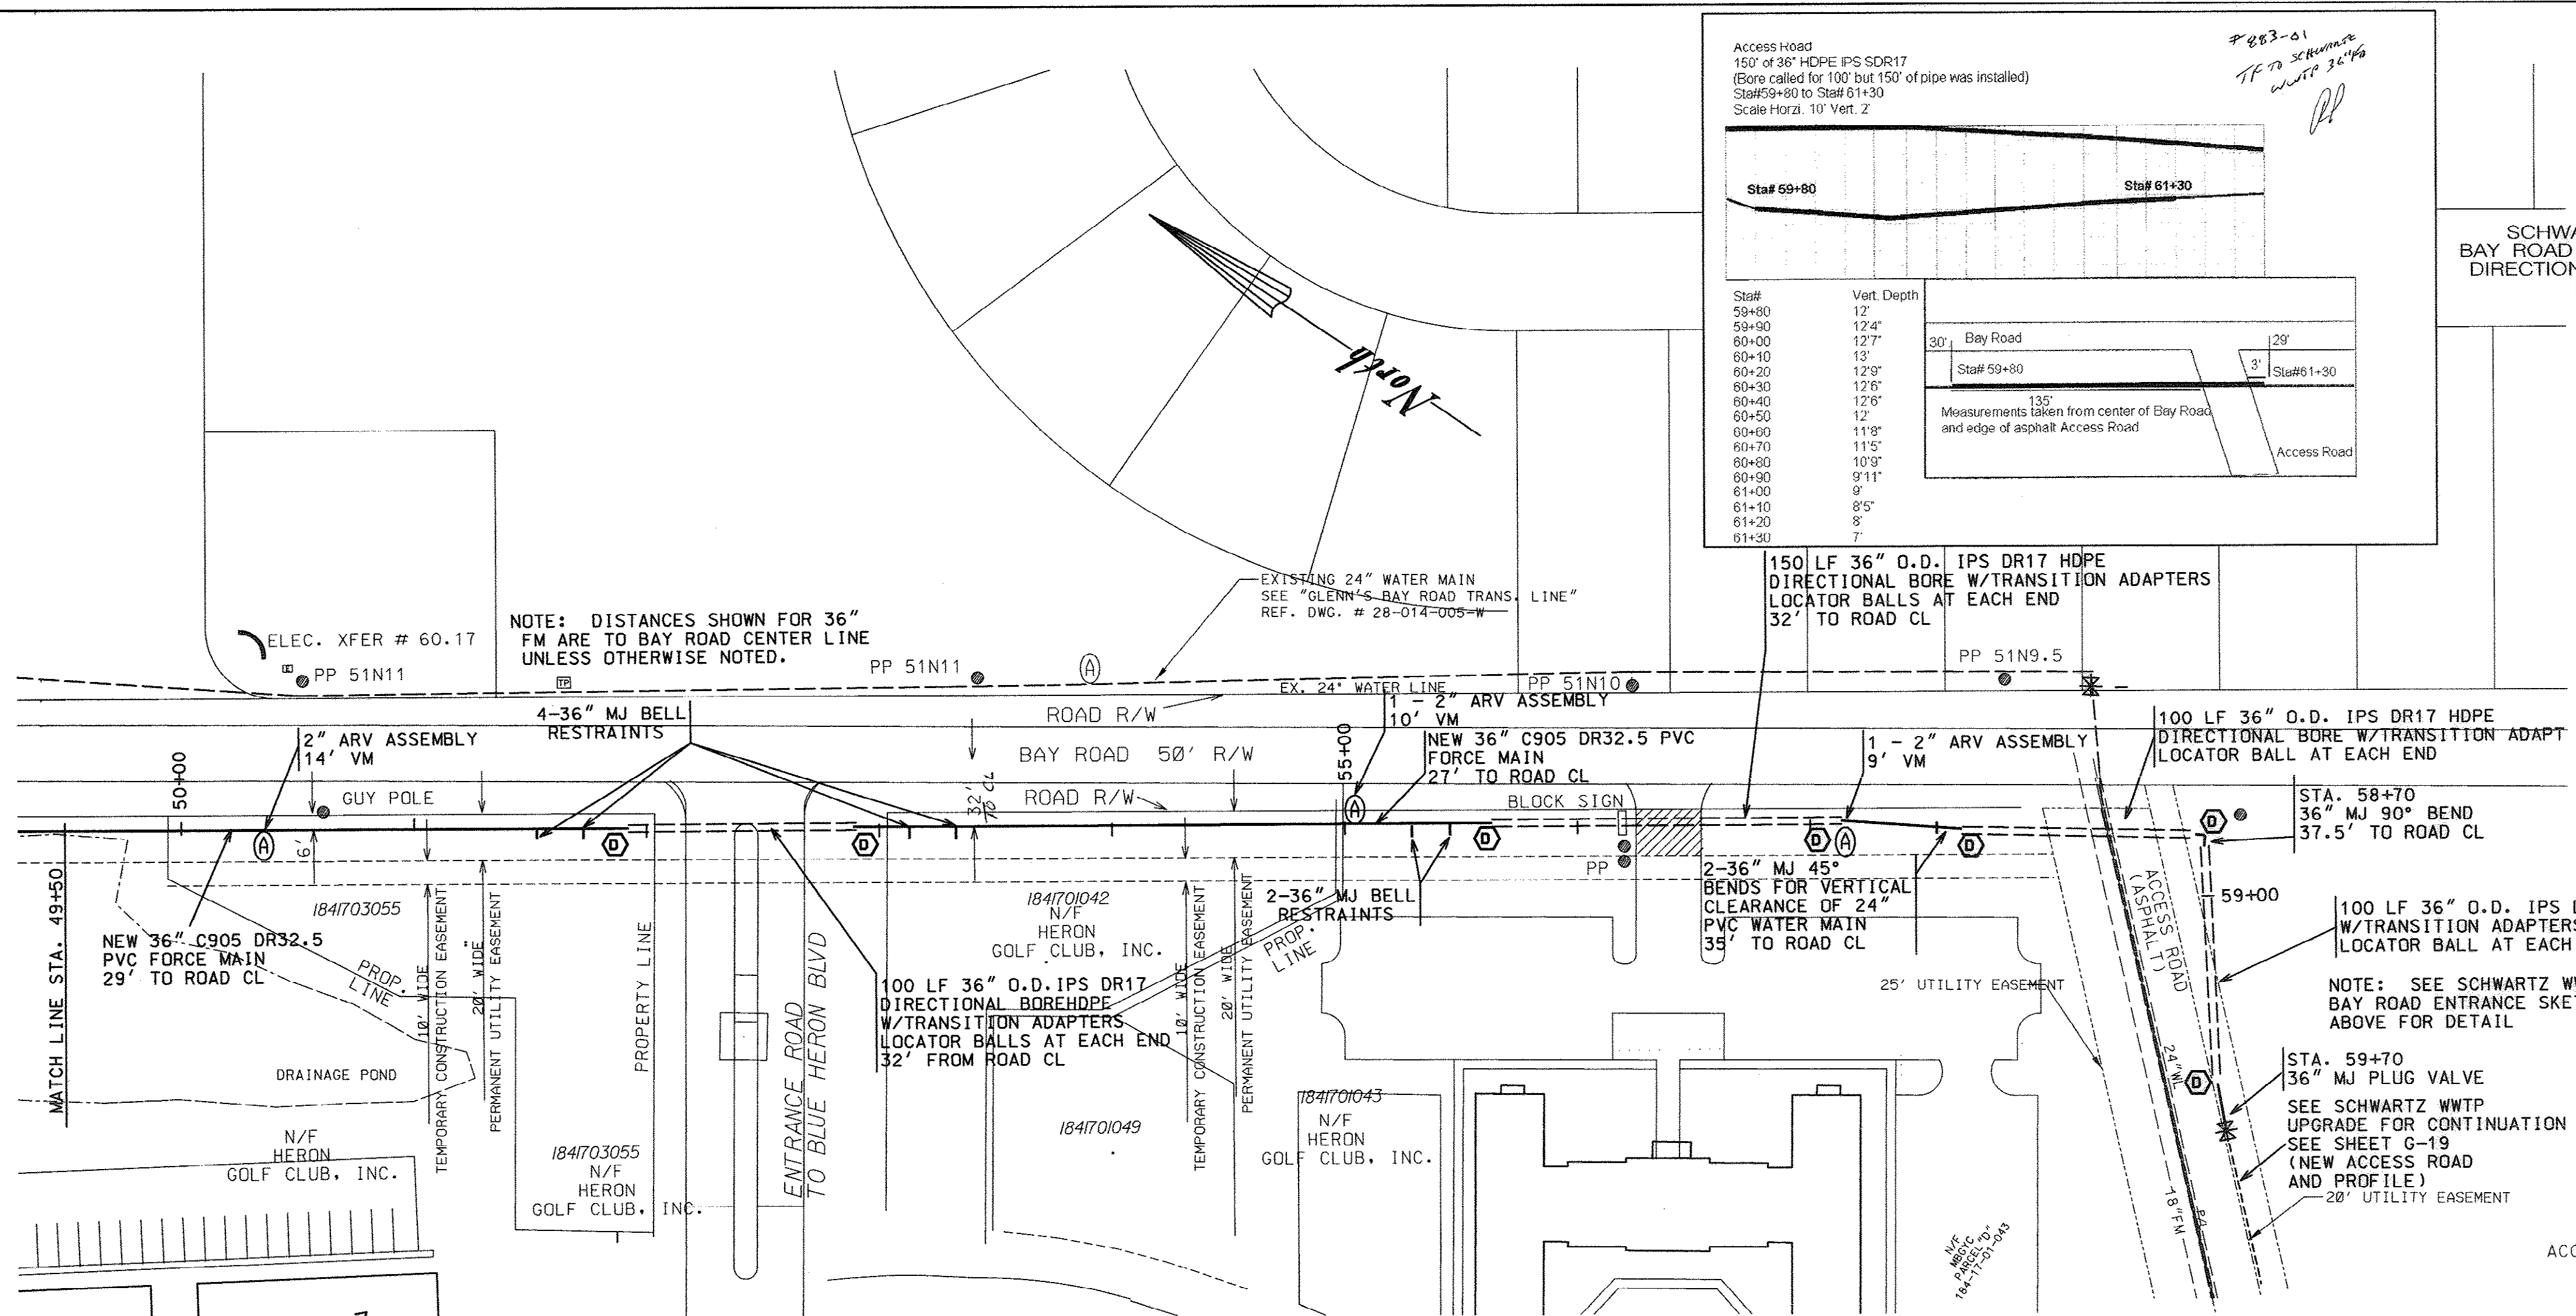


THESE DRAWINGS REFLECT
AS-BUILT
CONDITIONS


REVIEWED BY: _____ DATE: _____
INSPECTIONS

REVIEWED BY: *Jason Poston* DATE: *11/14/10*
ENGINEERING


GRAND STRAND WATER AND SEWER AUTHORITY

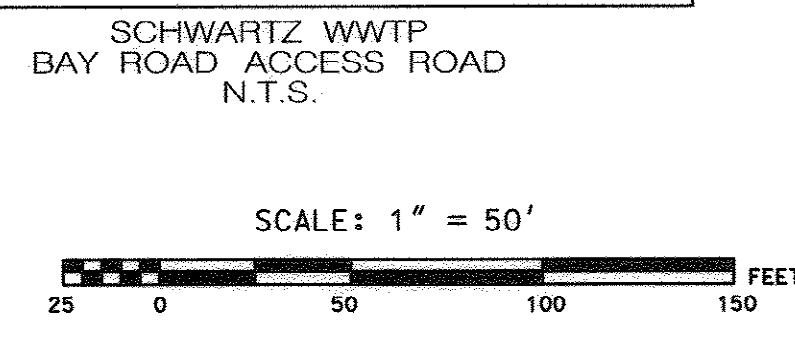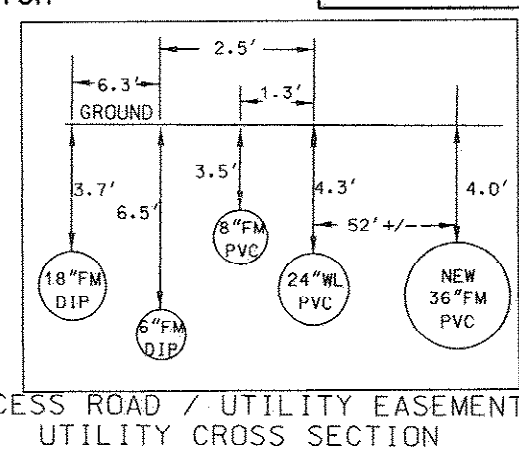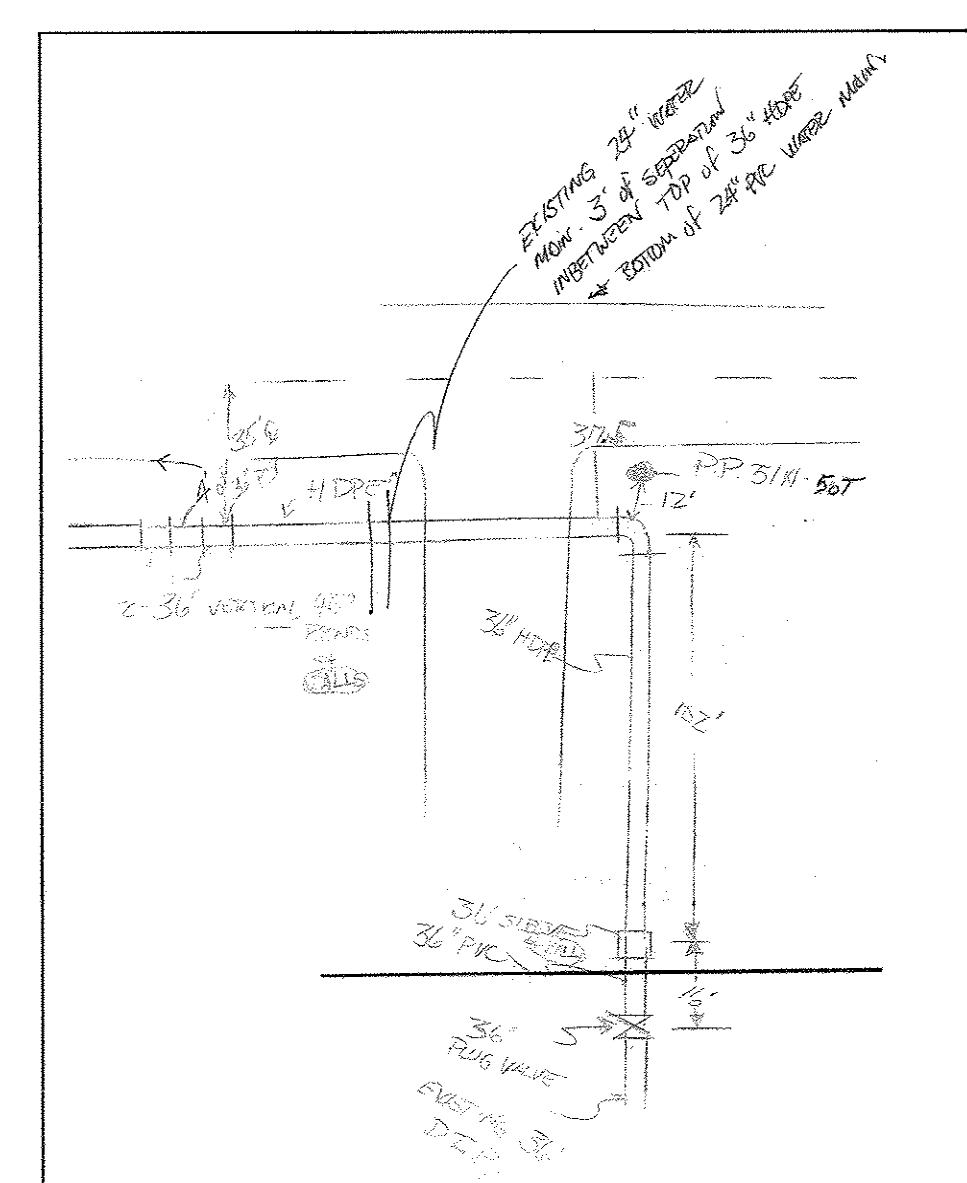

DATE	BY	REVISION
9/2/2006	REP	REDESIGNED WITHIN ACCESS ROAD
10/2/2006	REP	PROPOSED EASEMENT ADJUSTMENT
10/2/2006	REP	ROUTE CHANGE
NOV 2007	REP	ROUTE CHANGE
NOV 2008	REP	AS-BUILT

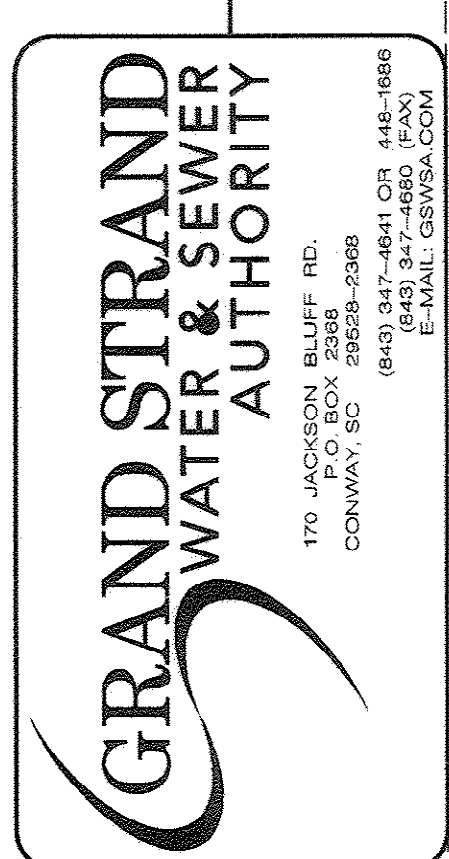



TURF FARM TO SCHWARTZ WWTP
36" FORCE MAIN
PROJ. # 883-01

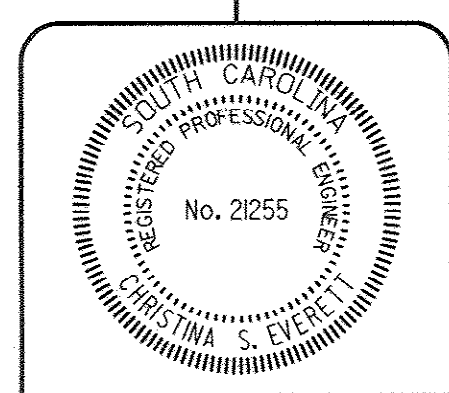

DATE: JUNE 2006
SCALE: 1" = 50 FEET
FILENAME: TPL SCHWARTZWWTP102

DRAWN BY: ROBERT E. PERKINS
CHECKED BY: JASON POSTON
APPROVED BY: _____

CHRISTINA S. EVERETT PE #21255
SHEET 6 OF 6
DWG # 07-020-0066-S

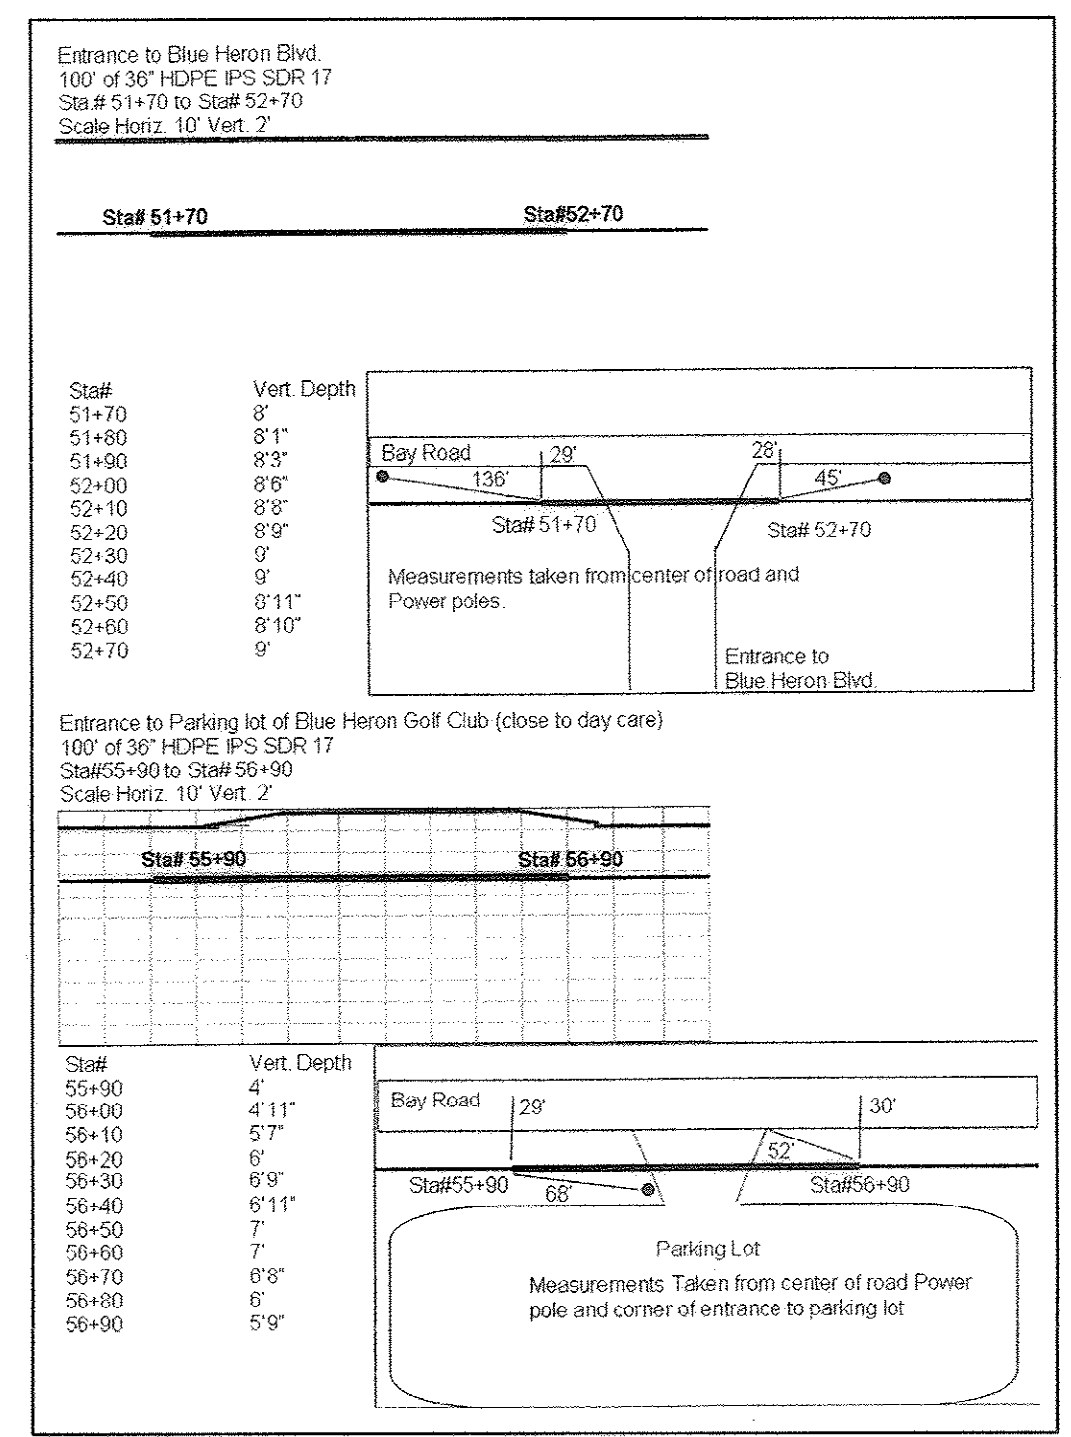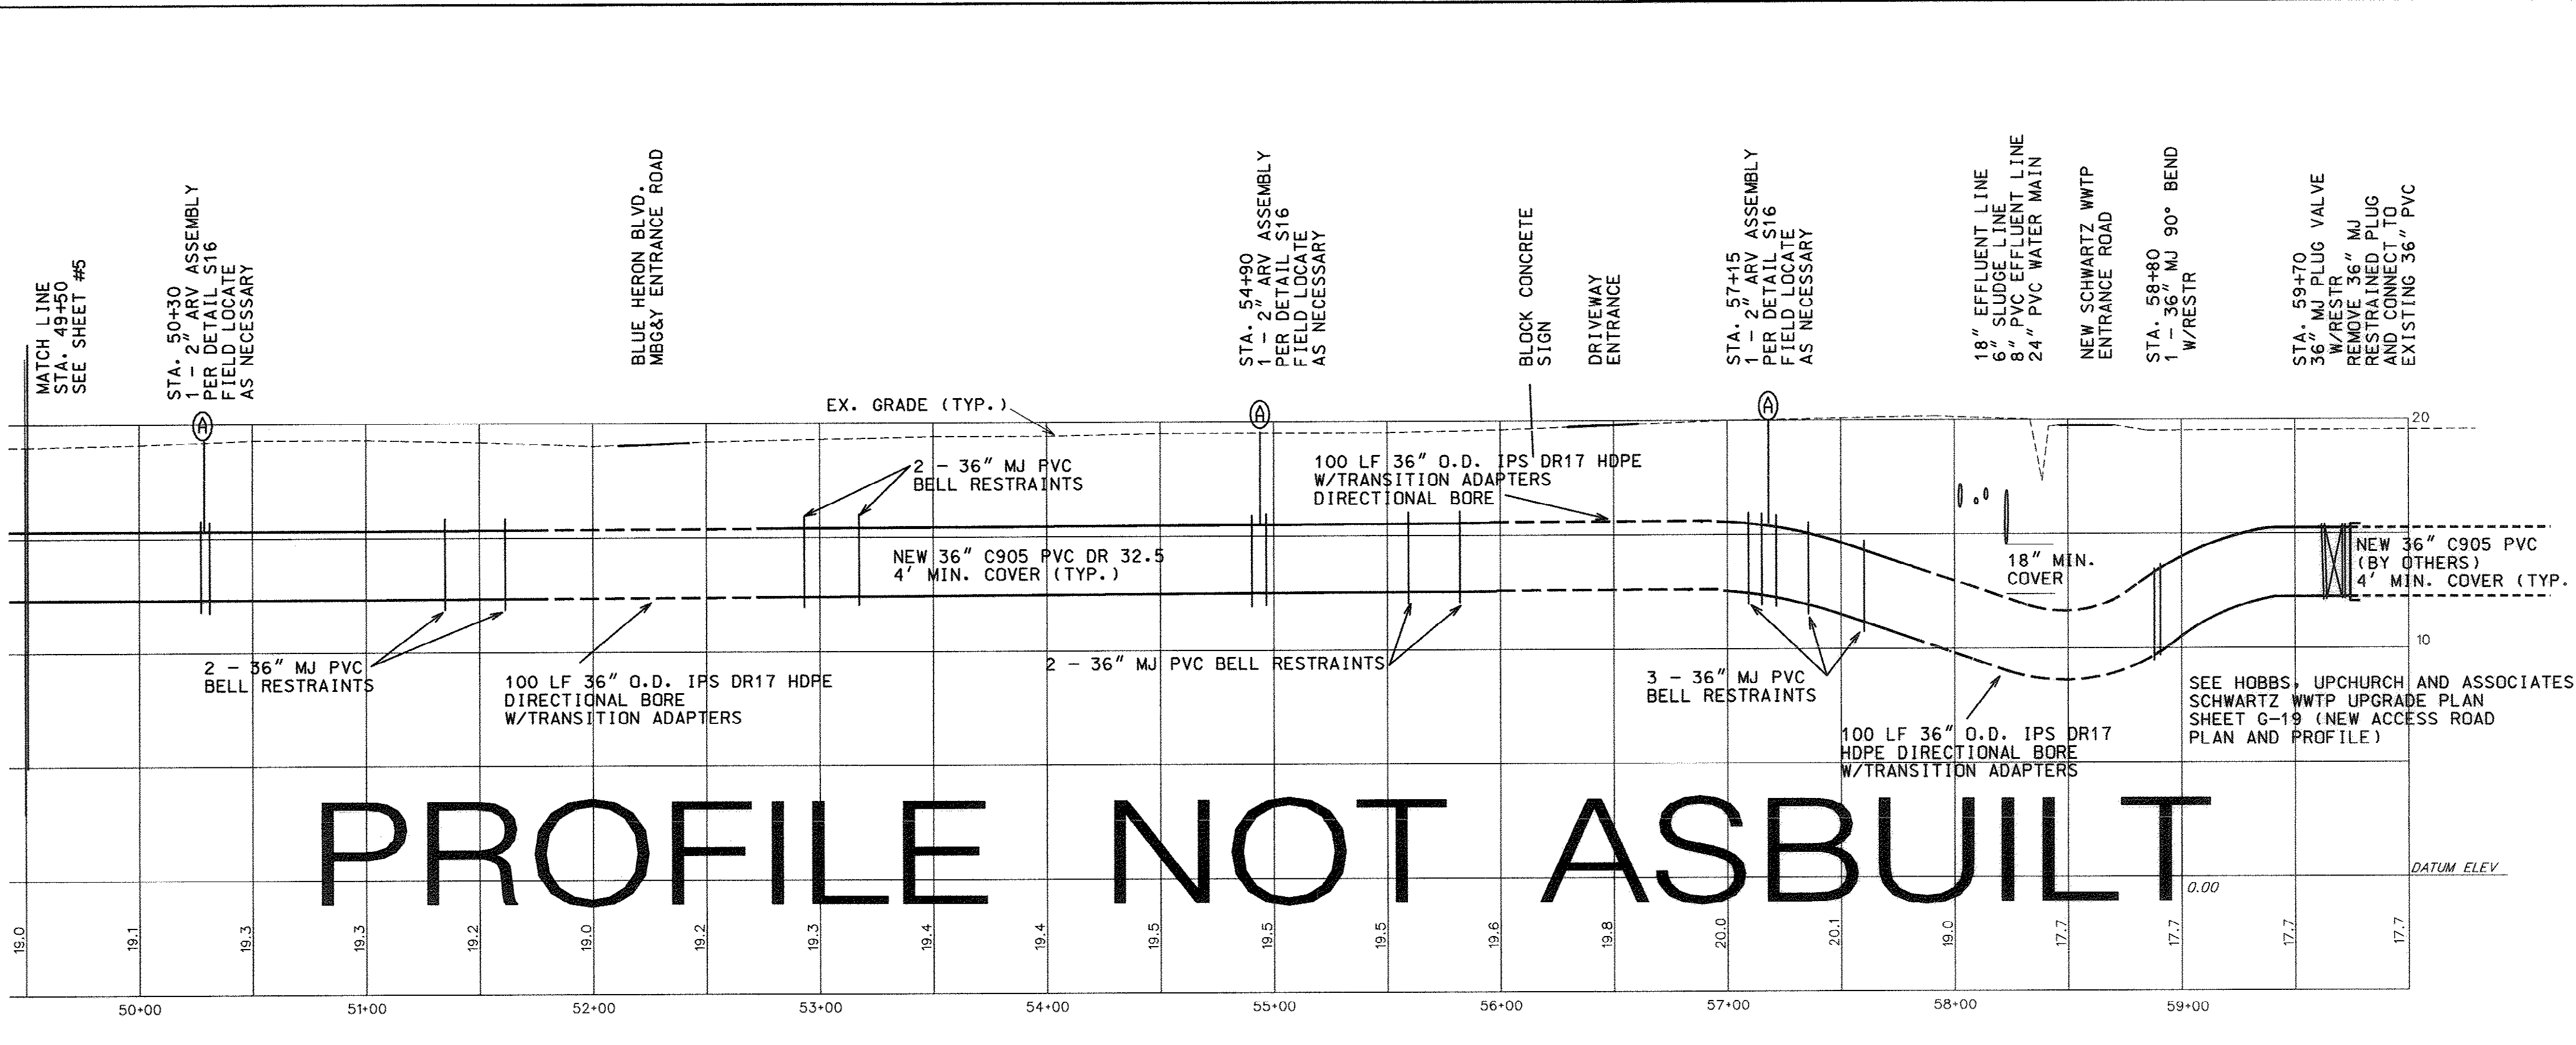

PROFILE NOT ASBUILT

PROFILE SCALE: 1" = 50 FEET (HORIZONTAL)
1" = 5 FEET (VERTICAL)