

WASTEWATER SYSTEM IMPROVEMENTS FOR THE GRAND STRAND WATER AND SEWER AUTHORITY

ADDENDUM # 2 - Supplement for Rebid

CENTRAL WASTEWATER TREATMENT SYSTEM

PART 1 TRANSMISSION PIPELINES

PROJECT NO. CA68505.71

EPA NO. C450381-05



B,C&E/CH2M HILL

GAINESVILLE
COLUMBIA



FLORIDA
SOUTH CAROLINA

RECORD DRAWING

8-01-06 -ws

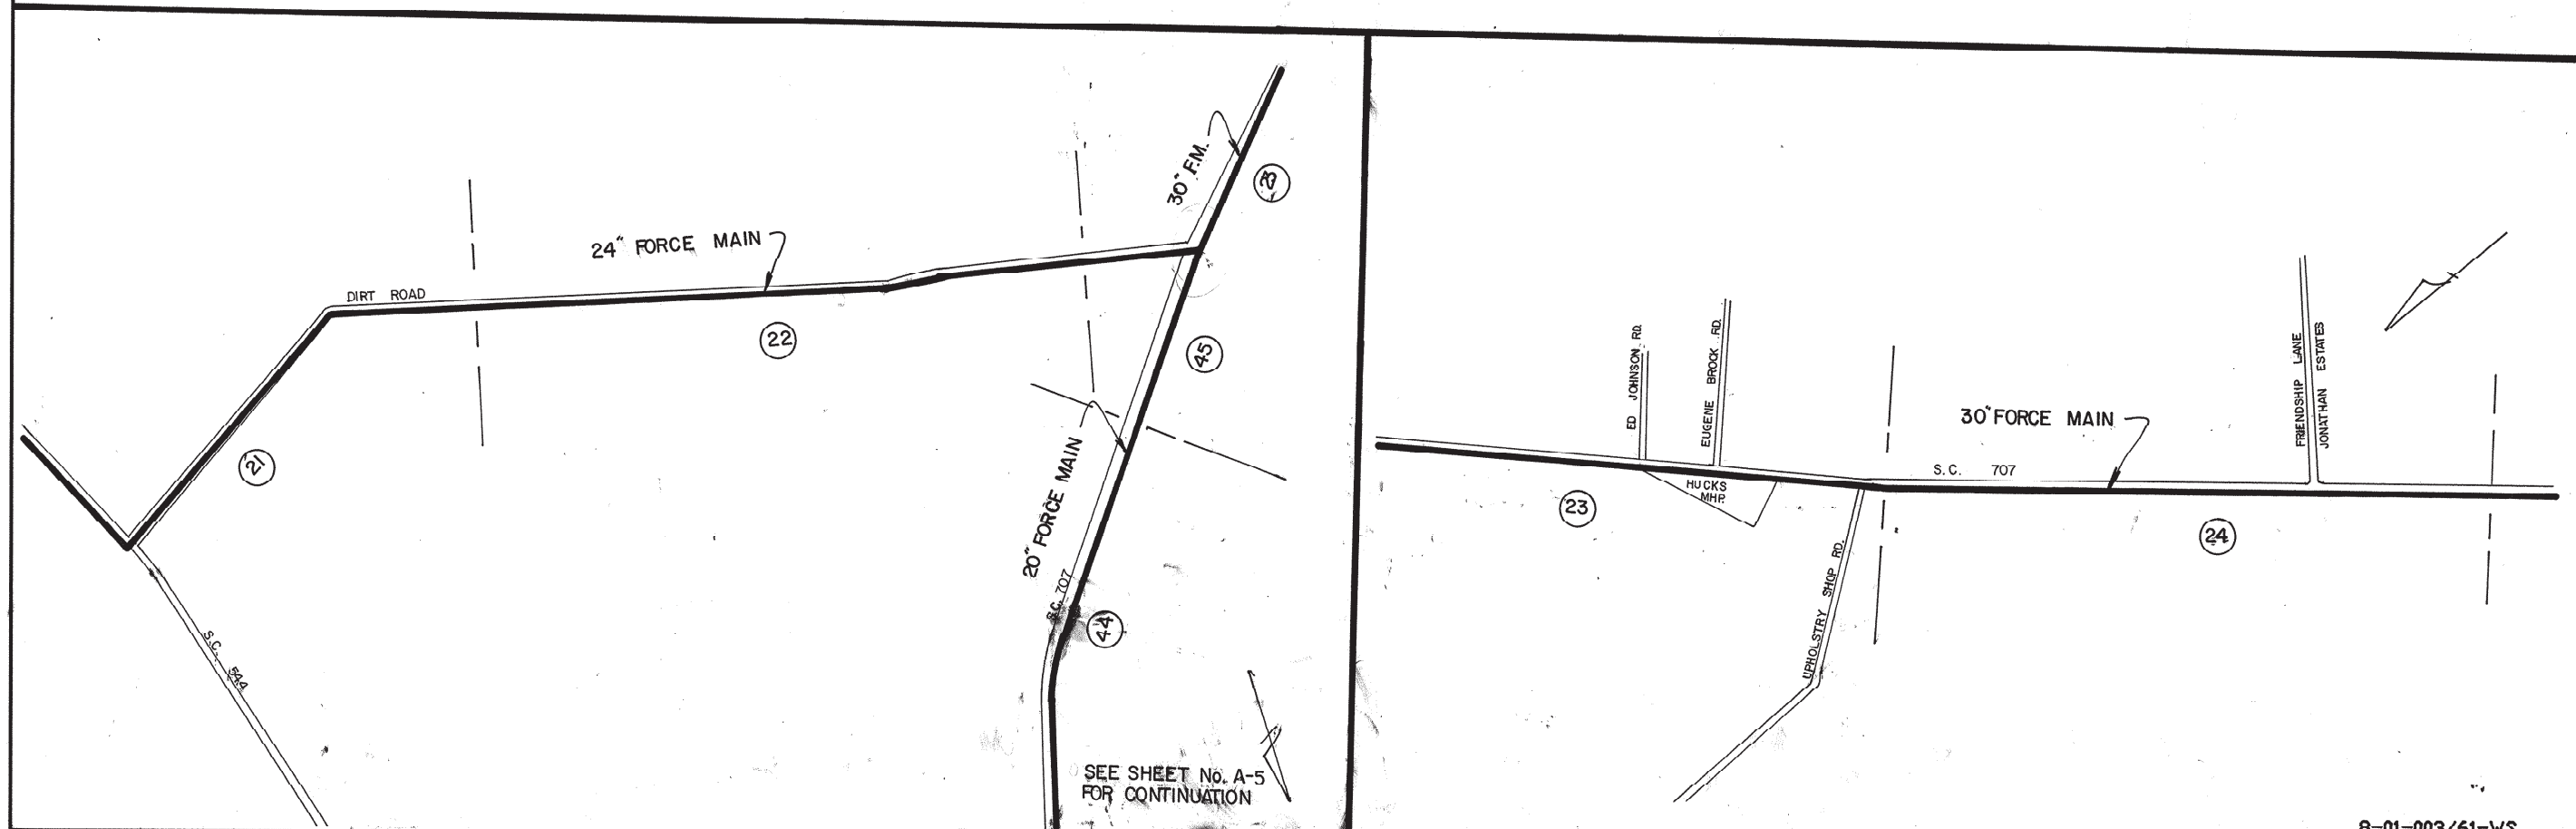
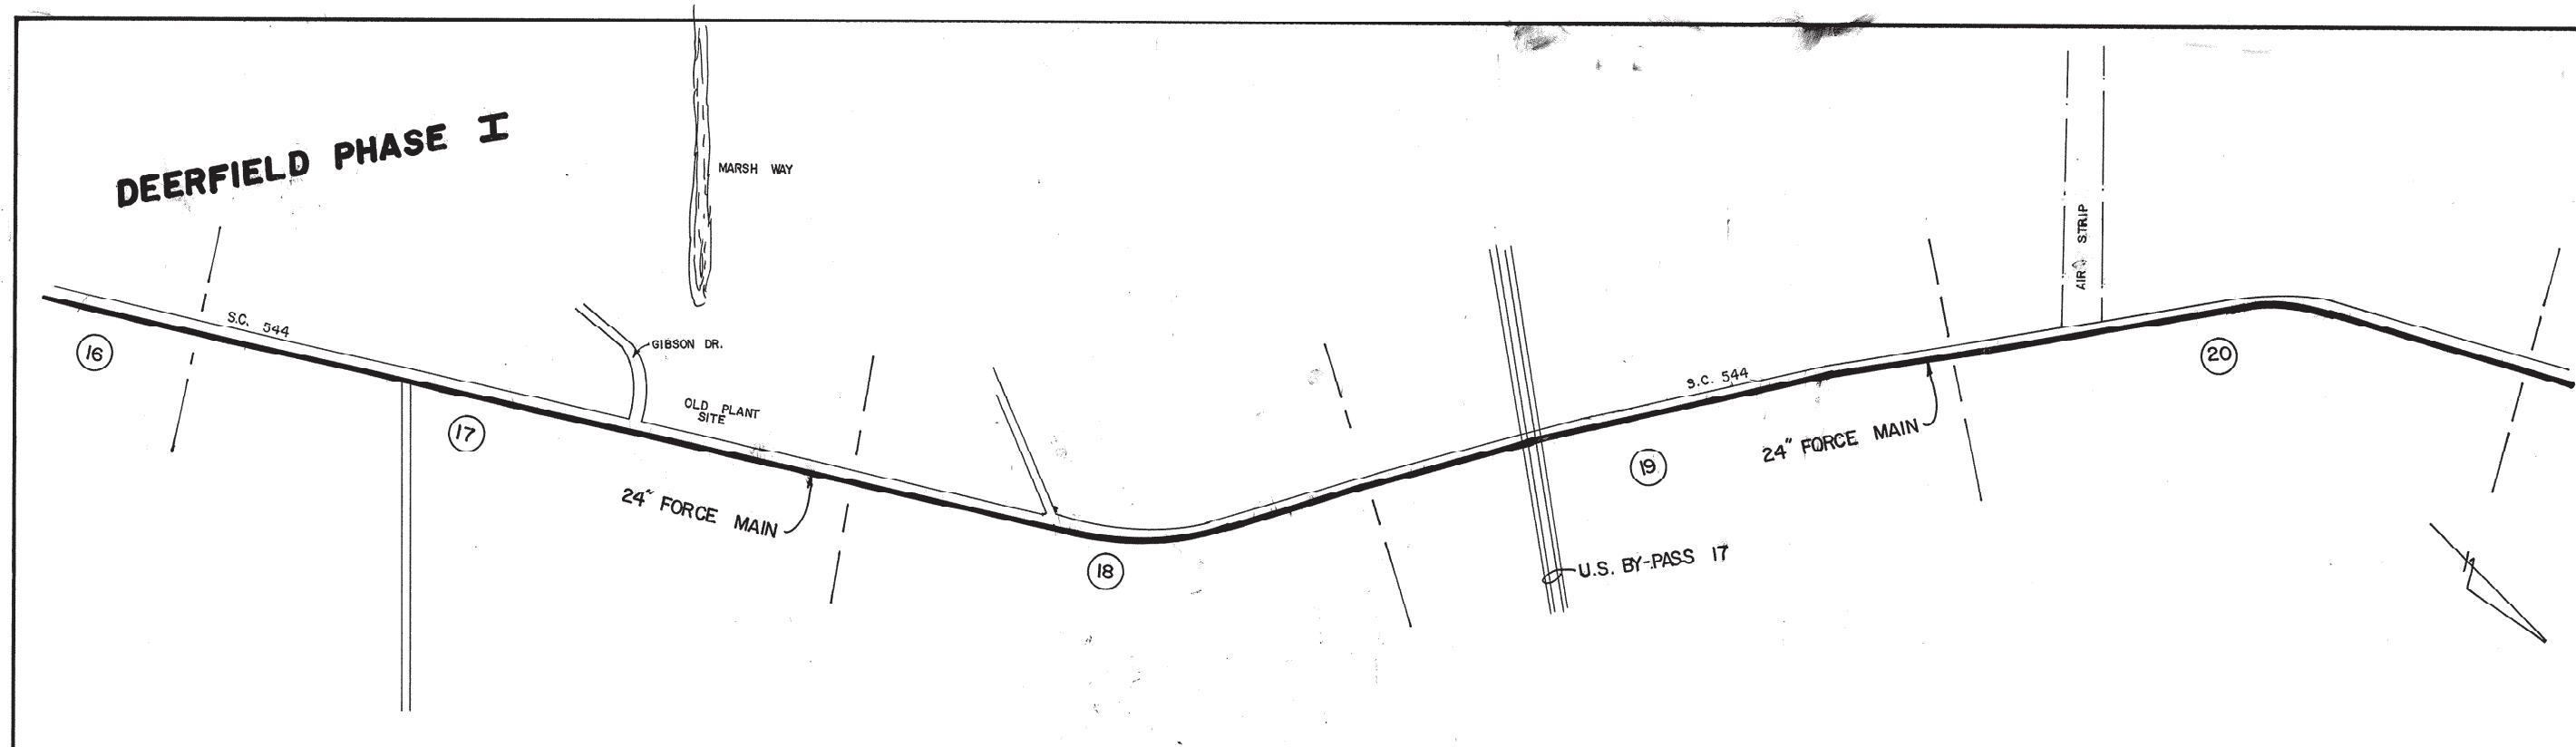







50 0 50 100 Graphic Scale	This Drawing is a Tracing of an original design by Black, Crow and Eidsness. It has been traced by GSWSA to be Microfilmed.	<table border="1"> <thead> <tr> <th>No.</th> <th>Date</th> <th>REVISION</th> <th>By</th> <th>Appd.</th> </tr> </thead> <tbody> <tr> <td> </td> <td> </td> <td> </td> <td> </td> <td> </td> </tr> </tbody> </table>	No.	Date	REVISION	By	Appd.						GRAND STRAND WATER & SEWER AUTHORITY	201 SEWER SYSTEM	LOCATION MAP ALONG 544 TO HWY. 707	8-01-003/61-WS SHEET OF A-3 DATF May-78 Traced 01-86 CA 68505.71 C 450381-05
No.	Date	REVISION	By	Appd.												

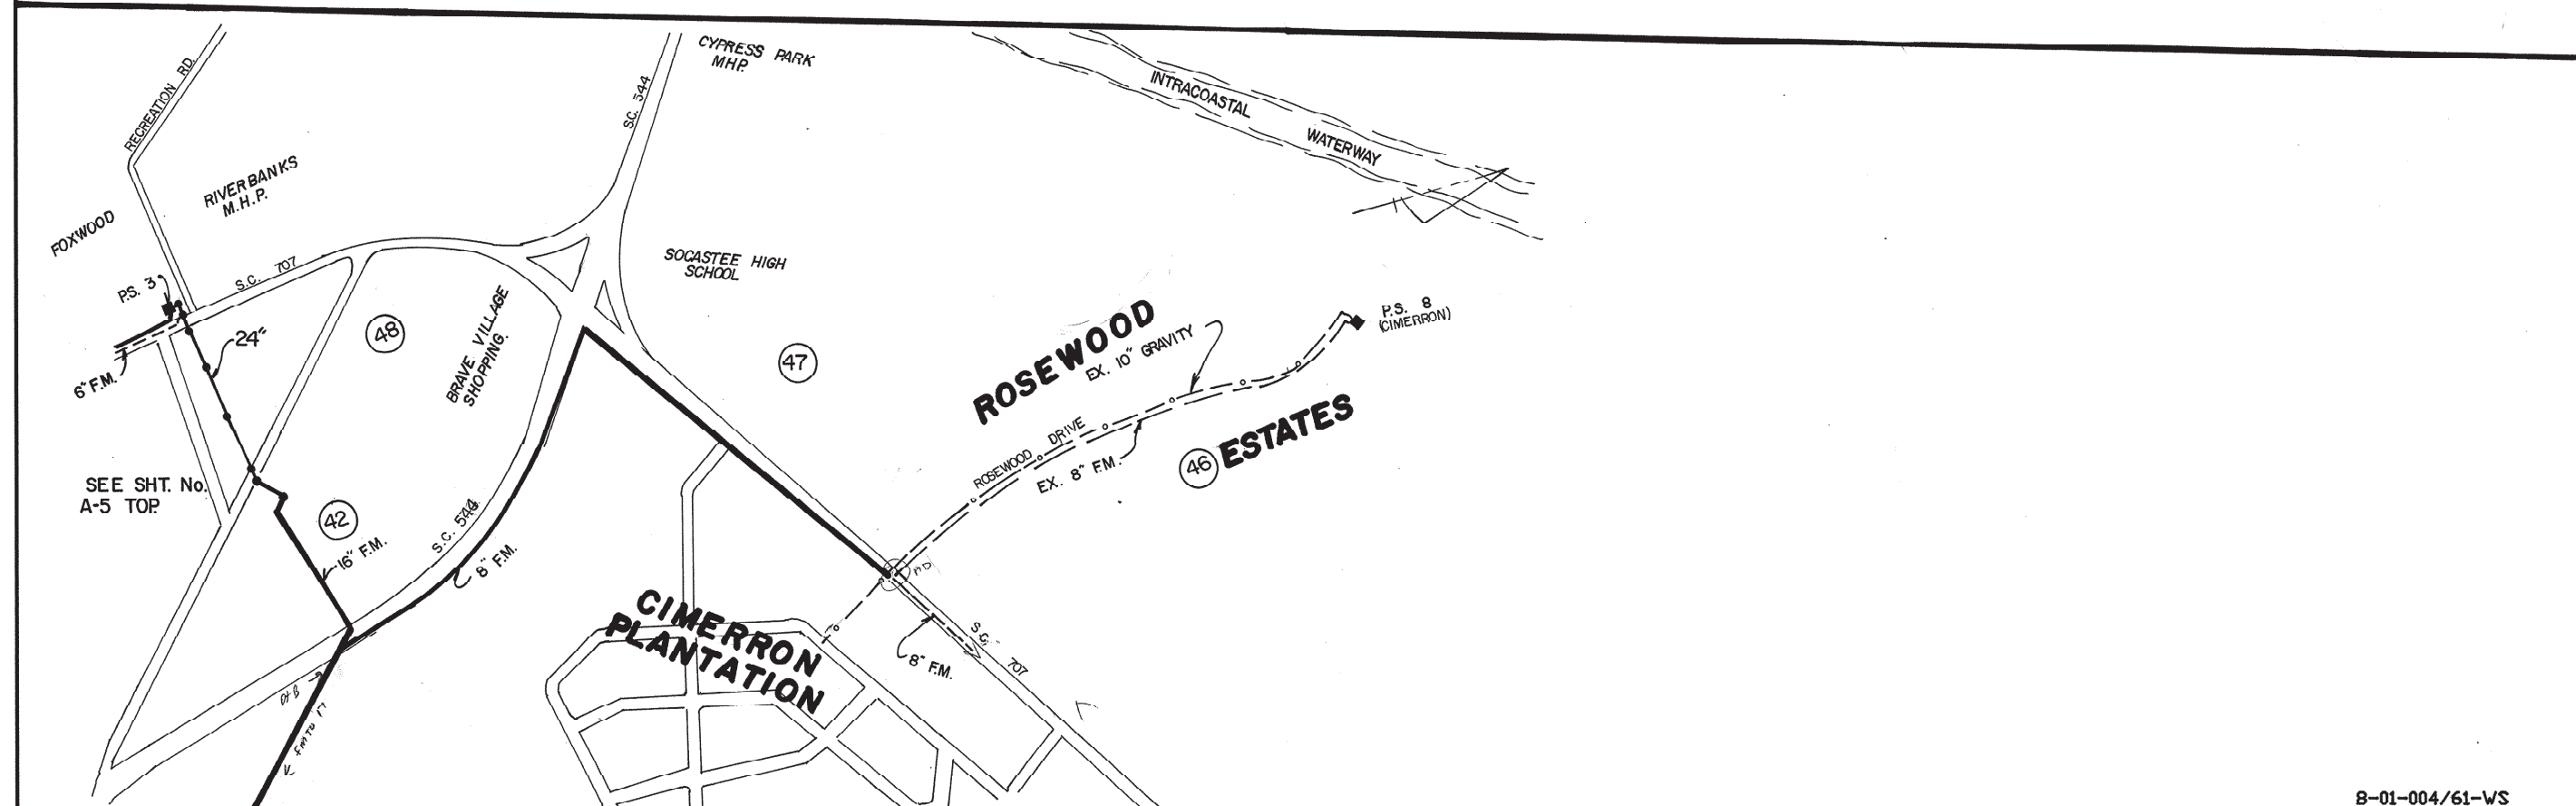
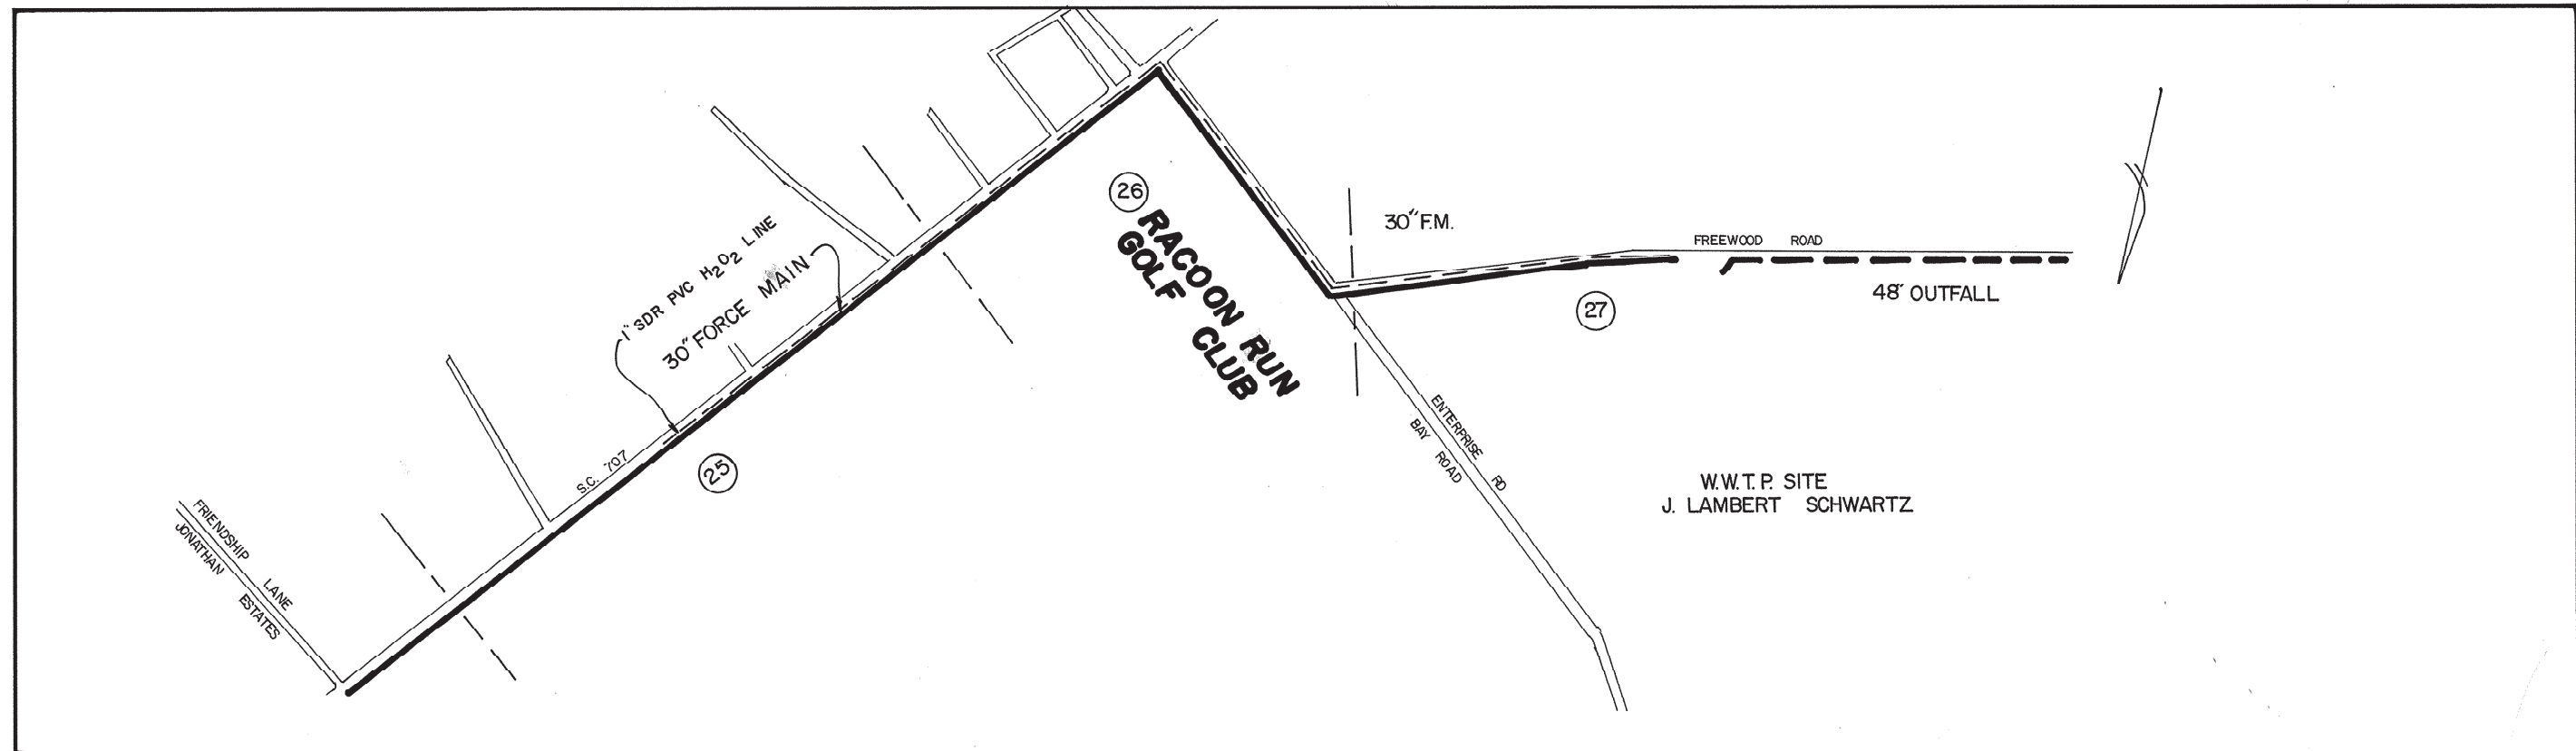


B-01-004/61-WS


50050100 Graphic Scale	This Drawing is a Tracing of an original design by Black,Crow and Eldness. It has been traced by GSWSA to be Microfilmed. <table><tr><th>No.</th><th>Date</th><th>REVISION</th><th>By</th><th>Appd.</th></tr><tr><td> </td><td> </td><td> </td><td> </td><td> </td></tr></table>	No.	Date	REVISION	By	Appd.						GRAND STRAND WATER & SEWER AUTHORITY	201 SEWER SYSTEM	LOCATION MAP ALONG 544 TO HWY. 707	SHEET OF A-4 DATE May-78 Traced 01-86 CA 68505.71 C 450381-05
No.	Date	REVISION	By	Appd.											

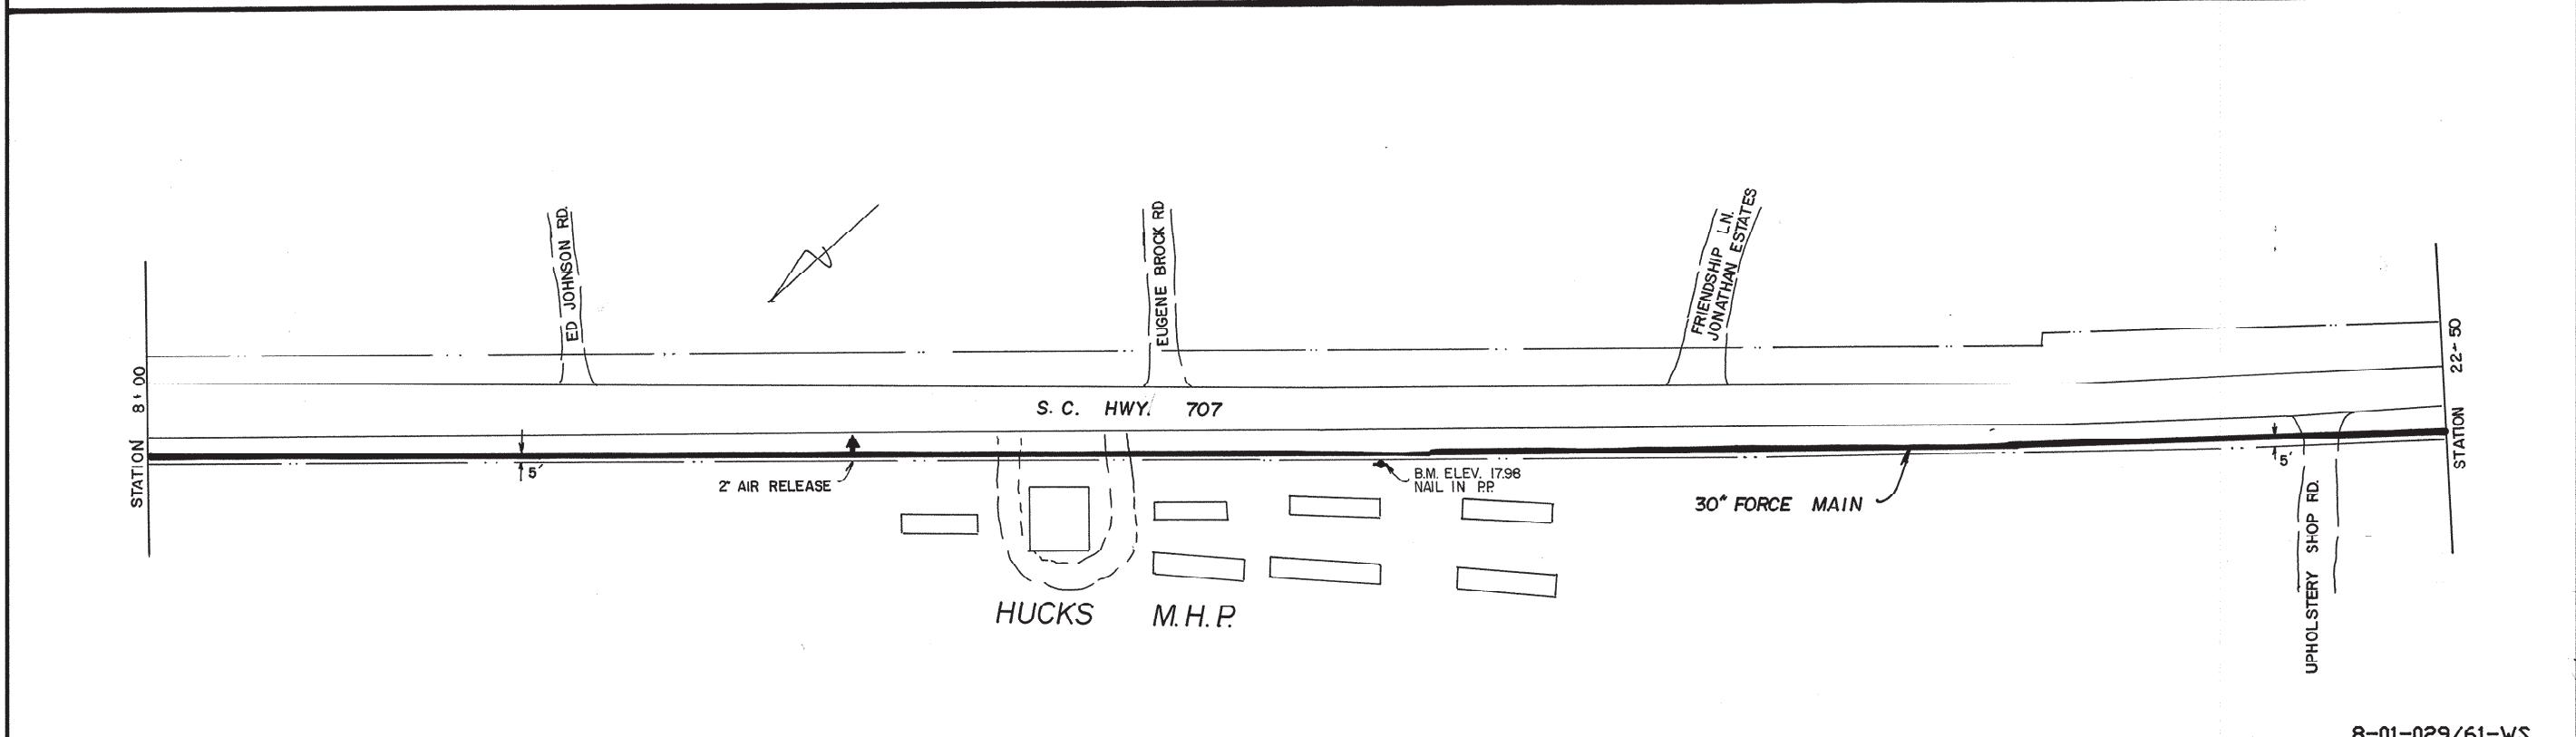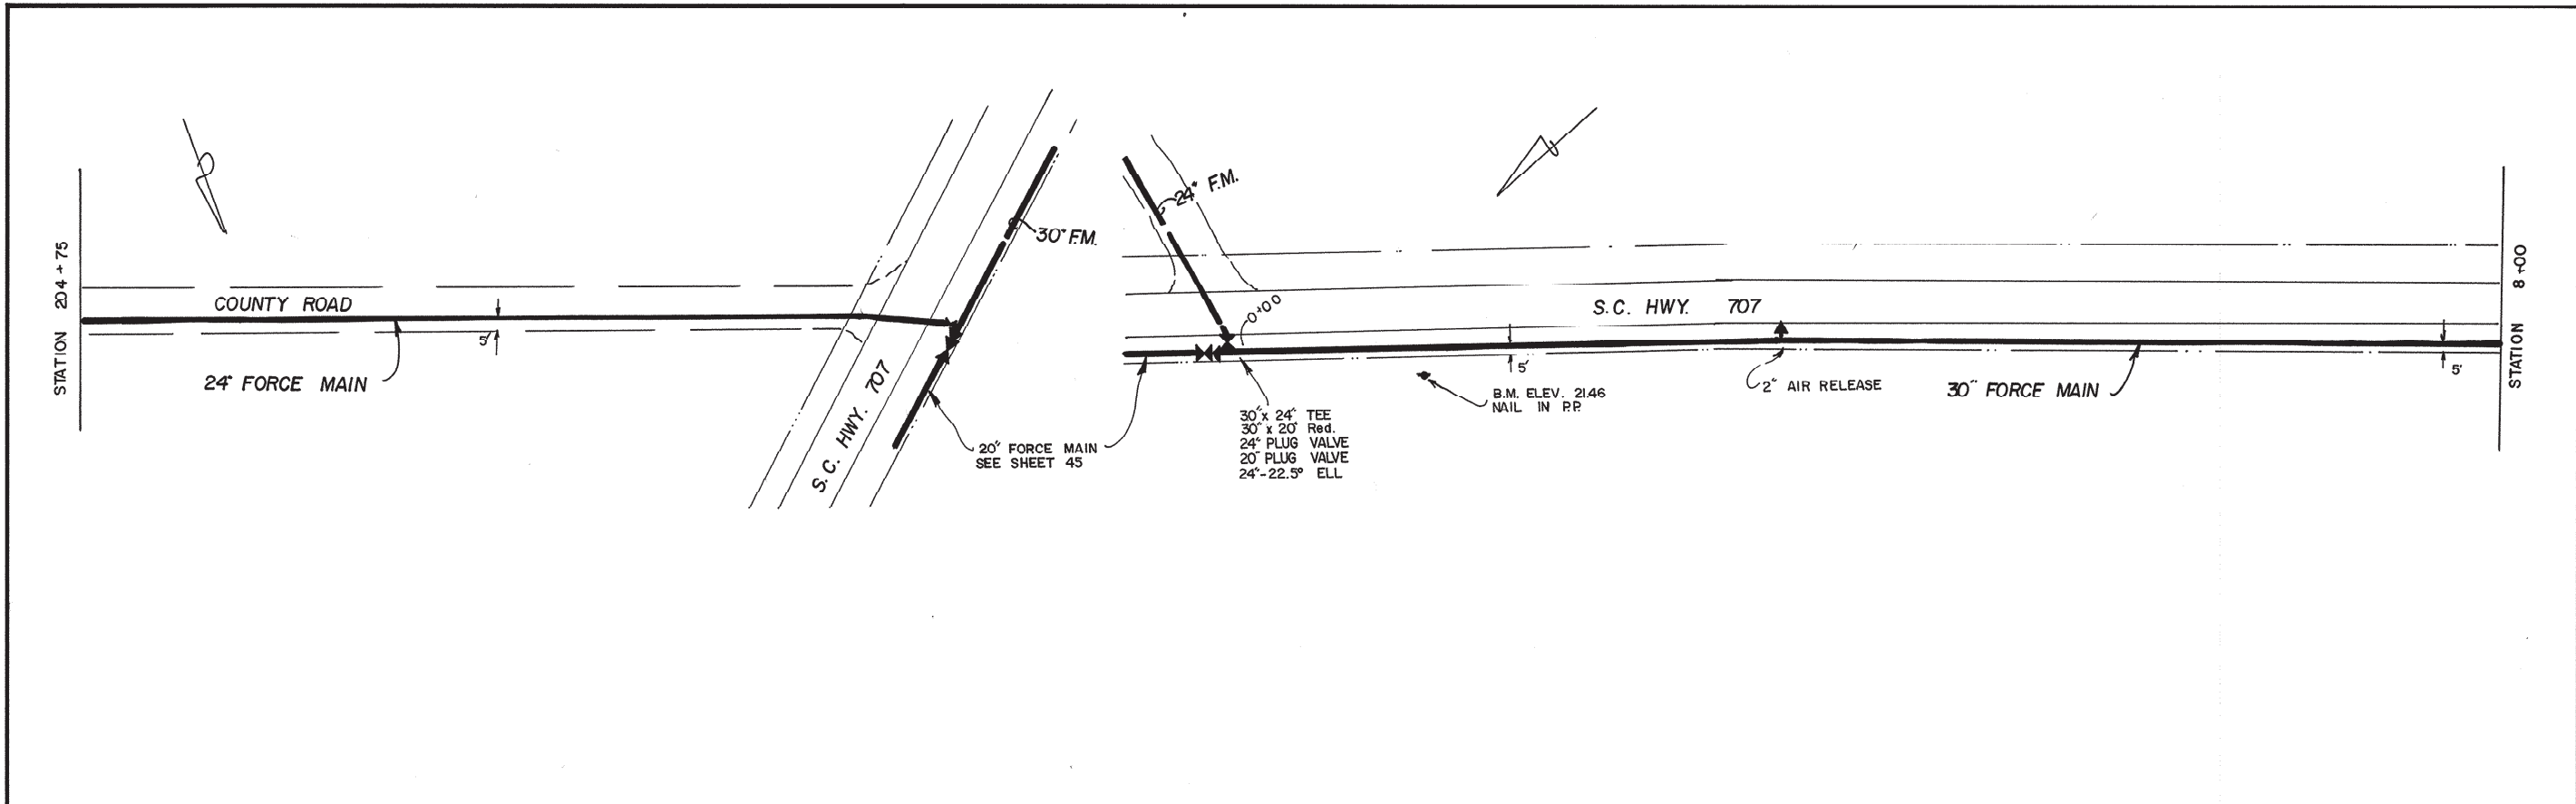

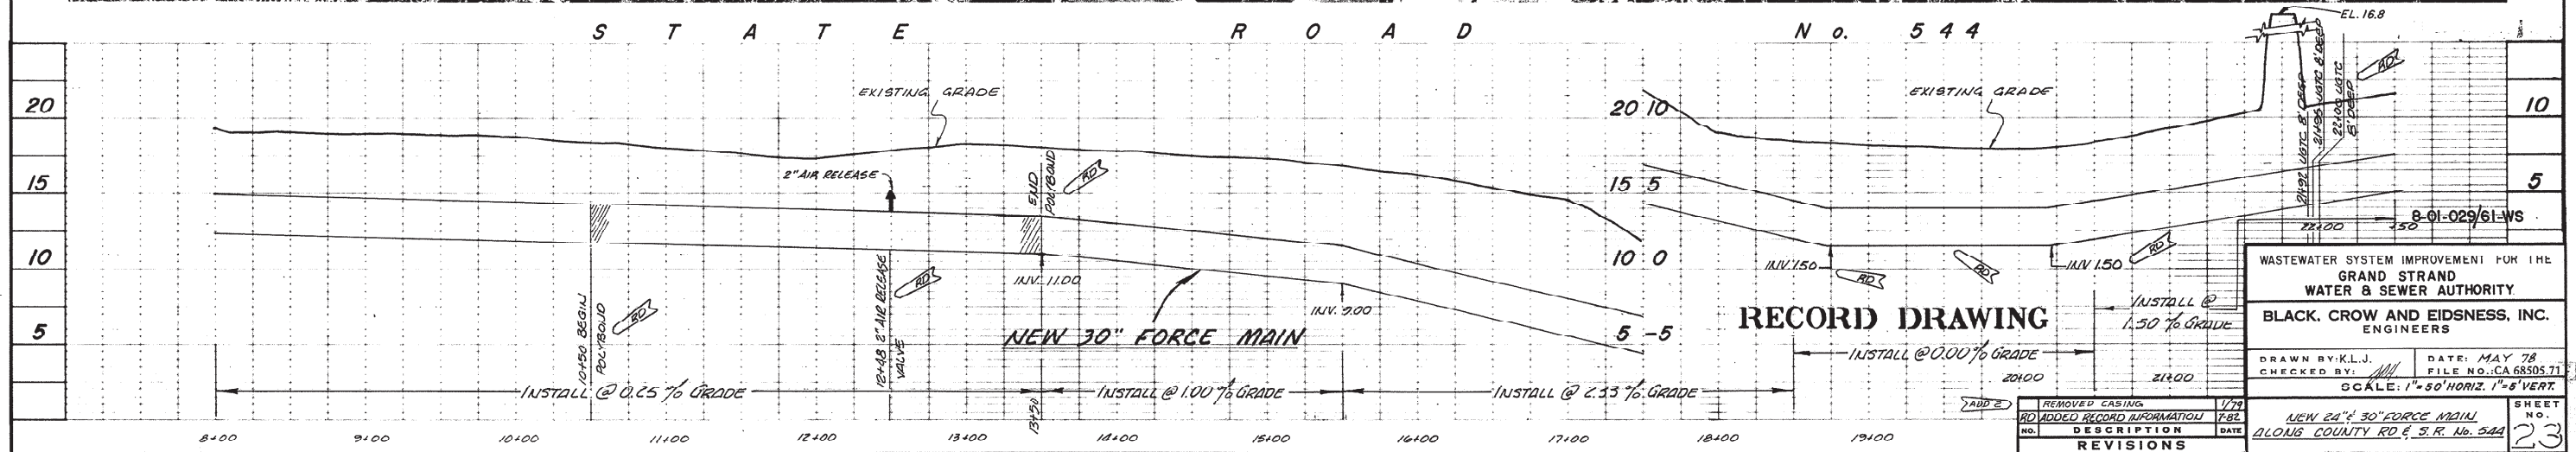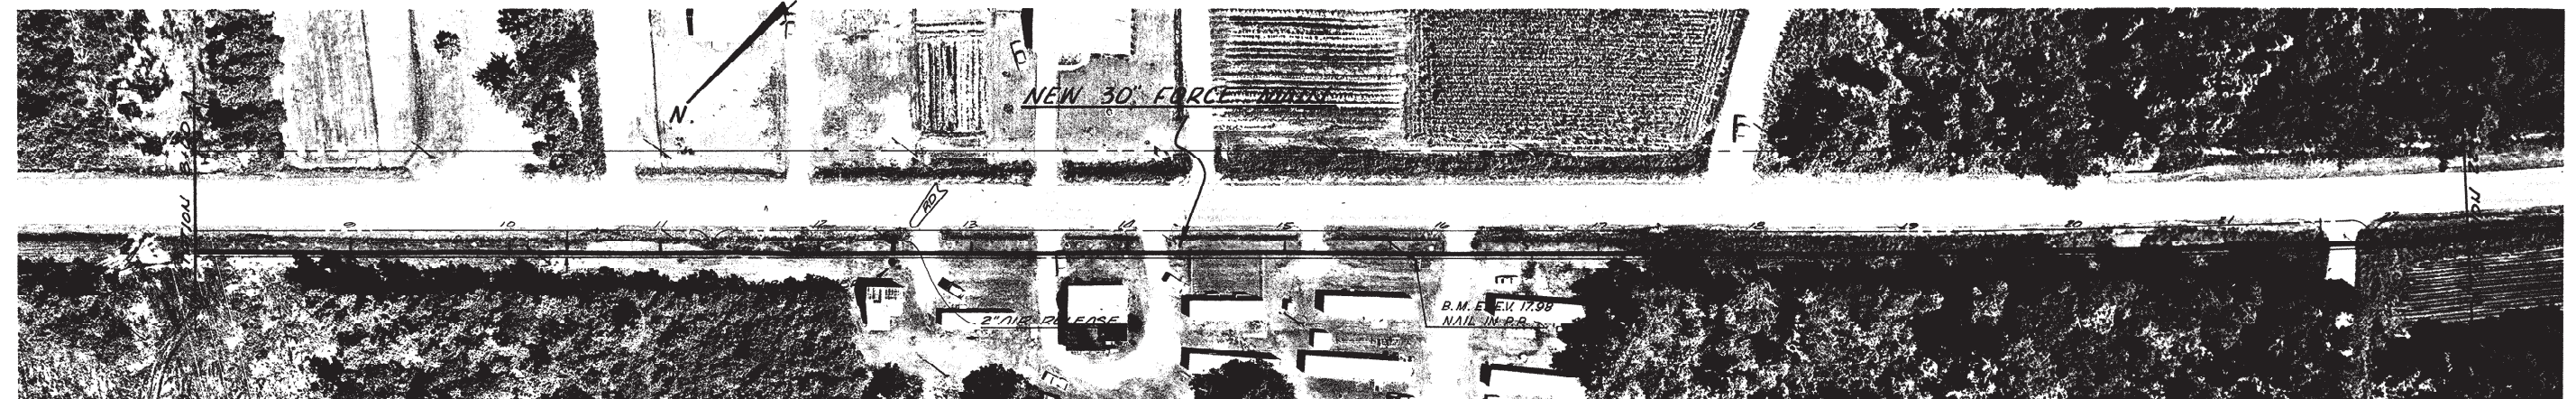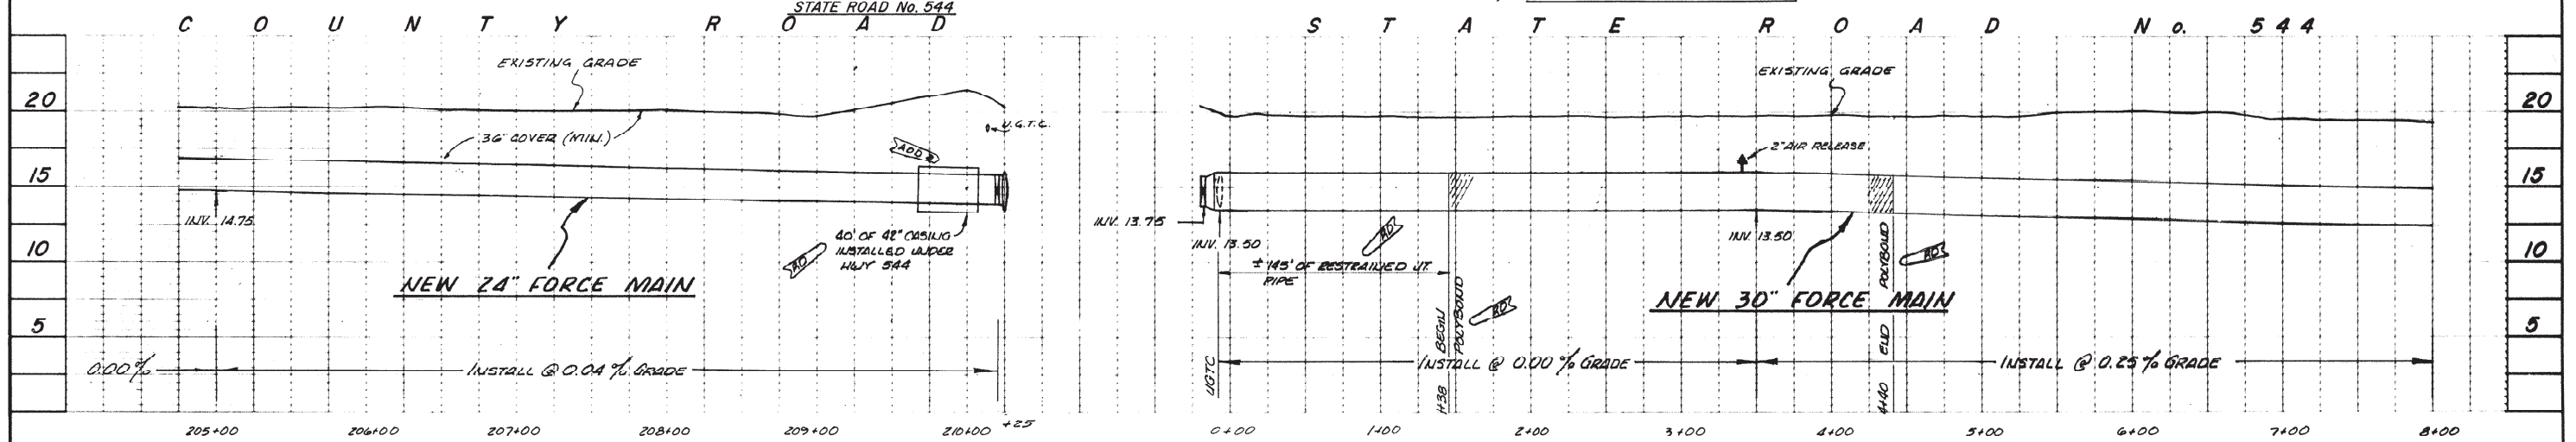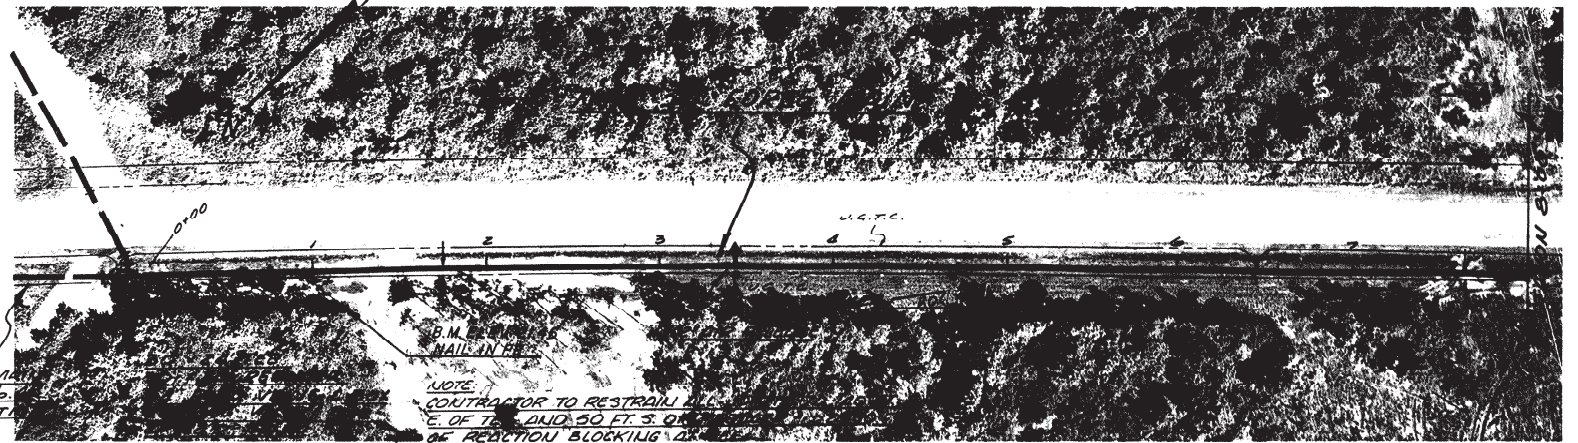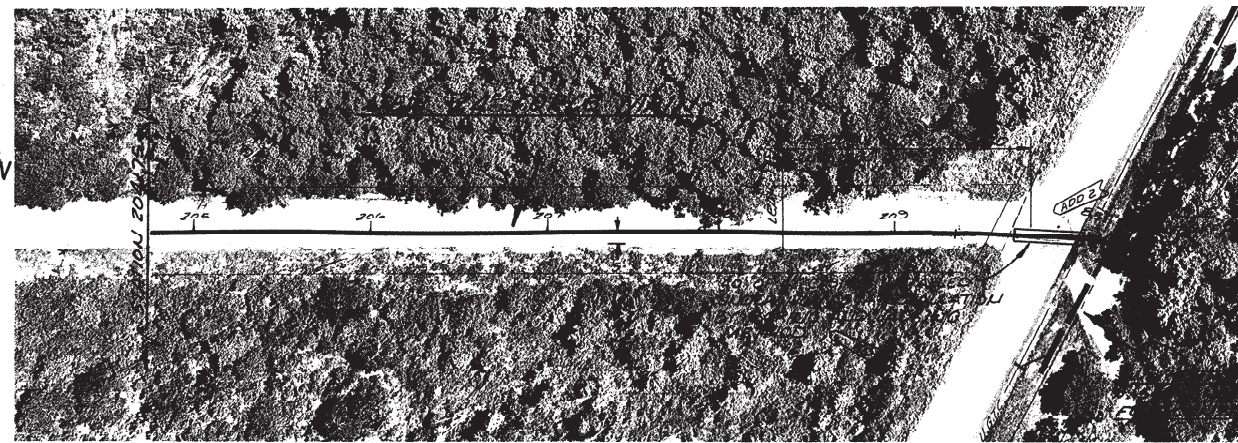

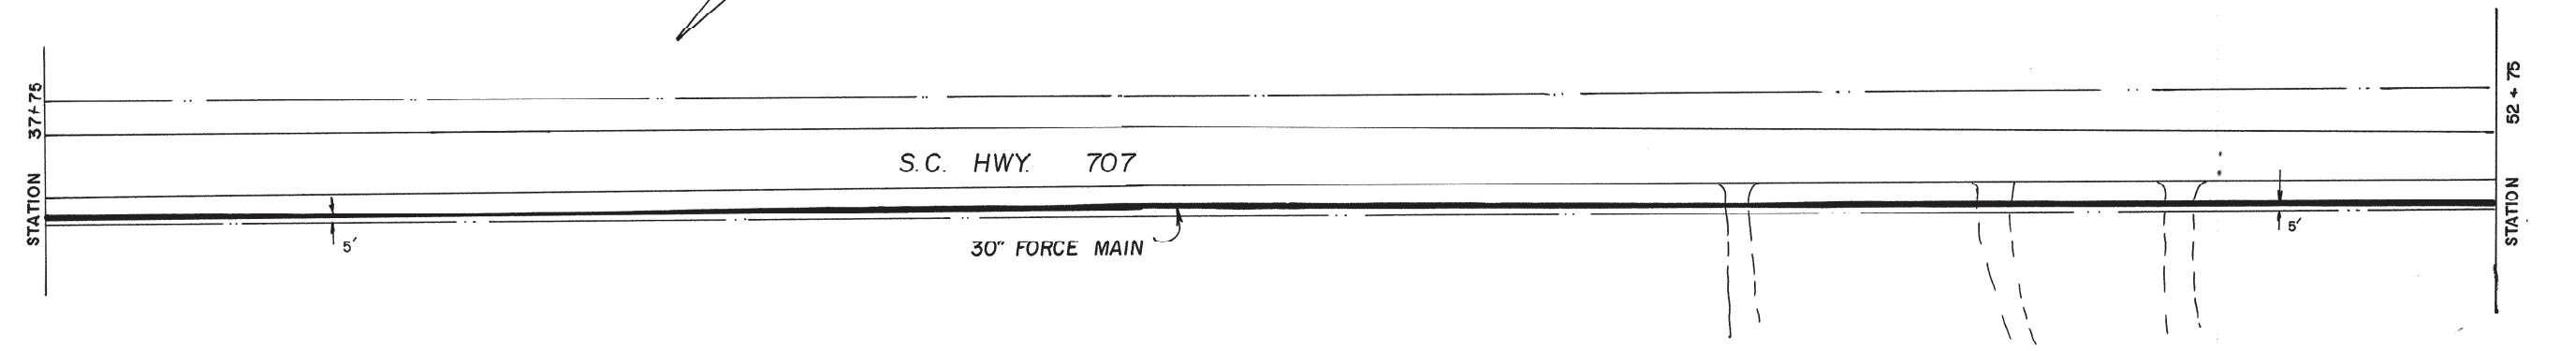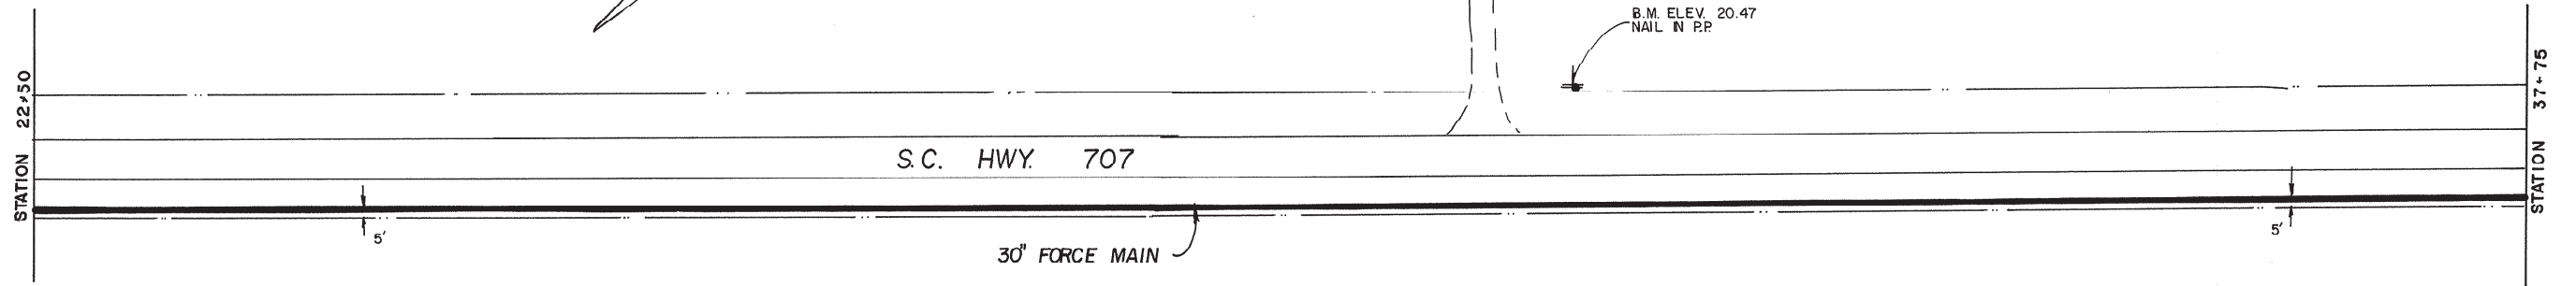

8-01-030/61-WS

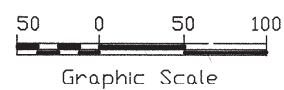

This Drawing is a Tracing
of an original design by
Black, Crow and Eldness.
It has been traced by
GSWSA to be Microfilmed.





No.	Date	REVISION	By	Appd.

GRAND STRAND
WATER & SEWER
AUTHORITY

201 SEWER SYSTEM

30" FORCE MAIN
ALONG U.S. 707


SHEET OF	24
DATE	May-78
Traced	01-86
CA	68505.71
C	450381-05

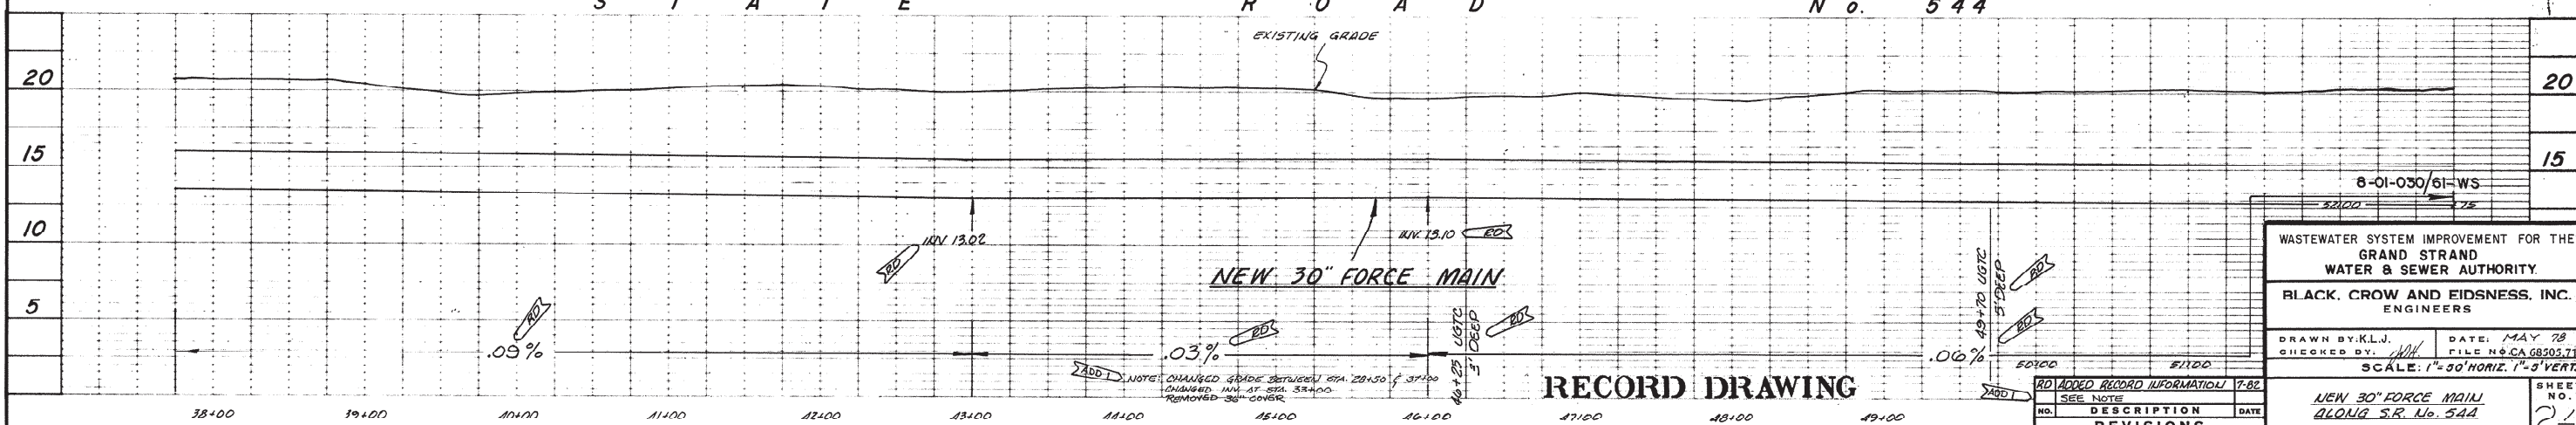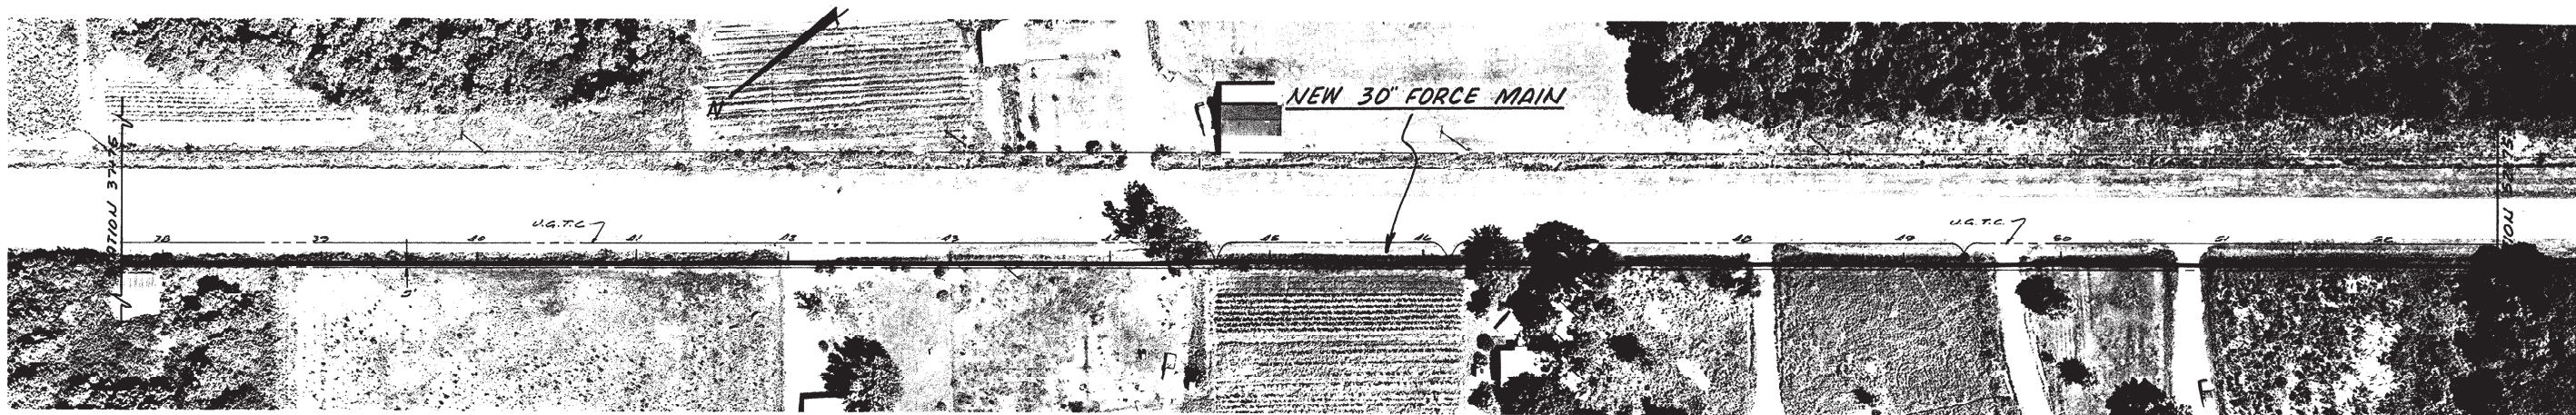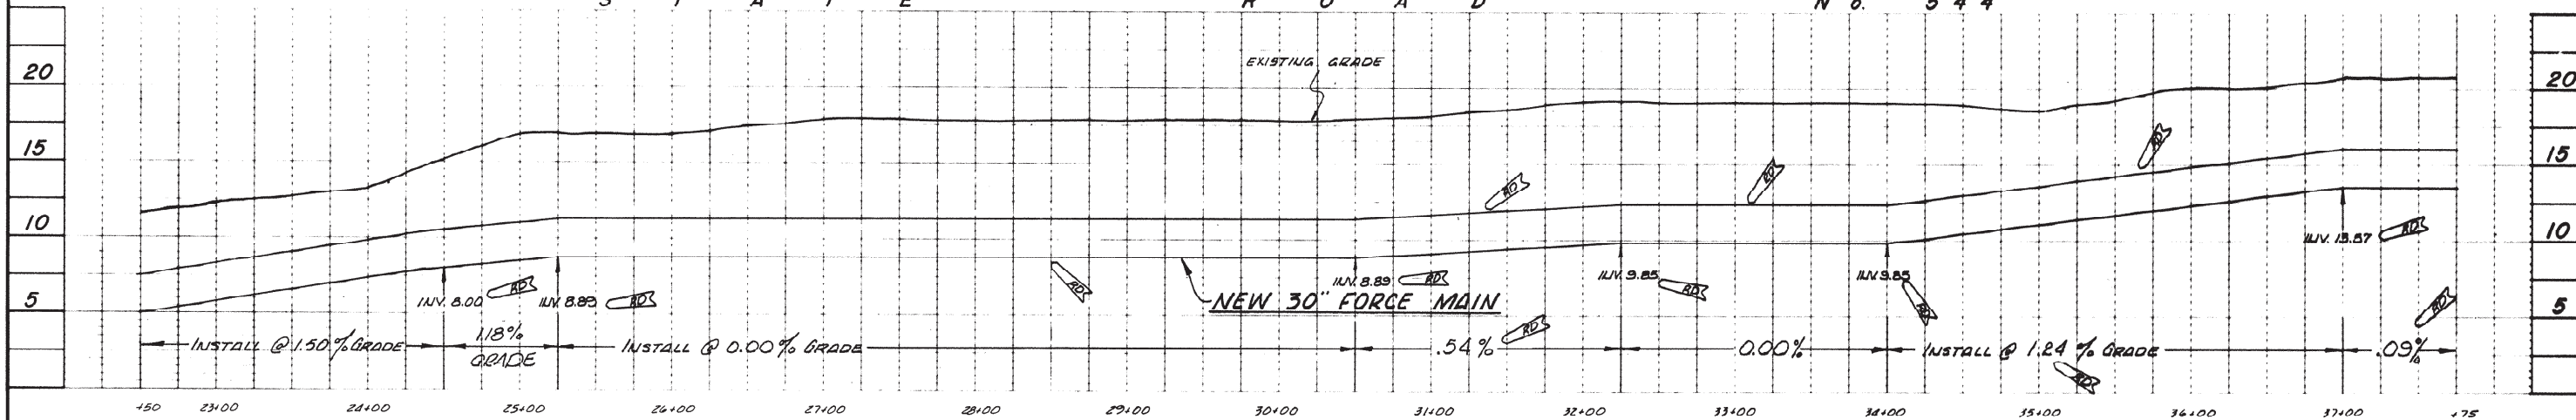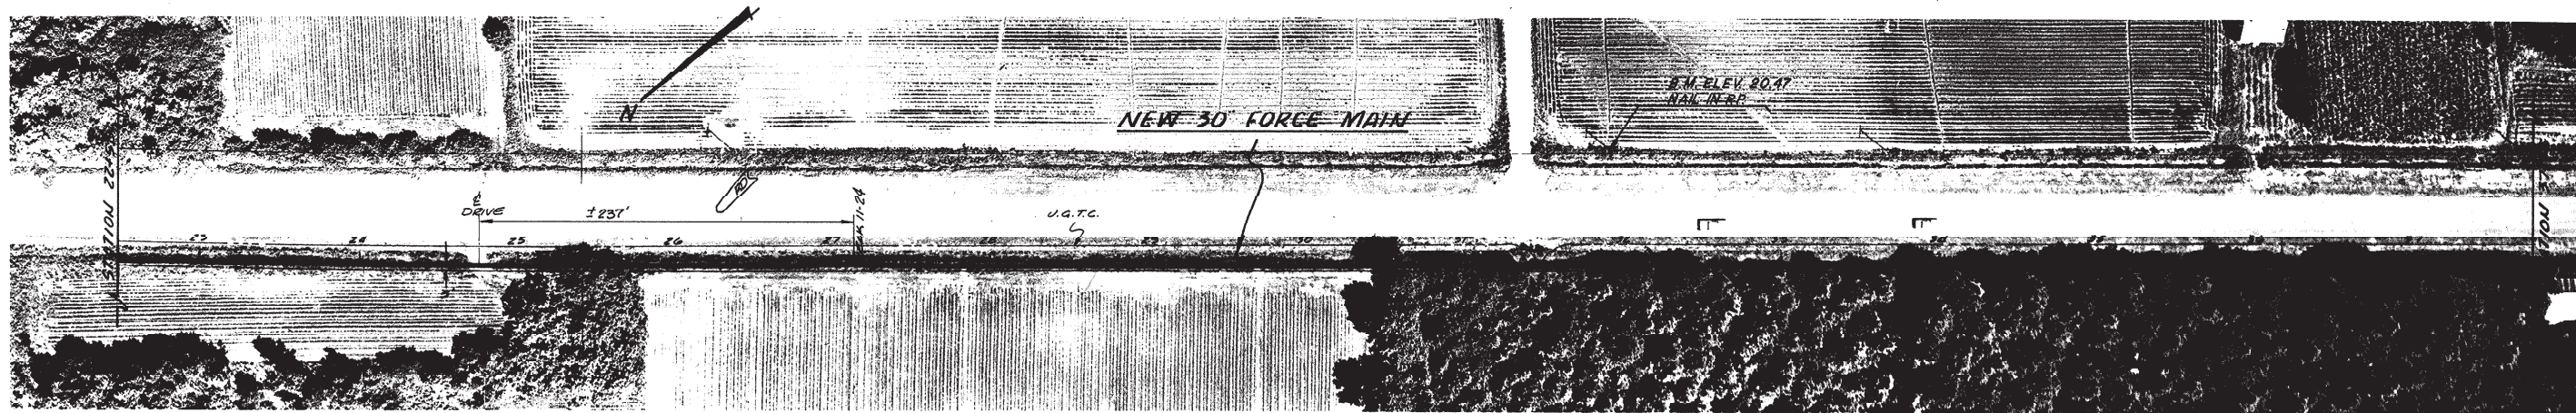


6-01-030/61-WS	
WASTEWATER SYSTEM IMPROVEMENT FOR THE GRAND STRAND WATER & SEWER AUTHORITY.	
BLACK, CROW AND EIDNESS, INC. ENGINEERS	
DRAWN BY: K.L.J.	DATE: MAY 78
CHECKED BY: W.H.	FILE NO: CA 68303.71
SCALE: 1"=30' HORIZ. 1"=3' VERT.	
NEW 30" FORCE MAIN ALONG S.R. No. 544	
SHEET NO. 24	

NO.	DESCRIPTION	DATE
1	ADDED RECORD INFORMATION	7-82
2	SEE NOTE	
3	REVISIONS	

RECORD DRAWING

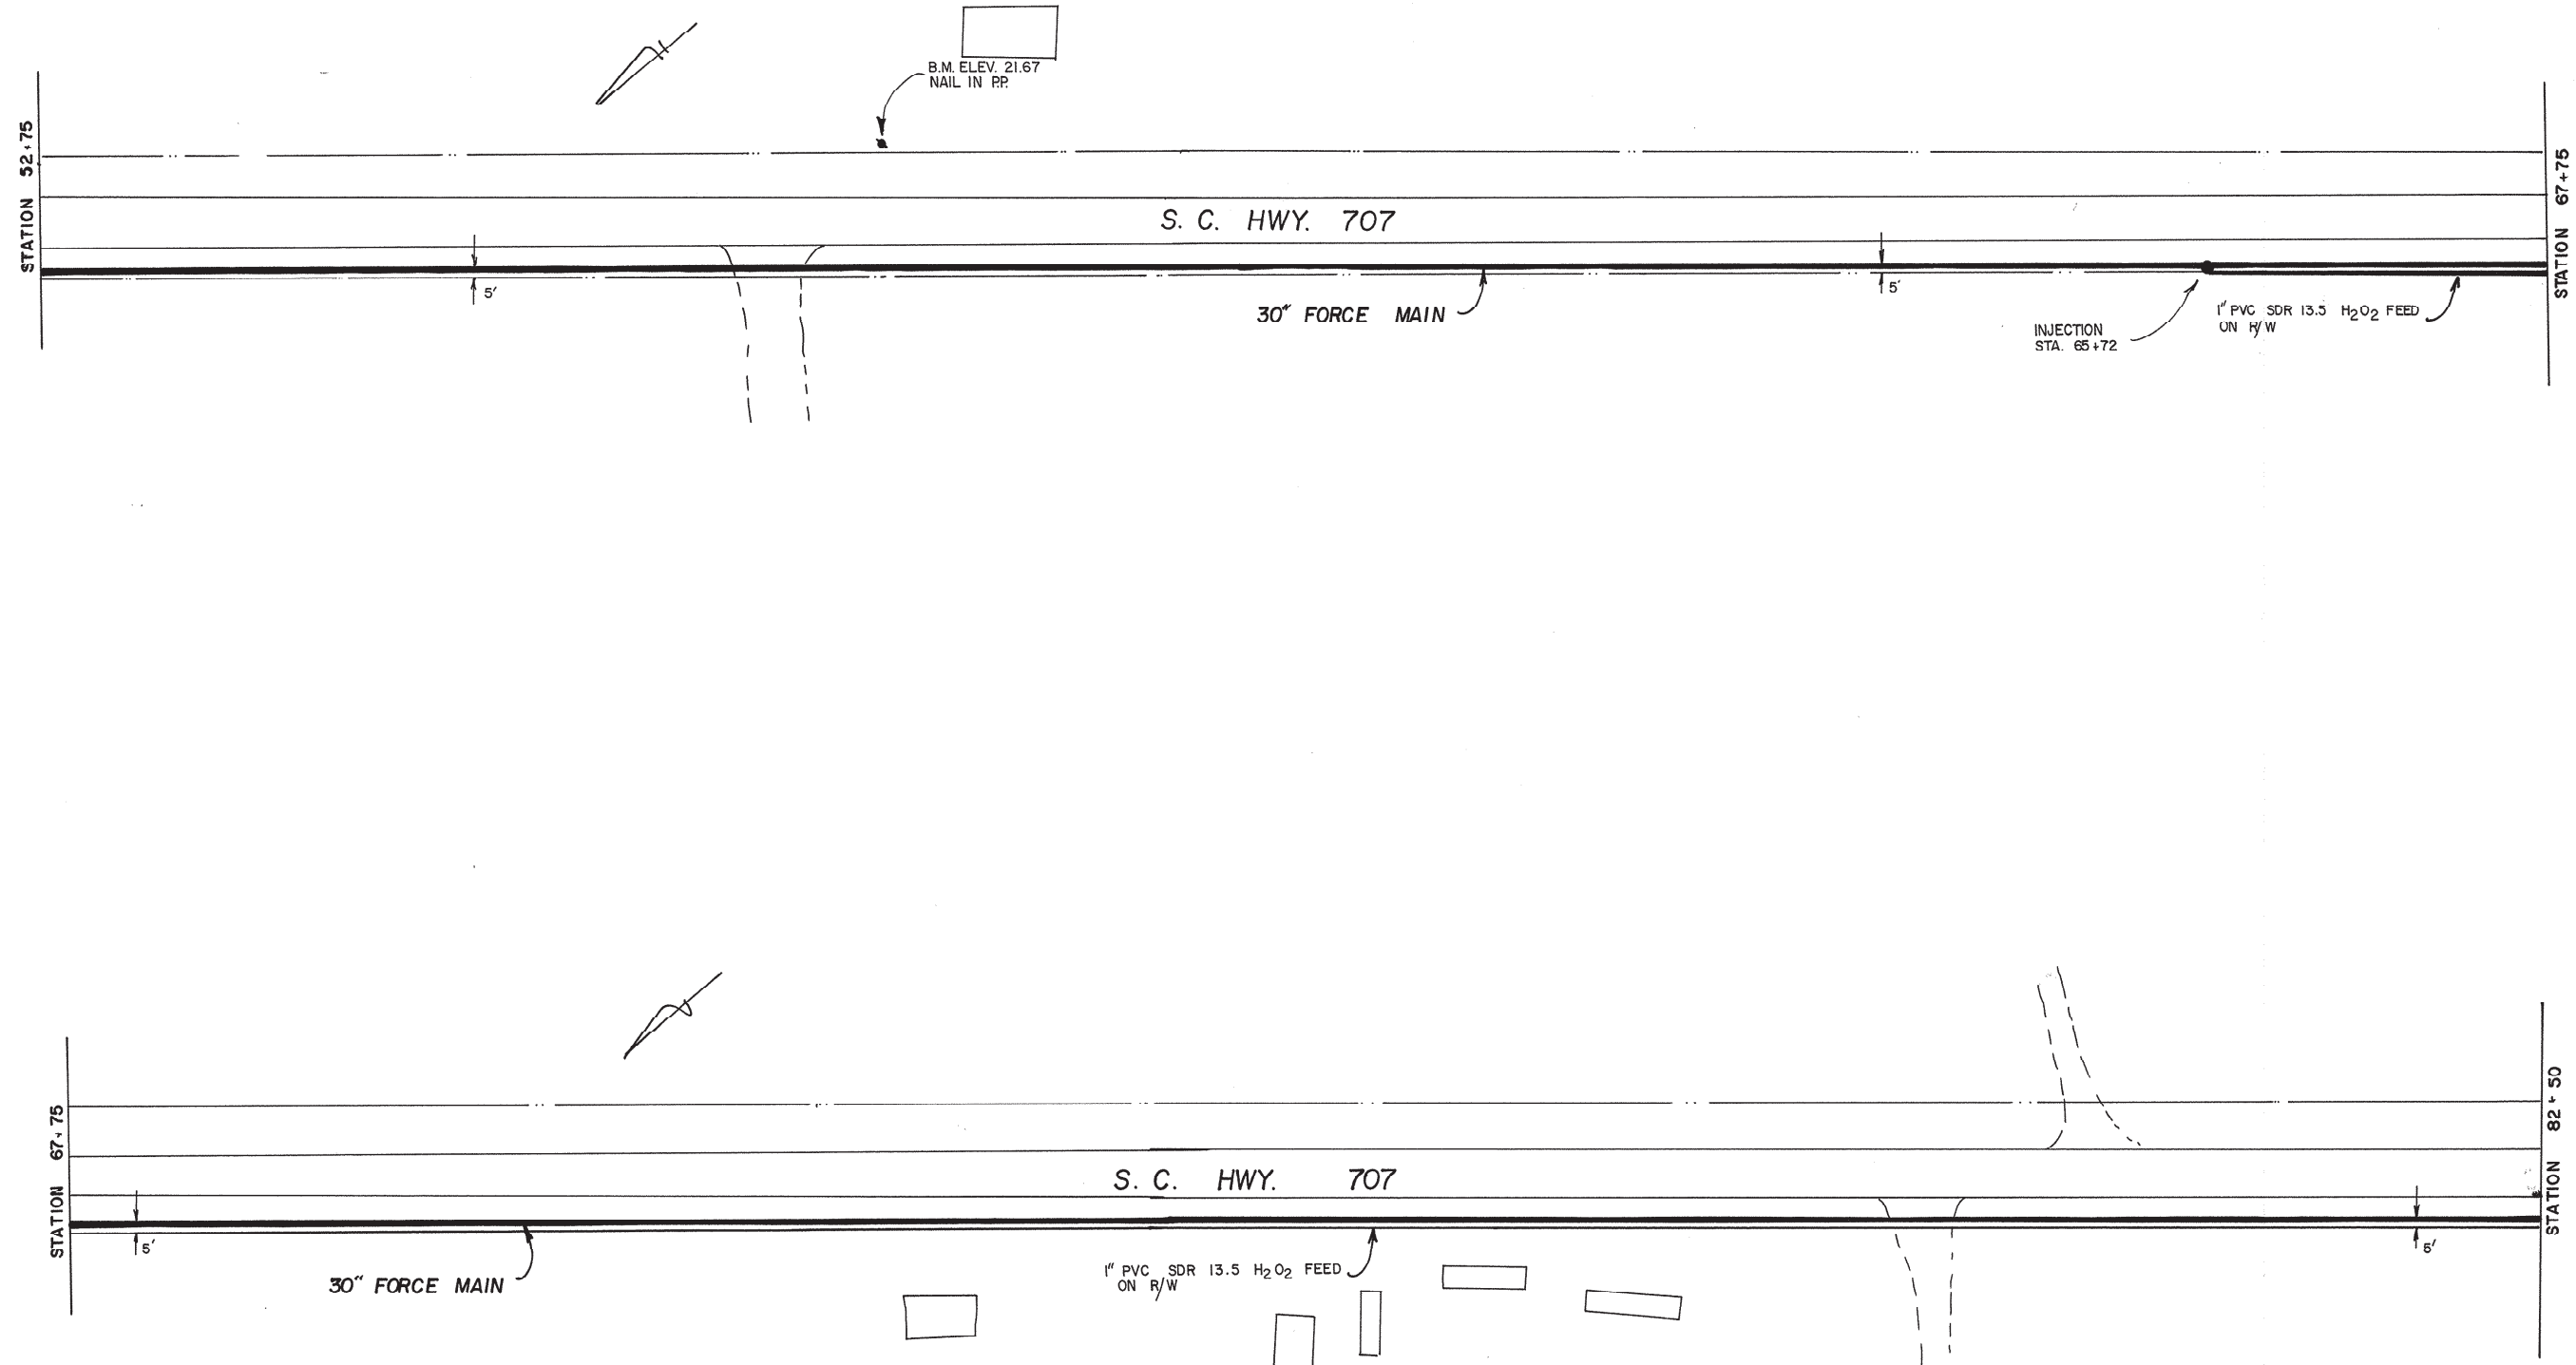

8-01-031/61-WS

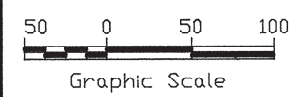

This Drawing is a Tracing
of an original design by
BlackCrow and Eldness.
It has been traced by
GSWSA to be Microfilmed.





No.	Date	REVISION	By	Appd.


GRAND STRAND
WATER & SEWER
AUTHORITY





201 SEWER SYSTEM



30" FORCE MAIN
ALONG U.S. 707

SHEET
OF 25
DATE May-78
Traced 01-86
CA 68505.71
C 450381-05

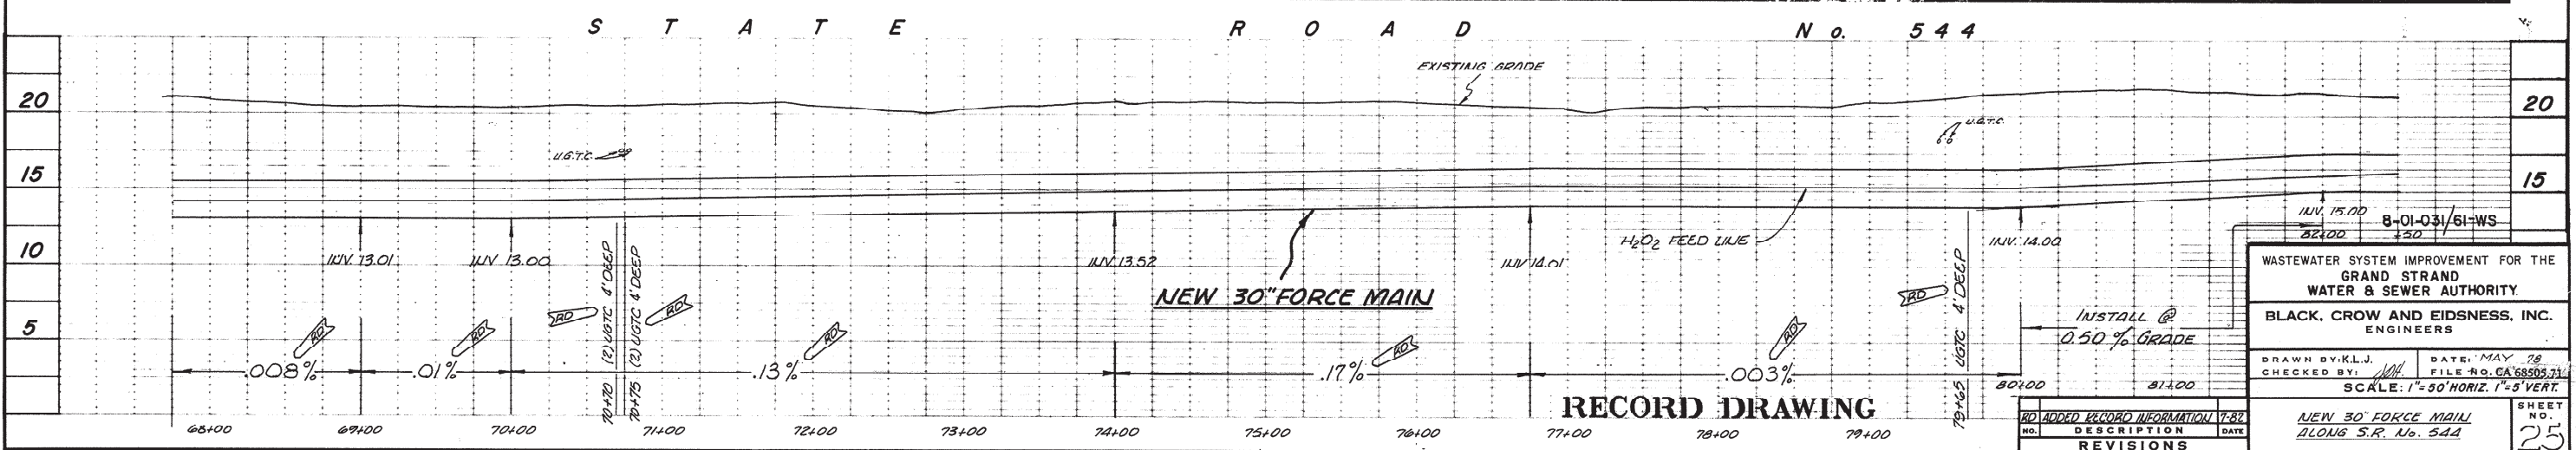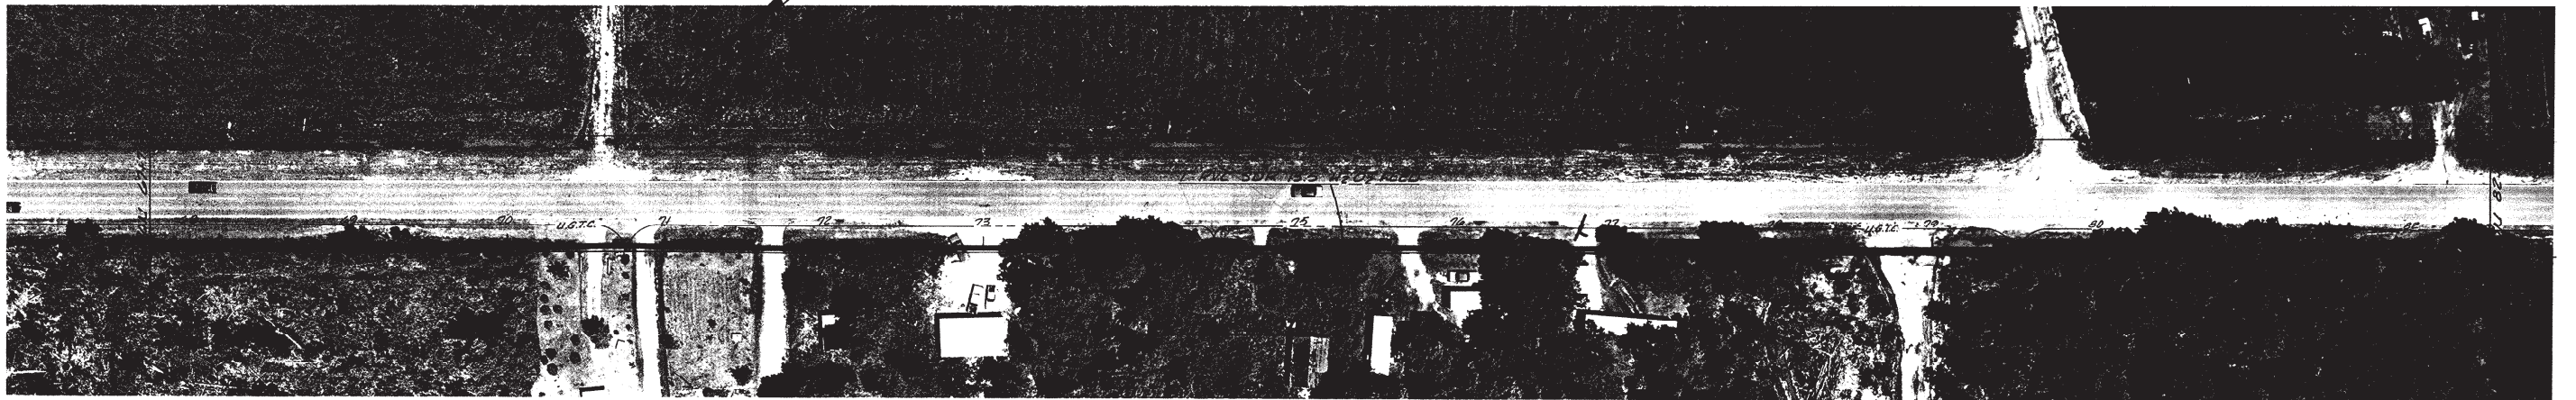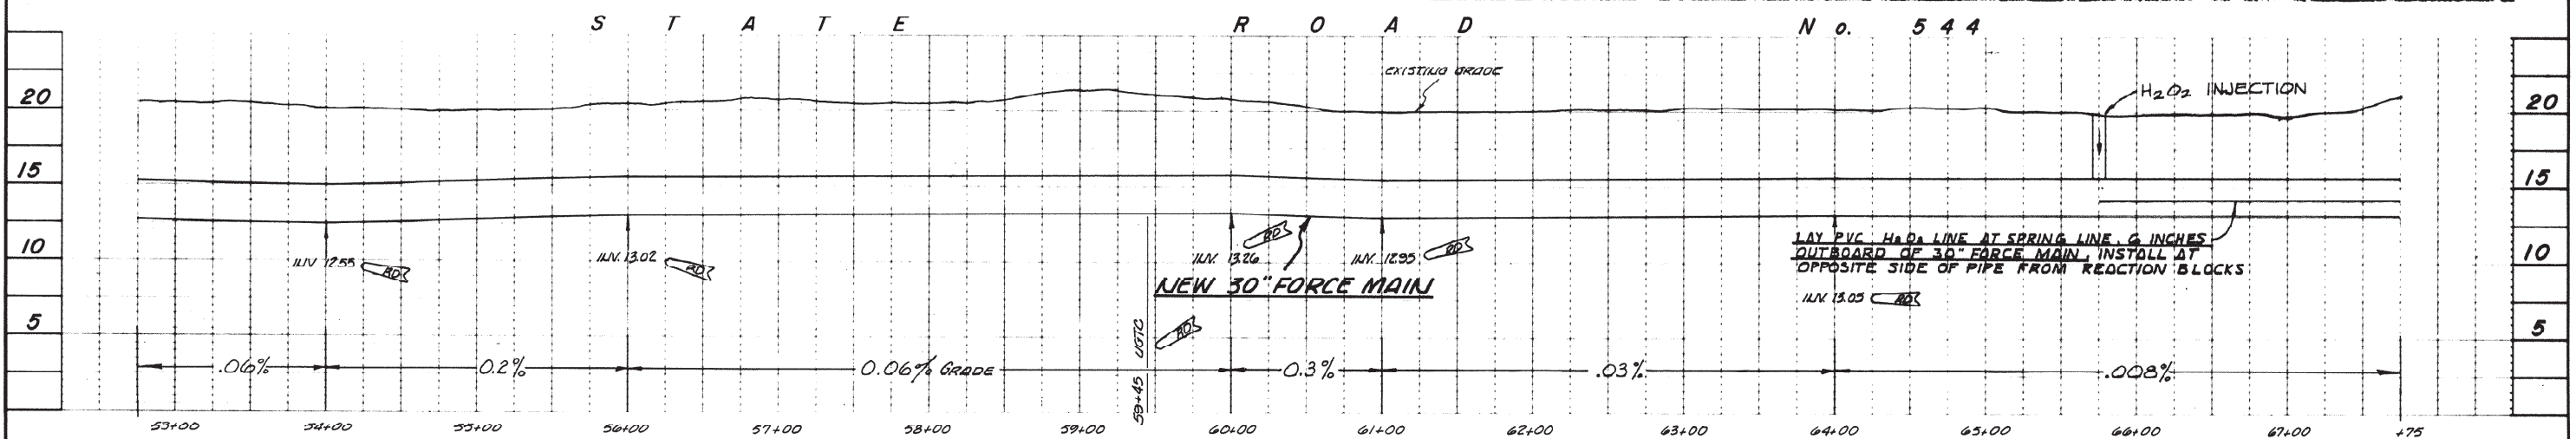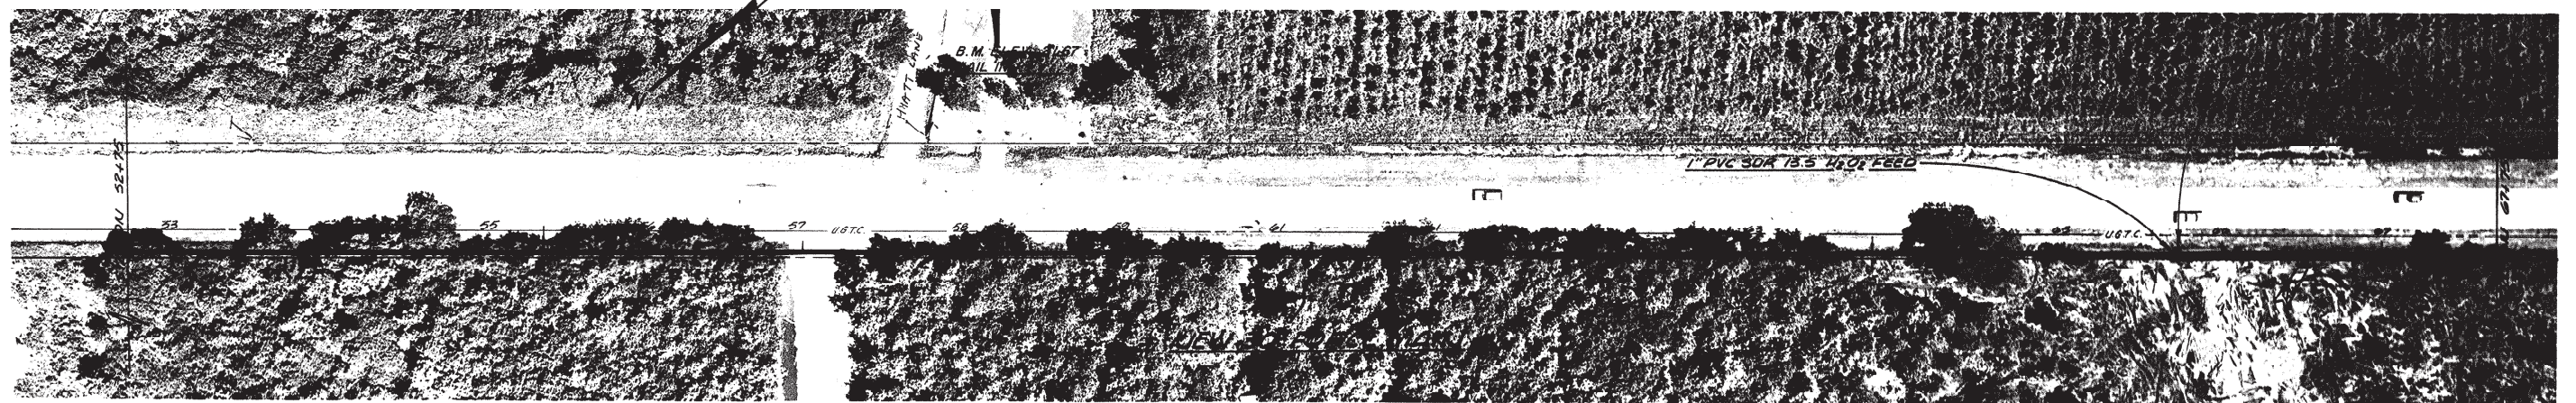

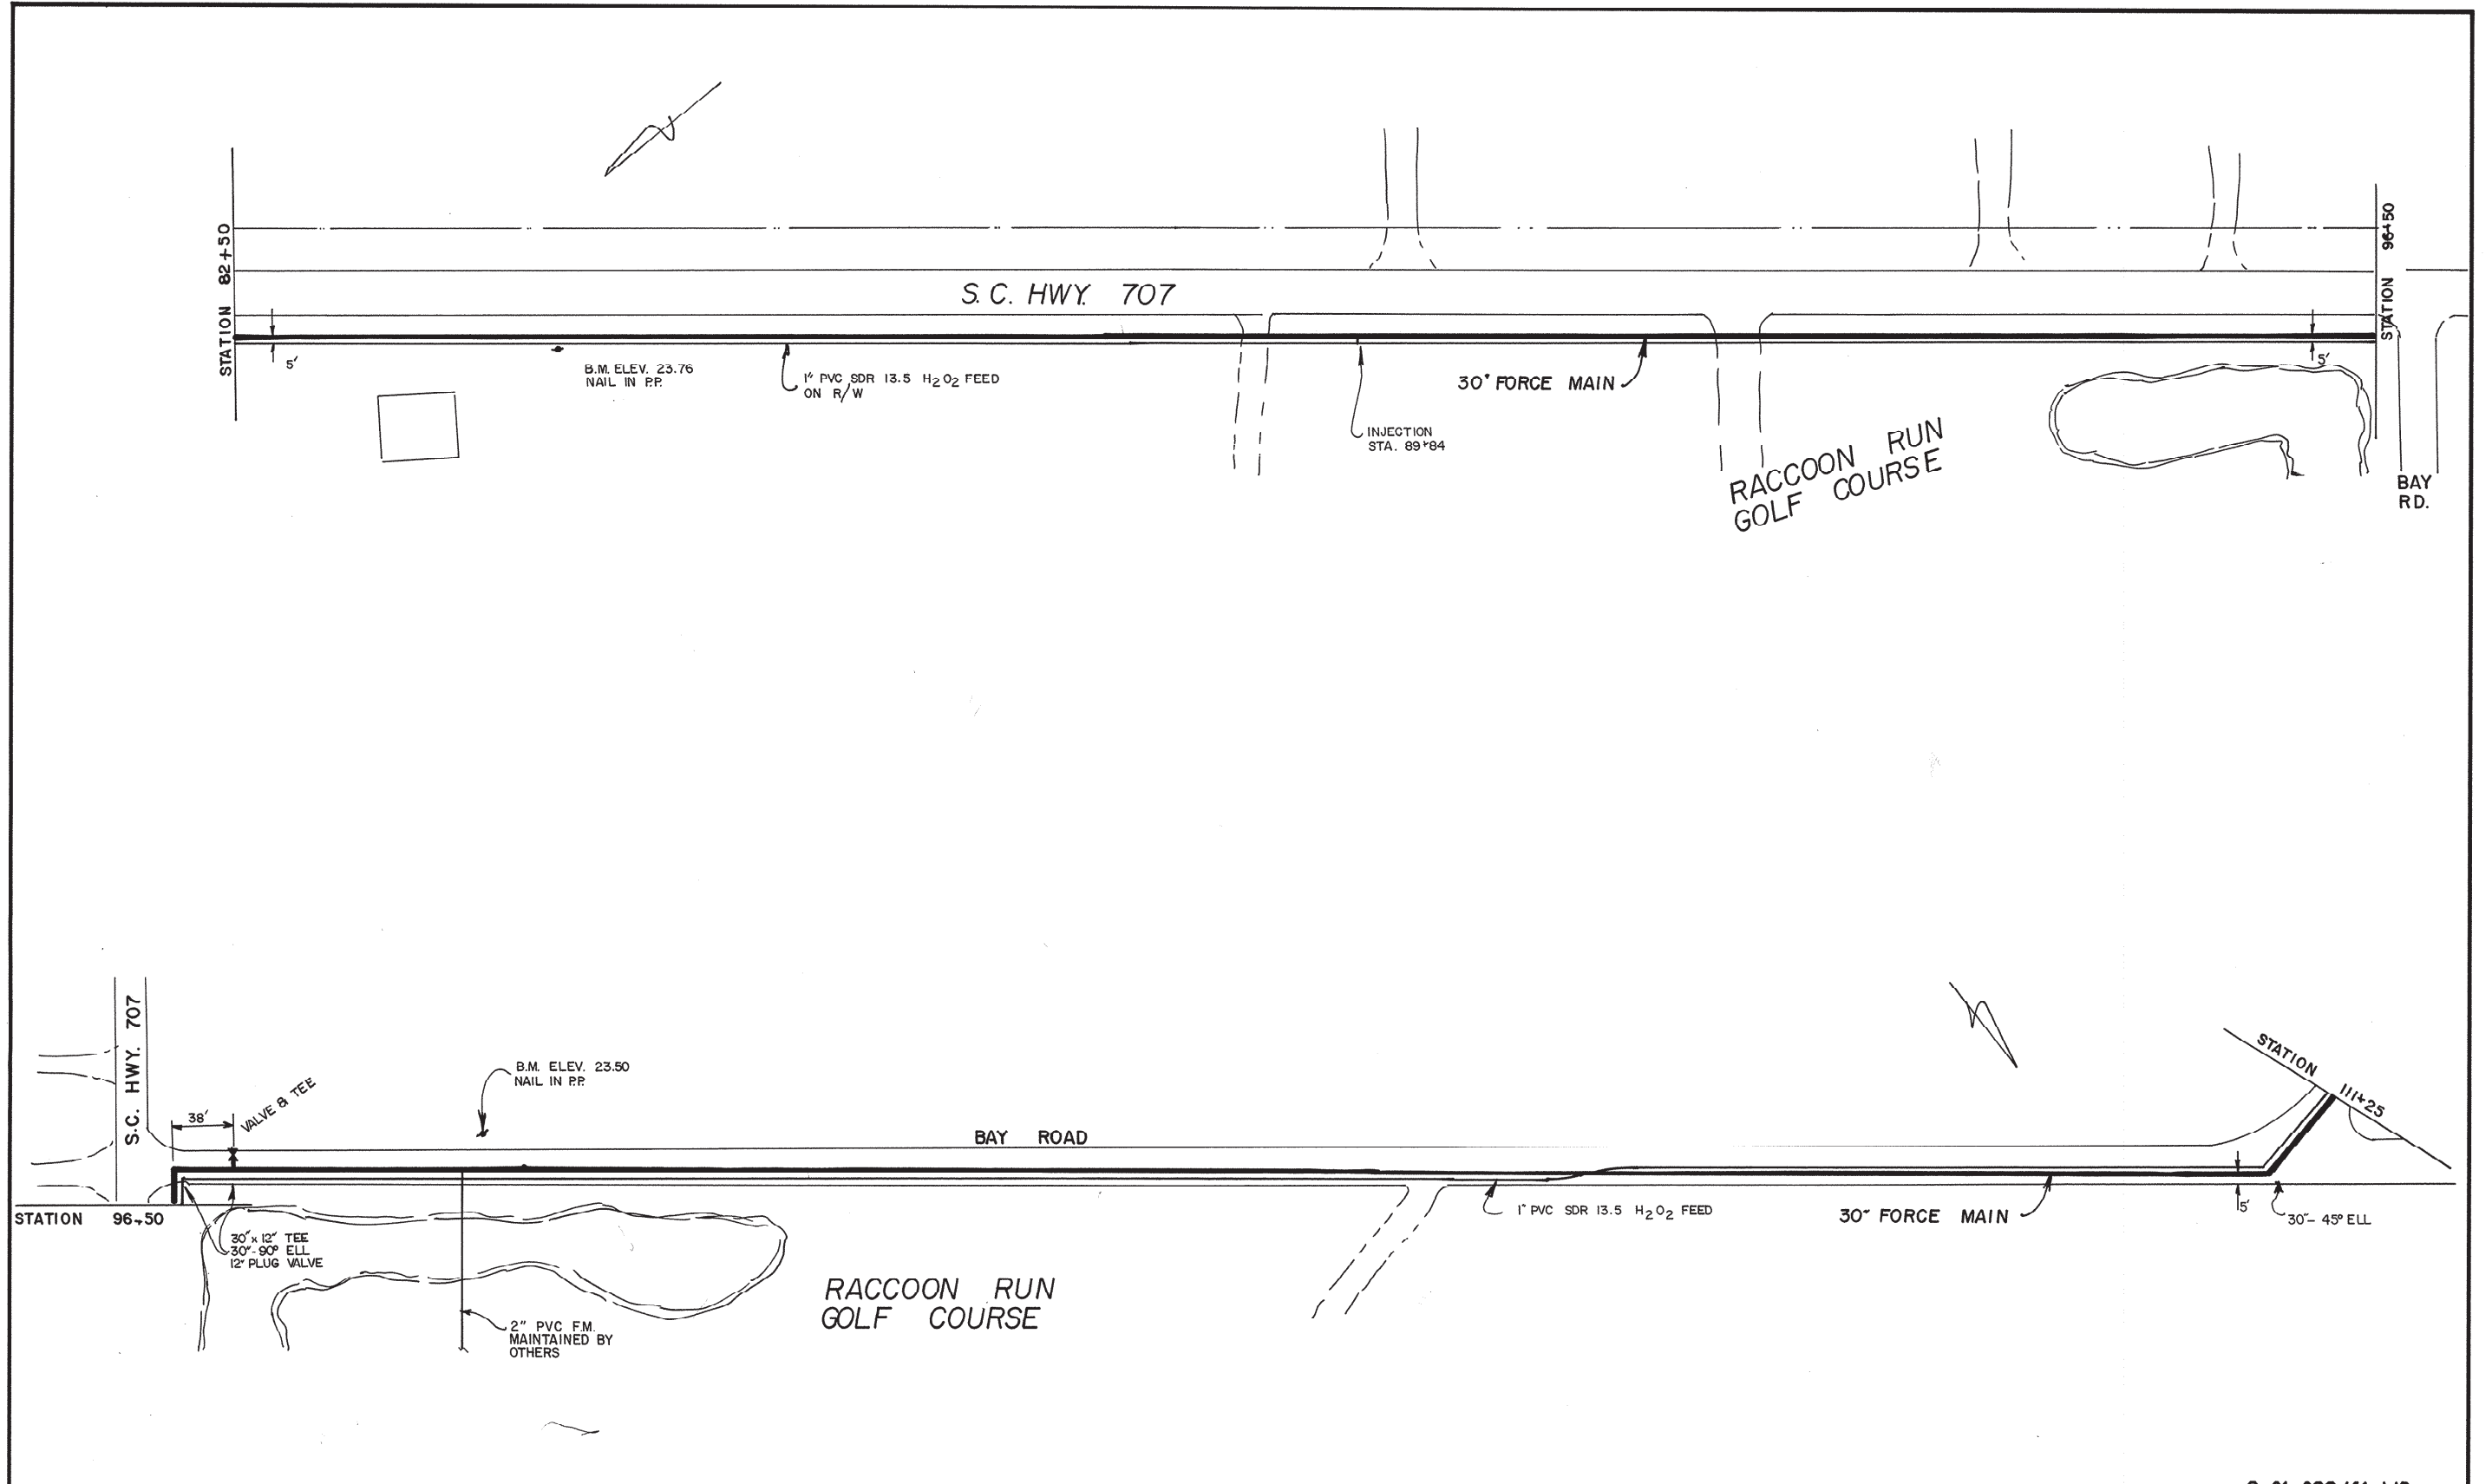

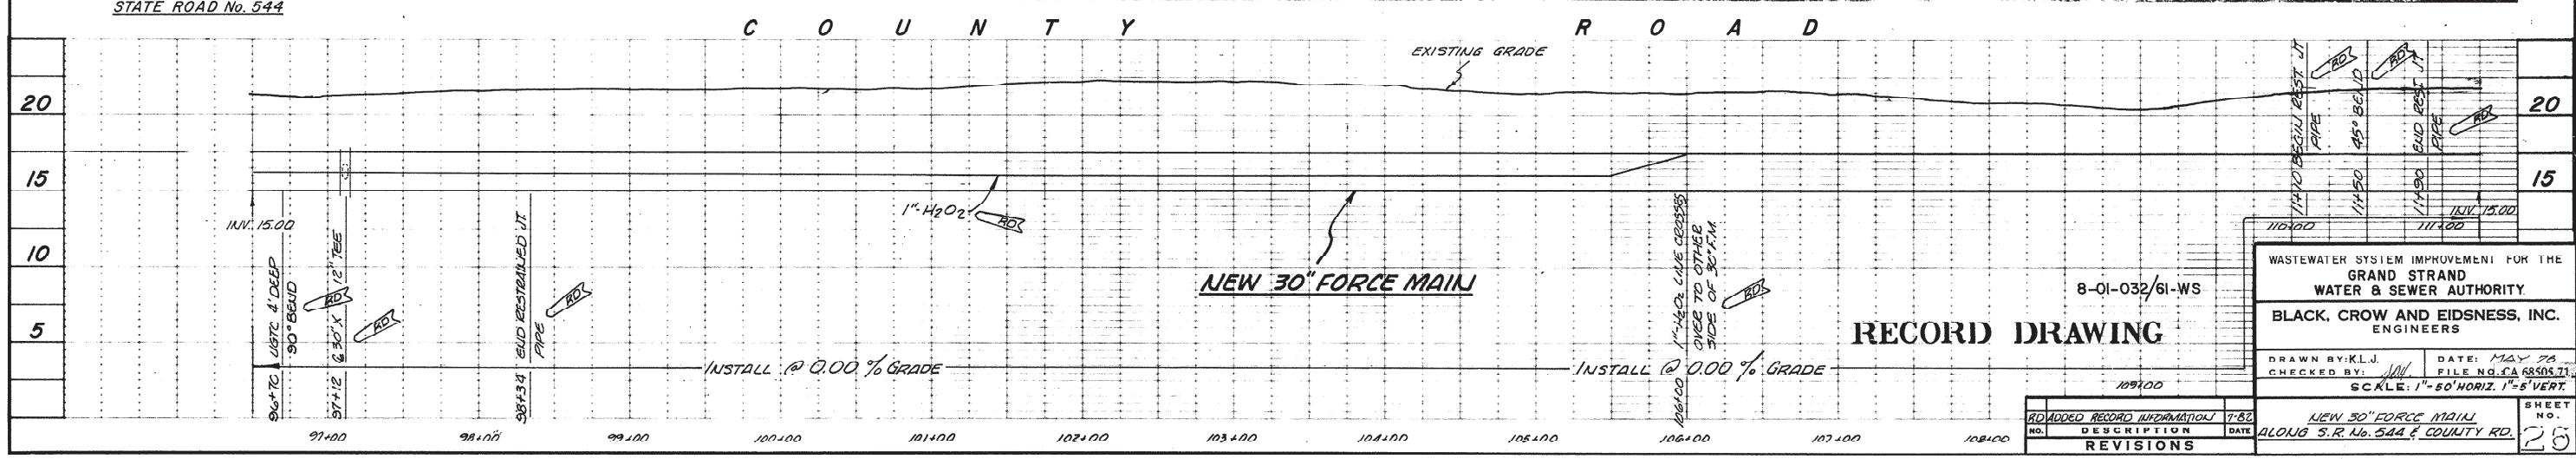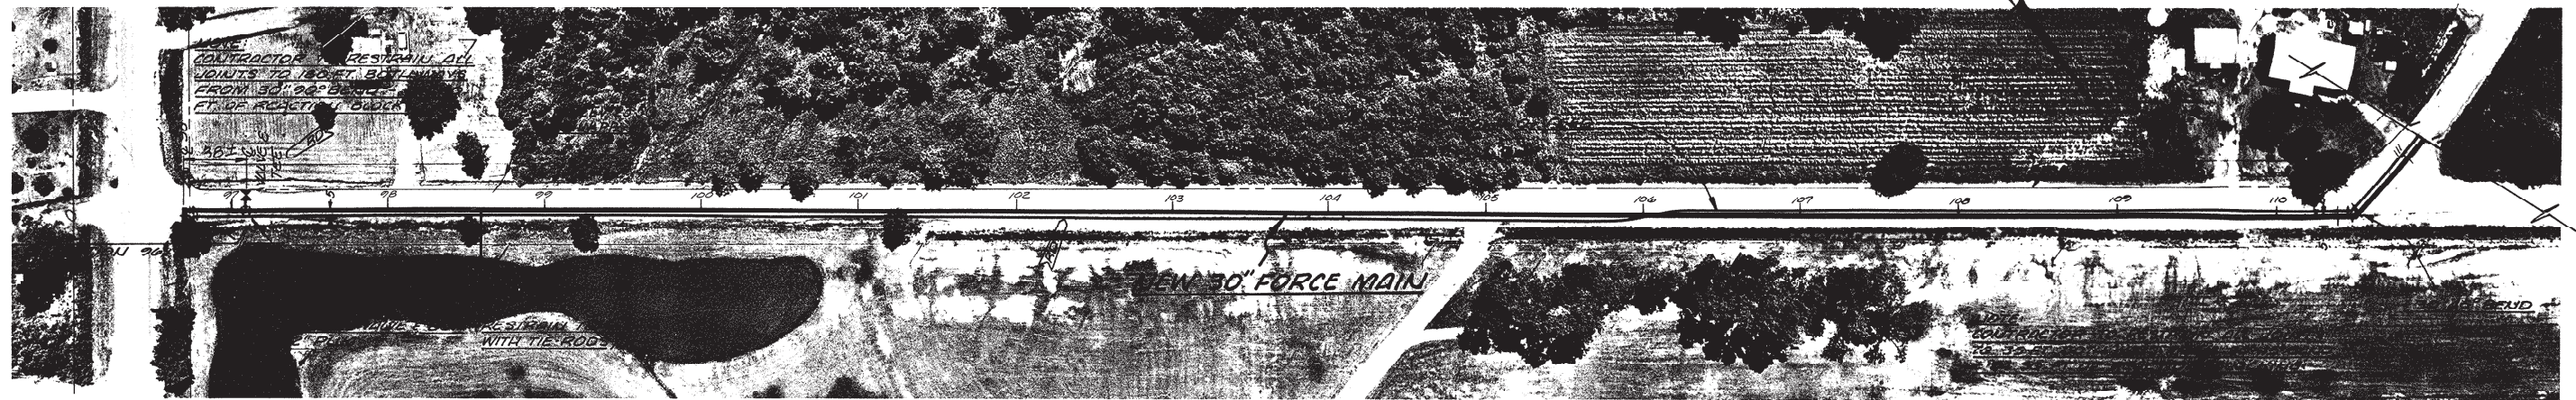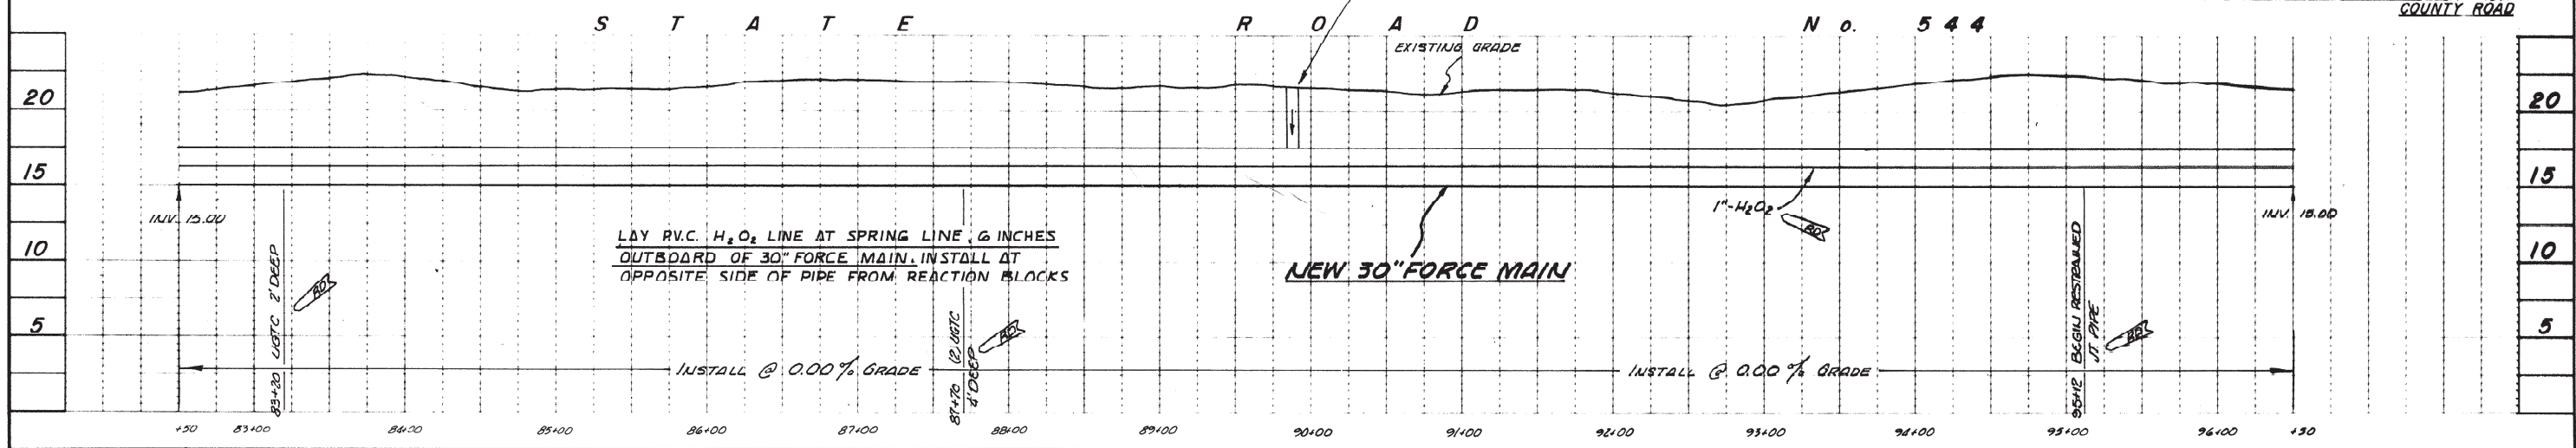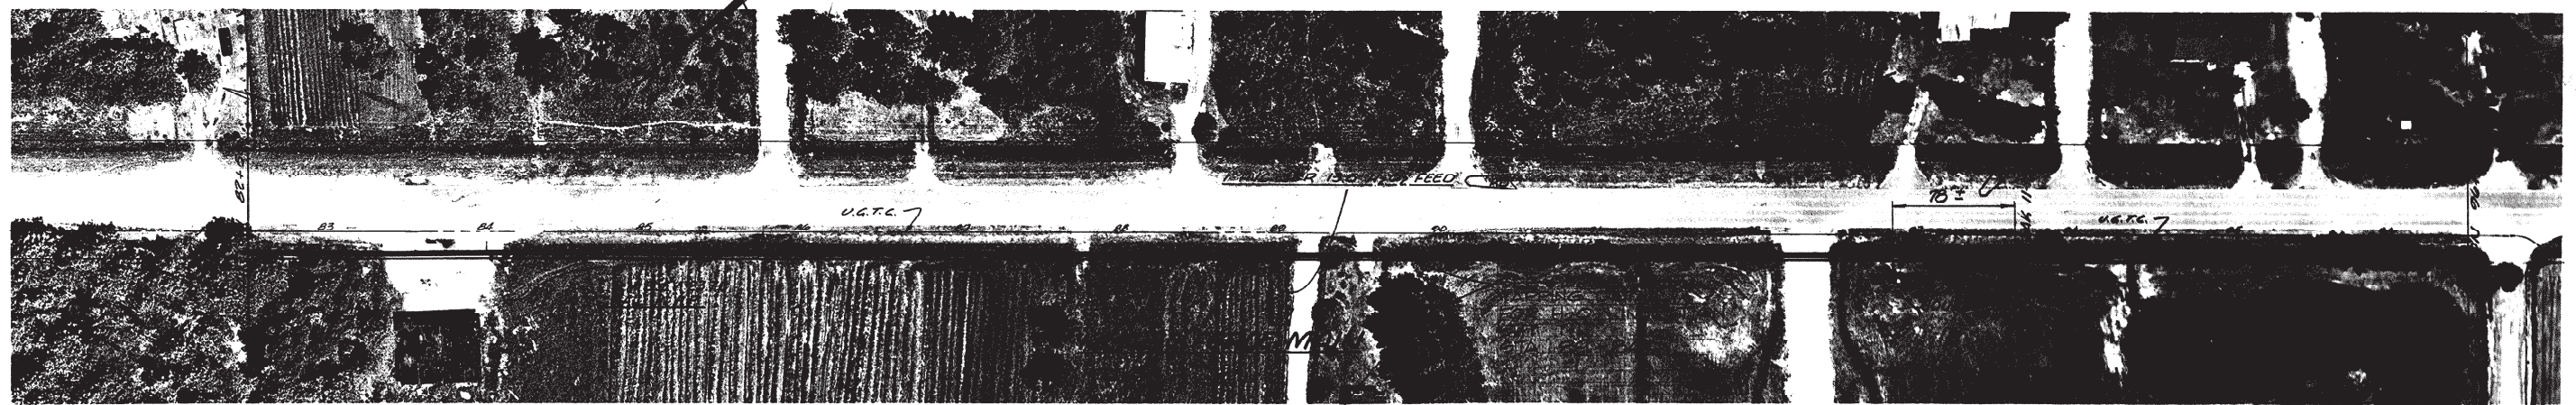

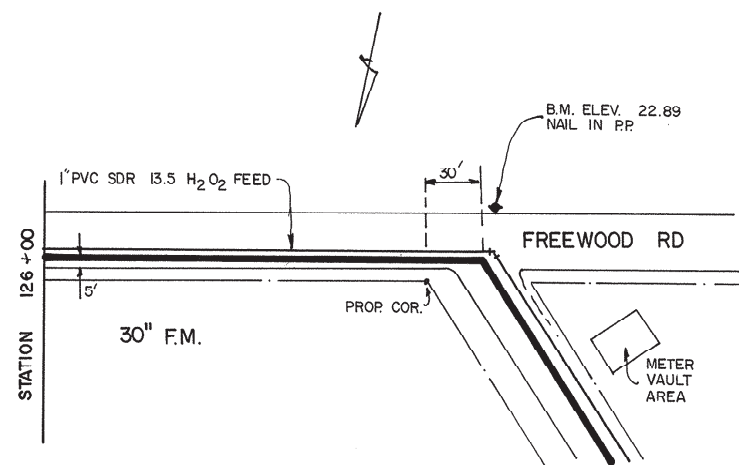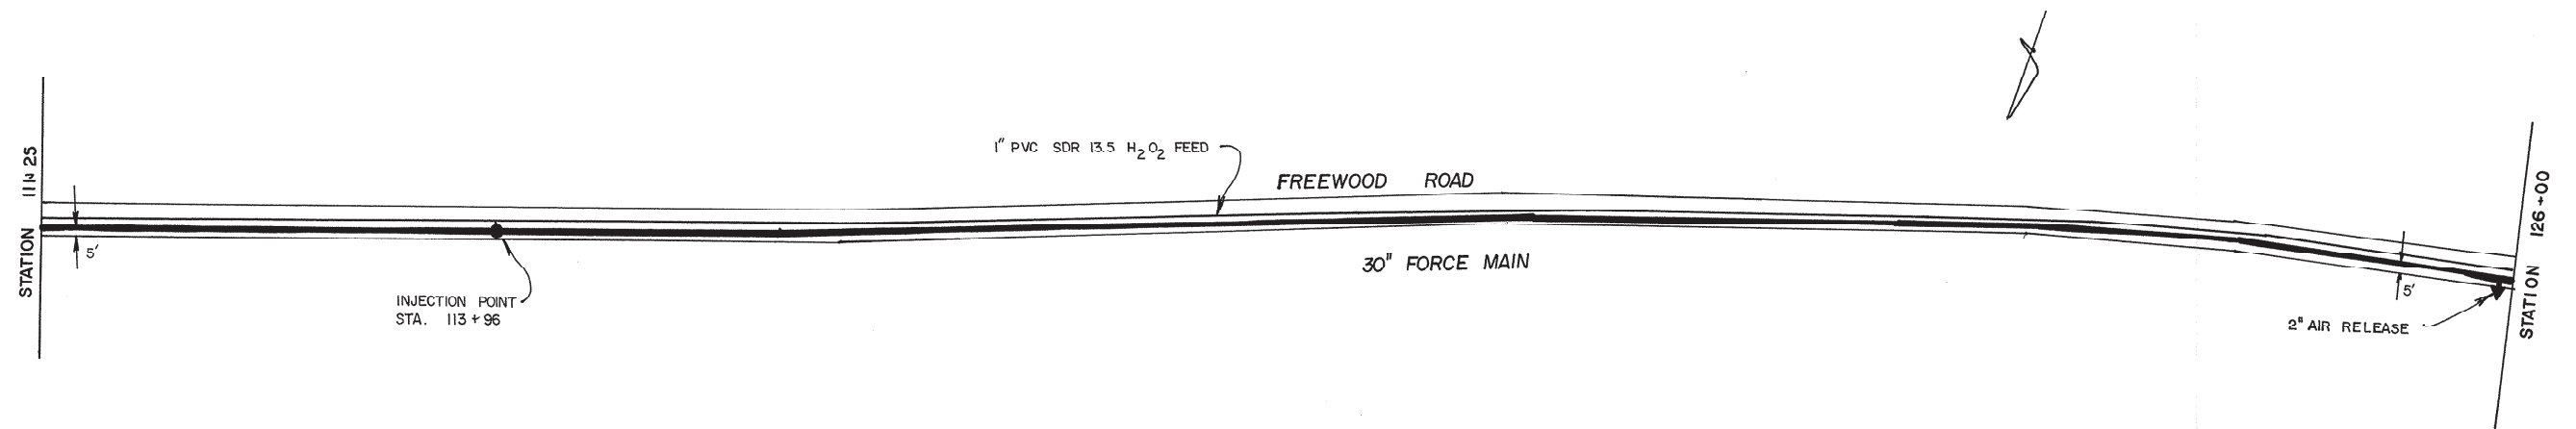

8-01-033/61-WS



This Drawing is a Tracing of an original design by Black, Crow and Eldsness. It has been traced by GSWSA to be Microfilmed.

No.	Date	REVISION	By	Appd.

GRAND STRAND
WATER & SEWER
AUTHORITY

201 SEWER SYSTEM

30" FORCE MAIN
ALONG COUNTY ROAD

SHEET
OF 27
DATE May-78
Traced 01-86
CA 68505.71
C 450381-05

