



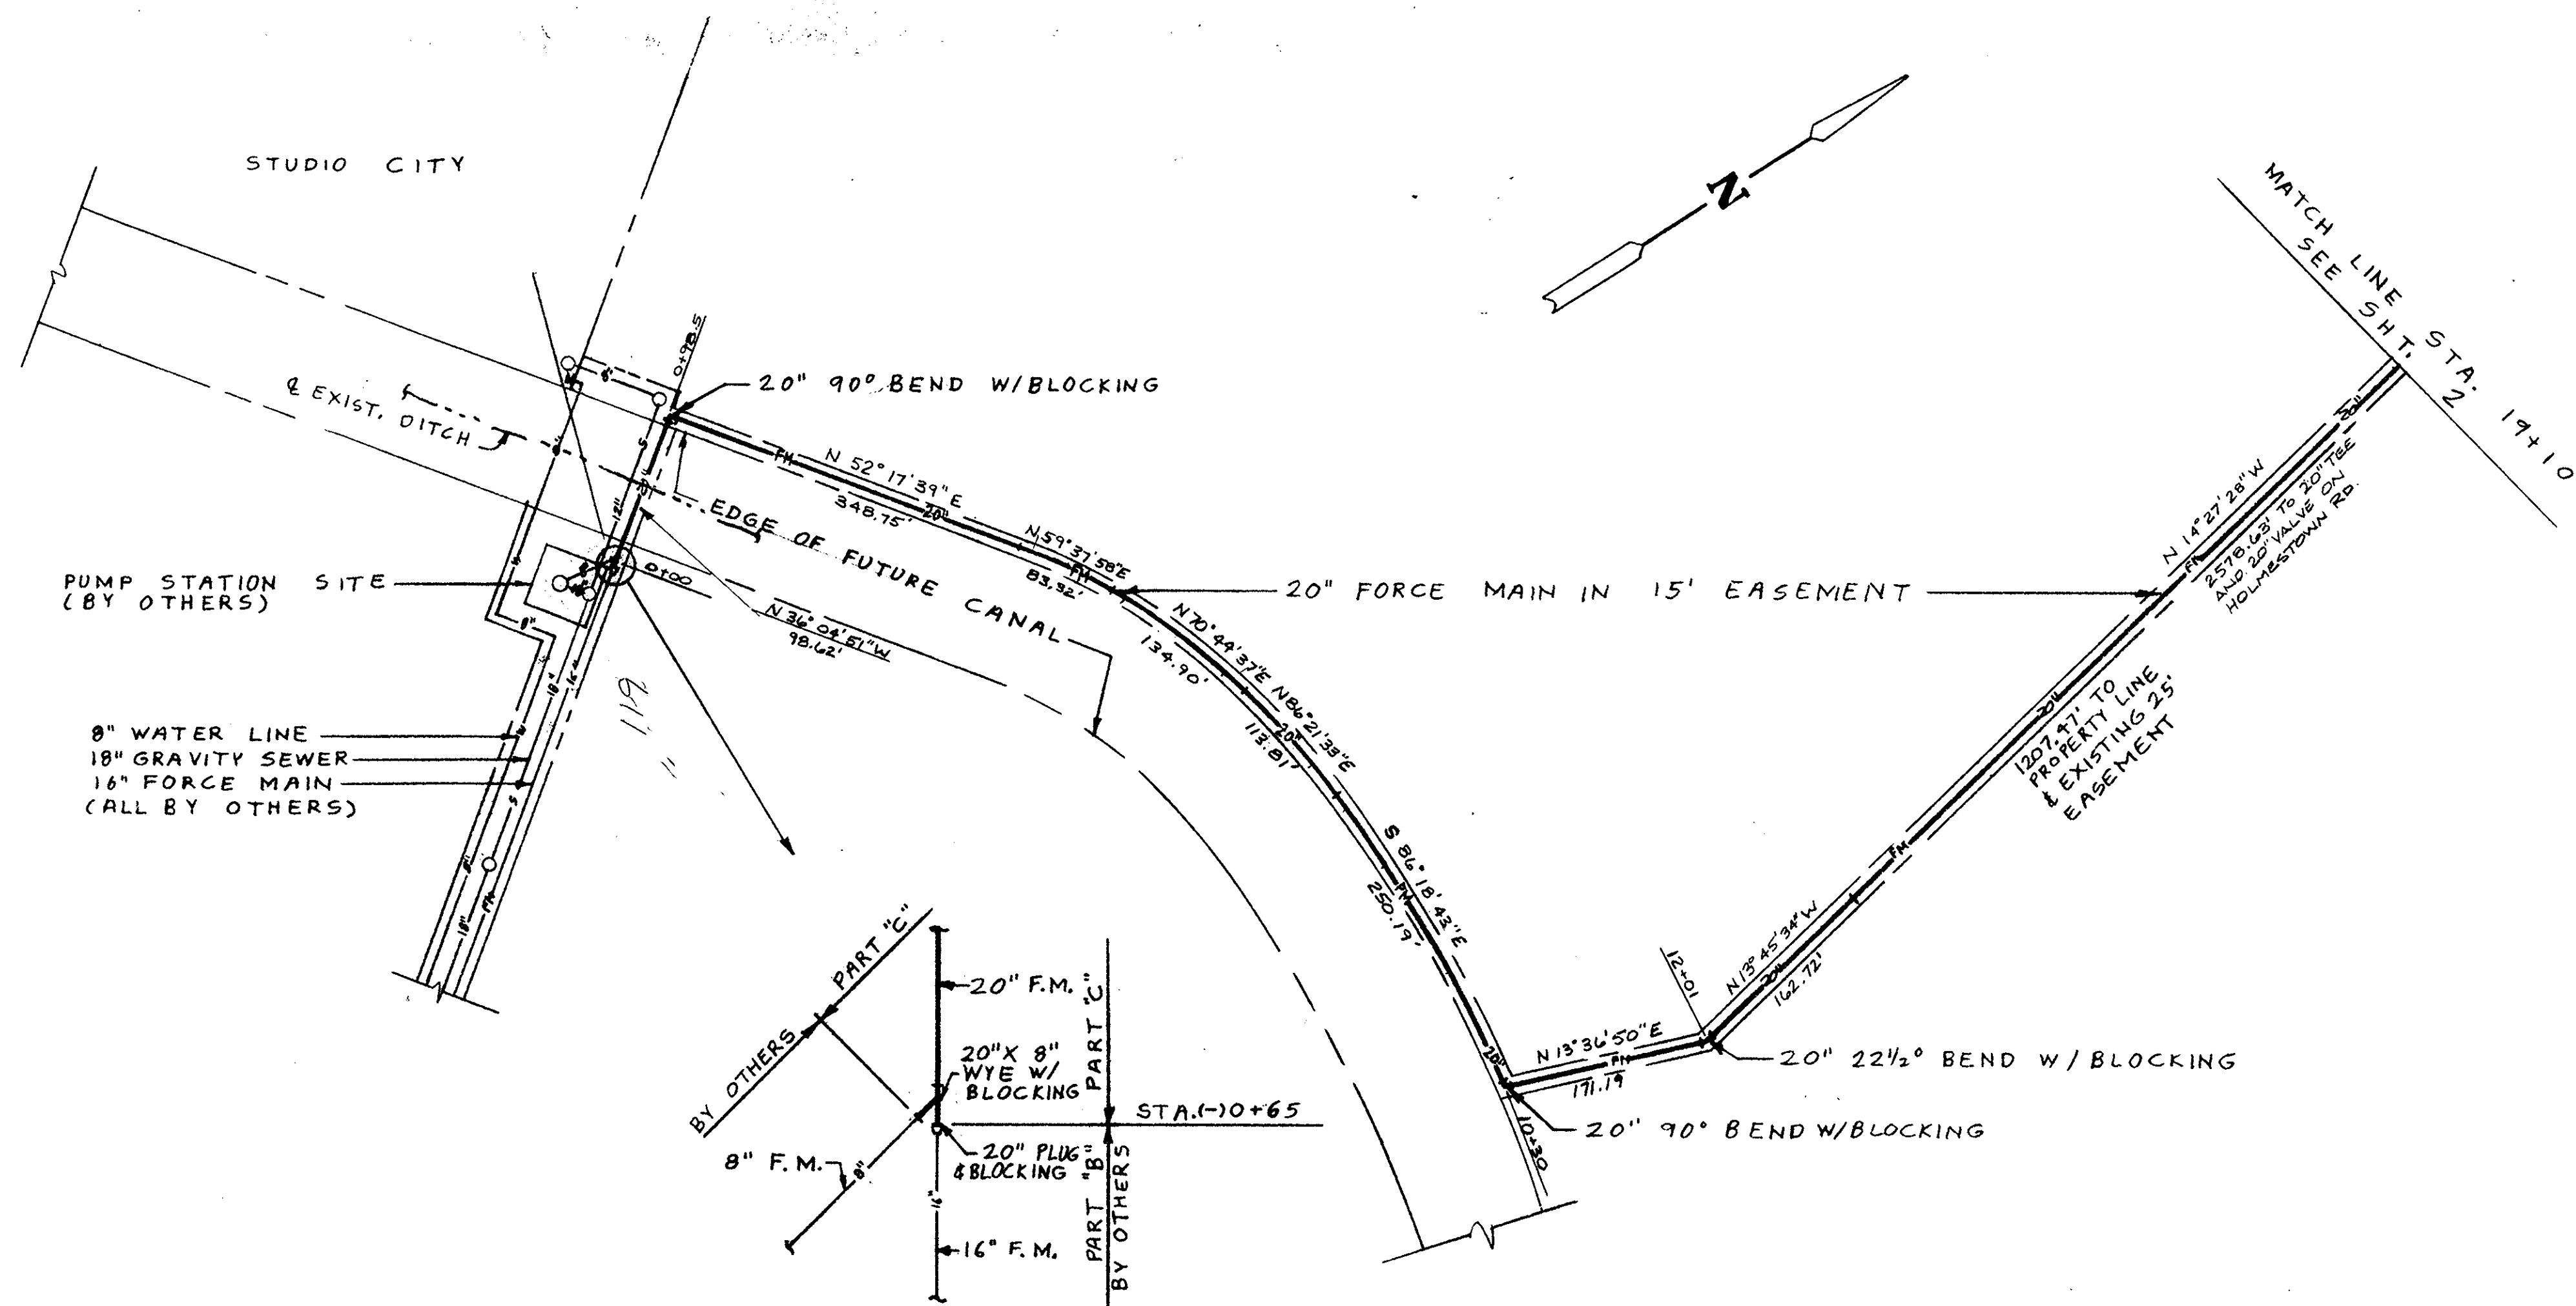



FORCE MAIN PLAN
SCALE: 1" = 100' UNO

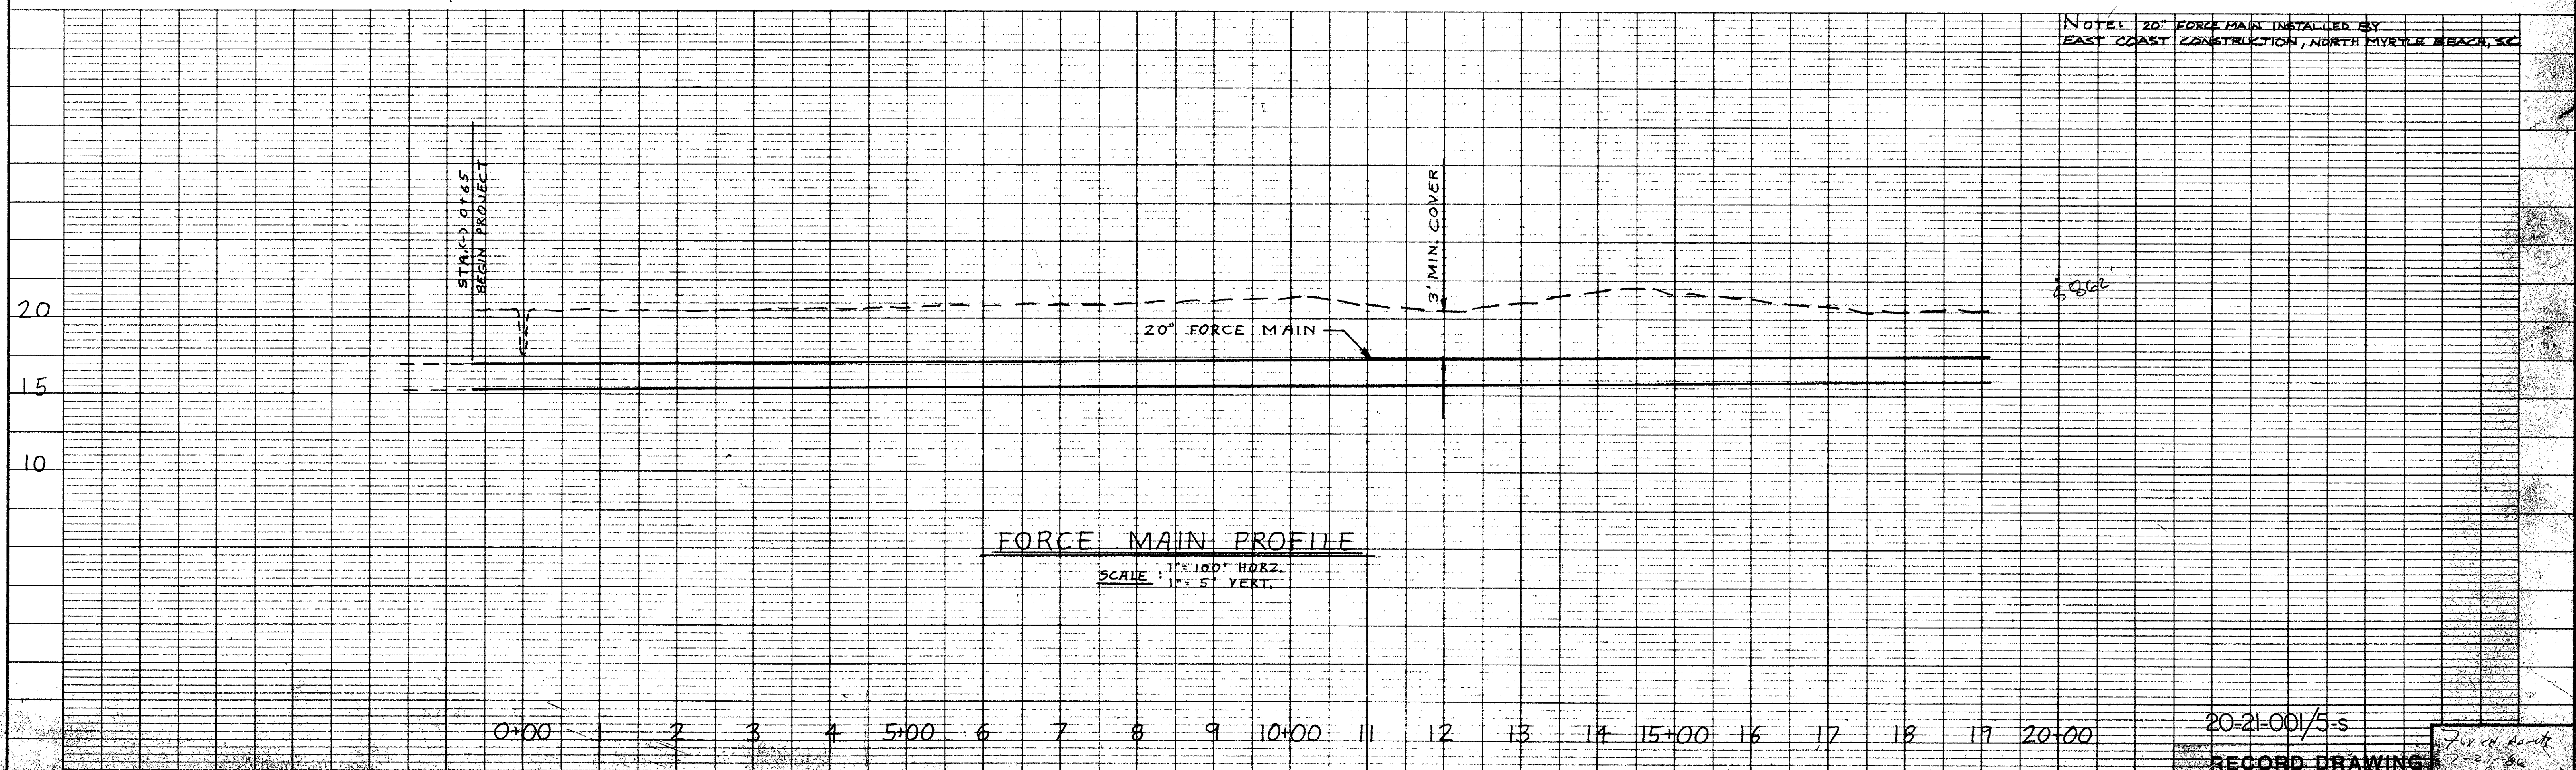

NOTE: 20" FORCE MAIN INSTALLED BY
EAST COAST CONSTRUCTION, NORTH MYRTLE BEACH, SC


PLAN	DATE	
	BY	
	SUPPLIED	
	NOTED	
NOTE BOOK GRADES CHECKED		
STRUCTURE NOTATIONS CHECKED		
No.		

PROFILE	DATE	
	BY	
	SUPPLIED	
	NOTED	
NOTE BOOK GRADES CHECKED		
STRUCTURE NOTATIONS CHECKED		
No.		

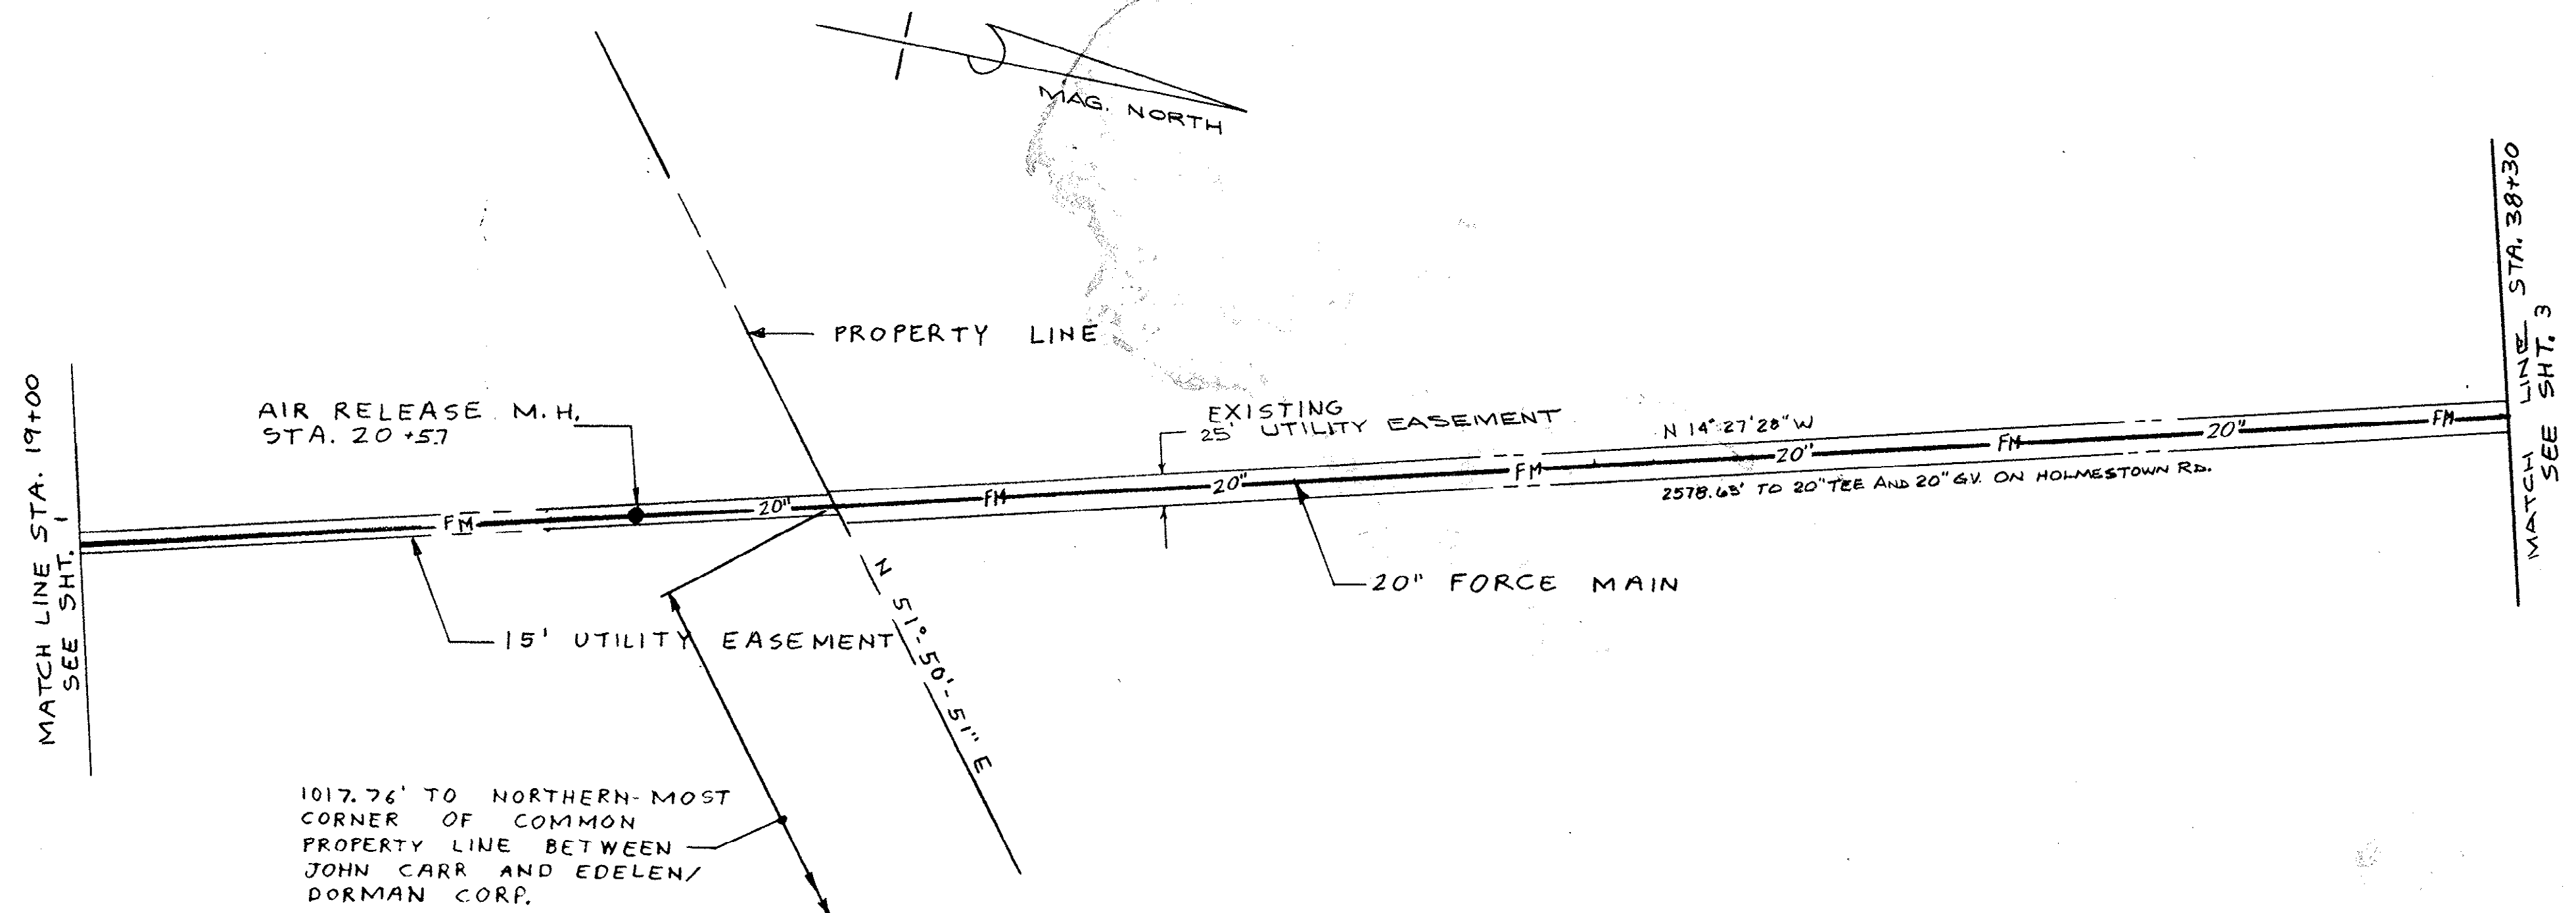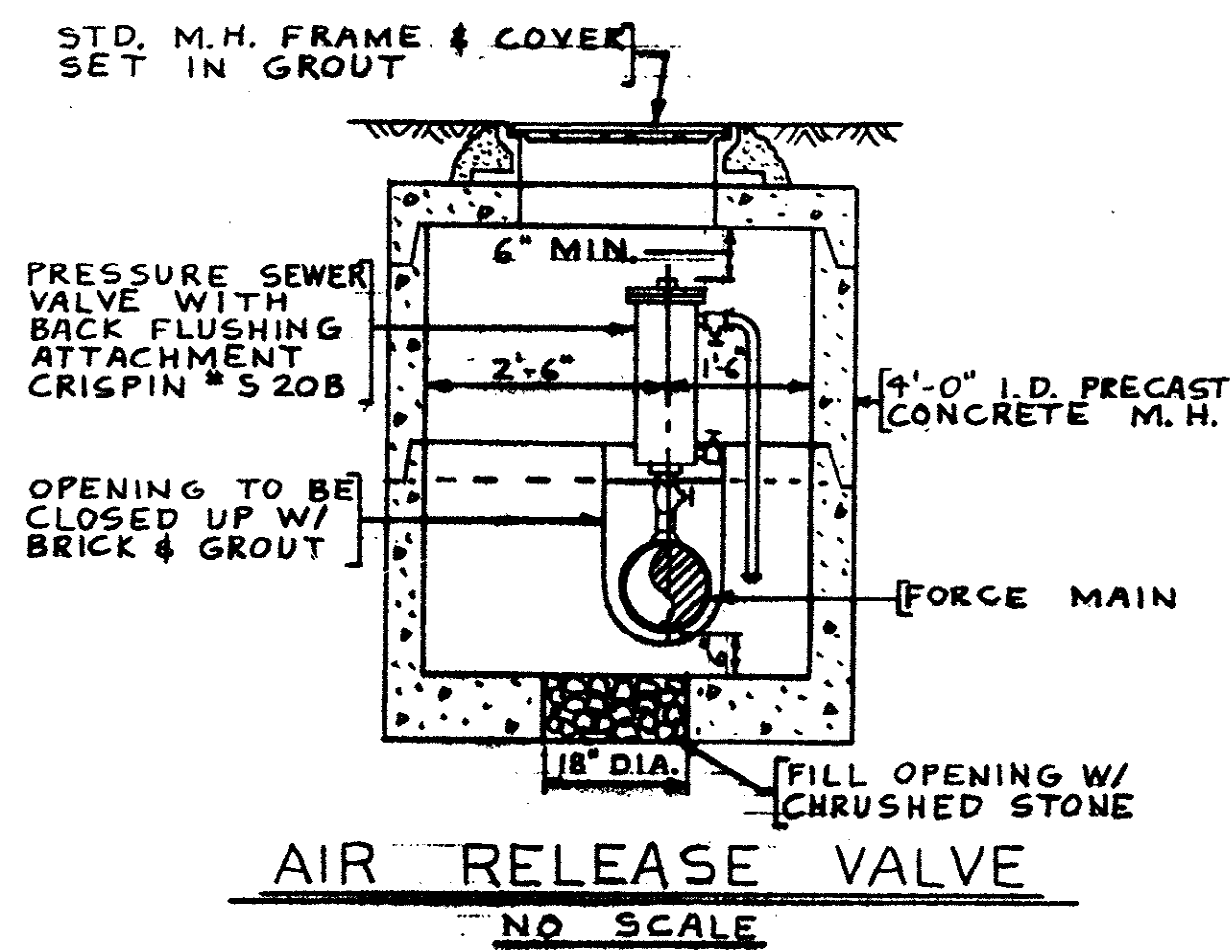

FORCE MAIN PLAN
SCALE 1"=100' HORIZ

FORCE MAIN PLAN & PROFILE
BASED ON A SURVEY BY
RAGSDALE CONSULTANTS, P.A.

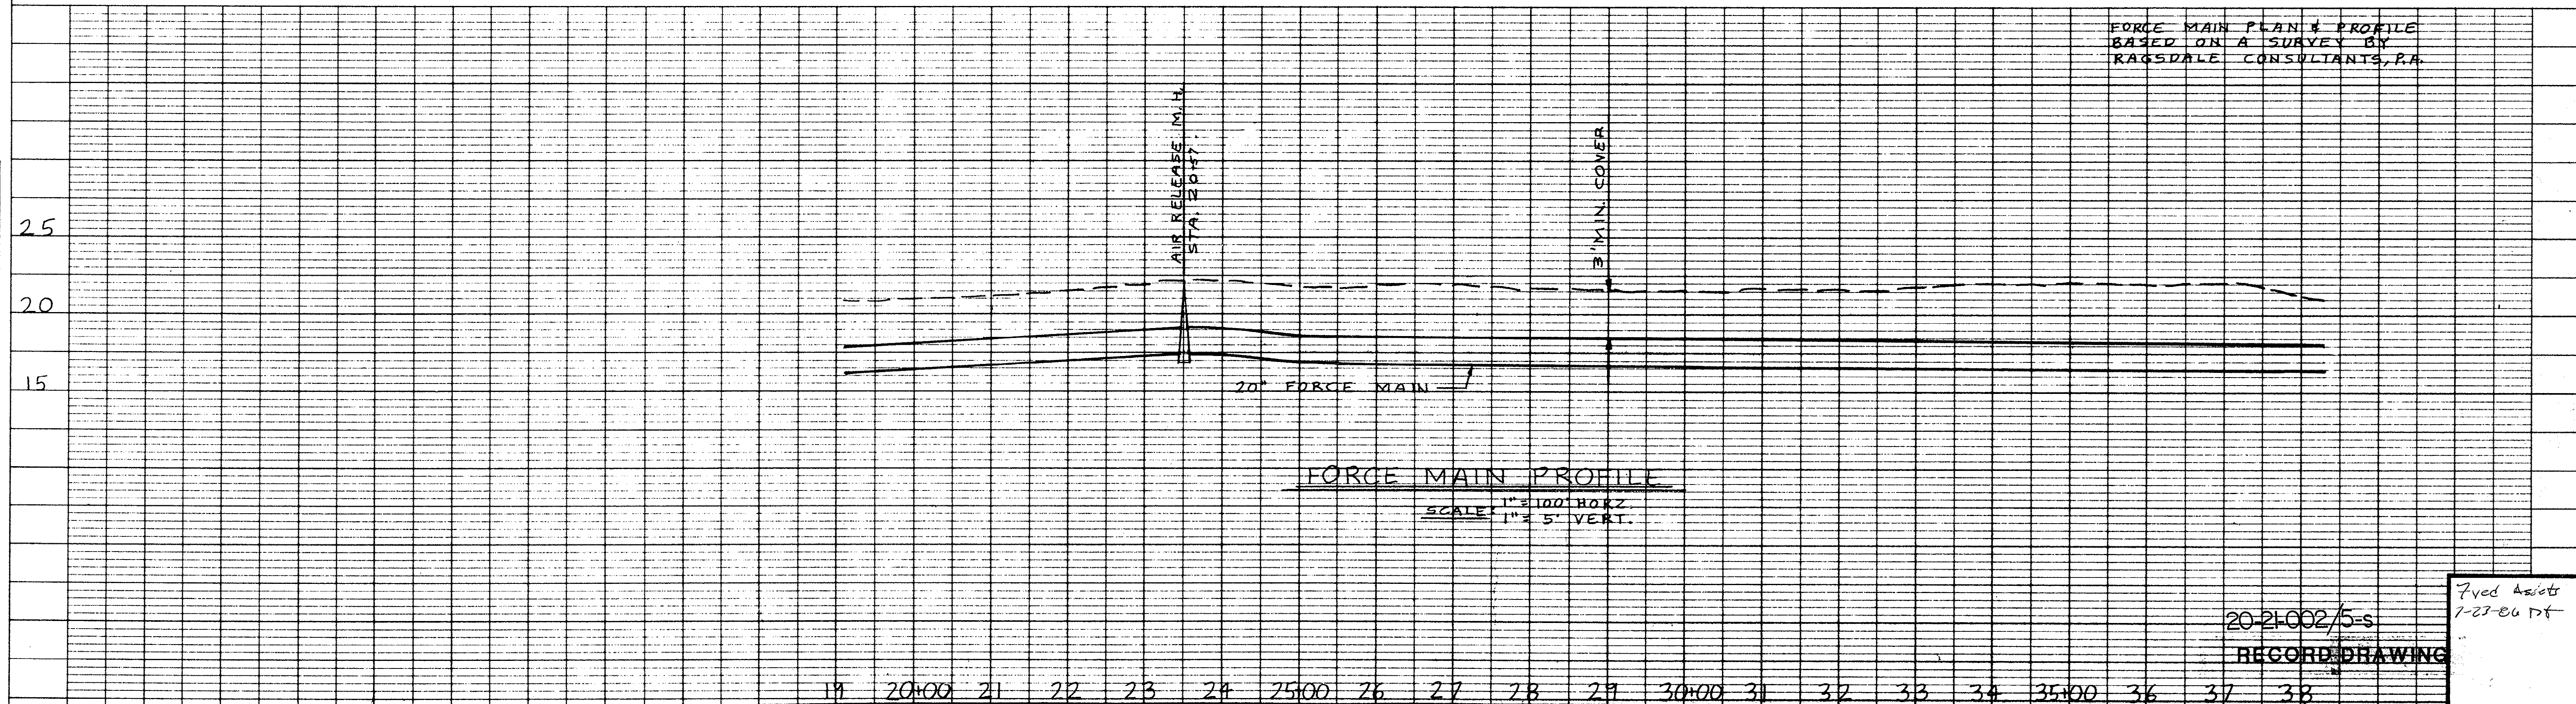

**GLENN'S BAY AREA FORCE MAIN
PART "C"**

ROBERT L. BELLAMY AND ASSOCIATES, Inc.
CONSULTING ENGINEERS AND LAND SURVEYORS
MYRTLE BEACH, SOUTH CAROLINA

SCALE NOTED
REVISIONS CHANGE TO 20"
9/13/88

SYMB

DRAWN BY TCH

CHECKED BY

DATE MAY 14, 1985


SHEET 2 OF 5

7 yed Assist
1-27-86 DT

20-21-002/5-S


RECORD DRAWING

PLAN	DATE	BY
	SURVEYED	PLOTTED
	NOTE BOOK	ALIGNMENT CHECKED
	No.	RE. OF WAY CHECKED

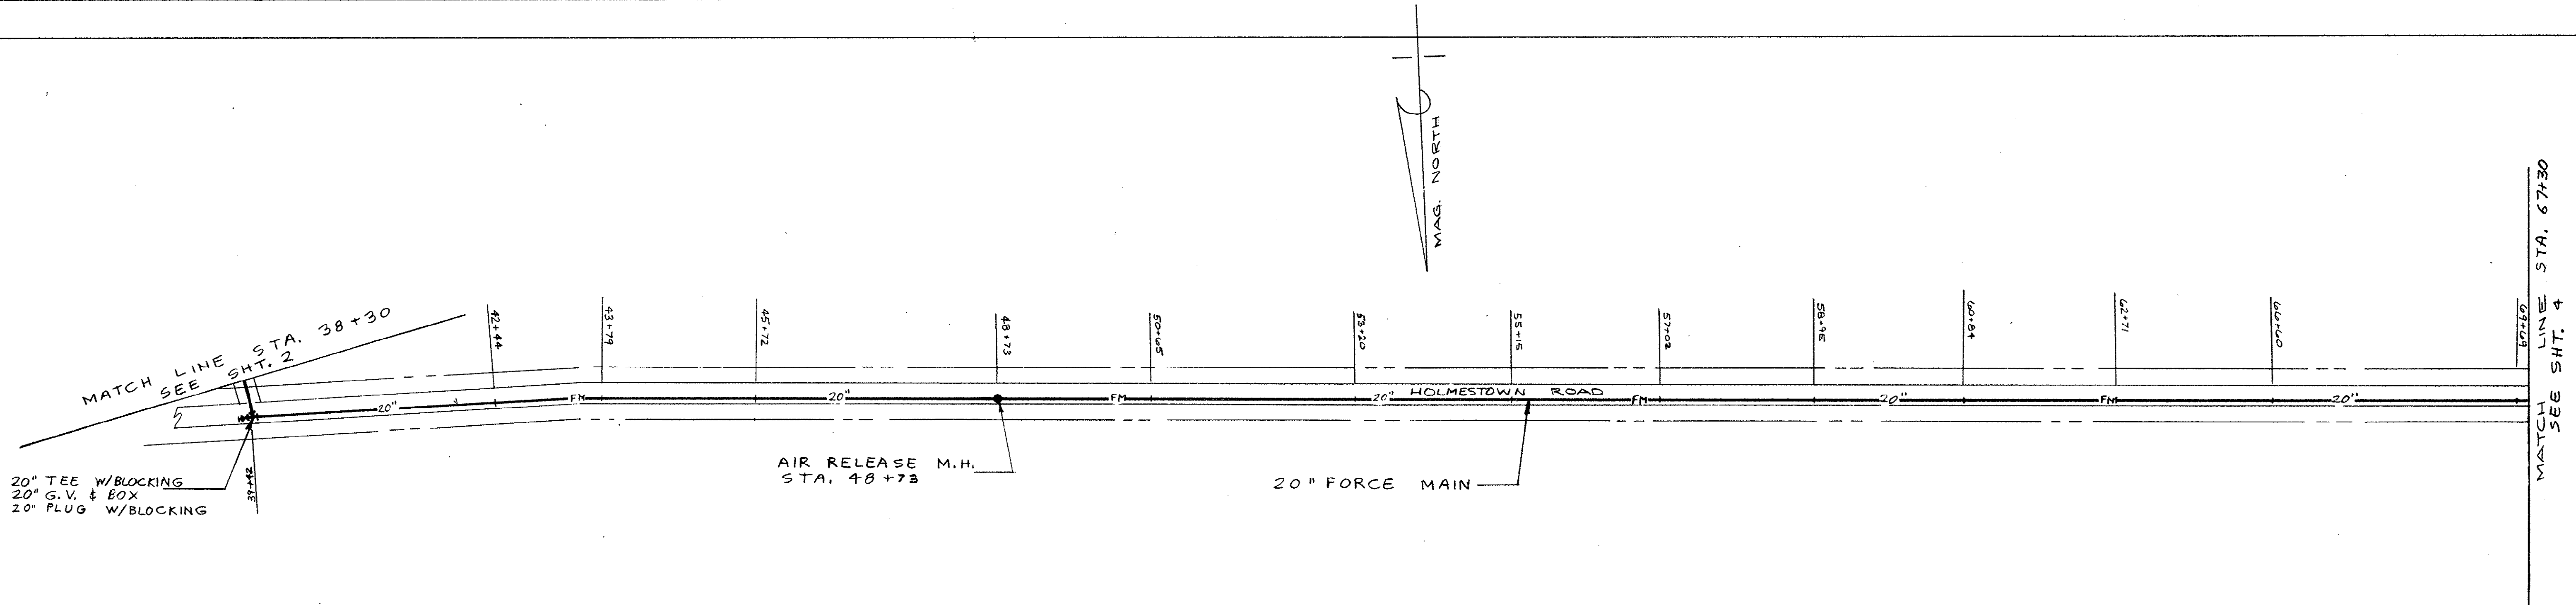

FORCE MAIN PLAN
SCALE 1" = 100' UNO

PROFILE	DATE	BY
	SURVEYED	PLOTTED
	NOTE BOOK	GRADES CHECKED
	No.	SECTION NOTATIONS CHECKED

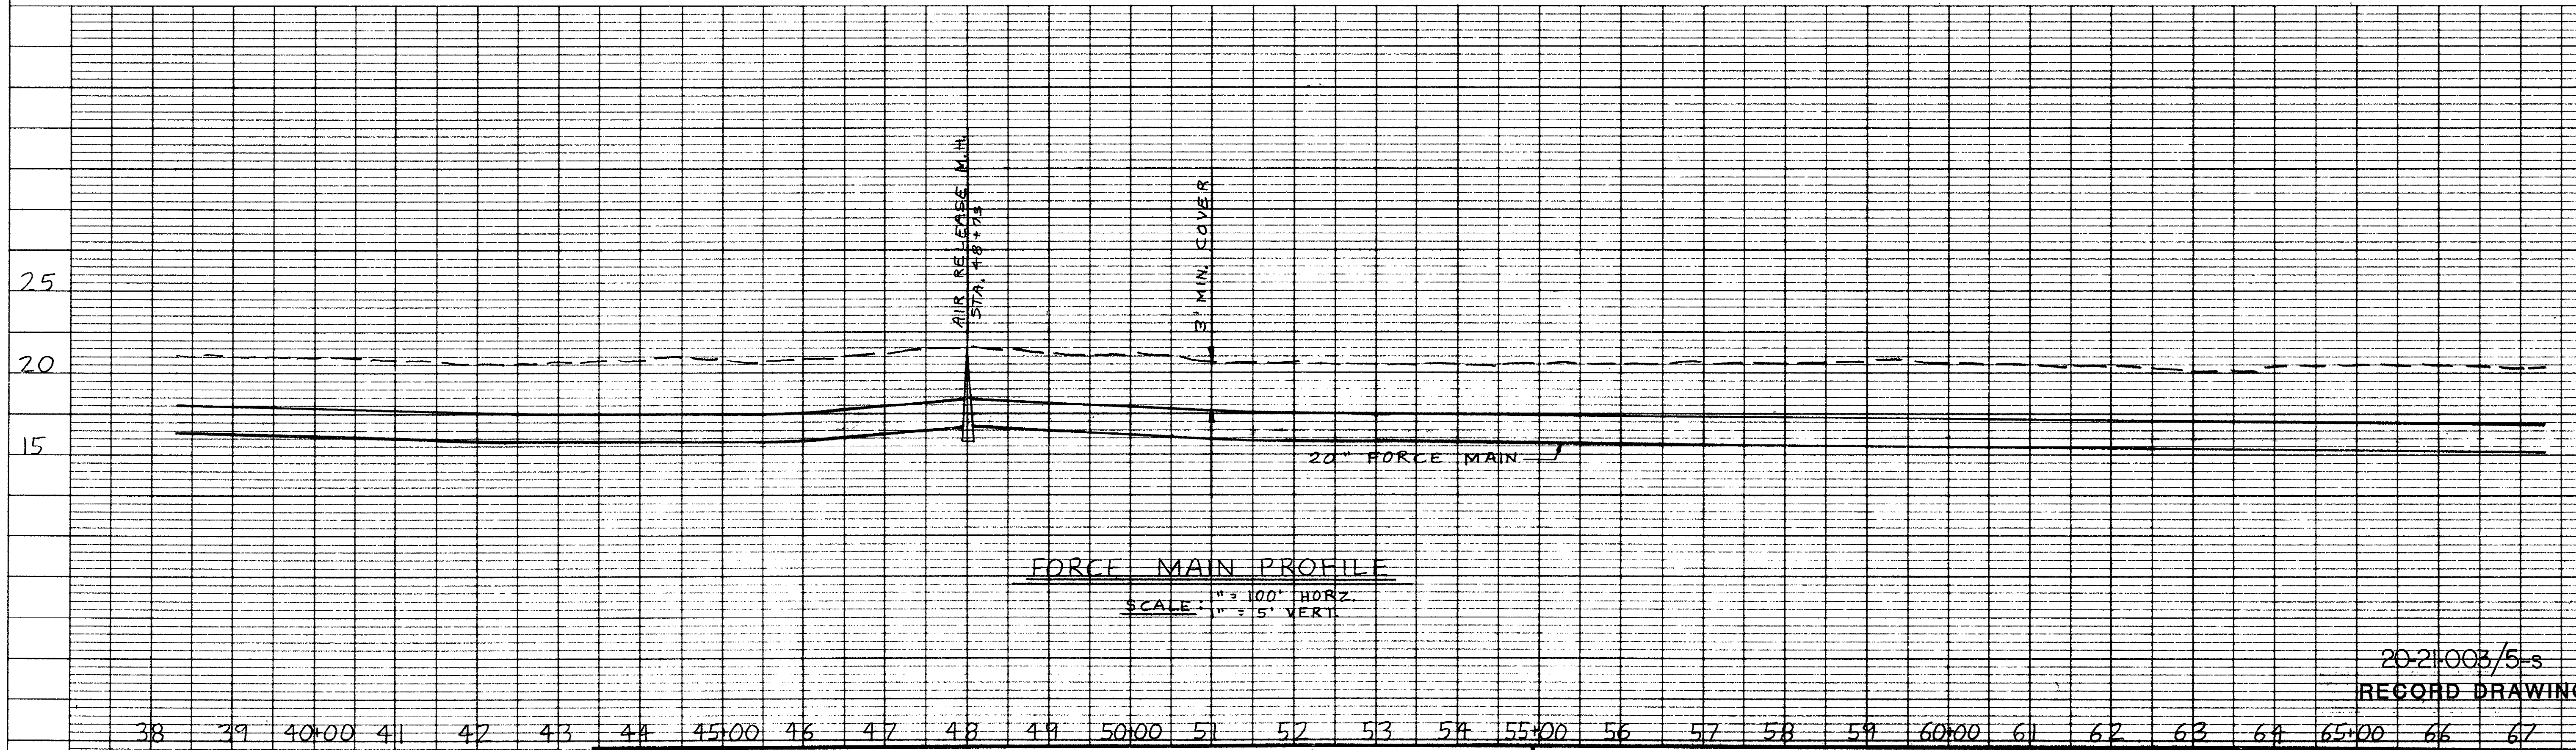

**GLENN'S BAY AREA FORCE MAIN
PART "C"**

ROBERT L. BELLAMY AND ASSOCIATES, Inc.
CONSULTING ENGINEERS AND LAND SURVEYORS
MYRTLE BEACH, SOUTH CAROLINA

SCALE NOTED
REVISIONS CHANGE TO 20"
9/15/84

SYMB
DRAWN BY TPH
CHECKED BY
DATE MAY 14, 1985

20-21003/5-s
RECORD DRAWING
FIXED ASSEMBLY
1-65 BIG SET

PROFILE NOTE BOOK No. _____	SURVEYED _____ PLOTTED _____ GRADES CHECKED _____ B. M.'s NOTED _____	BY _____ DATE _____
--	--	------------------------

