


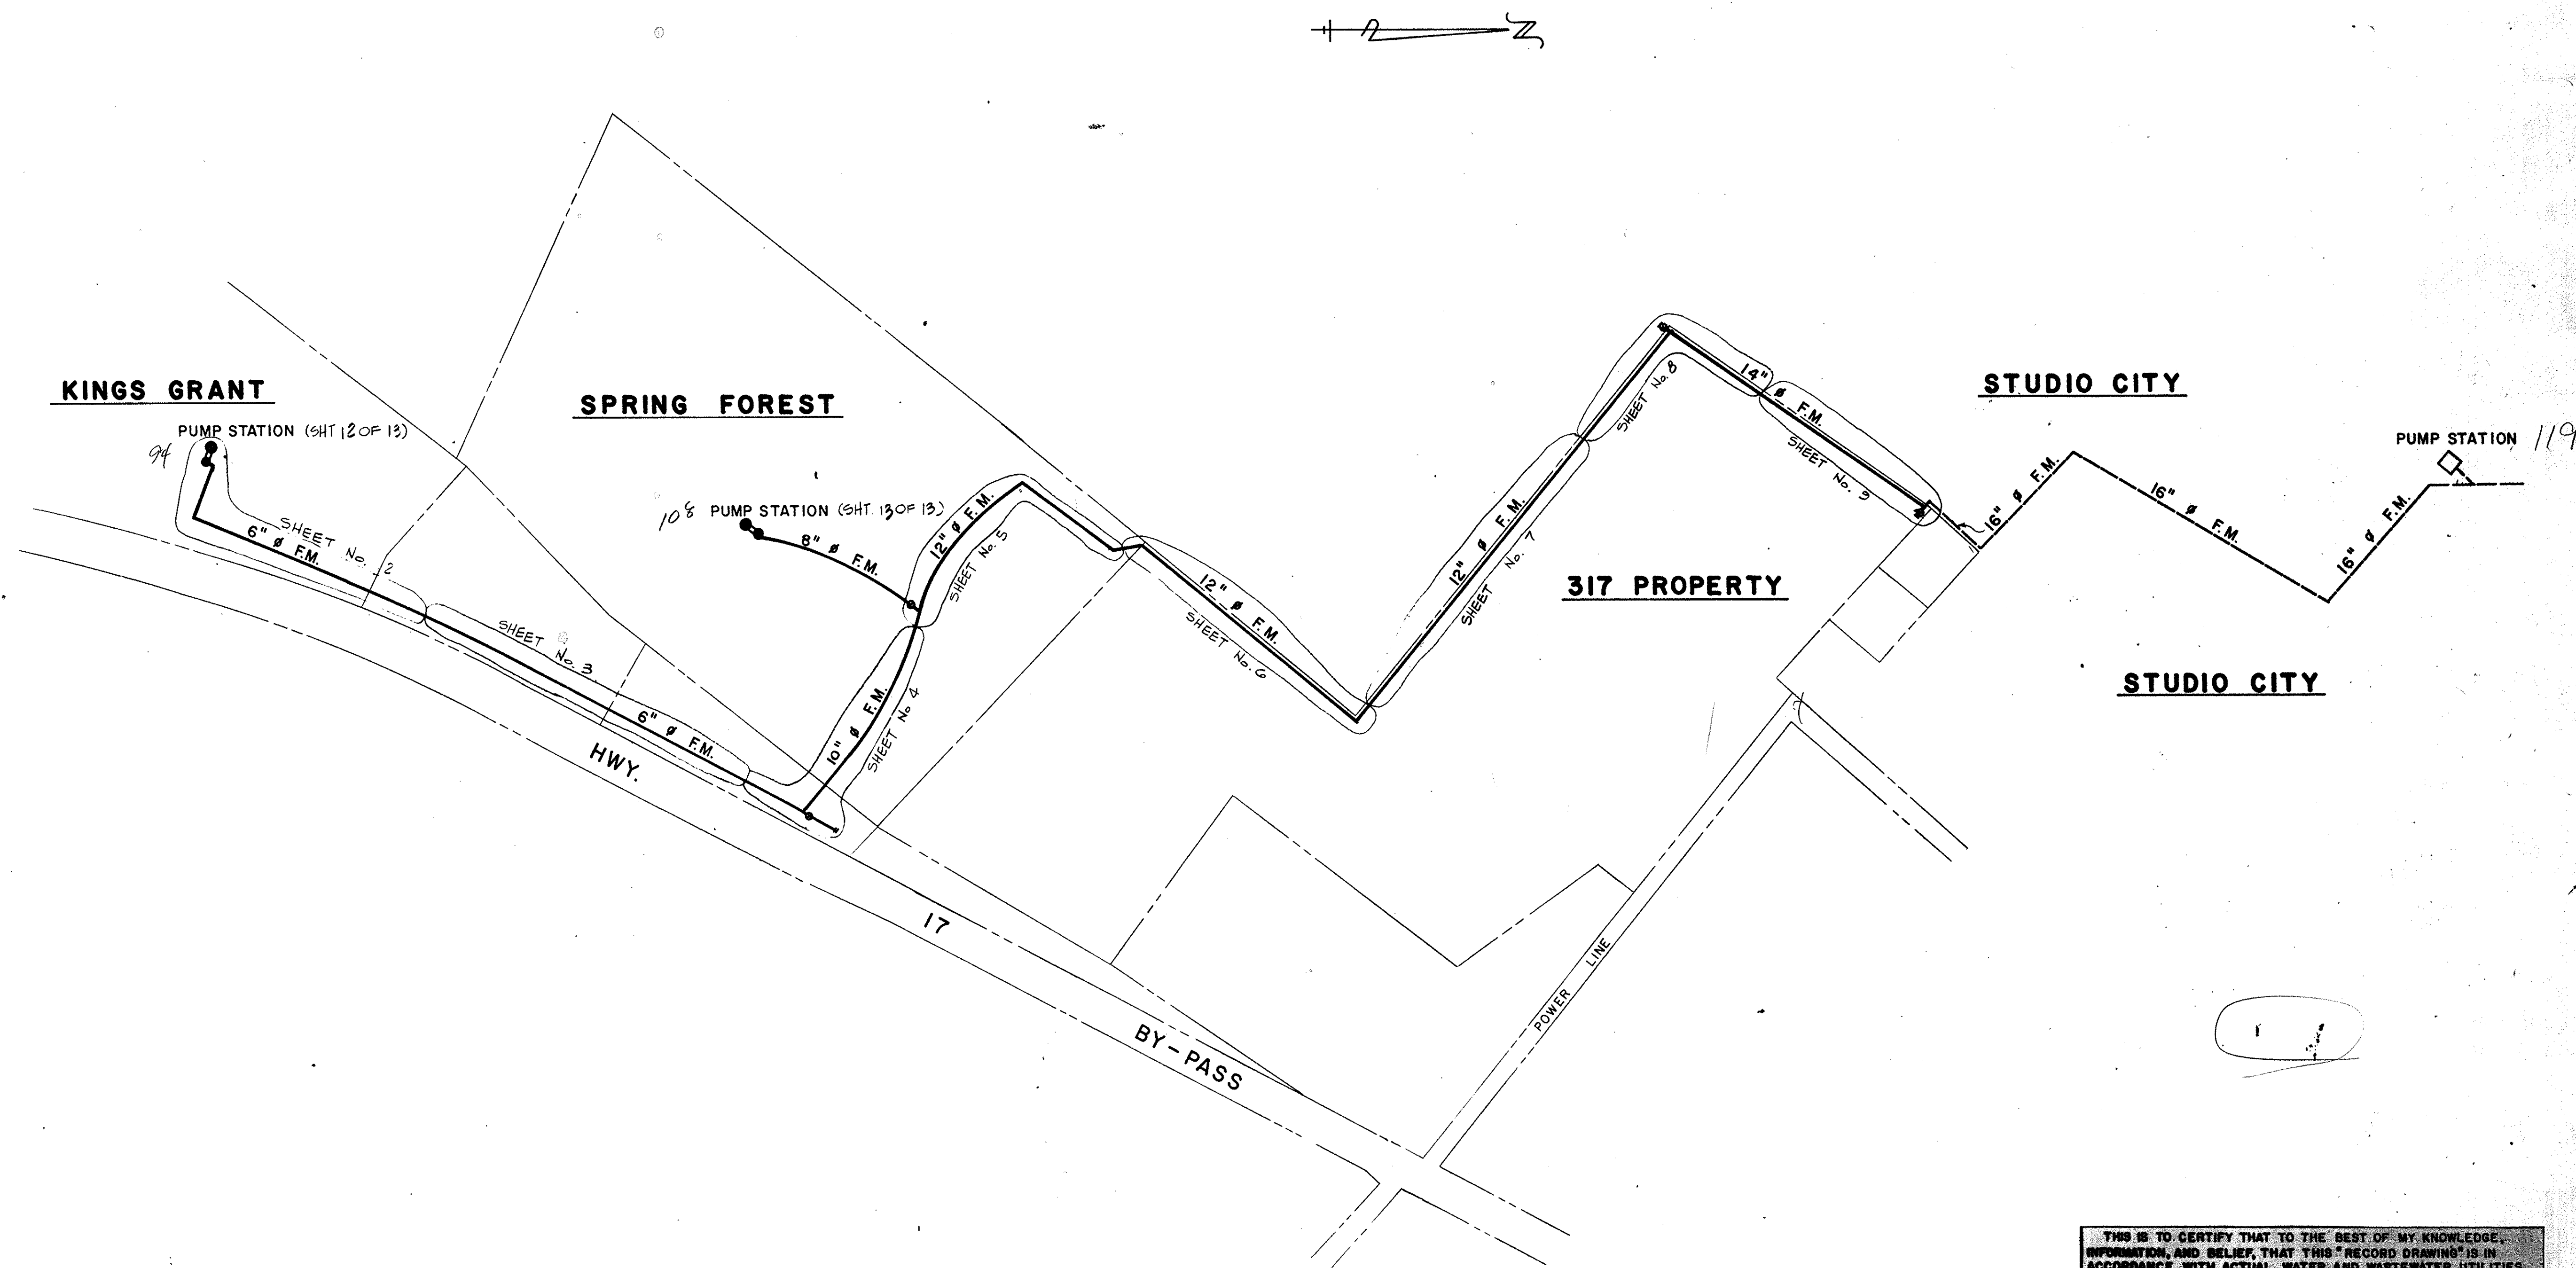

THIS IS TO CERTIFY THAT TO THE BEST OF MY KNOWLEDGE, INFORMATION, AND BELIEF, THAT THIS "RECORD DRAWING" IS IN ACCORDANCE WITH ACTUAL WATER AND WASTEWATER UTILITIES CONSTRUCTED. THIS DRAWING HAS BEEN MODIFIED AS NECESSARY TO RECORD ACTUAL CONSTRUCTION OF UTILITIES BASED ON INFORMATION PROVIDED BY THE CONTRACTOR AND THE ENGINEER'S PERIODIC INSPECTIONS OF THE SITE.

ENGINEER *John C. Wainwright* DATE *May 24, 1985*

APPD	ENGINEER	DATE
REVISION	SEAL	DATE
MARK	DATE	DATE

SOUTH CAROLINA
REGISTERED PROFESSIONAL ENGINEER
No. 4041
JOHN C. WAINWRIGHT

LOCATION PLAN

GSW & SA

FORCE MAIN

HORRY COUNTY, SOUTH CAROLINA

E.T.S., INC.
ENGINEERING & TECHNICAL SERVICES
MURRELLS INLET, SOUTH CAROLINA
803-681-8808

SCALE: N.T.S.

JOB NO. 198402
DRAWING NO. 20-59-003-S


20-59-003-S

THIS IS TO CERTIFY THAT TO THE BEST OF MY KNOWLEDGE,
INFORMATION, AND BELIEF, THAT THIS "RECORD DRAWING" IS
IN ACCORDANCE WITH ACTUAL WATER AND WASTEWATER UTILITIES
CONSTRUCTED. THIS DRAWING HAS BEEN MODIFIED AS NEEDED
TO RECORD ACTUAL CONSTRUCTION OF UTILITIES BASED ON
INFORMATION PROVIDED BY THE CONTRACTOR AND THE
ENGINEER'S PERIODIC INSPECTIONS OF THE SITE.

Michael J. O'Connell M. J. O'Connell
ENGINEER DATE 8-4-1985

JANUARY	FEBRUARY	MARCH	APRIL	MAY	JUNE	JULY	AUGUST	SEPTEMBER	OCTOBER	NOVEMBER	DECEMBER


5175
1775
1419

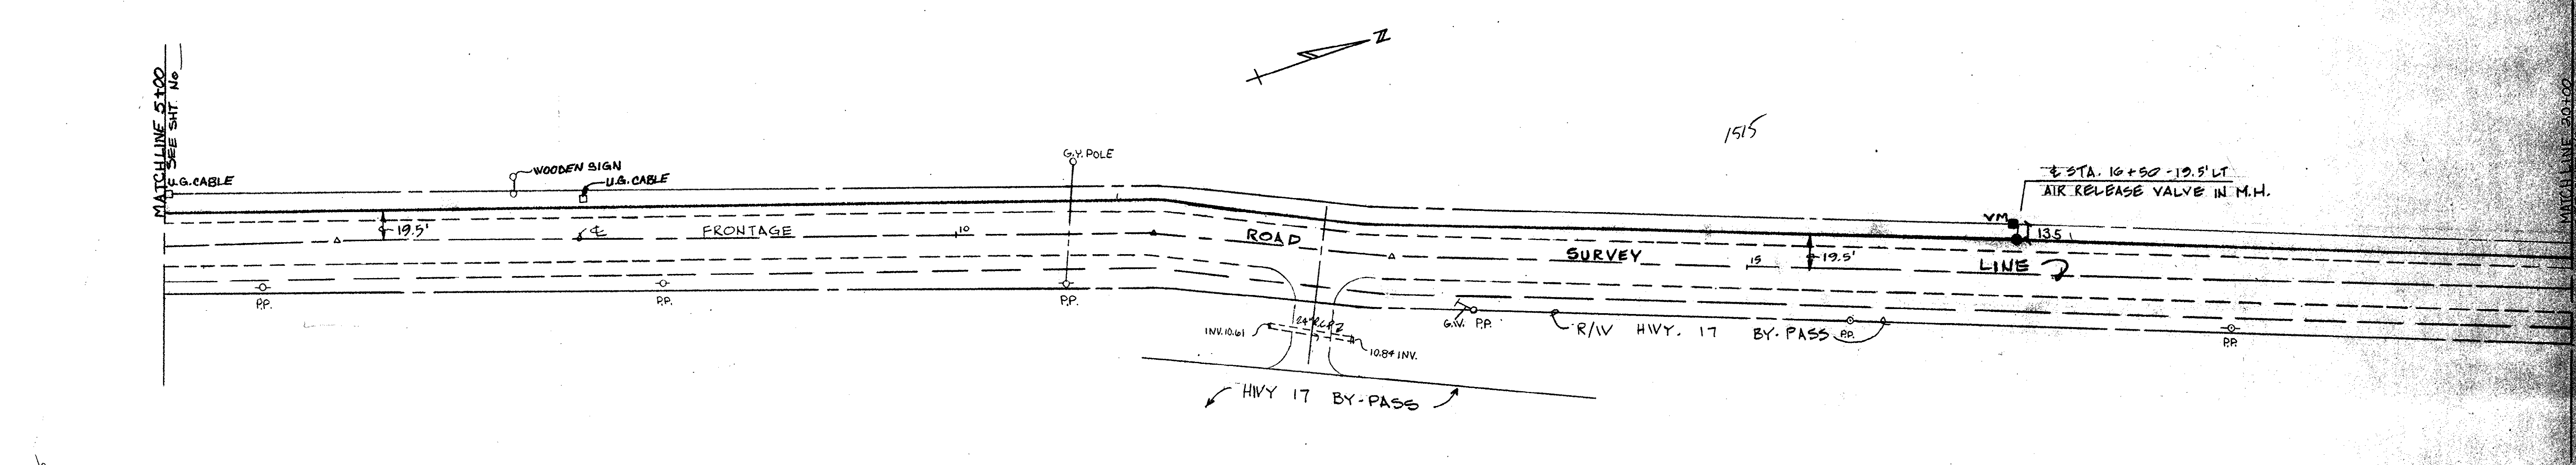

PLAN
SCALE: 1" = 30'

THIS IS TO CERTIFY THAT TO THE BEST OF MY KNOWLEDGE, INFORMATION, AND BELIEF, THAT THIS RECORD DRAWING IS IN ACCORDANCE WITH ACTUAL WATER AND WASTEWATER UTILITIES CONSTRUCTED. THIS DRAWING HAS BEEN MODIFIED AS NECESSARY TO RECORD ACTUAL CONSTRUCTION OF UTILITIES BASED ON INFORMATION PROVIDED BY THE CONTRACTOR AND THE ENGINEER'S PERIODIC INSPECTIONS OF THE SITE.

ENGINEER: *[Signature]* DATE: May 24 1975

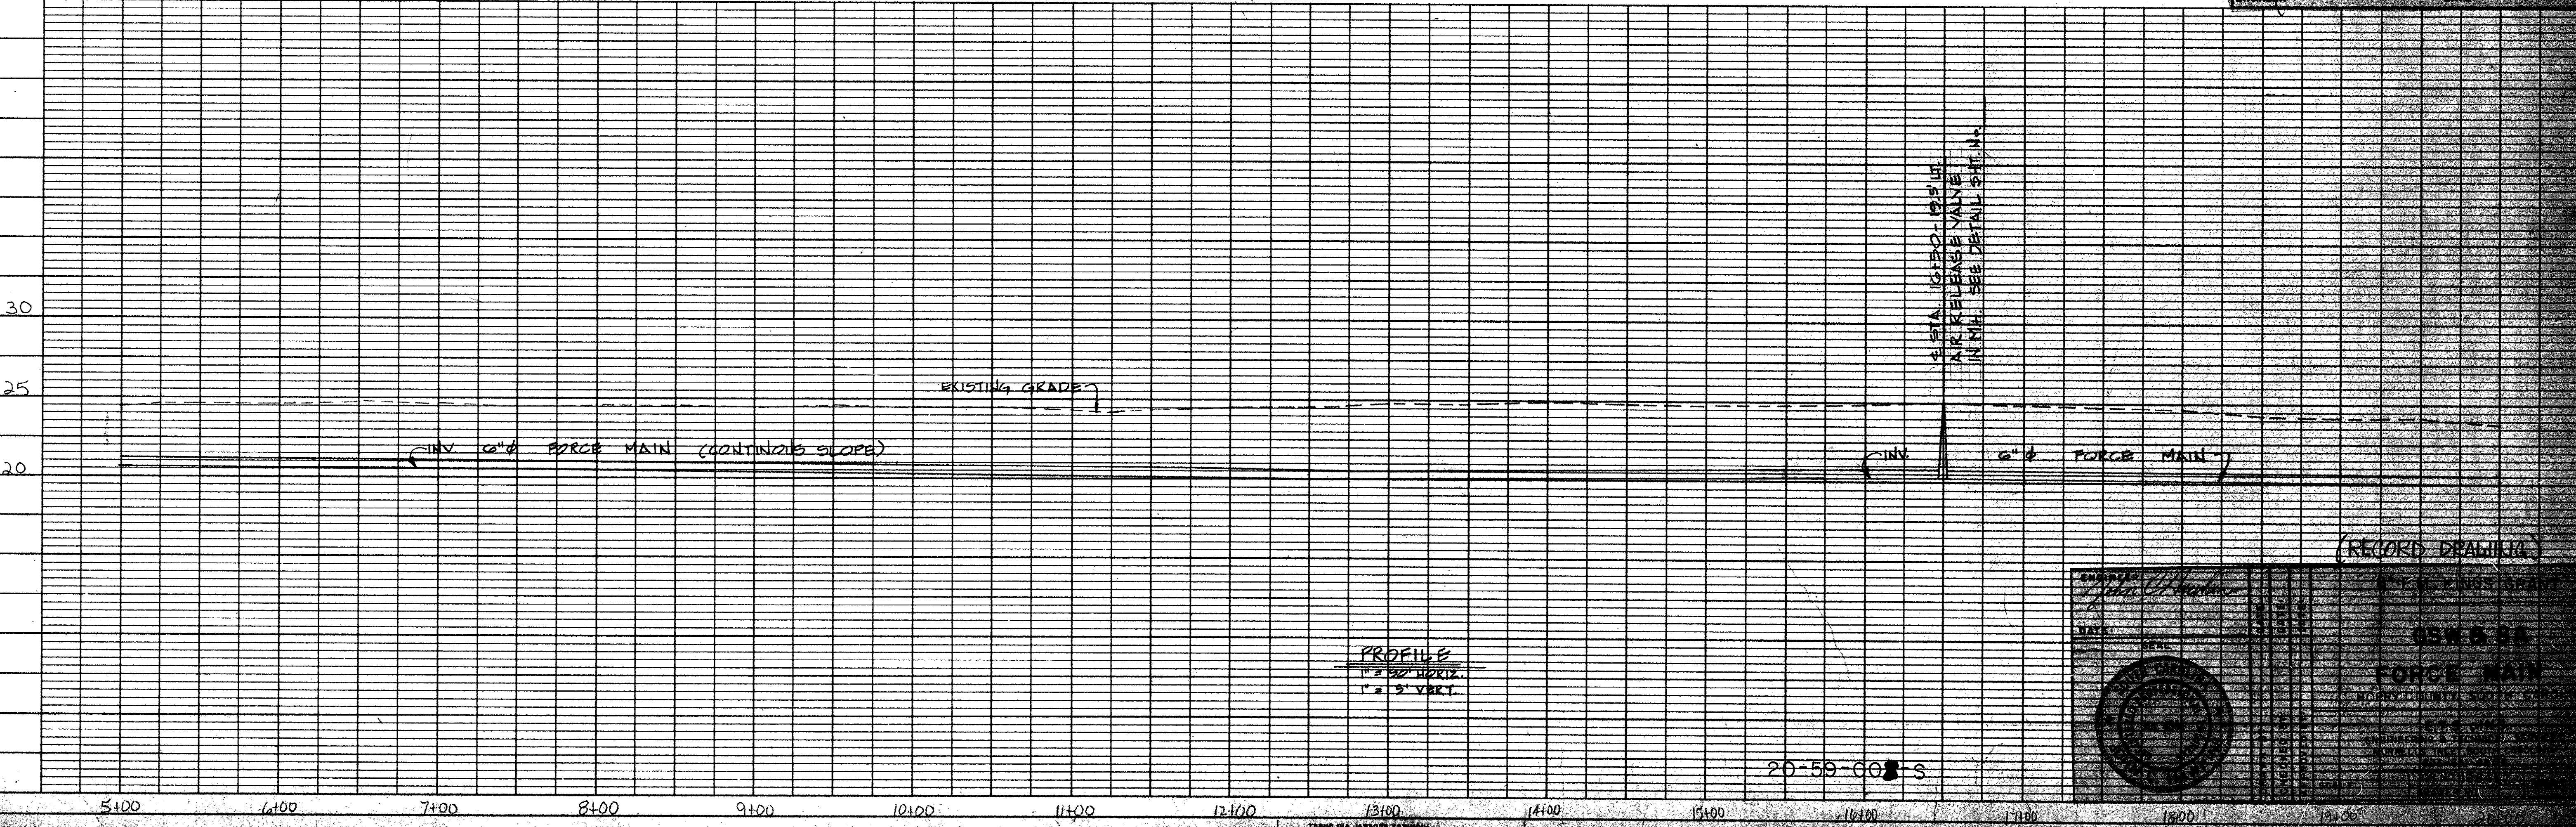

(RECORD DRAWING)


ENGINEER: *[Signature]*
DATE: May 24 1975

PROJECT: 20-59-60-S
DESCRIPTION: 6" FORCE MAIN
LOCATION: HOBBS COUNTY, SOUTH CAROLINA

APPROVED: *[Signature]*
DATE: May 24 1975

SCALE: 1" = 5' VERT.


FED. ROAD DIV. NO.	STATE	COUNTY	DOCKET NO.	PROJECT NO.	ROUTE NO.	SHEET NO.	TOTAL SHEETS
3	S. C.						

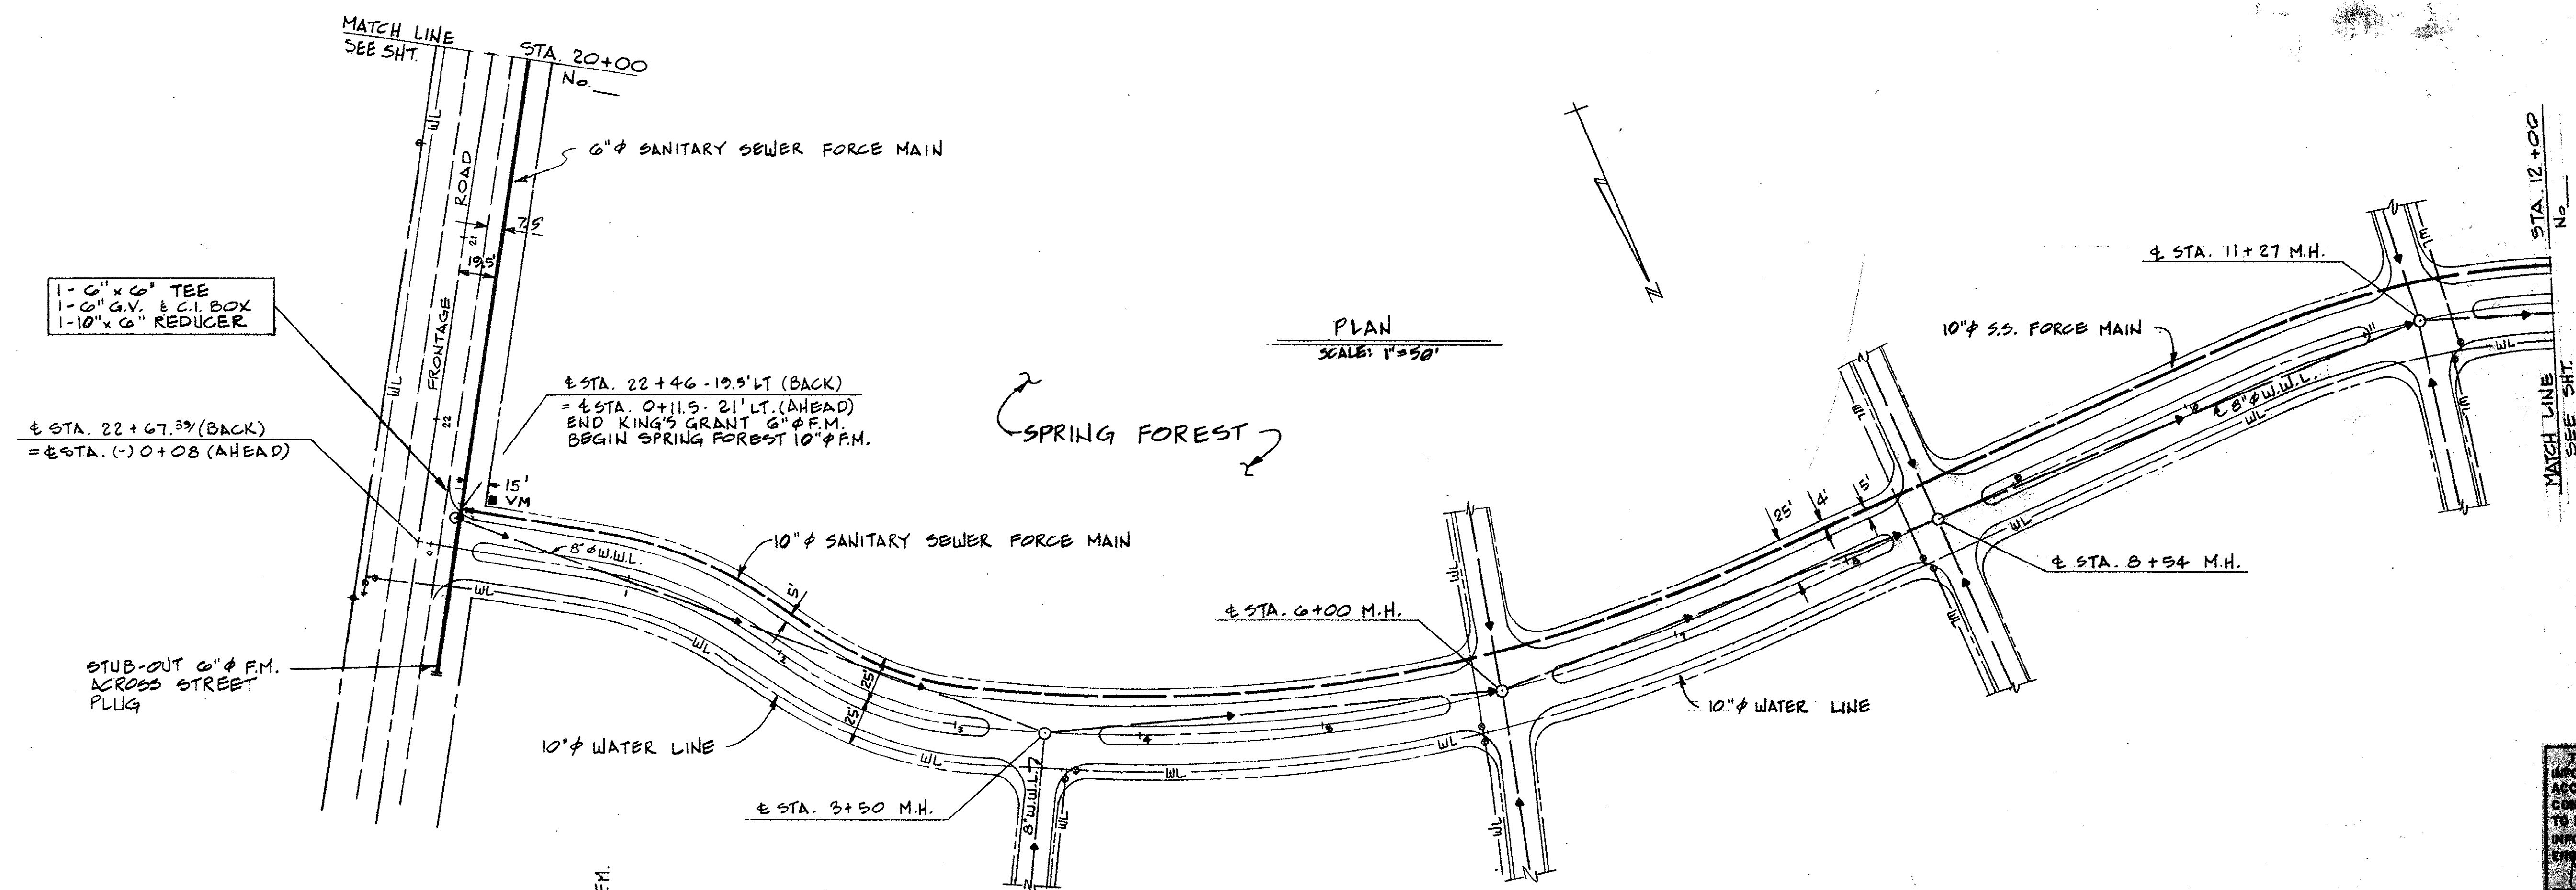

THIS IS TO CERTIFY THAT TO THE BEST OF MY KNOWLEDGE AND BELIEF, THAT THIS RECORD DRAWING IS IN ACCORDANCE WITH ACTUAL WATER AND WASTEWATER UTILITIES. THIS DRAWING HAS BEEN PROVIDED AS A GUIDE TO RECORD ACTUAL CONSTRUCTION OF UTILITIES BASED ON INFORMATION PROVIDED BY THE CONTRACTOR AND THE ENGINEER'S PERIODIC INSPECTIONS OF THE SITE.



[Signature] May 24 1975

ENGINEER DATE

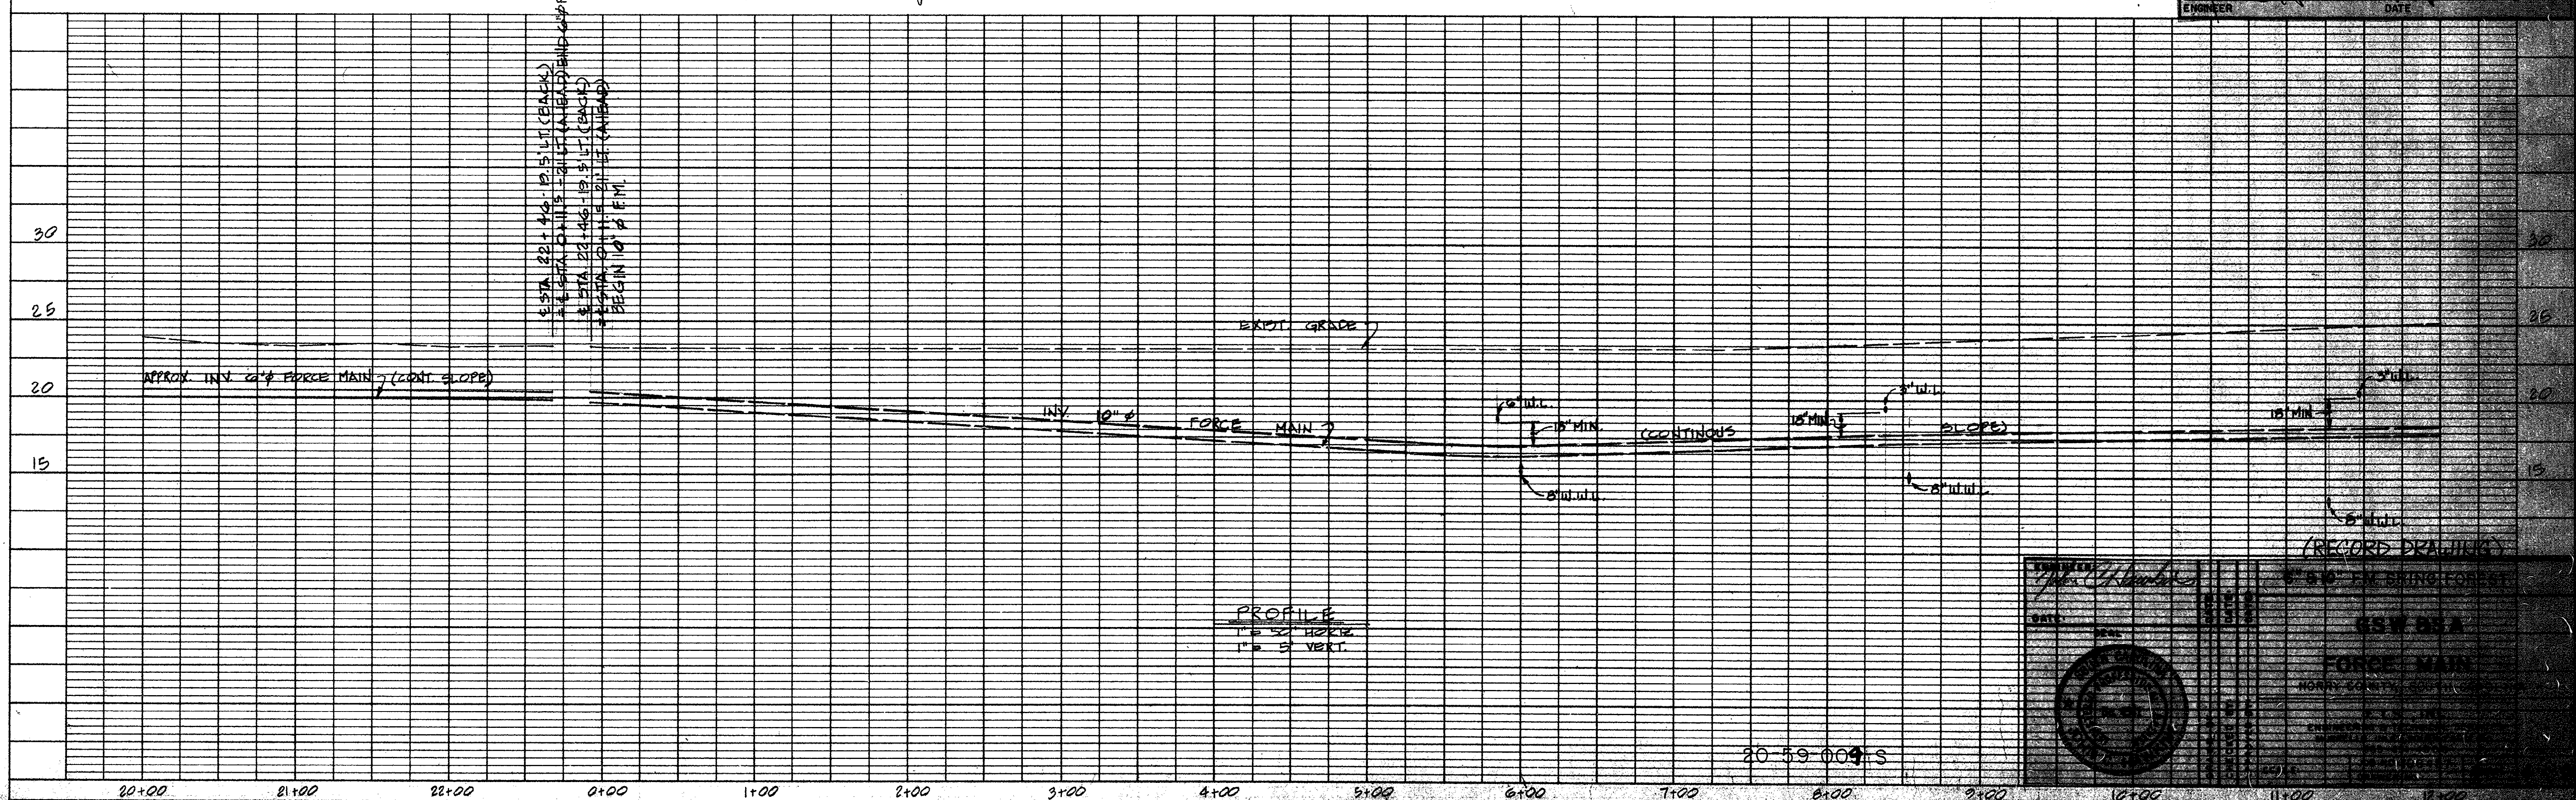


THIS IS TO CERTIFY THAT TO THE BEST OF MY KNOWLEDGE,
INFORMATION, AND BELIEF, THAT THIS "RECORD DRAWING" IS IN
ACCORDANCE WITH ACTUAL WATER AND WASTEWATER UTILITIES
CONSTRUCTED. THIS DRAWING HAS BEEN MODIFIED AS NECESSARY
TO RECORD ACTUAL CONSTRUCTION OF UTILITIES BASED ON
INFORMATION PROVIDED BY THE CONTRACTOR AND THE
ENGINEER'S PERIODIC INSPECTIONS OF THE SITE.

[Signature] *May 24 1985*
ENGINEER DATE

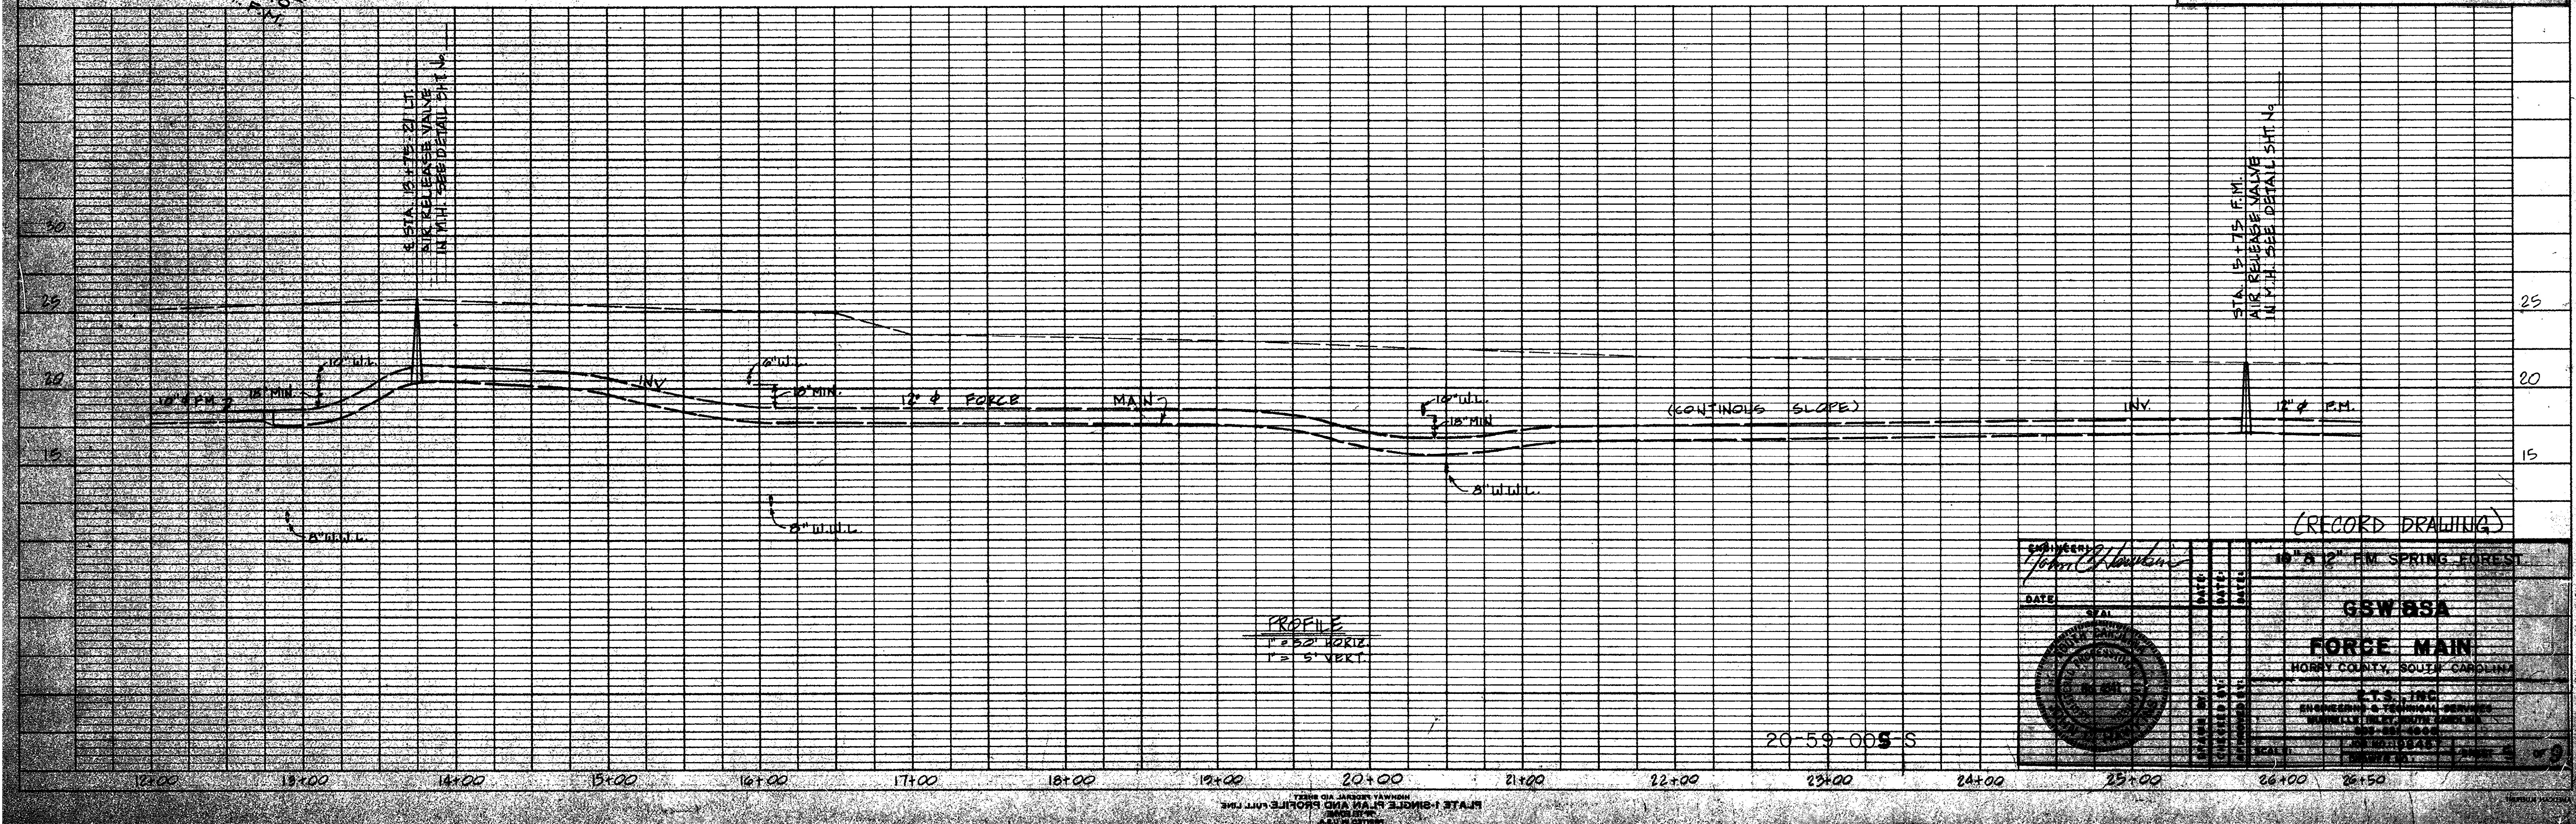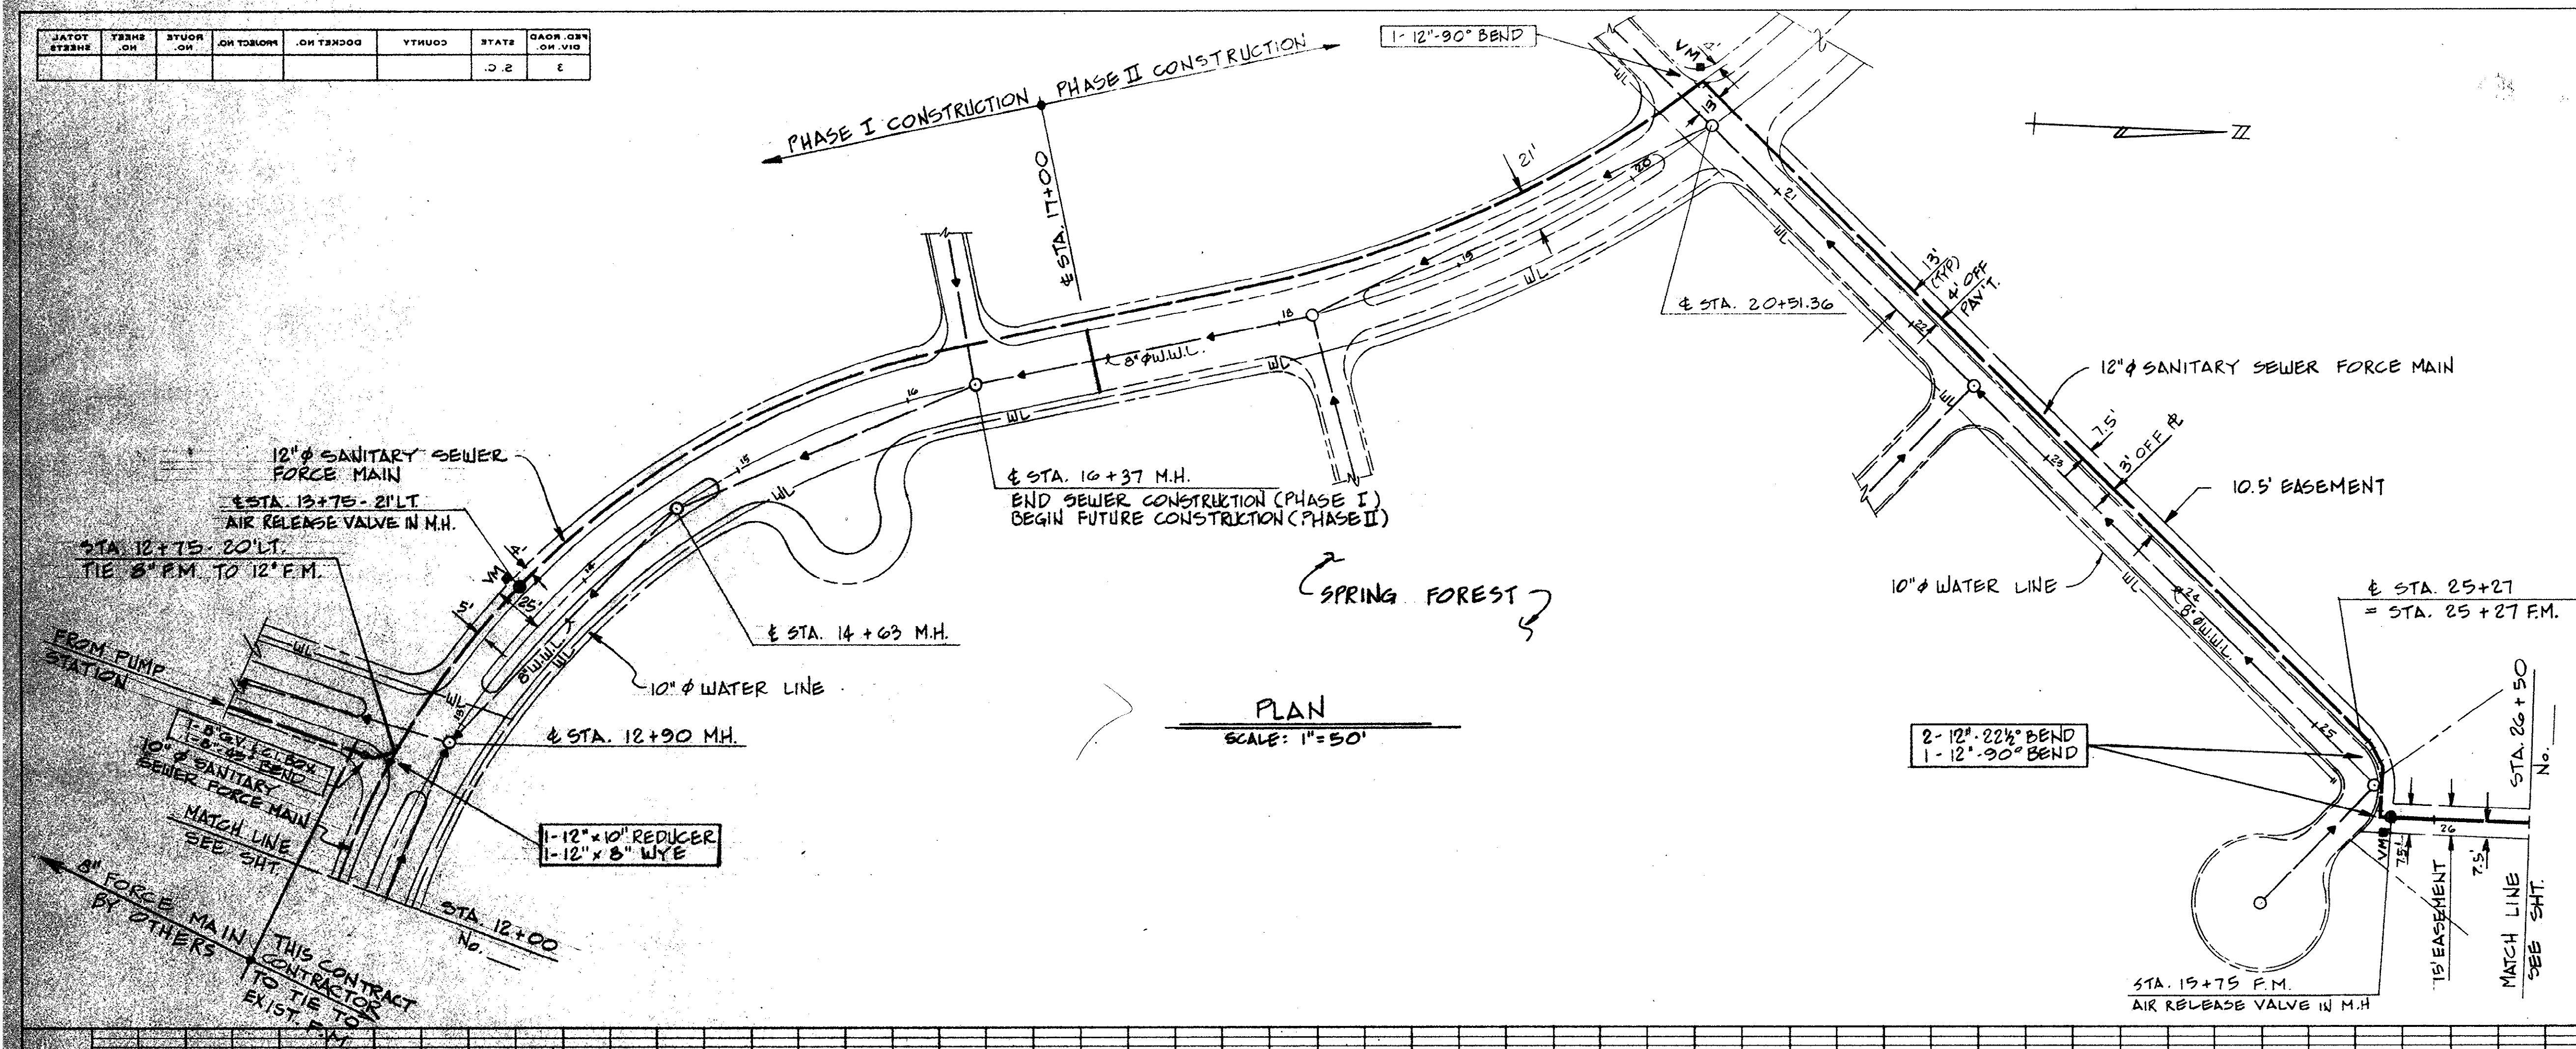


FED. ROAD DIV. NO.	STATE	COUNTY	DOCKET NO.	PROJECT NO.	ROUTE NO.	SHEET NO.	TOTAL SHEETS
3	S. C.						

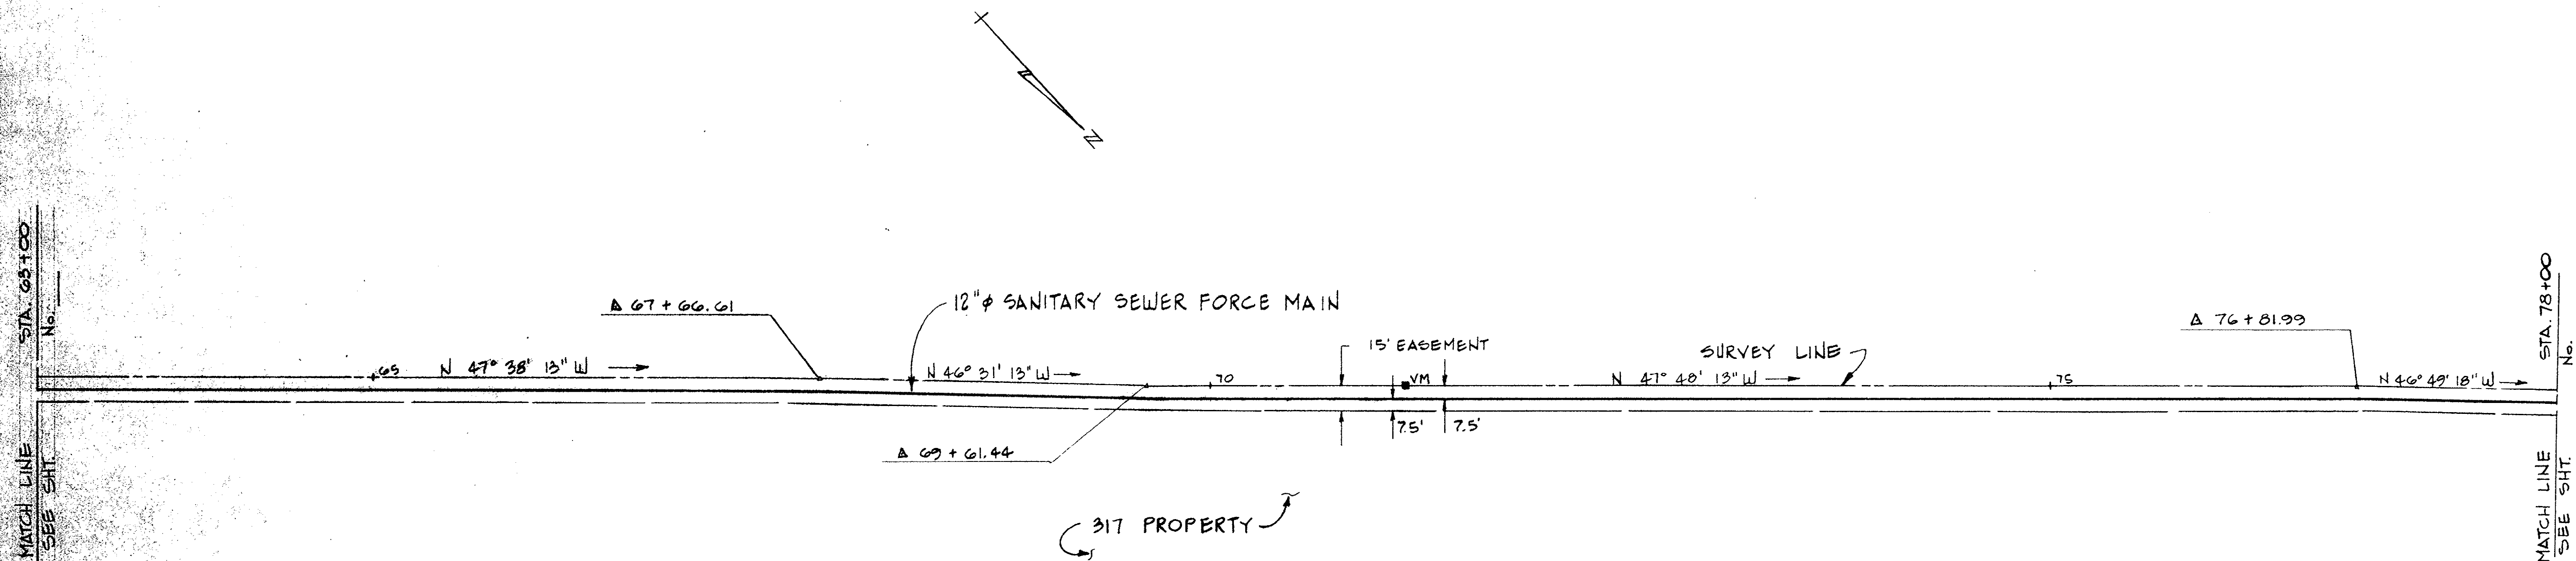

PLAN
SCALE: 1" = 50'

THIS IS TO CERTIFY THAT TO THE BEST OF MY KNOWLEDGE,
INFORMATION, AND BELIEF, THAT THIS RECORD DRAWING IS IN
ACCORDANCE WITH ALL WATER AND WASTE WATER UTILITIES
CONSTRUCTED. THIS DRAWING HAS BEEN MODIFIED AS NECESSARY
TO RECORD ACTUAL CONSTRUCTION OF UTILITIES BASED ON
INFORMATION PROVIDED BY THE CONTRACTOR AND THE
ENGINEER'S PERIODIC INSPECTIONS OF THE SITE.



ENGINEER DATE May 24 1985

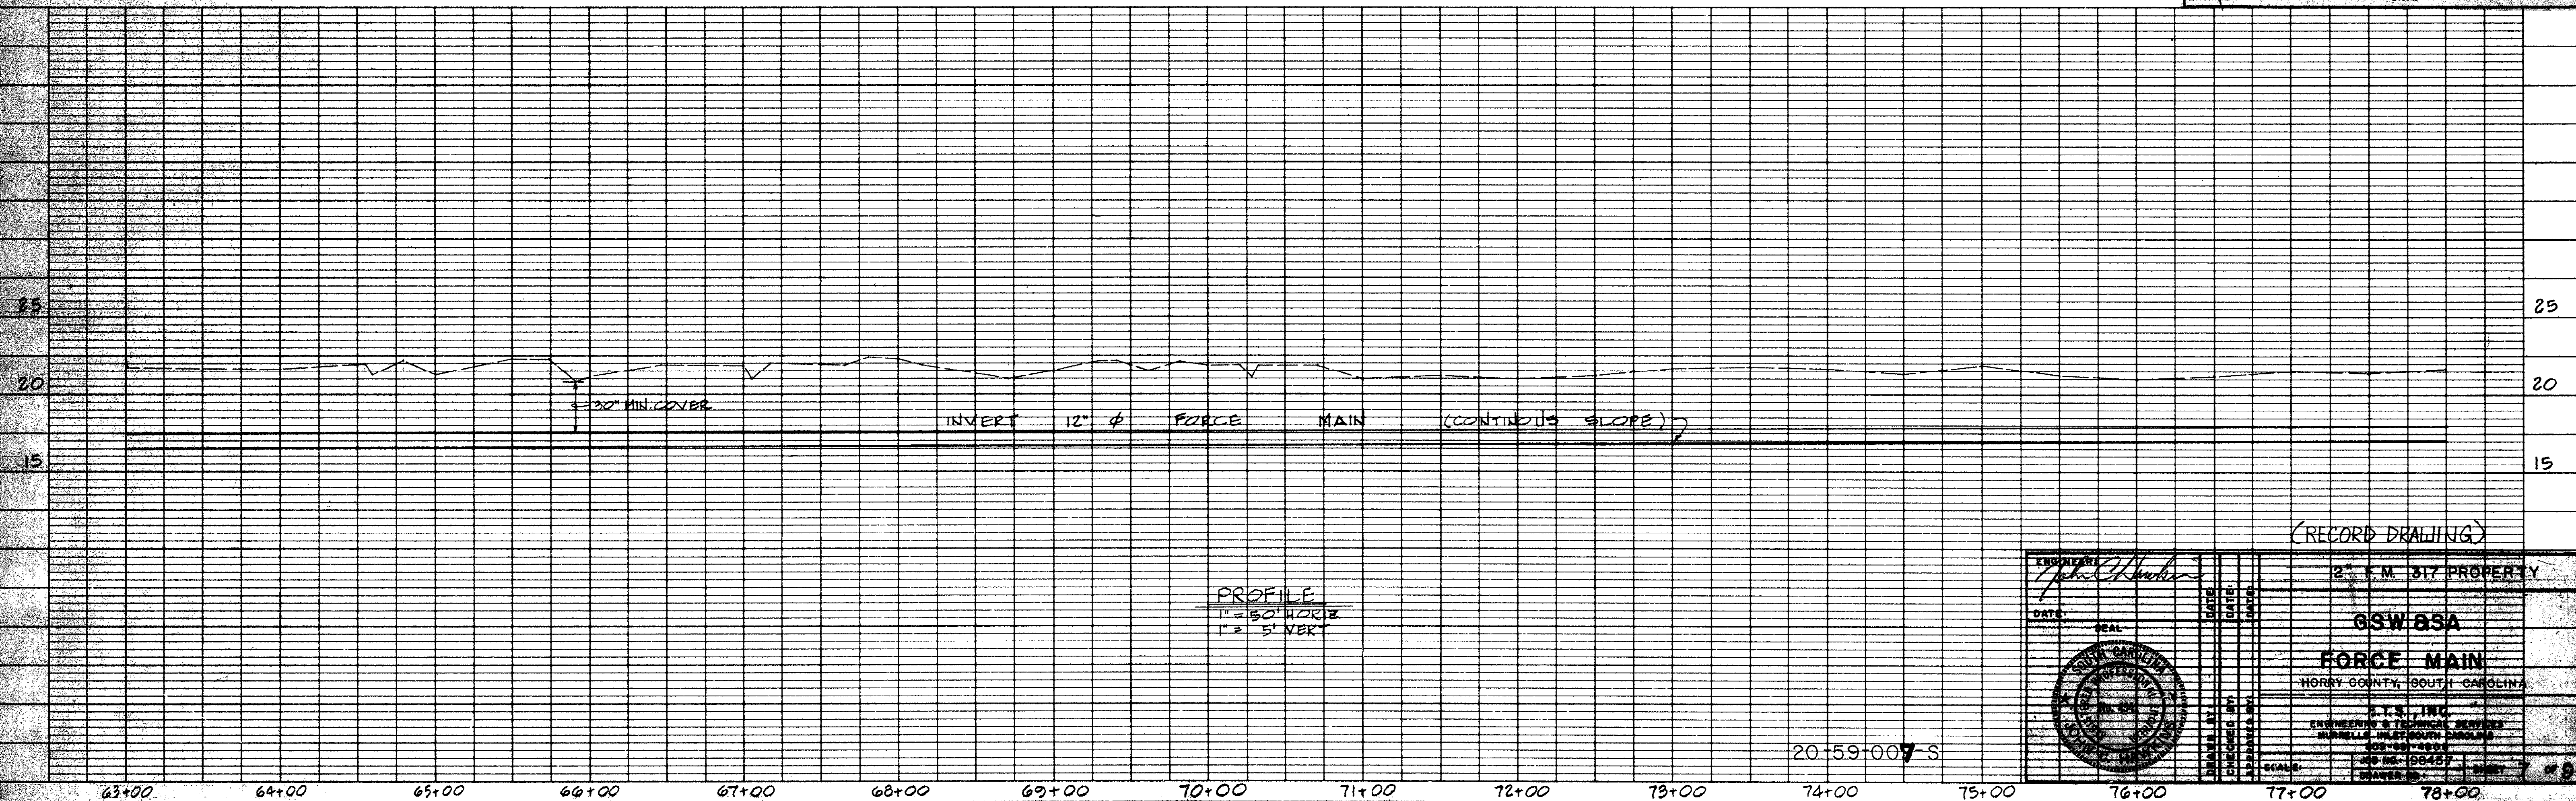


THIS IS TO CERTIFY THAT TO THE BEST OF MY KNOWLEDGE,
INFORMATION, AND BELIEF, THAT THIS "RECORD DRAWING" IS IN
ACCORDANCE WITH ACTUAL WATER AND WASTEWATER UTILITIES
CONSTRUCTED. THIS DRAWING HAS BEEN MODIFIED AS NECESSARY
TO RECORD ACTUAL CONSTRUCTION OF UTILITIES BASED ON
INFORMATION PROVIDED BY THE CONTRACTOR AND THE
ENGINEERS PERIODIC INSPECTIONS OF THE SITE.

[Signature]
ENGINEER

[Signature] May 24 1985
DATE

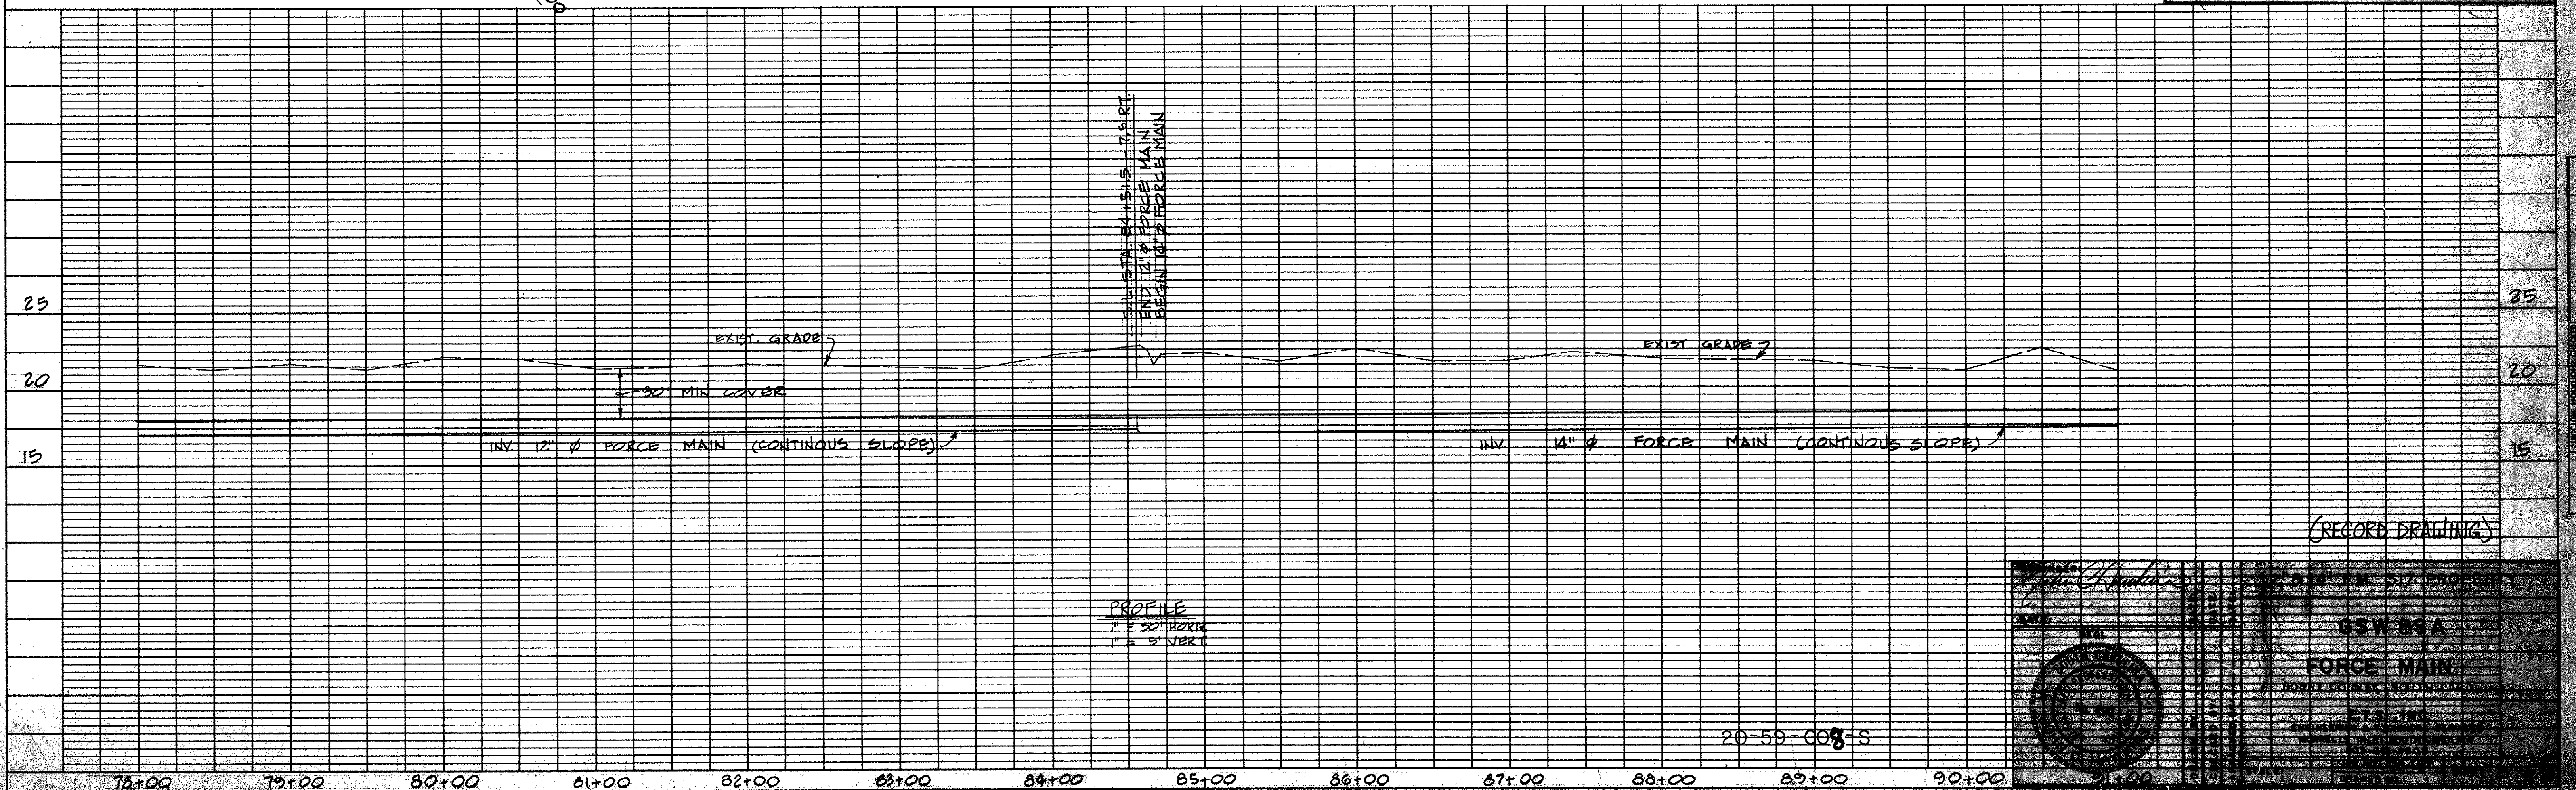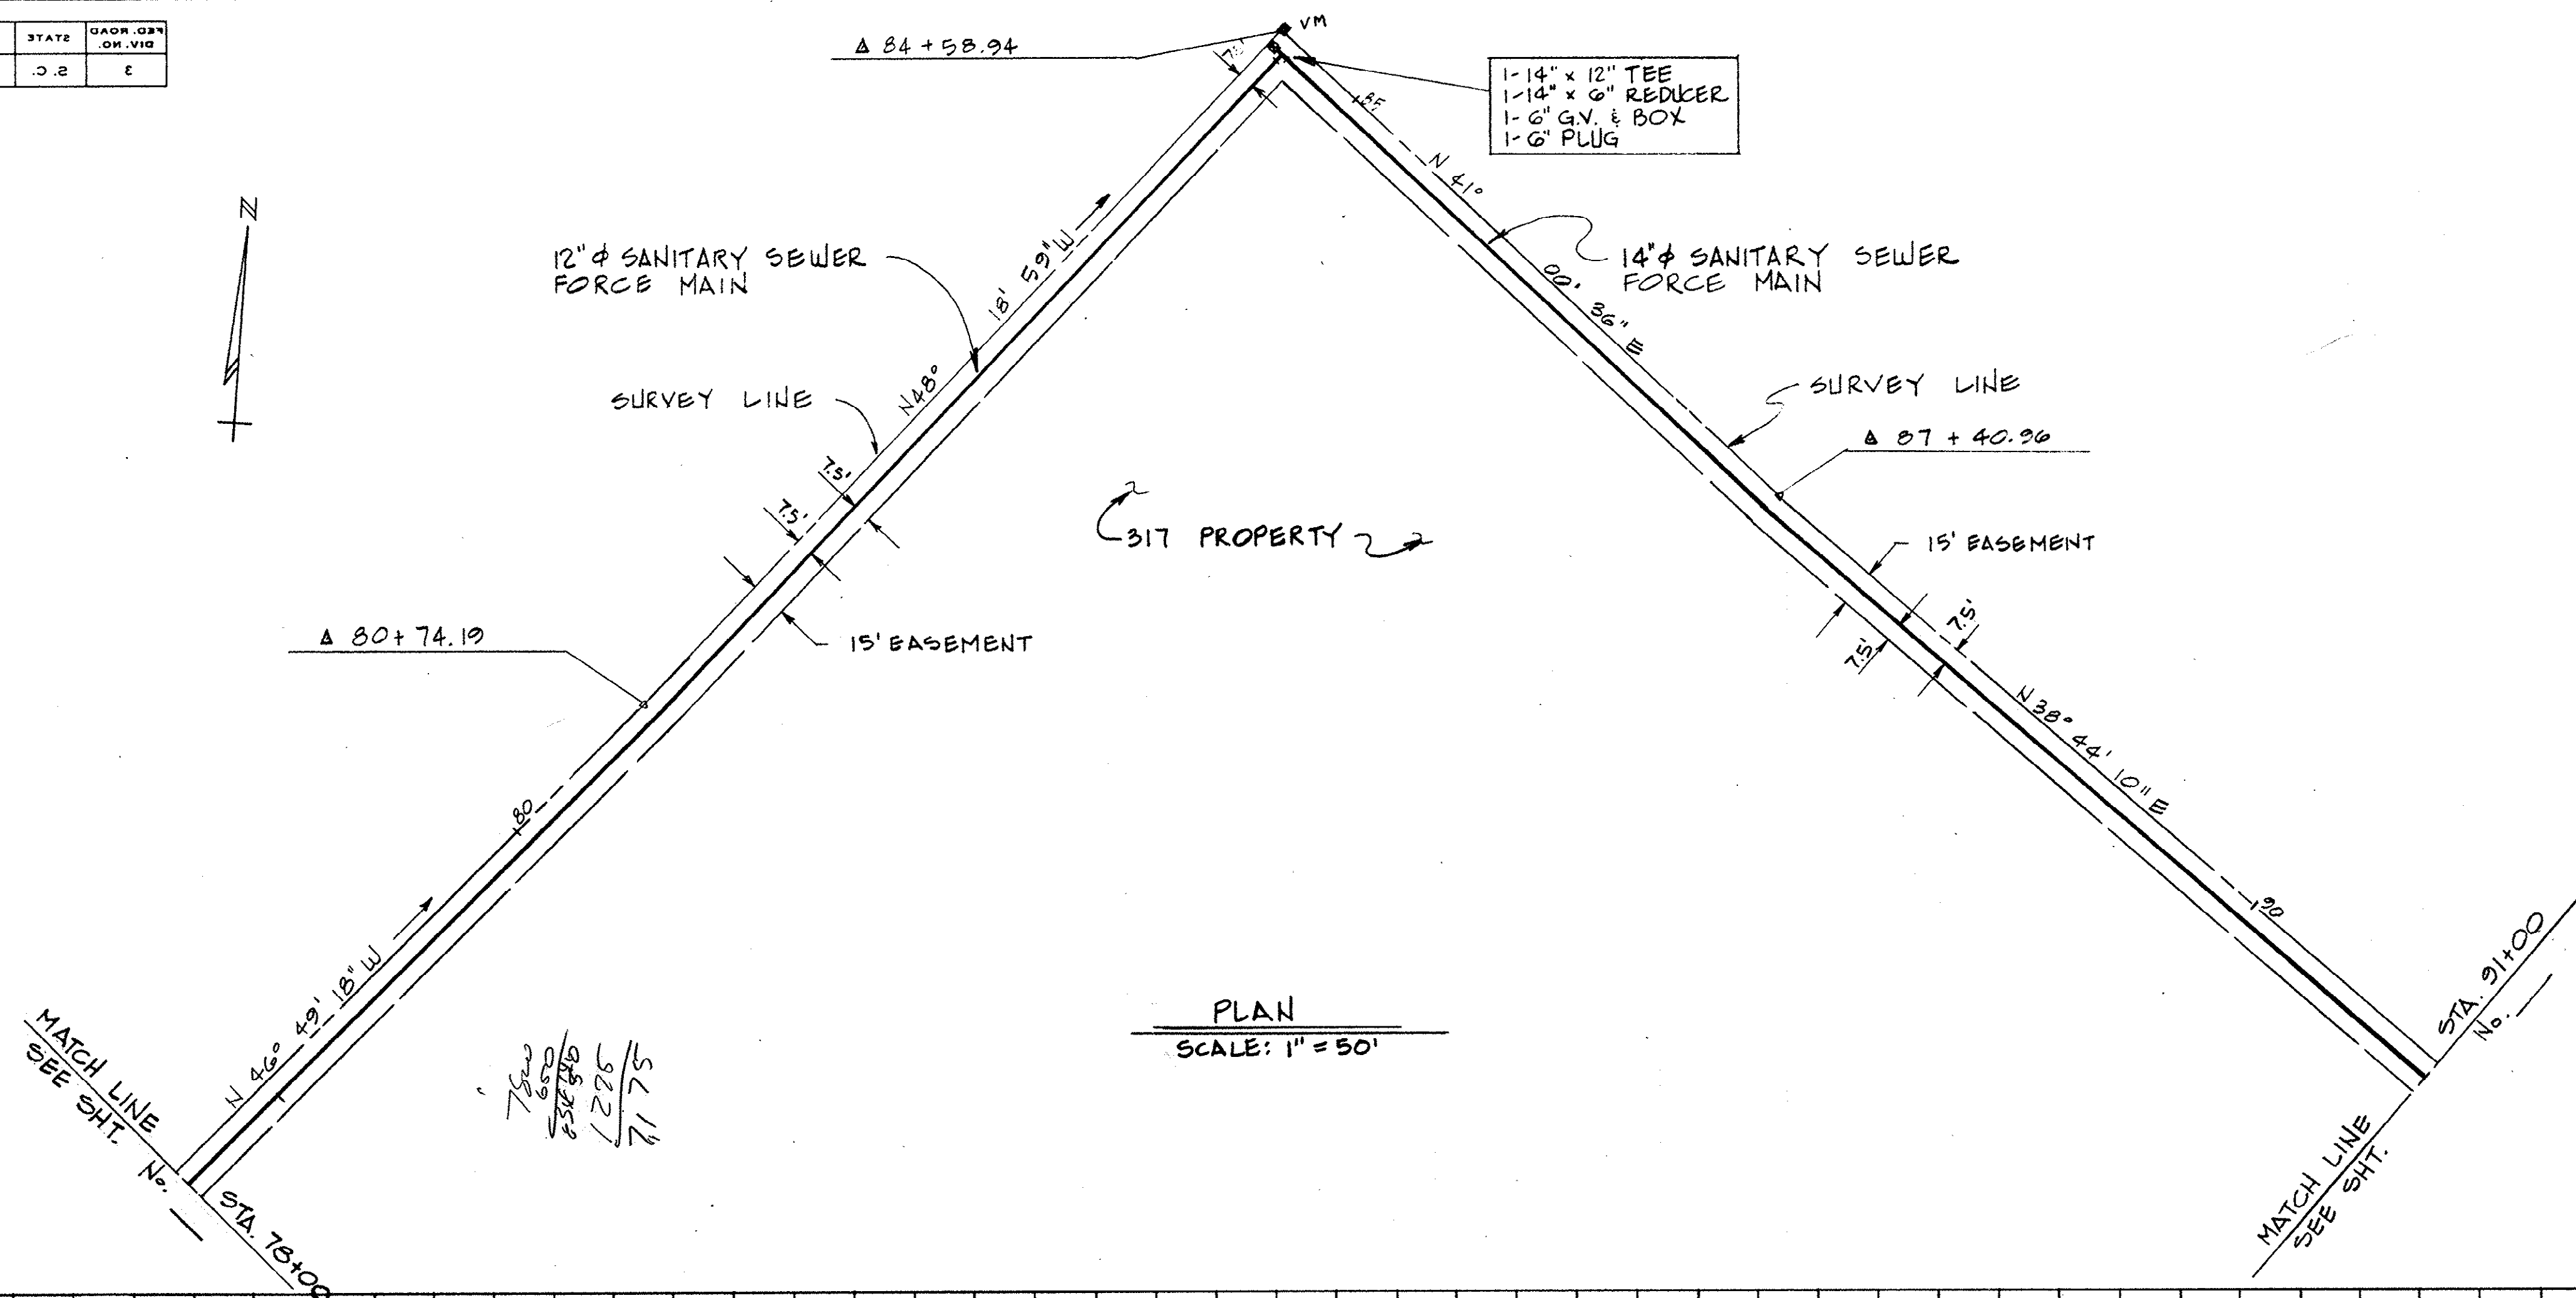


DATE	2/28/85	SHEET	NO.	ROUTE	NO.	PROJECT	NO.	DOCKET	NO.	COUNTY	STATE	ROAD	NO.	NO.

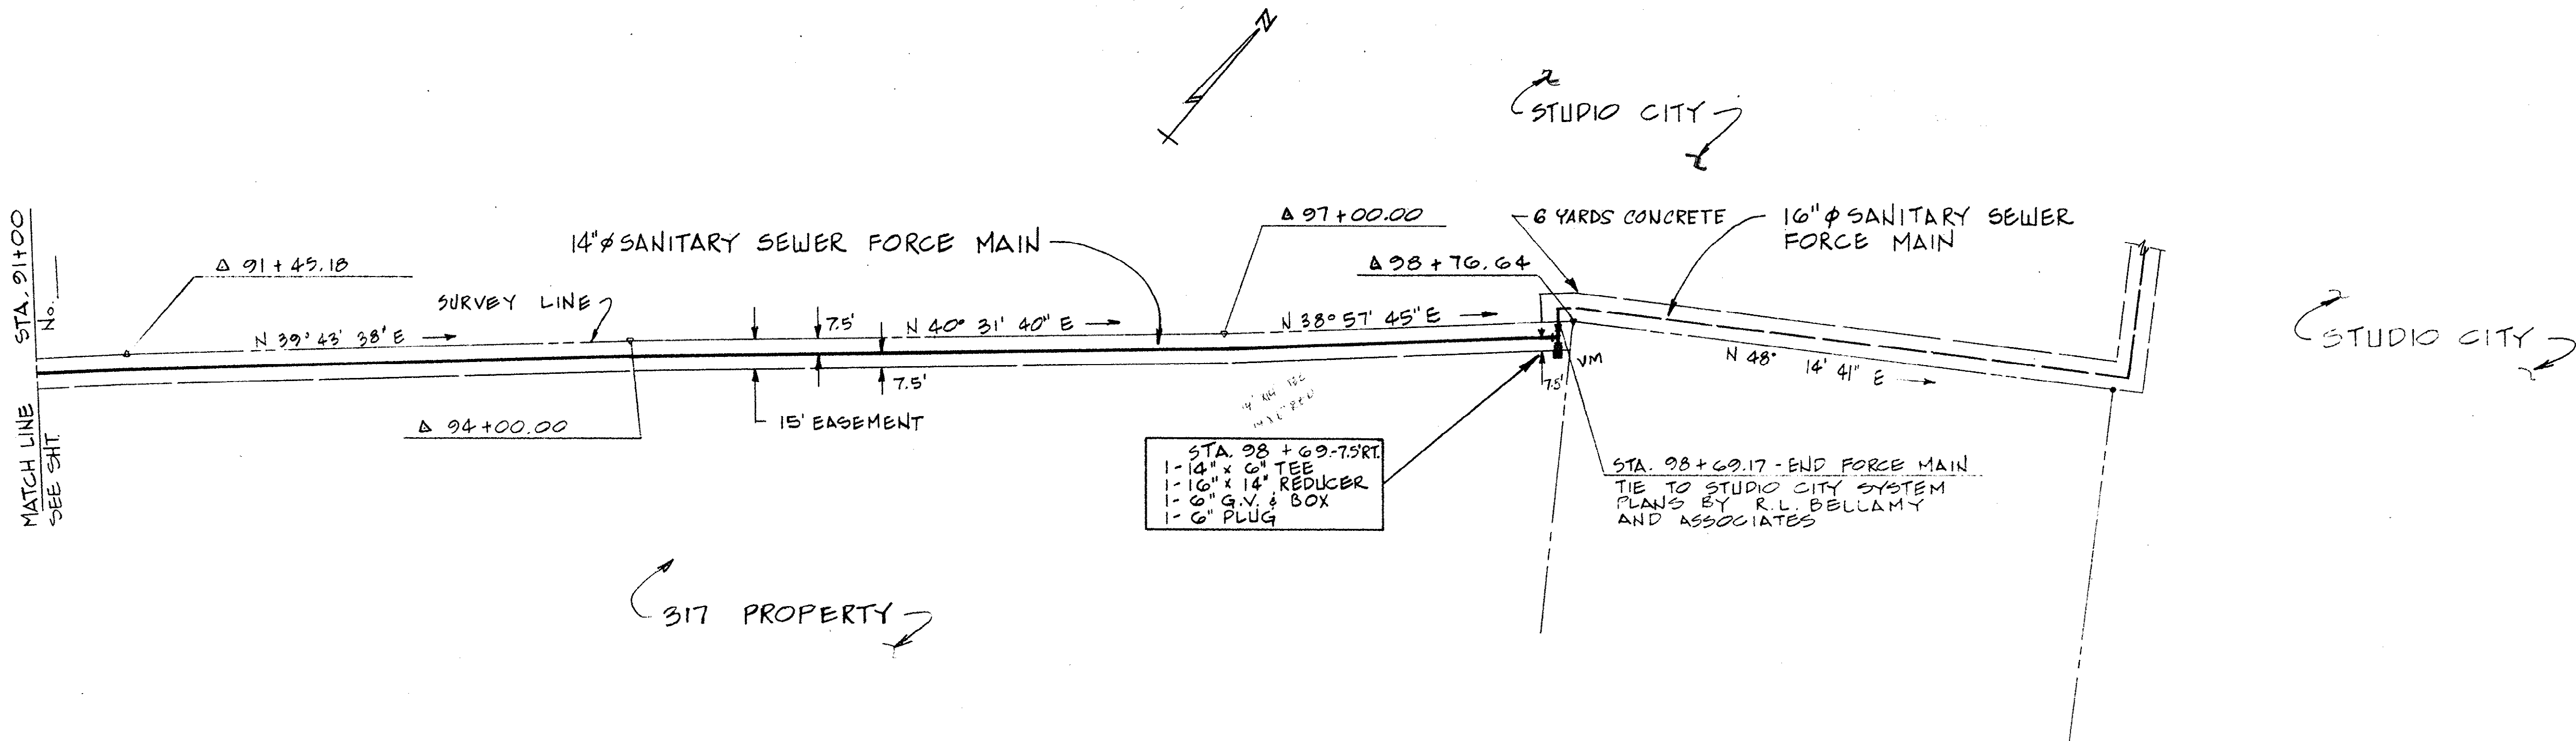

PLAN
SCALE: 1" = 50'

THIS IS TO CERTIFY THAT TO THE BEST OF MY KNOWLEDGE, INFORMATION, AND BELIEF, THAT THIS "RECORD DRAWING" IS IN ACCORDANCE WITH ACTUAL WATER AND WASTEWATER UTILITIES CONSTRUCTED. THIS DRAWING HAS BEEN MODIFIED AS NECESSARY TO RECORD ACTUAL CONSTRUCTION OF UTILITIES BASED ON INFORMATION PROVIDED BY THE CONTRACTOR AND THE ENGINEER'S PERIODIC INSPECTIONS OF THE SITE.

John C. Hamilton May 24, 1985
ENGINEER DATE

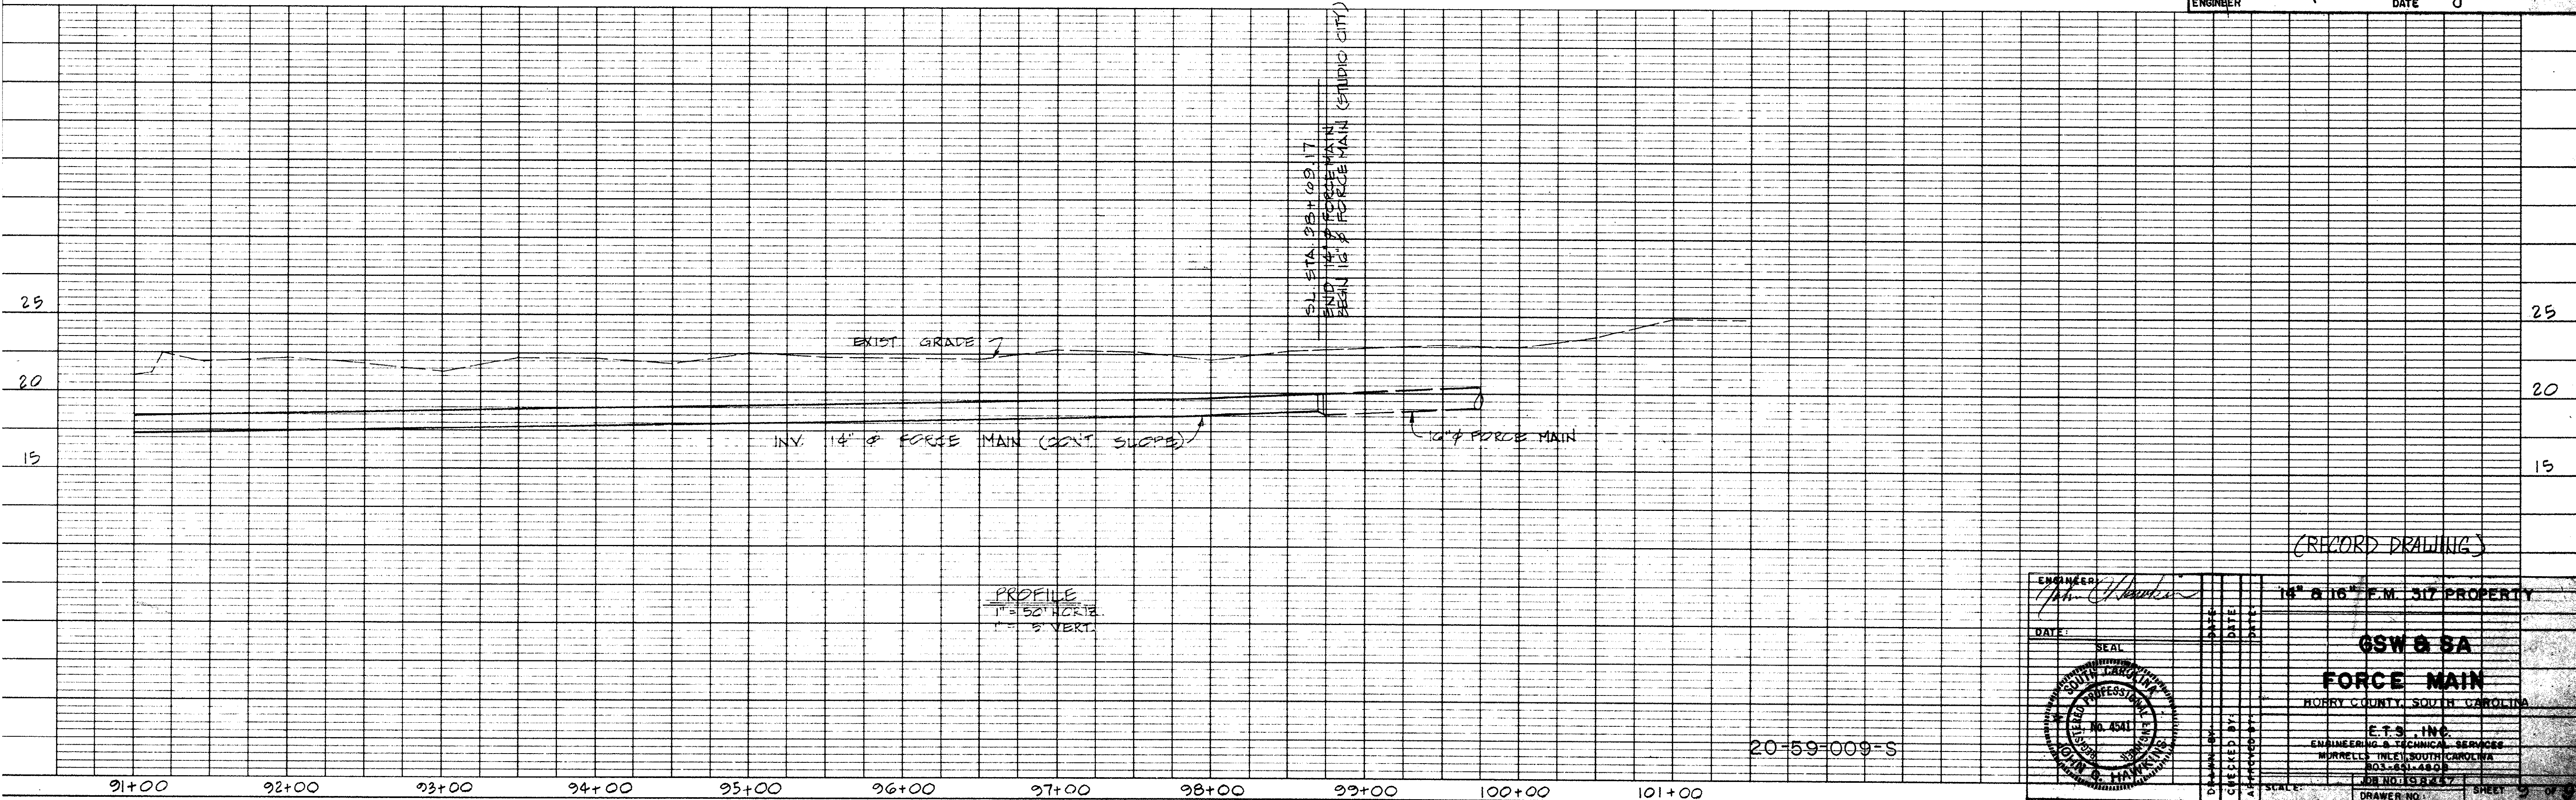

(RECORD DRAWING)

ENGINEER: *John C. Hamilton*
DATE: _____
SCALE: _____

14" & 16" F.M. 317 PROPERTY

CSW & SA
FORCE MAIN
Horry County, South Carolina

E.T.S. INC.
ENGINEERING & TECHNICAL SERVICES
MURRELLS INLET, SOUTH CAROLINA
803-681-4808
JOB NO. 1518487
DRAWER NO. _____ SHEET 5 OF 5