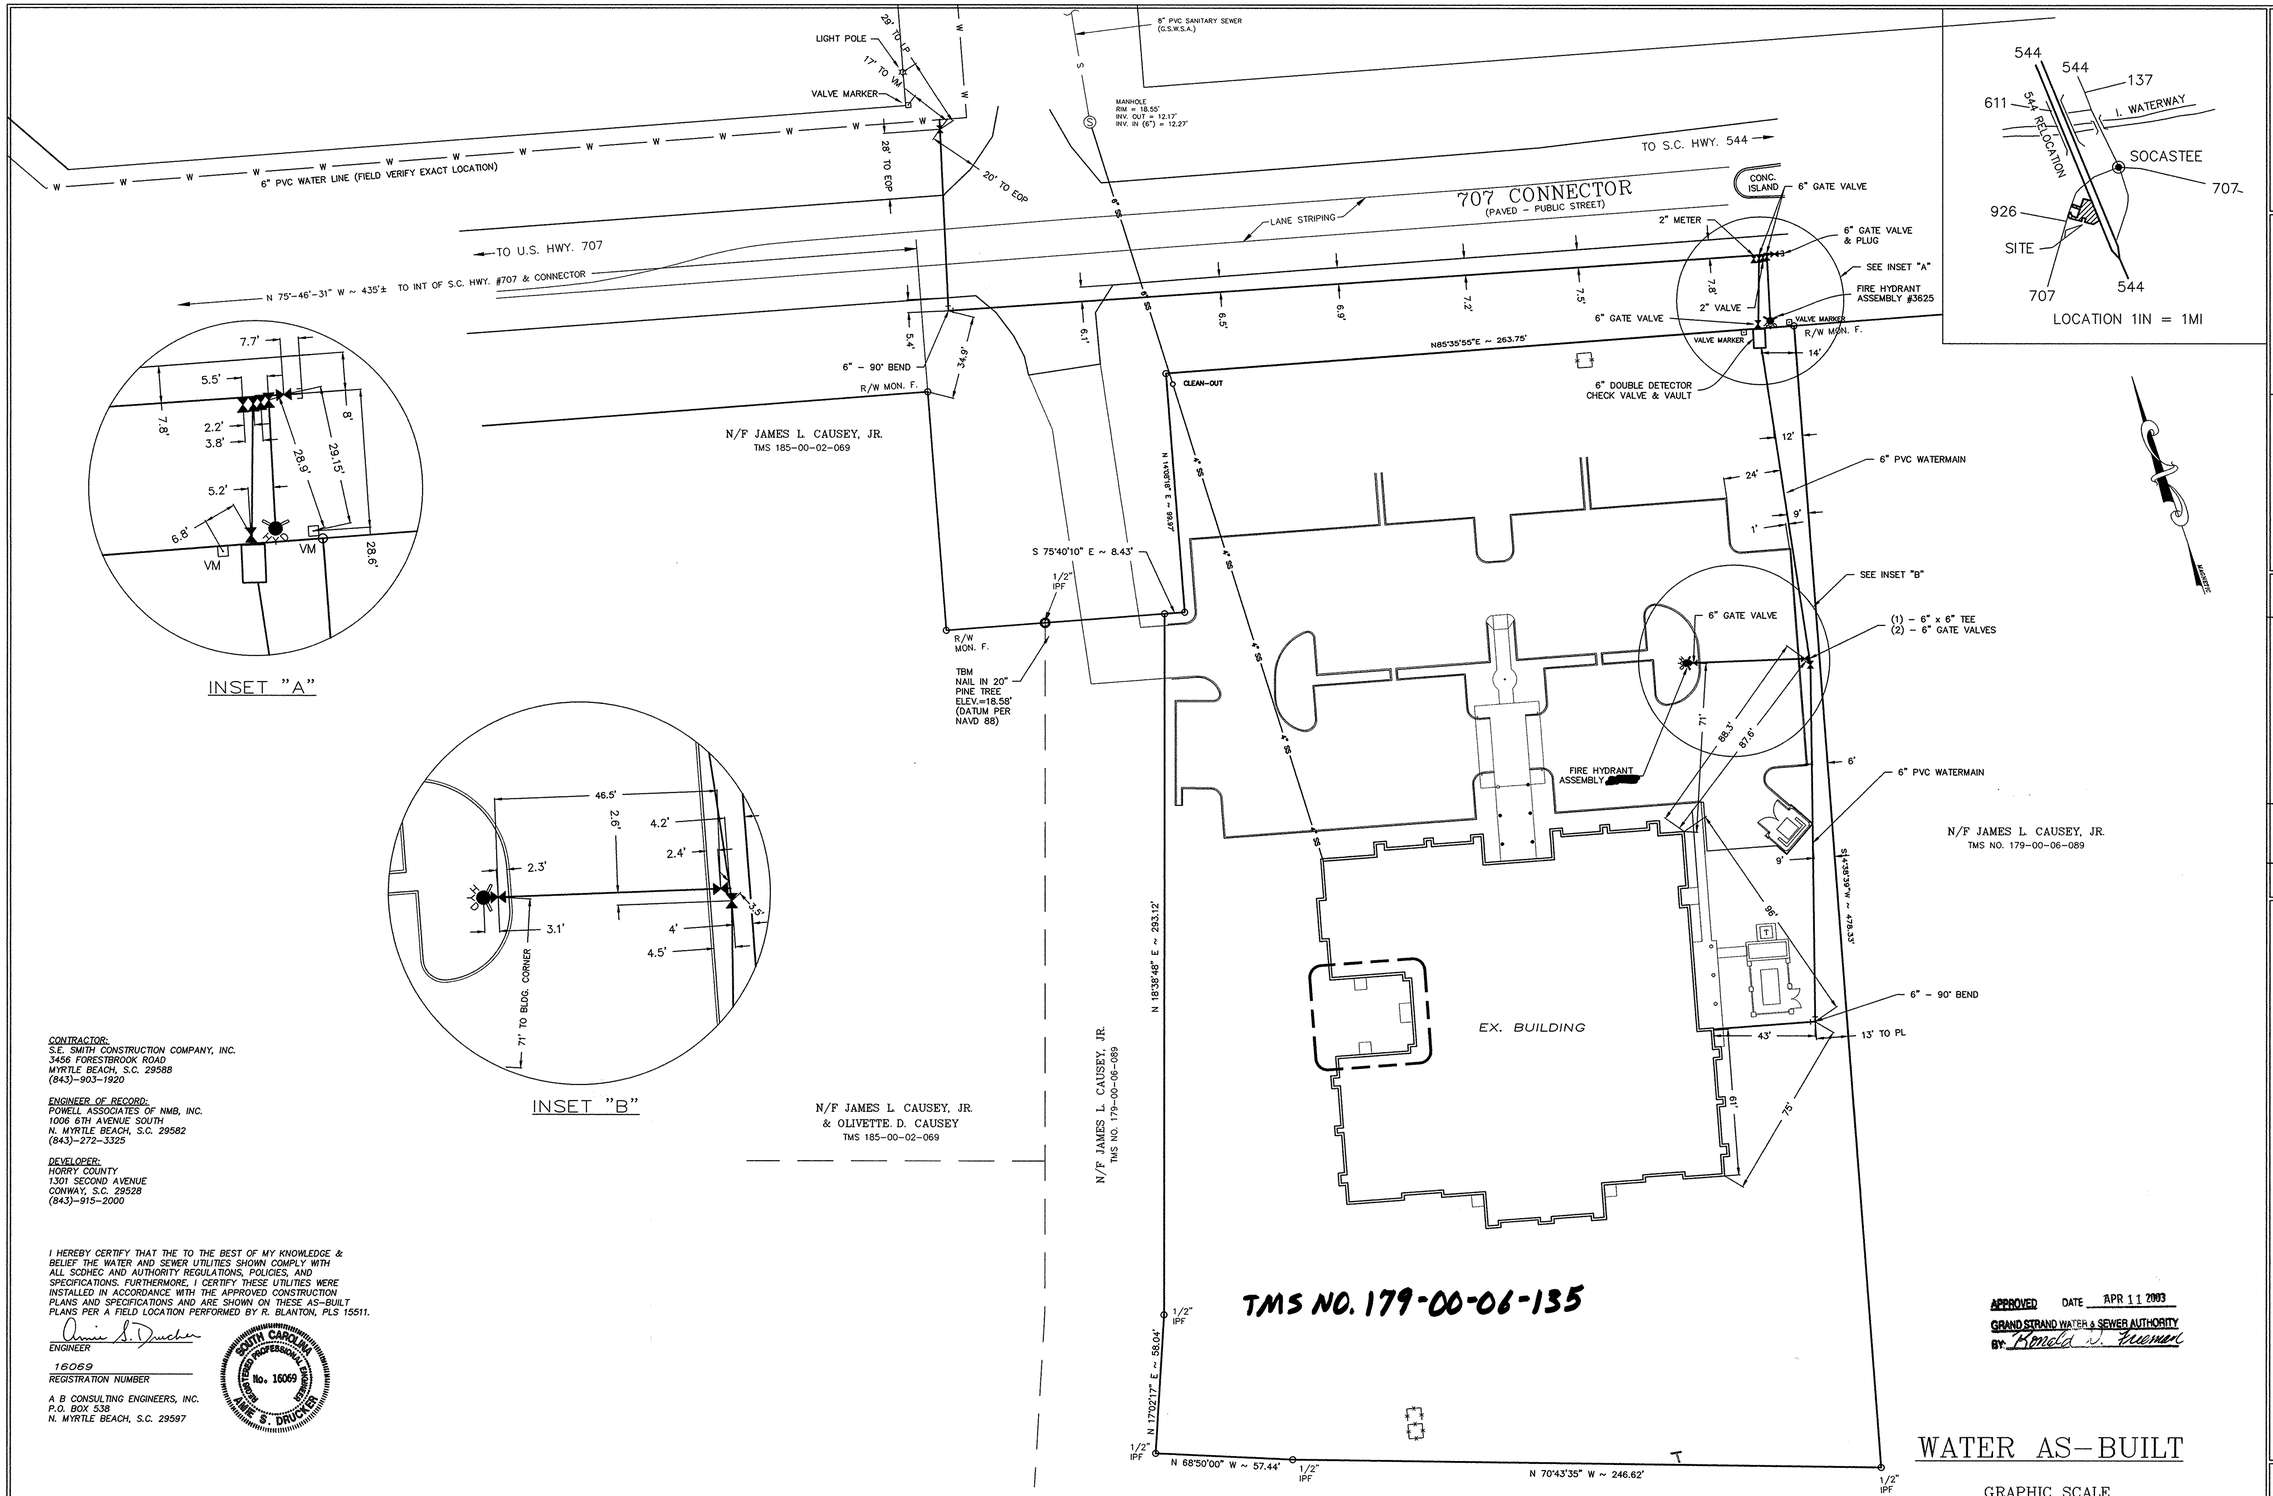

CONTRACTOR:
S.E. SMITH CONSTRUCTION COMPANY, INC.
3456 FORESTBROOK ROAD
MYRTLE BEACH, S.C. 29588
(843)-903-1920

ENGINEER OF RECORD:
POWELL ASSOCIATES OF NMB, INC.
1006 6TH AVENUE SOUTH
N. MYRTLE BEACH, S.C. 29582
(843)-272-3325

DEVELOPER:
HORRY COUNTY
1301 SECOND AVENUE
CONWAY, S.C. 29528
(843)-915-2000

I HEREBY CERTIFY THAT THE TO THE BEST OF MY KNOWLEDGE & BELIEF THE WATER AND SEWER UTILITIES SHOWN COMPLY WITH ALL SCDHEC AND AUTHORITY REGULATIONS, POLICIES, AND SPECIFICATIONS. FURTHERMORE, I CERTIFY THESE UTILITIES WERE INSTALLED IN ACCORDANCE WITH THE APPROVED CONSTRUCTION PLANS AND SPECIFICATIONS AND ARE SHOWN ON THESE AS-BUILT PLANS PER A FIELD LOCATION PERFORMED BY R. BLANTON, PLS 15511.

Amie S. Drucker
ENGINEER

16069
REGISTRATION NUMBER

SOUTH CAROLINA REGISTERED PROFESSIONAL ENGINEER No. 16069 AMIE S. DRUCKER

A B CONSULTING ENGINEERS, INC.
P.O. BOX 538
N. MYRTLE BEACH, S.C. 29597

NOTES:
1. AS-BUILT DRAWINGS PREPARED FROM DATA SUPPLIED BY JAMES R. BLANTON P.L.S..
2. DIMENSIONS SHOWN TO WATER SERVICES ARE FROM BACK-OF-CURB.

NO.	DATE	DESCRIPTION	BY
2.	4-7-03	REVISED PER G.S.W.S.A. COMMENTS	T.J.G.
1.	3-28-03	REVISED PER G.S.W.S.A. COMMENTS	T.J.G.

DRAWN BY: T.J.G. DATE: MARCH 13, 2003
CHECKED BY: P.A. DRAWING NO.: WAB
JOB NO.: 2003-ASB SHEET 1 OF 1

A NEW SOCASTEE PUBLIC LIBRARY
HORRY COUNTY, SOUTH CAROLINA
PREPARED FOR
HORRY COUNTY

10-019-001 W