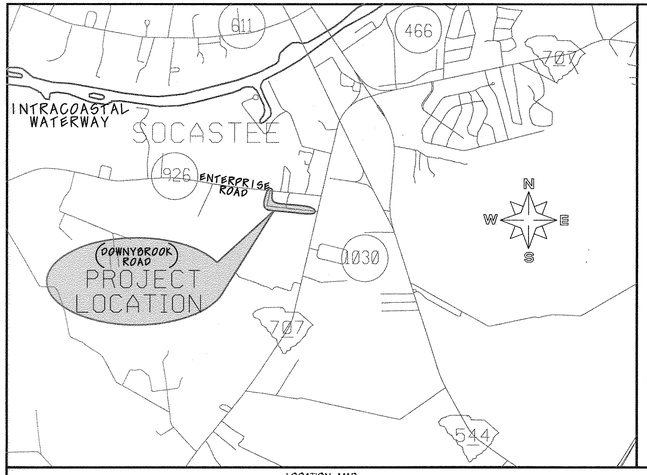

LOCATION MAP
SCALE: NTS

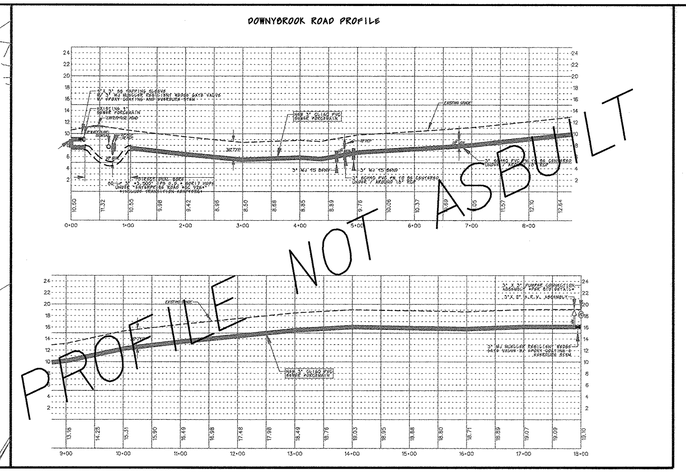

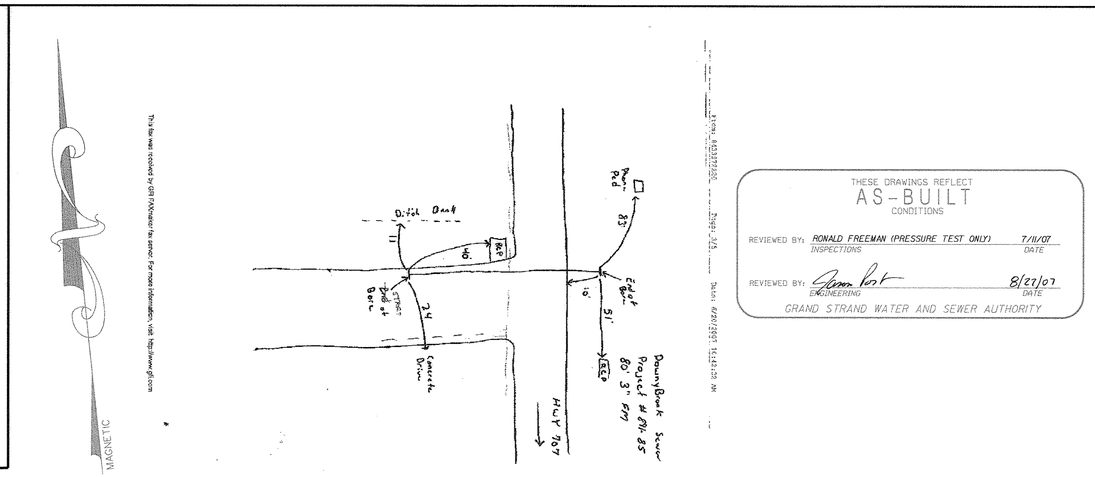

REVISION	BY	DATE
1) Asbuilt Revised	TBH	08/31/07

GRAND STRAND WATER & SEWER AUTHORITY
170 JACKSON BLUFF RD.
P.O. BOX 2368
CONWAY, SC 29528-2368
(843) 347-1641 OR 448-1686
(843) 347-1689 (FAX)
E-MAIL: GSWSA@COX.NET

DOWNYBROOK ROAD RURAL SEWER PROJECT

(LOCATED OFF OF SC HWY 707 & ENTERPRSE ROAD - SC 926)

PROJ. #891-85 /CONT. #S008-06

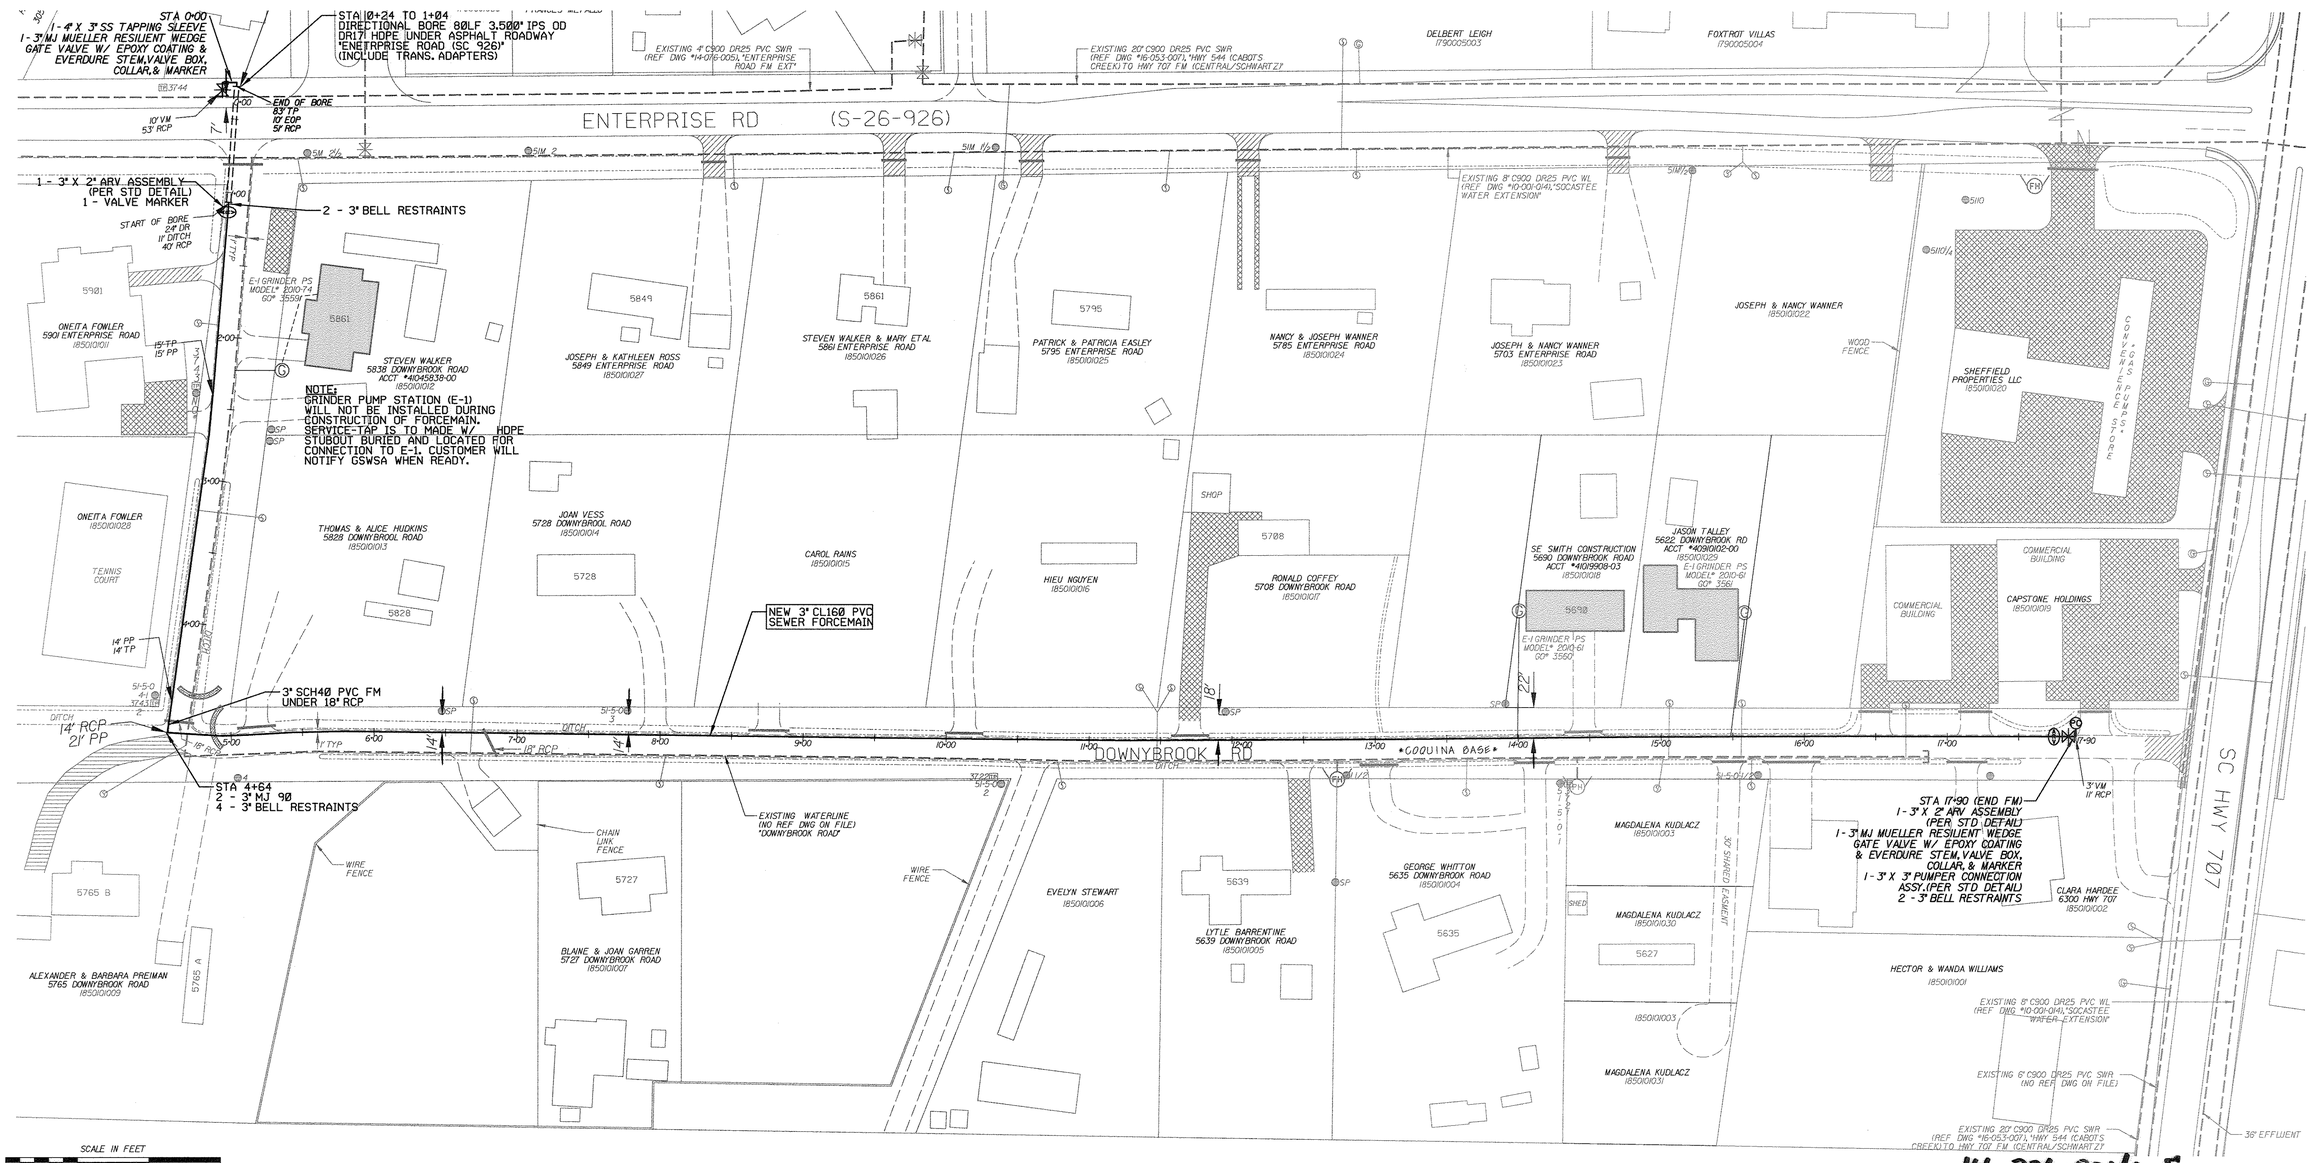

14-326-001/1-5

DOWNYBROOK ROAD RURAL SEWER PROJECT

SOUTH CAROLINA REGISTERED PROFESSIONAL ENGINEER No. 21255 CHRISTINA S. EVERETT

SC DHEC CONSTR. PERMIT # ISSUED:	
DATE: APRIL 2007	
SCALE: AS SHOWN	
FILENAME: downybrook.dgn	
DESIGNED BY	CRAIG DUNN
CHECKED BY	CHRISTINA S. EVERETT
APPROVED BY	
CHRISTINA S. EVERETT PE #21255	

SHEET 1 OF 1