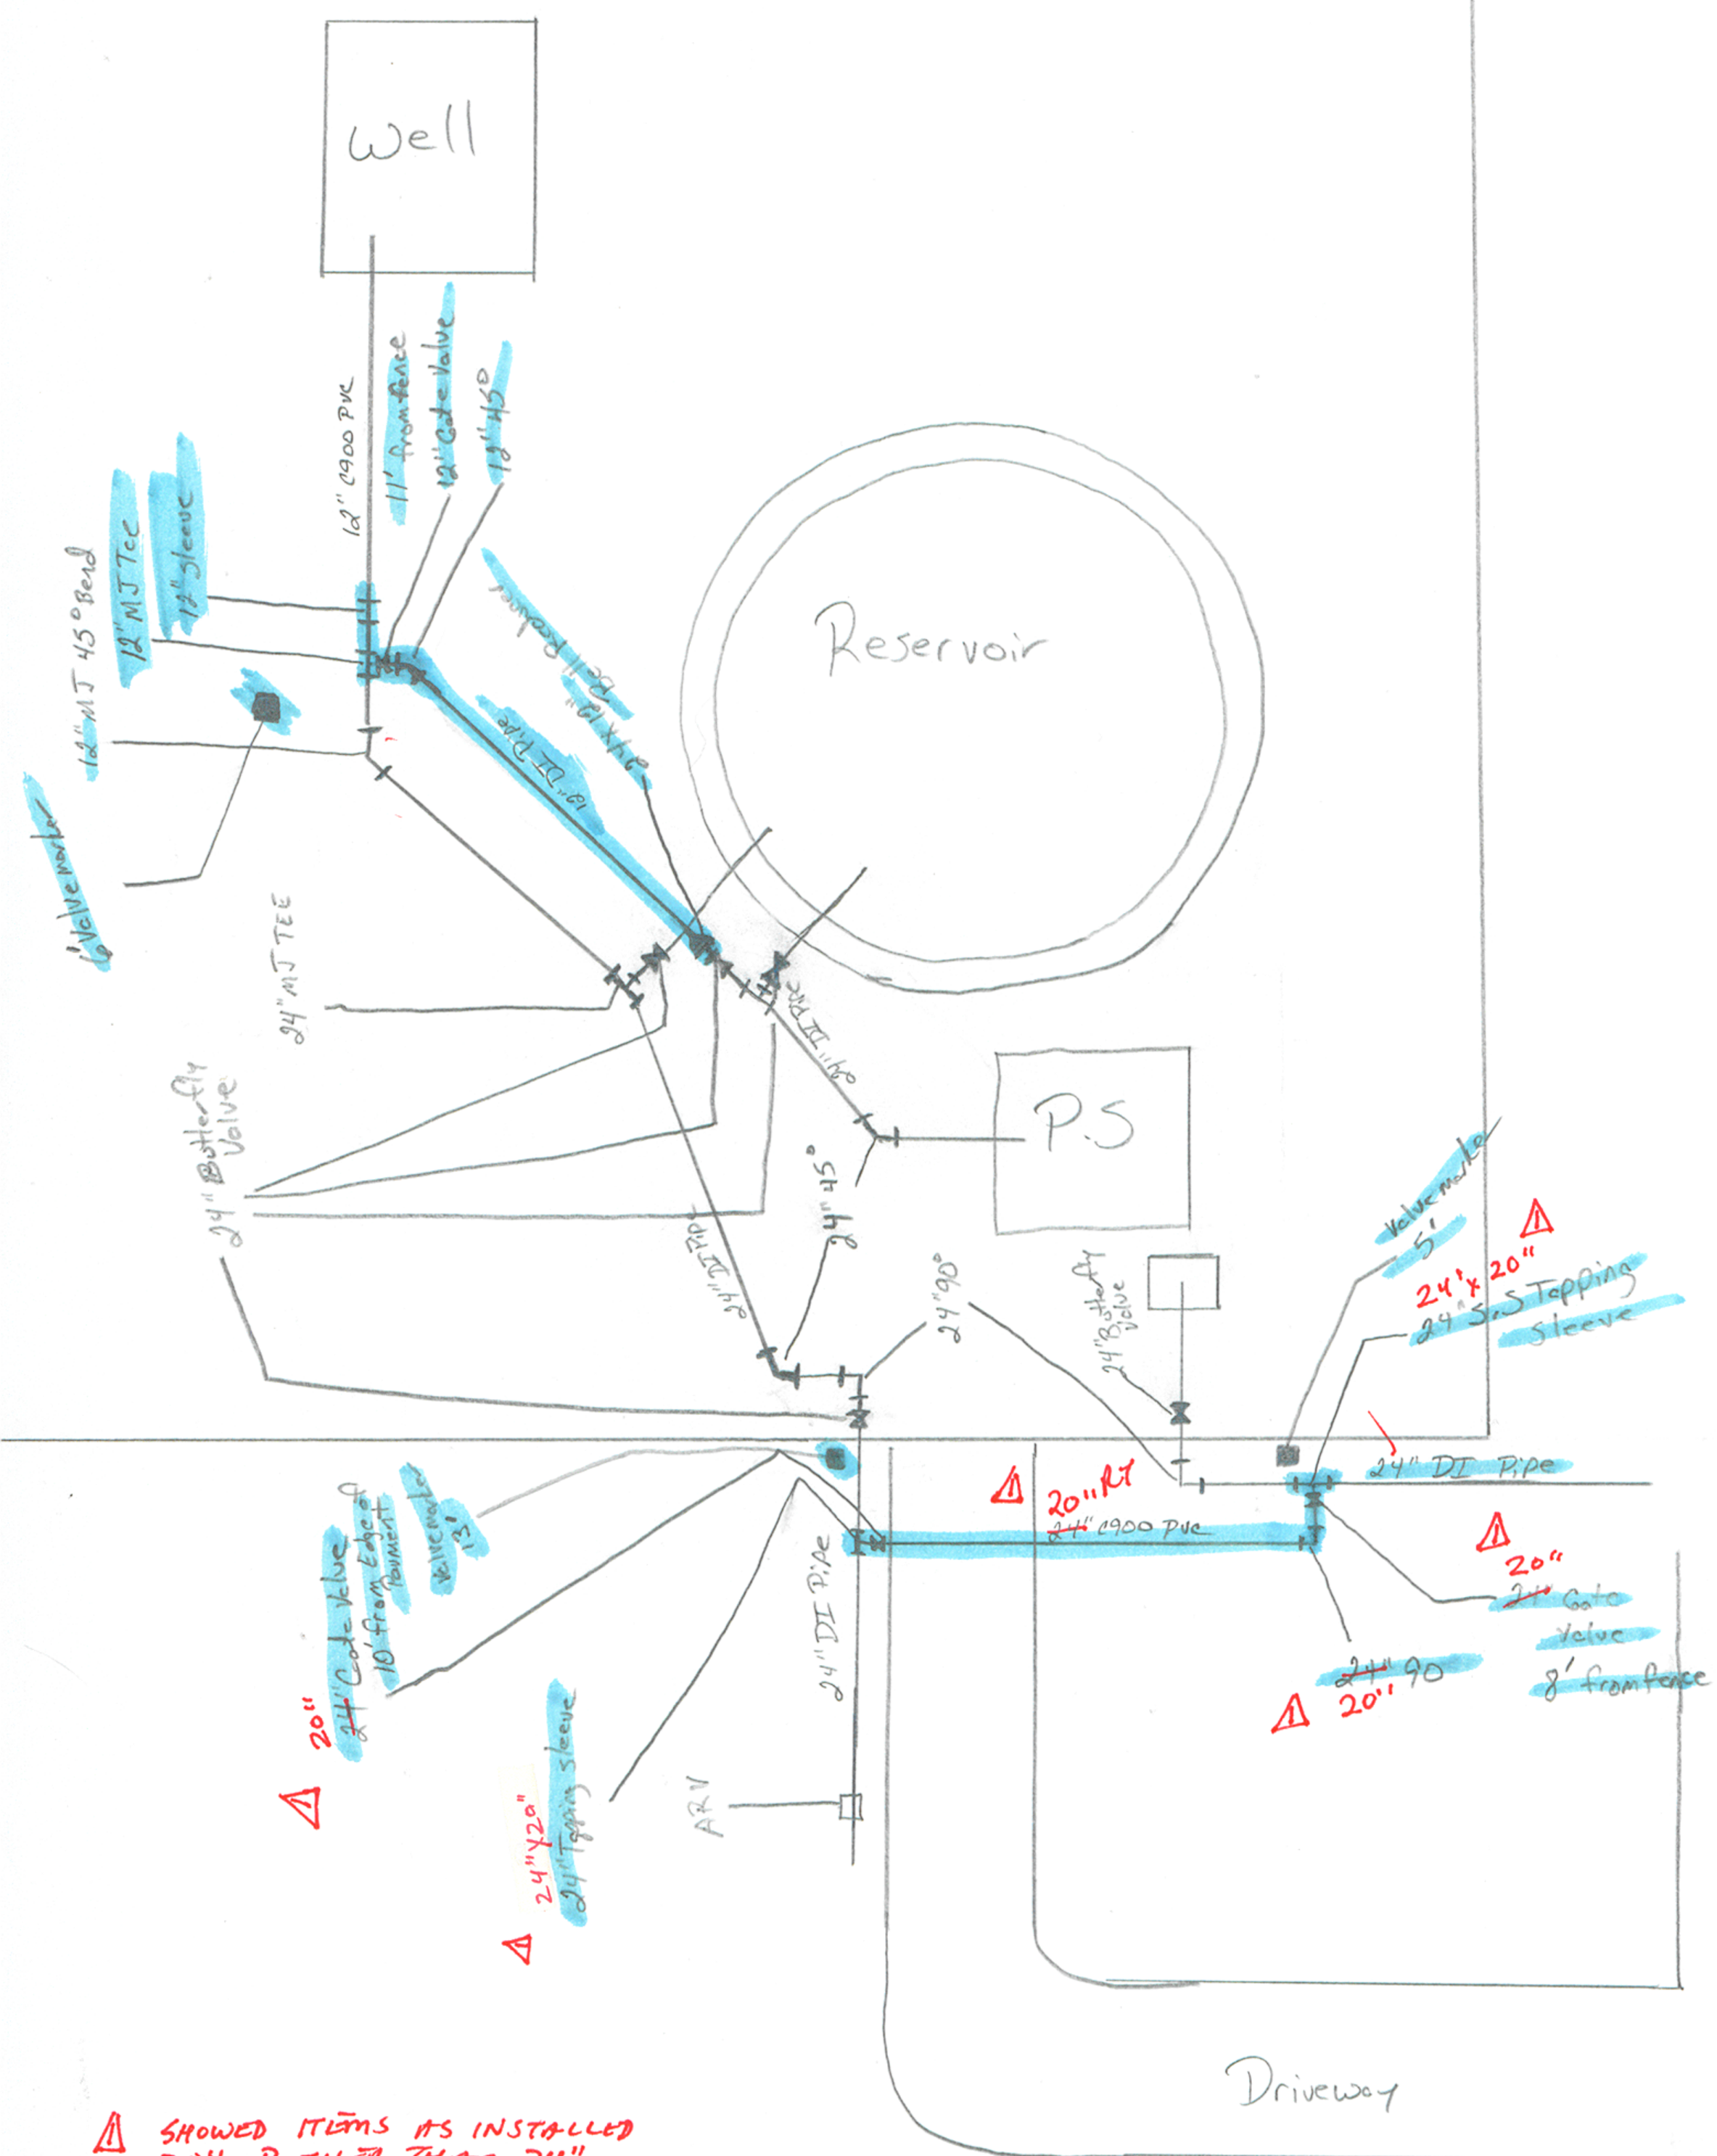

SHOWED ITEMS AS INSTALLED 20" RATHER THAN 24". (R. THOMPKINS 1-31-2012)

CONWAY RESERVOIR BYPASS LINES

99-045-001/1