Perry Rod.
Field Mark-up
by
Bradley Suggs
2/7/12
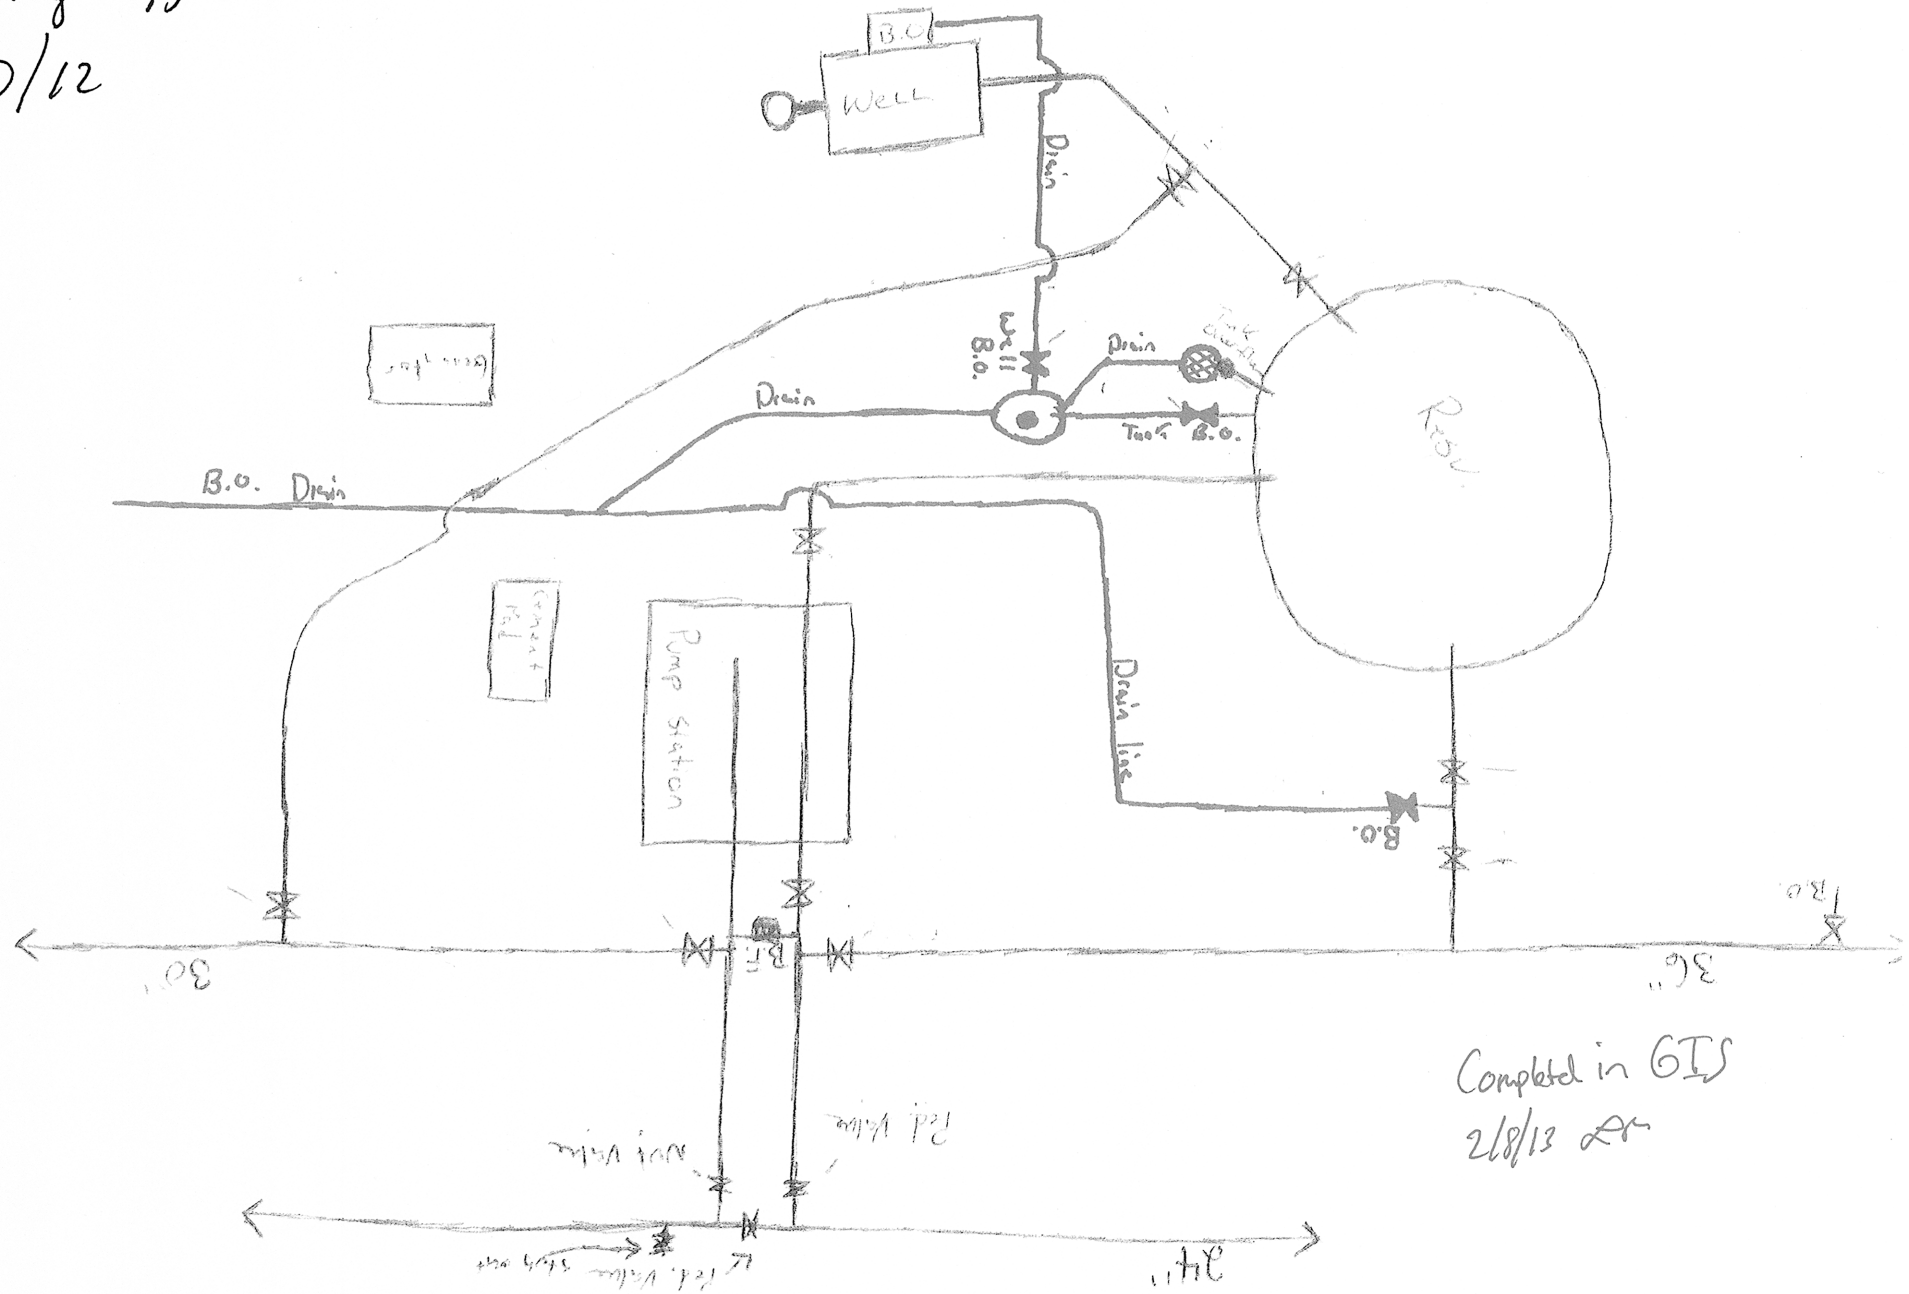
99-093 1 of 1