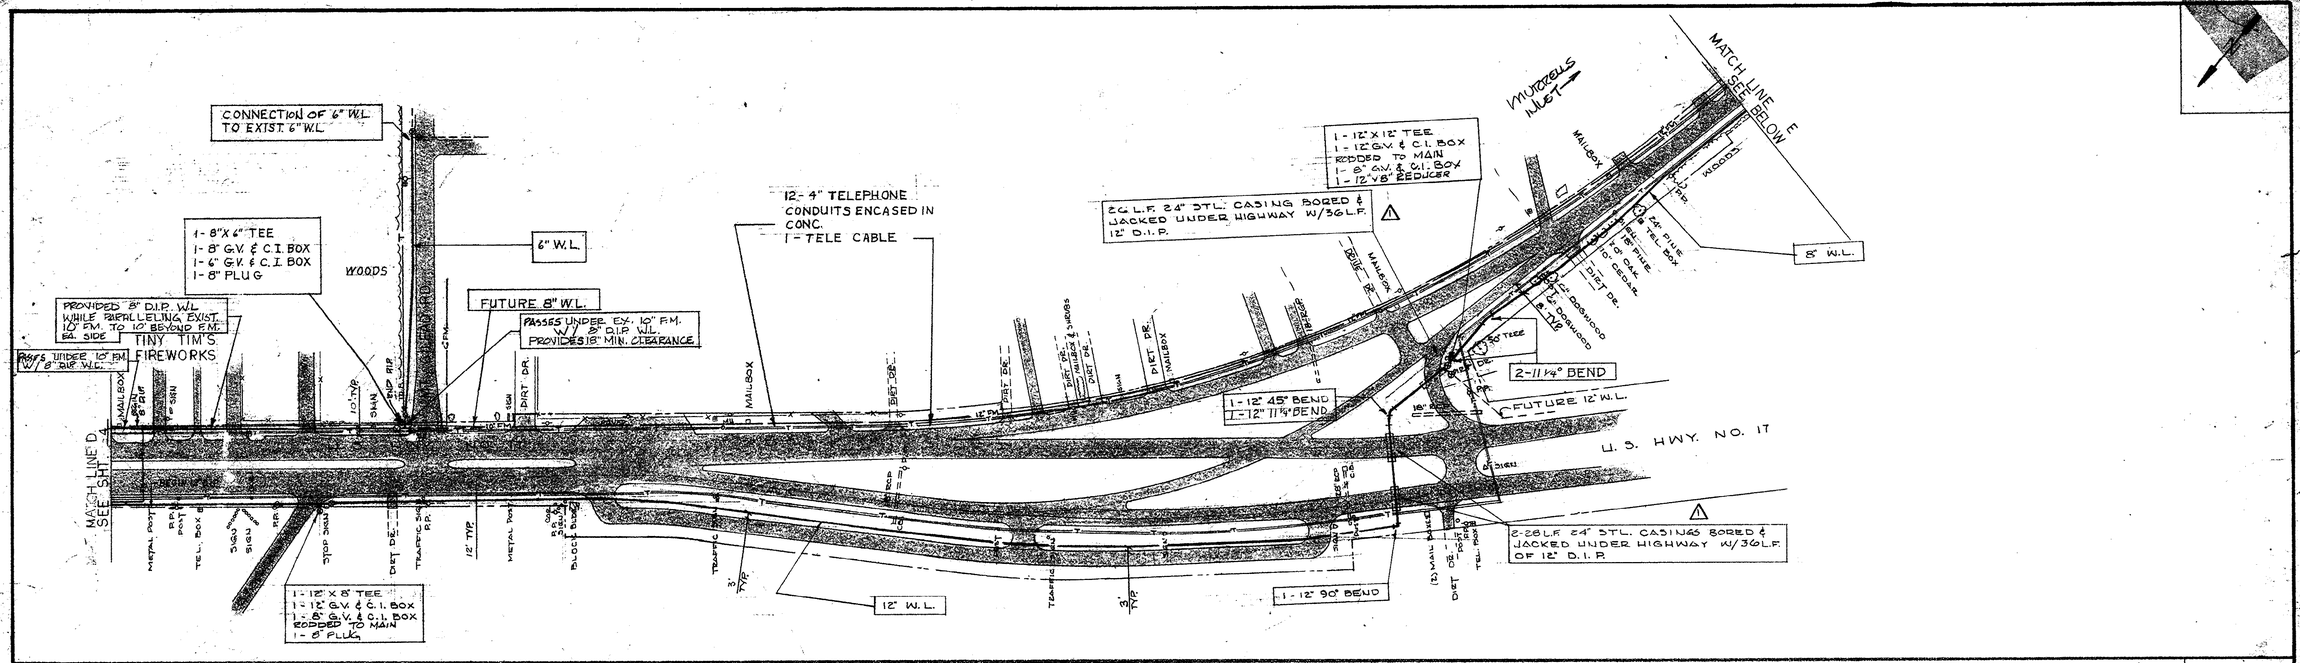

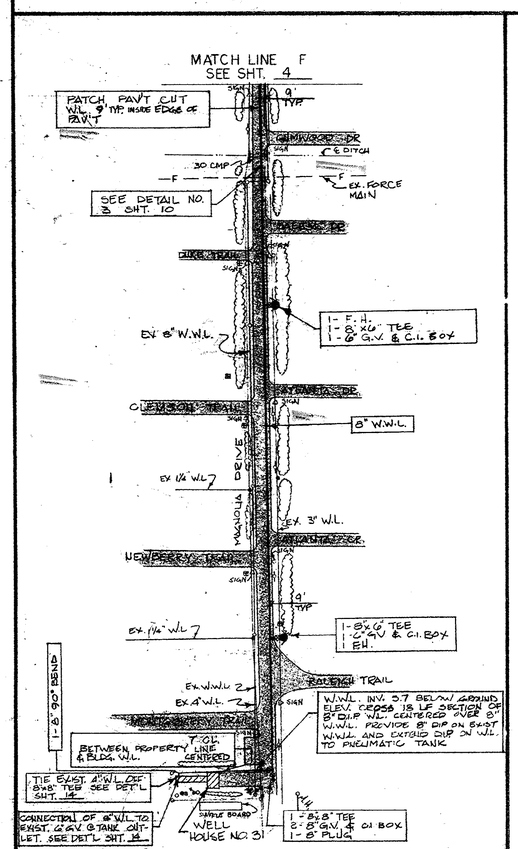

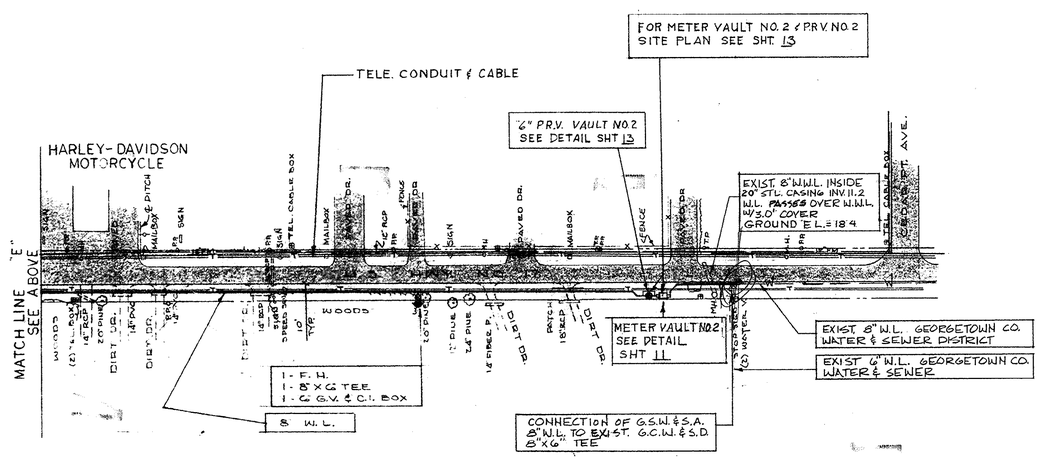

NOTES:

1) CONTRACTOR TO VERIFY LOCATION OF EXIST. UTILITIES.
2) CONC. TELE CONDUIT ON EAST SIDE OF US HWY 17 CONTAINS 12 - 4" CONDUITS. SEE SHT. 4 FOR END OF CONDUIT.

APPROVED:
MOORE, GARDNER & ASSOCIATES, INC.
By: W.P. Benjegerdes
Date: 1-27-82

FIXED ASSETS
1-29-86 RF

18-06-004/16-W

RECORD DRAWING
THIS DRAWING [illegible] TO REFLECT CHANGES [illegible] UPON INFORMATION PROVIDED BY THE CONTRACTOR [illegible] BY THE [illegible] REPRESENTATIVE.
BY: _____
ENGINEER

MARK	DATE	REVISION	APP'D.
△	1/15/86	PER AS BUILTS	M.F.R.

ENGINEER: Michael F. Redmond
DATE: 6-15-81
SEAL: SOUTH CAROLINA REGISTERED PROFESSIONAL ENGINEER No. 8285 MICHAEL F. REDMOND

DRAWN BY: J.L.
CHECKED BY:
APP'D. BY:
DATE:
DATE:
DATE:

US HWY 17
WATER DISTRIBUTION SYSTEM
PHASE I
GARDEN CITY
HORRY COUNTY
SOUTH CAROLINA

MOORE, GARDNER & ASSOCIATES, INC.
CONSULTING ENGINEERS
SURFSIDE BEACH
SOUTH CAROLINA

SCALE: 1" = 100'
JOB NO.: 800115
DRAWER NO.:
SHEET 5 OF 16